
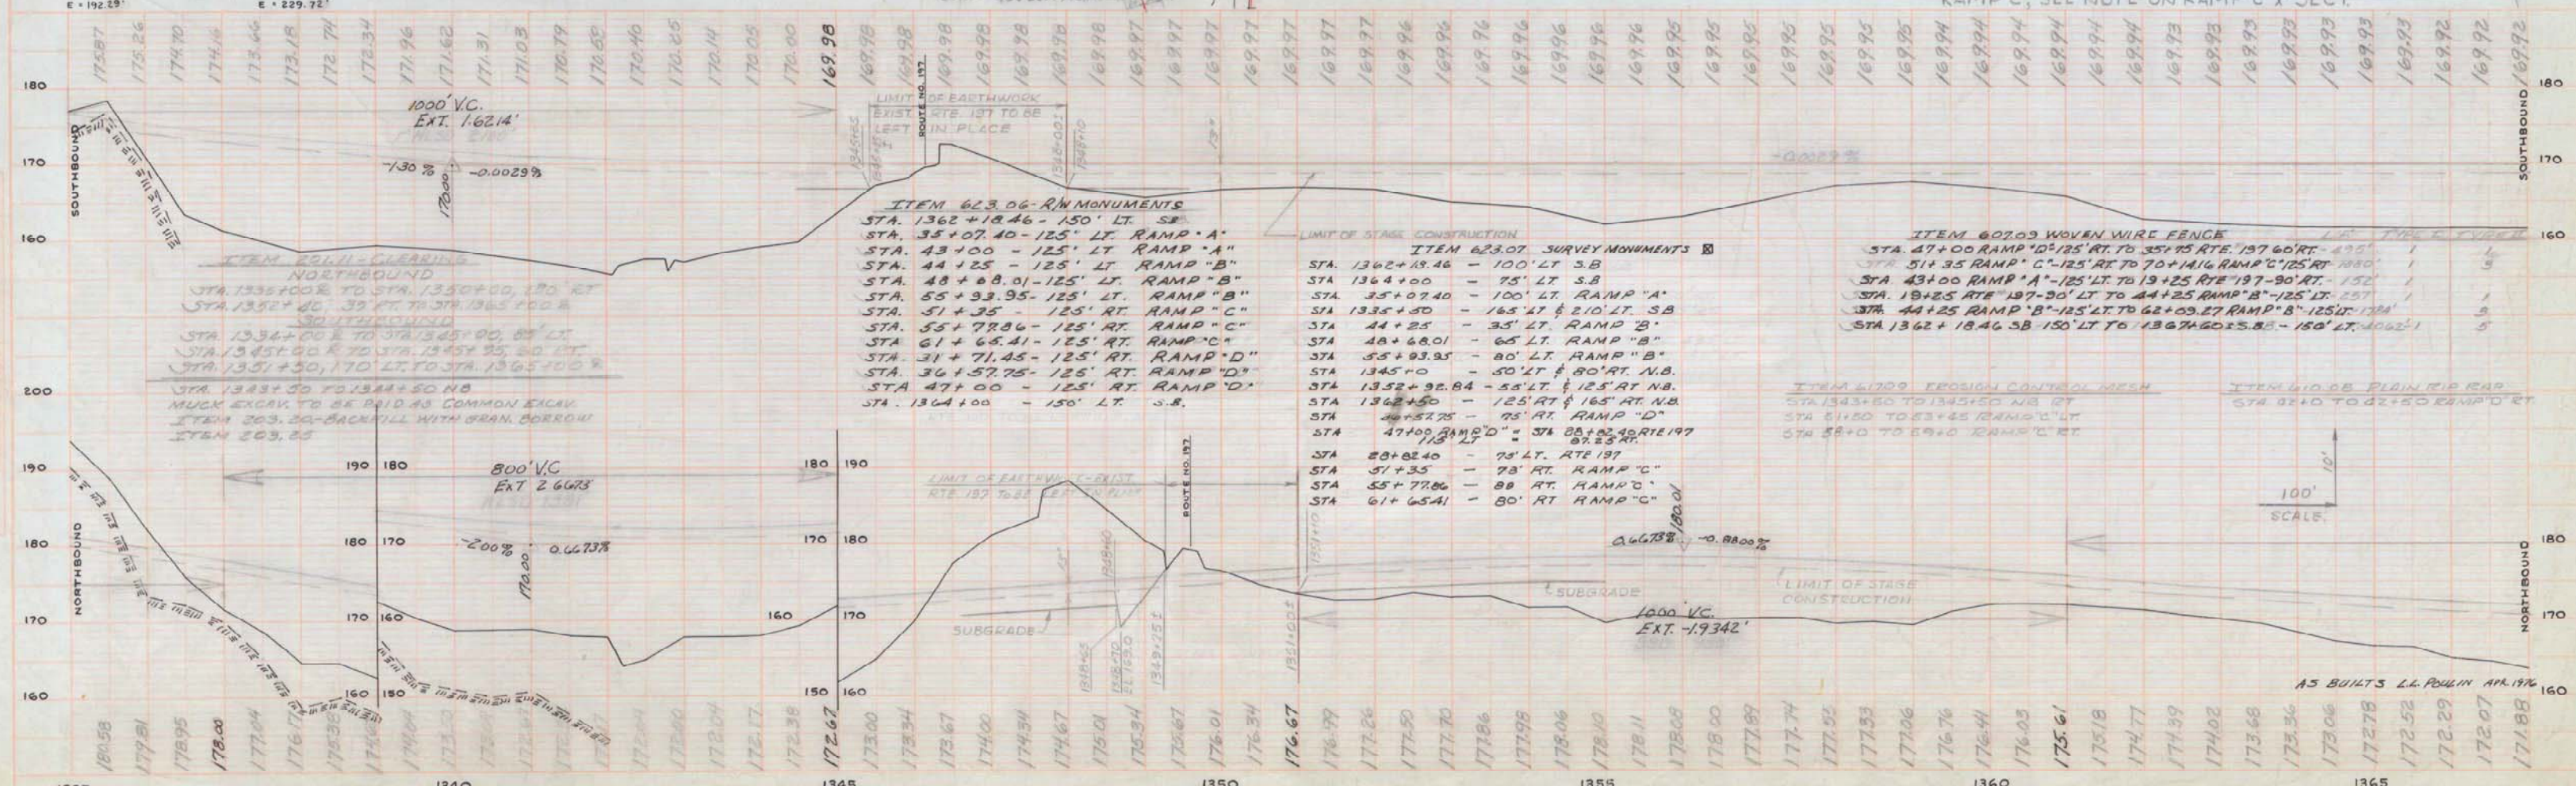


WINFIELD A. DEVLIN
ALICE DEVLIN

ALBION RAYNES

DATE	STATE	PROJECT NUMBER	SHEET NO.	TOTAL SHEETS
1	MAINE	I-95-5(37)	28	155

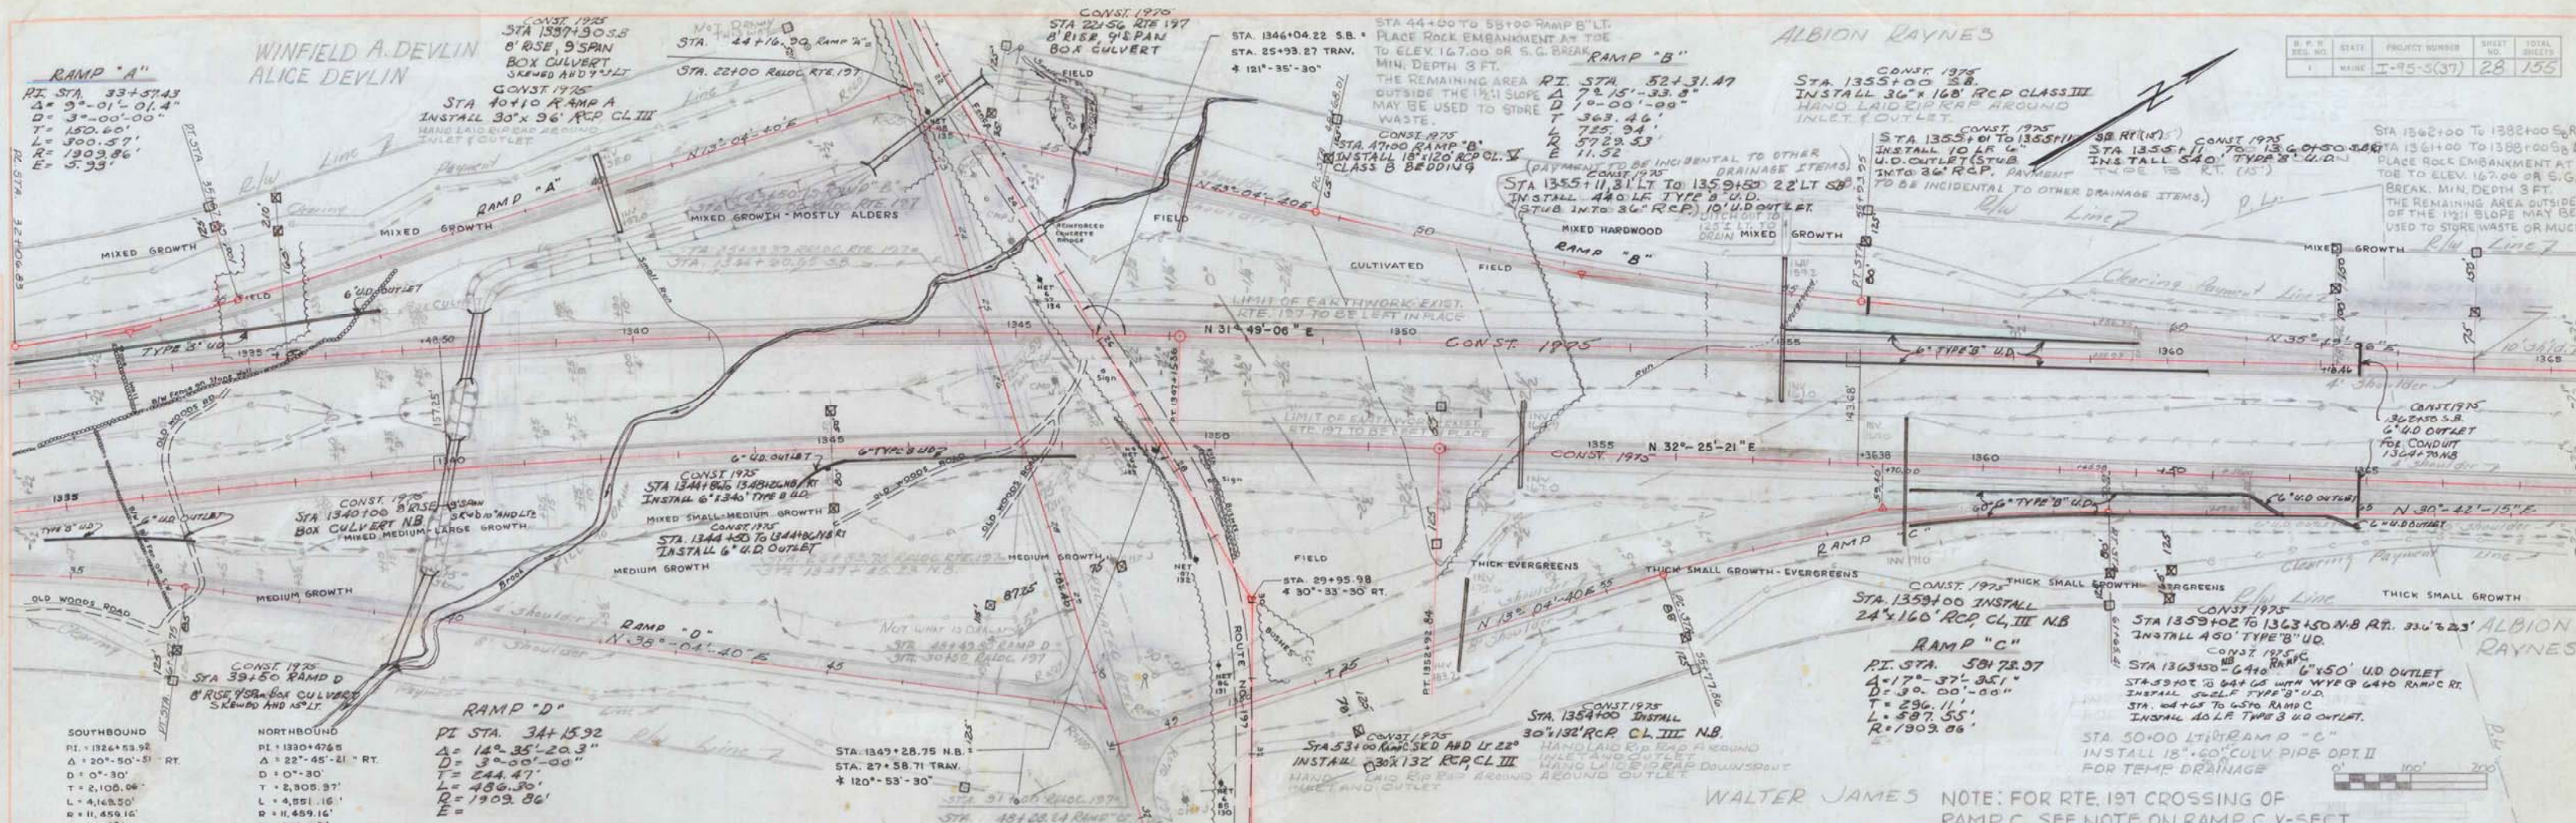

BOWDOINHAM-RICHMOND I-95-5(37)