F.P.R. REG. NO.	STATE	PROJECT NUMBER	SHEET NO.
1	MAINE	I-95-5(22)	19

SURVEY ℄ SOUTHBOUND
P.I. STA. 841+33.14
Δ = 24°-48'-09" LT.
D = 1°-15'-00"
T = 1,007.69'
L = 1,984.20'
R = 4583.66'
E = 109.50'

CONST ℄ SOUTHBOUND
P.I. STA. 840+37.78
Δ = 24°-48'-09" LT.
D = 1°-30'
T = 839.91'
L = 1,653.50'
R = 3,819.72'
E = 91.25'

S.B. Sta. 835+00
Install: 30"x105' R.C.P. Class III
INSTALLED 1974

ROBERT R. BERZINIS
SOPHIE KNIGHT

ERNEST F MARSTALLER

NORTHBOUND
P.I. STA. 882+01.68
Δ = 12°-30'-50" LT.
D = 0°-40'-00"
T = 942.28'
L = 1,877.06'
R = 8594.37'
E = 51.5'

SOUTHBOUND
P.I. STA. 882+33.20
Δ = 13°-18'-55" LT.
D = 1°-00'-00"
T = 668.77'
L = 1,331.01'
R = 5729.58'
E = 38.90

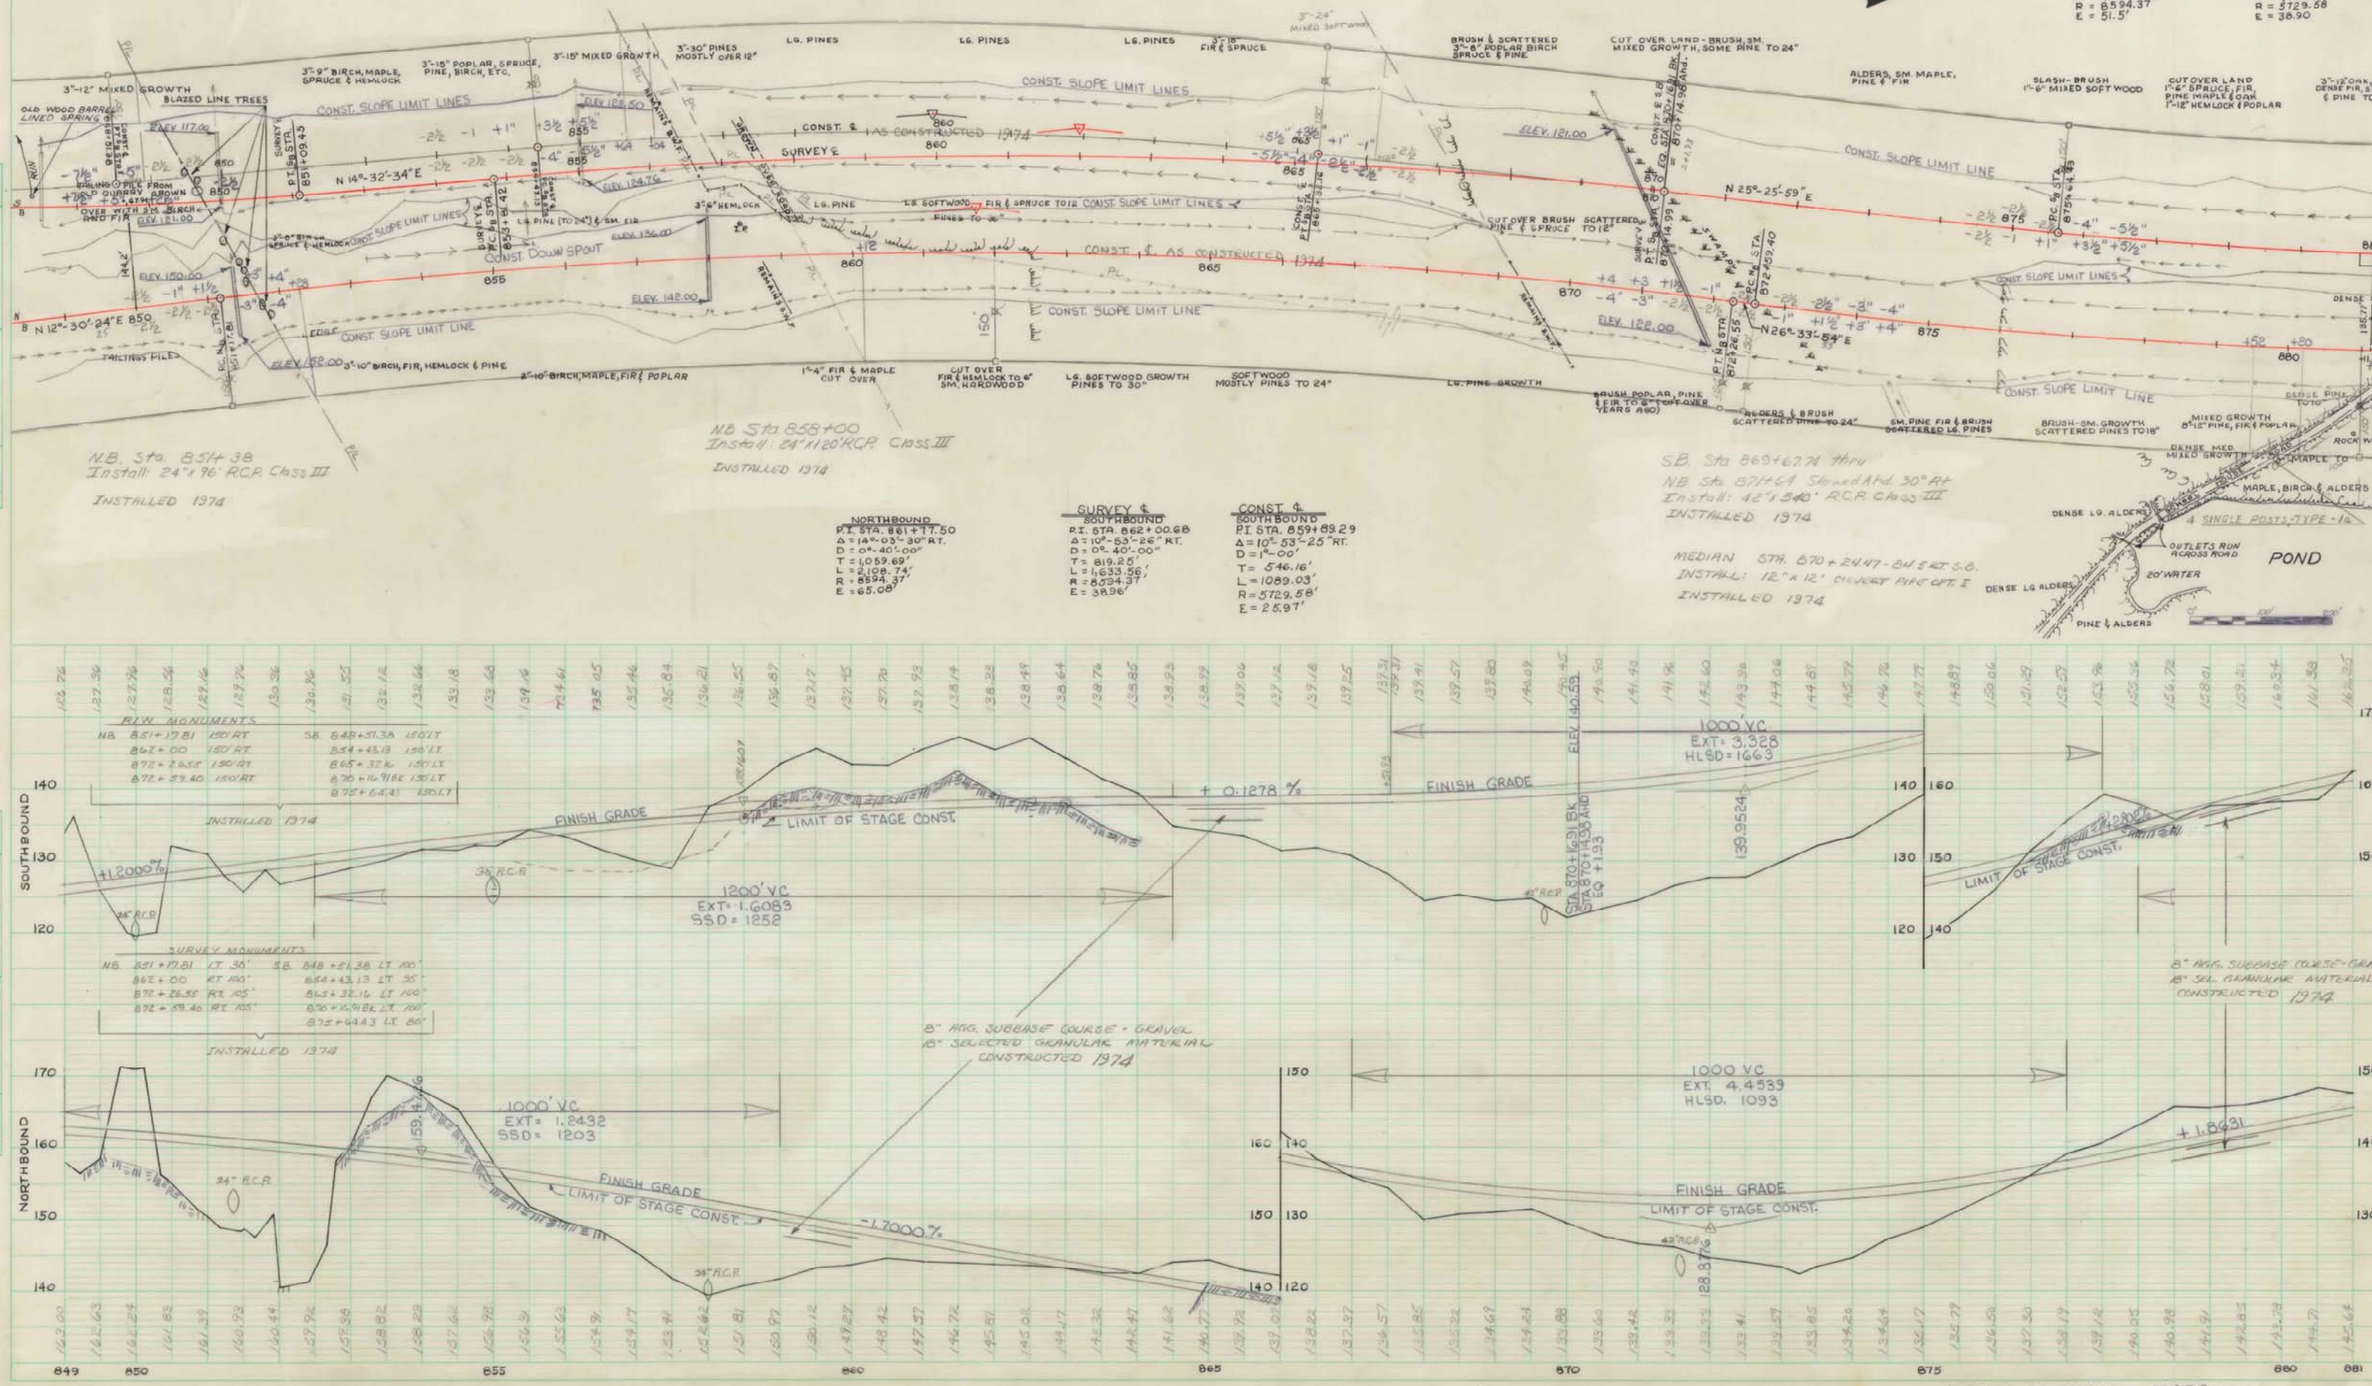

REVISED AS BUILT
G. Clark

TOPSHAM