R.P.B. REG. NO.	STATE	PROJECT NUMBER	SHEET NO.
1	MAINE	I-95-5(22)	17

PLAN — SURVEYED / PLOTTED / ALIGNMENT CHECKED / R.W. NOT CHECKED / NOTE BOOK / FIELD
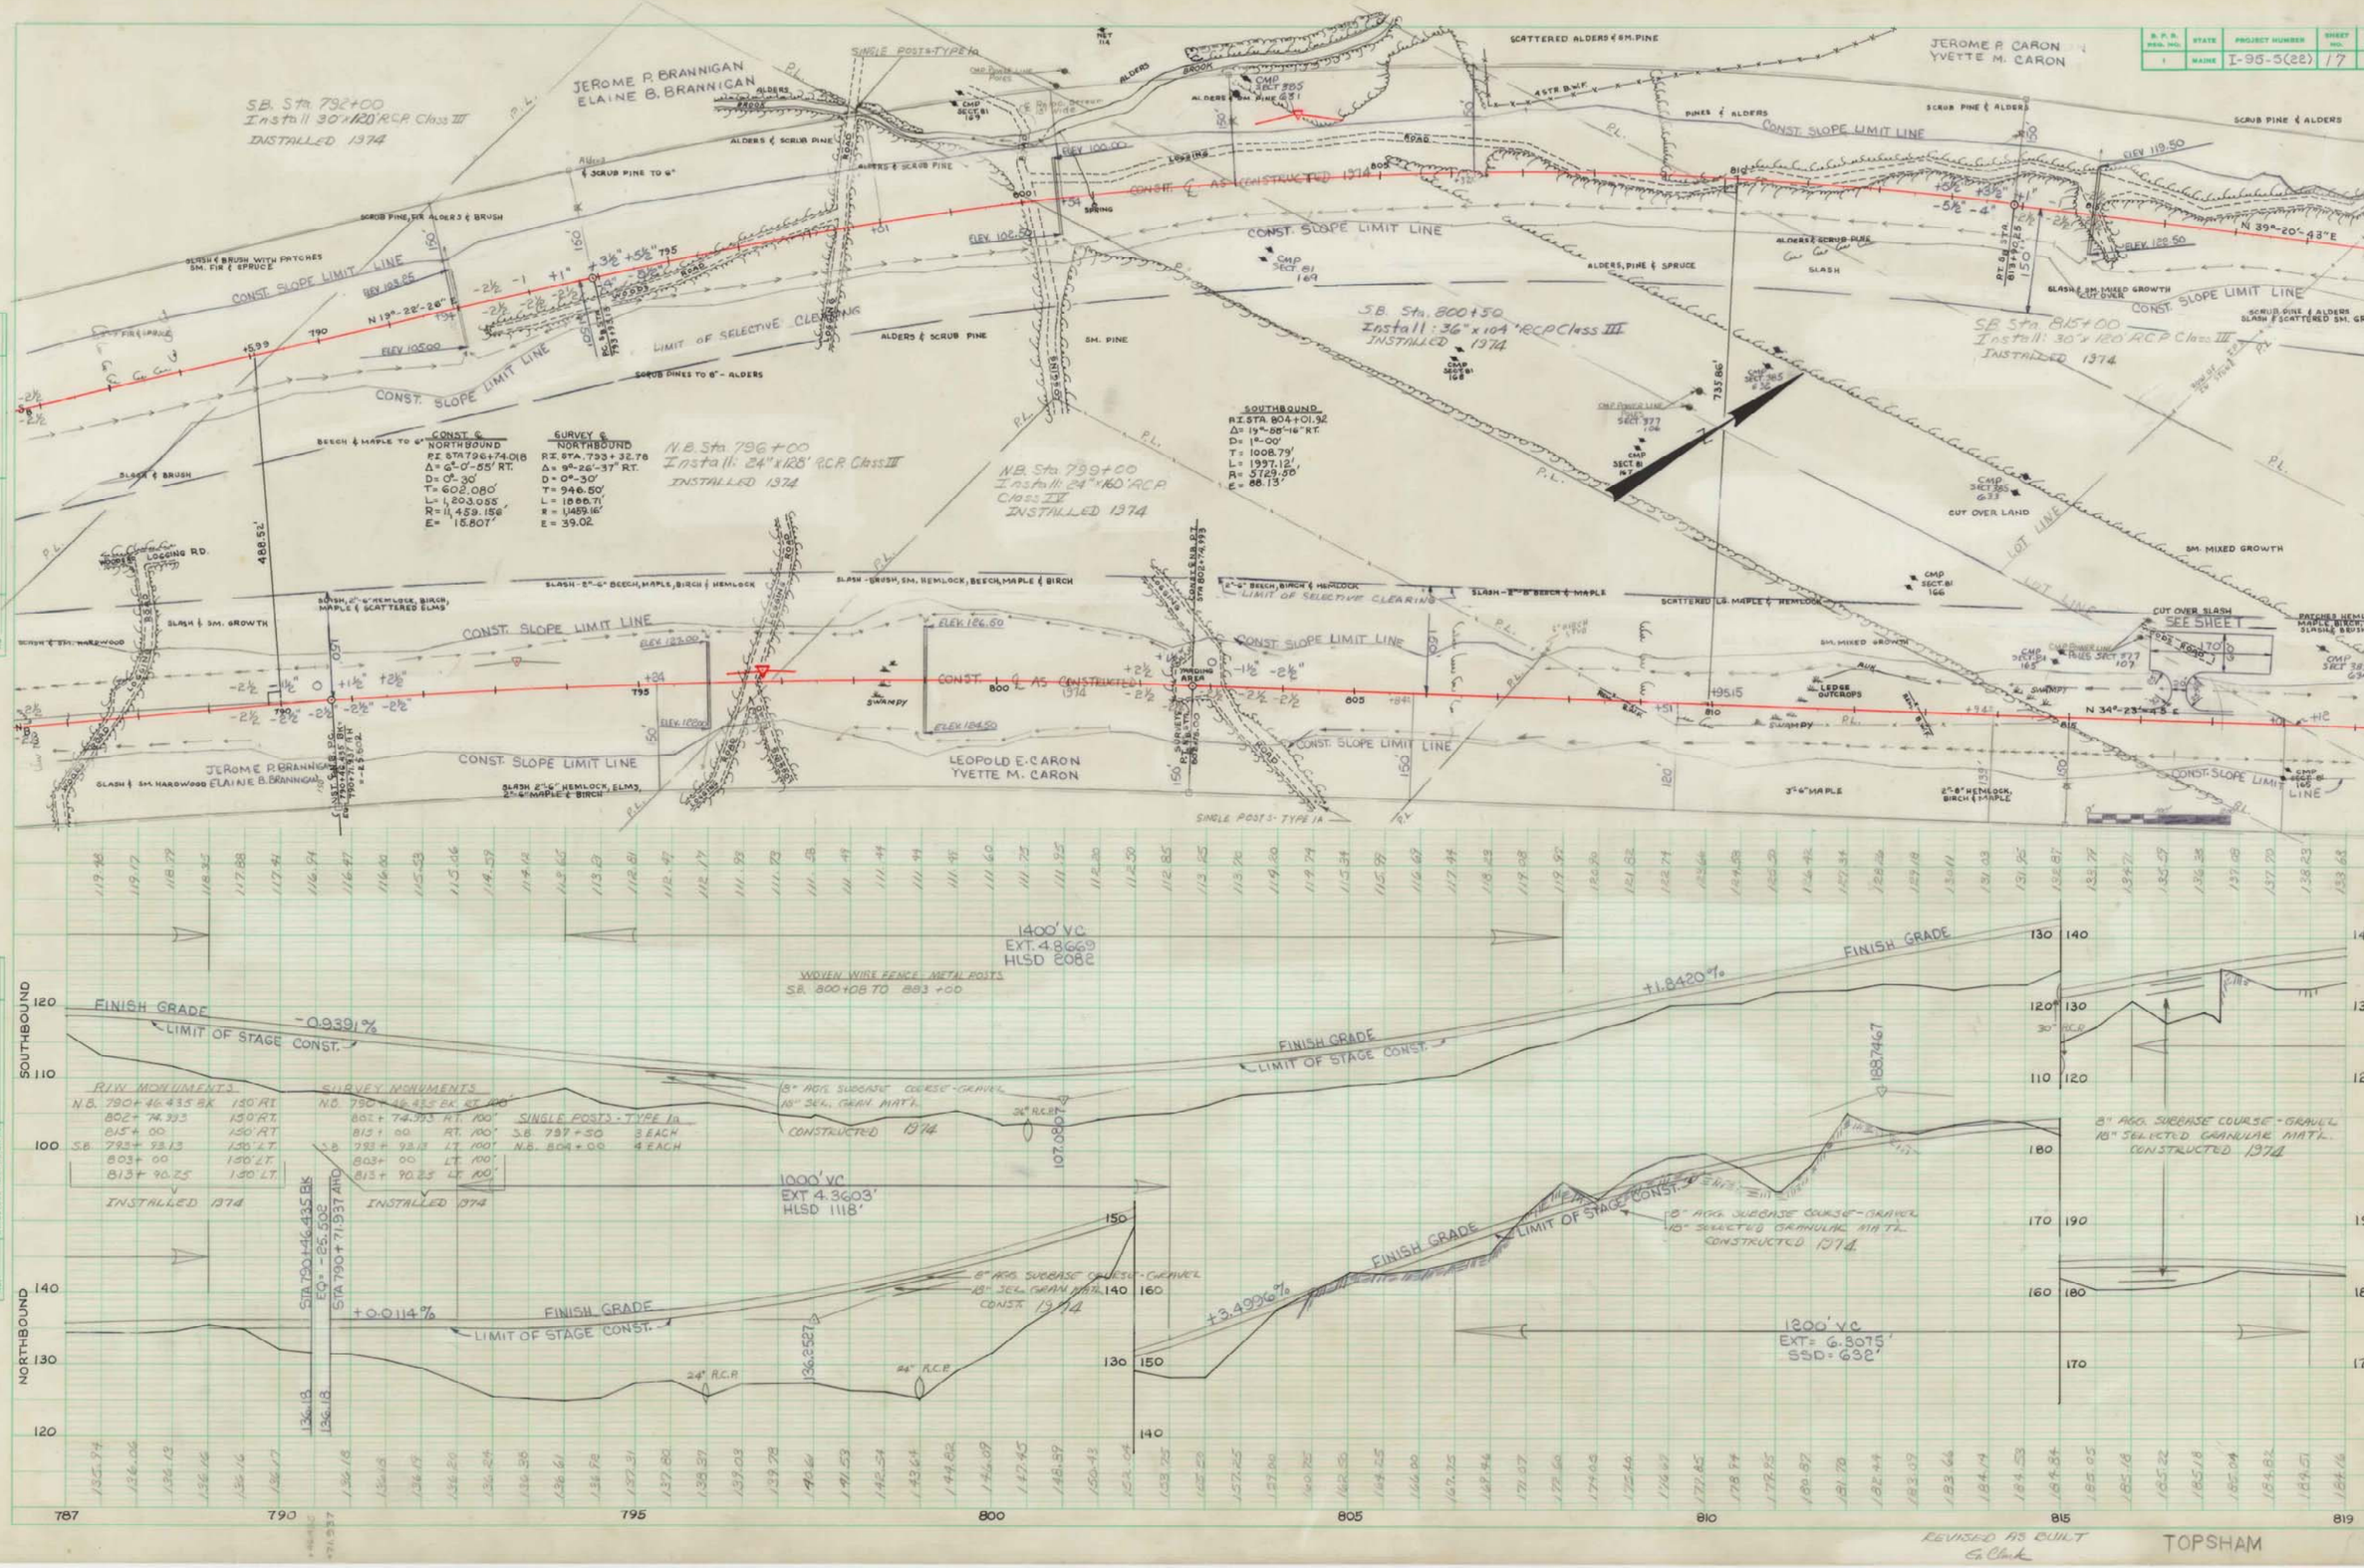
PROFILE — SURVEYED / PLOTTED / GRADES CHECKED / B. MAL. NOTES / STRUCTURE NOTES ON CP. NO. / NOTE BOOK / FIELD