


FINAL SURVEY
NO. _____
DATE _____
BY _____
SURVEYED
PLOTTER
CHECKED
AREA CHECKED

ORIGINAL SURVEY
NO. _____
DATE _____
BY _____
SURVEYED
PLOTTER
CHECKED
AREA CHECKED

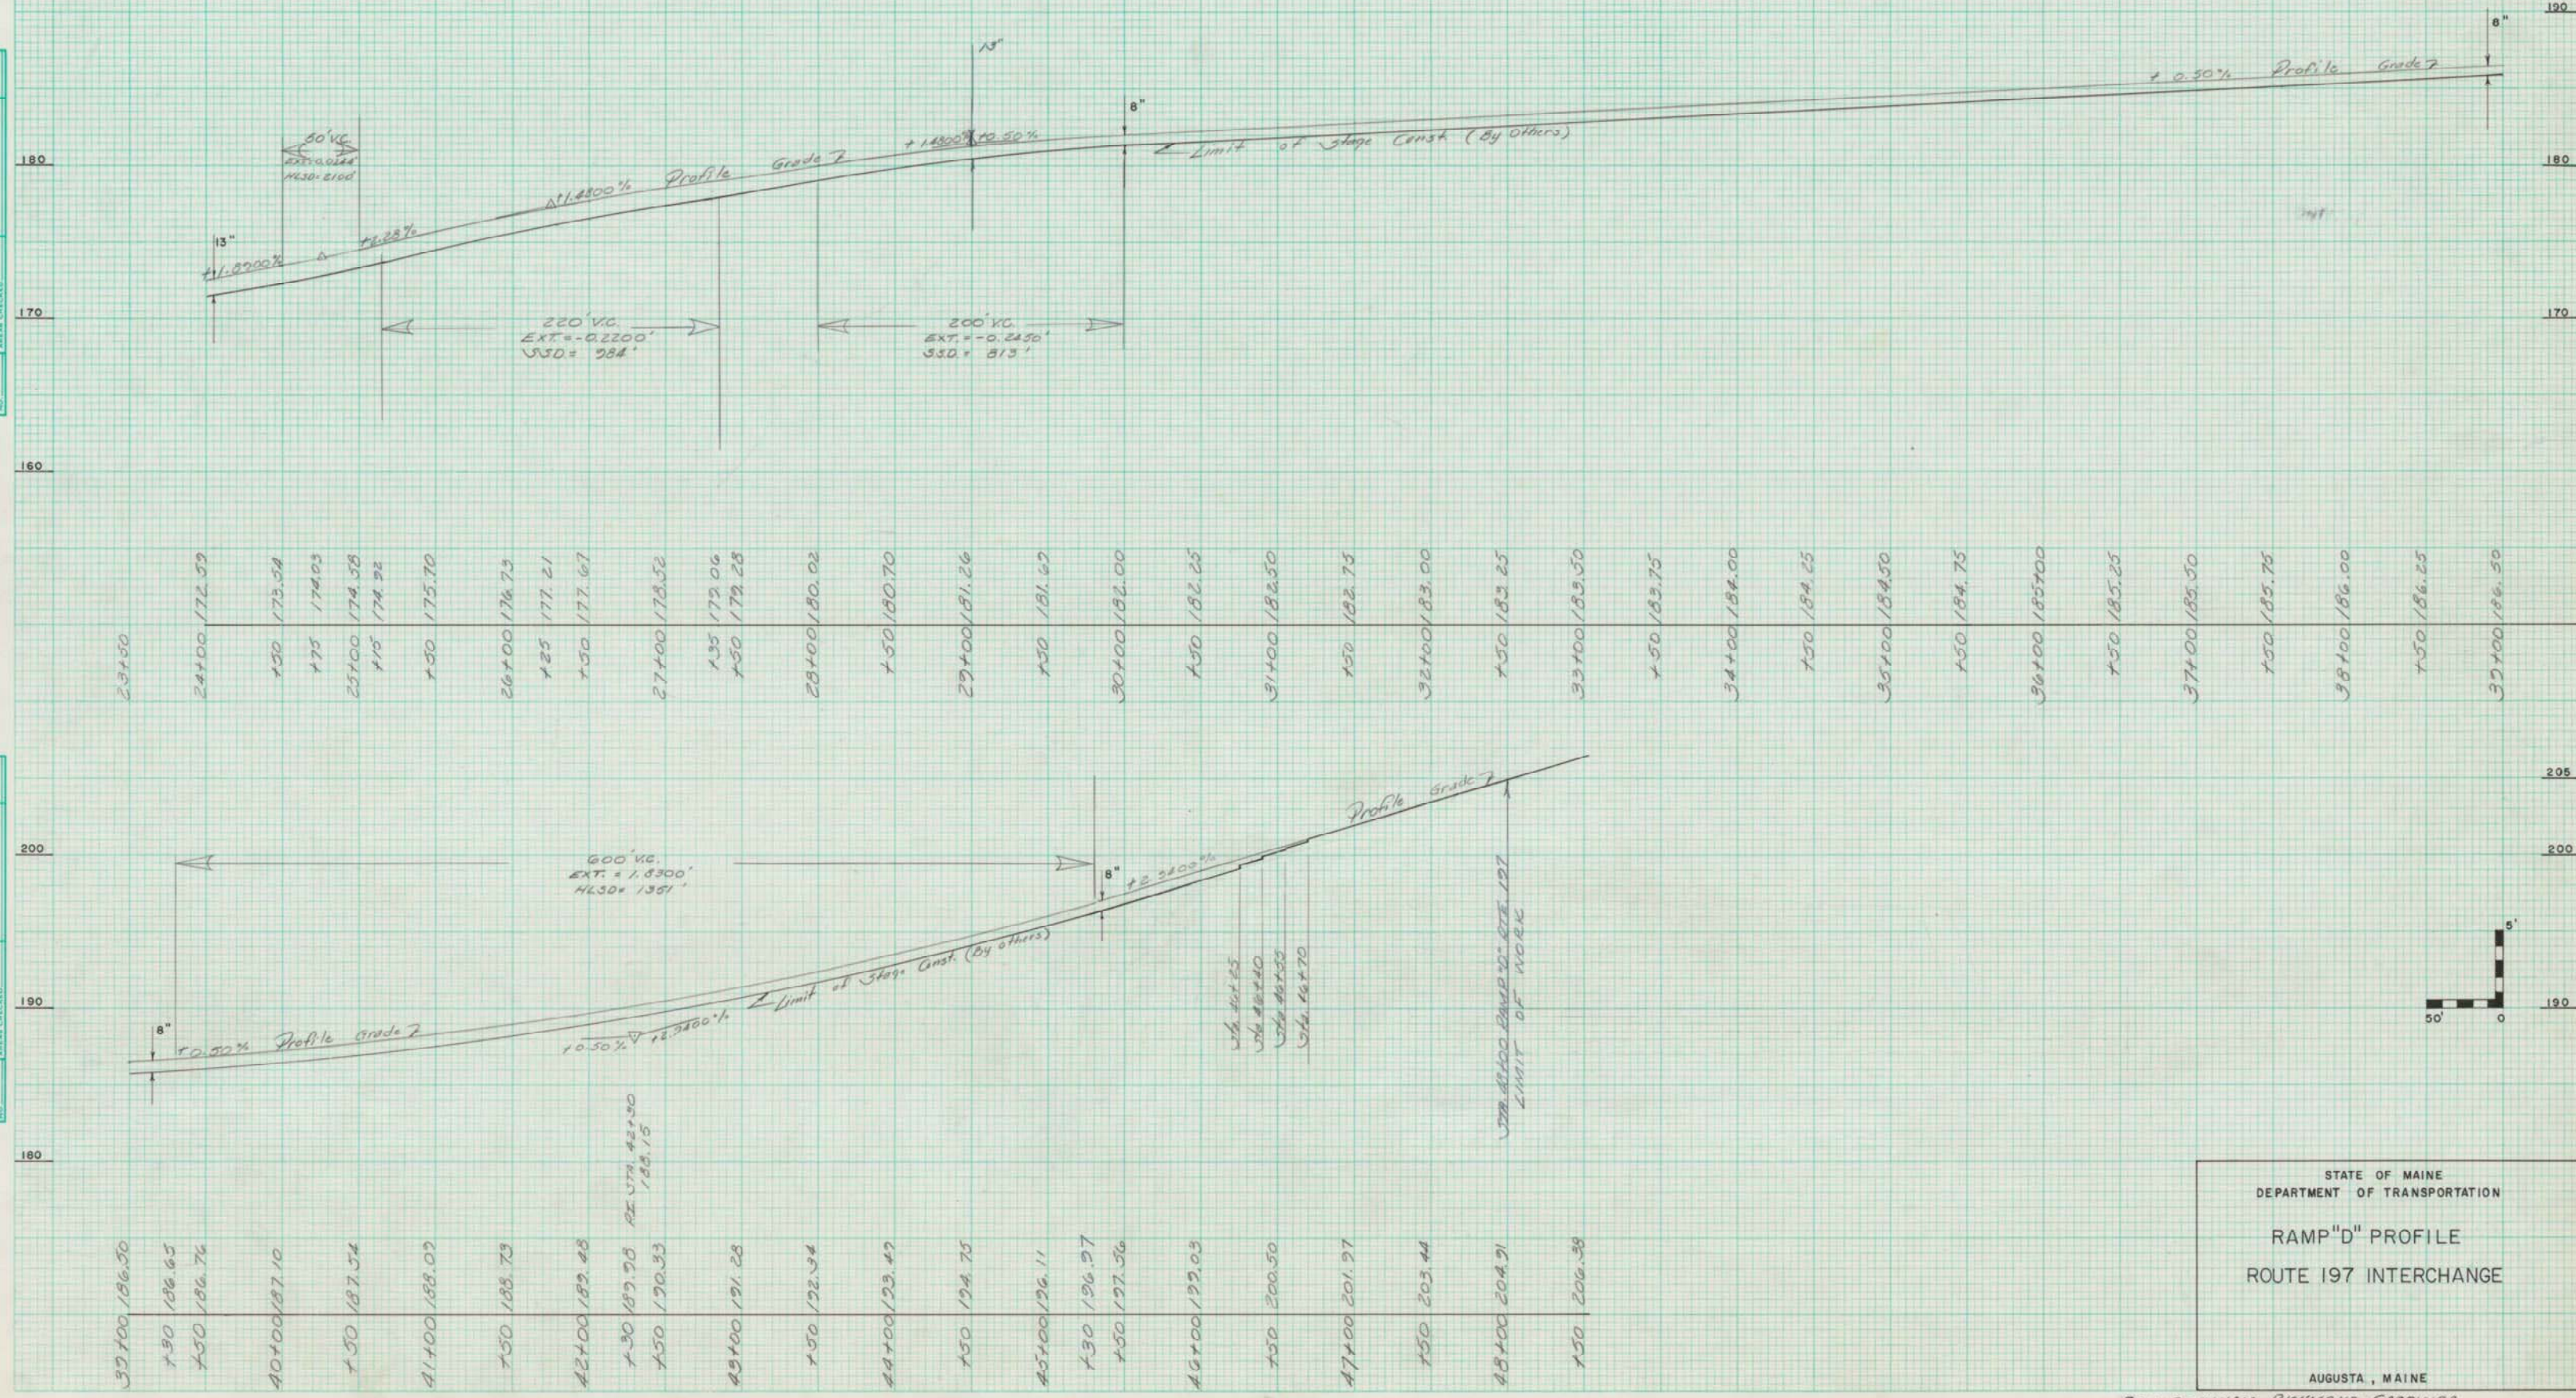

STATE OF MAINE
DEPARTMENT OF TRANSPORTATION

RAMP "D" PROFILE
ROUTE 197 INTERCHANGE

AUGUSTA, MAINE