

S.B. Sta. 471+53 S.B. Lt. Extended Existing 24" RCP With 24"x20' RCP Class III Removed Existing Concrete Headwall Rip Rap End Treatment

S.B. Sta. 477+03 Lt. Extended Existing 42" RCP With 42"x36' RCP Class III Removed Existing Concrete Headwall Rip Rap End Treatment

S.B. Sta. 485+68 Lt. (Skewed Lt. Bk. 18°44') Removed Existing 24" ACCMP, Replaced & Extended With 24"x60' RCP Class III

W.B. Sta. 480+61 Lt. Removed Existing 24" ACCMP To C.B. Installed 24"x28' BCCMP To Existing C.B.

S.B. Sta. 480+85 Lt. Altered Existing Catch Basin To Manhole. Raised Existing C.B. and Installed Type "D" Manhole Cover

W.B. Sta. 487+97 Lt. (Skewed Back Rt. 17°30') Removed Existing Concrete Headwall & One Section of RCP Culvert, Extended Existing 60" RCP With 60"x64' RCP Class III Rip Rap End Treatment

S.B. Sta. 493+53 Lt. Removed Existing Concrete Headwall & First Section of Existing 36" RCP Extended Existing 36" RCP With 36"x60' RCP Class II Rip Rap End Treatment

W.B. Sta. 494+15 to 494+50 Lt. Installed 6"x50' U.D. Outlet

W.B. Sta. 494+50 to 497+50 Lt. Installed 6"x300' U.D. Type B One Elbow @ 494+50


W.B. Sta. 485+21 to 485+62 Installed 6"x56' U.D. Outlet

W.B. Sta. 481+12 to 485+21 Lt. Installed 6"x409' U.D. Type B One Elbow @ 485+21



Culverts Constructed 1972

Constructed 1973

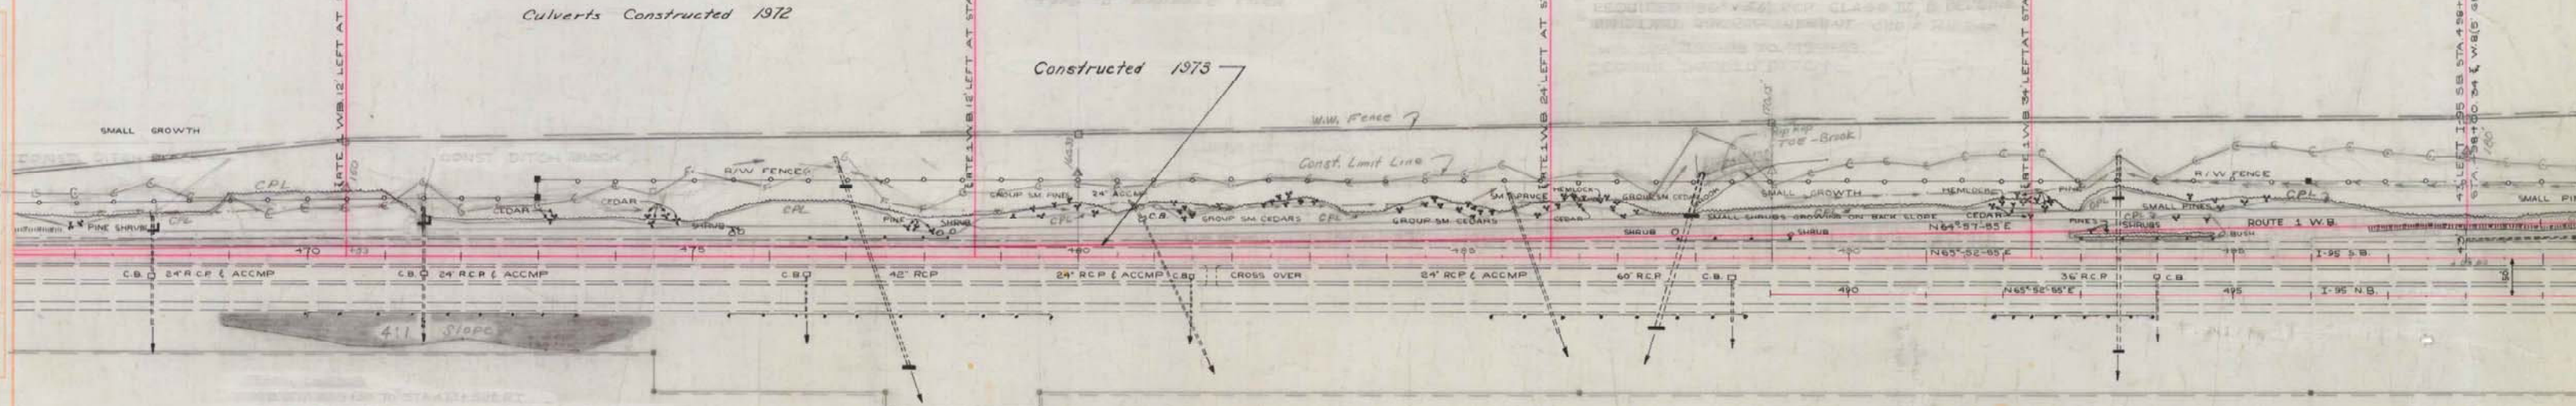

N.B. Sta. 471+50 Rt. Extended Existing 24" ACCMP With 24"x12' BCCMP

Woven Wire Fence & Metal Post Installed 6" Inside RIW
W.B. Lt. Sta. 463+03 to 470+53
W.B. Lt. Sta. 470+53 to 498+03

Right of Way Monuments

S.B. Sta. 470+53 150' Lt.
S.B. Sta. 480+00 160' Lt.
S.B. Sta. 489+00 170' Lt.
S.B. Sta. 498+03 180' Lt.

Survey Monuments

S.B. Sta. 470+53 Left
S.B. Sta. 480+00 Left
S.B. Sta. 489+00 Left

