




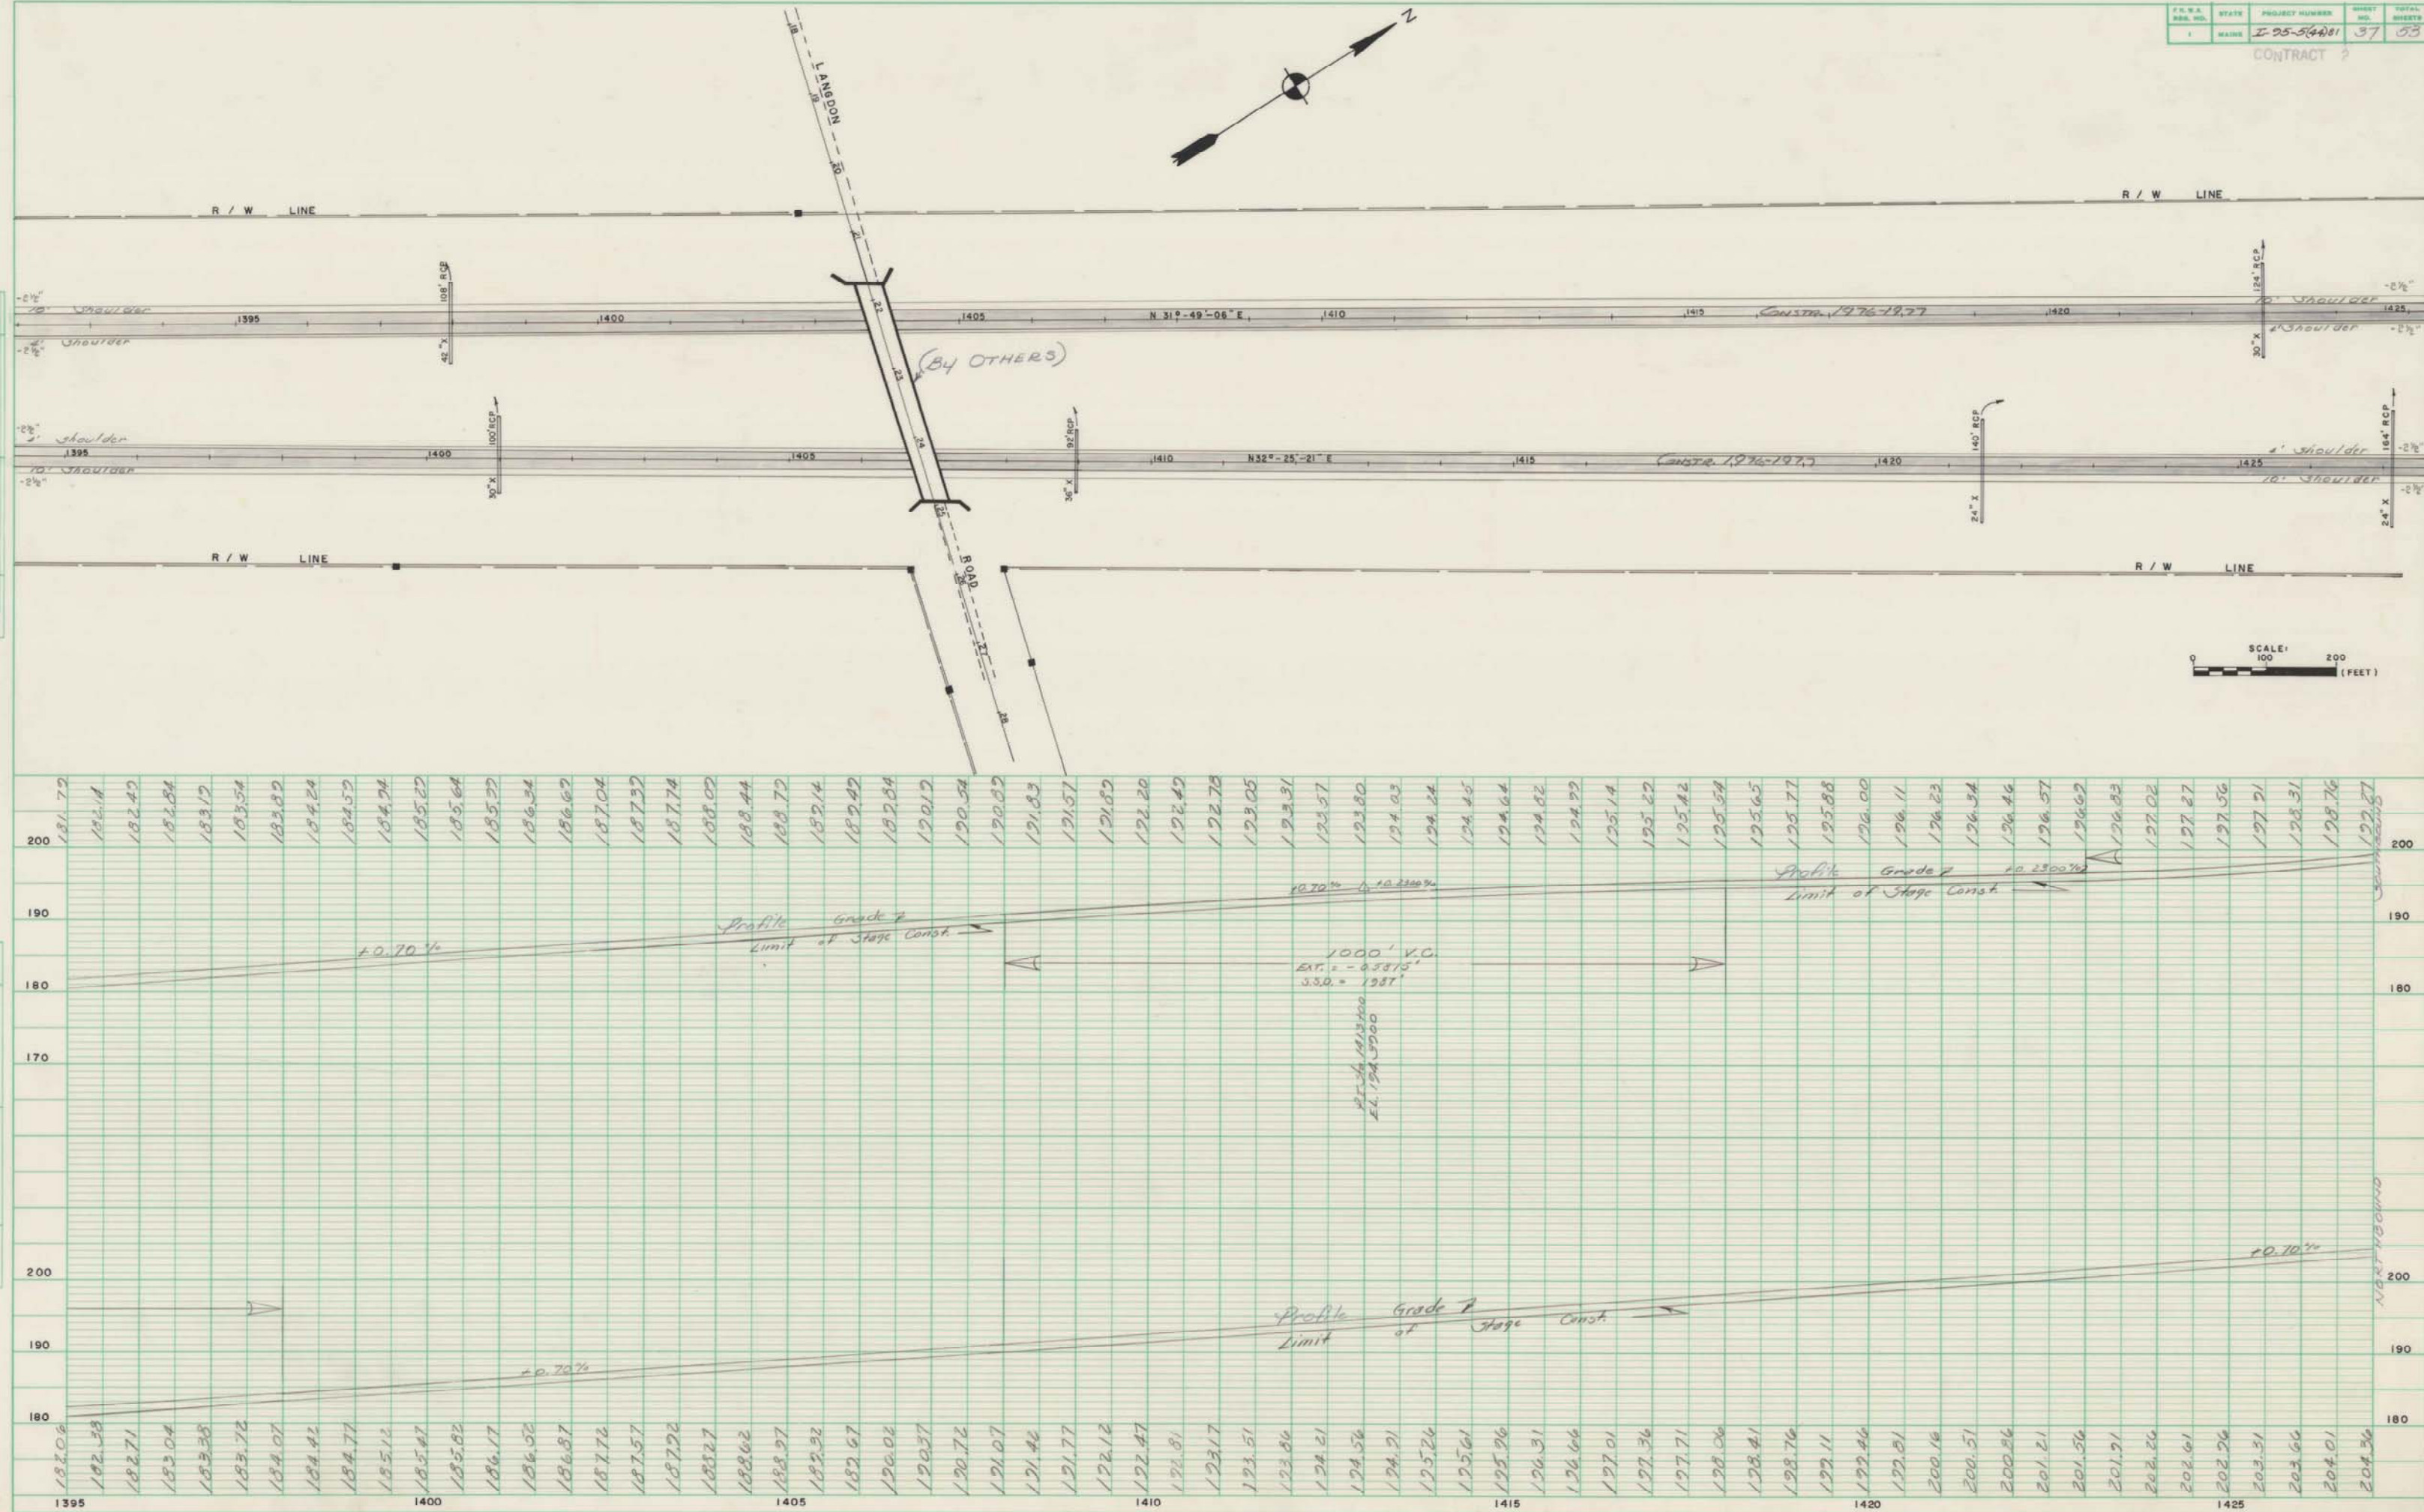

SCALE: 1" = 100' (FEET)