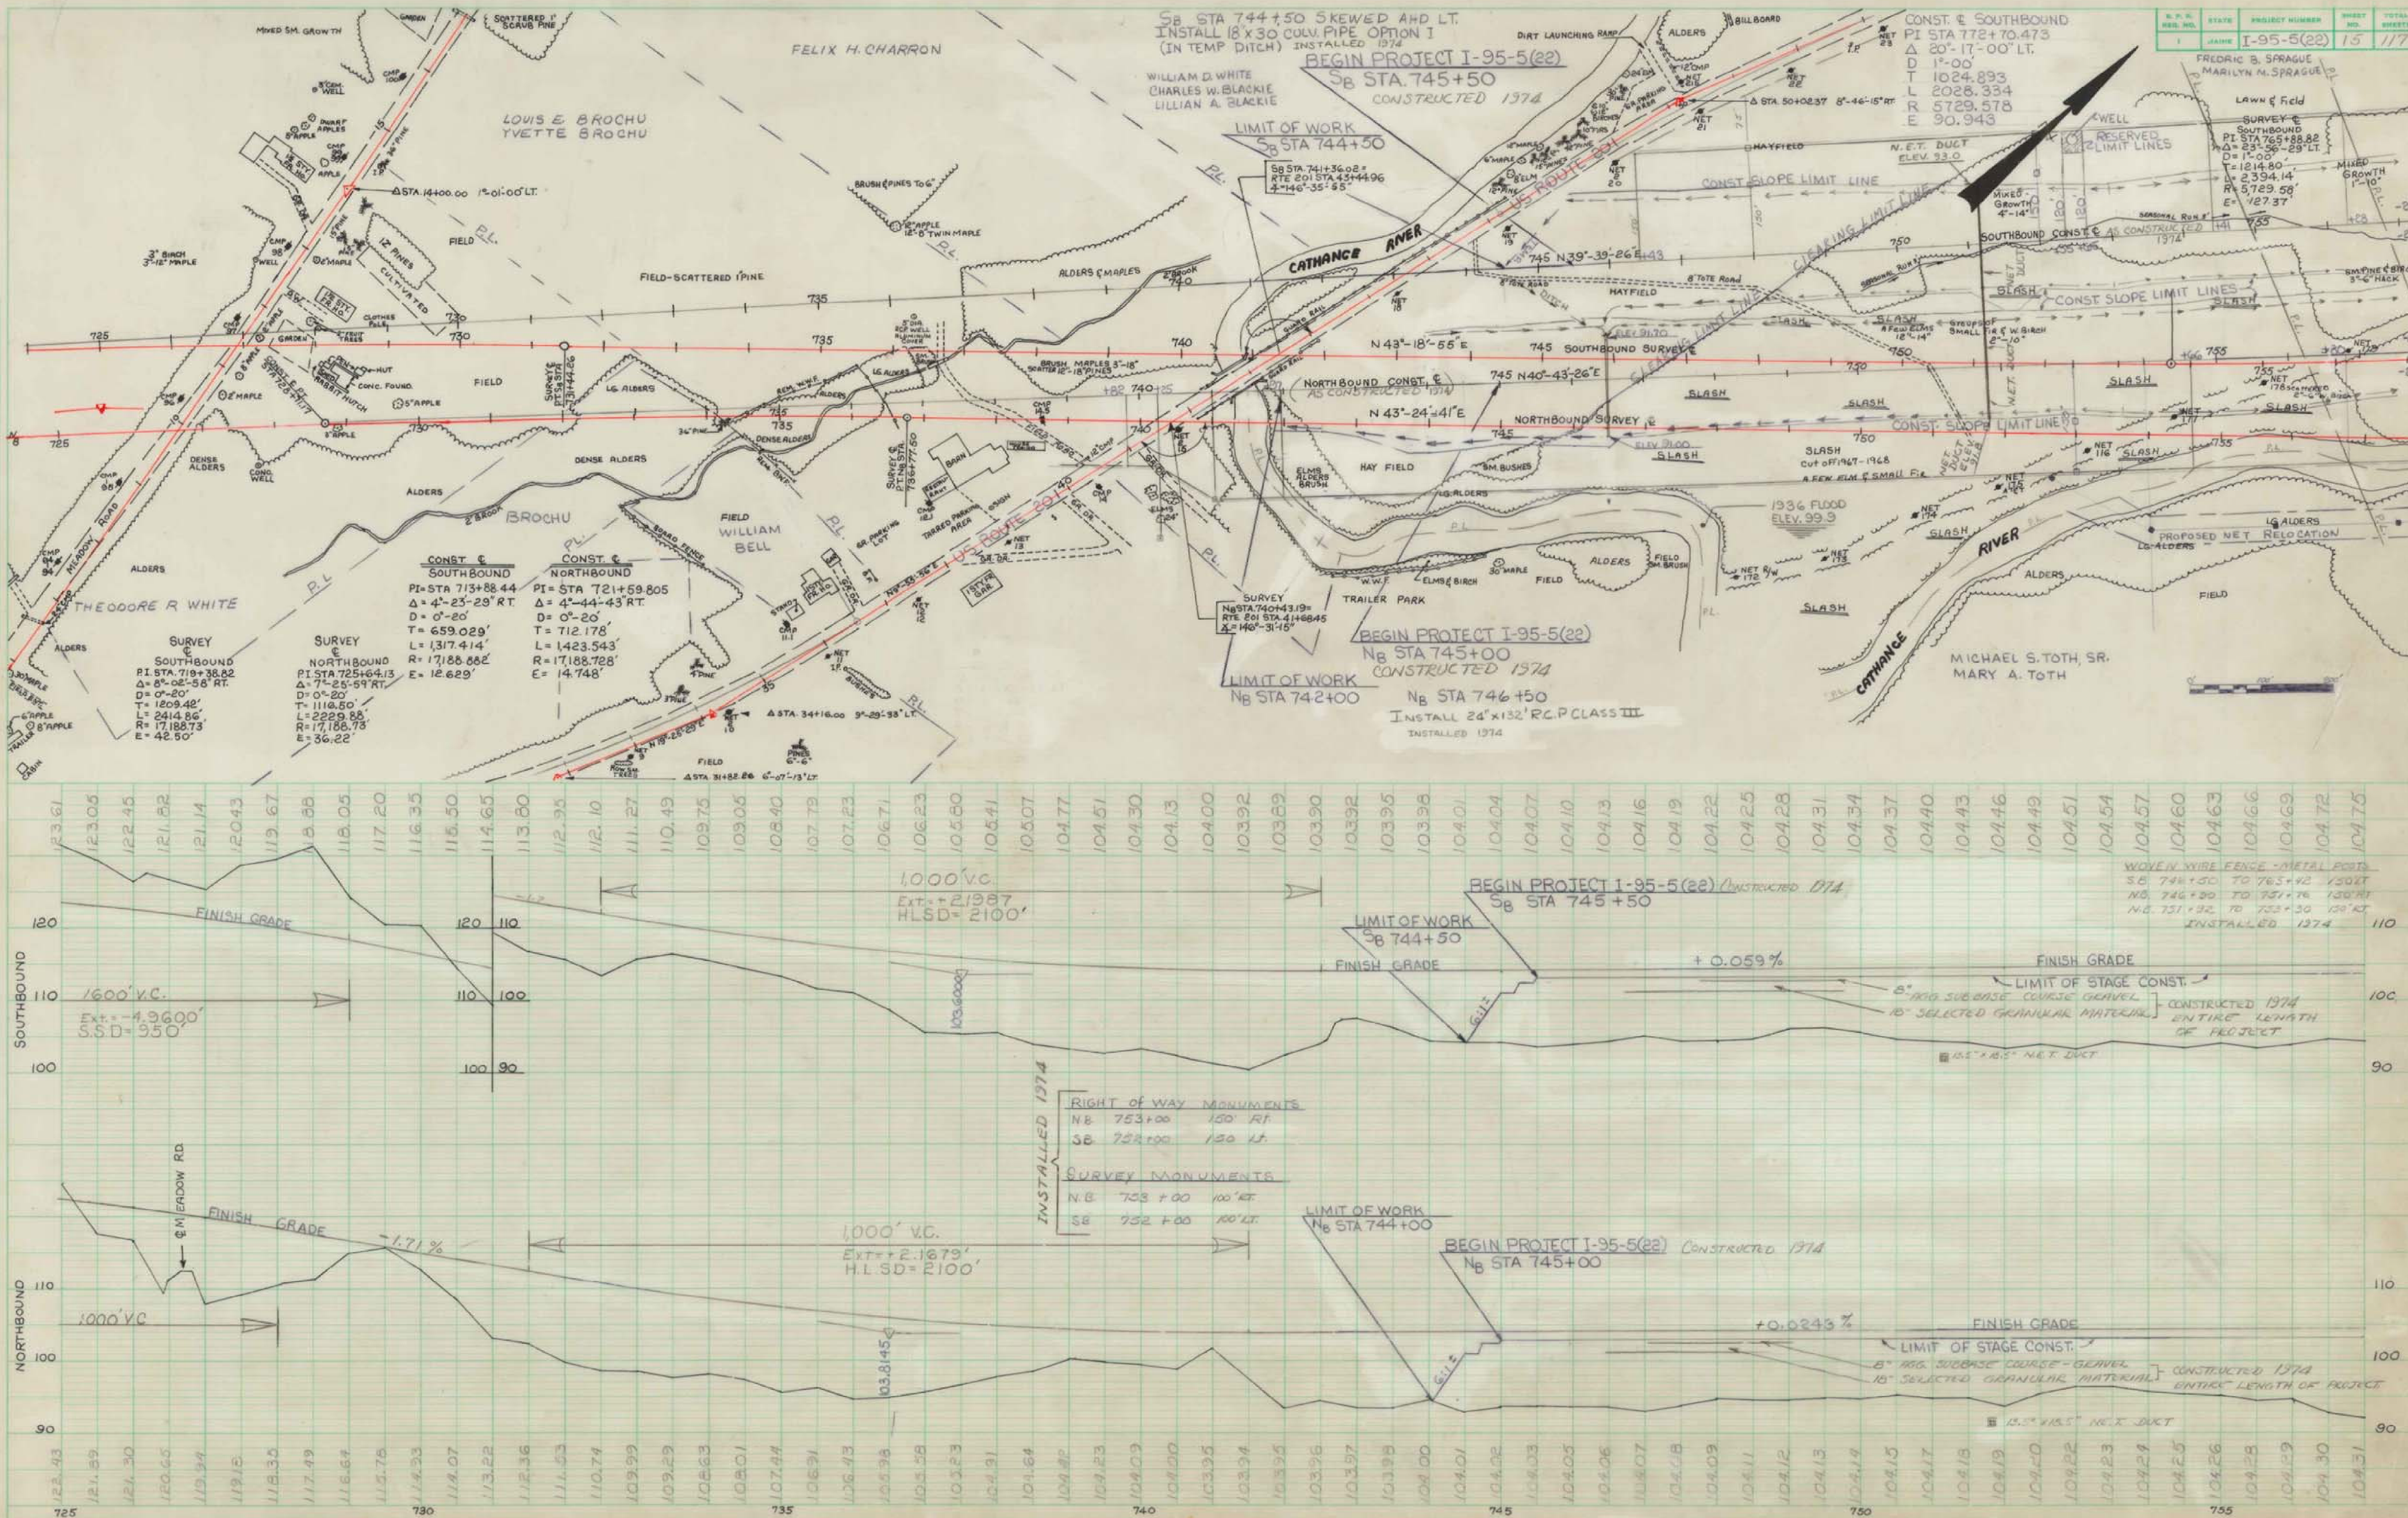

REVISED AS BUILT
G Clark

TOPSHAM