F.H.W.A. REG. NO.	STATE	PROJECT NUMBER	SHEET NO.	TOTAL SHEETS
1	MAINE	I-95-5 (37)	34	155

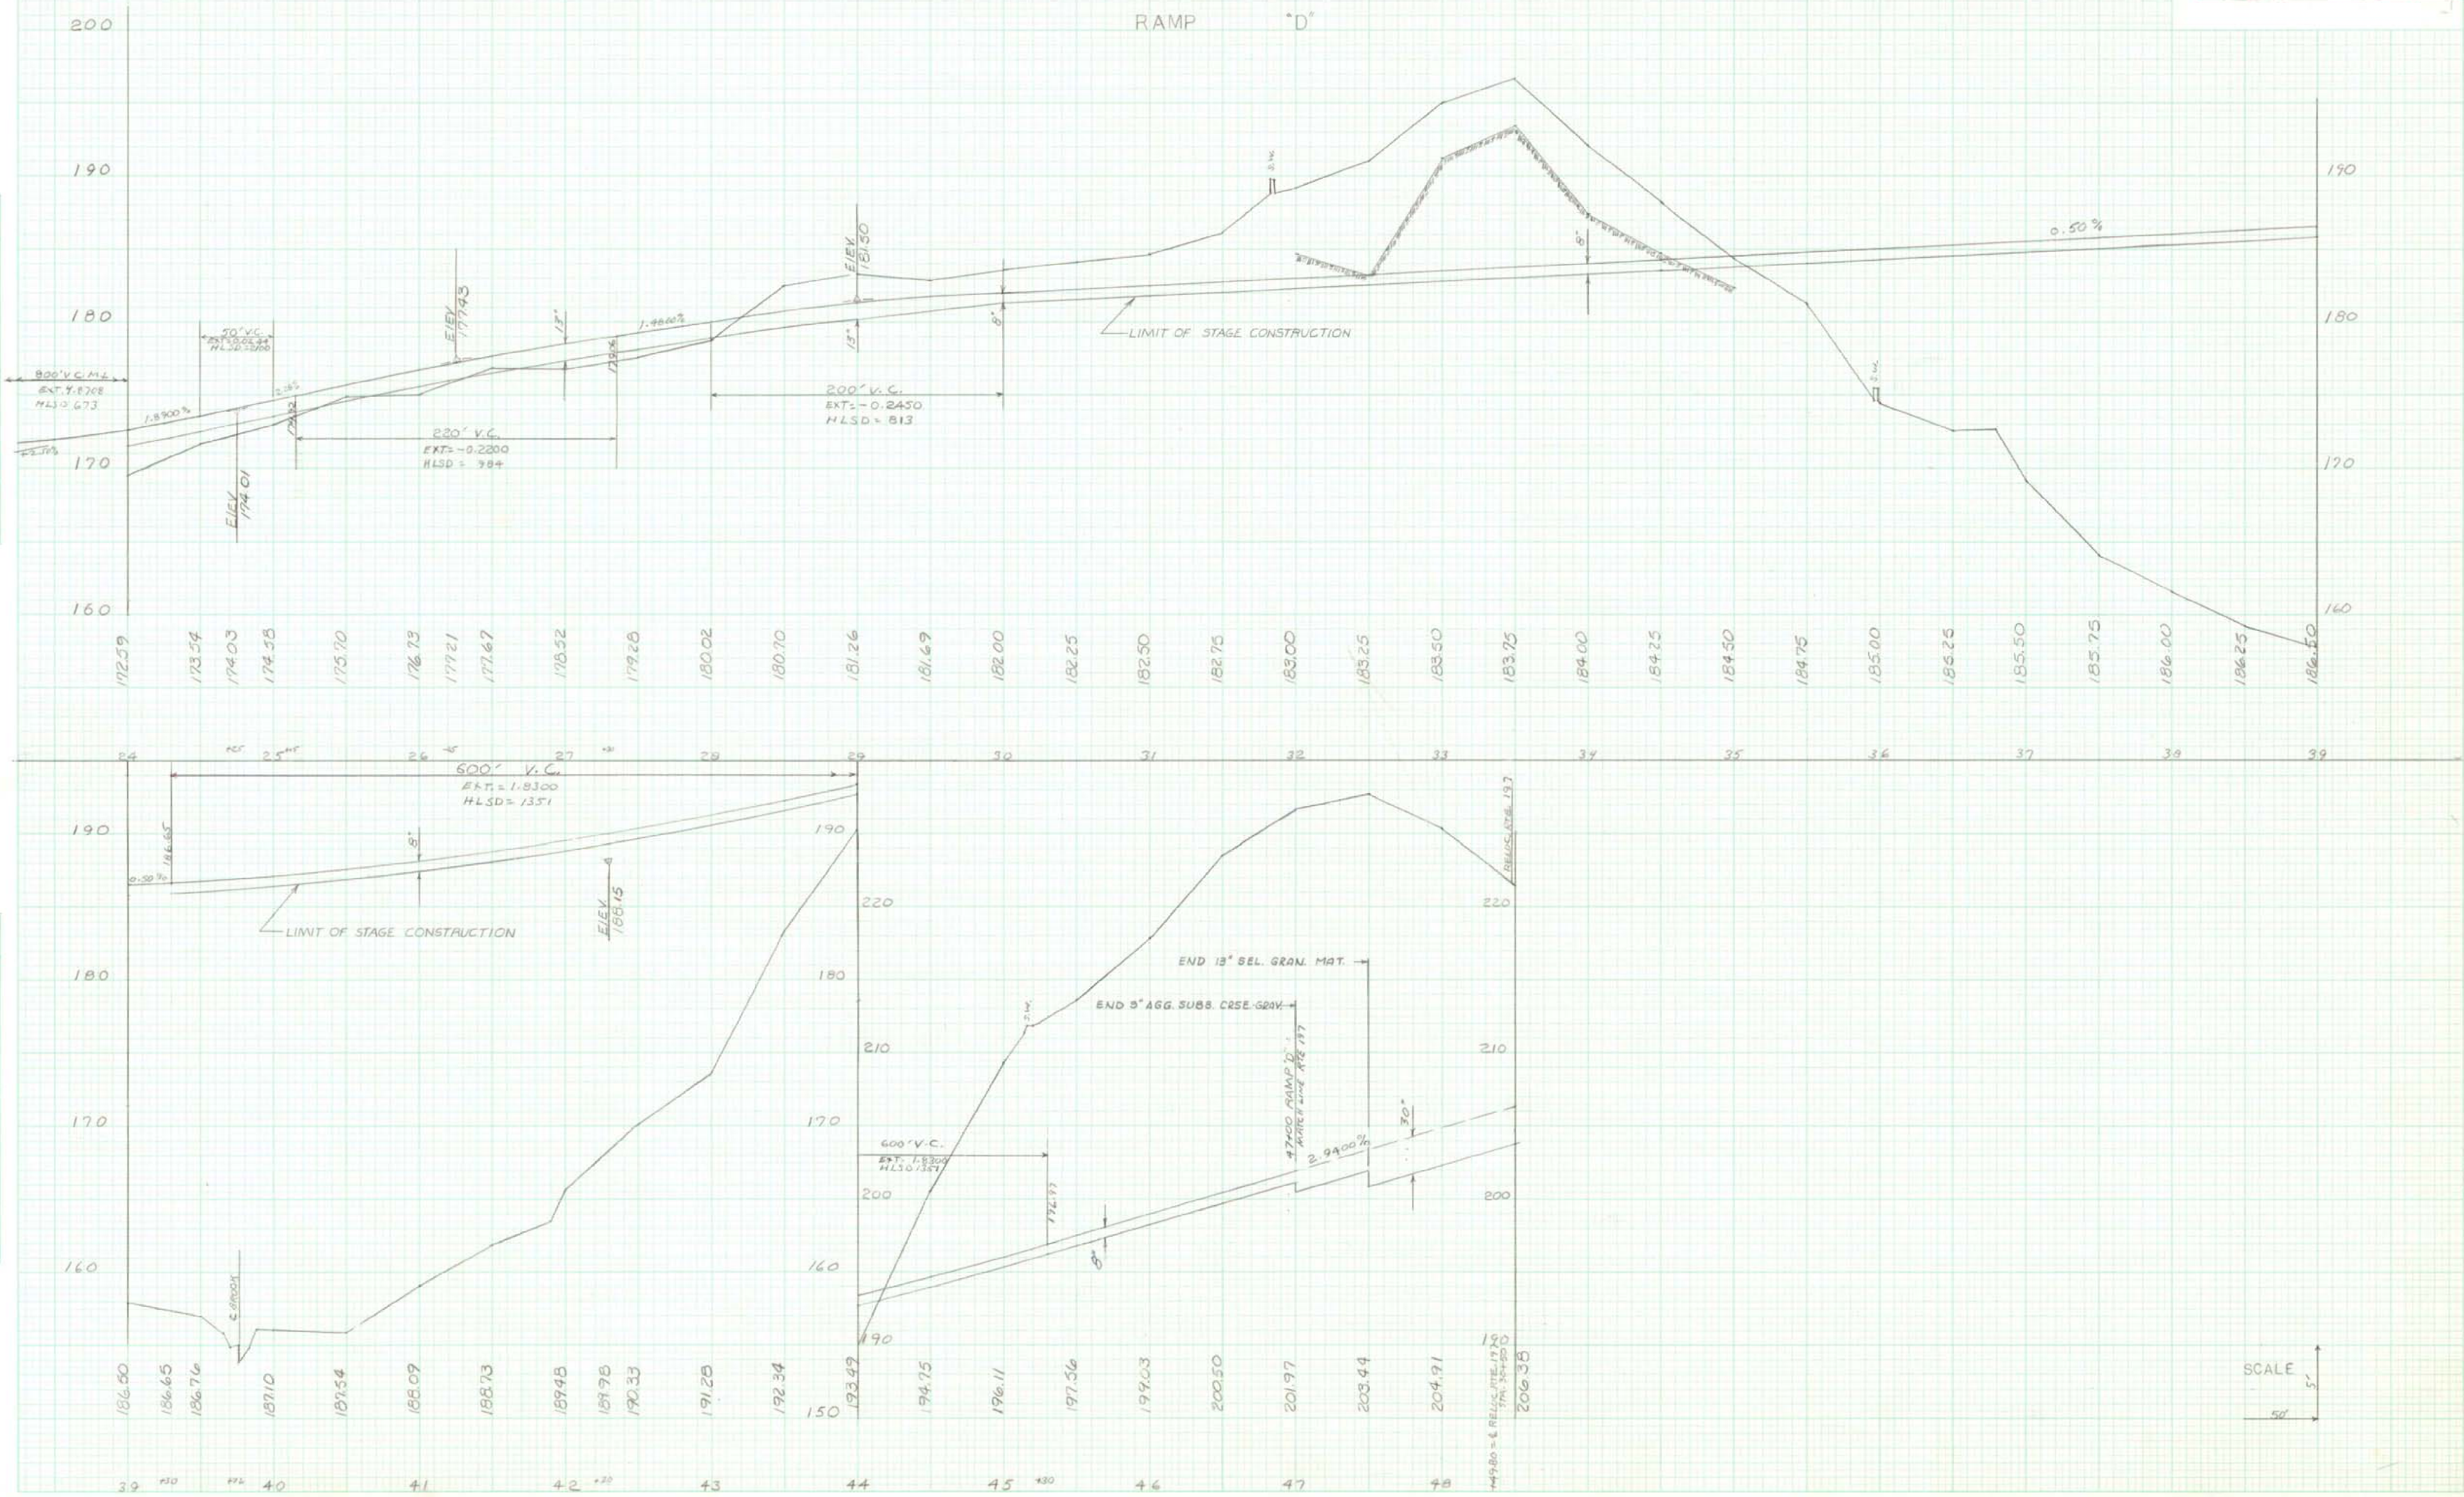

FINAL SURVEY — SURVEYED / PLOTTED / TEMPLATE / AREAS / AREAS CHECKED — BY — DATE — NOTE BOOK NO.

ORIGINAL SURVEY — SURVEYED: R. WELLS & CREW, 9-25-71 — PLOTTED: L. ALLEN, 11-6-73 — TEMPLATE / AREAS / AREAS CHECKED — NOTE BOOK NO. 95 4221

BOWDOINHAM - RICHMOND 95-5(37) RTE. 197 INTERCHANGE