


CONTRACT 2

PLAN
DATE 11/1/74
BY [Signature]
CHECKED [Signature]
NOTED [Signature]
NOTE BOOK [Signature]
NO.

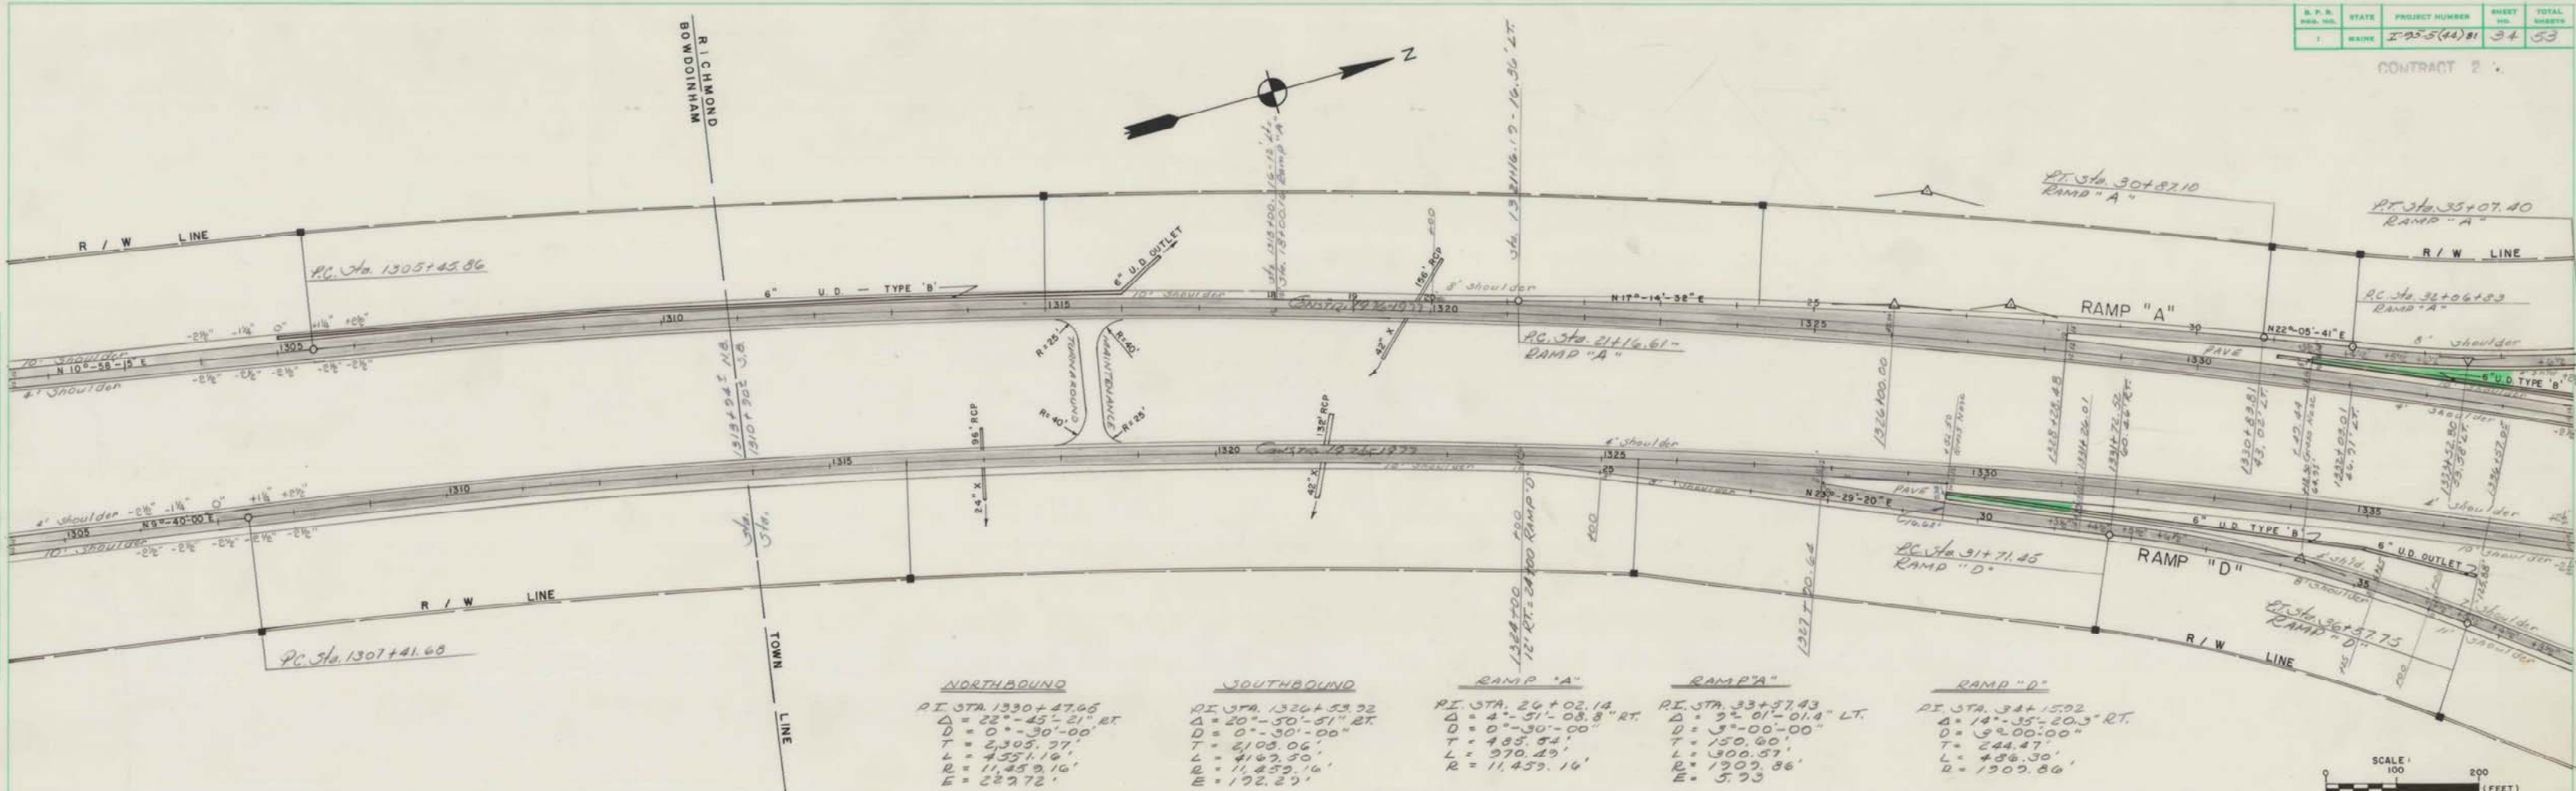

PROFILE
DATE 11/1/74
BY [Signature]
CHECKED [Signature]
NOTED [Signature]
NOTE BOOK [Signature]
NO.

