F.A.P. REG. NO.	STATE	PROJECT NUMBER	SHEET NO.	TOTAL SHEETS
I	MAINE	I-95-5(36)	33	175

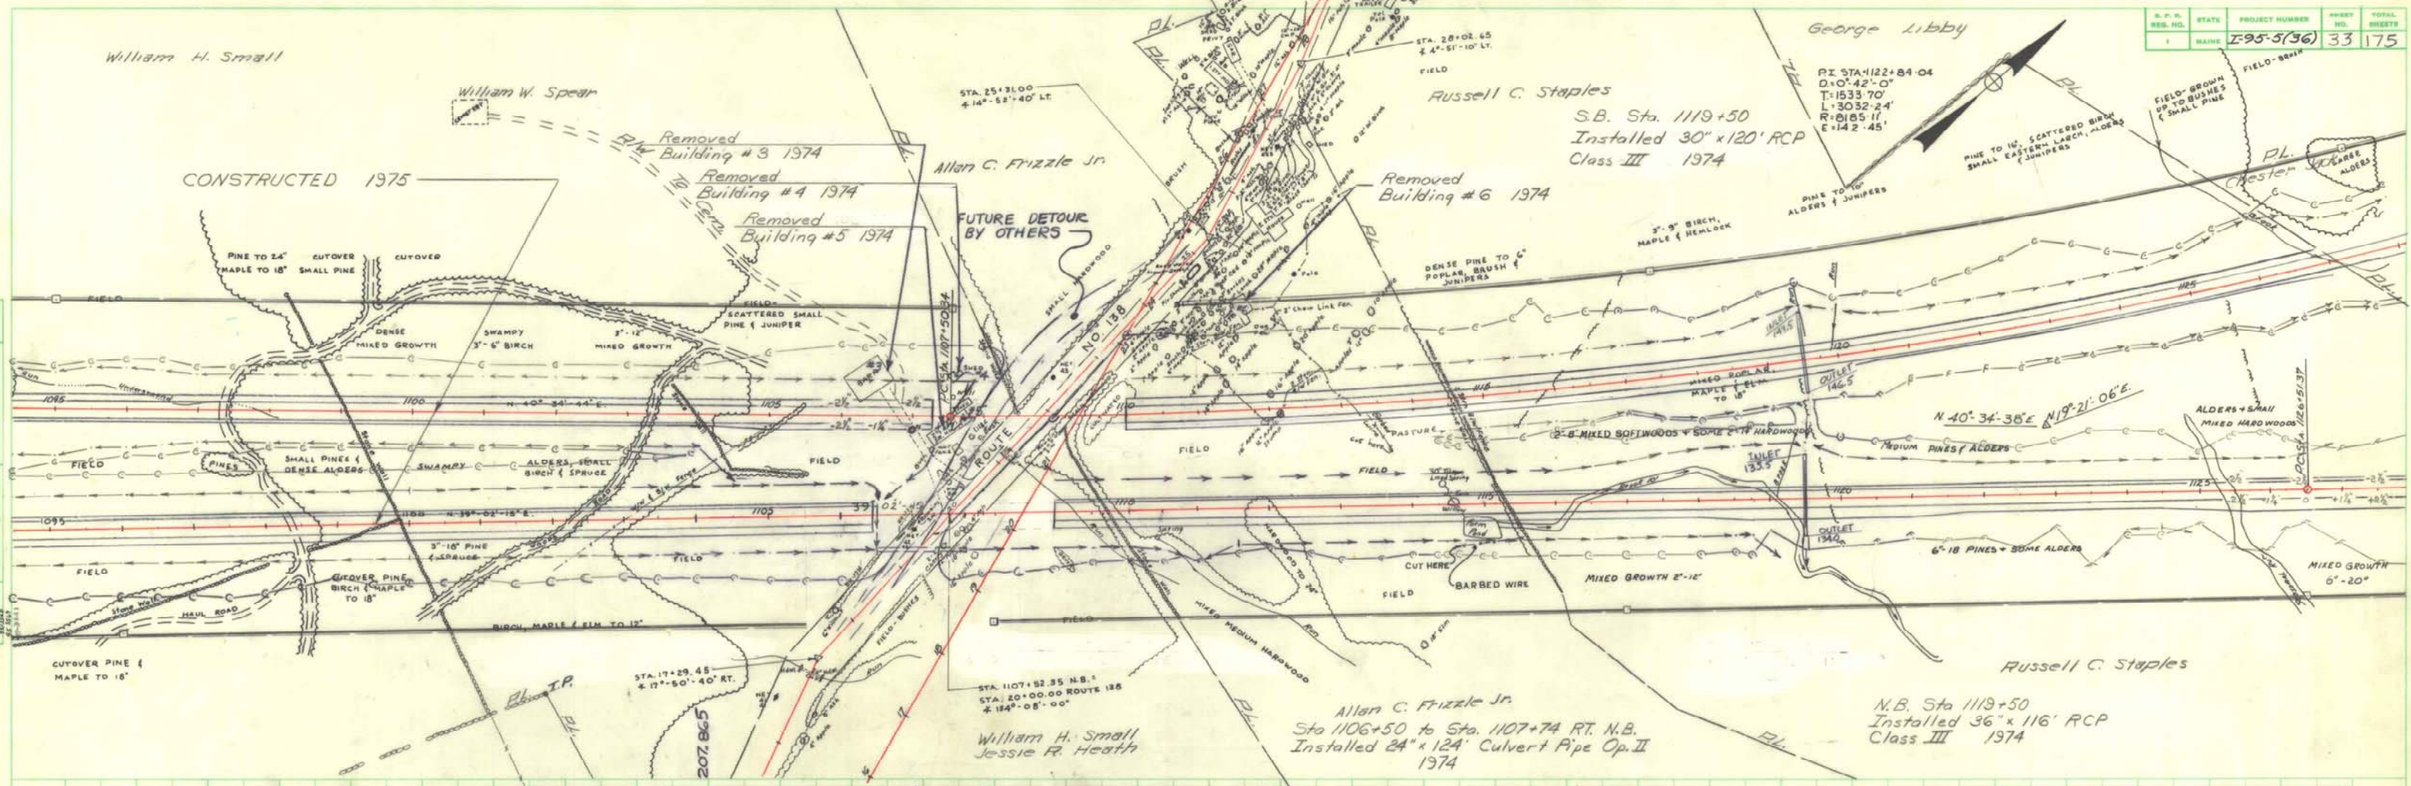

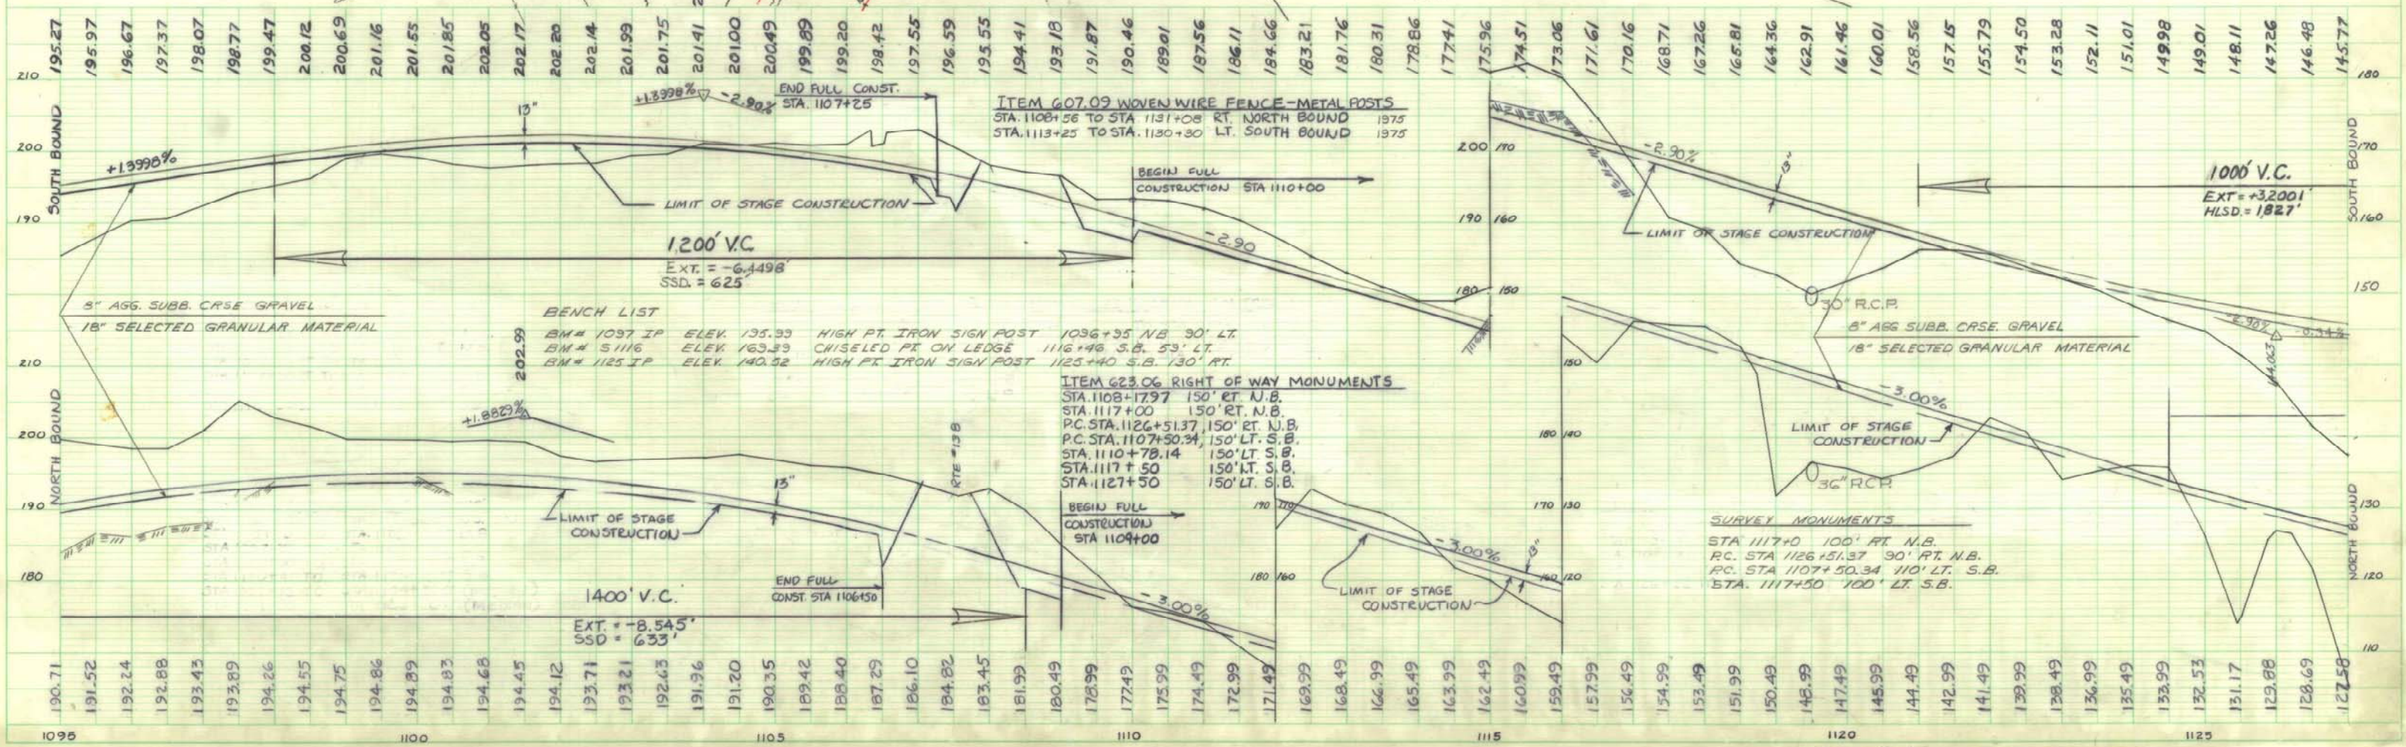

I-95-5(36) BOWDOINHAM