S.P.R. REG. NO.	STATE	PROJECT NUMBER	SHEET NO.	TOTAL SHEETS
1	MAINE	I-95-5(32)	19	96

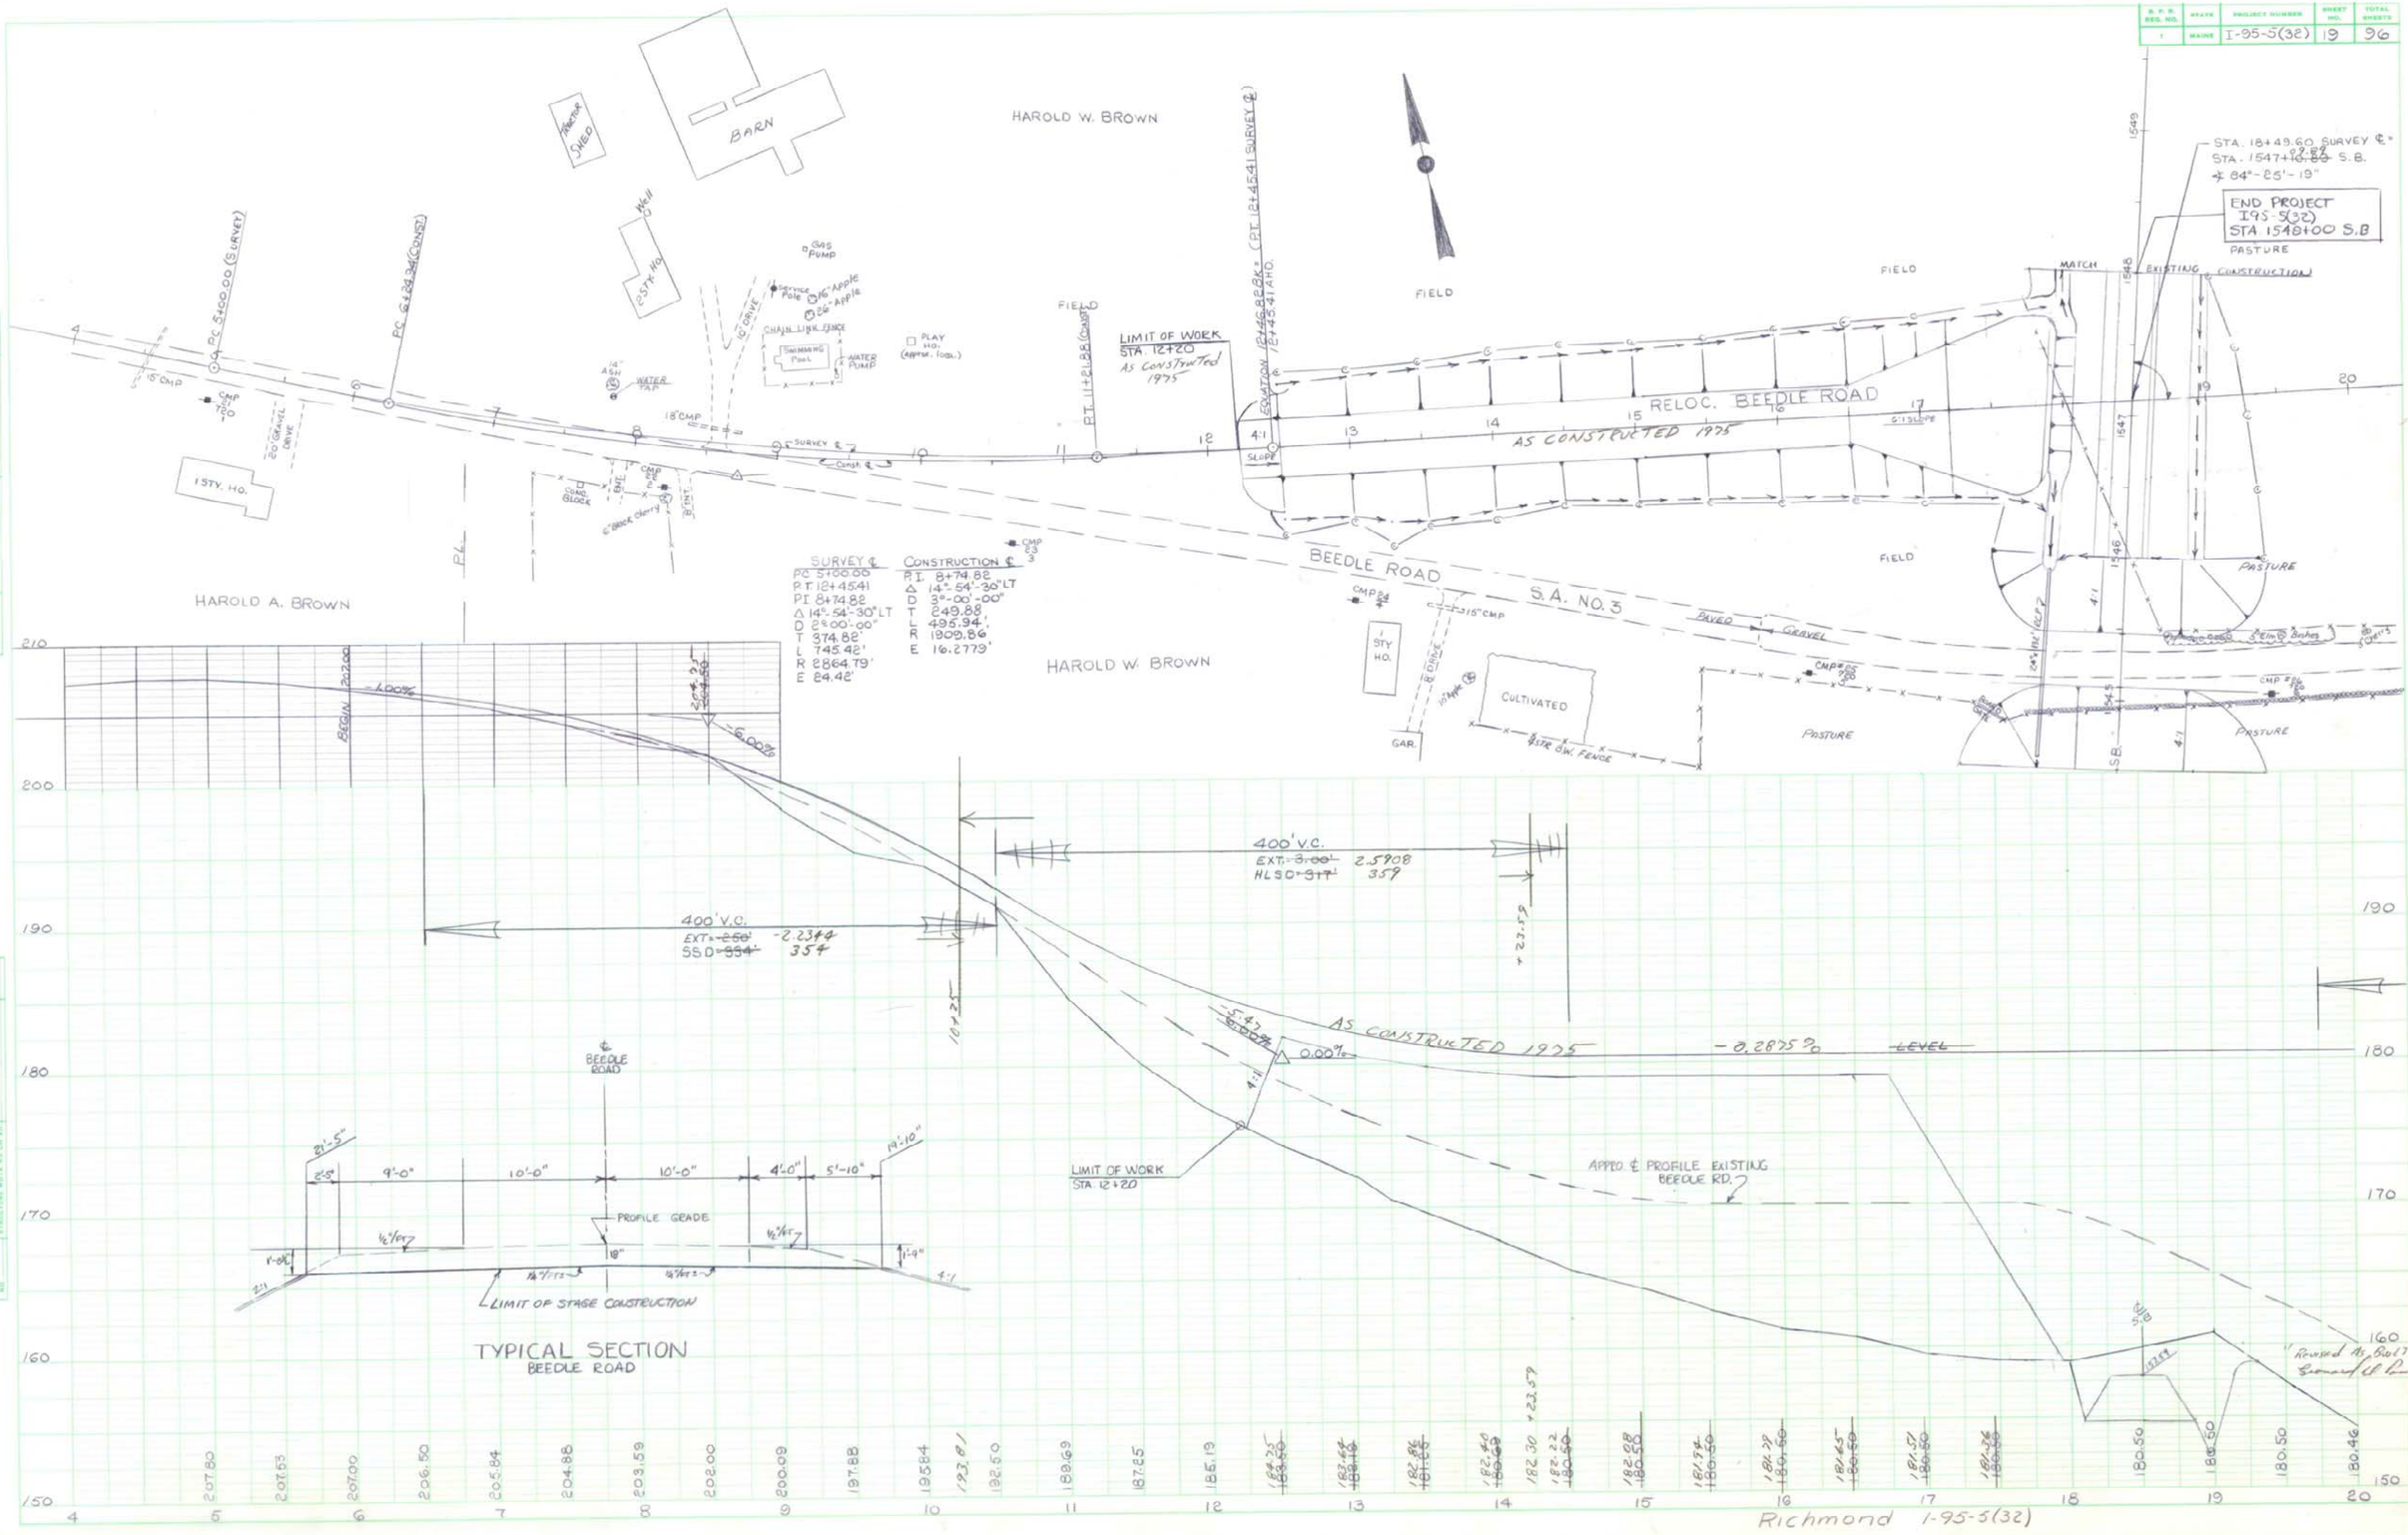

Richmond I-95-5(32)

PLAN — SURVEYED: PLOTTED: DRAWN: CHECKED: R.O.W.: ACCEPTED: STATE ENGINEER: AS BUILT MAP CHECKED: NOTE BOOK NO. DATE BY

PROFILE — SURVEYED: PLOTTED: DRAWN: CHECKED: R.O.W.: ACCEPTED: STATE ENGINEER: AS BUILT MAP CHECKED: NOTE BOOK NO. DATE BY