B. P. R. REG. NO.	STATE	PROJECT NUMBER	SHEET NO.	TOTAL SHEETS
1	MAINE	I-95-3(44) 81	32	53

CONTRACT 2

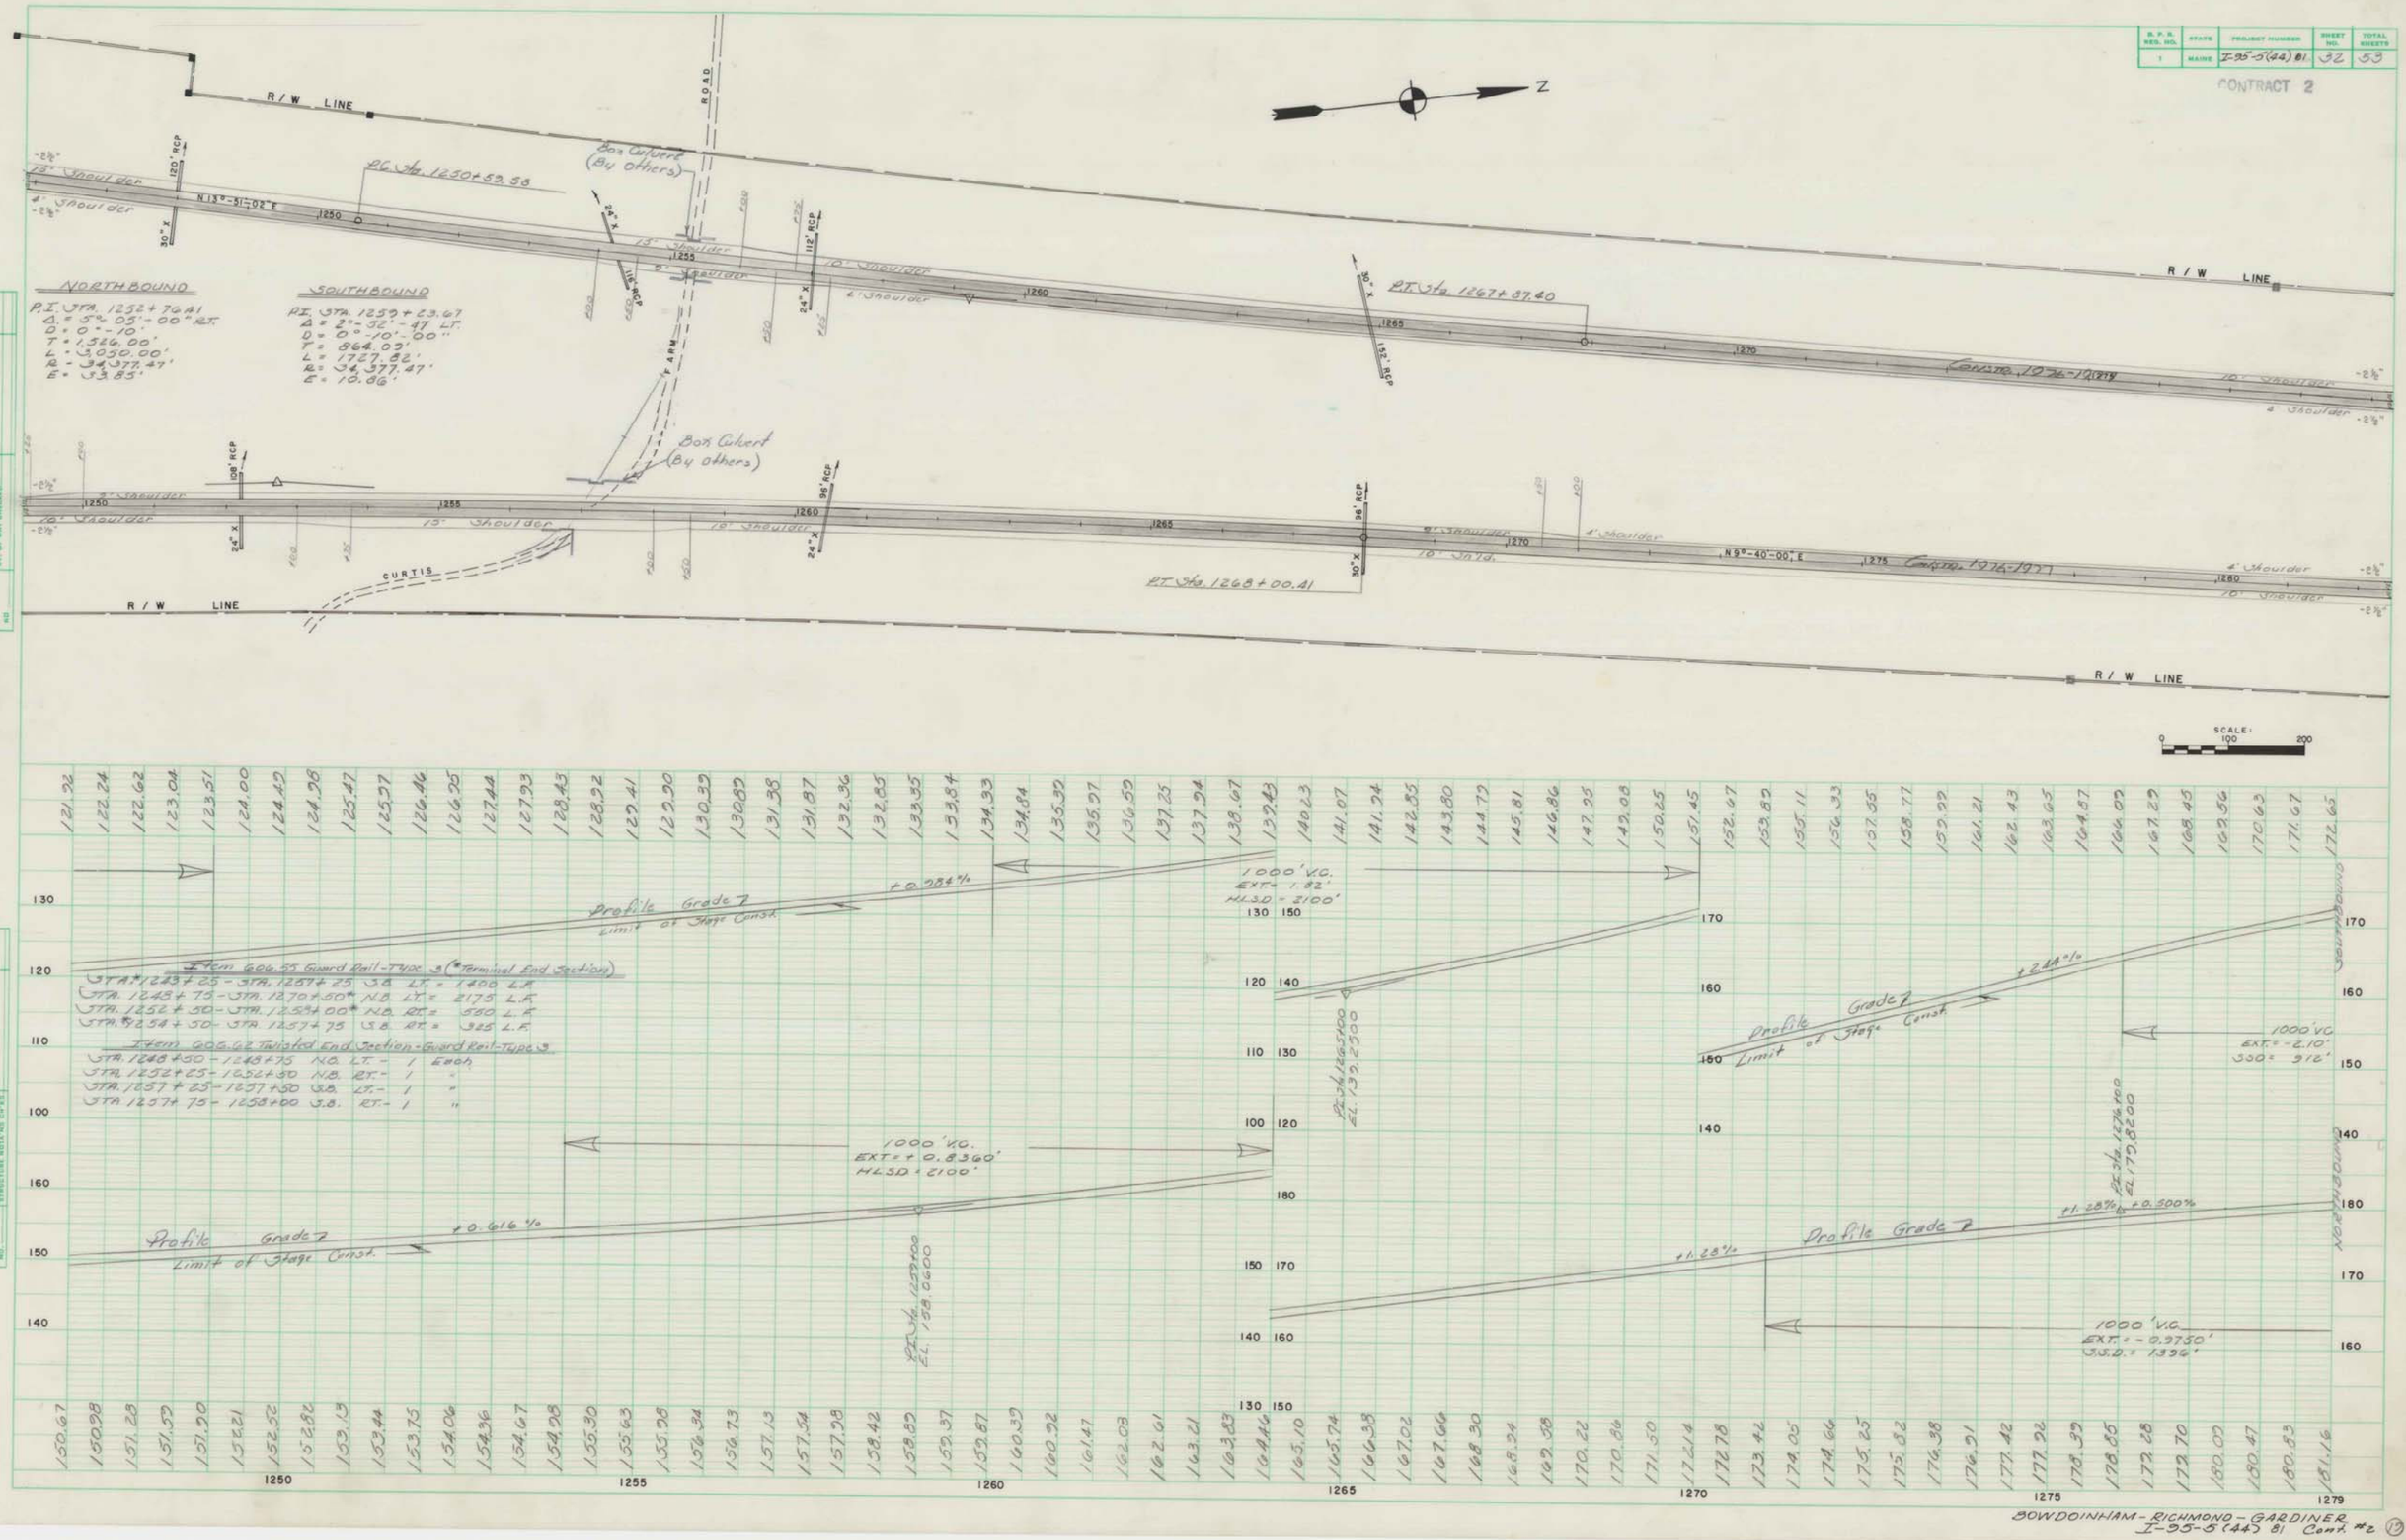

PLAN — SURVEYED, PLOTTED, ALIGNMENT CHECKED, PL. & P. CHK. CHECKED, NOTE BOOK, NO.

PROFILE — SURVEYED, PLOTTED, GRADES CHECKED, B. MS., NOTES, STRUCTURE NOTE NO. CH'KD.

BY Tracy DATE 12-3-76

BY Tracy DATE 12-3-76

BOWDOINHAM - RICHMOND - GARDINER
I-95-3(44) 81 Cont. #2