
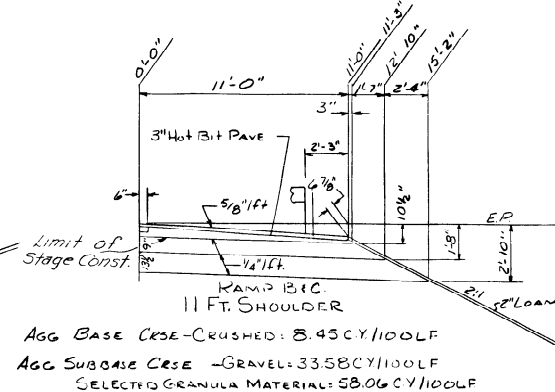
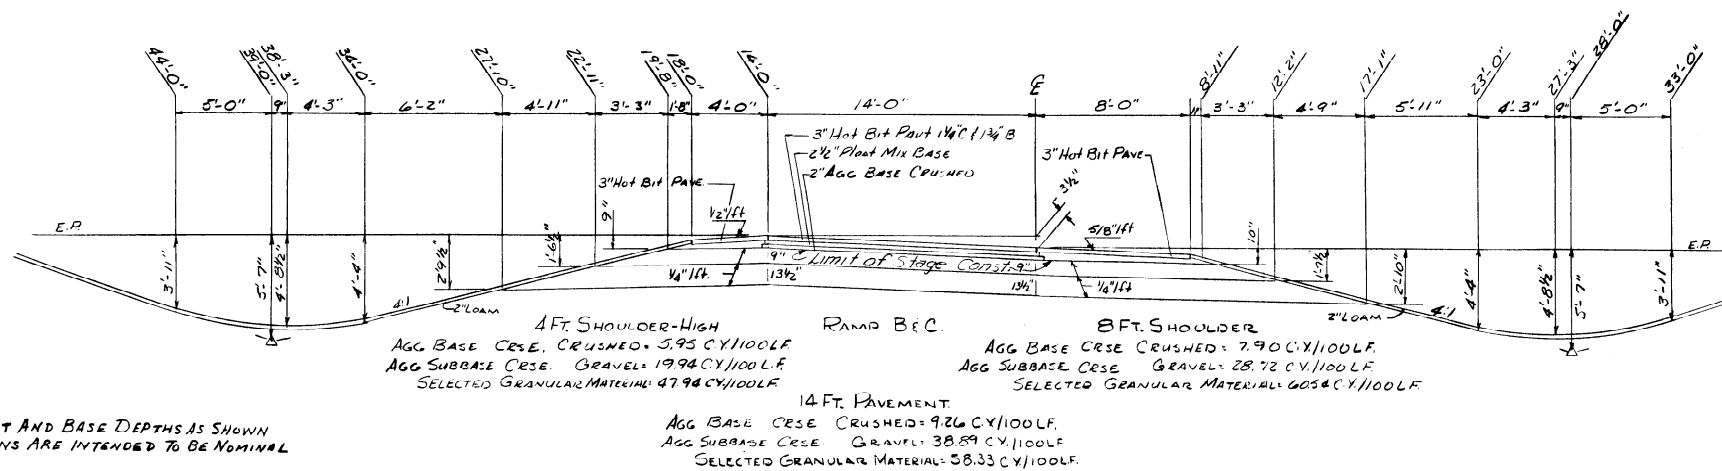
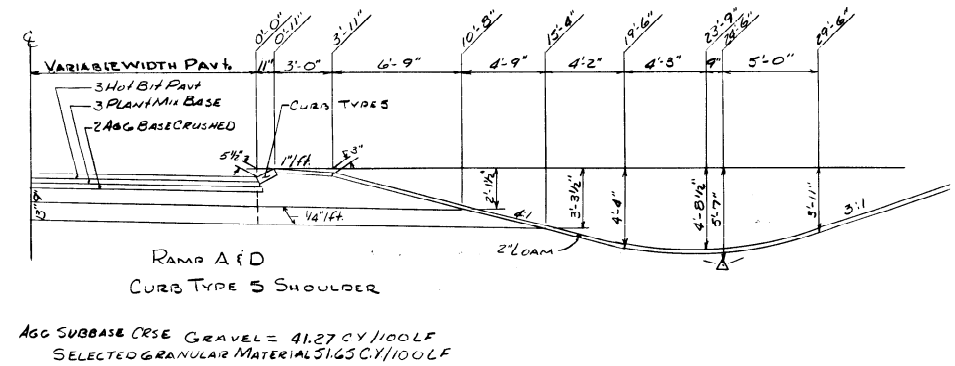
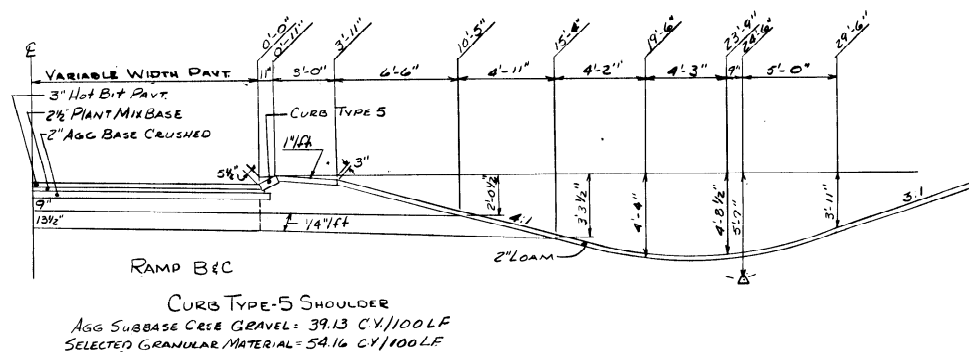
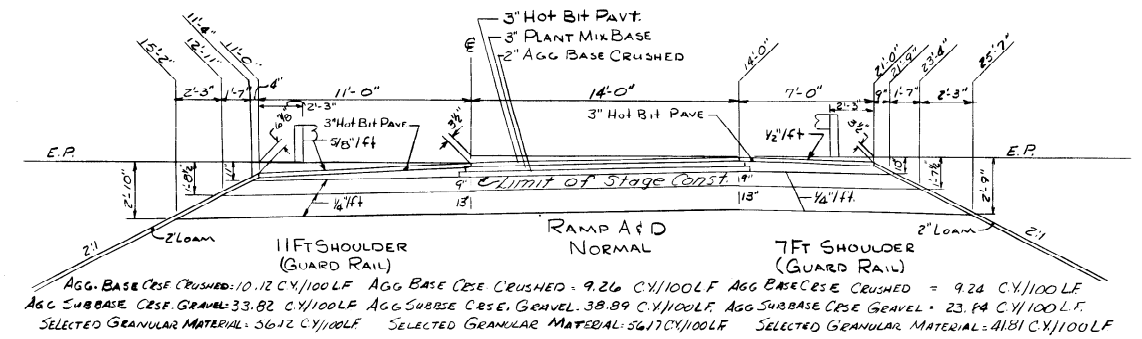


3" HOT BITUMINOUS PAVEMENT *

F.R.W.A. REQ. NO.	STATE	PROJECT NUMBER	SHEET NO.	TOTAL SHEETS
1	MAINE	95-5(31)79	3	219

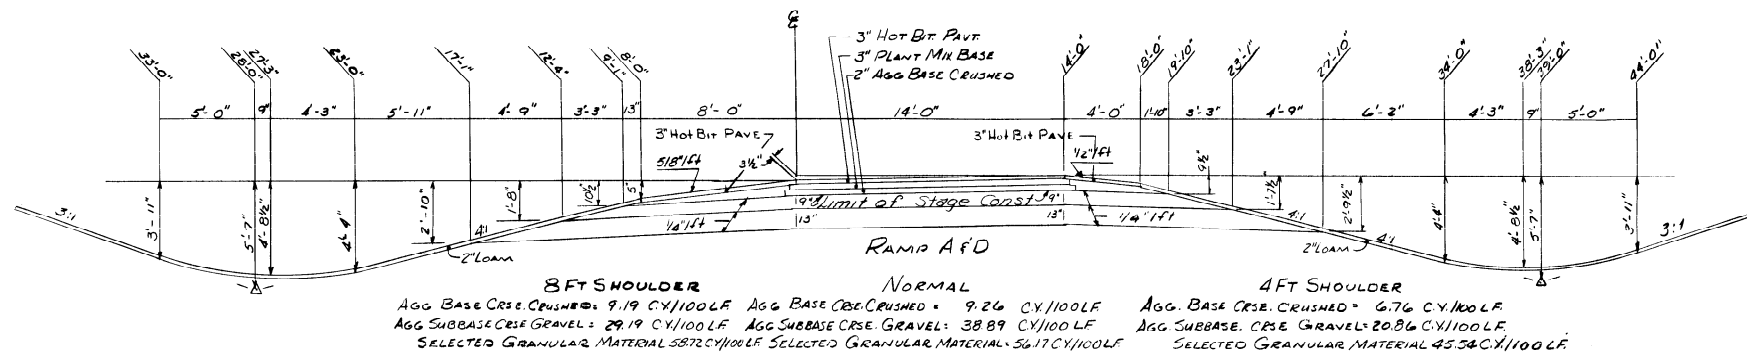

* NOTE:
 THE PAVEMENT AND BASE DEPTHS AS SHOWN
 ON THE PLANS ARE INTENDED TO BE NOMINAL

STATE OF MAINE
 DEPARTMENT OF TRANSPORTATION
 TYPICAL SECTIONS RAMPS
 RAMPS A & D
 RAMPS B & C
 0 5 10'

DATE	3-73
BY	EP
DESIGN - DETAILED	
CHECKED	
REVISIONS	
FIELD CHANGES	
PLANS	