



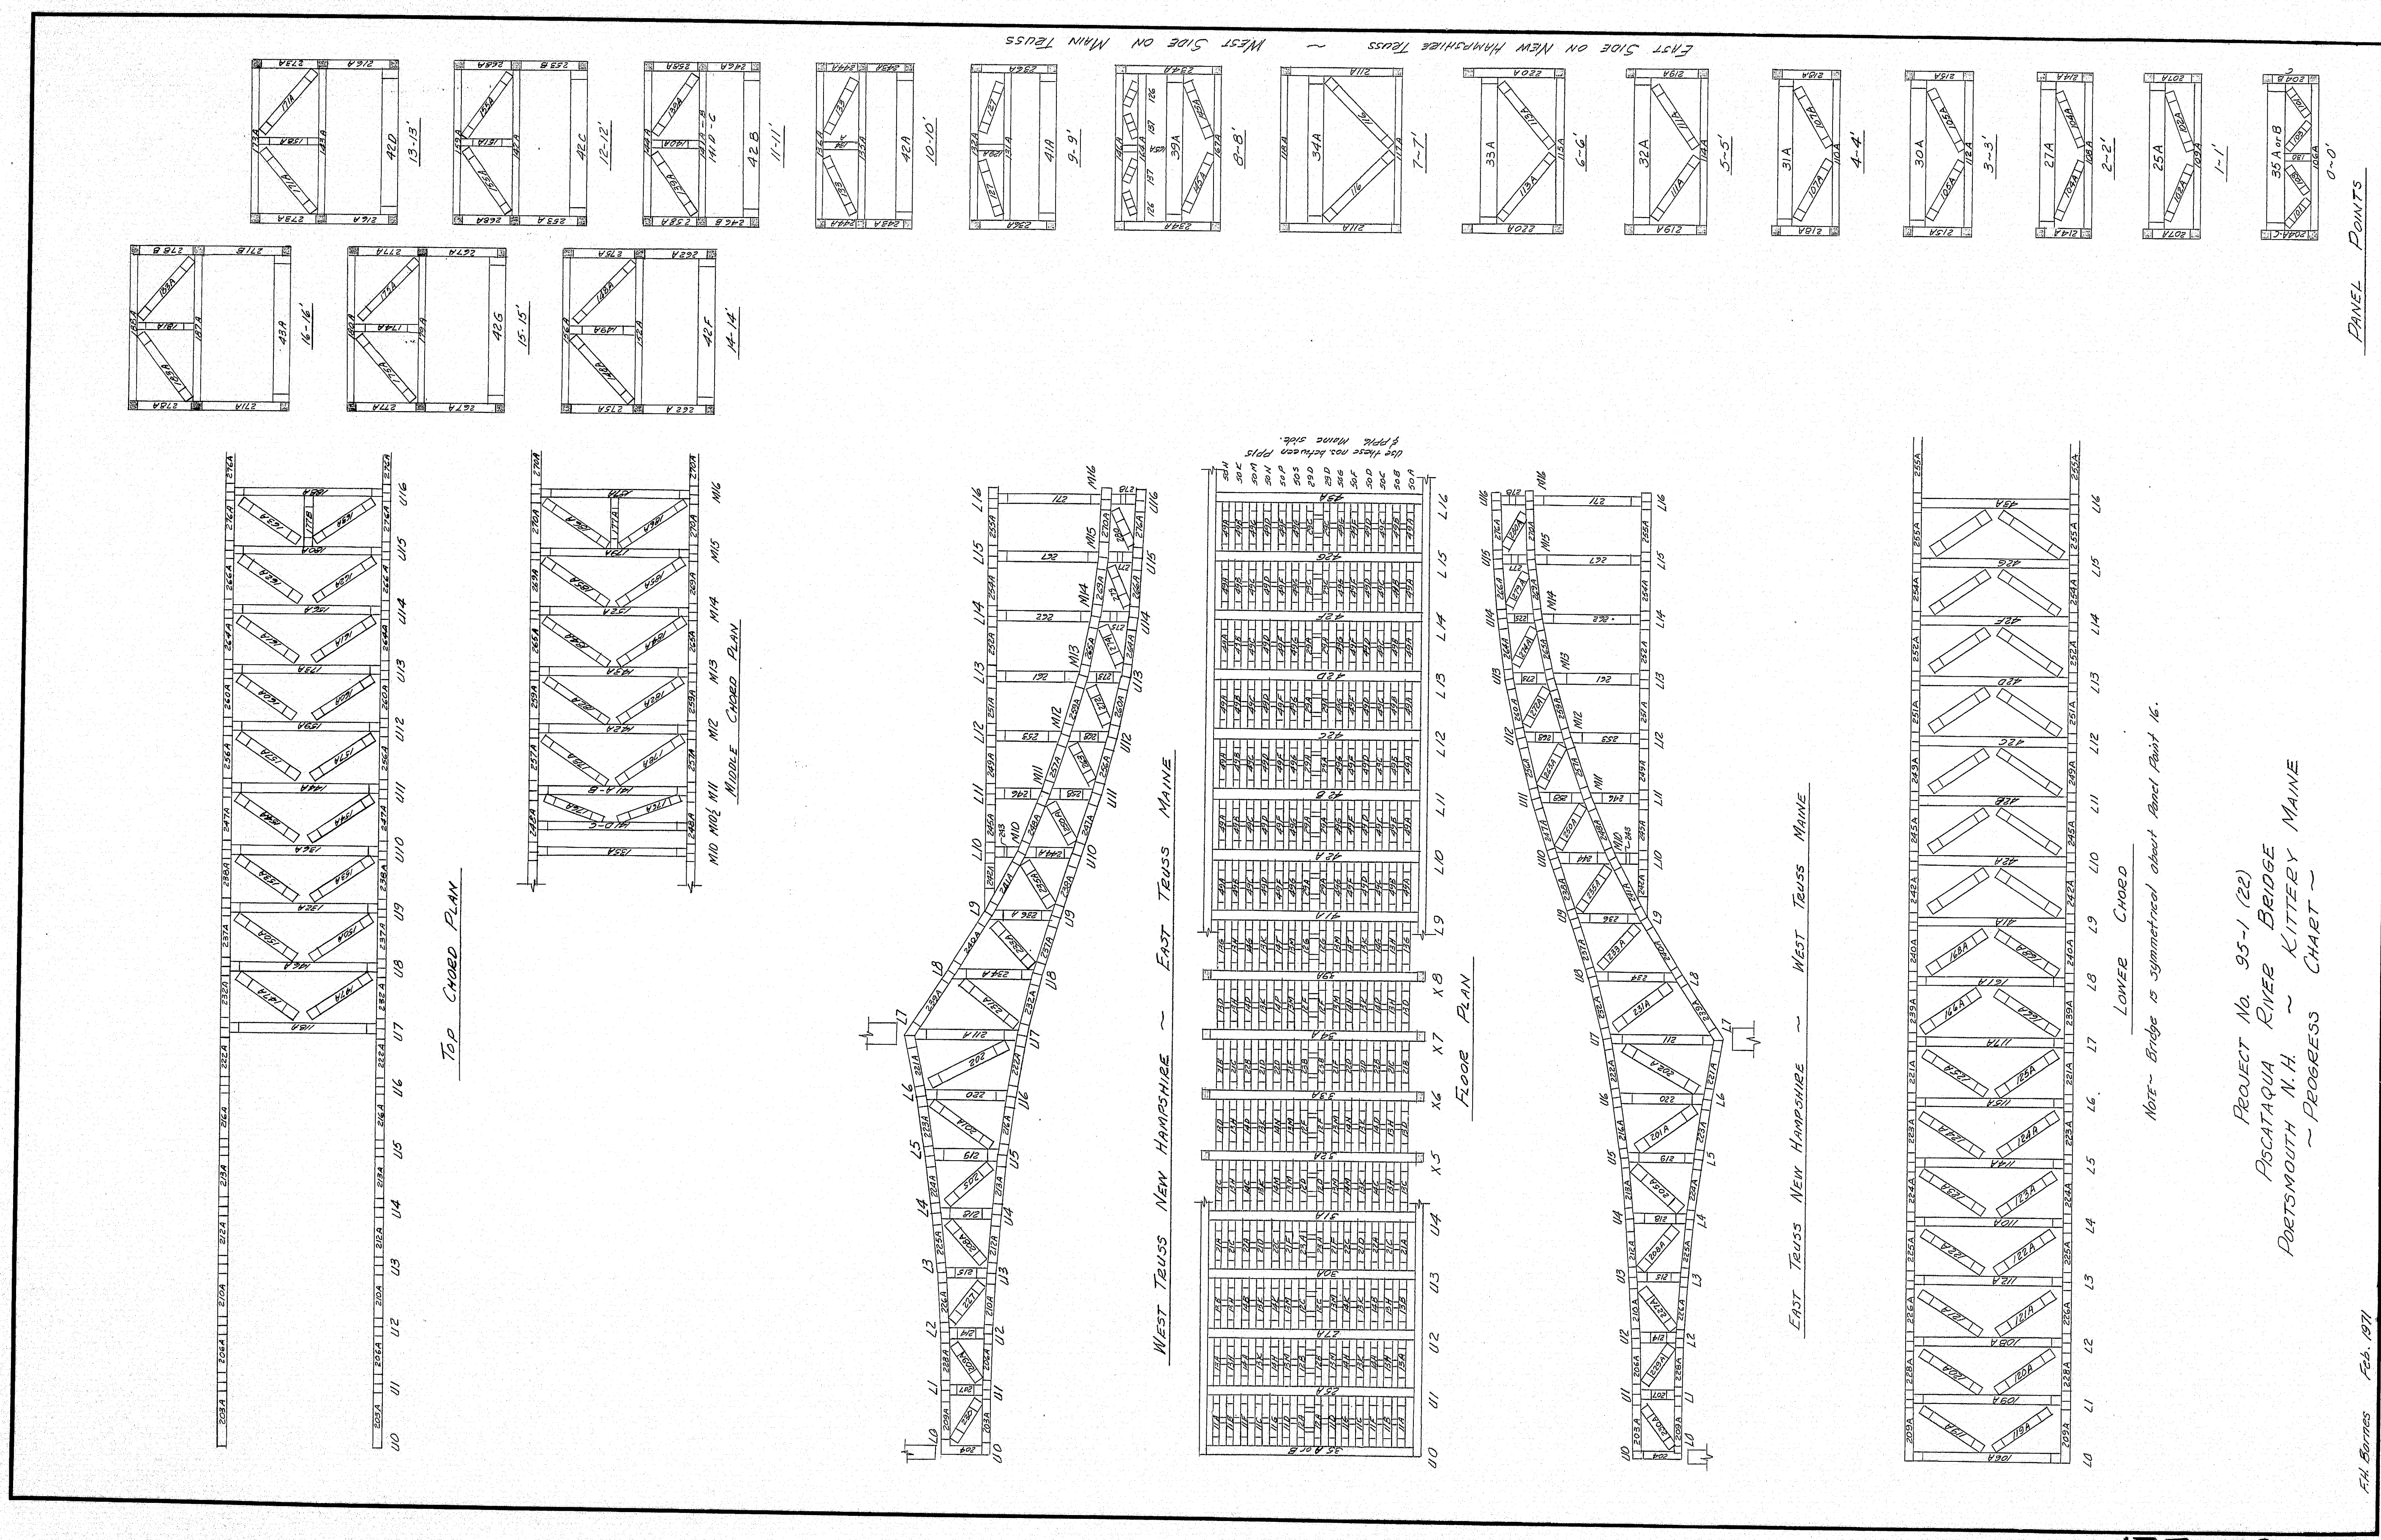


133-39

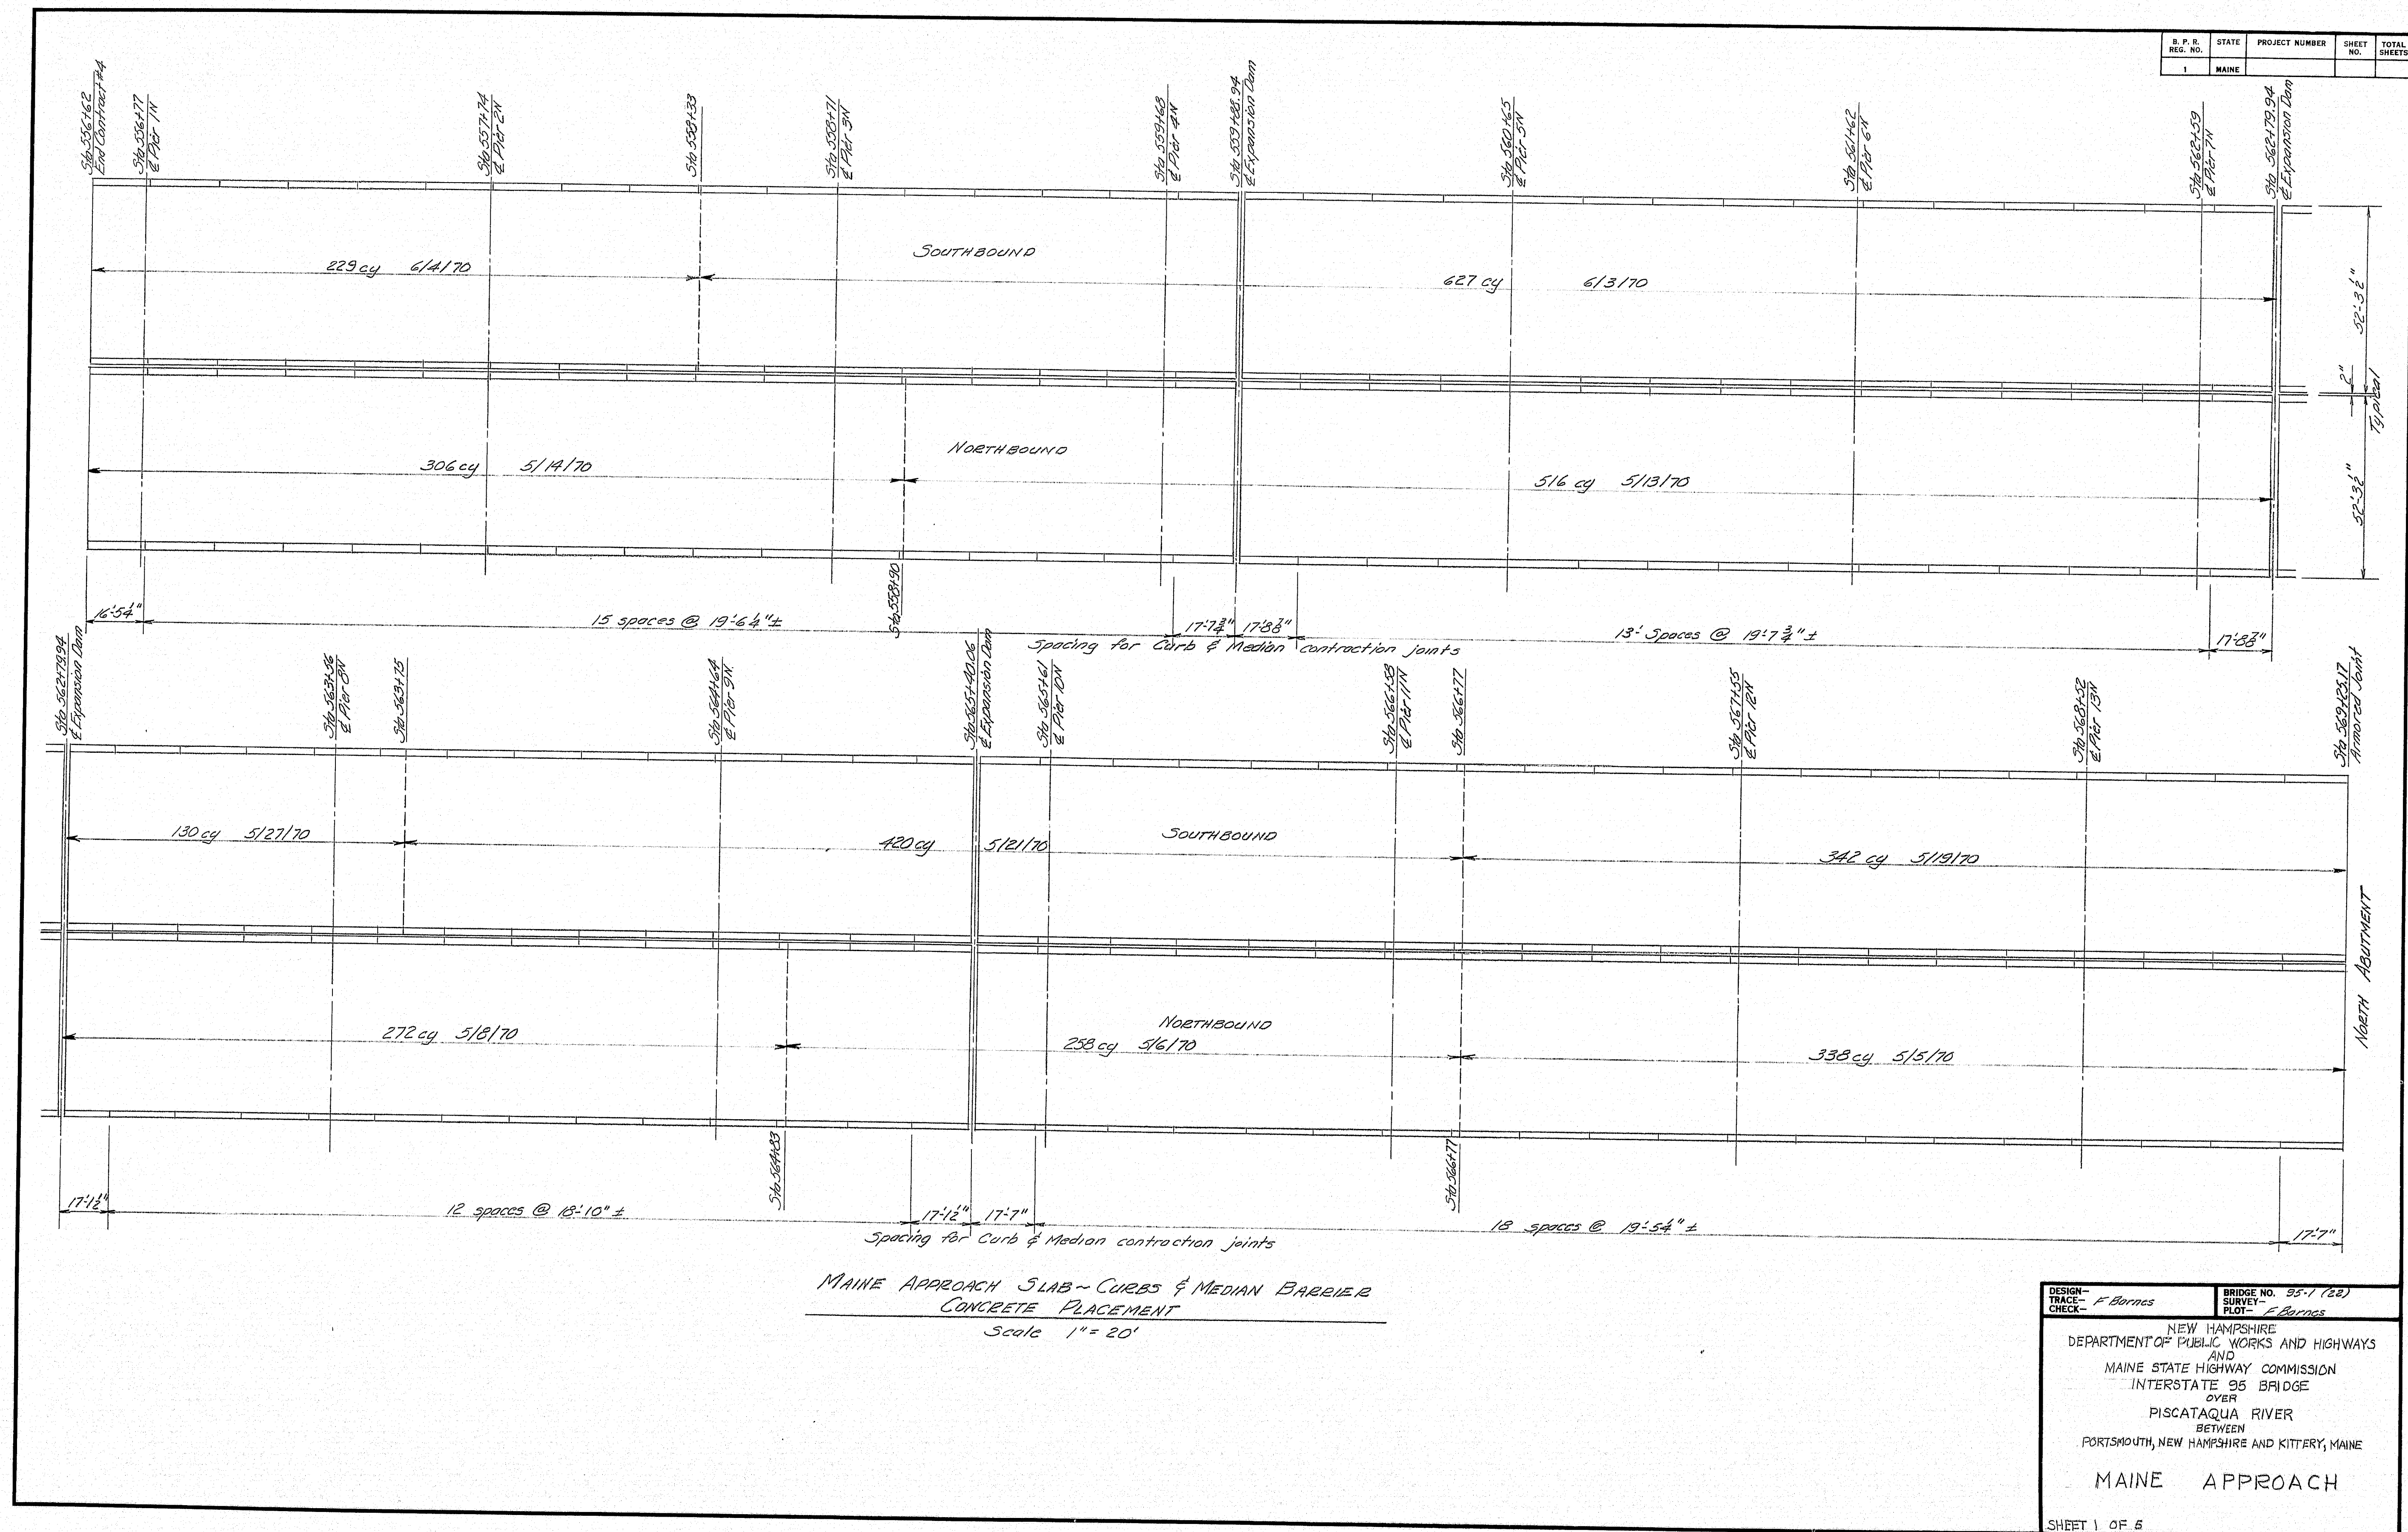

133:40

E. P. & S. REG. NO.	STATE	PROJECT NUMBER	SHEET NO.	TOTAL SHEETS
1	MAINE			

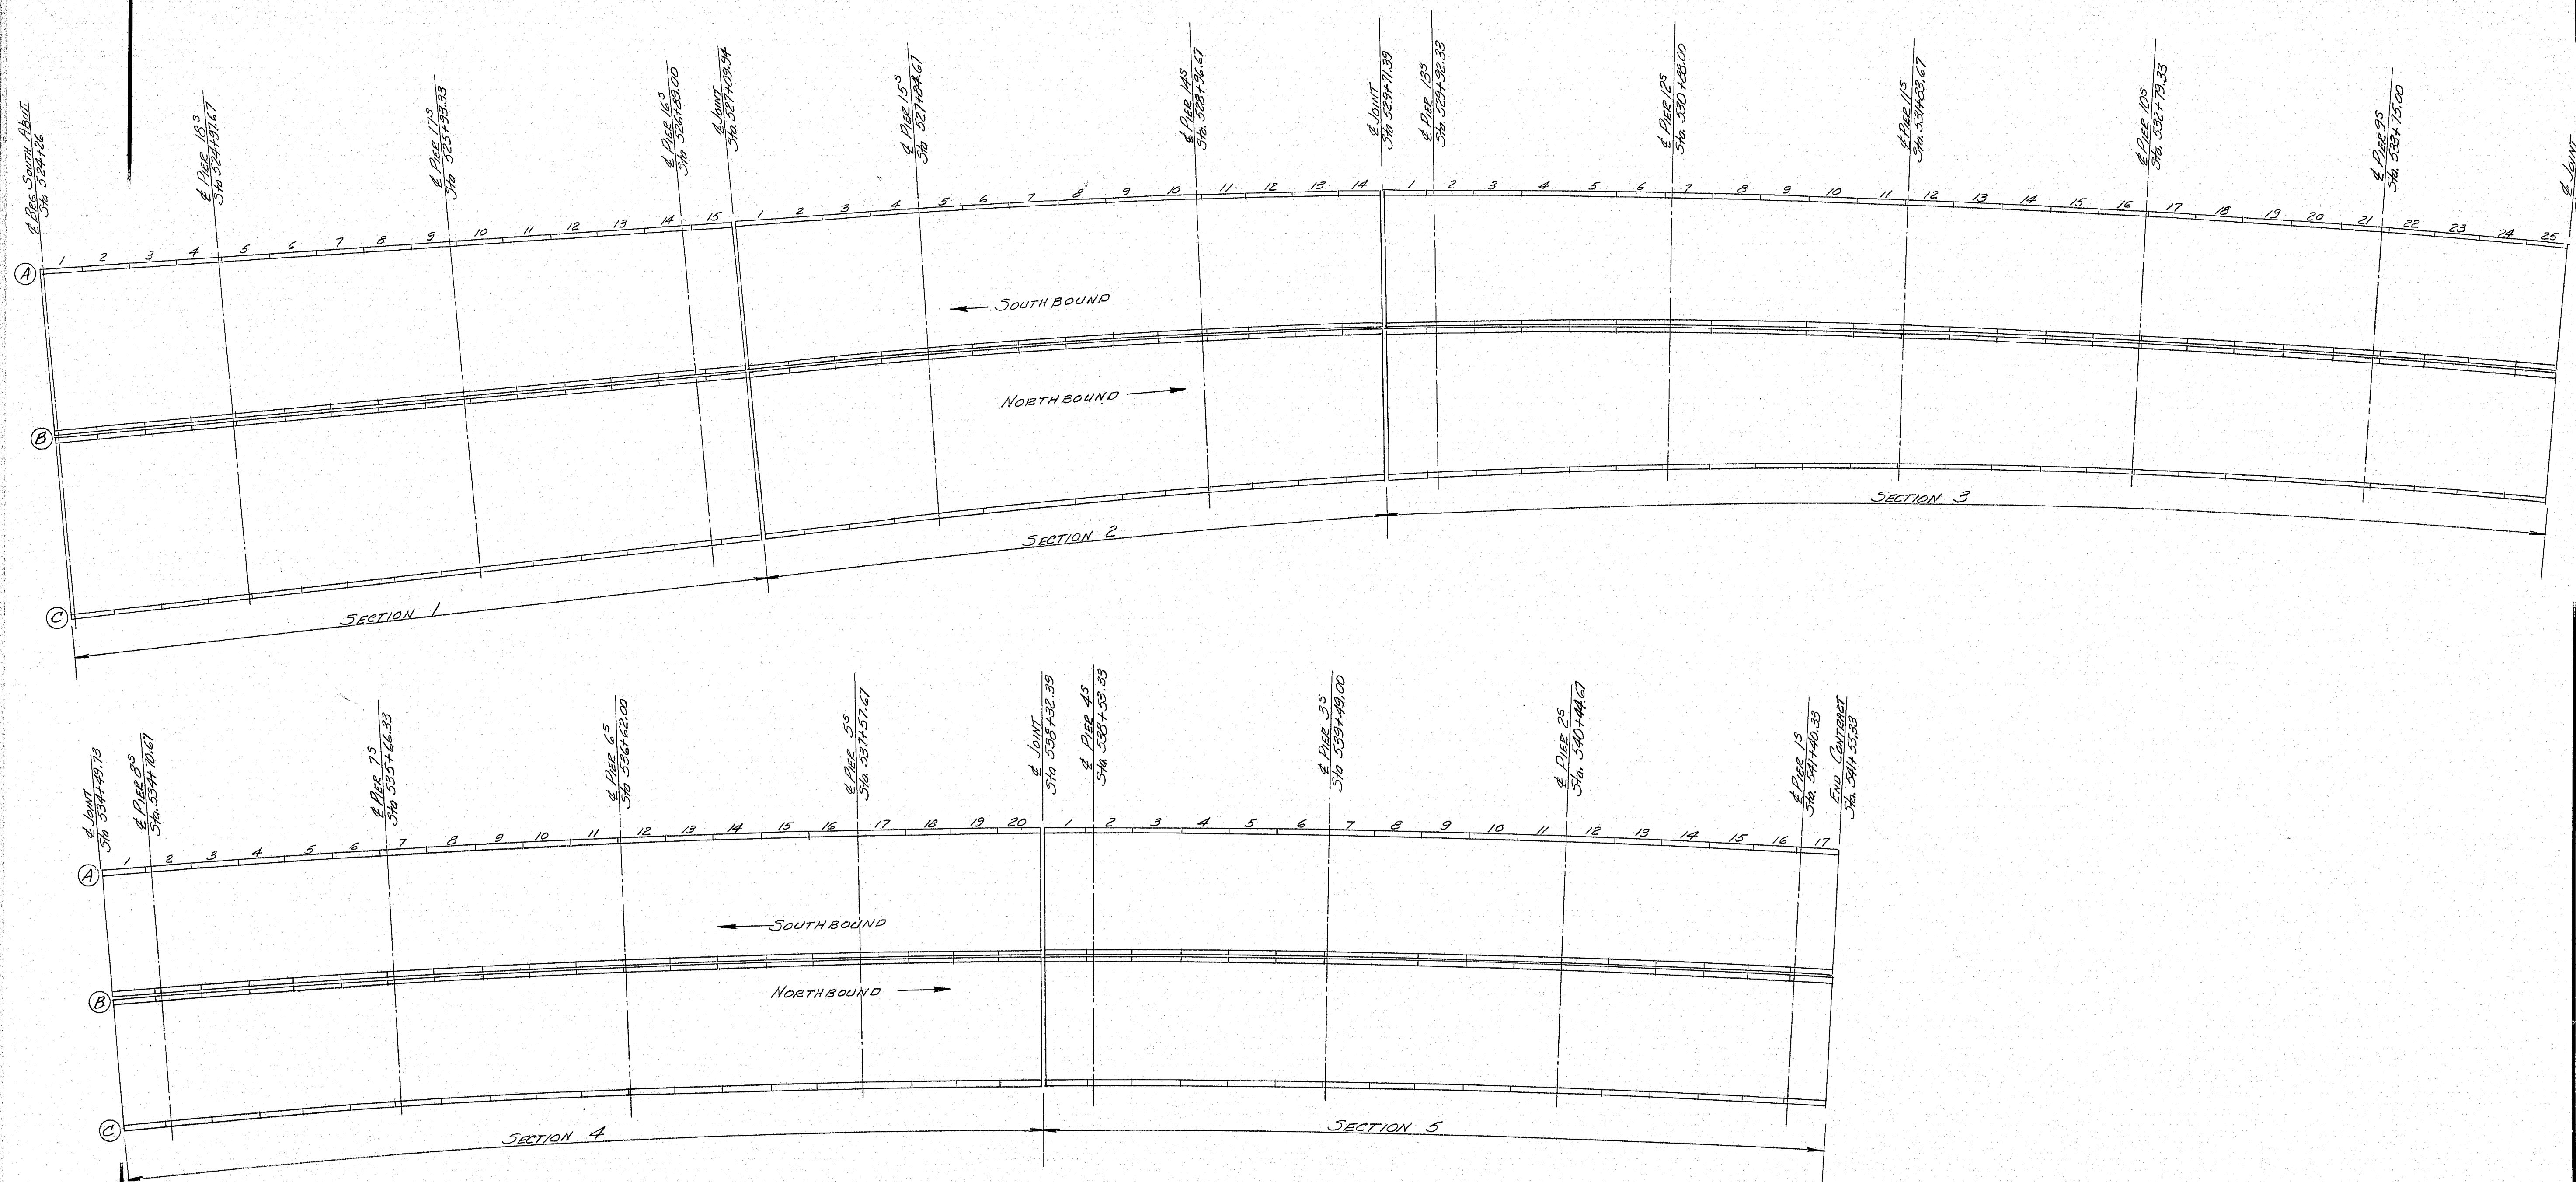

DESIGN - TRACE - CHECK -	F. Barnes	BRIDGE NO. 95-1 (22) SURVEY - PLOT -	F. Barnes
NEW HAMPSHIRE DEPARTMENT OF PUBLIC WORKS AND HIGHWAYS AND MAINE STATE HIGHWAY COMMISSION INTERSTATE 95 BRIDGE OVER PISCATAQUA RIVER BETWEEN PORTSMOUTH, NEW HAMPSHIRE AND KITTERY, MAINE NEW HAMPSHIRE APPROACH			
SHEET 2 OF 3			

133:42