

ORIGINAL SURVEY NOTE BOOK NO.	BY Merry & Raymond	DATE 3-65
REVIEWED PLOTTED AREAS	DATE 3-65	DATE 3-65

FINAL SURVEY NOTE BOOK NO.	BY Merry & Raymond	DATE 3-65
REVIEWED PLOTTED AREAS	DATE 3-65	DATE 3-65

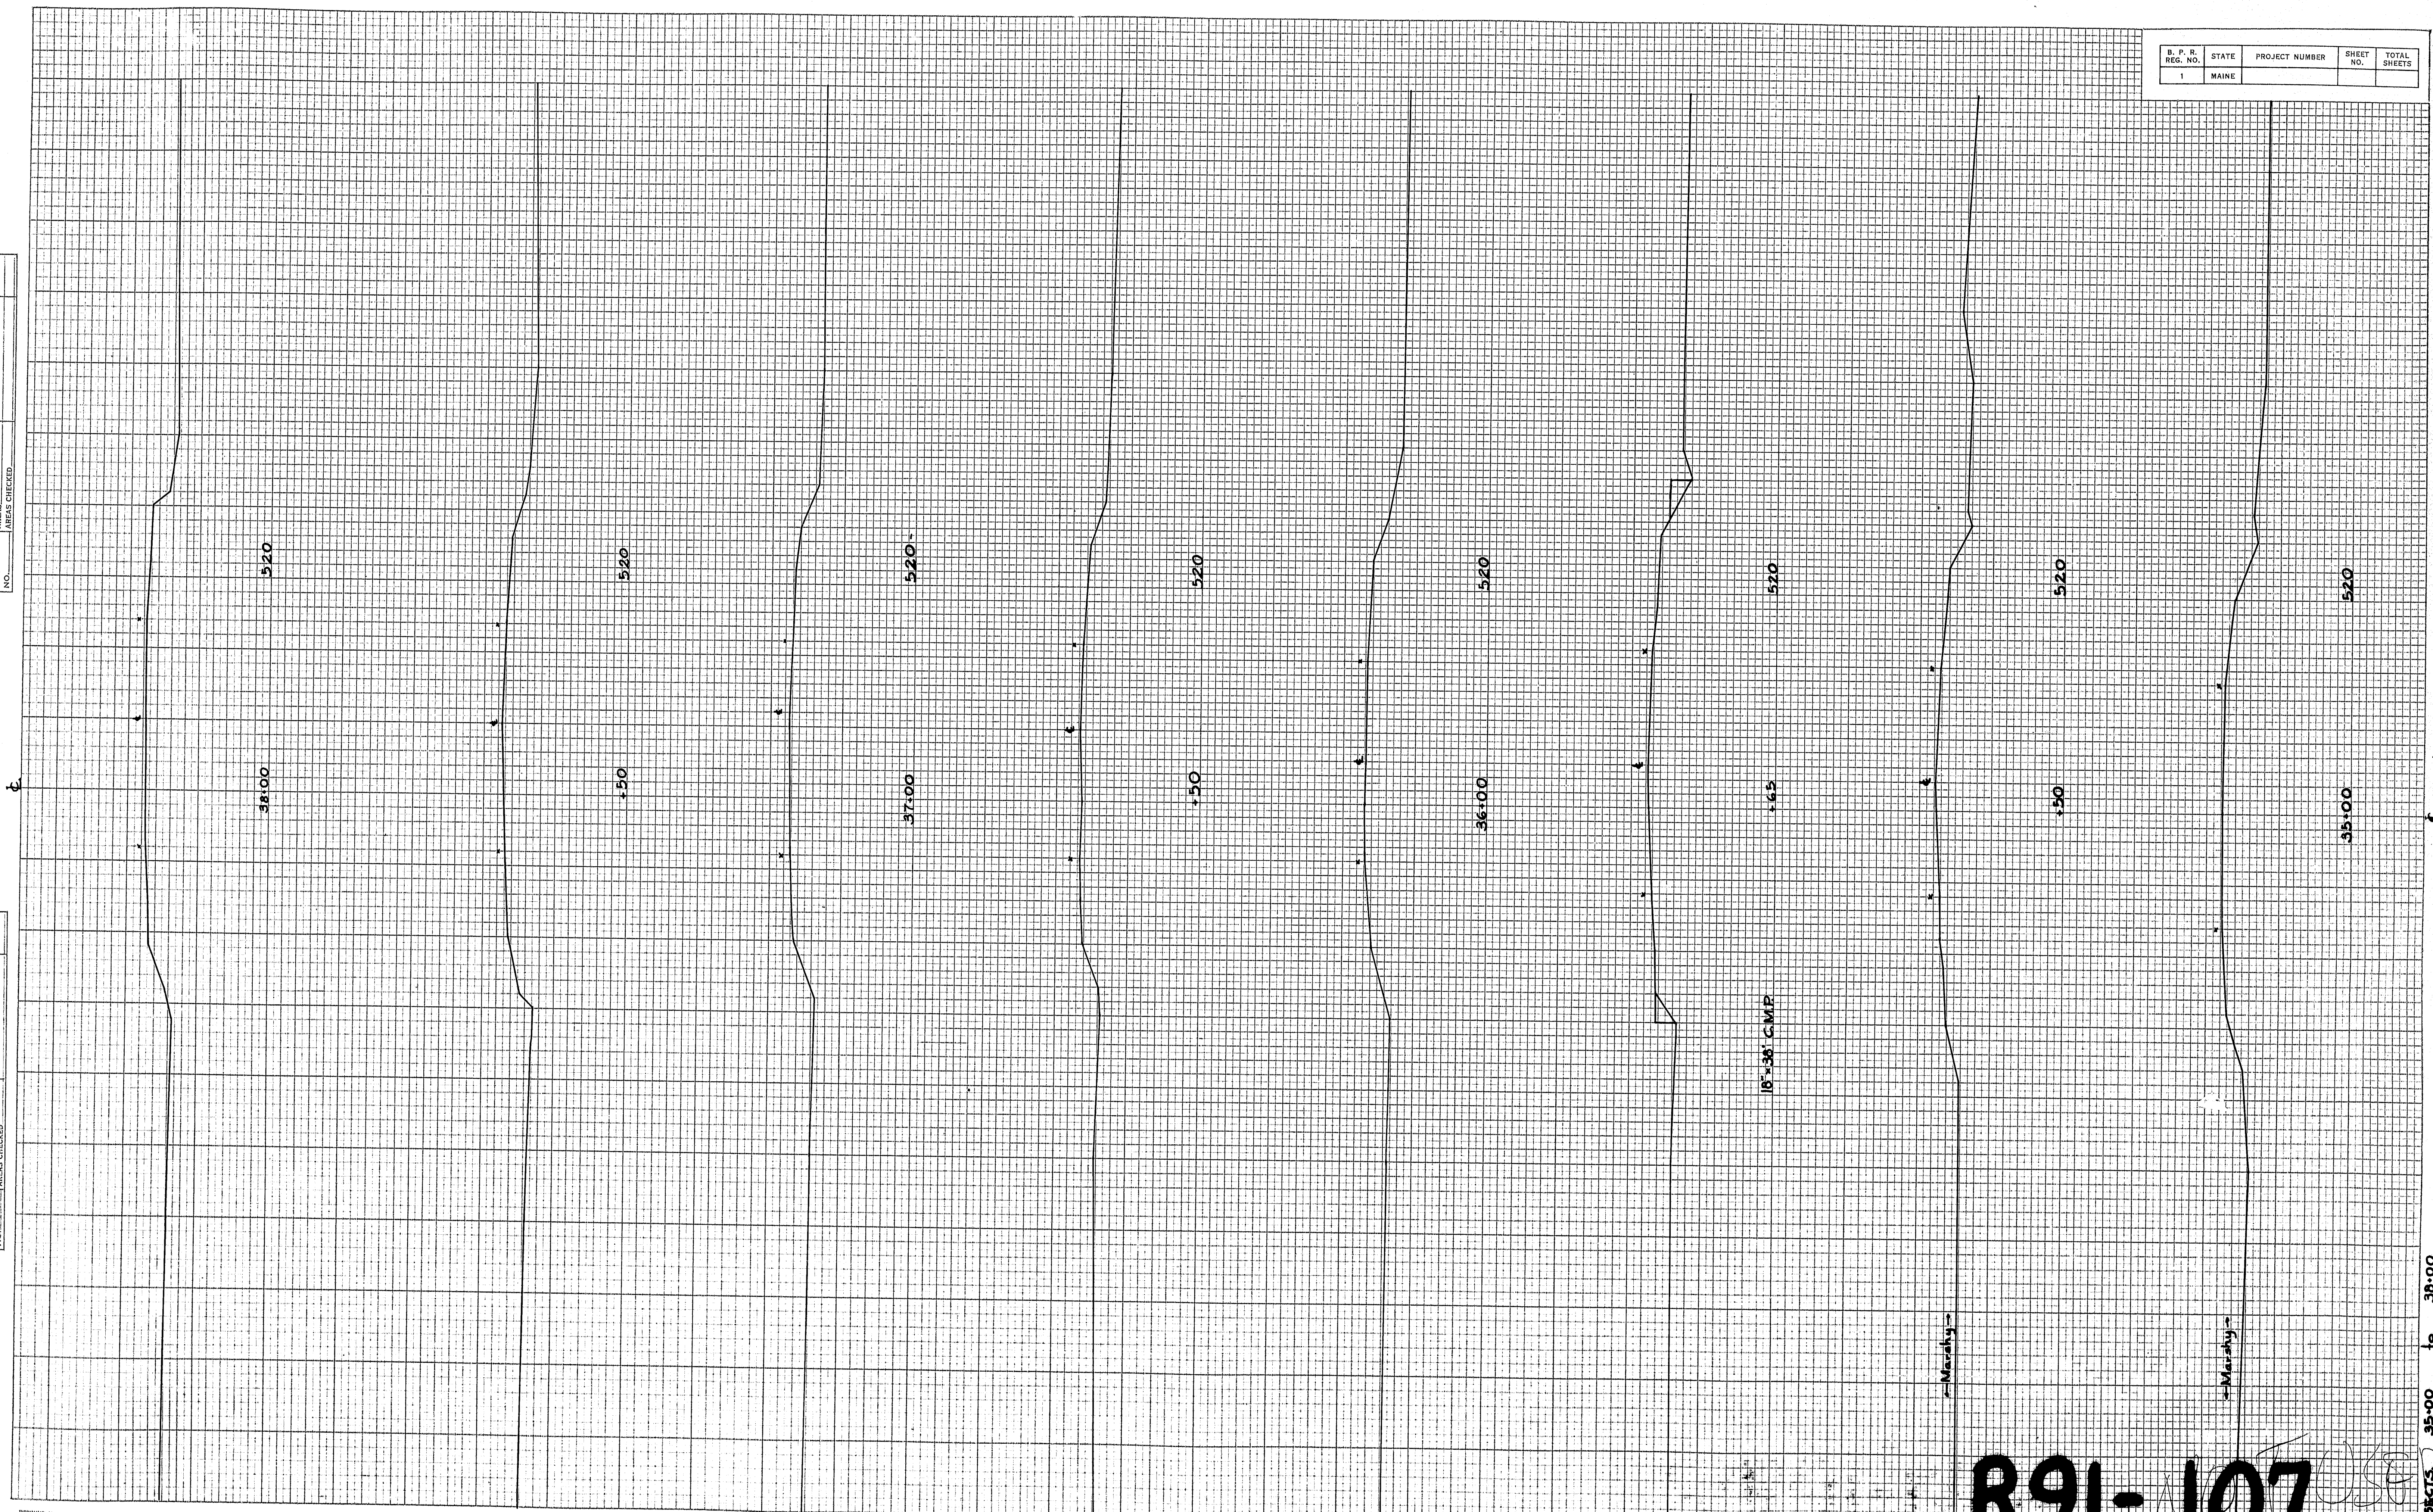



PLATE 3 - CROSS SECTION U. S. P. R. E.
MADE AND PRINTED IN U. S. A.
CHARLES BURNING COMPANY, INC.

R91-107

X-35475 35+00 to 38+00

ORIGINAL SURVEY NOTE BOOK NO.	BY Wesley E. Raymond DATE 3-68
--	---

FINAL SURVEY NO.	SURVEYED PLOTTER DATE AREAS CHECKED	BY DATE
------------------------	---	------------

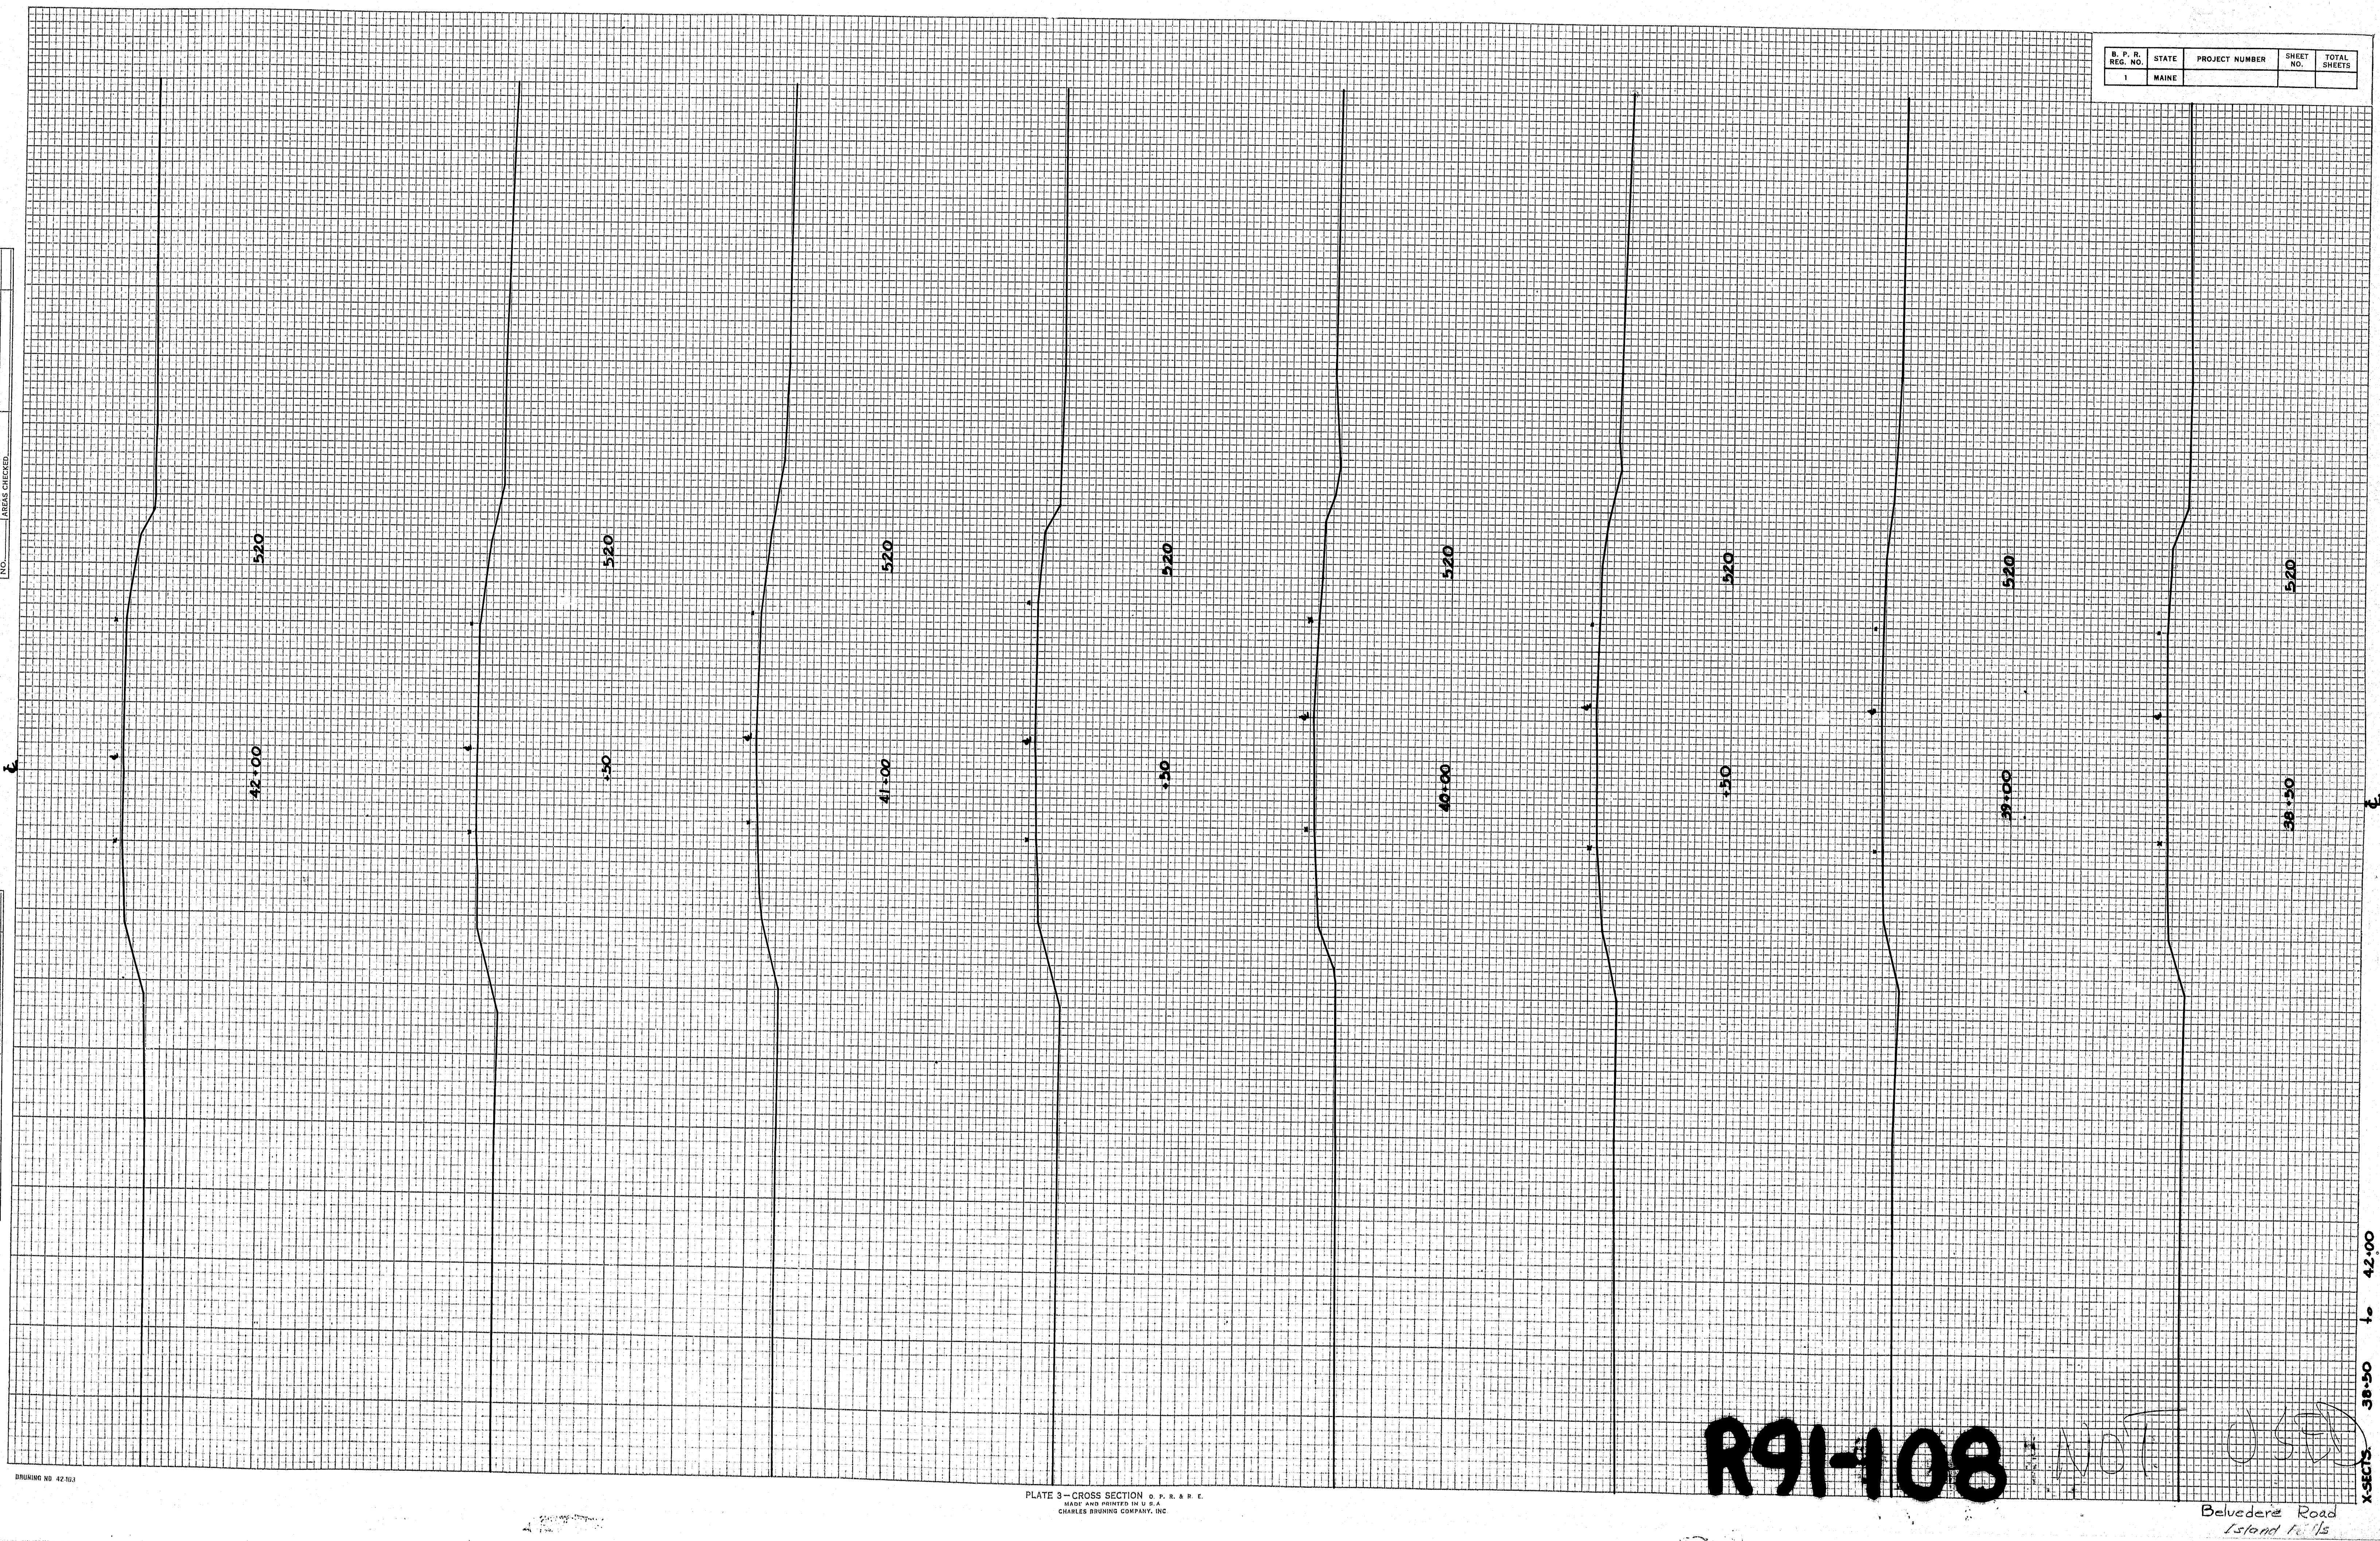

D. P. R. REF. NO.	STATE	PROJECT NUMBER	SHEET NO.	TOTAL SHEETS
1	MAINE			

R91-108


NOT USED

Belvedere Road
Island 10/15

PLATE 3 - CROSS SECTION D. P. R. & E.
MADE AND PRINTED IN U.S.A.
CHARLES BRIDGES COMPANY, INC.

ORIGINAL SURVEY NOTE BOOK NO.	SURVEYED AREAS CHECKED	BY Mary E. Raymond	DATE 3-65

FINAL SURVEY NOTE BOOK NO.	SURVEYED PLOTED AREAS CHECKED	BY	DATE

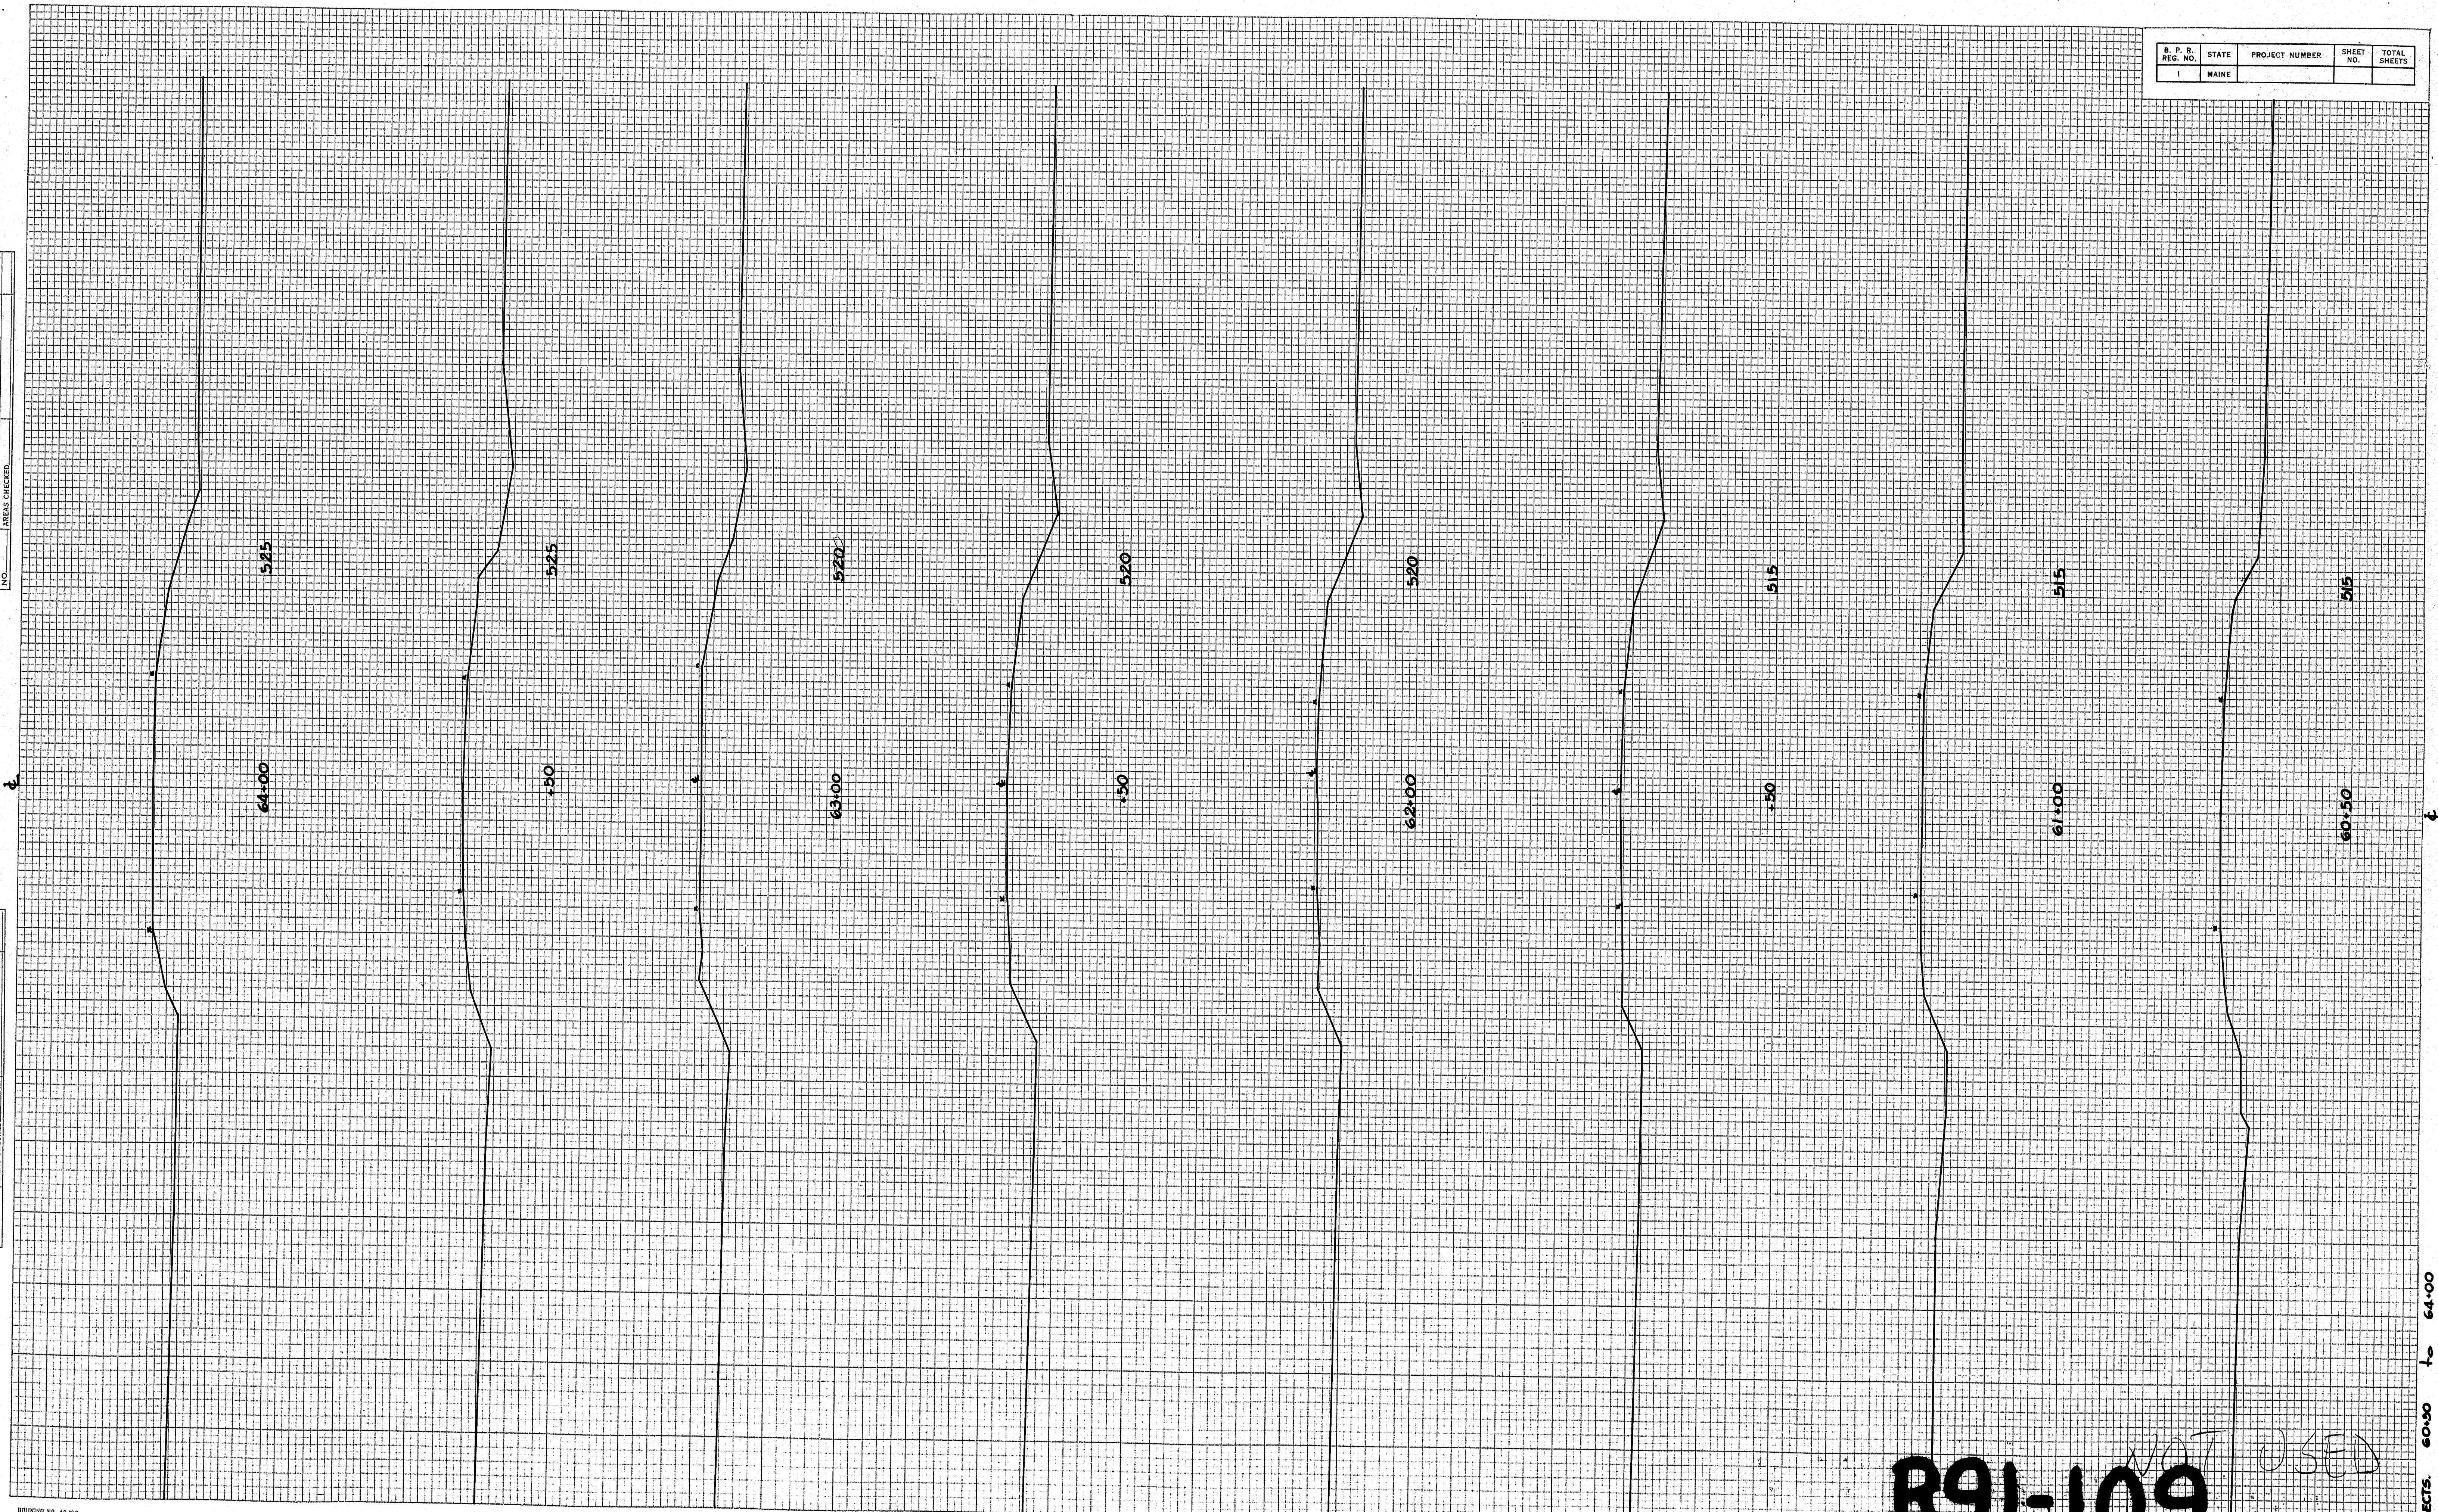

B. P. D.	STATE	PROJECT NUMBER	SHEET NO.	TOTAL SHEETS
1	MAINE			

PLATE 3 - CROSS SECTION B. P. D. S. R. E.
MADE AND PRINTED IN U. S. A.
CHARLES BRIDGES COMPANY, INC.

R91-109


Belvedere Road
Island Falls

X-SECTS. 60+50 to 64+00

ORIGINAL SURVEY	DATE
NO. 1	3-65
BY	
Mary E. Ryan	
NO. 2	
NO. 3	
FINAL SURVEY	DATE
NO. 1	
NO. 2	
B. F. R.	STATE	PROJECT NUMBER	SHEET NO.	TOTAL SHEETS
1	MAINE			

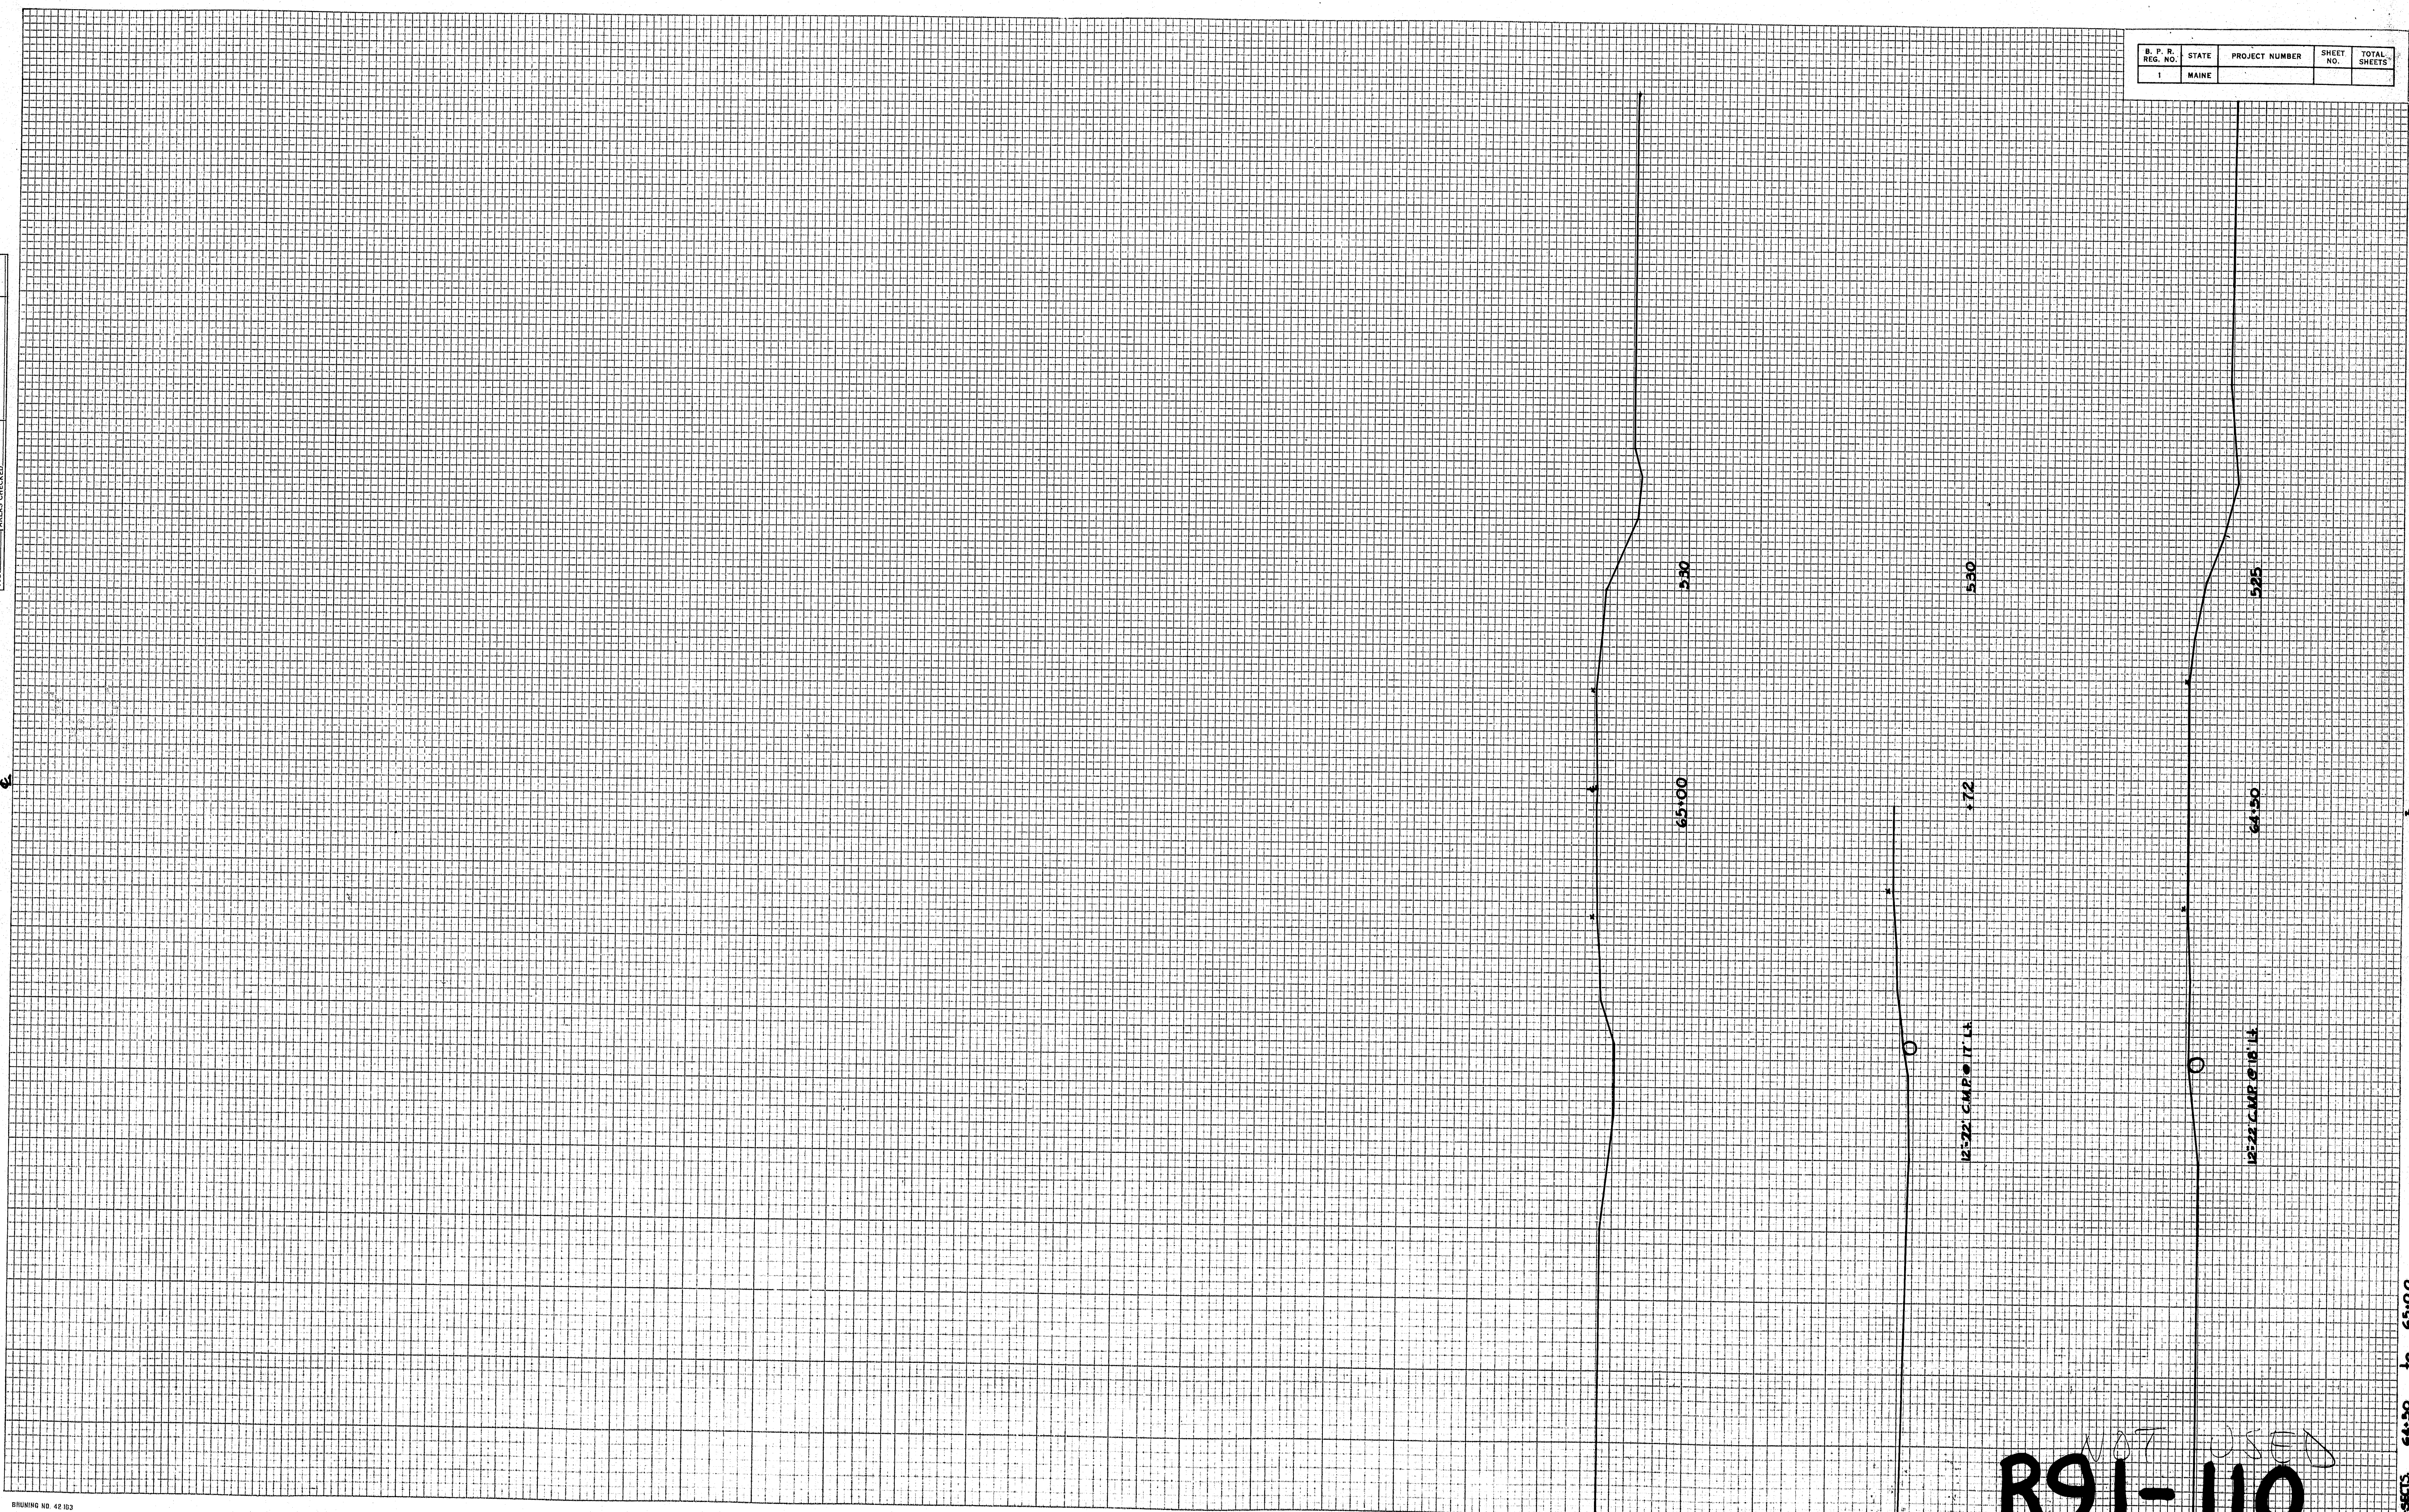


NOT USED
R91-110
Belvedere Road
1/10/77 P. 1/15

S. P. E.	STATE	PROJECT NUMBER	SHEET NO.	TOTAL SHEETS
1	MAINE			

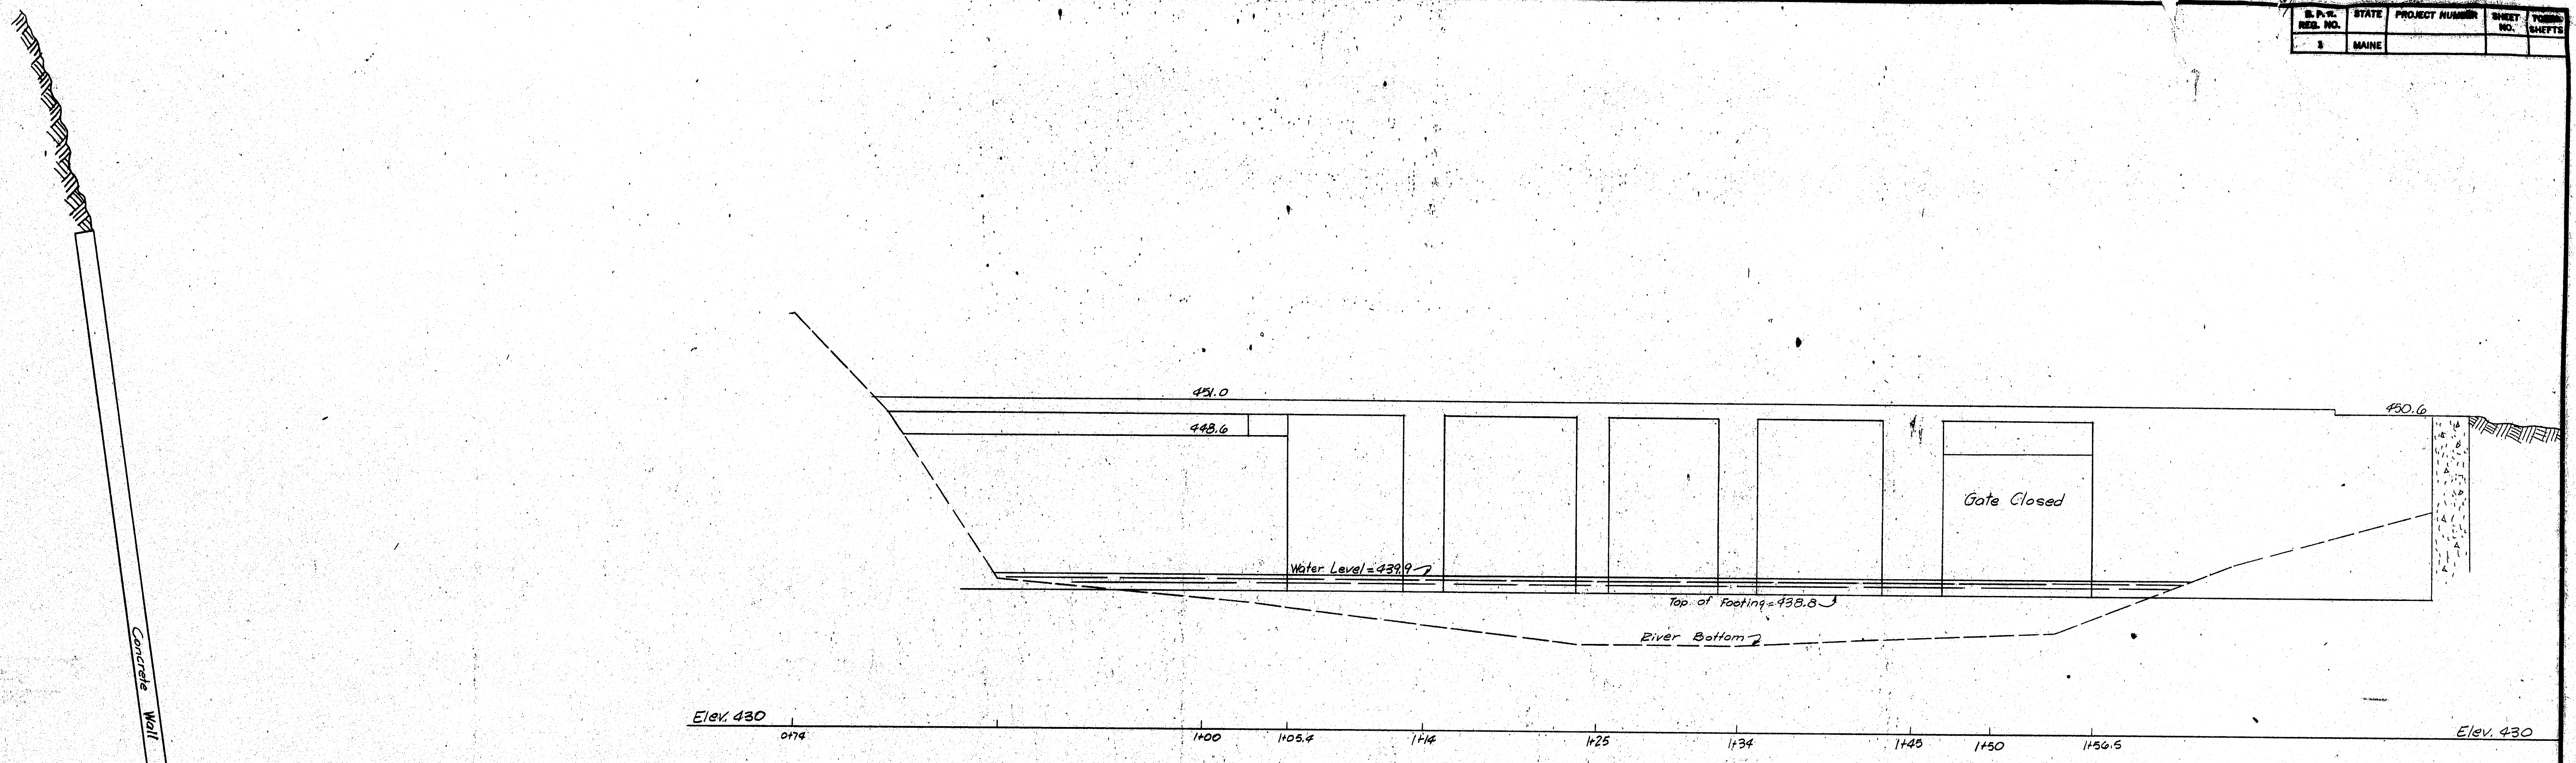

CROSS SECTION & ELEVATION
SCALE = 1" = 5'

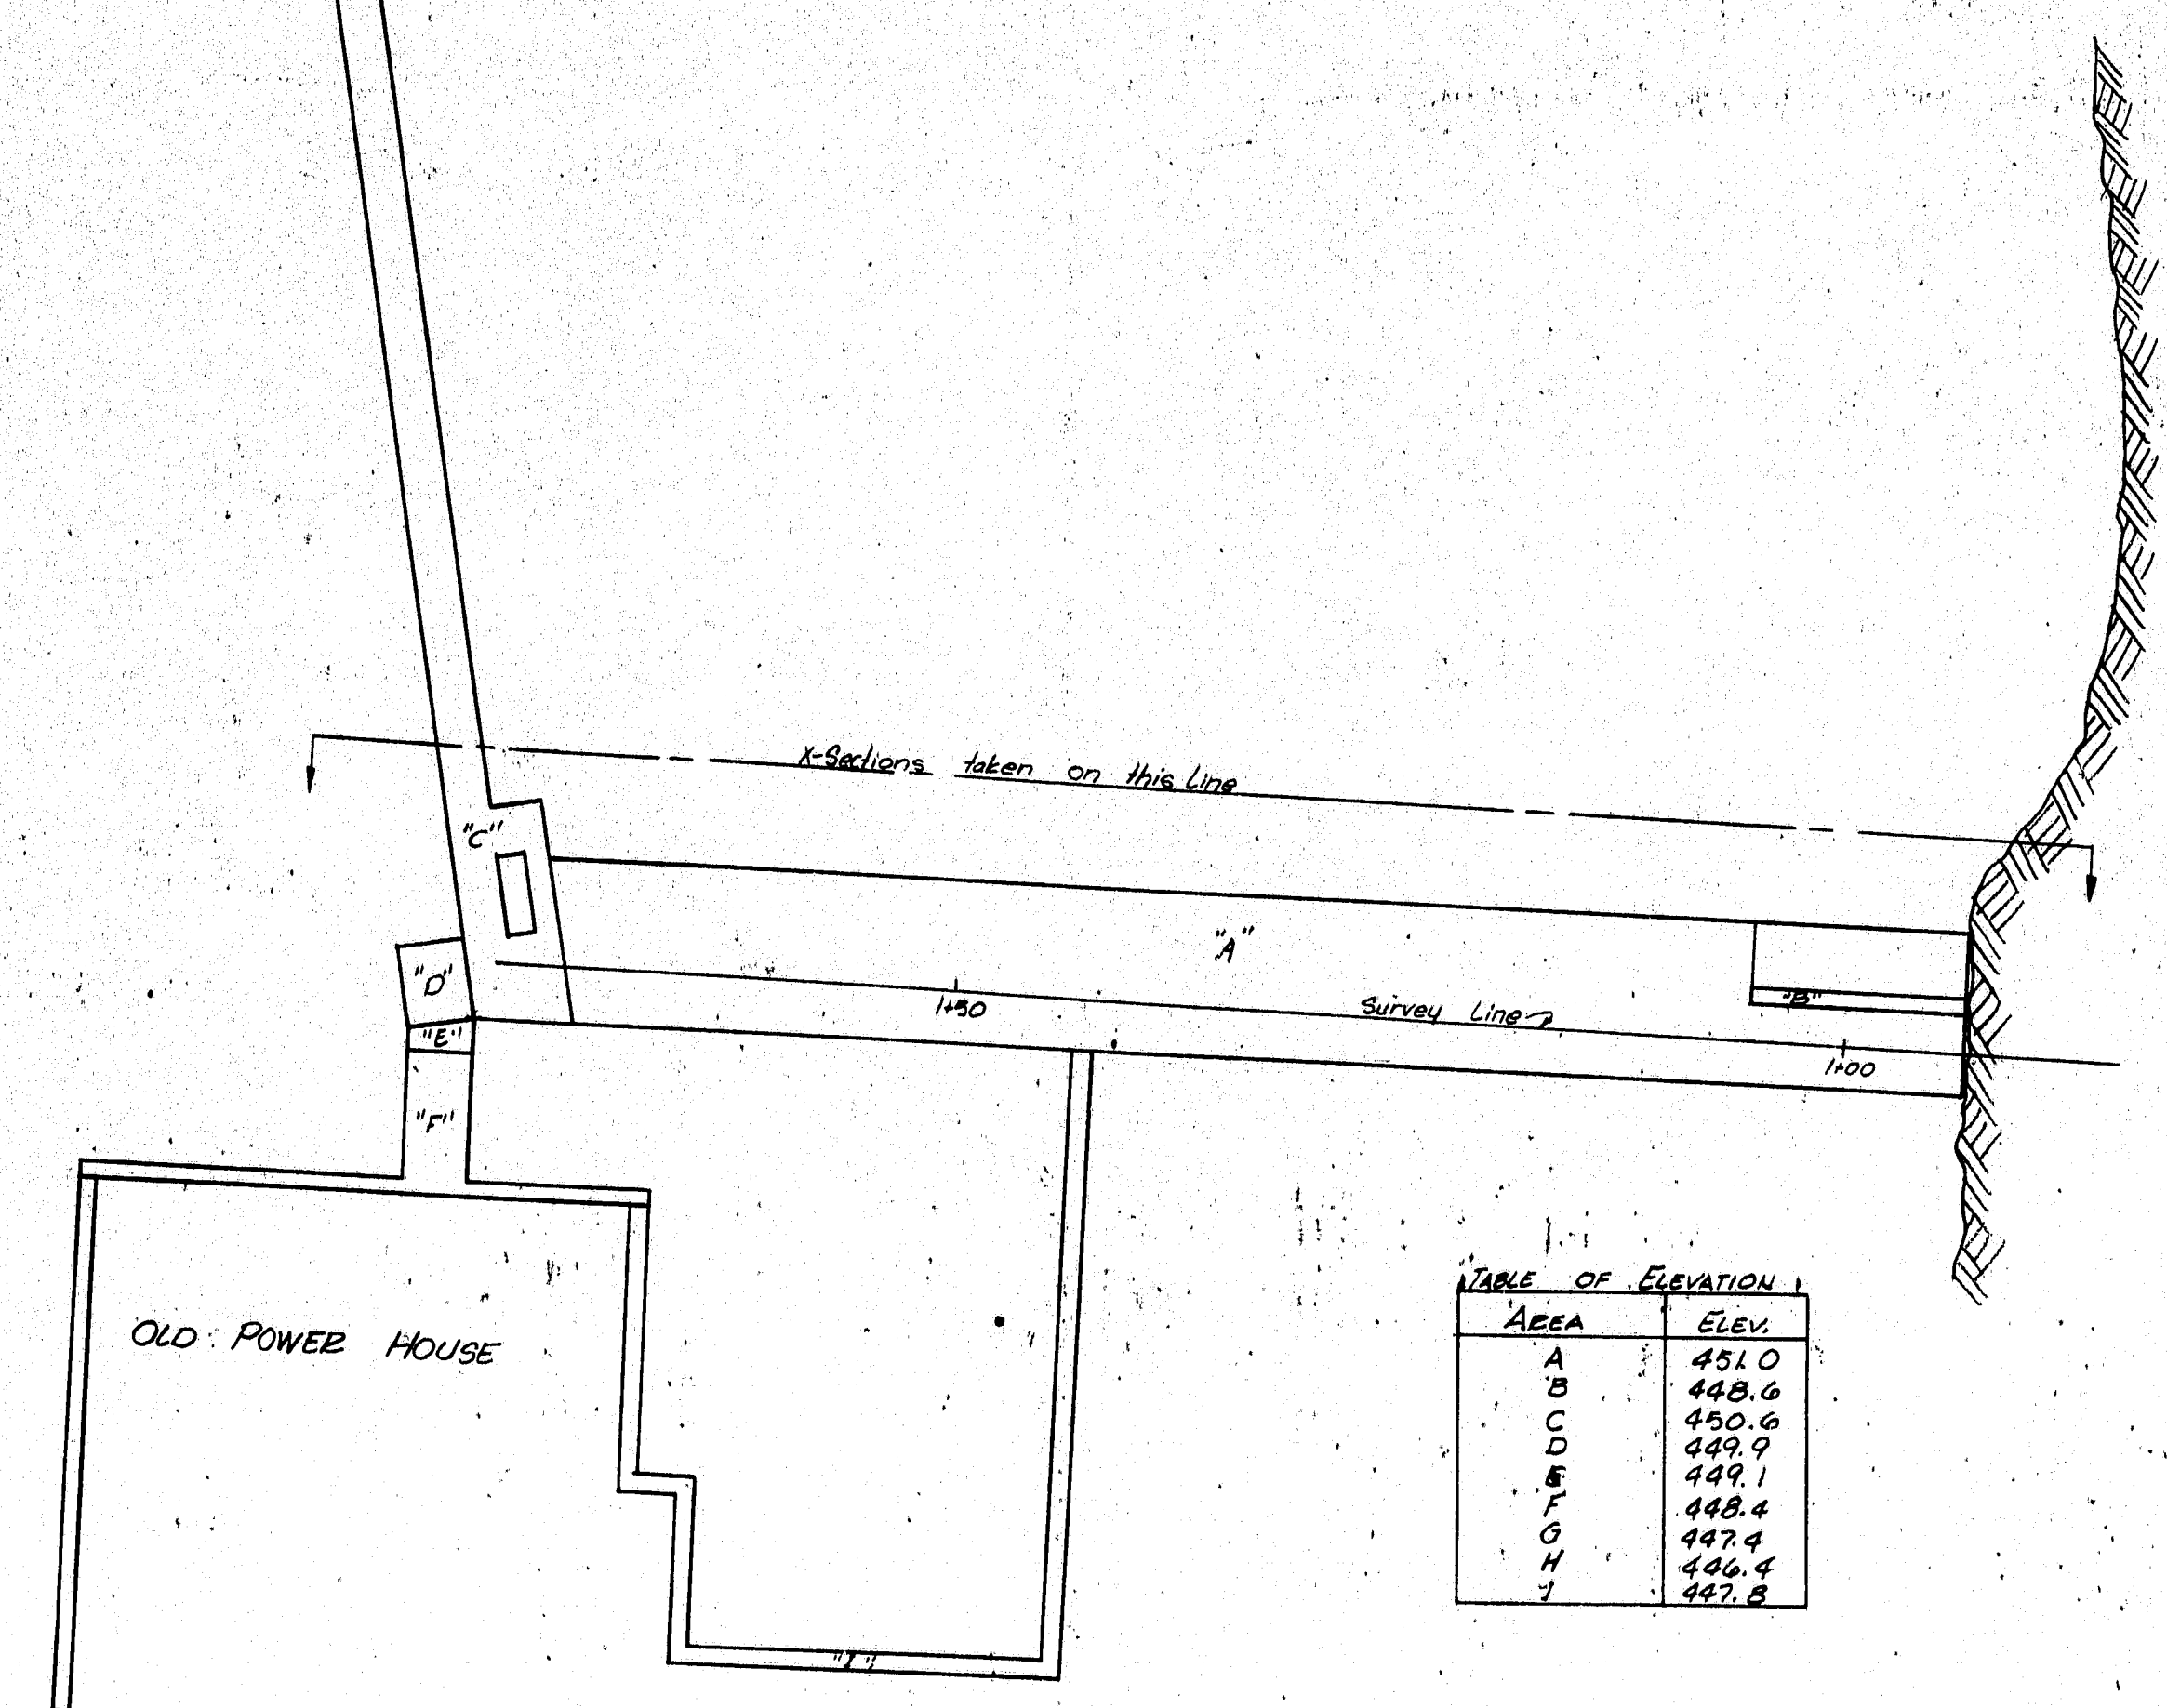

Area	Elev.
A	451.0
B	448.6
C	450.6
D	449.9
E	449.1
F	448.4
G	447.9
H	446.4
I	447.8

PLAN VIEW
DAM AT ISLAND FALLS
SCALE = 1" = 10'

HOWARD, NEEDLES, TAMMEN & BERGENDOFF
CONSULTING ENGINEERS
NEW YORK BOSTON KANSAS CITY

MAINE STATE HIGHWAY COMMISSION
AUGUSTA, MAINE

DAM

ISLAND FALLS

R91-III