
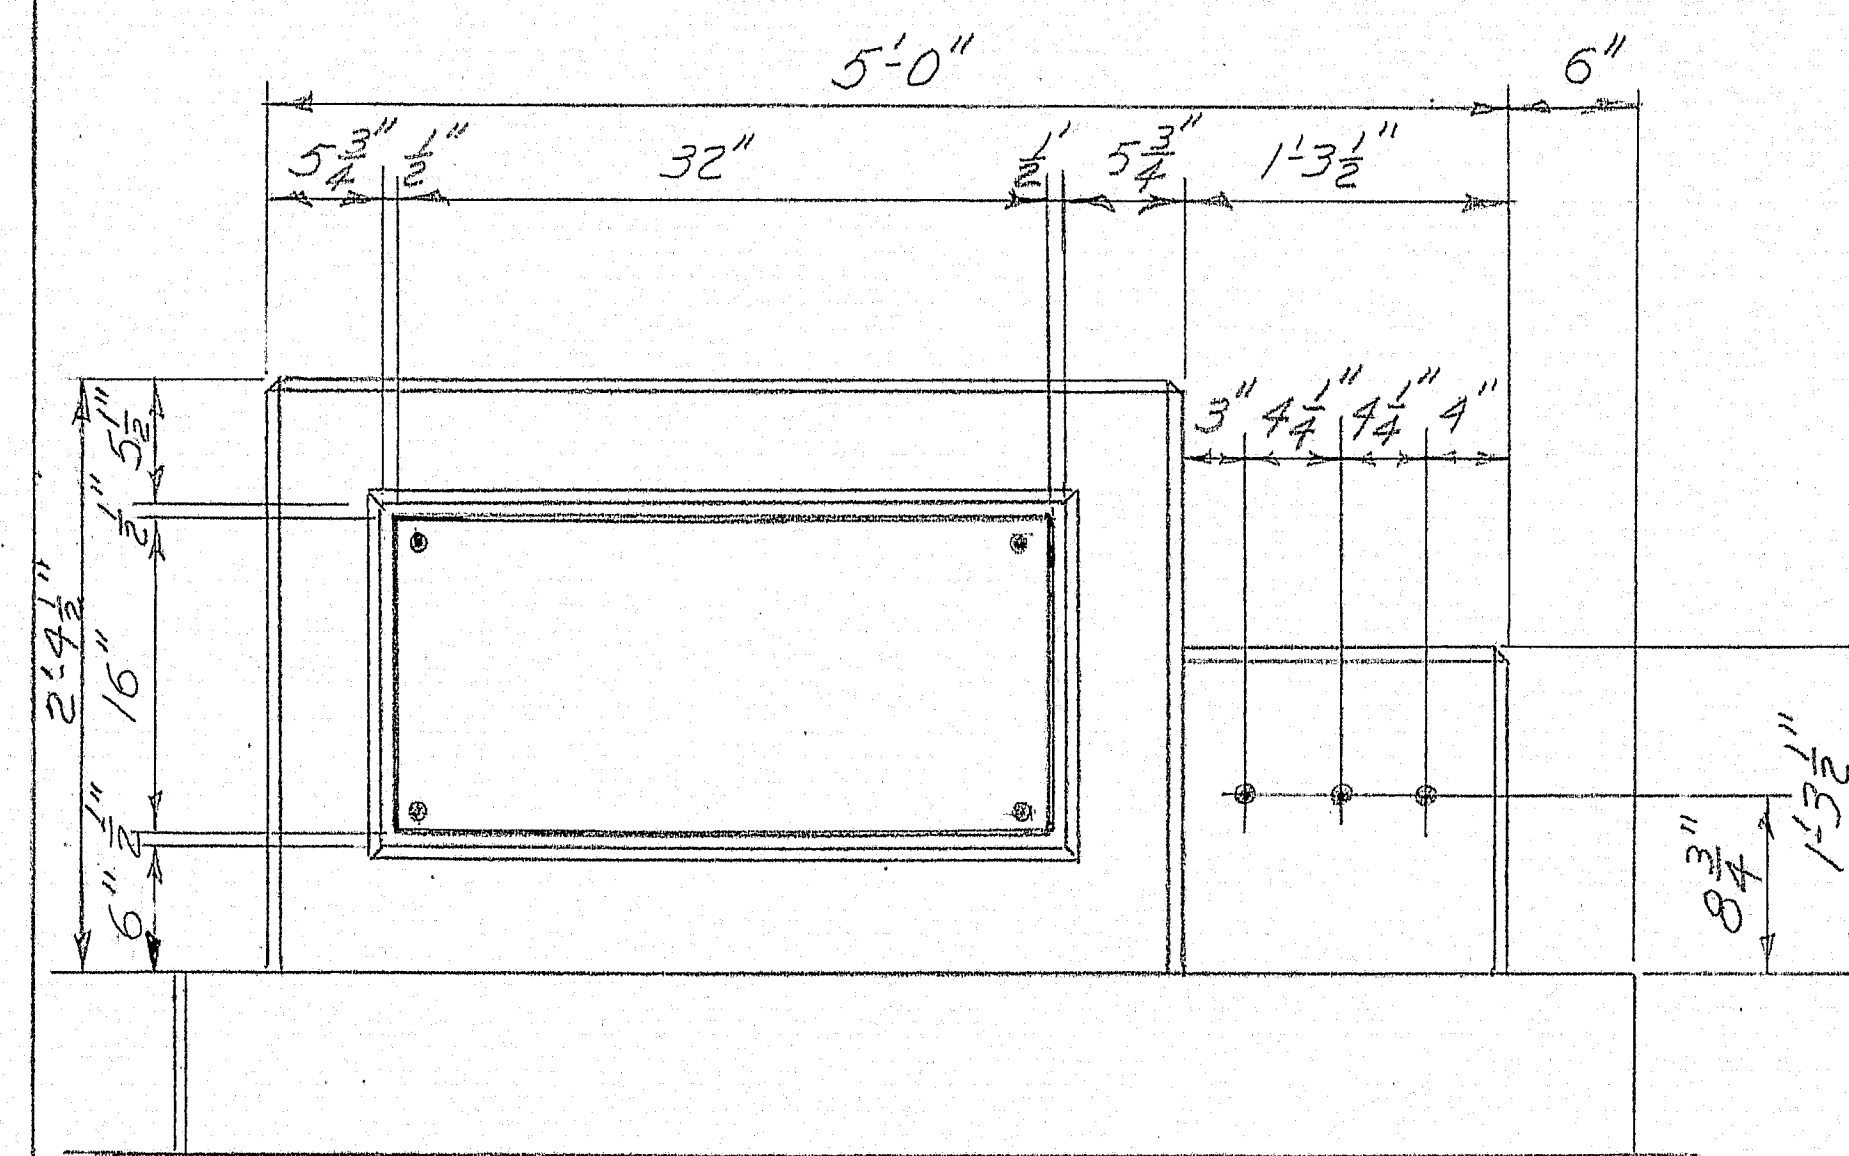


REVISED POSTS VAUGHAN M. DAGGETT
BRIDGES over the PENOBSCOT RIVER
MEDWAY, MAINE. NOTES: Anchor Bolts - $\frac{5}{8}$ " ϕ x 6" Galv.
Construct Post normal to grade
 $\frac{1}{2}$ " Chamfer

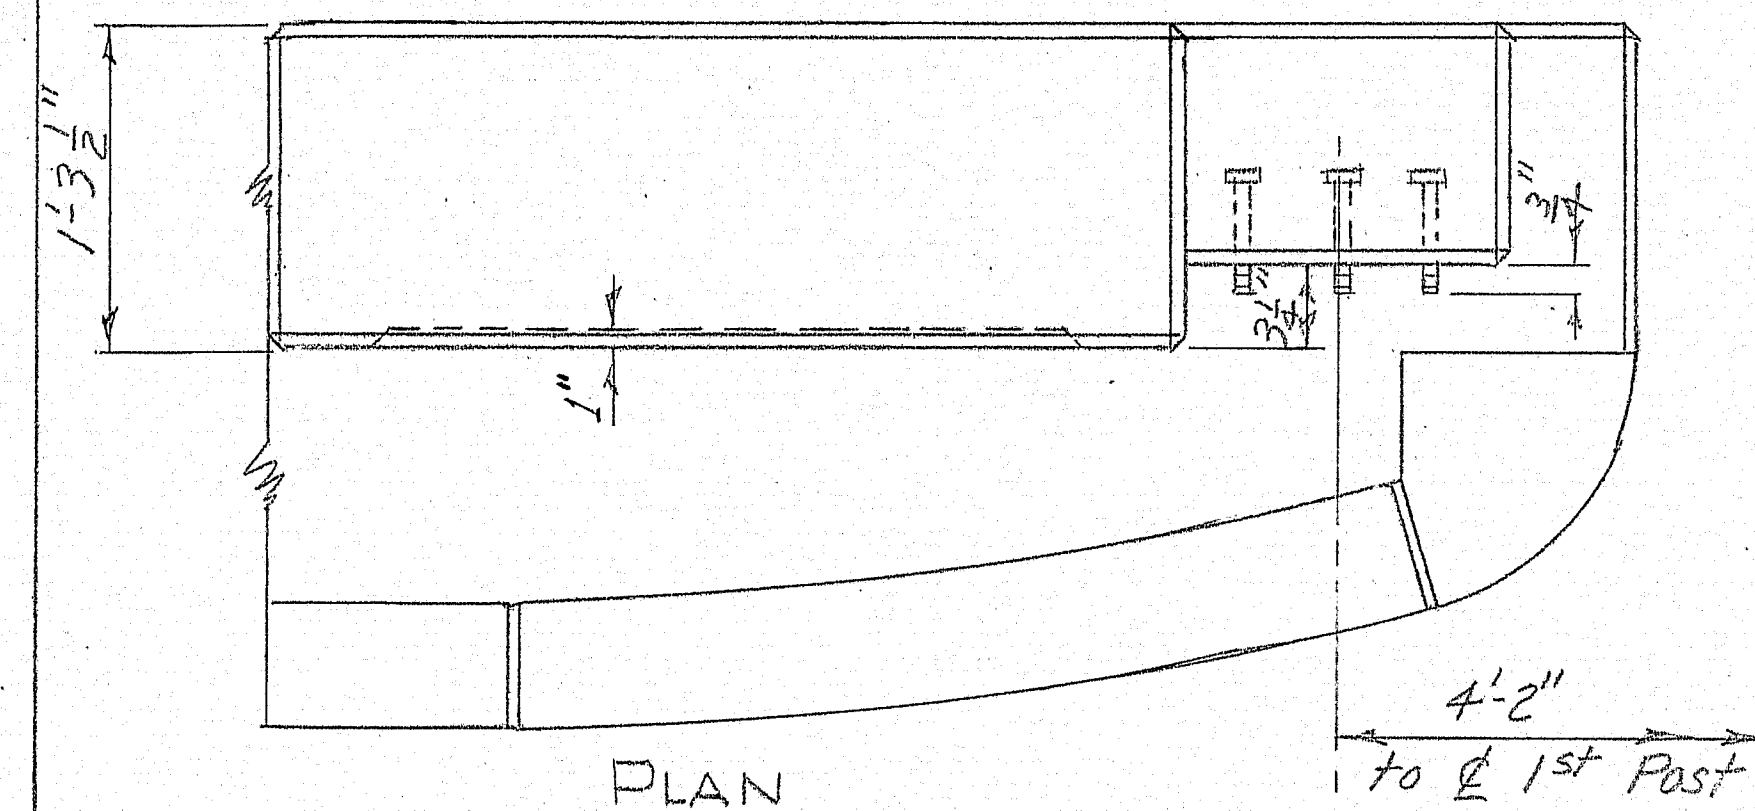

ELEVATION
NOTE: Revise posts & install plaques at same
corners as previously located.

133:9