



P.H.A. REG. NO.	STATE	PROJECT NUMBER	SHEET NO.	TOTAL SHEETS
1	MAINE			

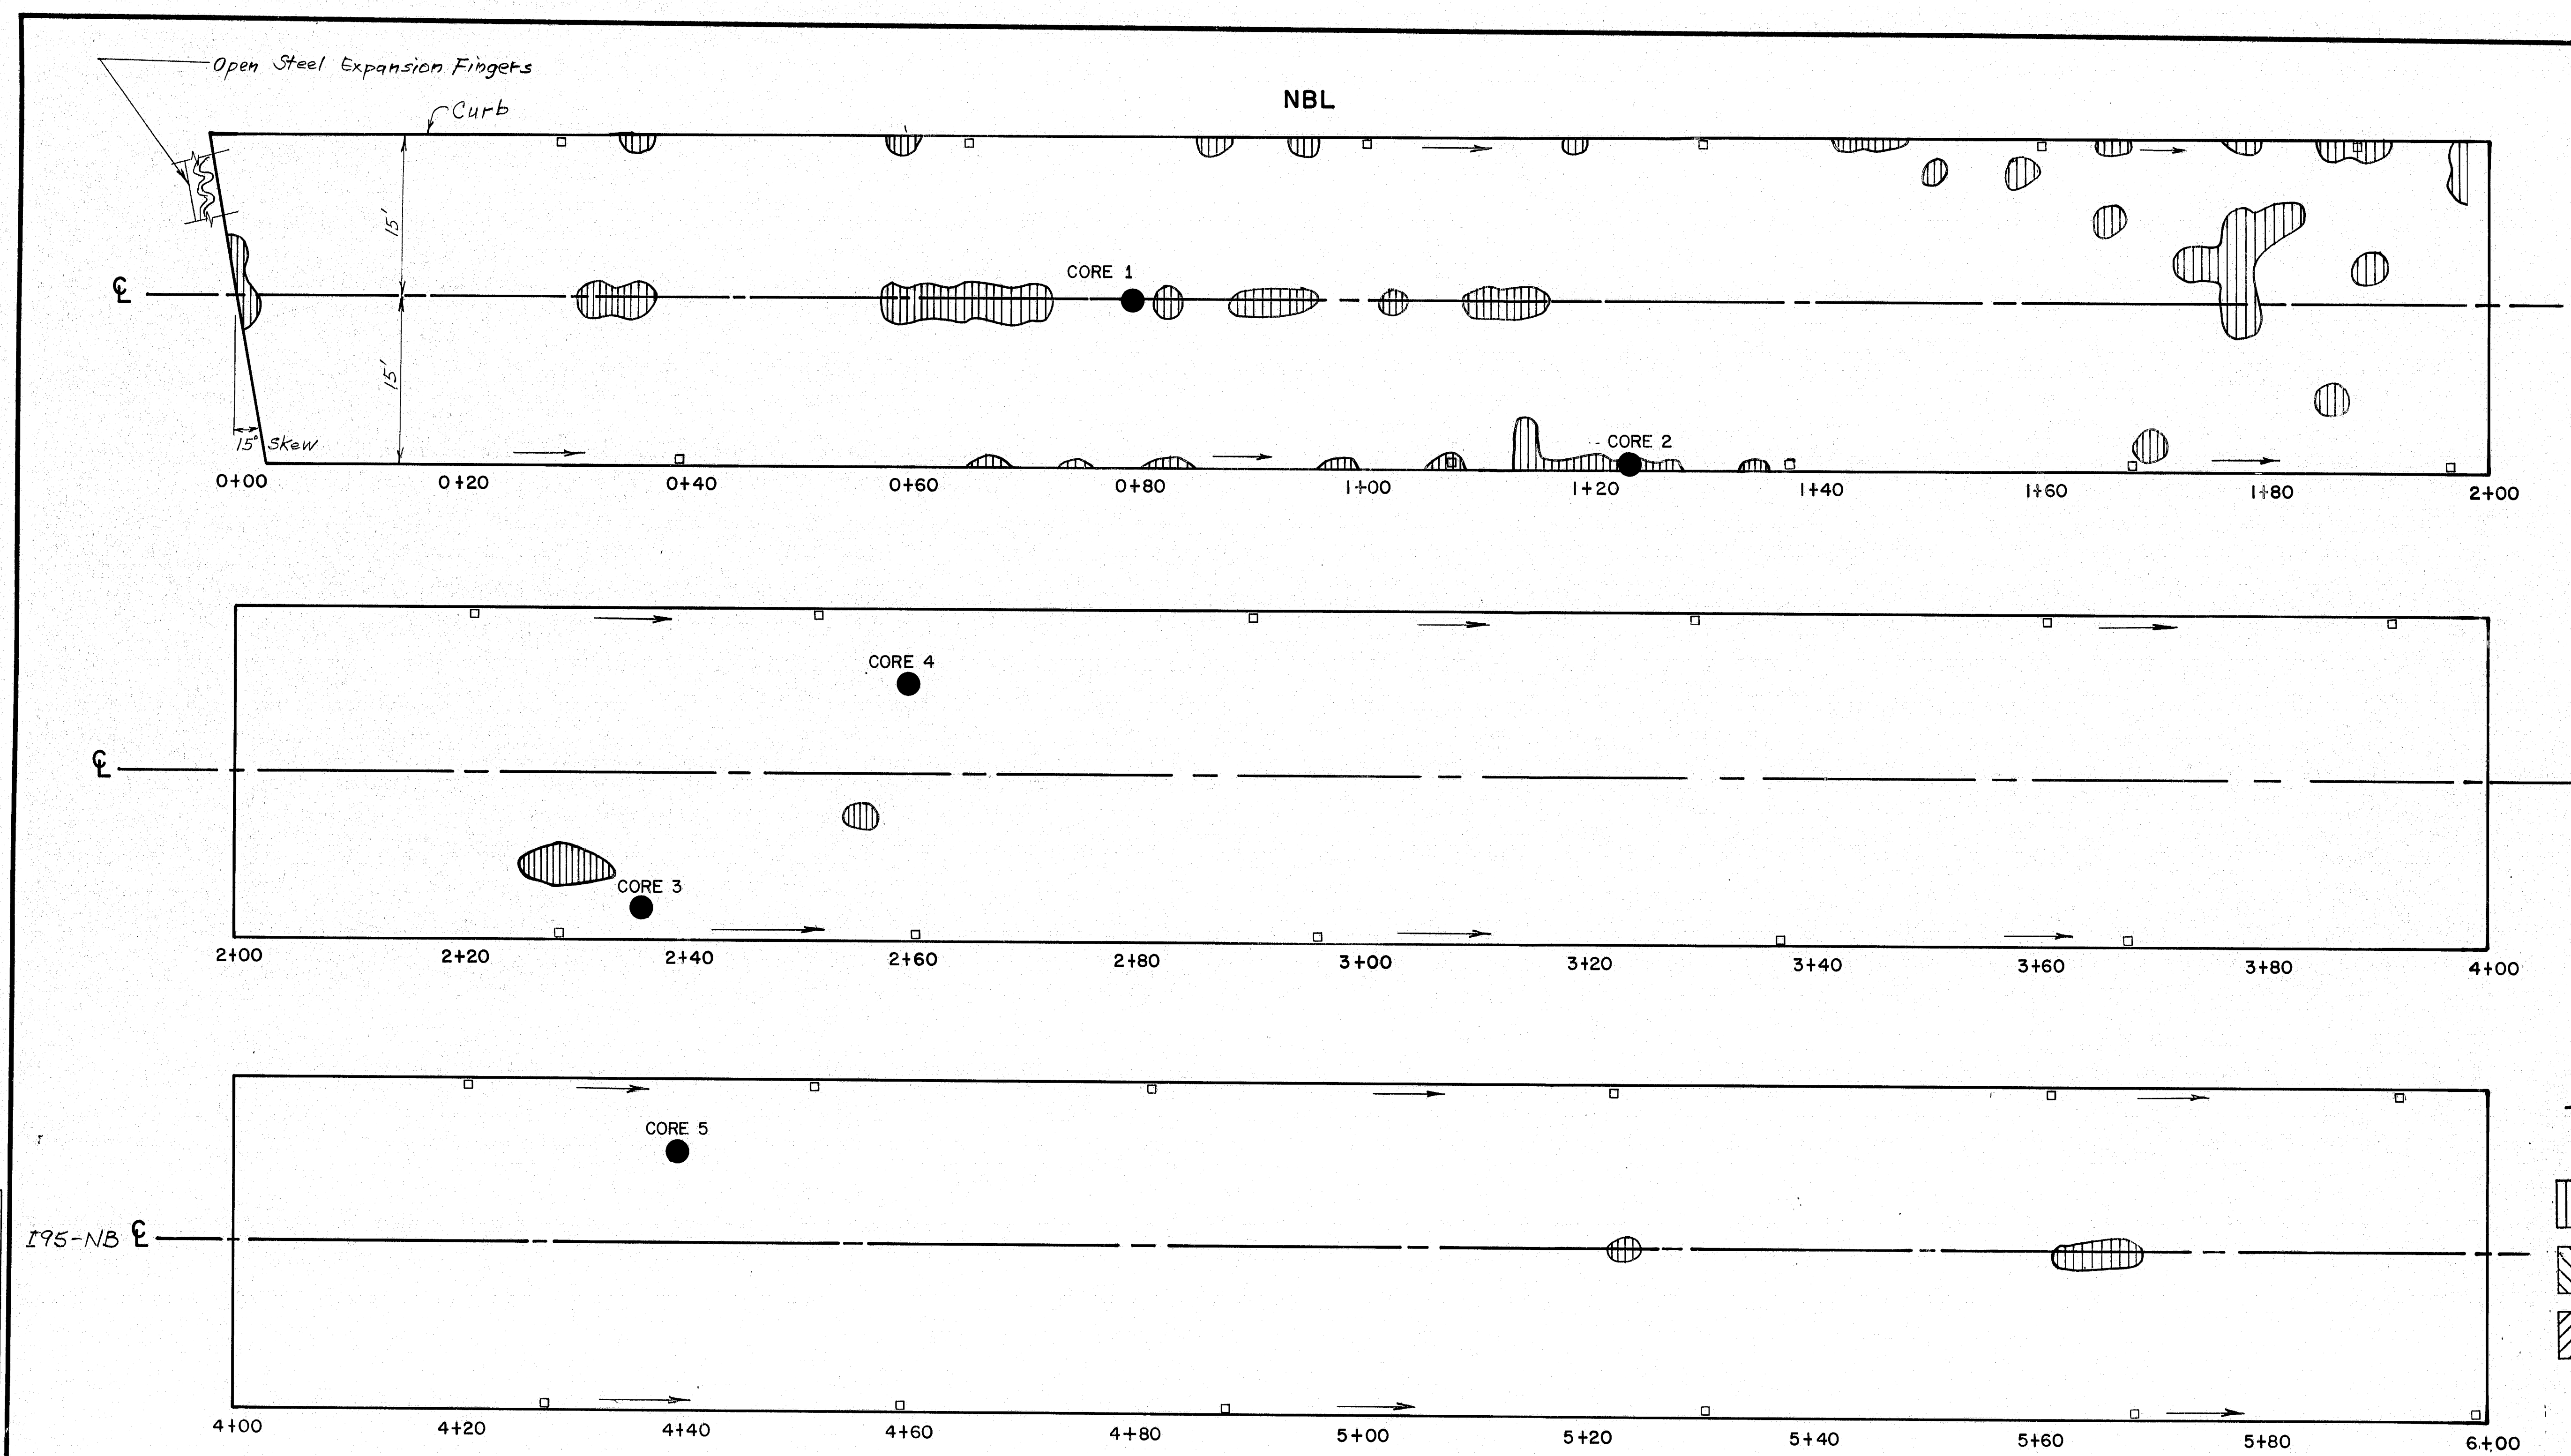

PLAN

LEGEND

- ← DIRECTION OF DRAINAGE
- BRIDGE DRAIN
- ▨ 0.30-0.39 VOLTS
- ▧ 0.40-0.49 VOLTS
- ▩ 0.50-0.59 VOLTS
- 0.60-0.69 VOLTS
- 0.70-0.79 VOLTS
- ▬ 0.80-0.89 VOLTS

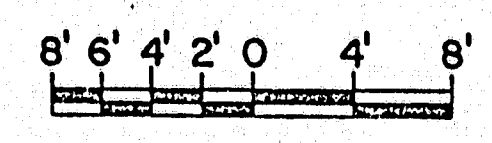

PERCENT OF DECK READINGS						
STATIONING	ALL READINGS ABOVE THESE VOLTS					
	0.30	0.40	0.50	0.60	0.70	0.80
0+00 - 10+50	3.8%	—	—	—	—	—

NOTE: AVERAGE OF ALL READINGS ON THE BRIDGE IS 0.14

PROJECT DESIGN ENGINEER	BY	DATE
DESIGN - DETAILED	CDH	8-84
CHECKED	TR	
REVISIONS	CDH	10-15-84
PLANS		





STATE OF MAINE  
DEPARTMENT OF TRANSPORTATION

BRIDGE DECK EVALUATION  
(VOLT-METER SURVEY)  
DAGGETT MEMORIAL BRIDGE #B  
IN THE TOWN OF  
MEDWAY

119-378

SHEET 1 OF 4 AUGUSTA, MAINE

F.W.A. REG. NO.	STATE	PROJECT NUMBER	SHEET NO.	TOTAL SHEETS
1	MAINE			

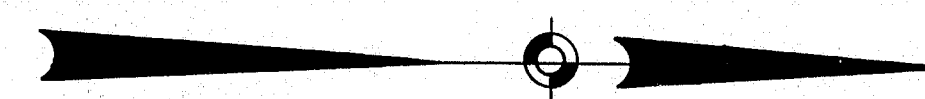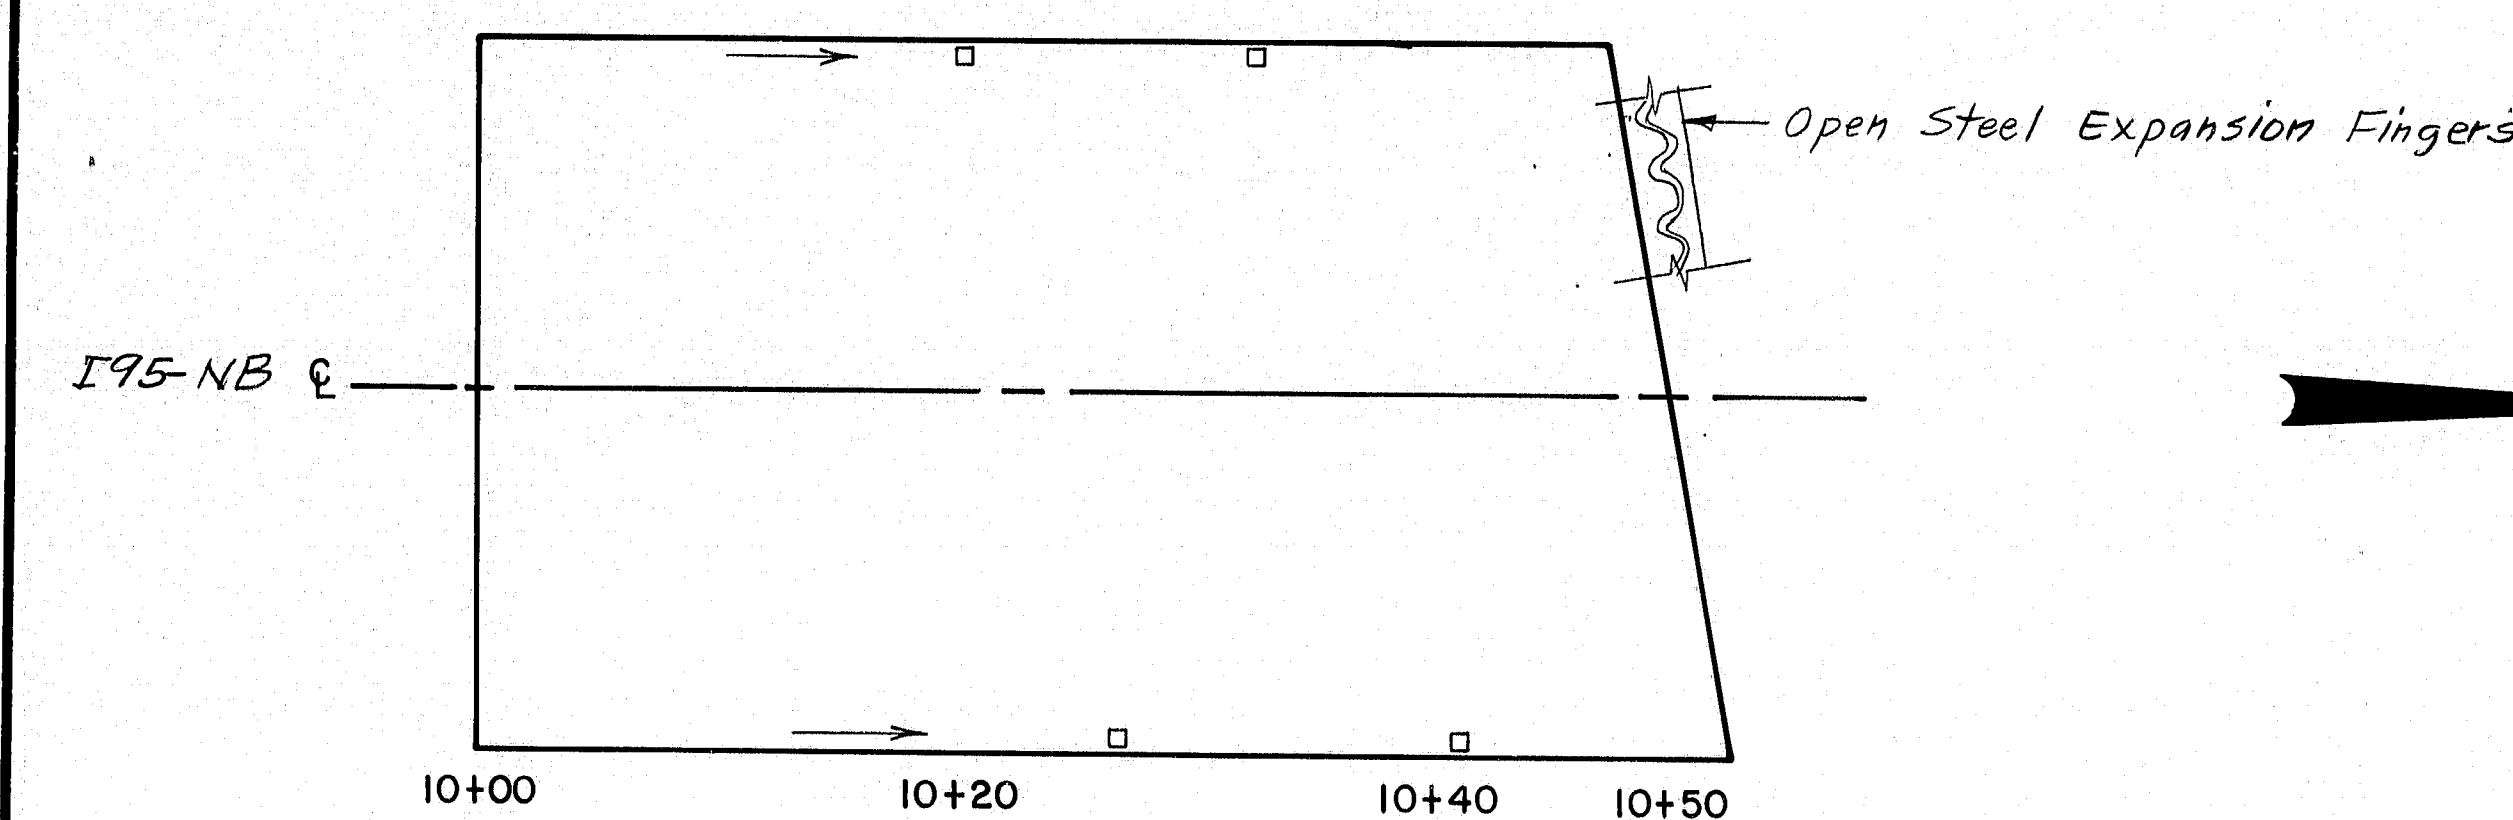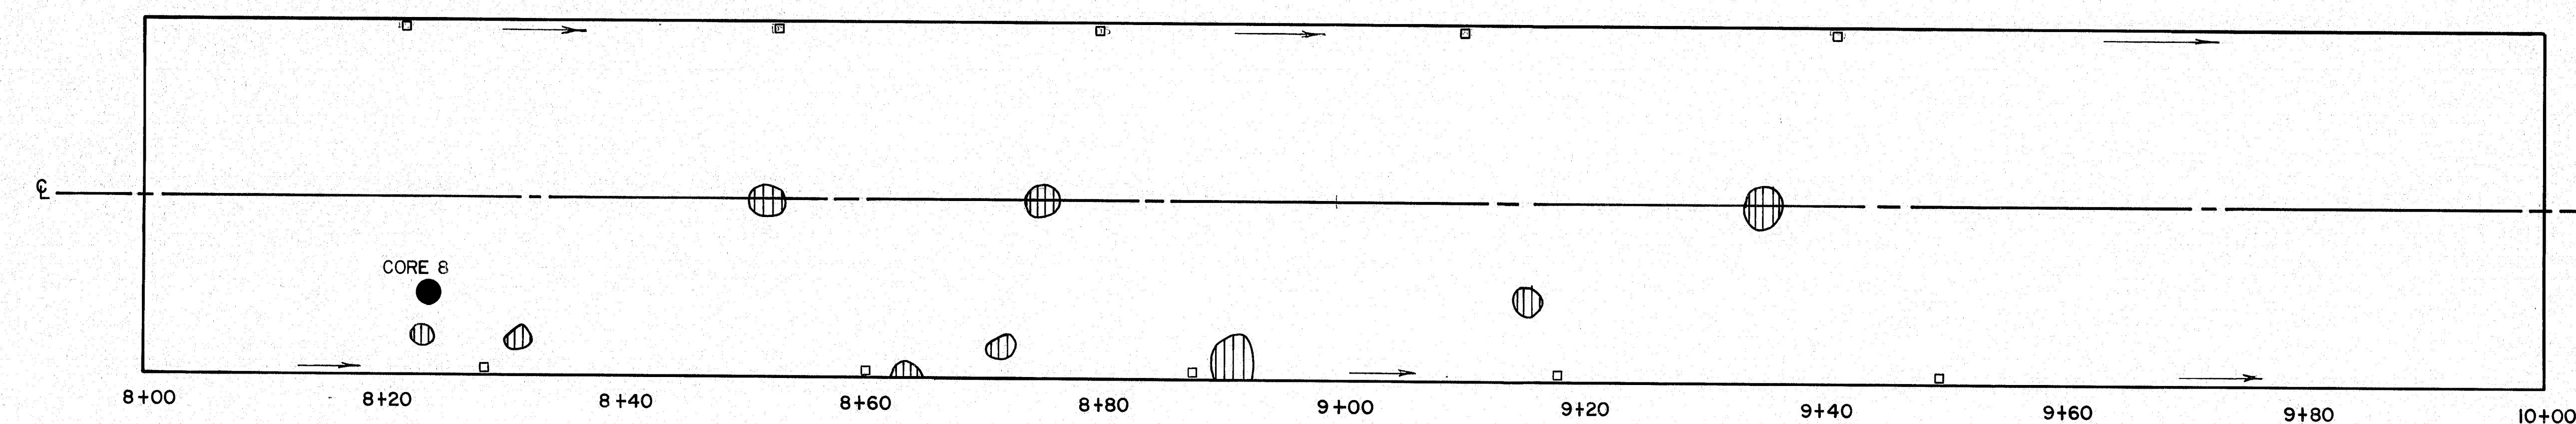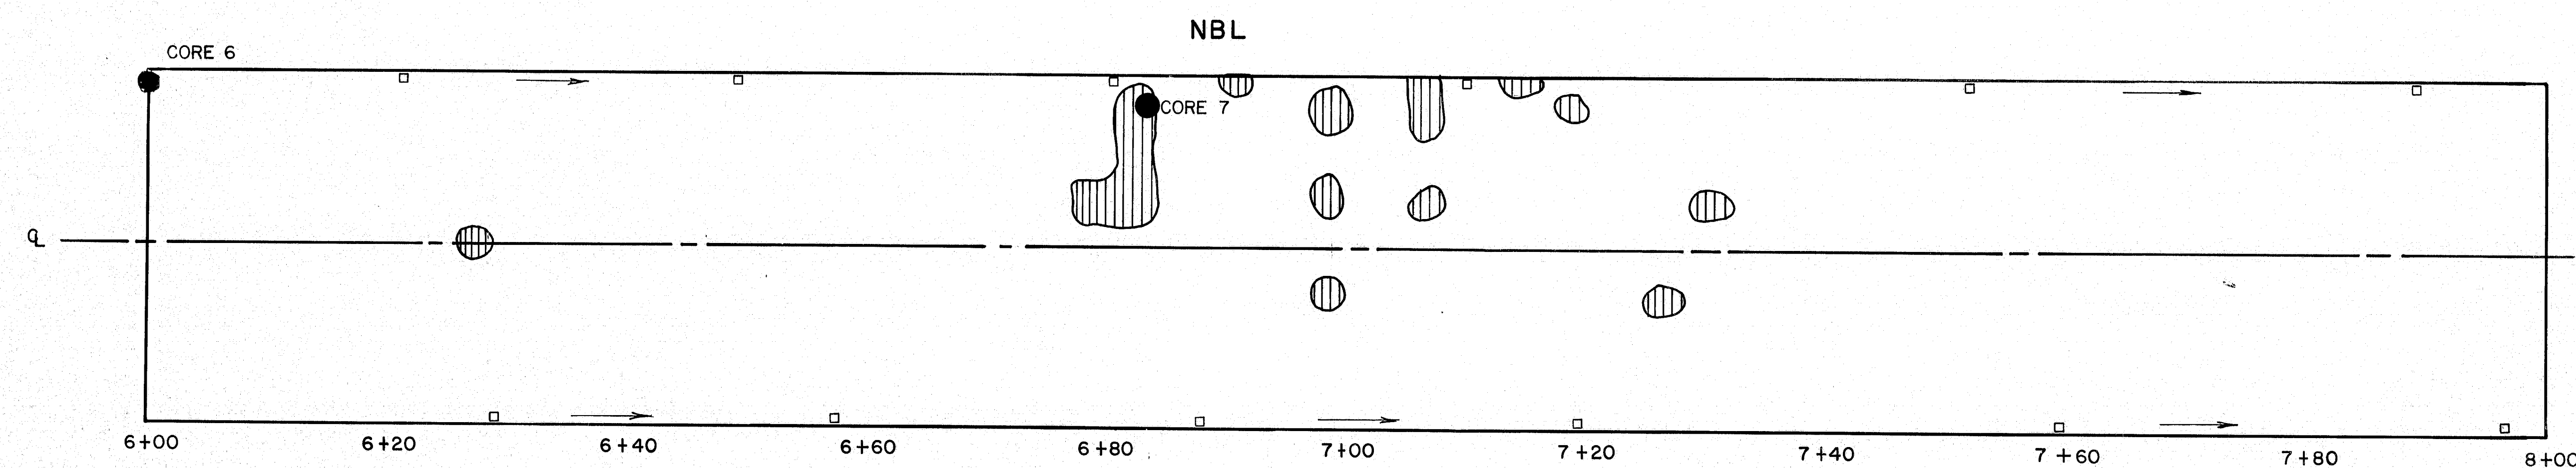

PLAN

PROJECT DESIGN ENGINEER	BY	DATE
DESIGN - DETAIL	CDH	8-84
CHECKED	TR	10-84
REVISIONS	CDH	
FIELD CHANGES		


STATE OF MAINE DEPARTMENT OF TRANSPORTATION	
BRIDGE DECK EVALUATION (VOLT-METER SURVEY) DAGGETT MEMORIAL BRIDGE-NB IN THE TOWN OF MEDWAY	
SHEET 2 OF 4	AUGUSTA, MAINE JULY 1984

119-379

DRAWING 44-132-4710




F.R.M.A. REG. NO.	STATE	PROJECT NUMBER	SHEET NO.	TOTAL SHEETS
1	MAINE			

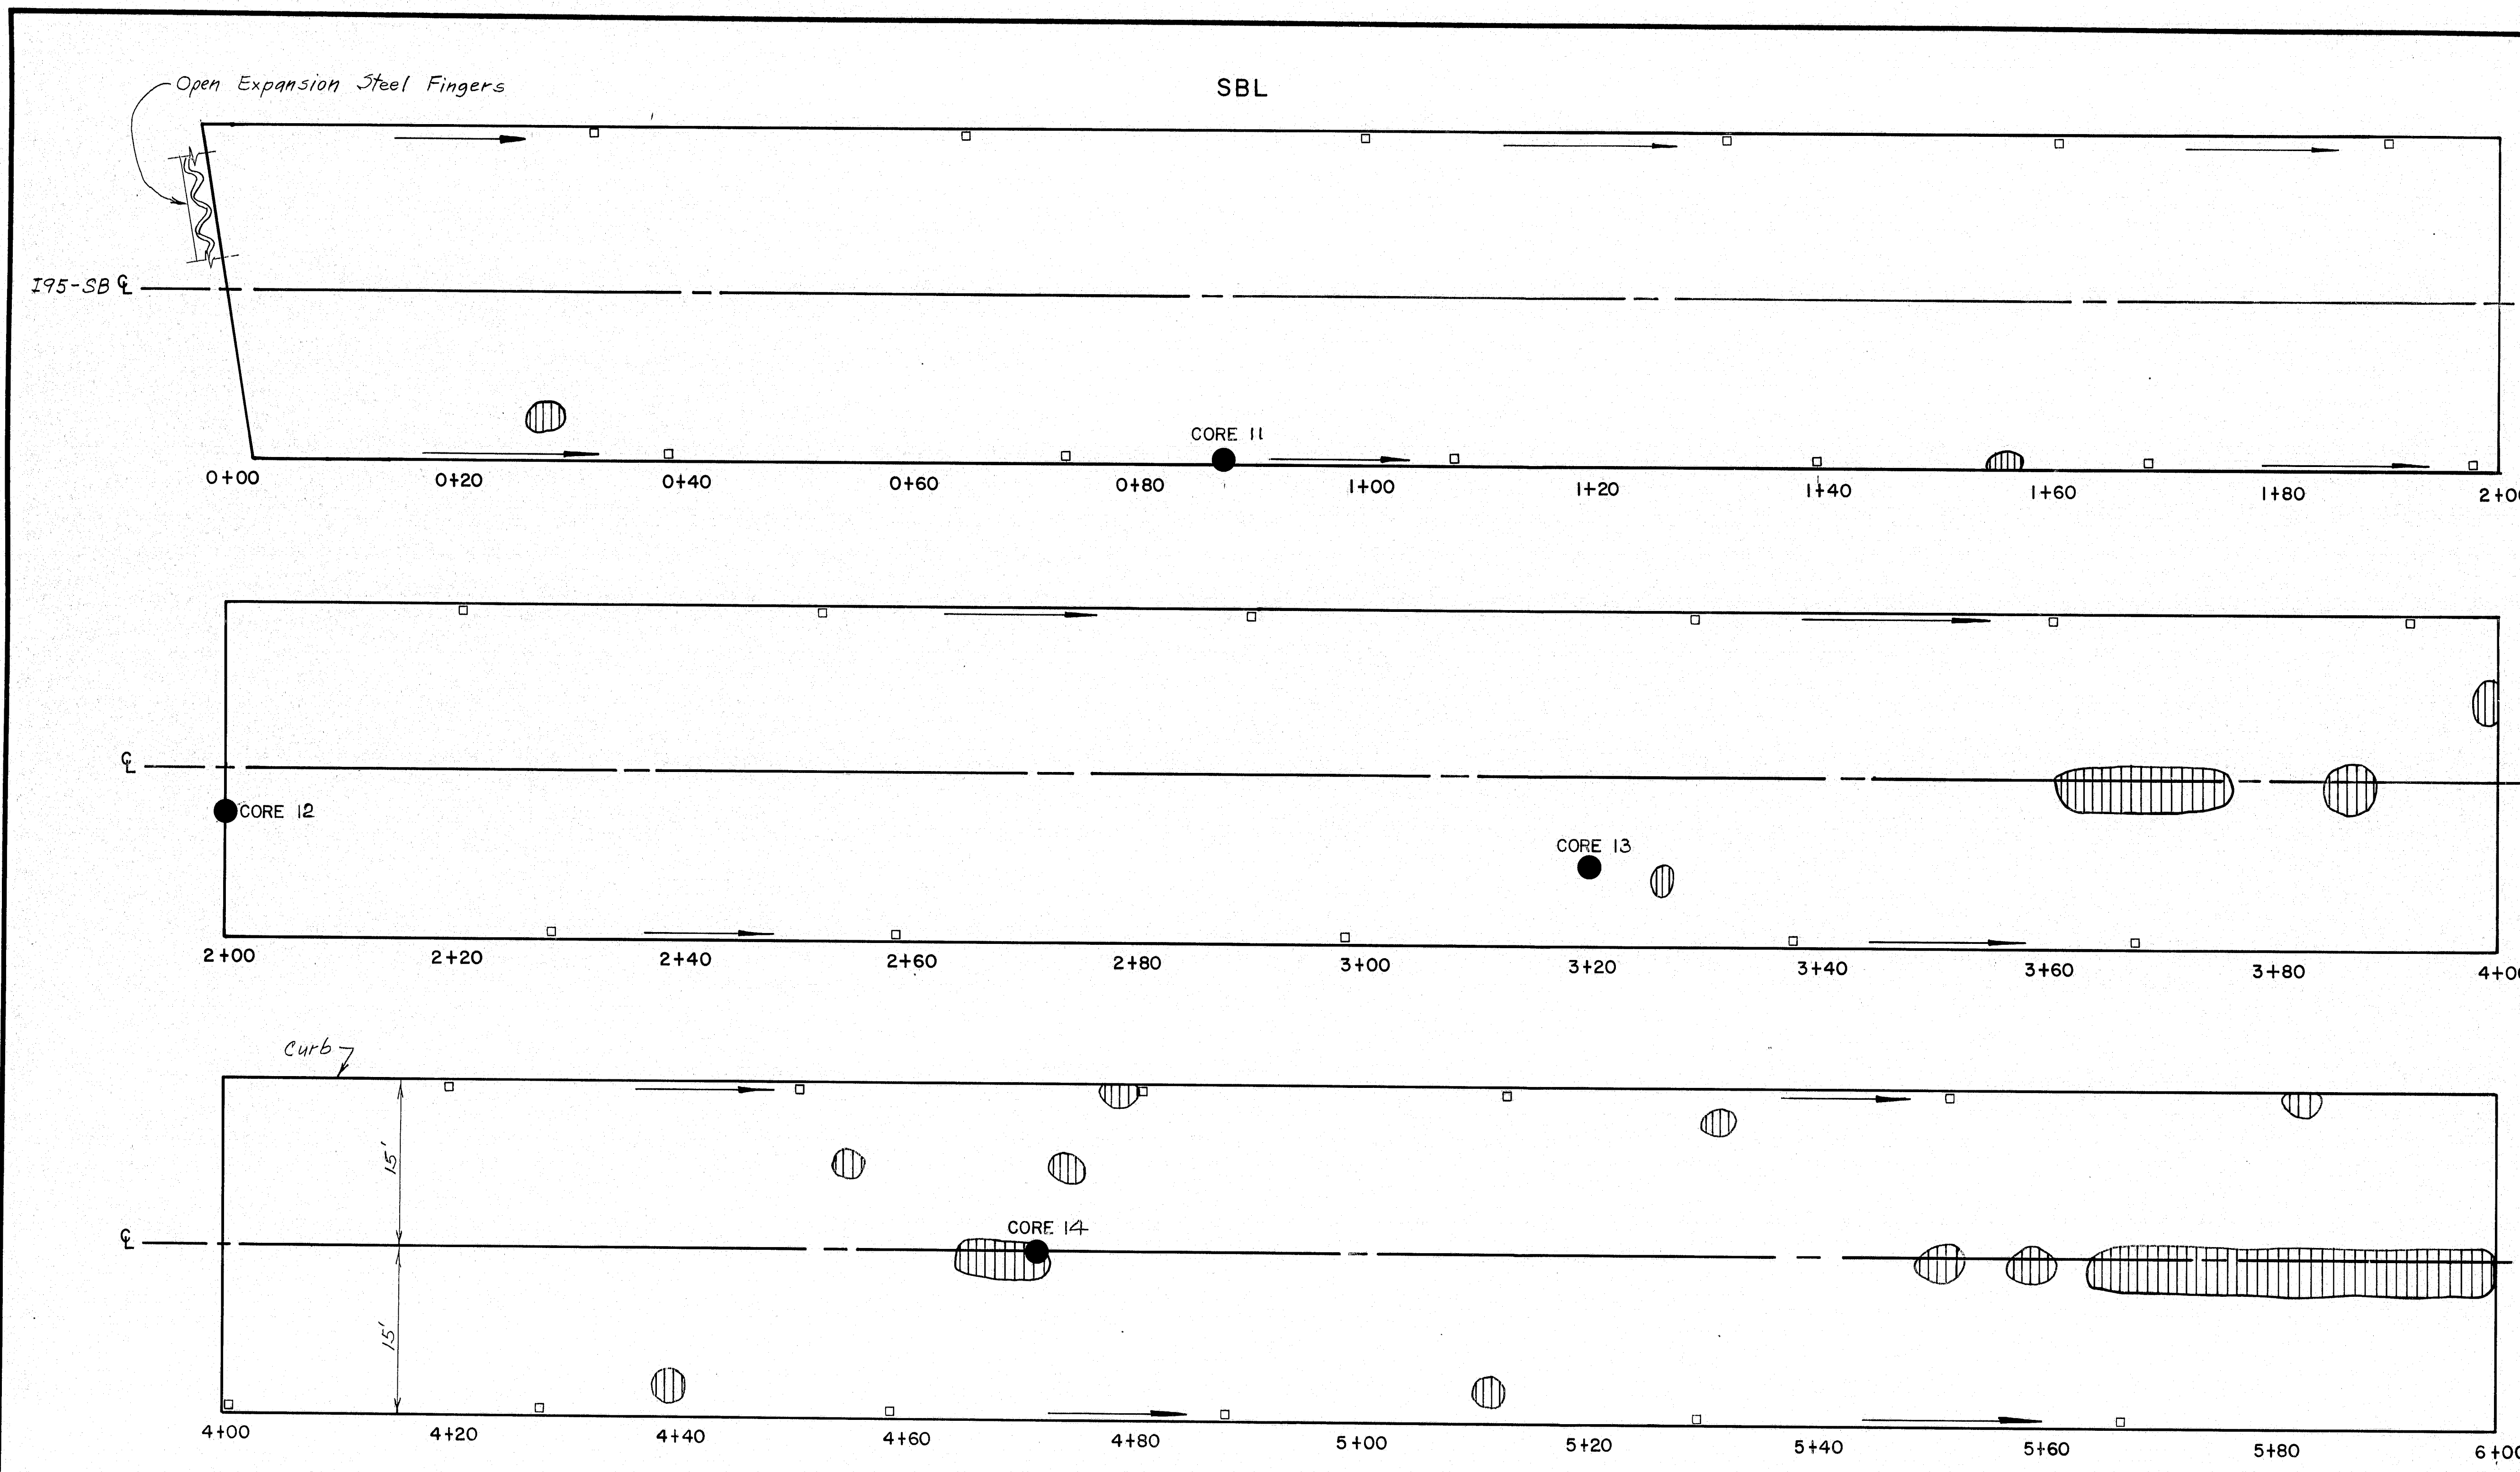

# LEGEND

- ← DIRECTION OF DRAINAGE
- BRIDGE DRAIN
- 0.30-0.39 VOLTS
- 0.40-0.49 VOLTS
- 0.50-0.59 VOLTS
- 0.60-0.69 VOLTS
- 0.70-0.79 VOLTS
- 0.80-0.89 VOLTS

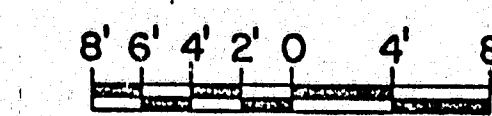

PERCENT OF DECK READINGS							
ALL READINGS ABOVE THESE VOLTS							
STATIONING	0.30	0.40	0.50	0.60	0.70	0.80	
0+00 - 10+00	3.5%	0.12%	-	-	-	-	-

NOTE: AVERAGE OF ALL READINGS ON THE BRIDGE IS 0.18

STATE OF MAINE  
DEPARTMENT OF TRANSPORTATION




BRIDGE DECK EVALUATION  
(VOLT-METER SURVEY)  
DAGGETT MEMORIAL BRIDGE-SB  
IN THE TOWN OF  
MEDWAY

119-380

PROJECT DESIGN ENGINEER	BY	DATE
DESIGN-DETAILED	CHH	7/8/84
CHECKED	CHH	7/8/84
REVISIONS		
FIELD CHANGES		

BRUNING 44132-2710

F.W.A. REG. NO.	STATE	PROJECT NUMBER	SHEET NO.	TOTAL SHEETS
1	MAINE			

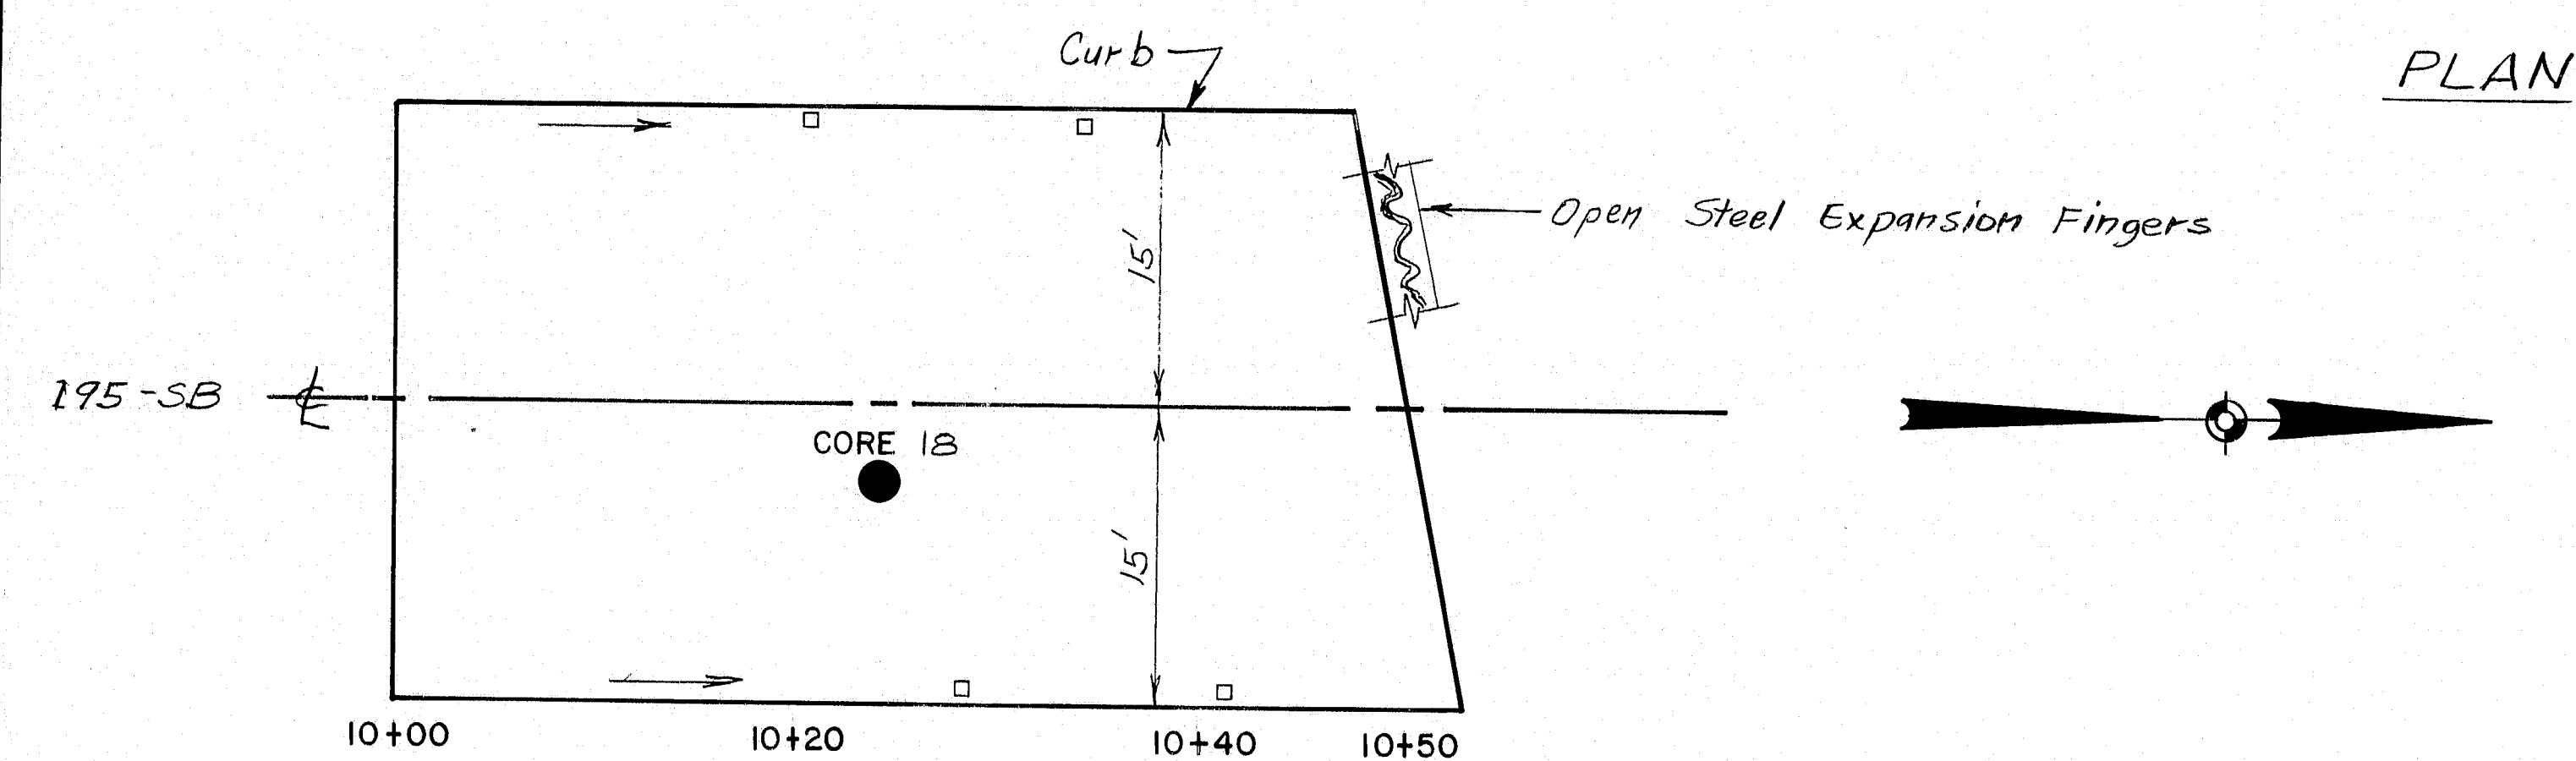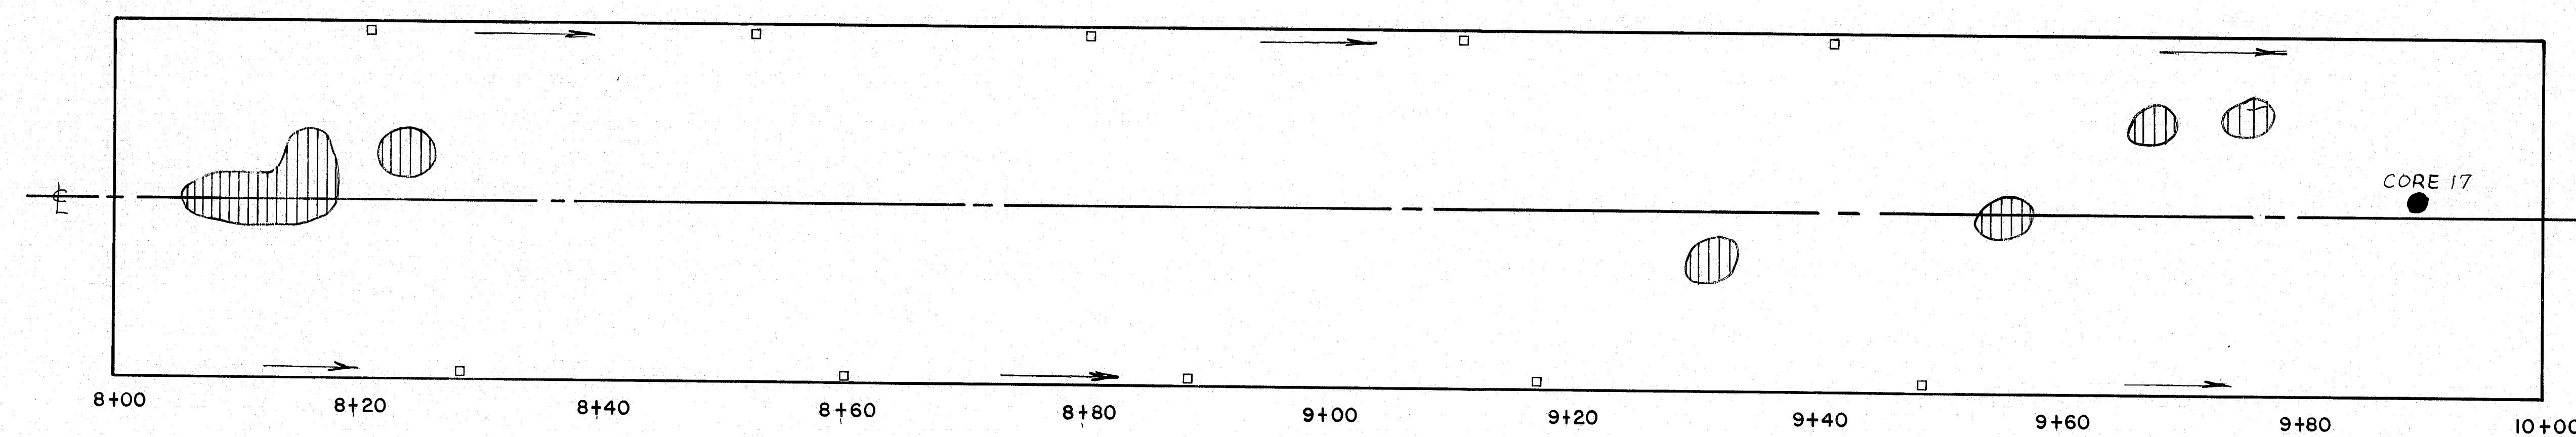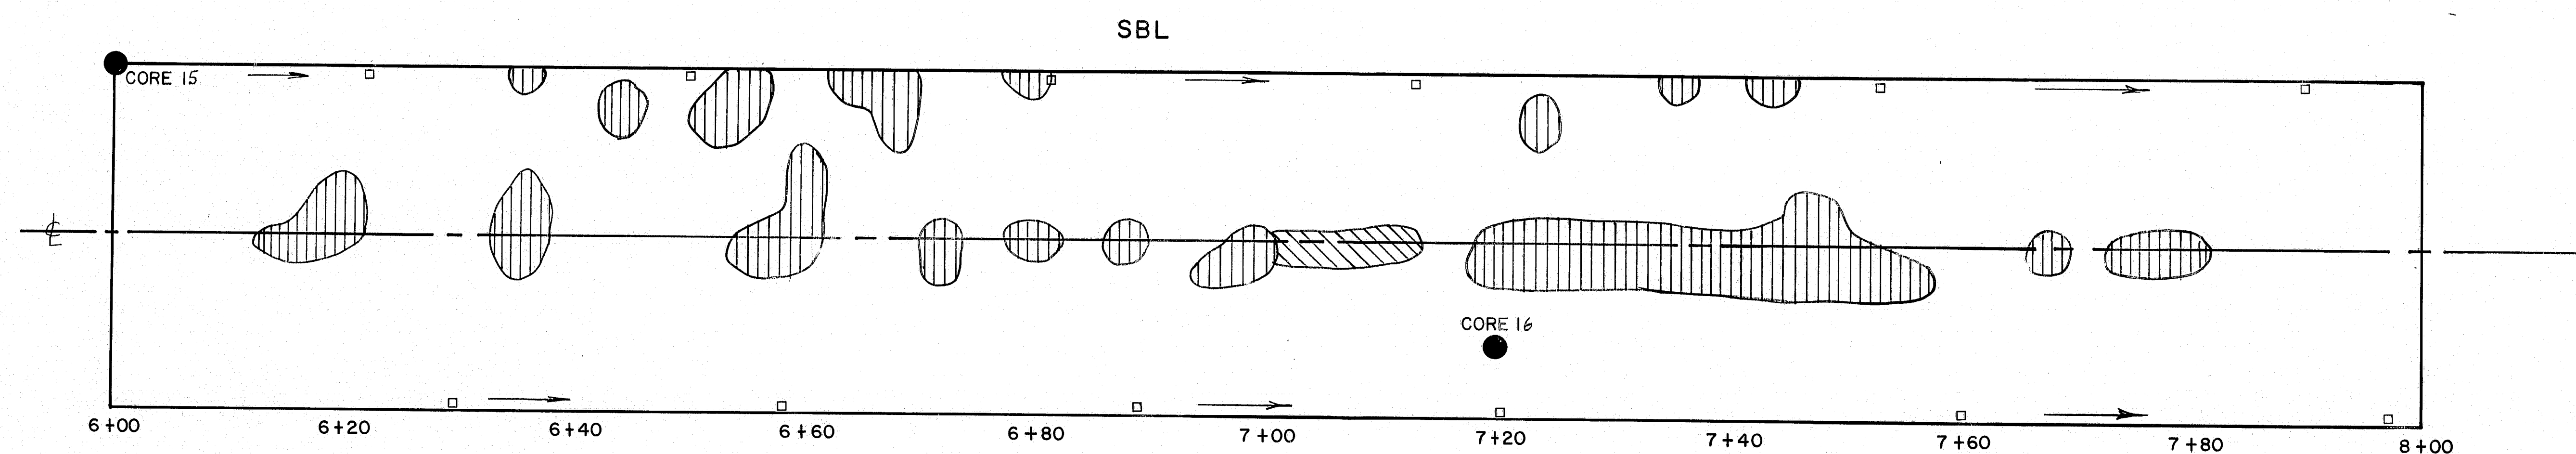

PLAN

PROJECT DESIGN ENGINEER	BY	DATE
DESIGN - DETAILED	CPH	8-84
CHECKED	TR	07-85
FIELD CHANGES	CDH	
PLANS		

BRUNING 44132 45710

STATE OF MAINE DEPARTMENT OF TRANSPORTATION
BRIDGE DECK EVALUATION (VOLT-METER SURVEY) DAGGETT MEMORIAL BRIDGE-SB IN THE TOWN OF MEDWAY
119-381
SHEET 4 OF 4 AUGUSTA, MAINE JULY 1984