


DATE	2/1/57
BY	W. J. B.
CHECKED	
APPROVED	

DATE	2/1/57
BY	W. J. B.
CHECKED	
APPROVED	

U. S. N. NO.	STATE	PROJECT NUMBER	SHEET NO.	TOTAL
1	MAINE	1-95-8(62)	41	93

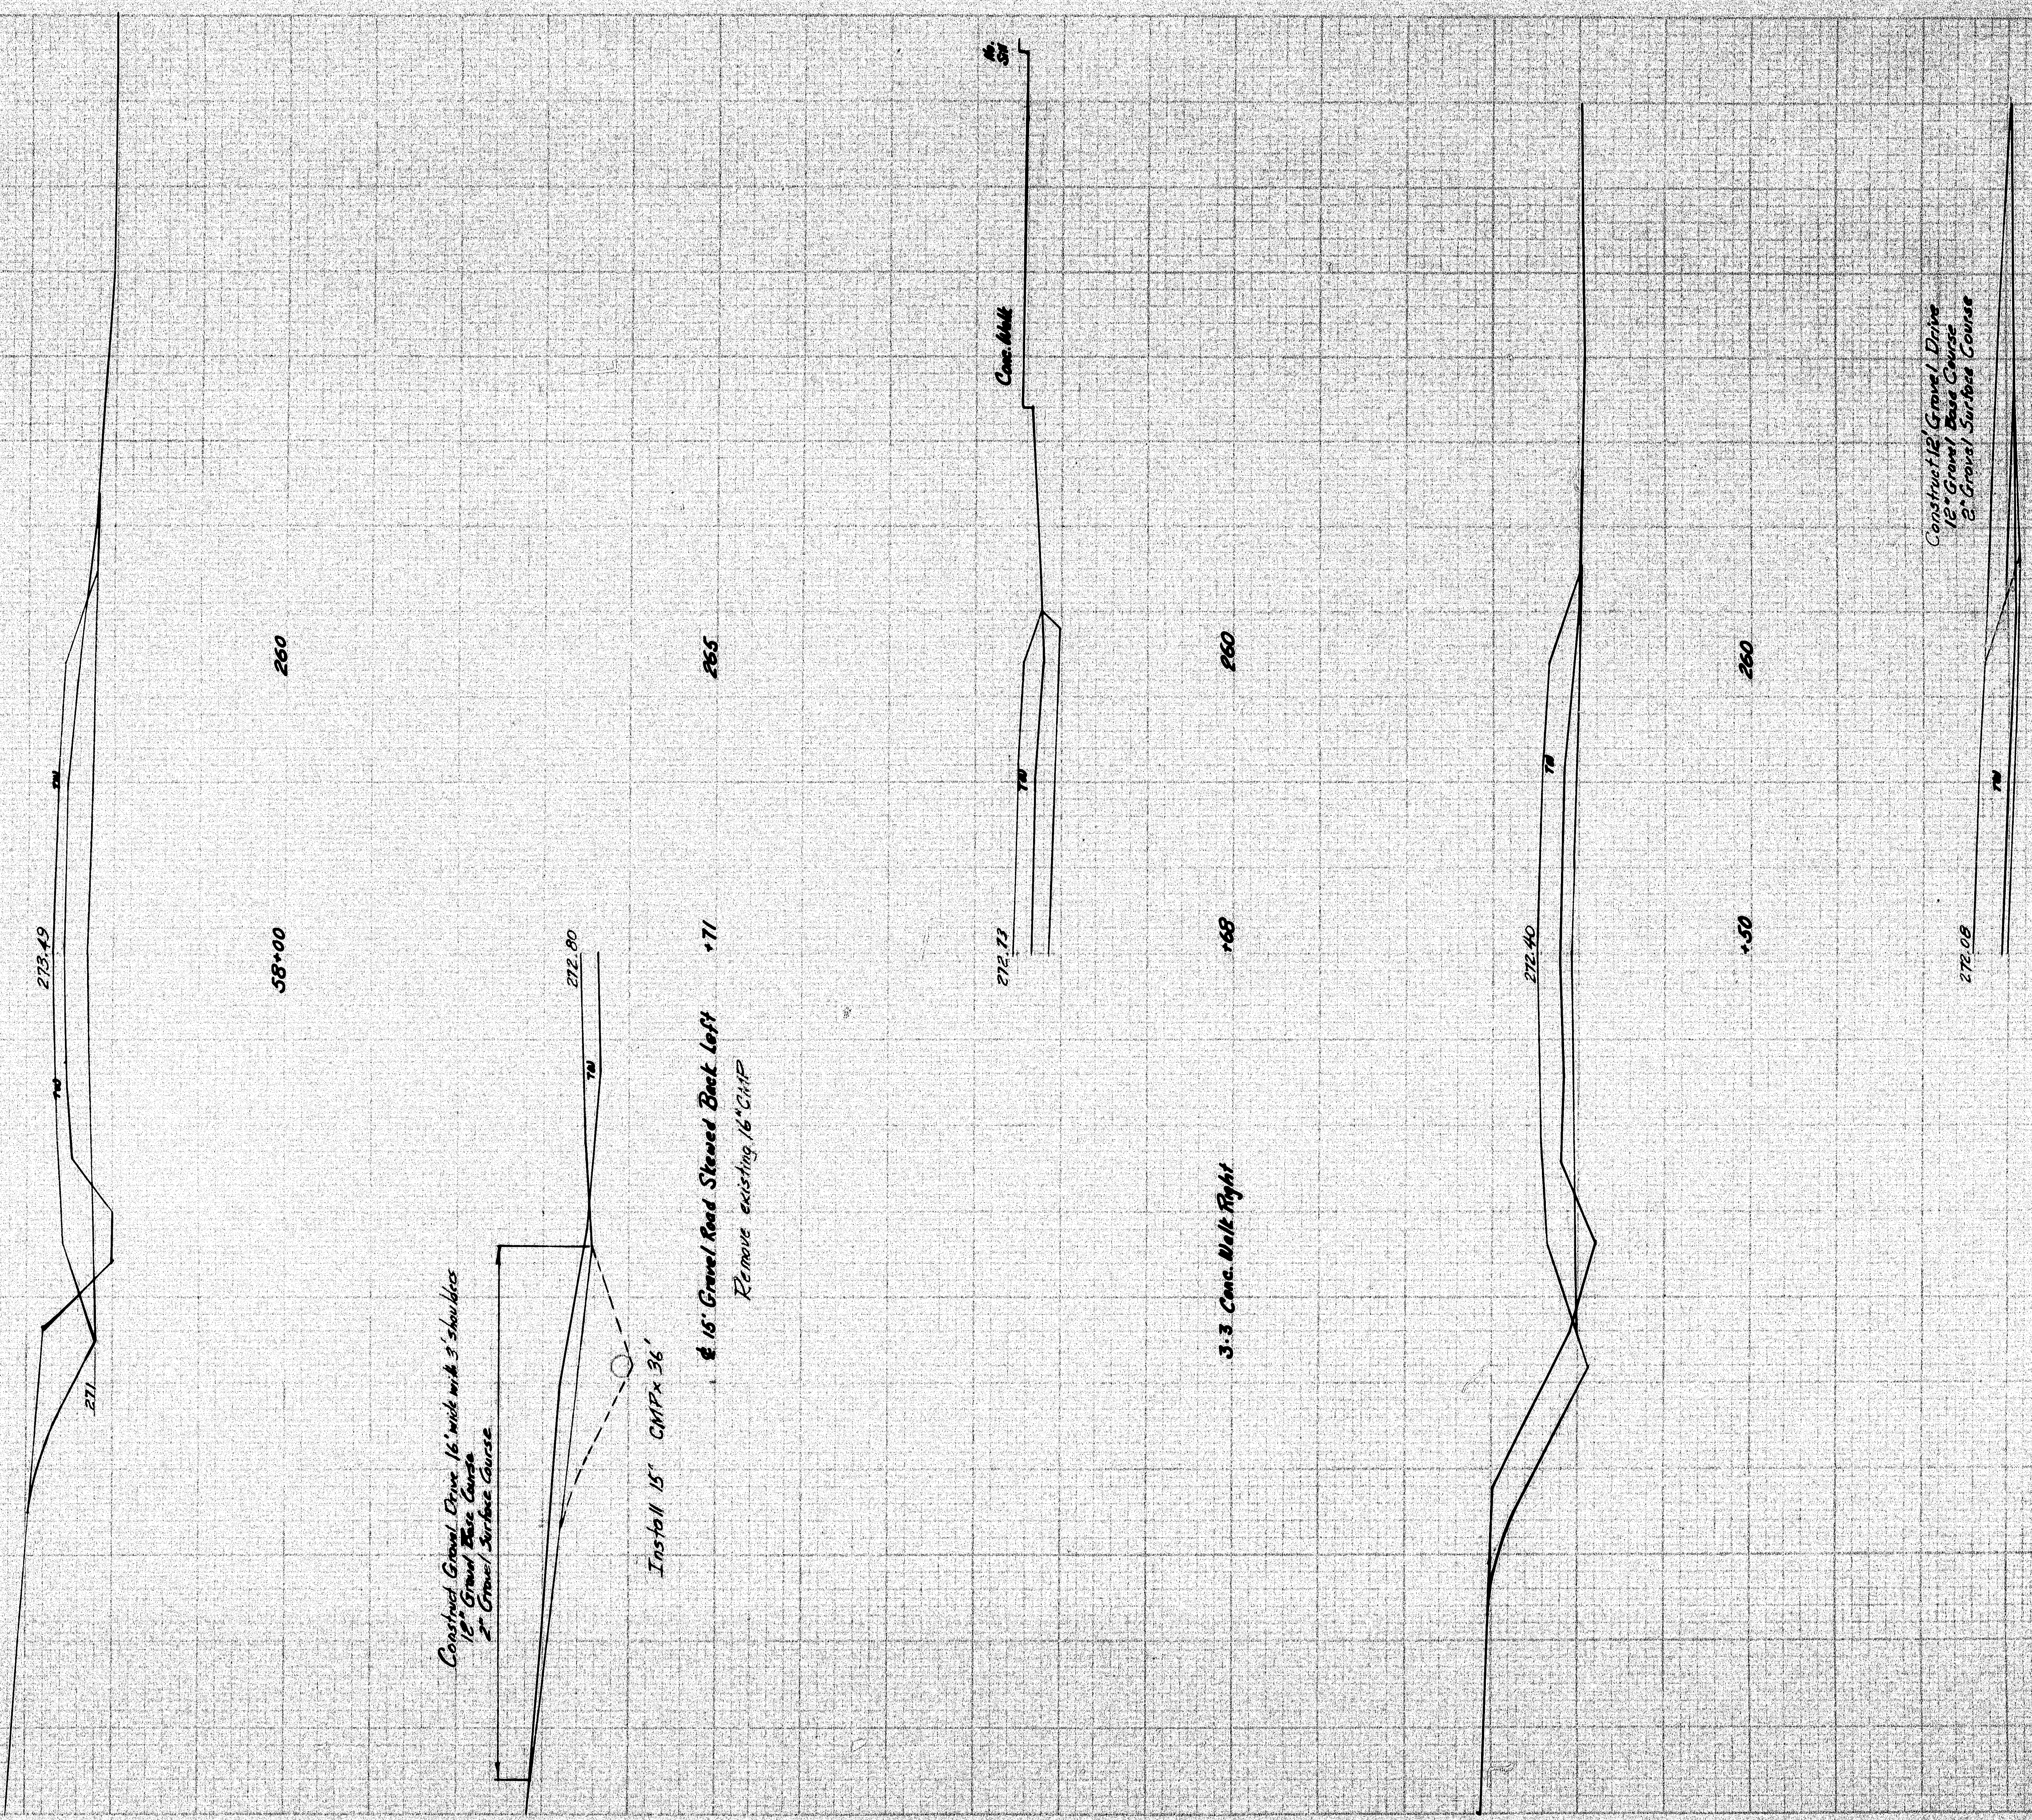

Construct Gravel Drive 16' wide with 3' shoulders
12' Gravel Base Course
2' Gravel Surface Course

Install 15' CMPx 36'

15' Gravel Road Shoulder Back Left
Remove existing 16" CMP

3.3' Conc. Wall Right


Construct 12' Gravel Drive
12' Gravel Base Course
2' Gravel Surface Course

Gravel Shoulder R. Gr. 15' 6.5' R. elev. 269.55

Revised


SCALE
Hor. & Vert. 1" = 5'

Route No. 116 Madaw

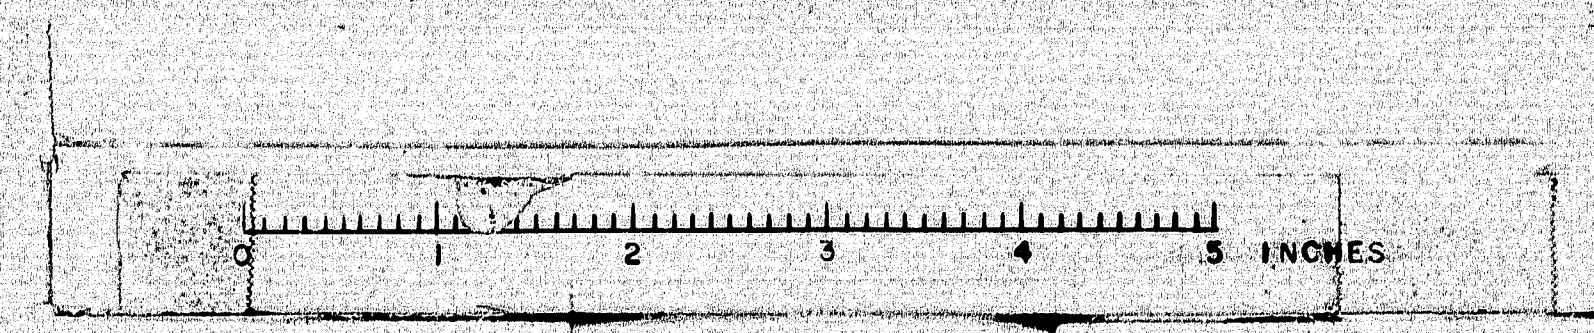

See Drawing 58-00

ORIGINAL	23	0477
SLAVE		
RECEIVED		
NOTED		
REMARKS		
RECEIVED		

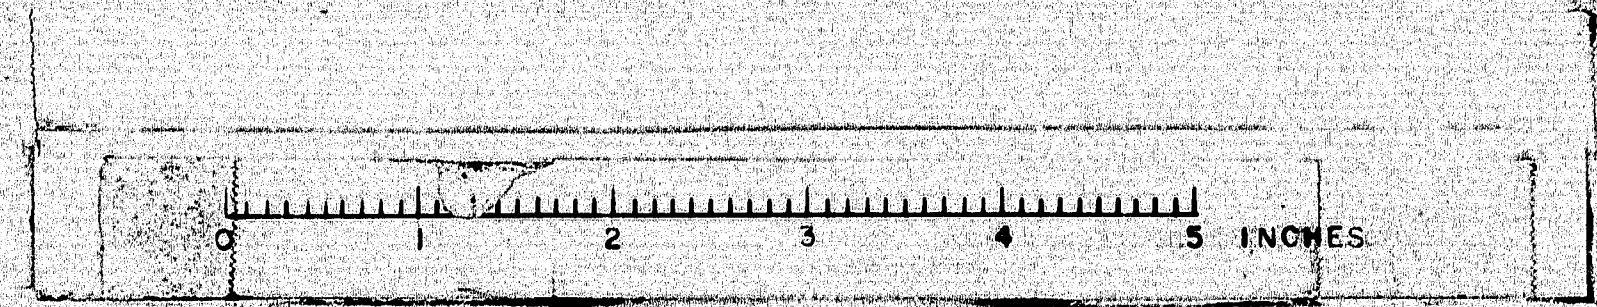

Sections using Revised Grade Line
(See Sheets 35 & 36)
HRS. 7-10-65

SCALE
Hor. & Vert. 1" = 5'

Route No. 116 Medway

0545-0510

DATE	BY	CHKD

DATE	BY	CHKD

B. P. N.	STATE	PROJECT NUMBER	SHEET NO.	TOTAL SHEETS
1	MAINE		41B	

Install 36" ACCMP x 60' with Metal Endwall on Left @ Sta 54+25
 Inv. El. 264.5 Left
 Inv. El. 262.0 Right
 Place Hand Load Riser
 Grouted around Inlet & Outlet

Warp Slope at Pipe 2:1 to 1:1 Metal Endwall

Hand Load Riser
 Grouted Ditch @ Pipe
 (See Survey Plan - Sheet 11)

2:1 Slope @ Pipe 7

Hand Load Riser
 Grouted Ditch @ Pipe
 (See Survey Plan - Sheet 11)

12' Gravel Drive Left Skewed Ahead

Cul. Sept. 90' 15" x 30" CMP (No G.W.) - Remove


12' Gravel Entrance Right

Sections using Revised Grade Line
 (See Sheets 40B & 41B)
 H.R. 7-12-66


SCALE
 Hor. & Vert. 1" = 5'

Route No. 116 Medway

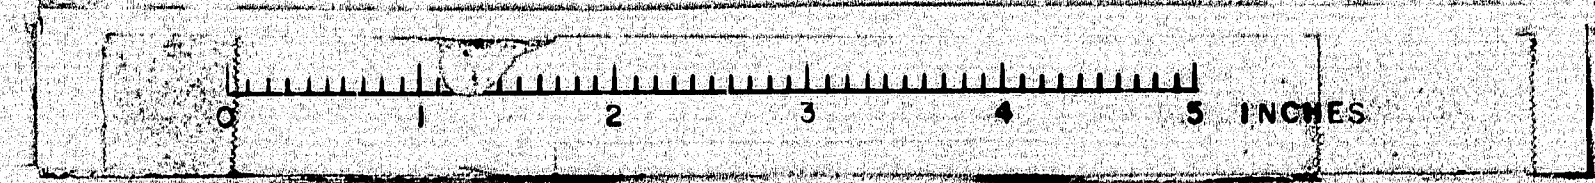



Sta 53+00 - 54+00

DATE	BY	REVISION




Sections using Revised Grade Line
(See Sheets 7-51 to 7-53)
HRS 7-12-65

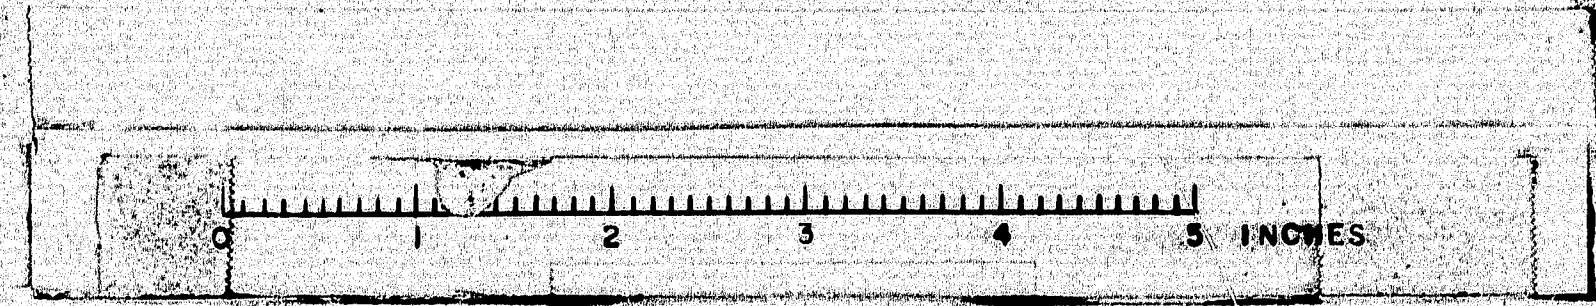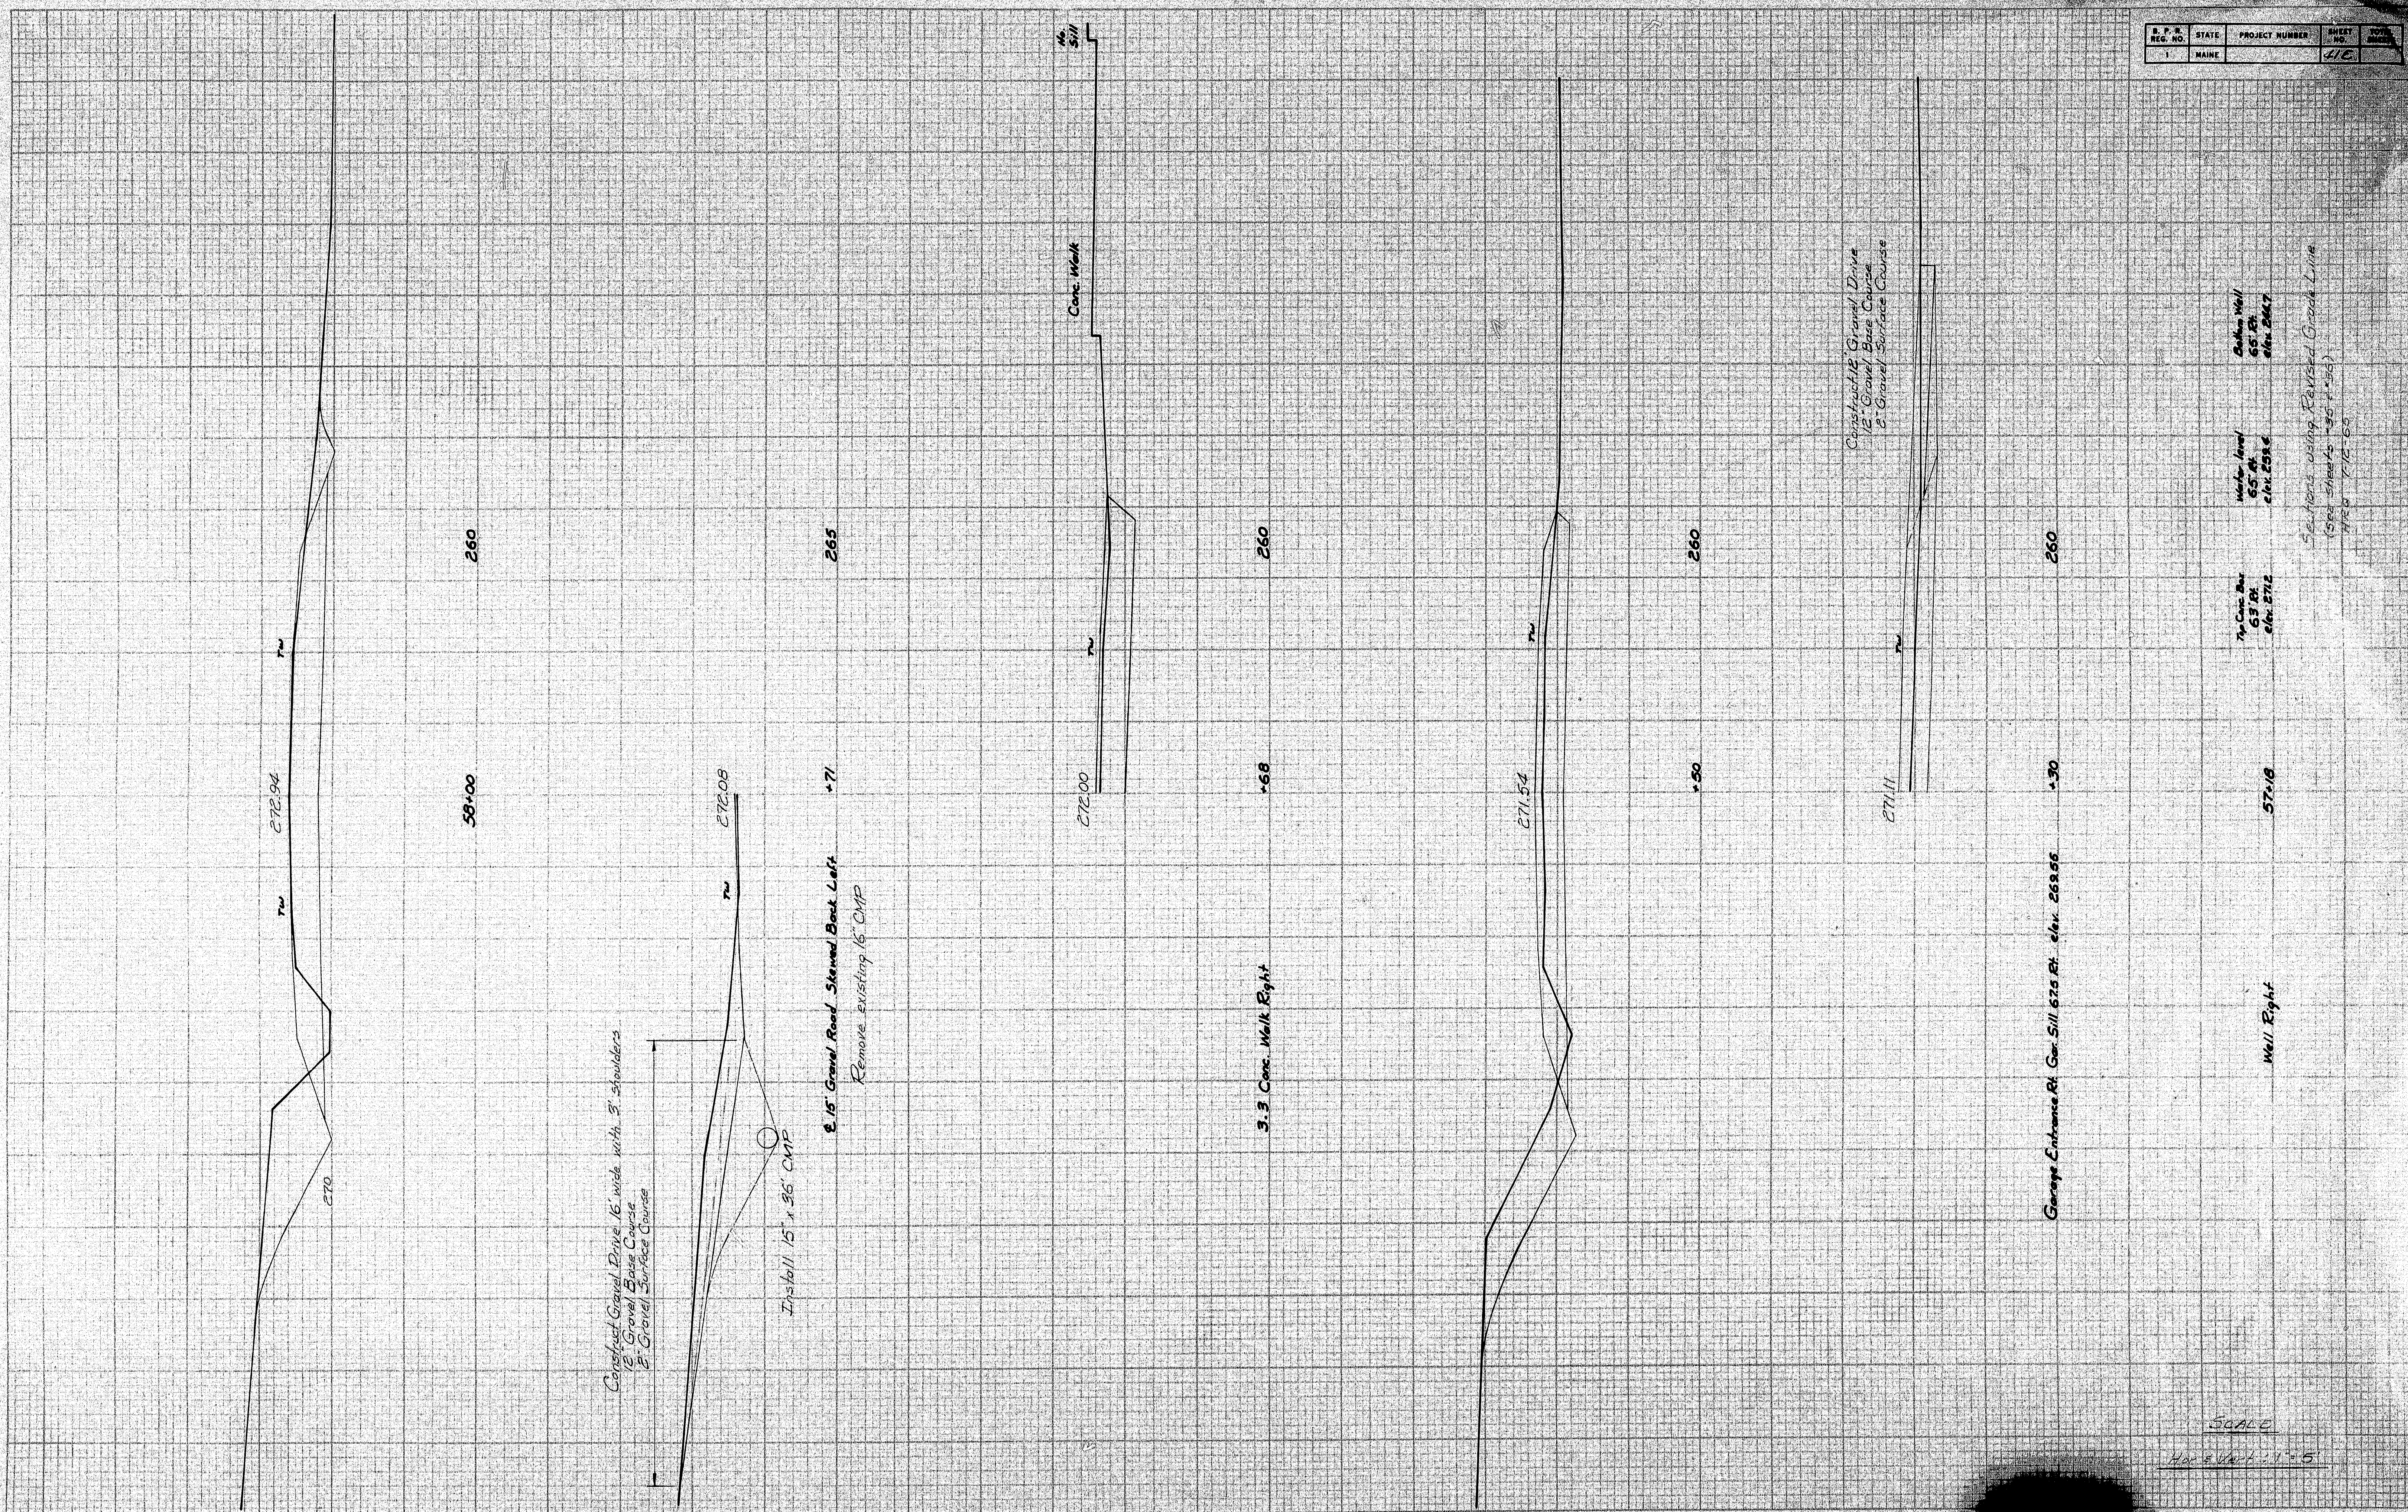

Excavate pavement, place 2" from, seed with Seeding Method No. 2, and place Hay Mulch on these areas of Existing Old Route 157 not otherwise obliterated by new construction.

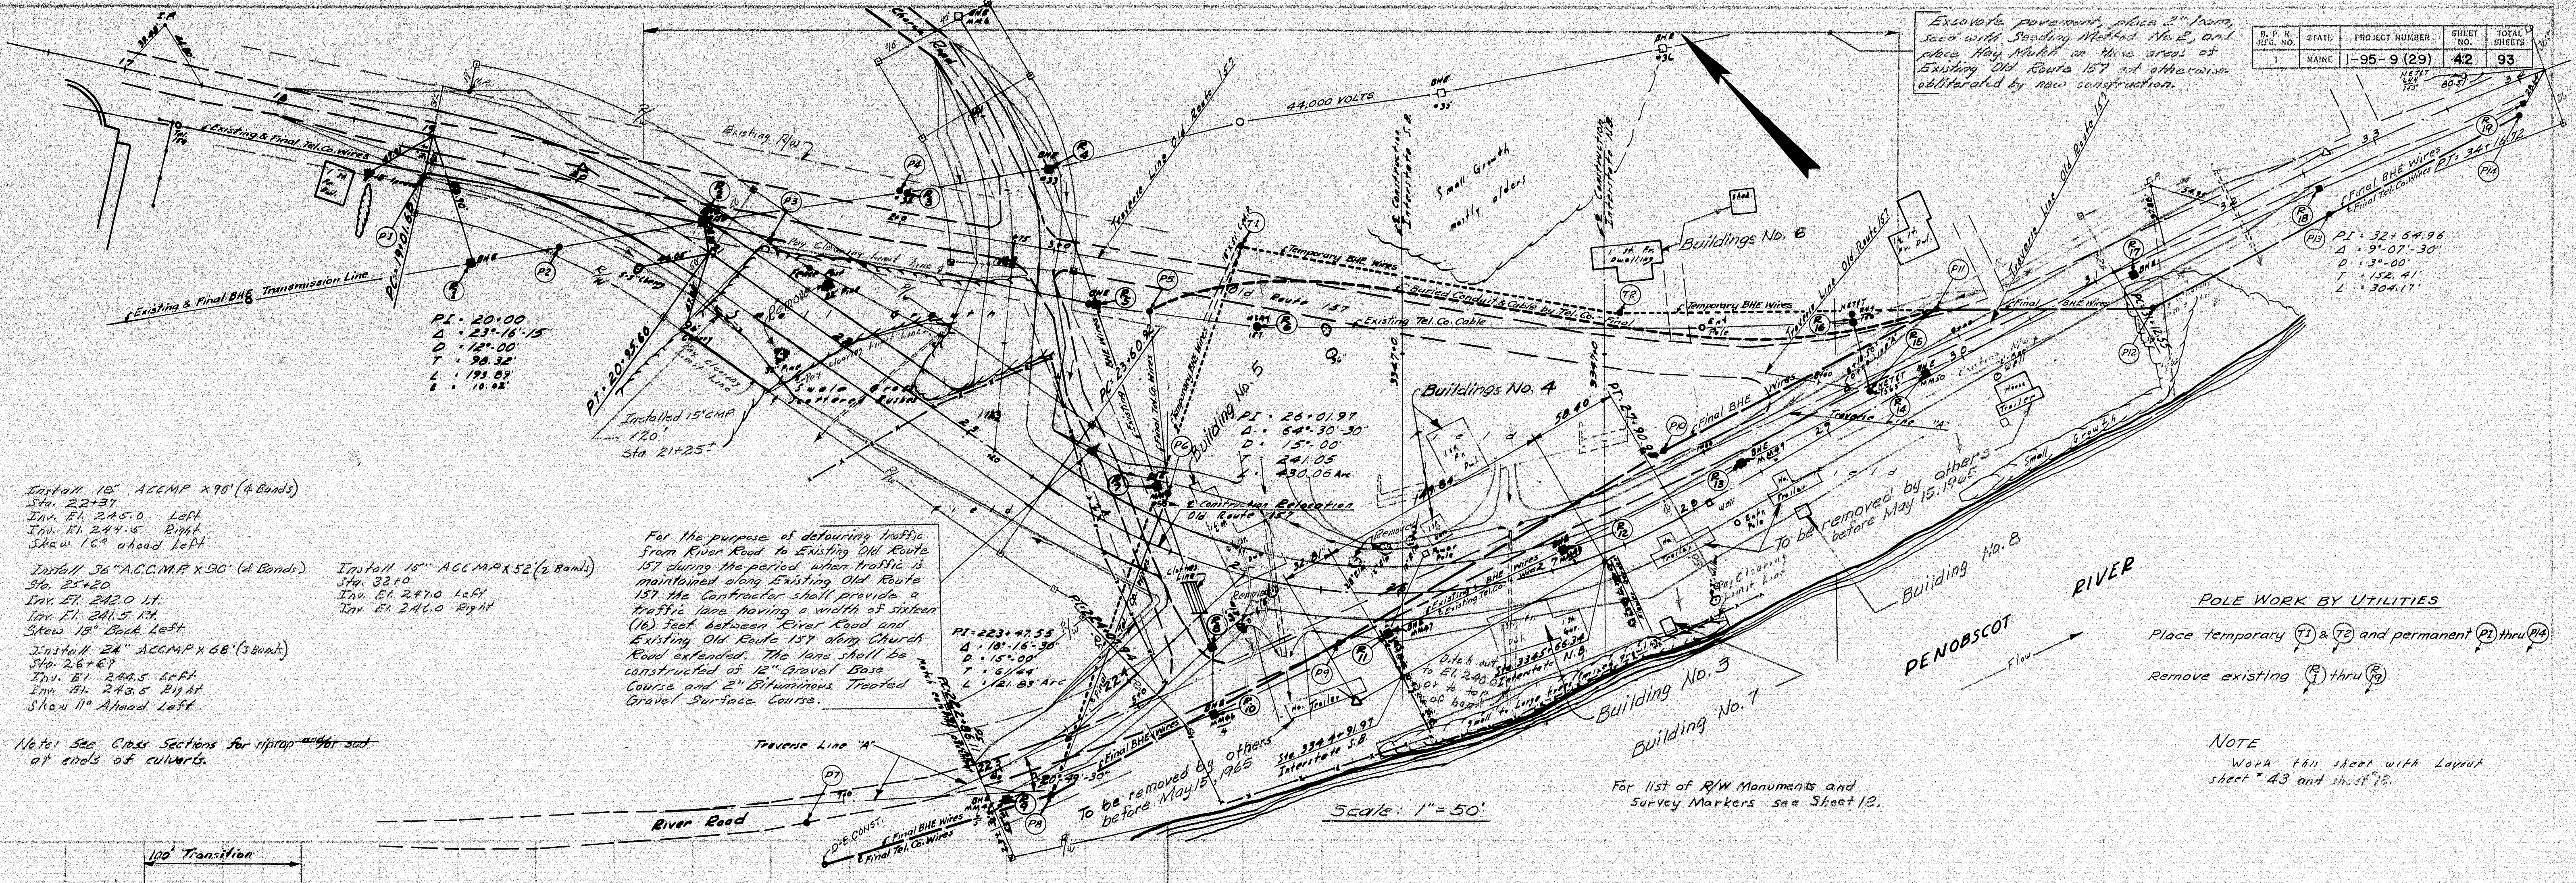

Install 18" ACCMP X 90' (4 Bands)
Sta. 22+37
Inv. El. 245.0 Left
Inv. El. 244.5 Right
Skew 16° ahead Left

Install 36" ACCMP X 90' (4 Bands)
Sta. 25+20
Inv. El. 242.0 Lt.
Inv. El. 241.5 Rt.
Skew 18° back Left

Install 24" ACCMP X 68' (3 Bands)
Sta. 26+67
Inv. El. 244.5 Left
Inv. El. 243.5 Right
Skew 11° ahead Left

Install 18" ACCMP X 52' (2 Bands)
Sta. 32+0
Inv. El. 247.0 Left
Inv. El. 246.0 Right

For the purpose of detouring traffic from River Road to Existing Old Route 157 during the period when traffic is maintained along Existing Old Route 157 the Contractor shall provide a traffic lane having a width of sixteen (16) feet between River Road and Existing Old Route 157 along Church Road extended. The lane shall be constructed of 12" Gravel Base Course and 2" Bituminous Treated Gravel Surface Course.


Note: See Cross Sections for riprap at ends of culverts.

POLE WORK BY UTILITIES
Place temporary (T) & TE and permanent (P) thru (PH)
Remove existing (E) thru (R)

NOTE
Work this sheet with Layout sheet 43 and sheet 42.


For list of R/W Monuments and Survey Markers see Sheet 12.



Scale: 1" = 50'

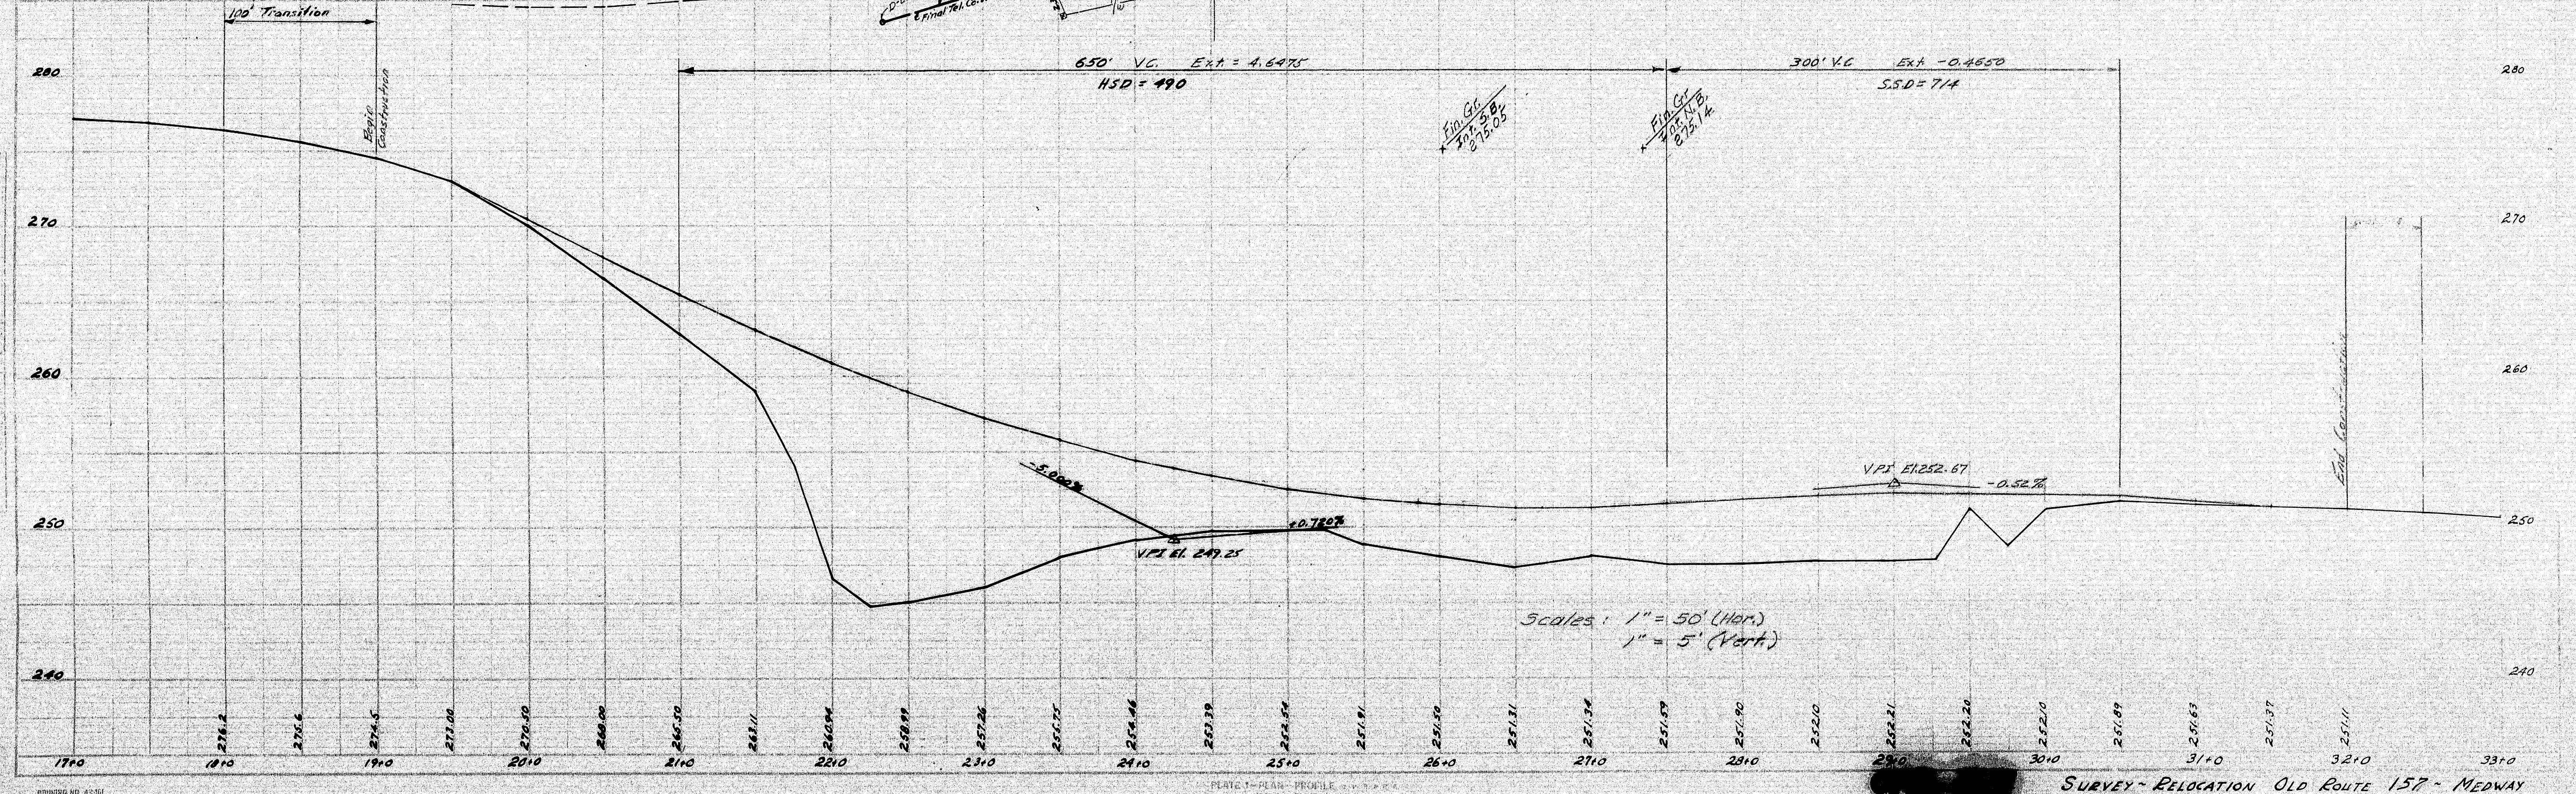


Scales: 1" = 50' (Hor.)
1" = 5' (Vert.)

SURVEY - RELOCATION OLD ROUTE 157 - MEDWAY

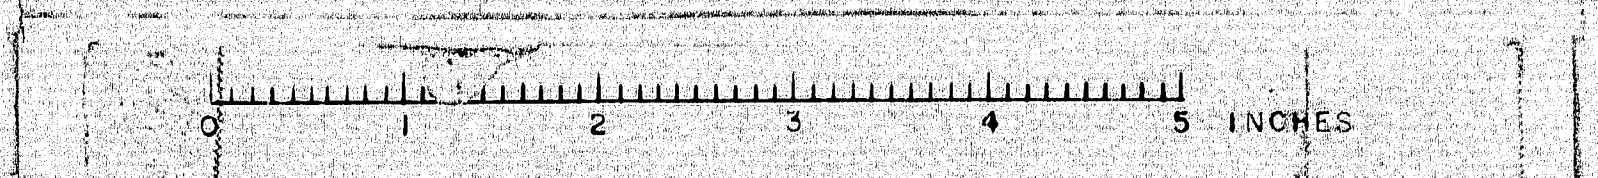


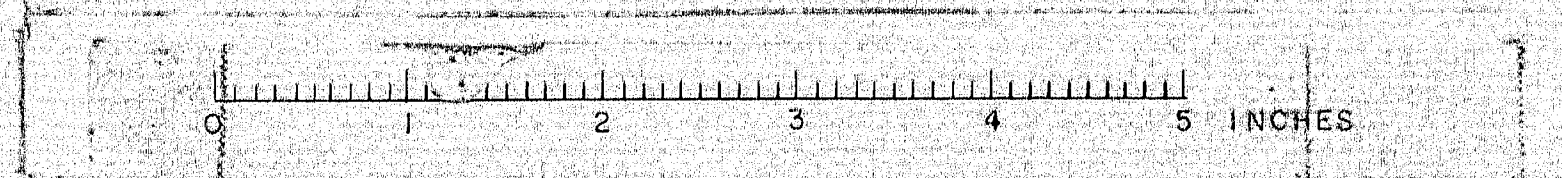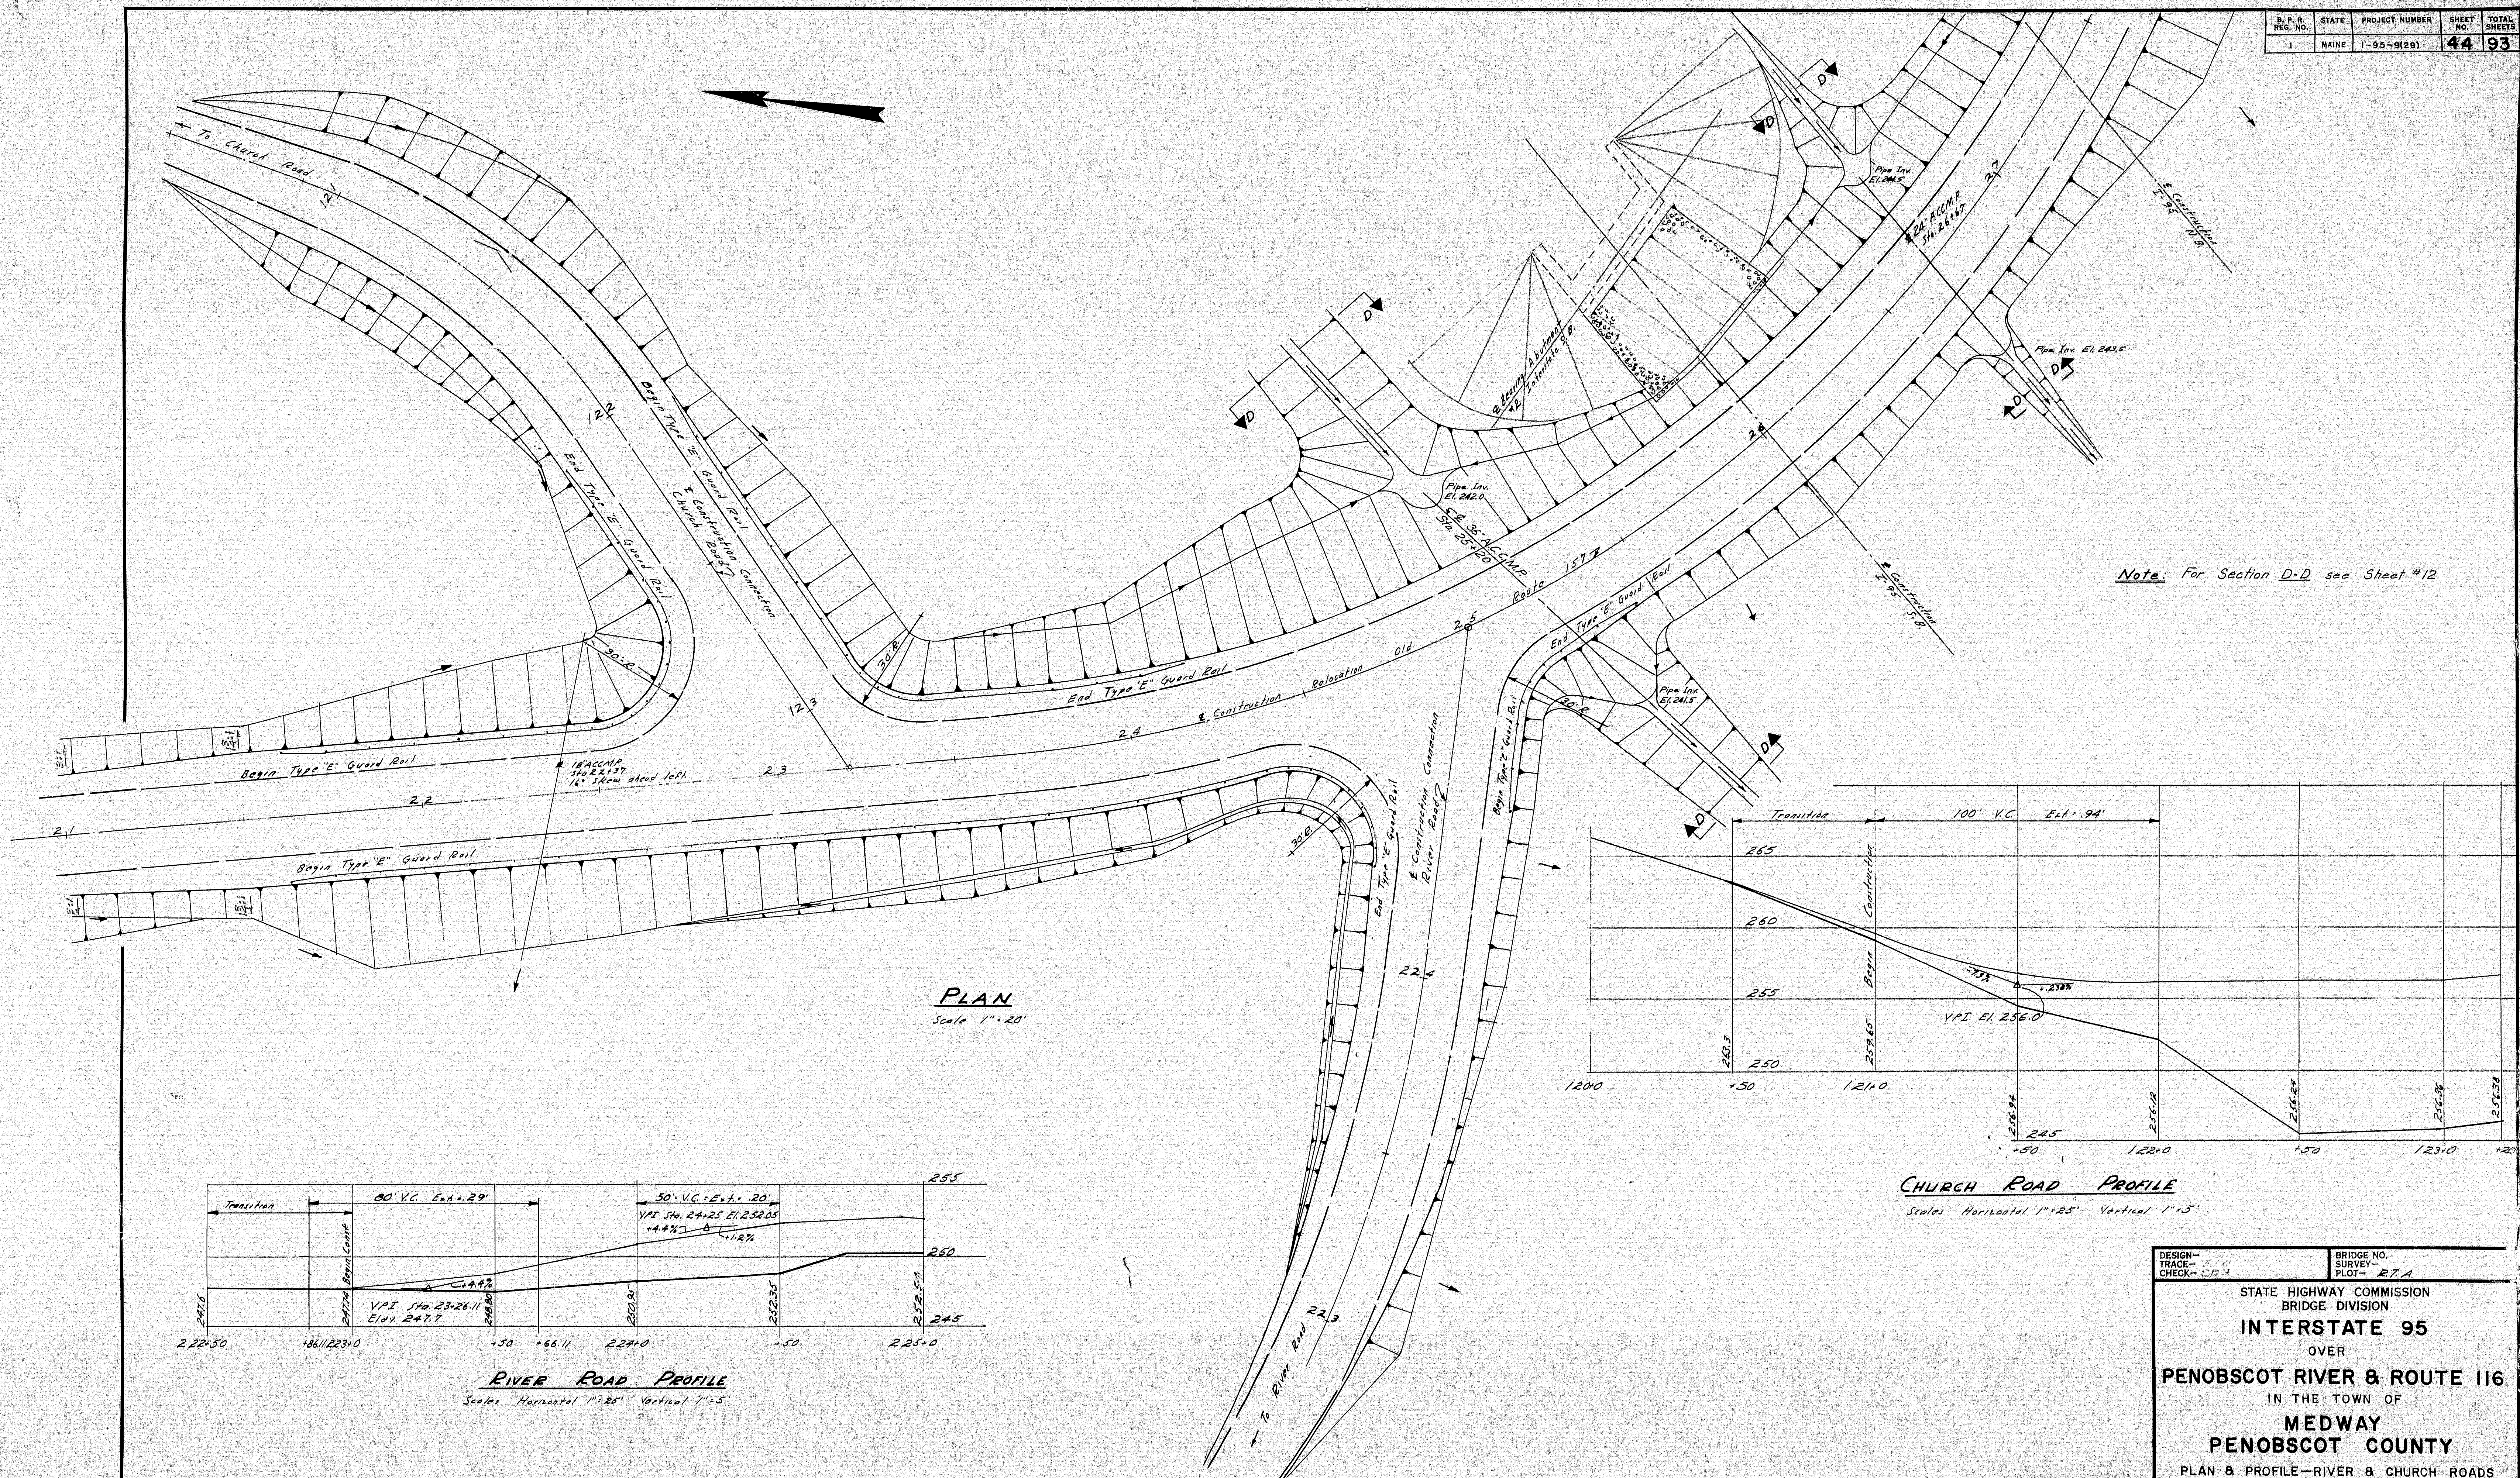

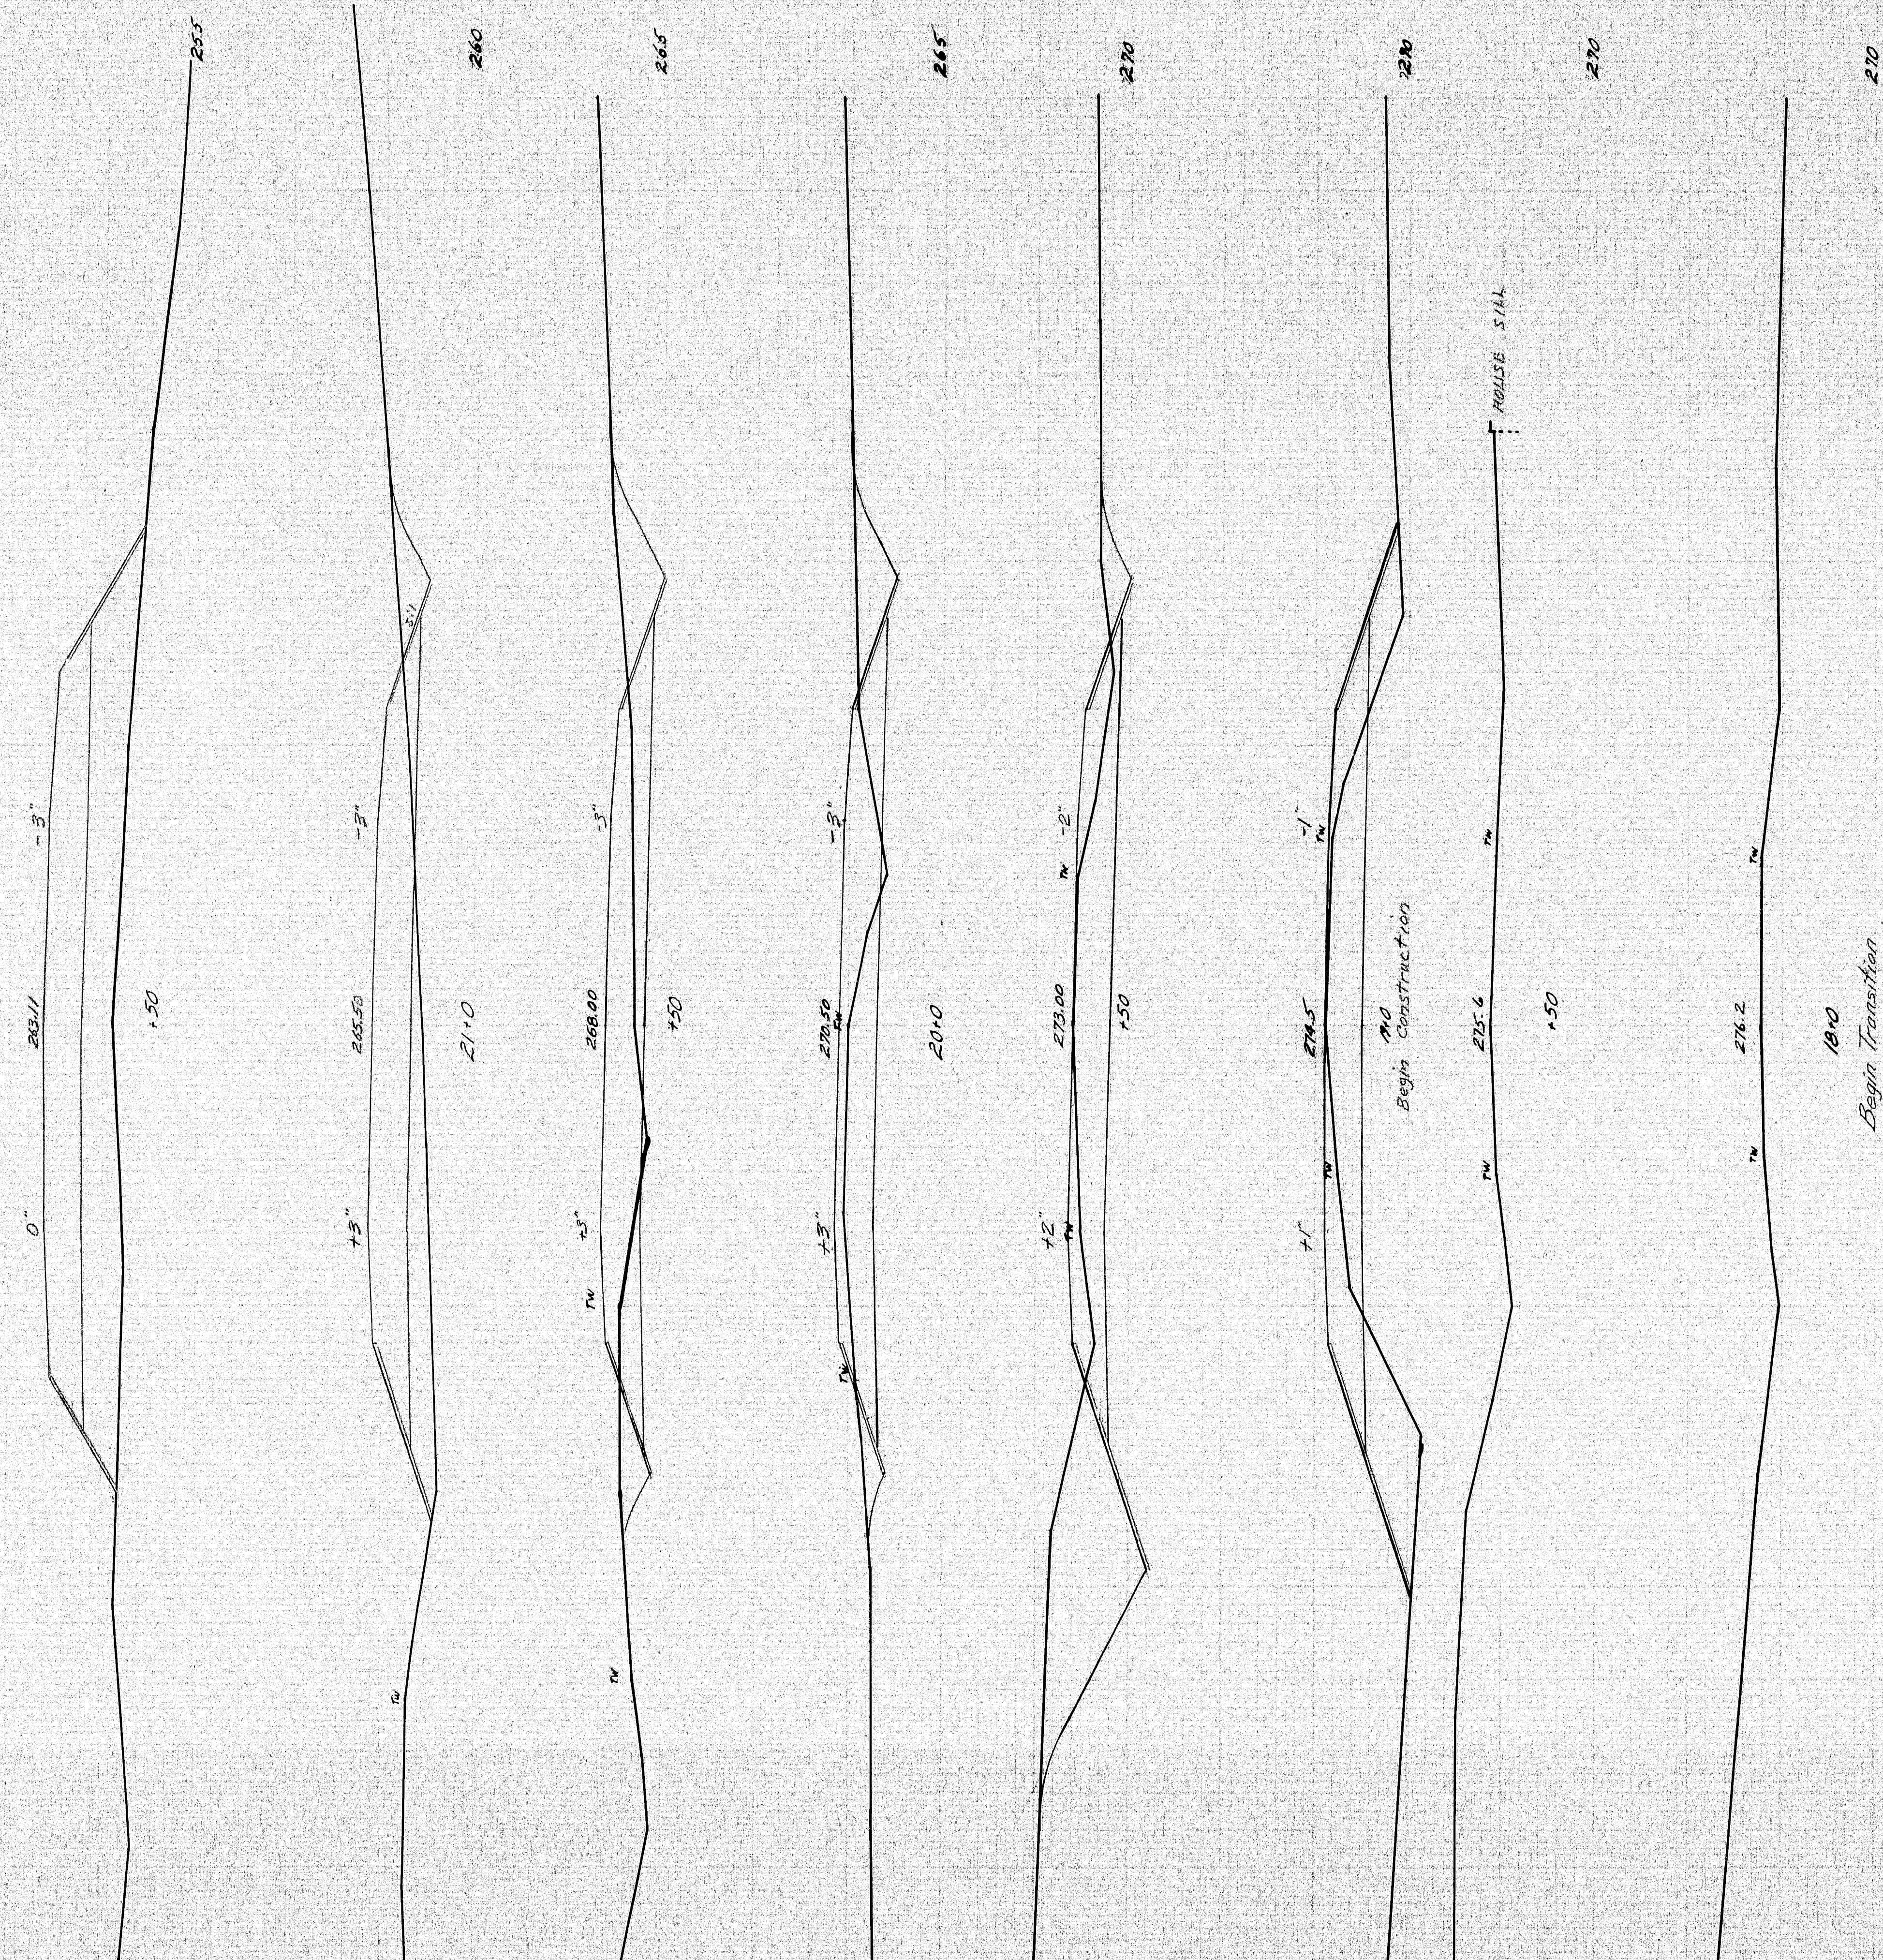



SCALE
Hor. + Vert. : 1" = 5'

X-SECTIONS RELOCATION OLD ROUTE 157- 18+0 to 21+50

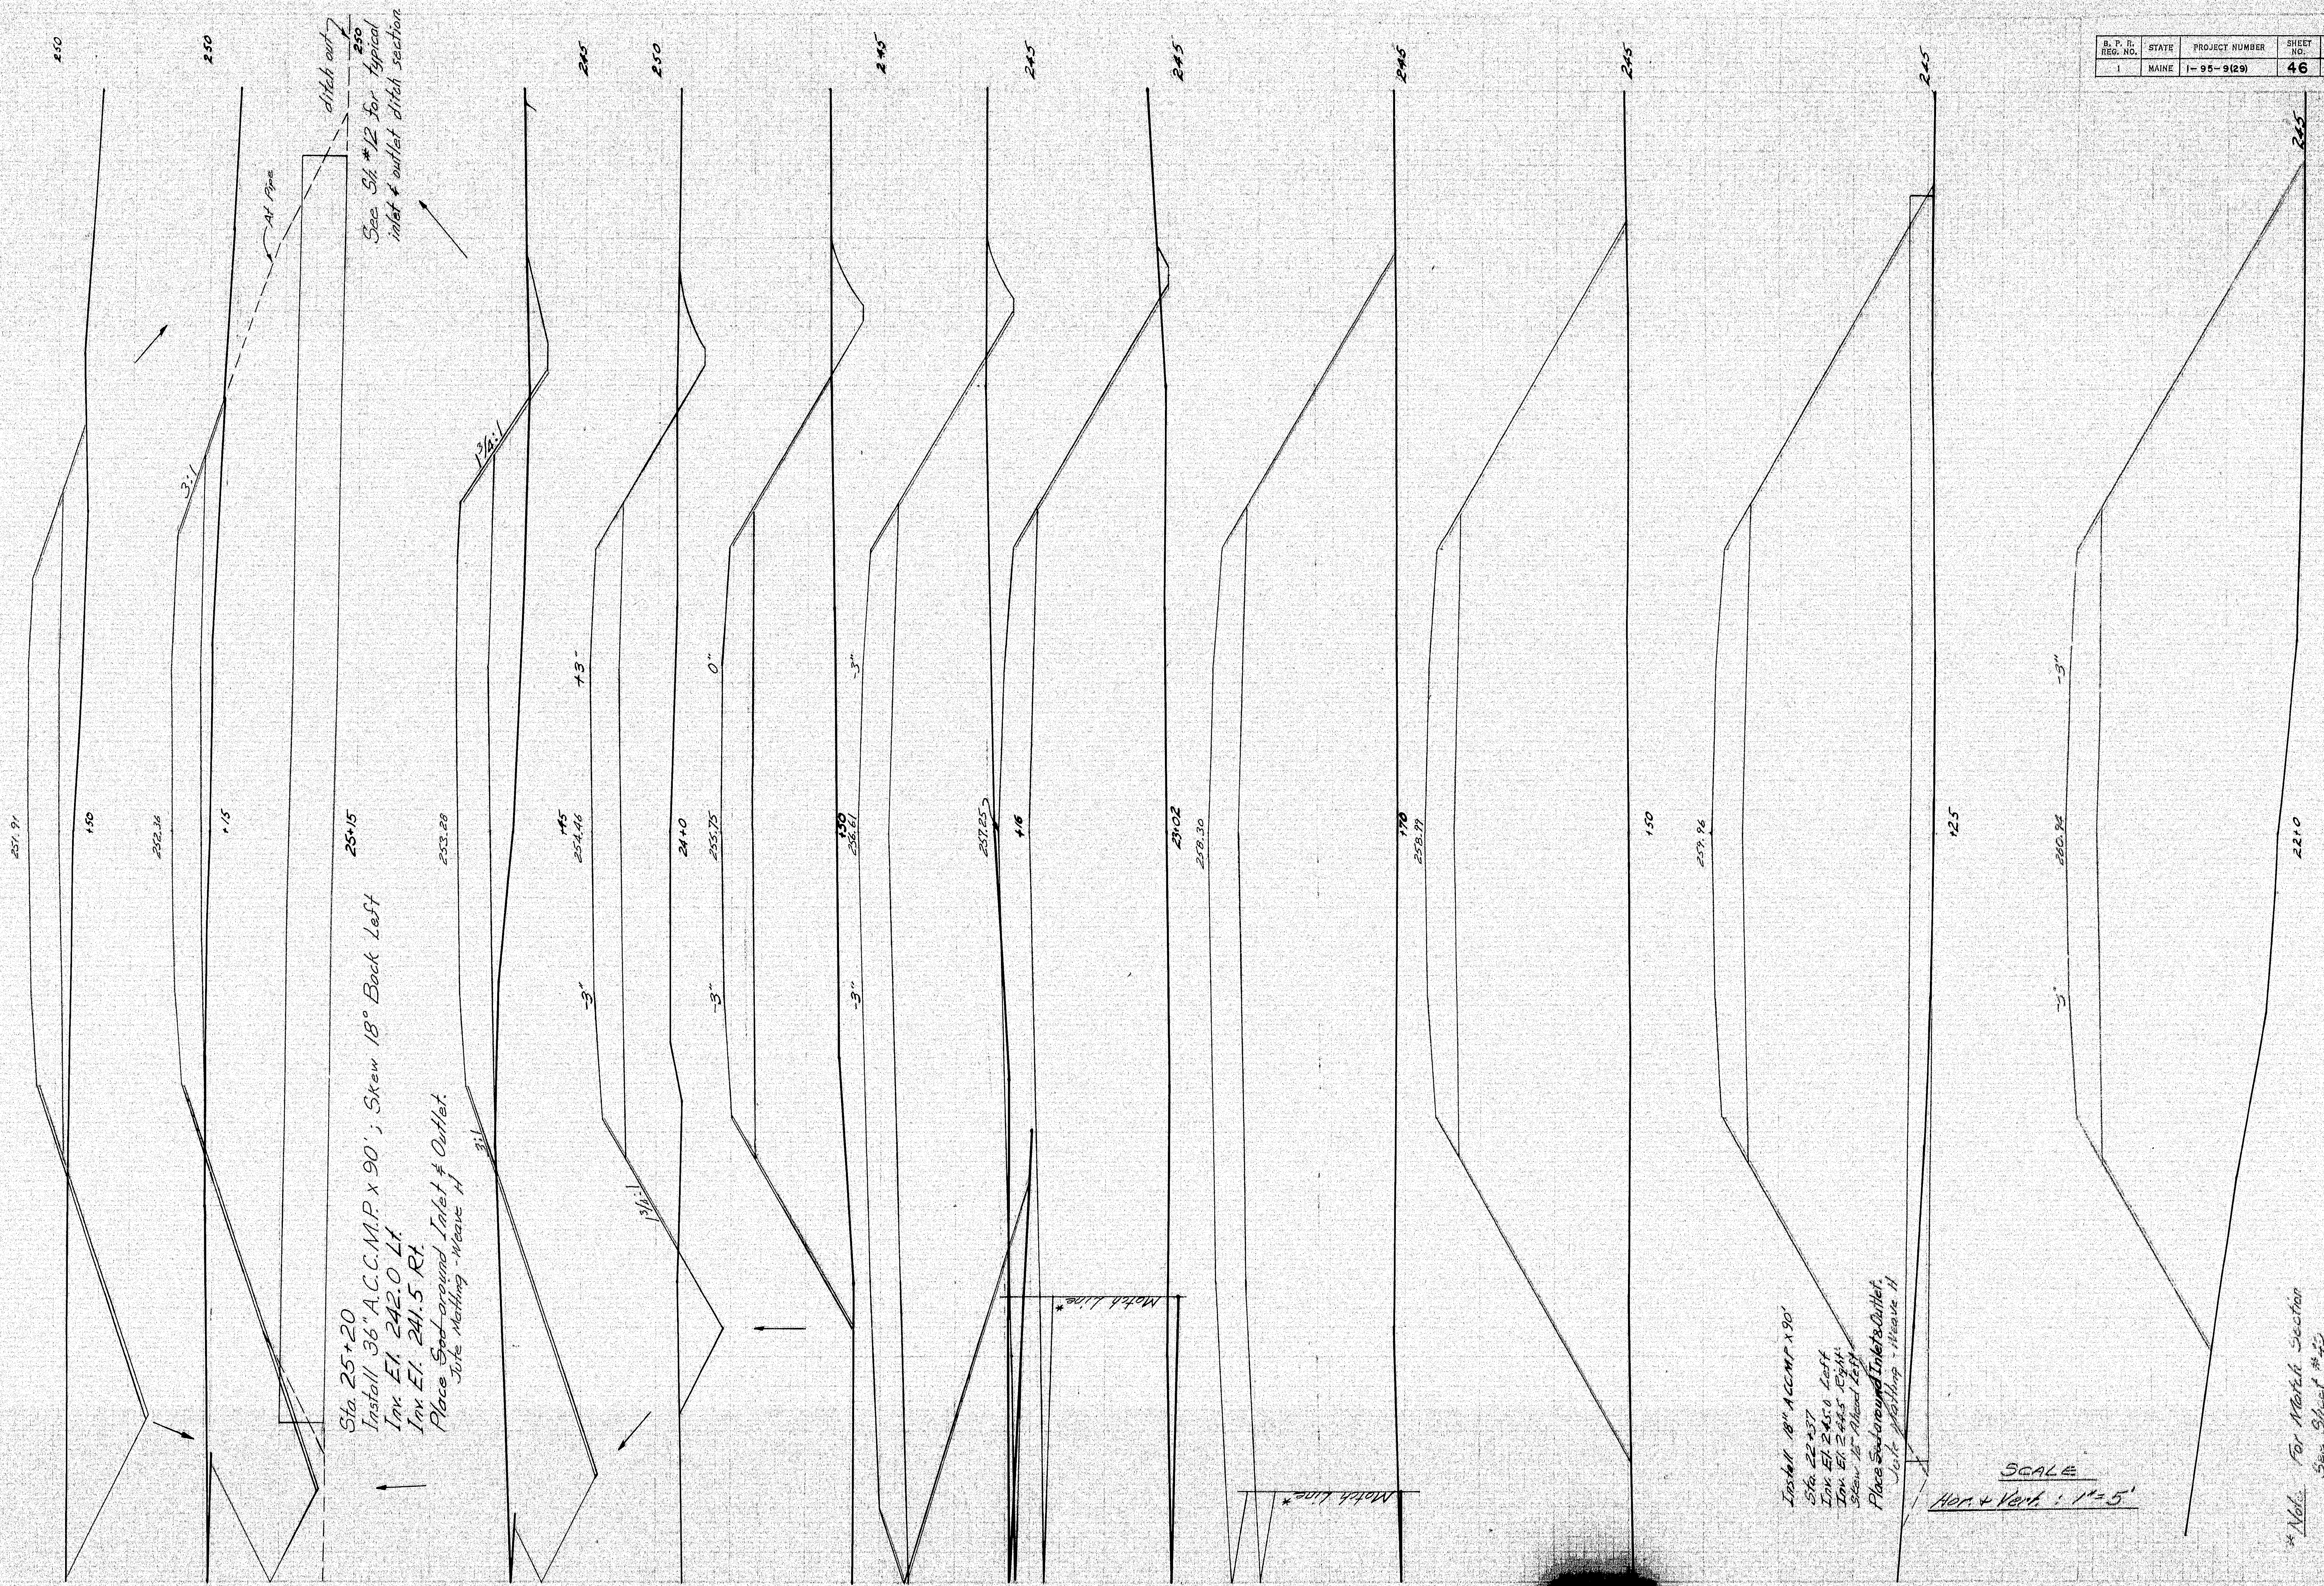

X-SECTIONS RELOCATION OLD ROUTE 157 - 22+0 TO 25+50

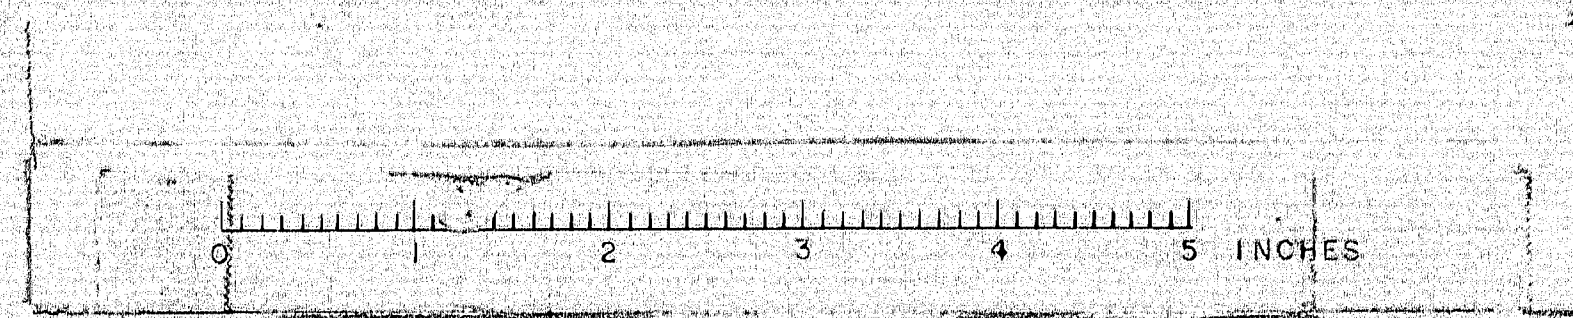

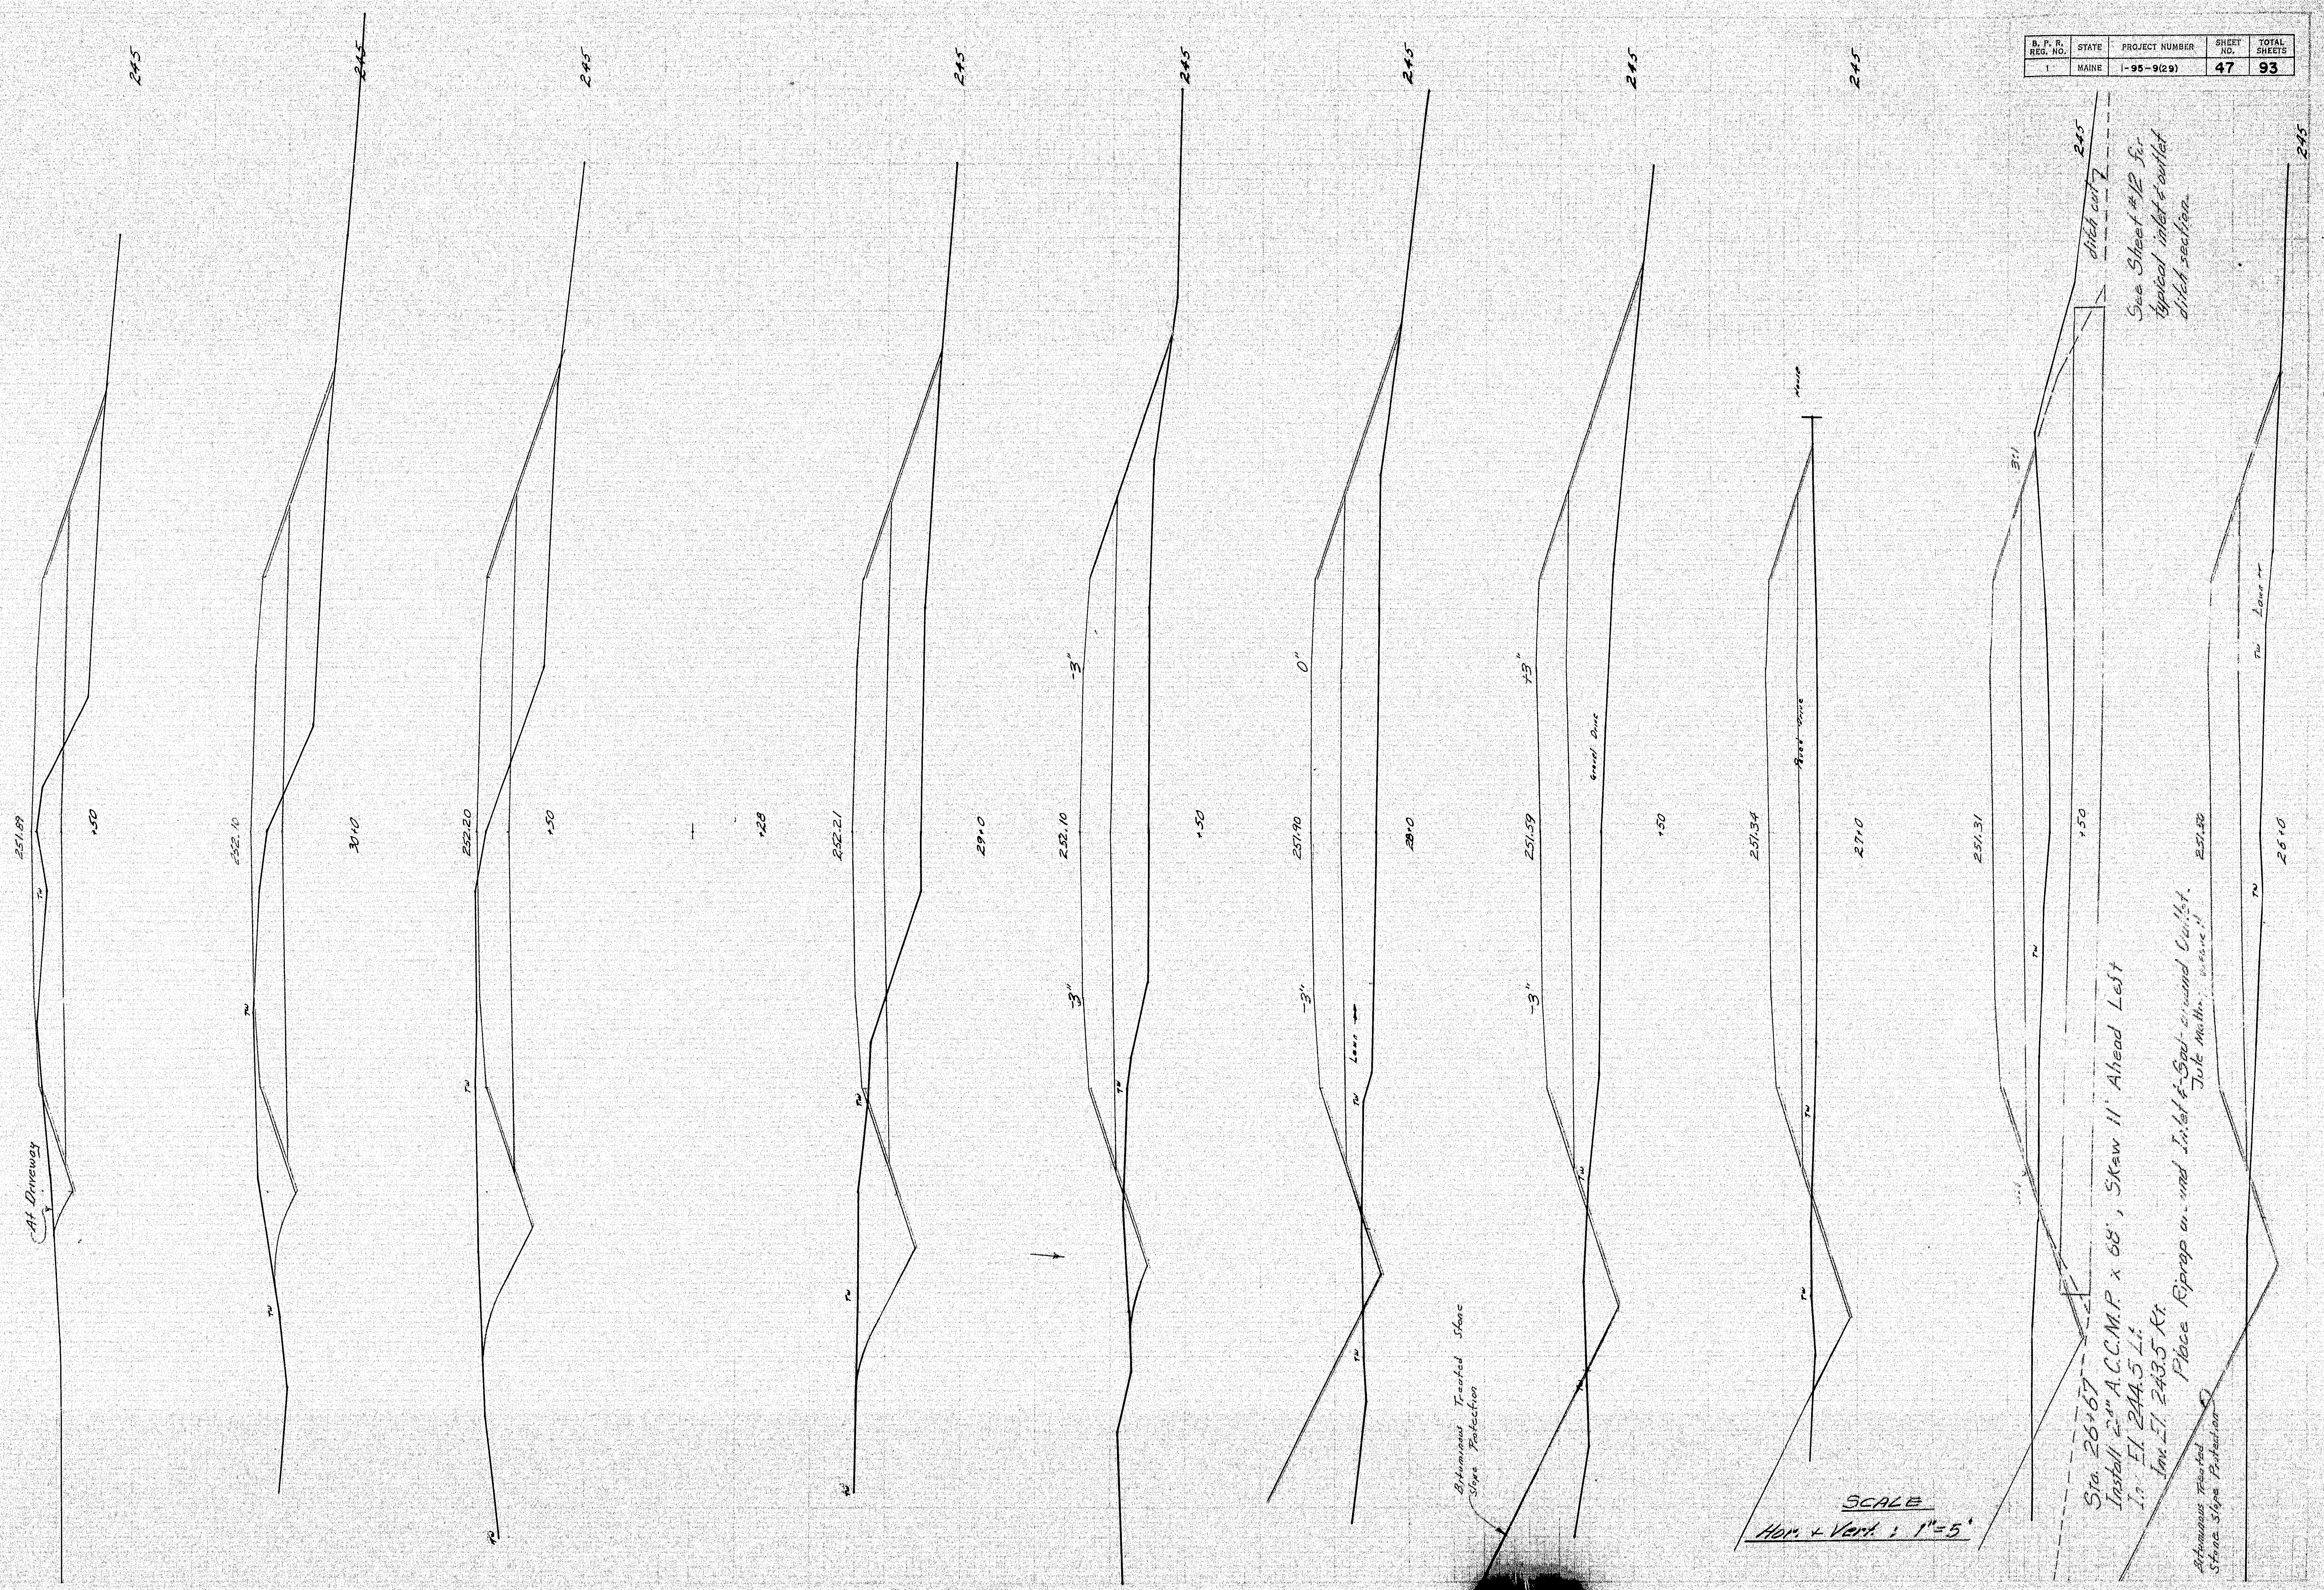

X-SECTIONS RELOCATION OLD ROUTE 157 ~ 26+0 TO 30+50

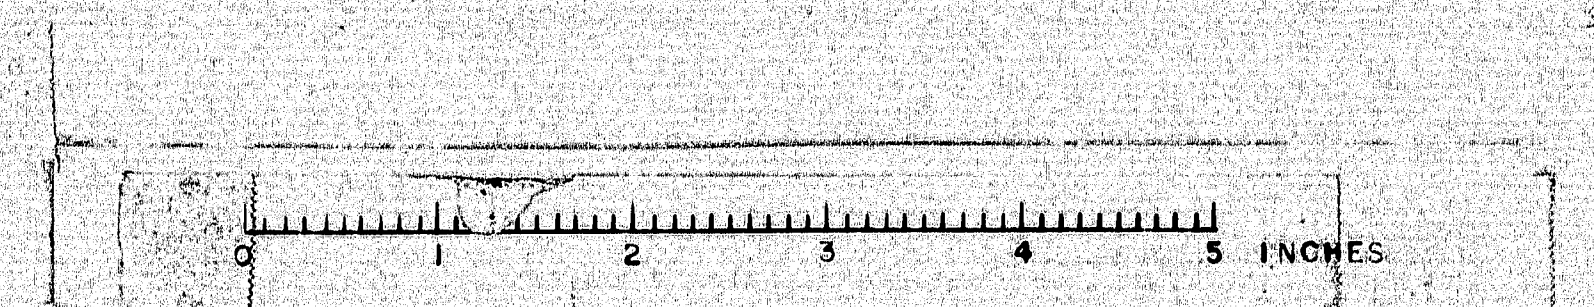



SCALE
Hor. & Vert. 1" = 5'

V CDH

X Sections

Connection from
Church Road to
Relocation Old Route 157

*Note: For March Lim.
See Sheet # 46

120+50
Begin Trenching
Connection Church Road
to Relocation Old Route 157

121+0
Begin Construction

257.4

3"

257.0

121+50

3"

253.9

121+83

3"

252.94

122+0

3"

252.12

122+50 (North Section)*

4:1

3"

256.24

123+0

256.36

U. S. P. R. REG. NO.	STATE	PROJECT NUMBER	SHEET NO.	TOTAL SHEETS
1	MAINE	1-95-9 (29)	20	29

252.63

224.73

252.01

224.38

250.95

224.0

248.80

223.50

247.74

223.10

223.00


Connection from River Road to
Relocation of Old Road 157

SCALE
Horizontal 1" = 5'

Connection from
River Road to
Relocation of Old Road

X-Sectures


