


MATERIAL: ASTM-A36 & A5 NOTED  
BOLTS: ASTM-A325  
HOLES: A5 NOTED.  
ELECTRODES: SEE WELDING PROC.  
SURFACE PREP: SSPC-SPG  
PRIMER: NONE

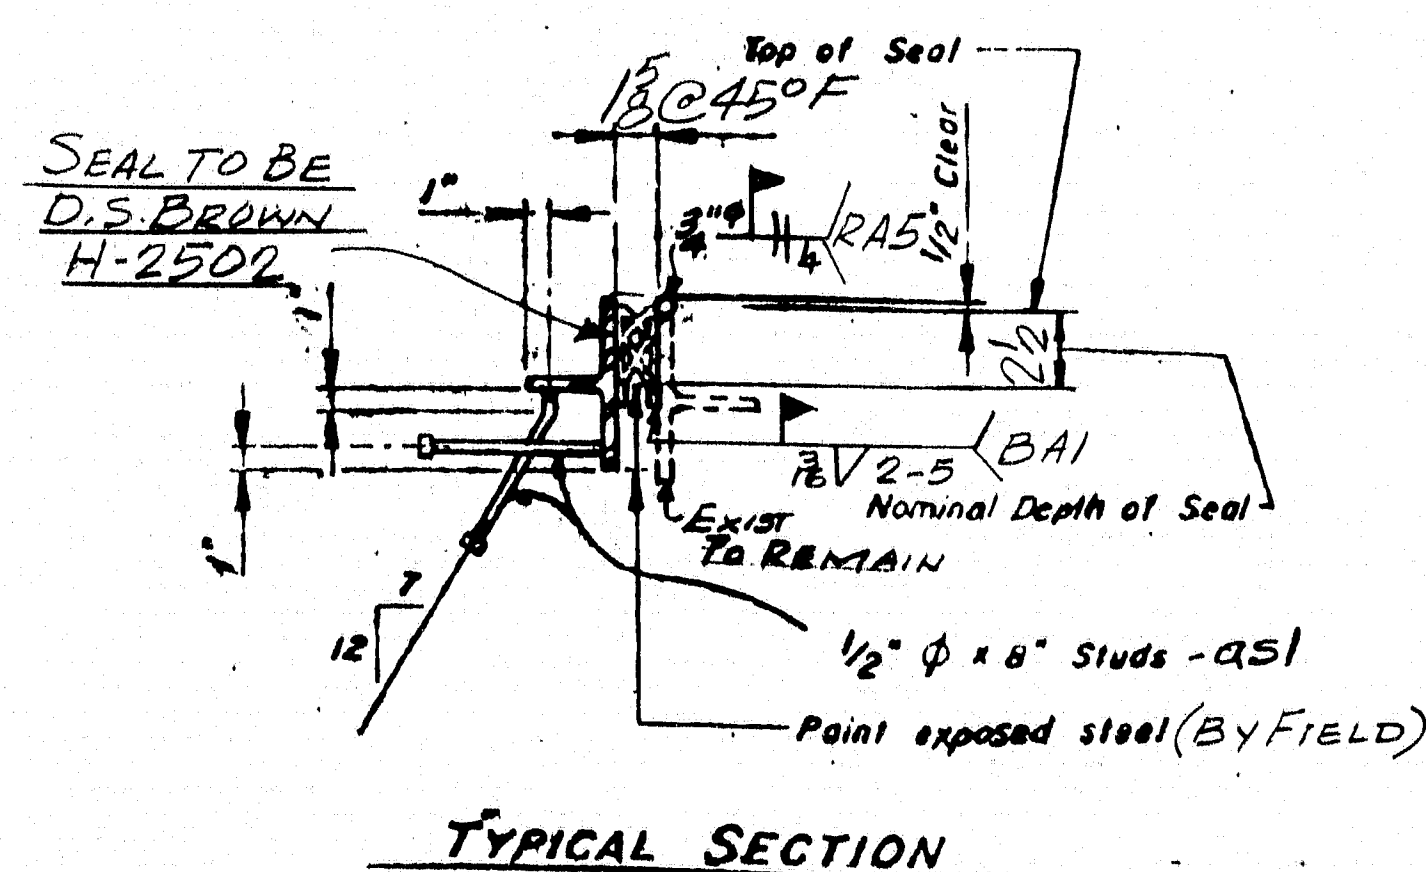

1	U123	PER MAINE DOT
REV. NO.	DATE	DESCRIPTION
HOLES <u>AS NOTED</u>		
PAINT <u>SEE NOTE ABOVE</u>		

DRAWING COVERS: <u>ARMORED JOINT MOD. - TYPE I</u>	
<u>ABUTMENT NO. 1</u>	
DATE SUB.	<u>I-95 SOUTHBOUND</u>
PROJECT	<u>OVER MEDUXNEKEAG RIVER</u>
LOCATION	<u>HOULTON, ME.</u>
ARCHITECT	
ENGINEER	<u>STATE OF MAINE D.O.T.</u>
DATE APP.	
DATE DIST.	<u>C.R.M. CONSTRUCTORS</u>

<b>MERRIMACK SHEET METAL</b>  119 HALL ST. CONCORD N.H. 03301  Tel. (603) 224-7766 Fax (603) 224-7925	DRAWN BY: <b>J.P.F.</b>  CKD. BY
	JOB NO <b>5760</b>
	DWG. NO <b>5</b>



