Bill of Materials		
Mark	Qty.	Part No.
PS	50	MA04-4490-74
CB	200	MP10-4-3658-1
PB	50	MA03-8842-4
PP	50	
AB1	40	incl 1 hard washer & 2 heavy hex n.
AB2	60	" " "
CS (Cap Screw)	800	MA17-56-1 (Not Shown)

Riveted post to base?

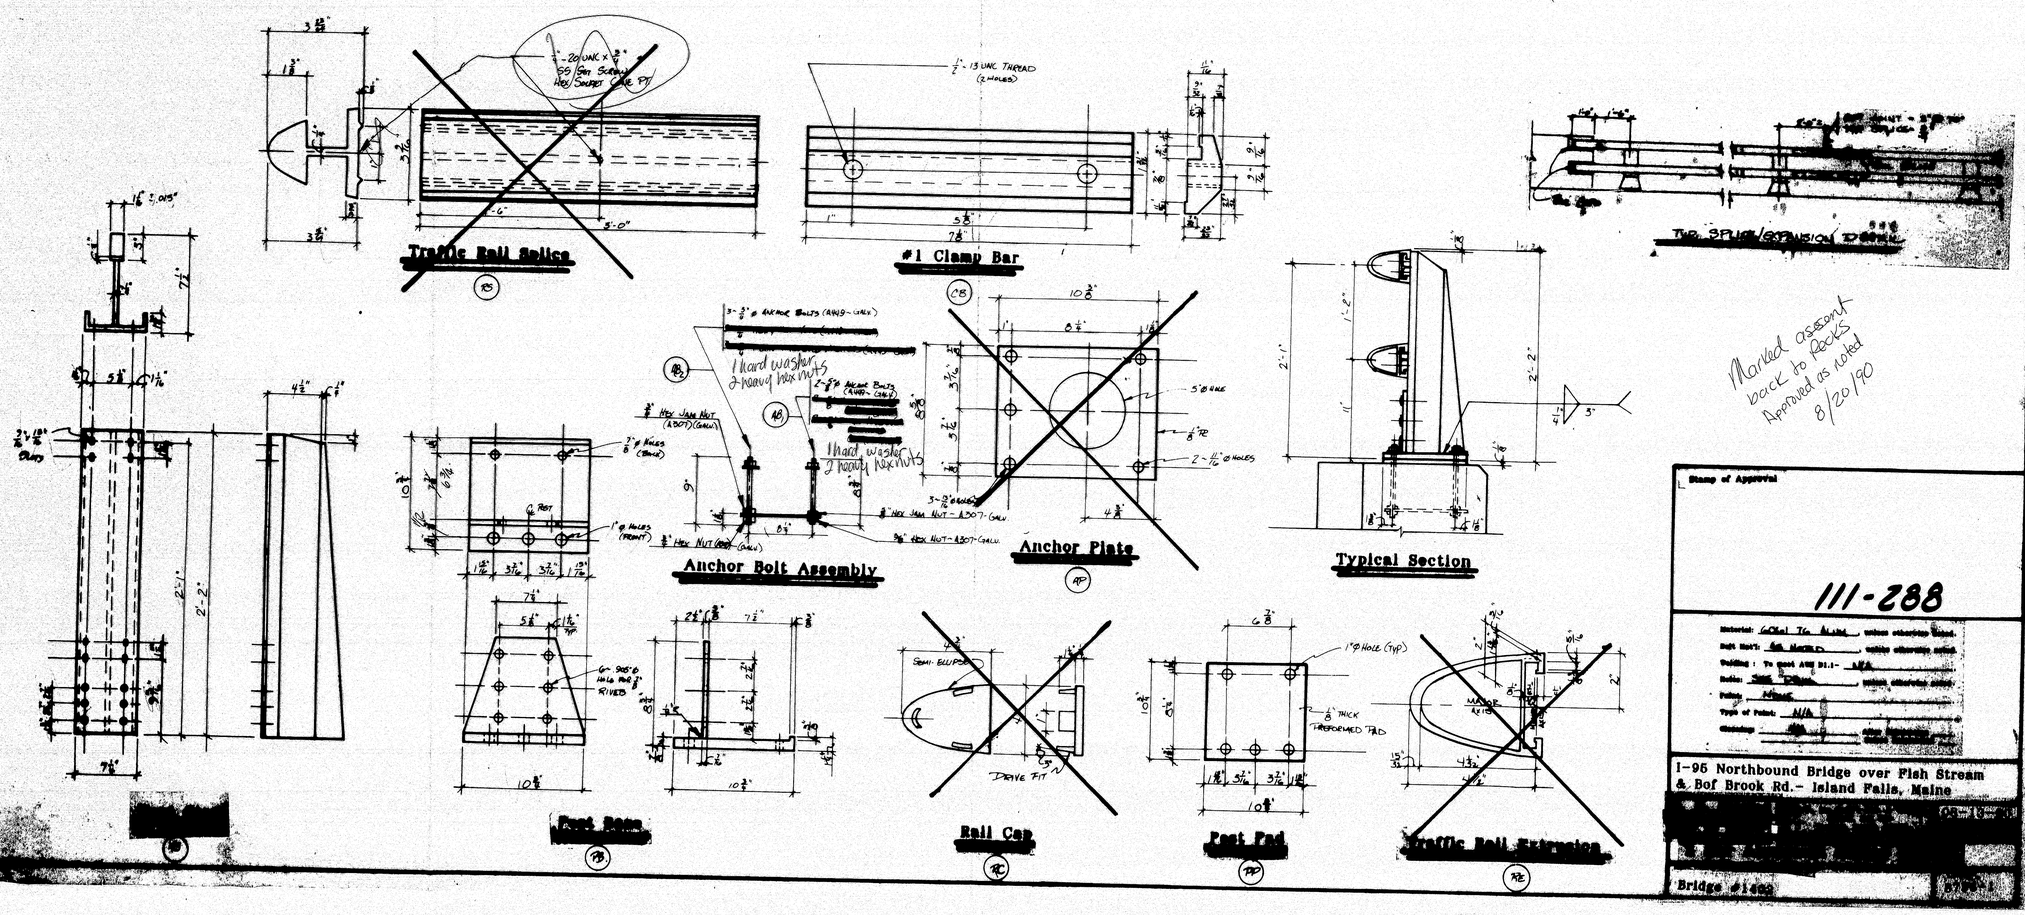

Marked assent back to Rocks Approved as noted 8/20/90

Stamp of Approval

111-288

Material: 6061 T6 ALUM, unless otherwise noted.
Bolt Mat'l: AS NOTED, unless otherwise noted.
Welding: To meet AWS D1.1- N/A
Notes: SEE DRAW, unless otherwise noted.
Paint: NONE
Type of Paint: N/A
Glazing: N/A

I-95 Northbound Bridge over Fish Stream & Bof Brook Rd.- Island Falls, Maine

[redacted]

Bridge #1402