
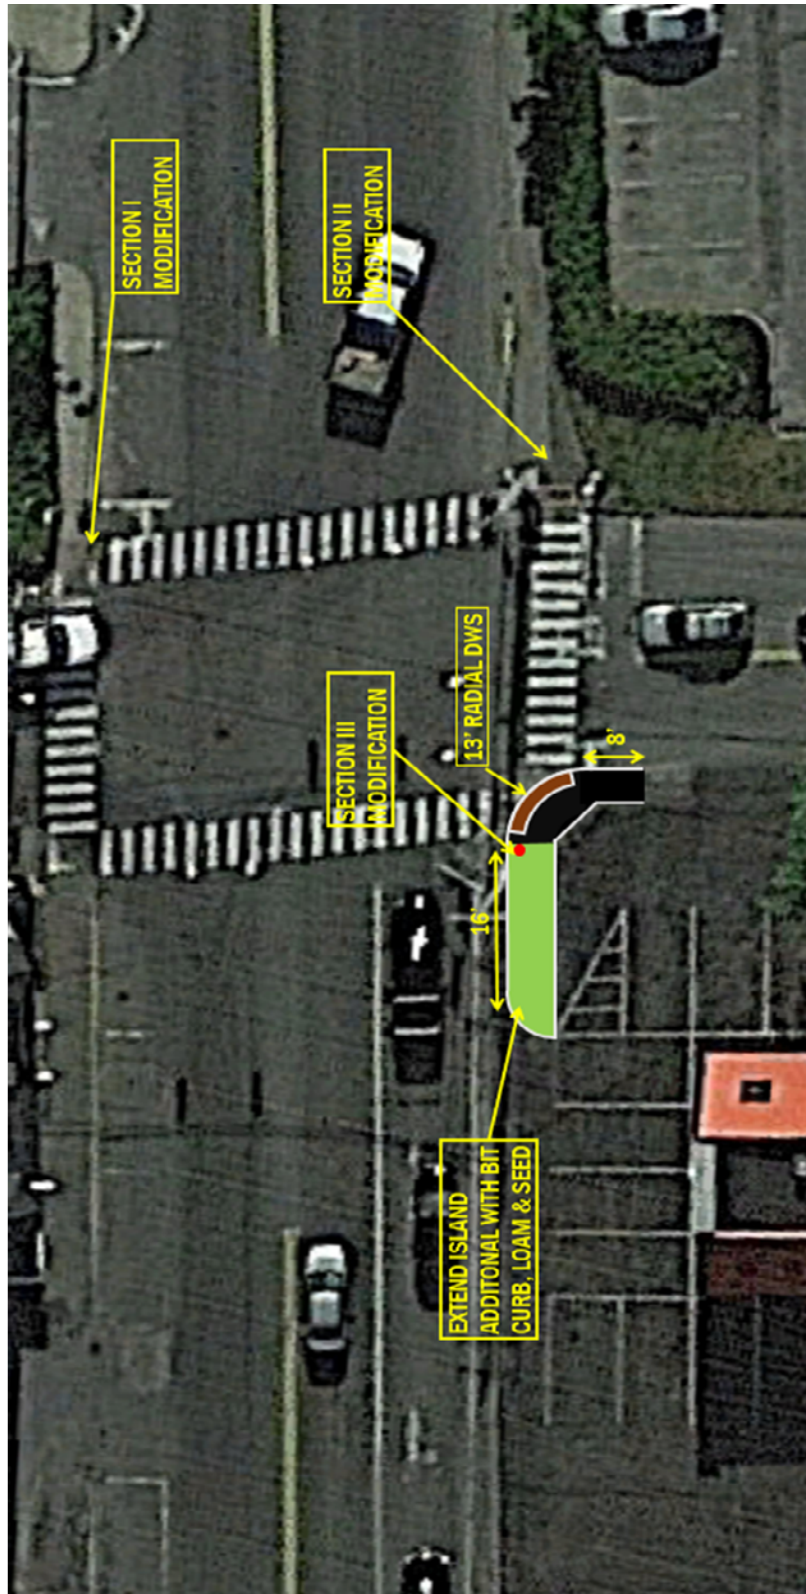
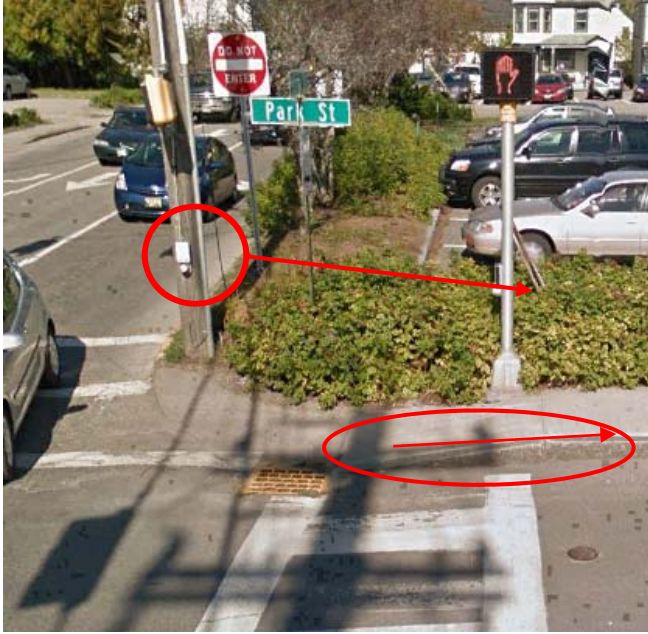



**Traffic Signal Modification – Park Street & Union Street**

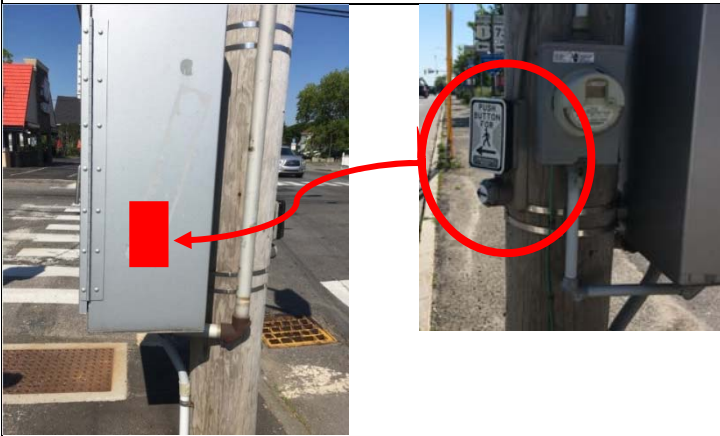

## Traffic Signal Modification – Park Street & Union Street

	<p><u>Section I</u></p> <ul style="list-style-type: none"> <li>Relocate the existing pedestrian pushbutton and sign that is currently located on the utility pole to the existing pedestal pole on Park Street side pointing toward Union Street.</li> <li>All pedestrian pushbuttons shall have a maximum allowable reach distance of 10". Install extension bracket if required.</li> <li>The existing sidewalk ramp will be rebuilt under Item 608.461. Slope of ramp will begin approximately 8 feet easterly of existing location.</li> </ul>
	<p><u>Section II</u></p> <ul style="list-style-type: none"> <li>Relocate the existing pedestrian pushbutton and sign located on the utility pole with traffic signal control cabinet to the east side of the control cabinet. All pedestrian pushbuttons shall have a maximum allowable reach distance of 10". Install extension bracket if required.</li> </ul>
	<p><u>Section III</u></p> <ul style="list-style-type: none"> <li>All pedestrian pushbuttons shall have a maximum allowable reach distance of 10". Install extension bracket if required.</li> </ul>