



Paul R. LePage
GOVERNOR

STATE OF MAINE
DEPARTMENT OF TRANSPORTATION
16 STATE HOUSE STATION
AUGUSTA, MAINE 04333-0016

David Bernhardt
COMMISSIONER

May 8, 2012
Subject: **Kittery**
Federal Project No: BH-1671(100)X
State WIN: 016710.10
Amendment No. 2


Dear Sir/Ms:

Make the following change to the Bid Document:

In the Plans, Sheet Number 8 of 8 "TYPICAL SECTIONS & DETAILS" bottom left hand corner, **REPLACE** the "THRIE BEAM DETAIL" with the attached new "THRIE BEAM DETAIL"

Consider this change and information prior to submitting your bid on May 16, 2012.


Sincerely,

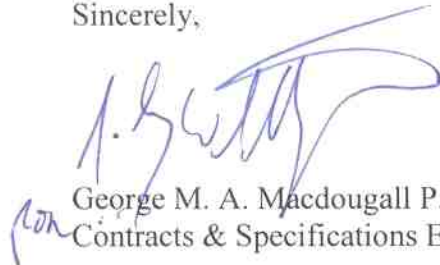

George M. A. Macdougall P.E.
Contracts & Specifications Engineer



PRINTED ON RECYCLED PAPER

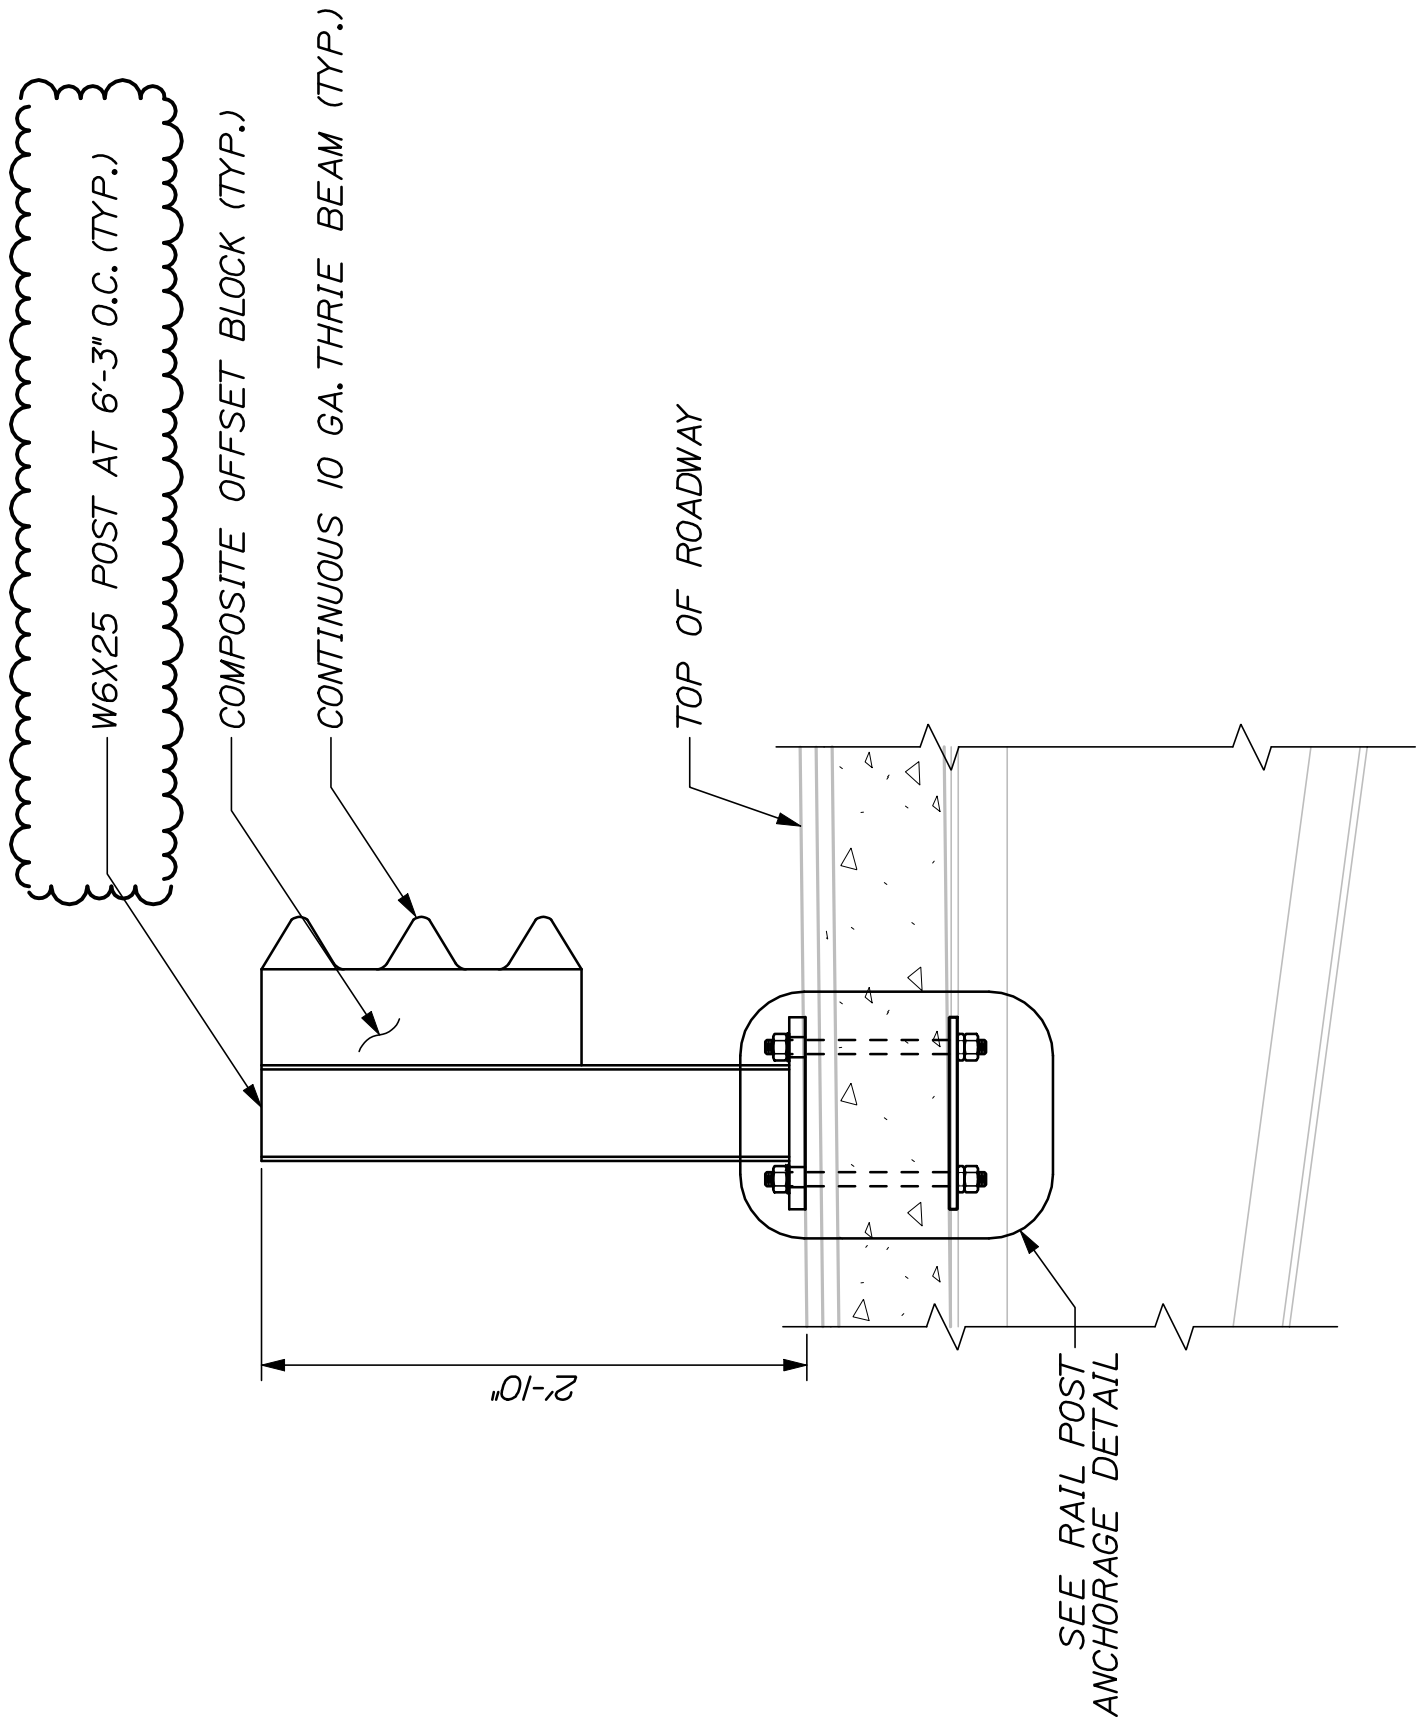

THRIE BEAM DETAIL

NTS

NOTE:
 ALL THRIE BEAM RAILING COMPONENTS SHALL MEET
 THE REQUIREMENTS OF STANDARD SPECIFICATION 606.