



Paul R. LePage
GOVERNOR

STATE OF MAINE
DEPARTMENT OF TRANSPORTATION
16 STATE HOUSE STATION
AUGUSTA, MAINE 04333-0016

David Bernhardt
COMMISSIONER

January 23, 2012
Subject: **Fryeburg**
Federal Project No: BR-1787(200)X
State PIN: 017872.00
Amendment No. 1


Dear Sir/Ms:

Make the following change to the Bid Document:

In the Plans, Sheet Number 3 of 24, ("PLANS") **CHANGE** the location of the Utility Pole (CMP #571) at Sta. 425+47 40.0' LT to **Sta.424+90.00, 38.0' LT** as shown in the attached detail. Make this change in pen and ink.


Consider this change and information prior to submitting your bid on February 1, 2012.

Sincerely,

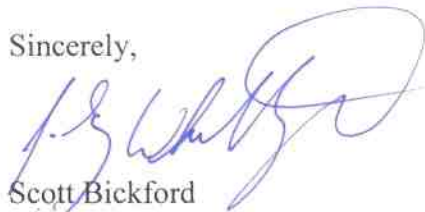
For Scott Bickford
Contracts & Specifications Engineer



PRINTED ON RECYCLED PAPER

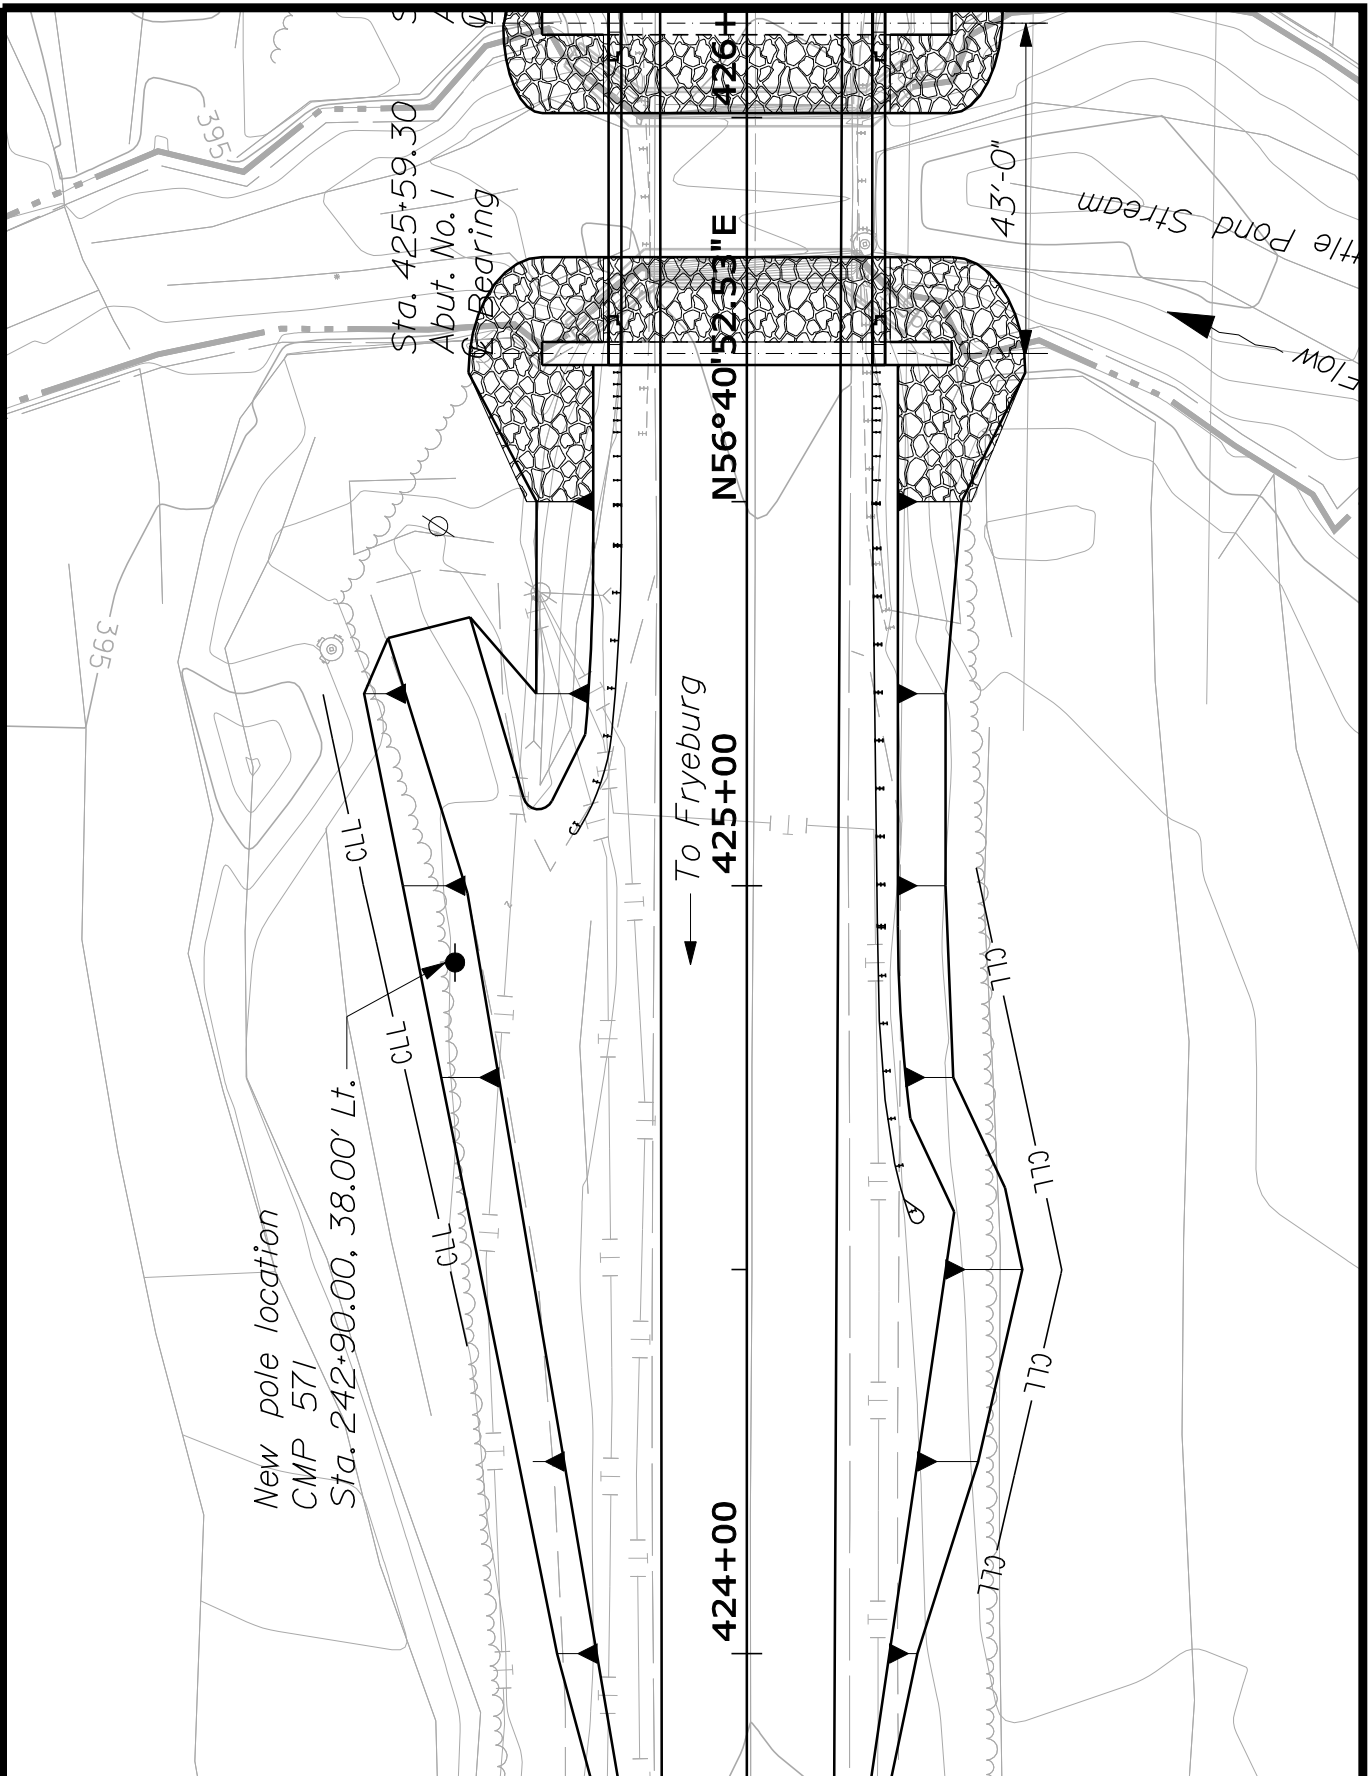

STATE OF MAINE
DEPARTMENT OF TRANSPORTATION

LITTLE POND BRIDGE
LITTLE POND STREAM
FRYEBURG OXFORD COUNTY

BR-1787(200)X
17872.00 BRIDGE NO. 2464

ADDENDUM