



Janet T. Mills
GOVERNOR

STATE OF MAINE
DEPARTMENT OF TRANSPORTATION
16 STATE HOUSE STATION
AUGUSTA, MAINE 04333-0016

Bruce A. Van Note
COMMISSIONER

January 7, 2020
Subject: Drainage & Safety
Improvements
State WIN: 019402.00
Location: **Augusta**
Amendment No. 3

Dear Sir/Ms.:

Please make the following changes to the Bid Documents:

In the Bid Book:

REMOVE pages 17 - 24, Proposal Schedule of Items, 8 pages, dated 12/4/2019, and **REPLACE** with the attached, revised Proposal Schedule of Items, 8 pages, dated 1/6/2020,

In the Plan Set:

REMOVE SHEET NUMBER 3 OF 52, ESTIMATED QUANTITIES, and **REPLACE** with the attached, revised SHEET NUMBER 3 OF 52, ESTIMATED QUANTITIES.

REMOVE SHEET NUMBER 14 OF 52, PLANS, and **REPLACE** with the attached, revised SHEET NUMBER 14 OF 52, PLANS.

REMOVE SHEET NUMBER 41 OF 52, CROSS SECTIONS, and **REPLACE** with the attached, revised SHEET NUMBER 41 OF 52, CROSS SECTIONS.

Consider these changes and information prior to submitting your bid on **January 15, 2020**.

Sincerely,

George M. A. Macdougall P.E.
Contracts & Specifications Engineer

Maine Department of Transportation

Proposal Schedule of Items

Proposal ID: 019402.00

Project(s): 019402.00

SECTION: 1 Project Items

Alt Set ID: Alt Mbr ID:

Contractor: _____

Proposal Line Number	Item ID Description	Approximate Quantity and Units	Unit Price		Bid Amount	
			Dollars	Cents	Dollars	Cents
0010	202.15 REMOVING MANHOLE OR CATCH BASIN	2.000 EA	_____	 _____	_____	 _____
0020	202.202 REMOVING PAVEMENT SURFACE	1,980.000 SY	_____	 _____	_____	 _____
0030	203.20 COMMON EXCAVATION	1,400.000 CY	_____	 _____	_____	 _____
0040	203.24 COMMON BORROW	200.000 CY	_____	 _____	_____	 _____
0050	203.25 GRANULAR BORROW	50.000 CY	_____	 _____	_____	 _____
0060	206.061 STRUCTURAL EARTH EXCAVATION - DRAINAGE AND MINOR STRUCTURES, BELOW GRADE	50.000 CY	_____	 _____	_____	 _____
0070	304.10 AGGREGATE SUBBASE COURSE - GRAVEL	1,300.000 CY	_____	 _____	_____	 _____
0080	403.2081 12.5 MM POLYMER MODIFIED HOT MIX ASPHALT	211.000 T	_____	 _____	_____	 _____
0090	403.209 HOT MIX ASPHALT 9.5 MM (SIDEWALKS, DRIVES, INCIDENTALS)	280.000 T	_____	 _____	_____	 _____
0100	403.211 HOT MIX ASPHALT (SHIMMING)	53.000 T	_____	 _____	_____	 _____
0110	403.213 HOT MIX ASPHALT 12.5 MM BASE	150.000 T	_____	 _____	_____	 _____
0120	409.15 BITUMINOUS TACK COAT - APPLIED	100.000 G	_____	 _____	_____	 _____

Maine Department of Transportation

Proposal Schedule of Items

Proposal ID: 019402.00

Project(s): 019402.00

SECTION: 1 Project Items

Alt Set ID: Alt Mbr ID:

Contractor: _____

Proposal Line Number	Item ID Description	Approximate Quantity and Units	Unit Price		Bid Amount	
			Dollars	Cents	Dollars	Cents
0130	514.06 CURING BOX FOR CONCRETE CYLINDERS	1.000 EA	_____	 _____	_____	 _____
0140	603.159 12 INCH CULVERT PIPE OPTION III	210.000 LF	_____	 _____	_____	 _____
0150	603.179 18 INCH CULVERT PIPE OPTION III	270.000 LF	_____	 _____	_____	 _____
0160	603.199 24 INCH CULVERT PIPE OPTION III	8.000 LF	_____	 _____	_____	 _____
0170	604.16 ALTERING CATCH BASIN TO MANHOLES	1.000 EA	_____	 _____	_____	 _____
0180	604.164 REBUILDING CATCH BASIN	1.000 EA	_____	 _____	_____	 _____
0190	604.2403 SPECIAL BASIN	2.000 EA	_____	 _____	_____	 _____
0200	604.243 CATCH BASIN TYPE F3-C	2.000 EA	_____	 _____	_____	 _____
0210	604.245 CATCH BASIN TYPE F4-C	2.000 EA	_____	 _____	_____	 _____
0220	604.248 CATCH BASIN TYPE F6	2.000 EA	_____	 _____	_____	 _____
0230	604.26 CATCH BASIN TYPE B5	2.000 EA	_____	 _____	_____	 _____
0240	604.262 CATCH BASIN TYPE B5-C	1.000 EA	_____	 _____	_____	 _____

Maine Department of Transportation

Proposal Schedule of Items

Proposal ID: 019402.00

Project(s): 019402.00

SECTION: 1 Project Items

Alt Set ID: Alt Mbr ID:

Contractor: _____

Proposal Line Number	Item ID Description	Approximate Quantity and Units	Unit Price		Bid Amount	
			Dollars	Cents	Dollars	Cents
0250	606.1301 31" W-BM GR, MID-WAY SPLICE-SGL FACED	288.000 LF	_____	 _____	_____	 _____
0260	606.1304 31" W-BM GR, MID-WAY SPLICE-OVER 15' RAD	25.000 LF	_____	 _____	_____	 _____
0270	606.1305 31" W-BM GR, MID-WAY SPLICE FLARED TERMINAL	1.000 EA	_____	 _____	_____	 _____
0280	606.178 GUARDRAIL BEAM	25.000 LF	_____	 _____	_____	 _____
0290	606.265 TERMINAL END - SINGLE RAIL - GALVANIZED STEEL	4.000 EA	_____	 _____	_____	 _____
0300	606.353 REFLECTORIZED FLEXIBLE GUARDRAIL MARKER	10.000 EA	_____	 _____	_____	 _____
0310	606.48 SINGLE GALVANIZED STEEL POST	4.000 EA	_____	 _____	_____	 _____
0320	606.79 GUARDRAIL 350 FLARED TERMINAL	1.000 EA	_____	 _____	_____	 _____
0330	607.22 CEDAR RAIL FENCE	72.000 LF	_____	 _____	_____	 _____
0340	607.24 REMOVE AND RESET FENCE	96.000 LF	_____	 _____	_____	 _____
0350	608.26 CURB RAMP DETECTABLE WARNING FIELD	161.000 SF	_____	 _____	_____	 _____
0360	609.11 VERTICAL CURB TYPE 1	790.000 LF	_____	 _____	_____	 _____

Maine Department of Transportation

Proposal Schedule of Items

Proposal ID: 019402.00

Project(s): 019402.00

SECTION: 1 Project Items

Alt Set ID: Alt Mbr ID:

Contractor: _____

Proposal Line Number	Item ID Description	Approximate Quantity and Units	Unit Price		Bid Amount	
			Dollars	Cents	Dollars	Cents
0370	609.12 VERTICAL CURB TYPE 1 - CIRCULAR	15.000 LF	_____	 _____	_____	 _____
0380	609.23 TERMINAL CURB TYPE 1	18.000 EA	_____	 _____	_____	 _____
0390	609.232 TERMINAL CURB TYPE I - CIRCULAR	12.000 EA	_____	 _____	_____	 _____
0400	609.31 CURB TYPE 3	390.000 LF	_____	 _____	_____	 _____
0410	609.34 CURB TYPE 5	40.000 LF	_____	 _____	_____	 _____
0420	610.08 PLAIN RIPRAP	14.000 CY	_____	 _____	_____	 _____
0430	610.09 HAND LAID RIPRAP	5.000 CY	_____	 _____	_____	 _____
0440	613.319 EROSION CONTROL BLANKET	130.000 SY	_____	 _____	_____	 _____
0450	615.07 LOAM	180.000 CY	_____	 _____	_____	 _____
0460	615.10 DIRTY BORROW	150.000 CY	_____	 _____	_____	 _____
0470	618.13 SEEDING METHOD NUMBER 1	15.000 UN	_____	 _____	_____	 _____
0480	618.14 SEEDING METHOD NUMBER 2	24.000 UN	_____	 _____	_____	 _____
0490	619.12 MULCH	39.000 UN	_____	 _____	_____	 _____

Maine Department of Transportation

Proposal Schedule of Items

Proposal ID: 019402.00

Project(s): 019402.00

SECTION: 1 Project Items

Alt Set ID: Alt Mbr ID:

Contractor: _____

Proposal Line Number	Item ID Description	Approximate Quantity and Units	Unit Price		Bid Amount	
			Dollars	Cents	Dollars	Cents
0500	620.58 EROSION CONTROL GEOTEXTILE	40.000 SY	_____	 _____	_____	 _____
0510	626.11 PRECAST CONCRETE JUNCTION BOX	5.000 EA	_____	 _____	_____	 _____
0520	626.21 METALLIC CONDUIT	70.000 LF	_____	 _____	_____	 _____
0530	626.22 NON-METALLIC CONDUIT	3,000.000 LF	_____	 _____	_____	 _____
0540	626.32 24 INCH FOUNDATION	9.000 EA	_____	 _____	_____	 _____
0550	626.332 30 INCH DIAMATER GREATER THAN 8 FEET LONG & 36 INCH DIAMETER, 42 INCH DIAMETER FOUNDATION	4.000 CY	_____	 _____	_____	 _____
0560	626.36 REMOVE OR MODIFY CONCRETE FOUNDATION	5.000 EA	_____	 _____	_____	 _____
0570	627.733 4" WHITE OR YELLOW PAINTED PAVEMENT MARKING LINE	1,700.000 LF	_____	 _____	_____	 _____
0580	627.75 WHITE OR YELLOW PAVEMENT & CURB MARKING	1,230.000 SF	_____	 _____	_____	 _____
0590	627.77 REMOVING PAVEMENT MARKINGS	200.000 SF	_____	 _____	_____	 _____
0600	627.78 TEMPORARY 4 INCH PAINTED PAVEMENT MARKING LINE, WHITE OR YELLOW	1,000.000 LF	_____	 _____	_____	 _____

Maine Department of Transportation

Proposal Schedule of Items

Proposal ID: 019402.00

Project(s): 019402.00

SECTION: 1 Project Items

Alt Set ID: Alt Mbr ID:

Contractor: _____

Proposal Line Number	Item ID Description	Approximate Quantity and Units	Unit Price		Bid Amount	
			Dollars	Cents	Dollars	Cents
0610	629.05 HAND LABOR, STRAIGHT TIME	10.000 HR	_____	 _____	_____	 _____
0620	631.12 ALL PURPOSE EXCAVATOR (INCLUDING OPERATOR)	10.000 HR	_____	 _____	_____	 _____
0630	631.172 TRUCK - LARGE (INCLUDING OPERATOR)	10.000 HR	_____	 _____	_____	 _____
0640	631.18 CHAIN SAW RENTAL (INCLUDING OPERATOR)	5.000 HR	_____	 _____	_____	 _____
0650	631.20 STUMP CHIPPER (INCLUDING OPERATOR)	5.000 HR	_____	 _____	_____	 _____
0660	631.22 FRONT END LOADER (INCLUDING OPERATOR)	10.000 HR	_____	 _____	_____	 _____
0670	631.32 CULVERT CLEANER (INCLUDING OPERATOR)	5.000 HR	_____	 _____	_____	 _____
0680	634.16 HIGHWAY LIGHTING	LUMP SUM		 LUMP SUM	_____	 _____
0690	634.2042 LED LUMINARIES	6.000 EA	_____	 _____	_____	 _____
0700	634.210 CONVENTIONAL LIGHT STANDARD	1.000 EA	_____	 _____	_____	 _____
0710	639.19 FIELD OFFICE TYPE B	1.000 EA	_____	 _____	_____	 _____
0720	643.71 TRAFFIC SIGNAL MODIFICATION	LUMP SUM		 LUMP SUM	_____	 _____

Maine Department of Transportation

Proposal Schedule of Items

Proposal ID: 019402.00

Project(s): 019402.00

SECTION: 1 Project Items

Alt Set ID: Alt Mbr ID:

Contractor: _____

Proposal Line Number	Item ID Description	Approximate Quantity and Units	Unit Price		Bid Amount	
			Dollars	Cents	Dollars	Cents
0730	643.92 PEDESTAL POLE	4.000 EA	_____	 _____	_____	 _____
0740	645.103 DEMOUNT GUIDE SIGN	3.000 EA	_____	 _____	_____	 _____
0750	645.106 DEMOUNT REGULATORY, WARNING, CONFIRMATION AND ROUTE MARKER ASSEMBLY SIGN	20.000 EA	_____	 _____	_____	 _____
0760	645.113 REINSTALL GUIDE SIGN	3.000 EA	_____	 _____	_____	 _____
0770	645.116 REINSTALL REGULATORY, WARNING, CONFIRMATION AND ROUTE MARKER ASSEMBLY SIGN	20.000 EA	_____	 _____	_____	 _____
0780	645.271 REGULATORY, WARNING, CONFIRMATION AND ROUTE MARKER ASSEMBLY SIGNS, TYPE I	120.000 SF	_____	 _____	_____	 _____
0790	645.292 REGULATORY, WARNING, CONFIRMATION AND ROUTE MARKER ASSEMBLY SIGNS TYPE II	13.000 SF	_____	 _____	_____	 _____
0800	645.512 LED BLANK-OUT SIGN, OVERHEAD MOUNT	1.000 EA	_____	 _____	_____	 _____
0810	652.33 DRUM	115.000 EA	_____	 _____	_____	 _____
0820	652.34 CONE	115.000 EA	_____	 _____	_____	 _____
0830	652.35 CONSTRUCTION SIGNS	800.000 SF	_____	 _____	_____	 _____

Maine Department of Transportation

Proposal Schedule of Items

Proposal ID: 019402.00

Project(s): 019402.00

SECTION: 1 Project Items

Alt Set ID: Alt Mbr ID:

Contractor: _____

Proposal Line Number	Item ID Description	Approximate Quantity and Units	Unit Price		Bid Amount	
			Dollars	Cents	Dollars	Cents
0840	652.36 MAINTENANCE OF TRAFFIC CONTROL DEVICES	90.000 CD	_____	 _____	_____	 _____
0850	652.38 FLAGGER	2,250.000 HR	_____	 _____	_____	 _____
0860	652.381 TRAFFIC OFFICER	40.000 HR	_____	 _____	_____	 _____
0870	652.41 PORTABLE CHANGEABLE MESSAGE SIGN	3.000 EA	_____	 _____	_____	 _____
0880	656.75 TEMPORARY SOIL EROSION AND WATER POLLUTION CONTROL	LUMP SUM		 LUMP SUM	_____	 _____
0890	659.10 MOBILIZATION	LUMP SUM		 LUMP SUM	_____	 _____
0900	801.03 TEST PITS	2.000 EA	_____	 _____	_____	 _____
Section: 1			Total:		_____	 _____
			Total Bid:		_____	 _____

August 25, 2011

SPECIAL PROVISION
SECTION 801
TEST PITS

Description. This work shall consist of excavating test pits for buried site features. At least 10 CY of material must be excavated to qualify as a test pit. Only one test pit payment per specific site will be made.

Method of Measurement. Test Pits will be measured by the unit each, complete.

Basis of Payment. Payment for test pits shall include clearing, excavation, dewatering, backfill and compaction in locations as shown on the plans or as directed.

<u>Pay Item</u>		<u>Pay Unit</u>
801.03	Test Pits	Each

Date:1/6/2020

Username: common


Division: HIGHWAY

Filename: ... \003_Estimate.dgn


ESTIMATED QUANTITIES			
ITEM NO.	DESCRIPTION	QUANTITY	UNIT
202.15	REM MANHOLE OR CATCH BASIN	EACH	1
202.202	REMOVING PAVEMENT SURFACE	SY	1,980
203.20	COMMON EXCAVATION	CY	1,400
203.24	COMMON BORROW	CY	200
203.25	GRANULAR BORROW	CY	50
206.061	STRUCT EARTH EXC-DRAIN & MINOR STRUCT-BELOW GRADE	CY	50
304.10	AGGREGATE SUBBASE COURSE - GRAVEL	CY	1,300
403.2081	12.5 MM POLYMER MODIFIED HMA	TON	211
403.209	HOT MIX ASPHALT, 9.5mm (SW,DRIVES,INCIDENTALS)	TON	280
403.211	HOT MIX ASPHALT (SHIM)	TON	53
403.213	HOT MIX ASPHALT, 12.5mm BASE	TON	150
409.15	BITUMINOUS TACK COAT - APPLIED	GAL	100
514.06	CURING BOX FOR CONCRETE CYLINDERS	EACH	1
603.159	12 INCH CULVERT PIPE OPTION III	LF	210
603.179	18 INCH CULVERT PIPE OPTION III	LF	270
603.199	24 INCH CULVERT PIPE OPTION III	LF	8
604.16	ALTERING CATCH BASIN TO MANHOLE	EACH	1
604.164	REBUILDING CATCH BASIN	EACH	1
604.2403	SPECIAL BASIN	EACH	2
604.243	CATCH BASIN TYPE F3-C	EACH	2
604.245	CATCH BASIN TYPE F4-C	EACH	2
604.248	CATCH BASIN TYPE F6	EACH	2
604.26	CATCH BASIN TYPE B5	EACH	2
604.262	CATCH BASIN TYPE B5-C	EACH	1
606.1301	31 INCH W-BM GR, MID-WAY SPLICE - SINGLE FACED	LF	288
606.1304	31 INCH W-BM GR, MID-WAY SPLICE - OVER 15' RADIUS	LF	25
606.1305	31 INCH W-BM GR, MID-WAY SPLICE - FLARED TERMINAL	EACH	1
606.178	GUARDRAIL BEAM	LF	25
606.265	TERMINAL END - SINGLE RAIL GALV STEEL	EACH	4
606.353	REFLECTORIZED FLEXIBLE GUARDRAIL MARKER	EACH	10
606.48	SINGLE GALVANIZED STEEL POST	EACH	4
606.79	GUARDRAIL 350 FLARED TERMINAL	EACH	1
607.22	CEDAR RAIL FENCE	LF	72
607.24	REMOVE AND RESET FENCE	LF	96
608.26	CURB RAMP DETECTABLE WARNING FIELD	SF	161
609.11	VERTICAL CURB TYPE 1	LF	790
609.12	VERTICAL CURB TYPE 1 - CIRCULAR	LF	15
609.23	TERMINAL CURB TYPE 1	EACH	18
609.232	TERMINAL CURB TYPE 1 - CIRCULAR	EACH	12
609.31	CURB TYPE 3	LF	390
609.34	CURB TYPE 5	LF	40
610.08	PLAIN RIPRAP	CY	14
610.09	HAND LAID RIPRAP	CY	5
613.319	EROSION CONTROL BLANKET	SY	130
615.07	LOAM	CY	180
615.10	DIRTY BORROW	CY	150
618.13	SEEDING METHOD NUMBER 1	UNIT	15
618.14	SEEDING METHOD NUMBER 2	UNIT	24
619.12	MULCH	UNIT	39
620.58	EROSION CONTROL GEOTEXTILE	SY	40
626.11	PRECAST CONCRETE JUNCTION BOX	EACH	5
626.21	METALLIC CONDUIT	LF	70
626.22	NON-METALLIC CONDUIT	LF	3,000
626.32	24" FOUNDATION	EACH	9
626.332	30" DIA GREATER 8' LONG & 36" DIA & 42" DIA FOUNDATION	CY	4
626.36	REMOVE OR MODIFY CONCRETE FOUNDATION	EACH	5
627.733	4" WHITE OR YELLOW PAINTED PVMT MARKING LINE	LF	1,700
627.75	WHITE OR YELLOW PAVEMENT AND CURB MARKING	SF	1,190
627.77	REMOVING PAVEMENT MARKINGS	SF	200
627.78	TEMPORARY 4 INCH PAINTED PVMT MARK LINE W OR Y	LF	1,000
629.05	HAND LABOR	HR	10
631.12	ALL PURPOSE EXCAVATOR (INCLUDING OPERATOR)	HR	10
631.172	TRUCK - LARGE (INCLUDING OPERATOR)	HR	10
631.18	CHAIN SAW RENTAL (INCLUDING OPERATOR)	HR	5
631.20	STUMP CHIPPER (INCLUDING OPERATOR)	HR	5
631.22	FRONT END LOADER (INCLUDING OPERATOR)	HR	10
631.32	CULVERT CLEANER (INCLUDING OPERATOR)	HR	5
634.160	HIGHWAY LIGHTING	LS	1
634.2042	LED LUMINAIRES	EACH	6
634.210	CONVENTIONAL LIGHT STANDARD	EACH	1
639.19	FIELD OFFICE TYPE B	EACH	1
643.71	TRAFFIC SIGNAL MODIFICATIONS	LS	1
643.92	PEDESTAL POLE	EACH	4
645.103	DEMOUNT GUIDE SIGN	EACH	3
645.106	DEMOUNT REG, WRN, CON, & RTE SIGN	EACH	20
645.113	REINSTALL GUIDE SIGN	EACH	3
645.116	REINSTALL REG, WRN, CON, & RTE SIGN	EACH	20
645.271	REG WARN CONF RTE SIGNS TYPE I	SF	120
645.292	REG WARN CONF RTE SIGNS TYPE II	SF	13
645.512	LED BLANK-OUT SIGN	EACH	1

ESTIMATED QUANTITIES			
ITEM NO.	DESCRIPTION	QUANTITY	UNIT
652.33	DRUM	EACH	115
652.34	CONE	EACH	115
652.35	CONSTRUCTION SIGNS	SF	800
652.36	MAINTENANCE OF TRAFFIC CONTROL DEVICES	CD	90
652.38	FLAGGER	HR	2,250
652.381	TRAFFIC OFFICER	HR	40
652.41	PORTABLE CHANGEABLE MESSAGE SIGN	EACH	3
656.75	TEMP. SOIL EROSION AND WATER POLLUTION CONTROL PLAN	LS	1
659.10	MOBILIZATION	LS	1
801.03	TEST PITS	EACH	2

ESTIMATED QUANTITIES				
ITEM NO.	DESCRIPTION	QUANTITY	UNIT	
SUMMARY OF EARTHWORK AND BORROW				
COMMON EXCAVATION FOR ESTIMATE				
COMMON EXCAVATION (FROM CROSS SECTIONS - MAINLINE)		1,289	CY	
PAVEMENT REMOVAL OUTSIDE OF SECTIONS		41	CY	
GRUBBING IN FILL		70	CY	
TOTAL COMMON EXCAVATION		1,400	CY	
FILL FOR BORROW CALCULATIONS				
COMMON FILL (FROM CROSS SECTIONS - MAINLINE)		841	CY	
COMMON BORROW OUTSIDE OF SECTIONS		21	CY	
GRUBBING IN FILL		70	CY	
TOTAL FILL		932	CY	
ROCK EXCAVATION FOR ESTIMATE				
ROCK EXCAVATION		0	CY	
TOTAL ROCK EXCAVATION		0	CY	
AVAILABLE COMMON EXCAVATION FOR BORROW CALCULATIONS				
(1) TOTAL COMMON EXCAVATION DEDUCTIONS:				
GRUBBING IN CUTT		250	CY	
GRUBBING IN FILL		70	CY	
PAVEMENT SALVAGE REMOVAL		226	CY	
(2) TOTAL DEDUCTIONS		546	CY	
TOTAL AVAILABLE COMMON EXCAVATION (1) MINUS (2)		854	CY	
COMPUTATION OF COMMON BORROW FOR ESTIMATE				
(3) TOTAL FILL				
TOTAL AVAILABLE NON-ROCK EXCAV.		854	X 0.90 = 769	CY
TOTAL AVAILABLE ROCK EXCAV.		0	X 1.30 = 0	CY
(4) TOTAL AVAILABLE EXCAVATION		769	CY	
BORROW NEEDED (3) MINUS (4)		163	CY	
TOTAL SURPLUS WASTE MATERIAL		546	CY	

STATE OF MAINE DEPARTMENT OF TRANSPORTATION AC-STP-1940(200)X	WIN 019402.00 HIGHWAY PLANS
	SIGNATURE: _____ P.E. NUMBER: 7960 DATE: 11/11/19
AUGUSTA CIVIC CENTER DRIVE ESTIMATED QUANTITIES	SHEET NUMBER 3 OF 52

Filename: ... \014_HDPlan_05.dgn
 Division: HIGHWAY
 Username: common
 Date: 1/6/2020

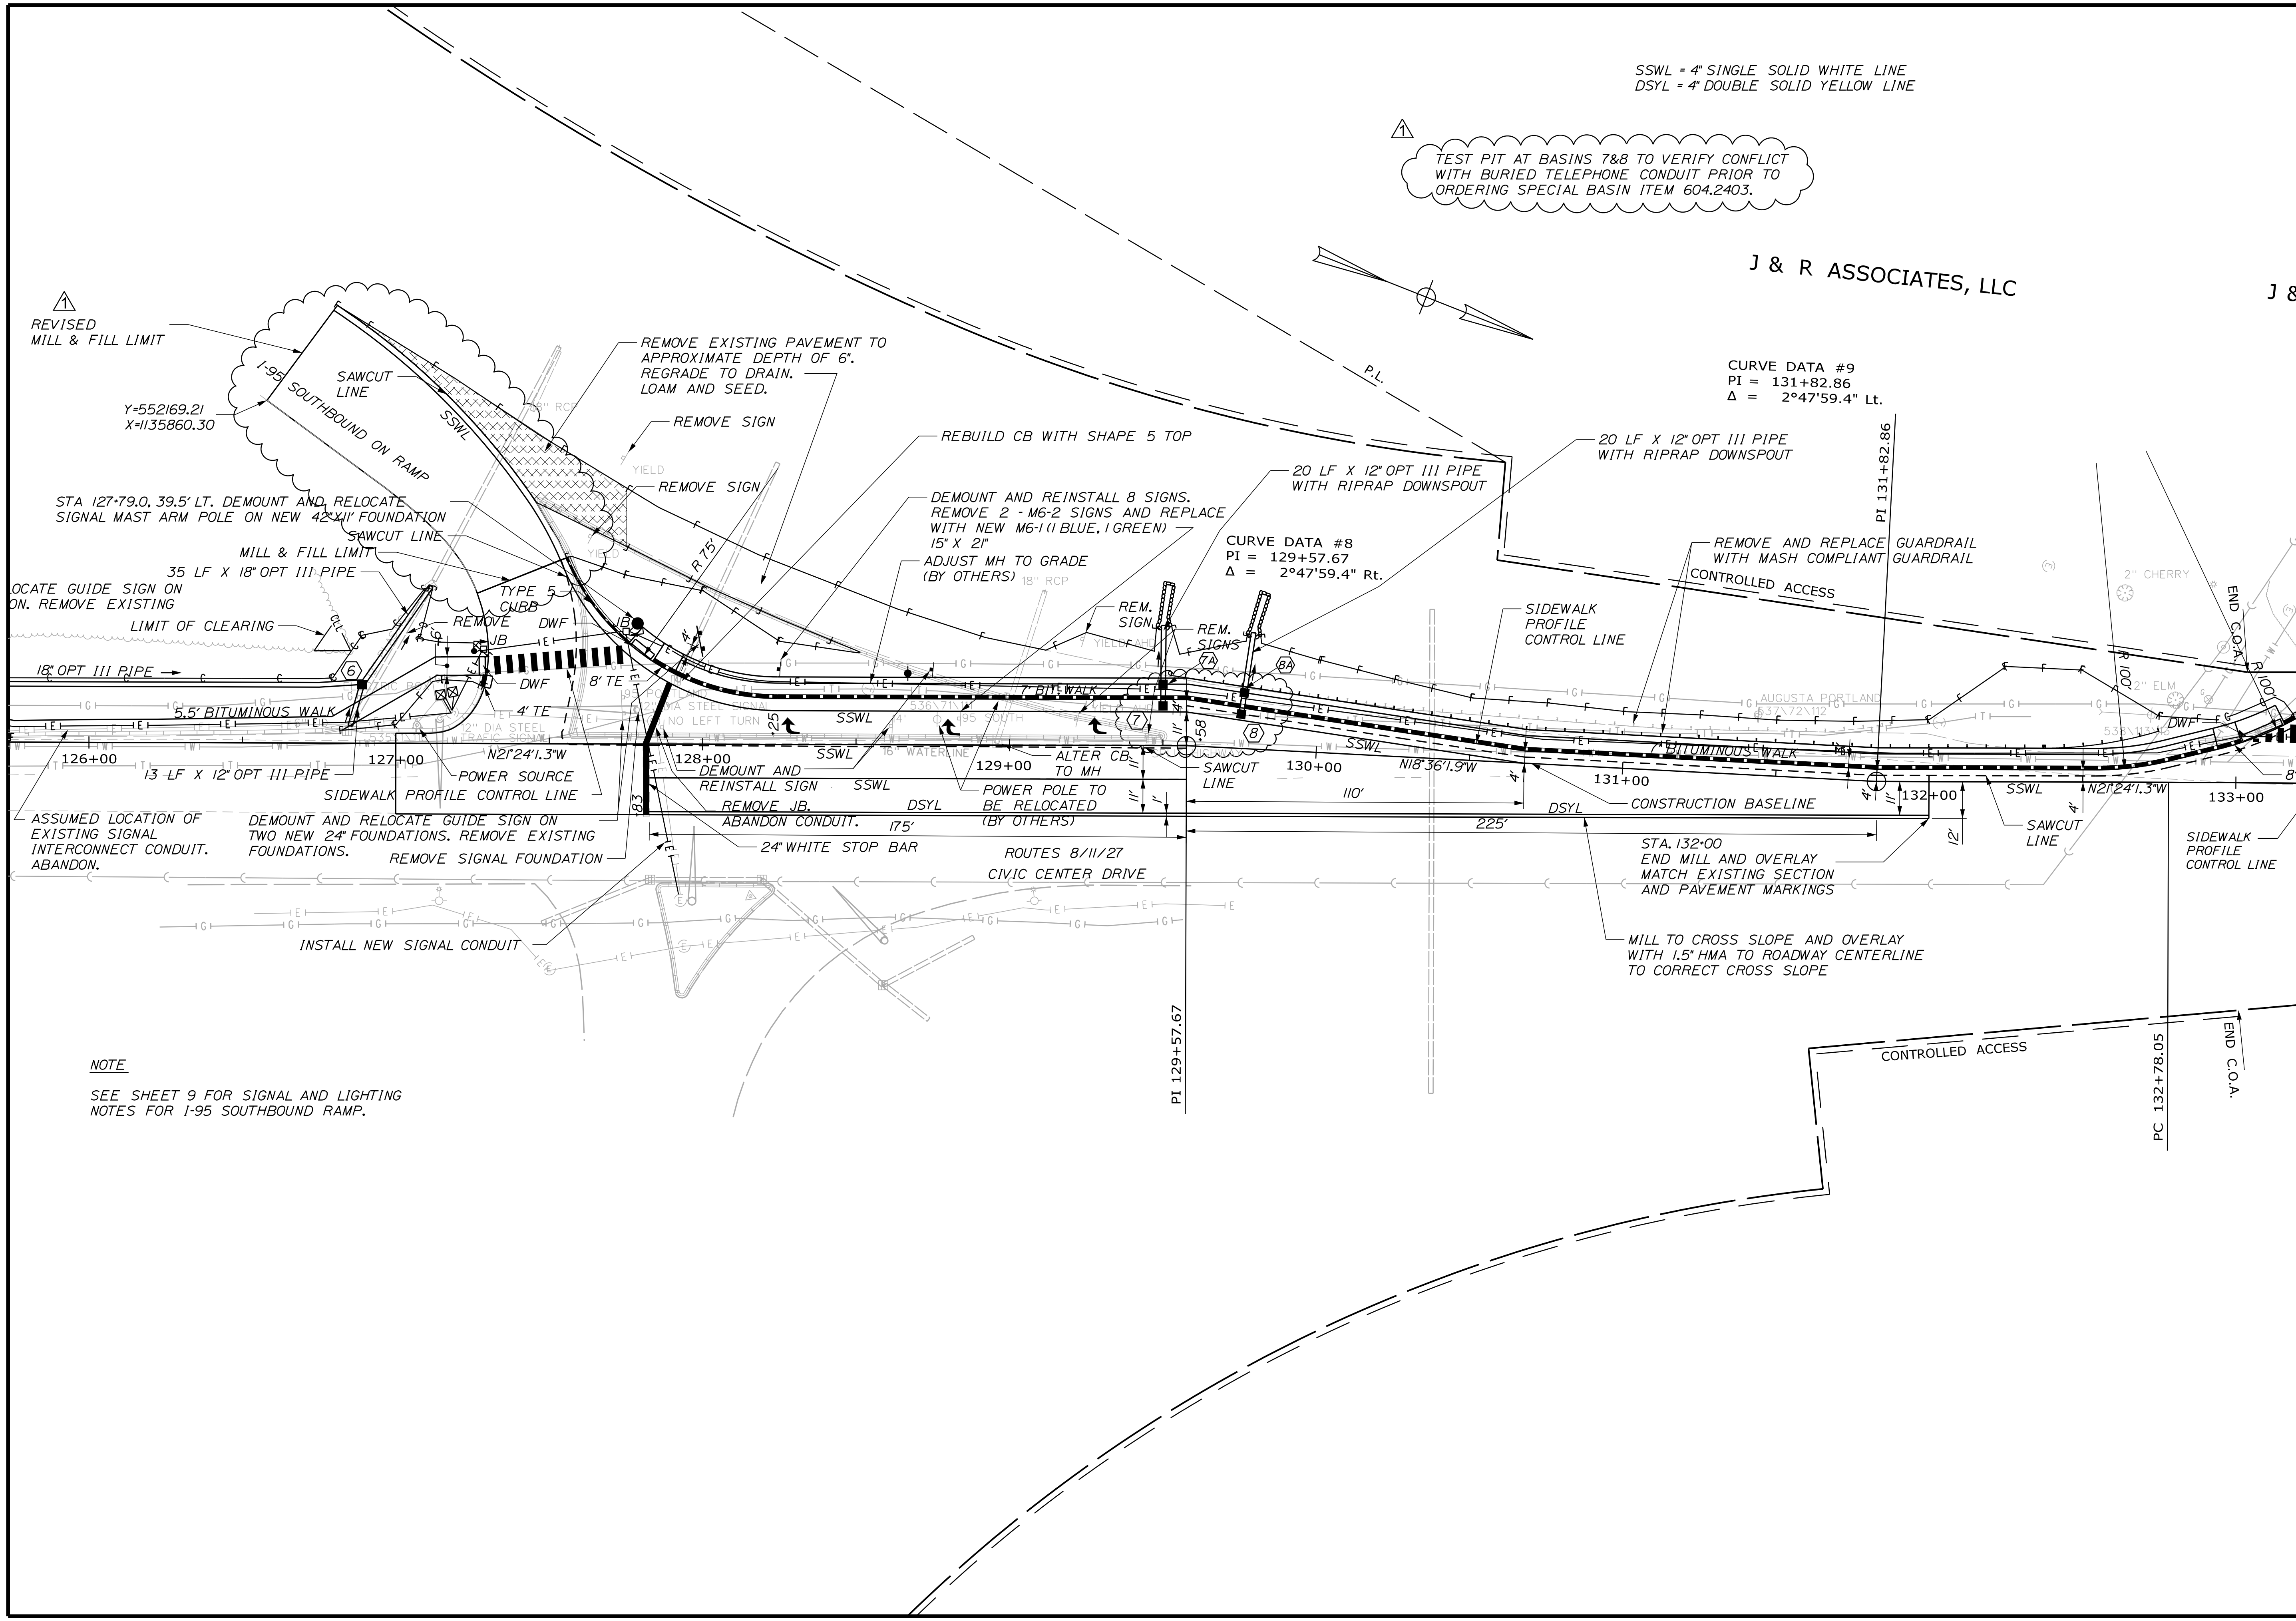

TEST PIT AT BASINS 7&8 TO VERIFY CONFLICT WITH BURIED TELEPHONE CONDUIT PRIOR TO ORDERING SPECIAL BASIN ITEM 604.2403.

SSWL = 4" SINGLE SOLID WHITE LINE
 DSYL = 4" DOUBLE SOLID YELLOW LINE

J & R ASSOCIATES, LLC

CURVE DATA #9
 PI = 131+82.86
 Δ = 2°47'59.4" Lt.

CURVE DATA #8
 PI = 129+57.67
 Δ = 2°47'59.4" Rt.

NOTE
 SEE SHEET 9 FOR SIGNAL AND LIGHTING NOTES FOR I-95 SOUTHBOUND RAMP.

STATE OF MAINE DEPARTMENT OF TRANSPORTATION		AC-STP-1940(200)X		WIN 019402.00		HIGHWAY PLANS	
		SIGNATURE		P.E. NUMBER		DATE	
		7960		11/17/19			
PROJ. MANAGER	A. GORNEAU II	BY		DATE		FIELD CHANGES	
DESIGN-DETAILED	ALG	DATE	11/19				
CHECKED-REVIEWED	ALG	DATE	11/19				
DESIGN-DETAILED		DATE					
REVISIONS 1							
REVISIONS 2							
REVISIONS 3							
REVISIONS 4							
AUGUSTA DRIVE CIVIC CENTER DRIVE		PLANS		SHEET NUMBER		14	
						OF 52	







Date: 1/6/2020

Username: common

Division: HIGHWAY

Filename: ... \041_XSECT_129+25_021.dgn

TEST PIT AT BASINS 7&8 TO VERIFY CONFLICT WITH BURIED TELEPHONE CONDUIT PRIOR TO ORDERING SPECIAL BASIN ITEM 604.2403.

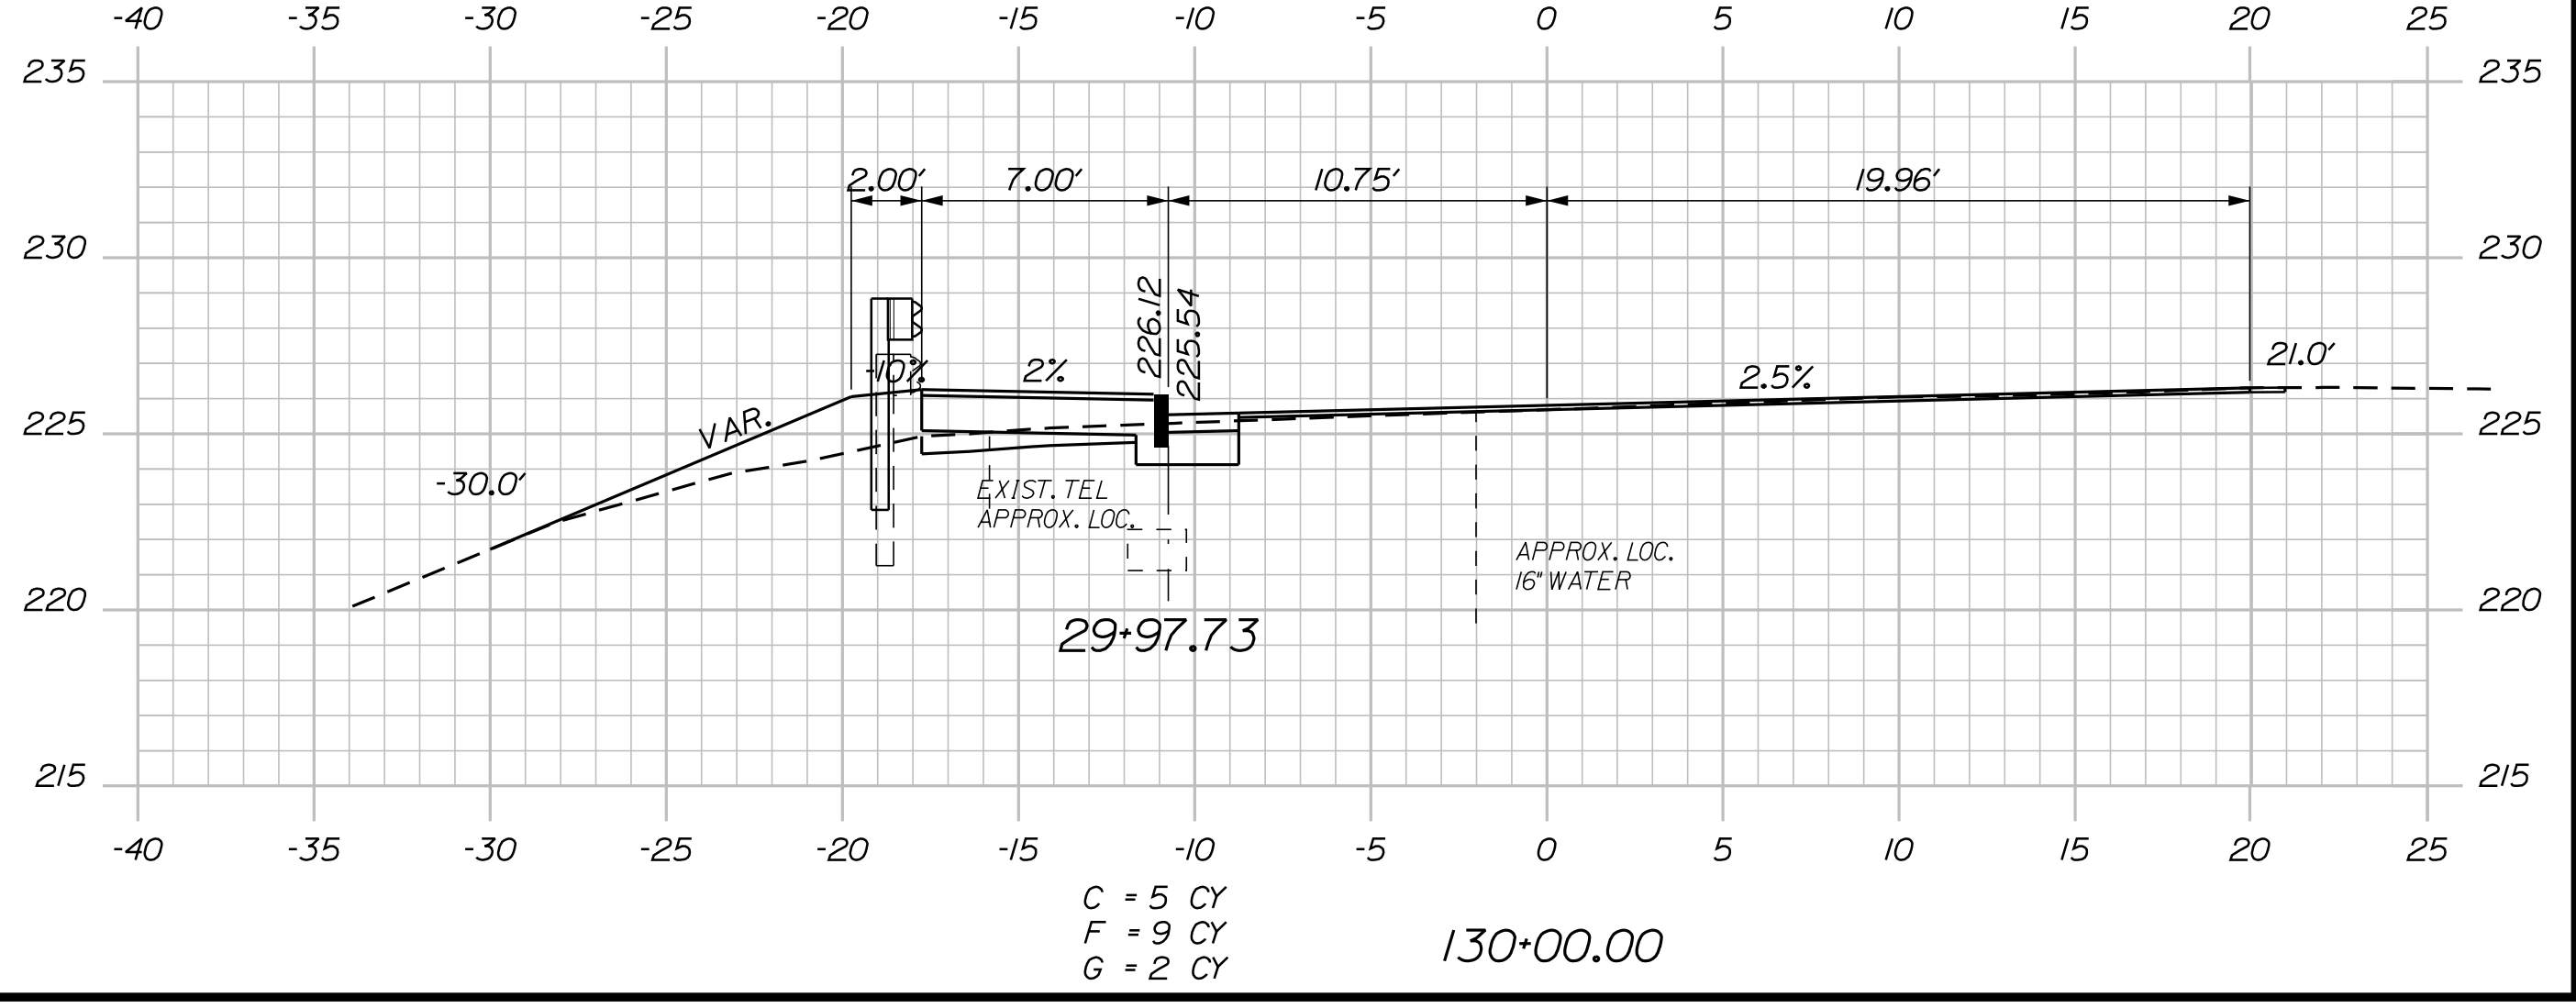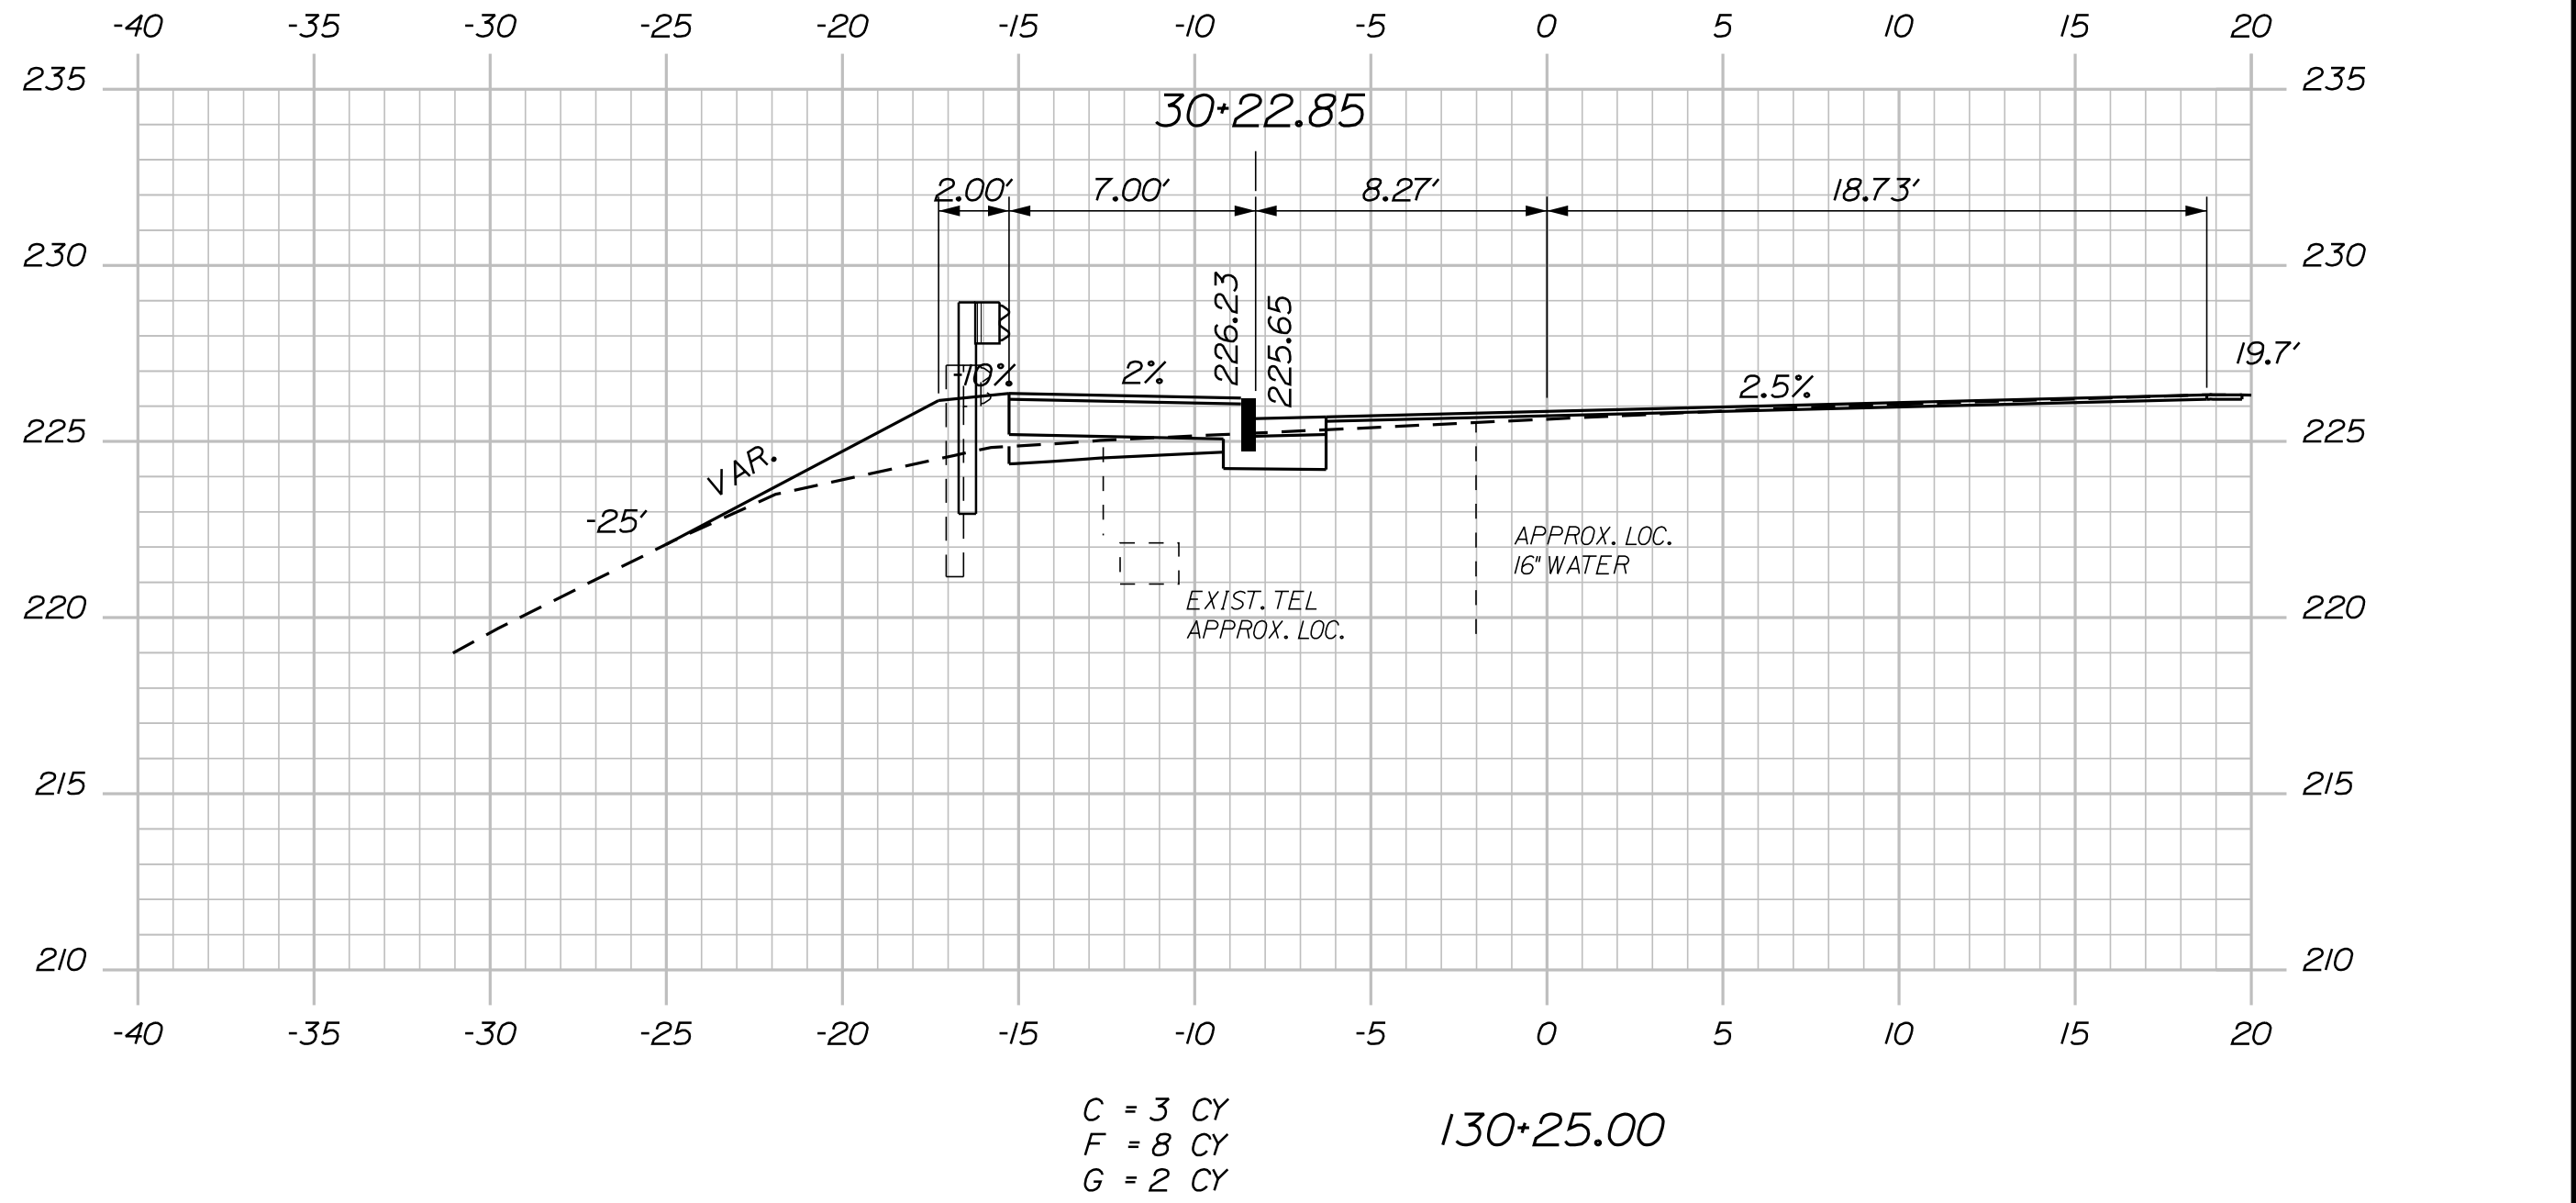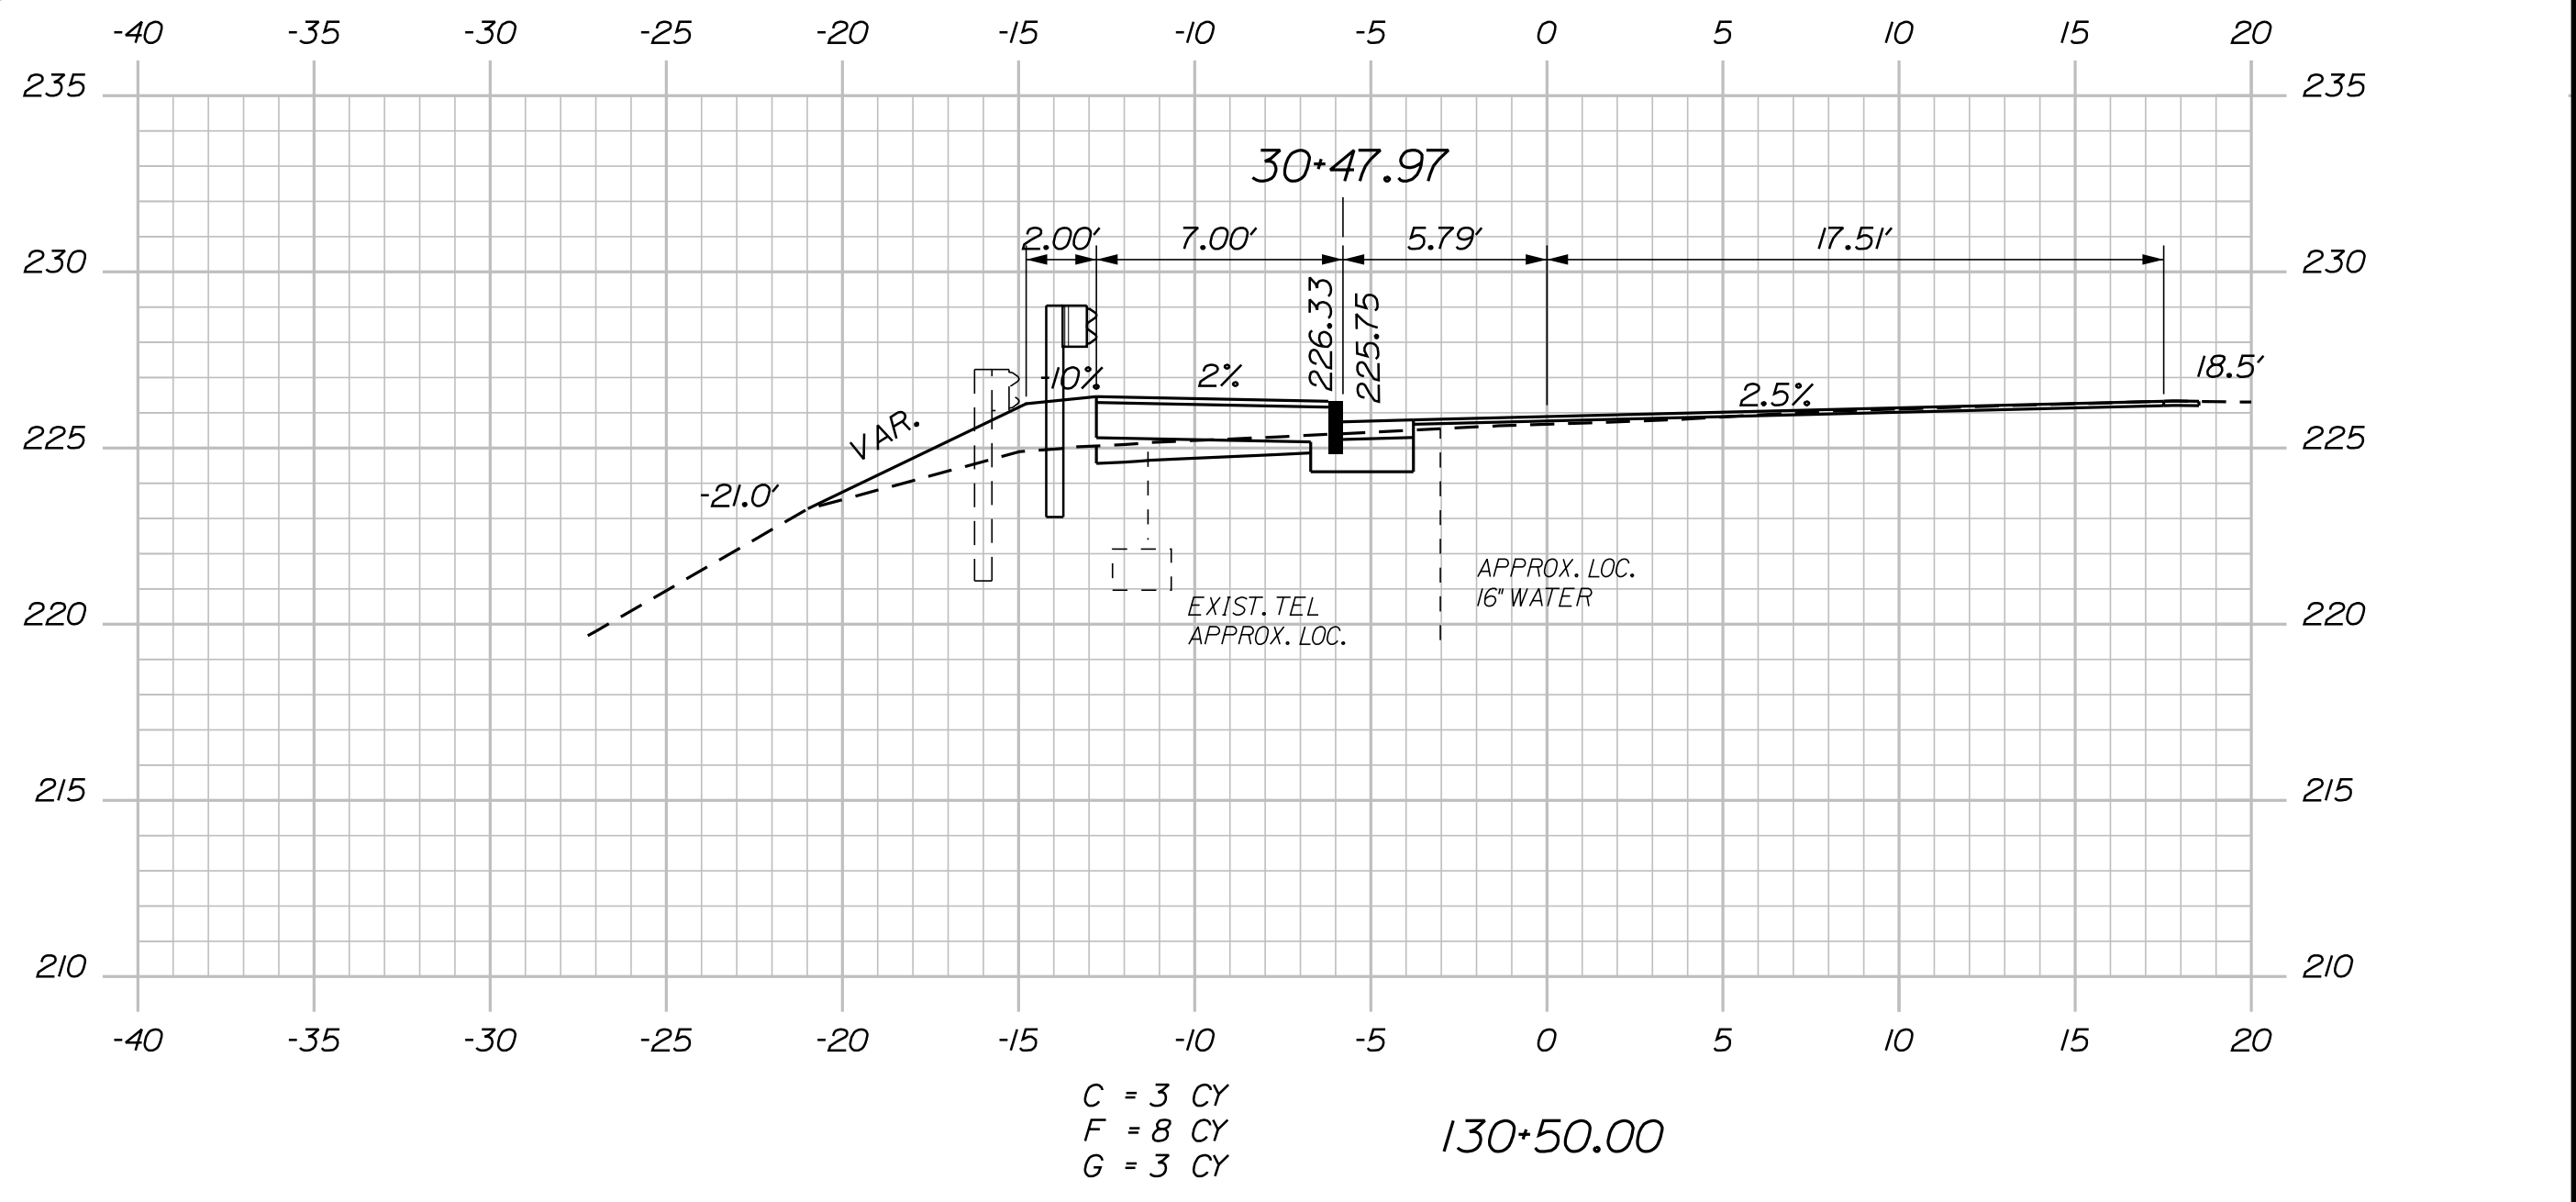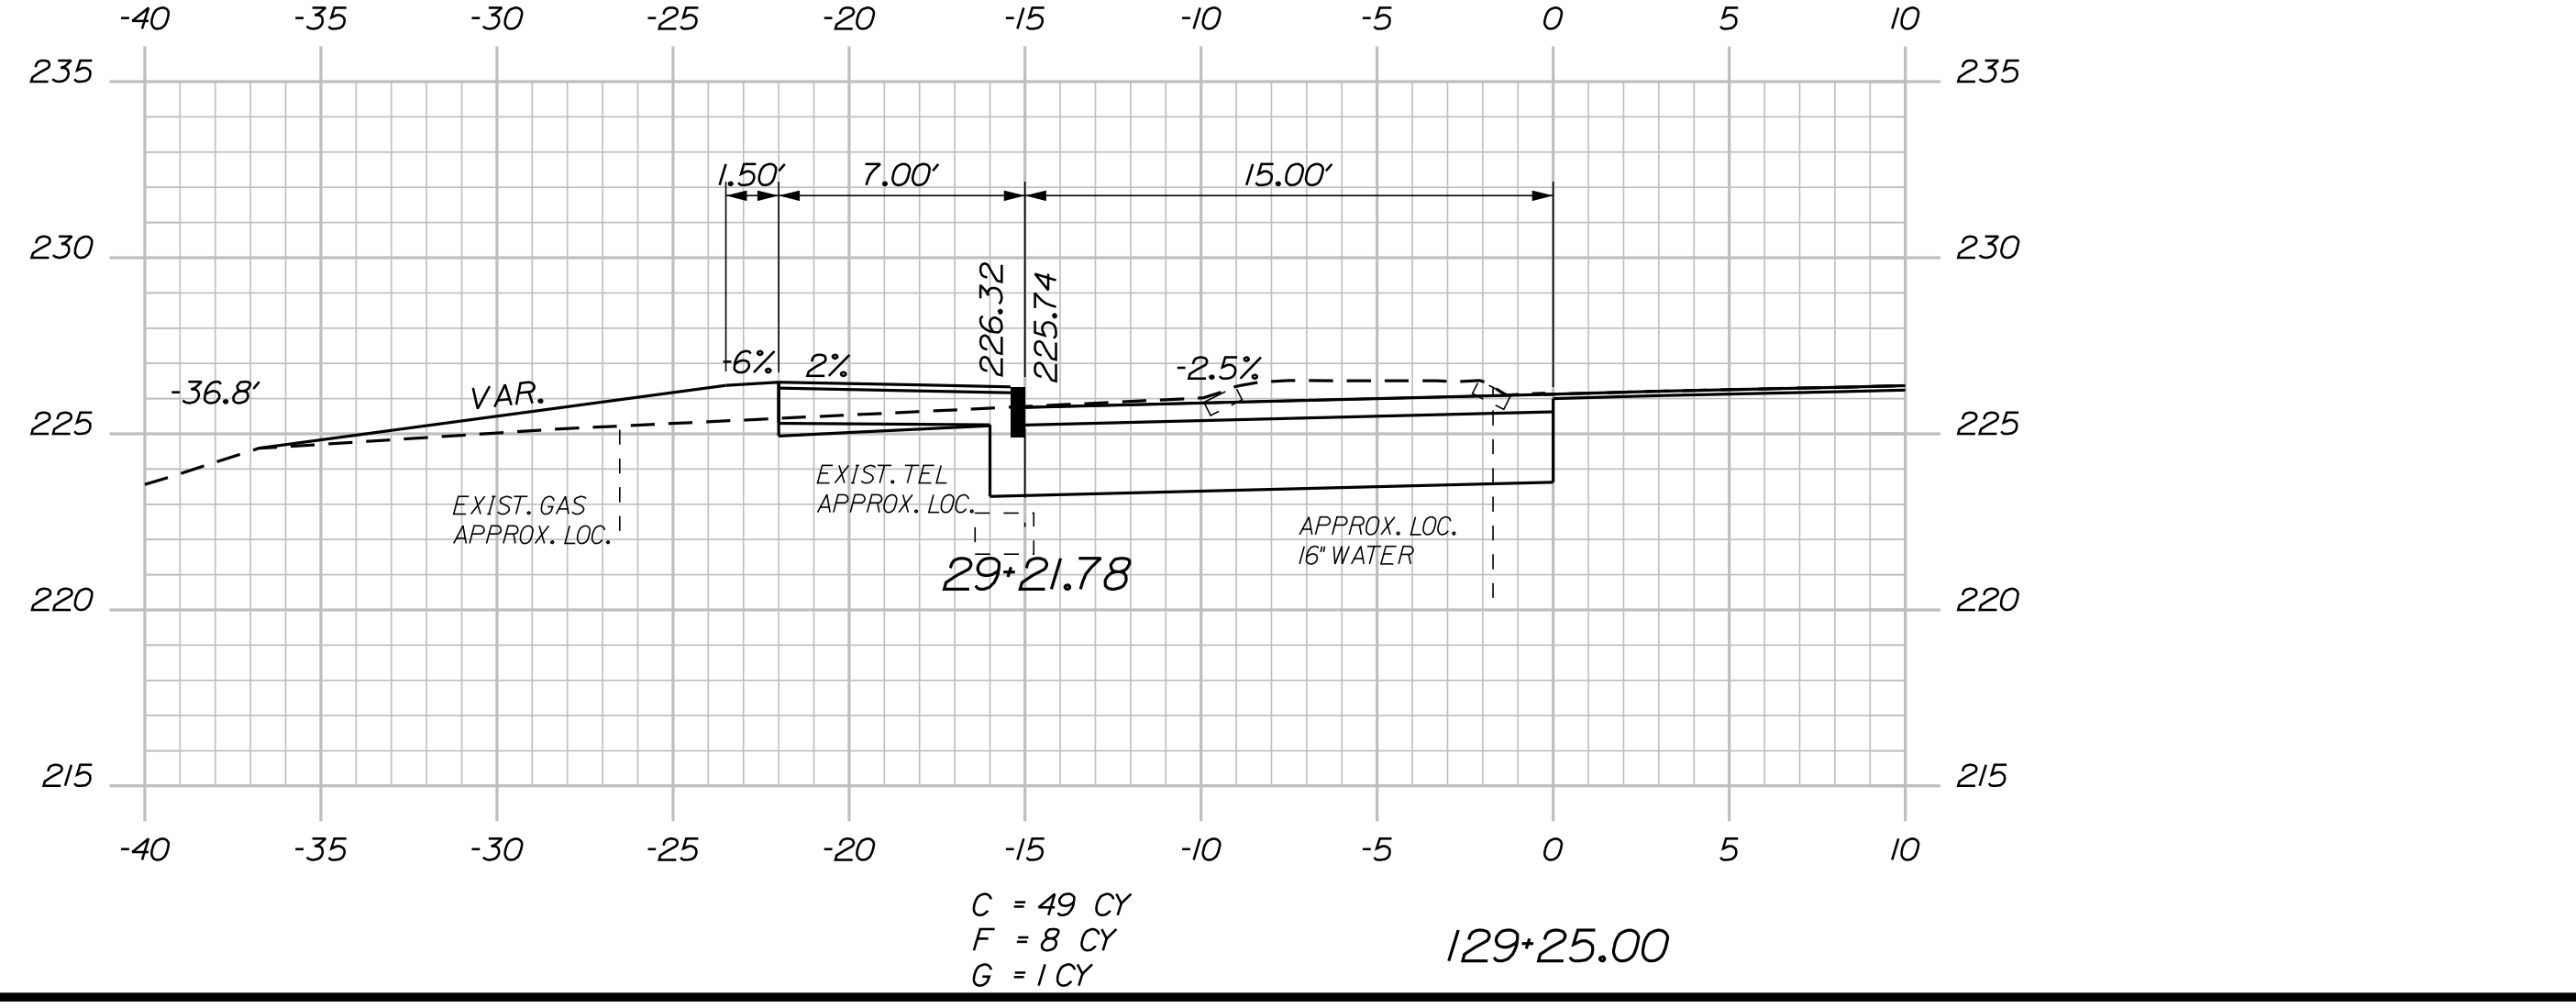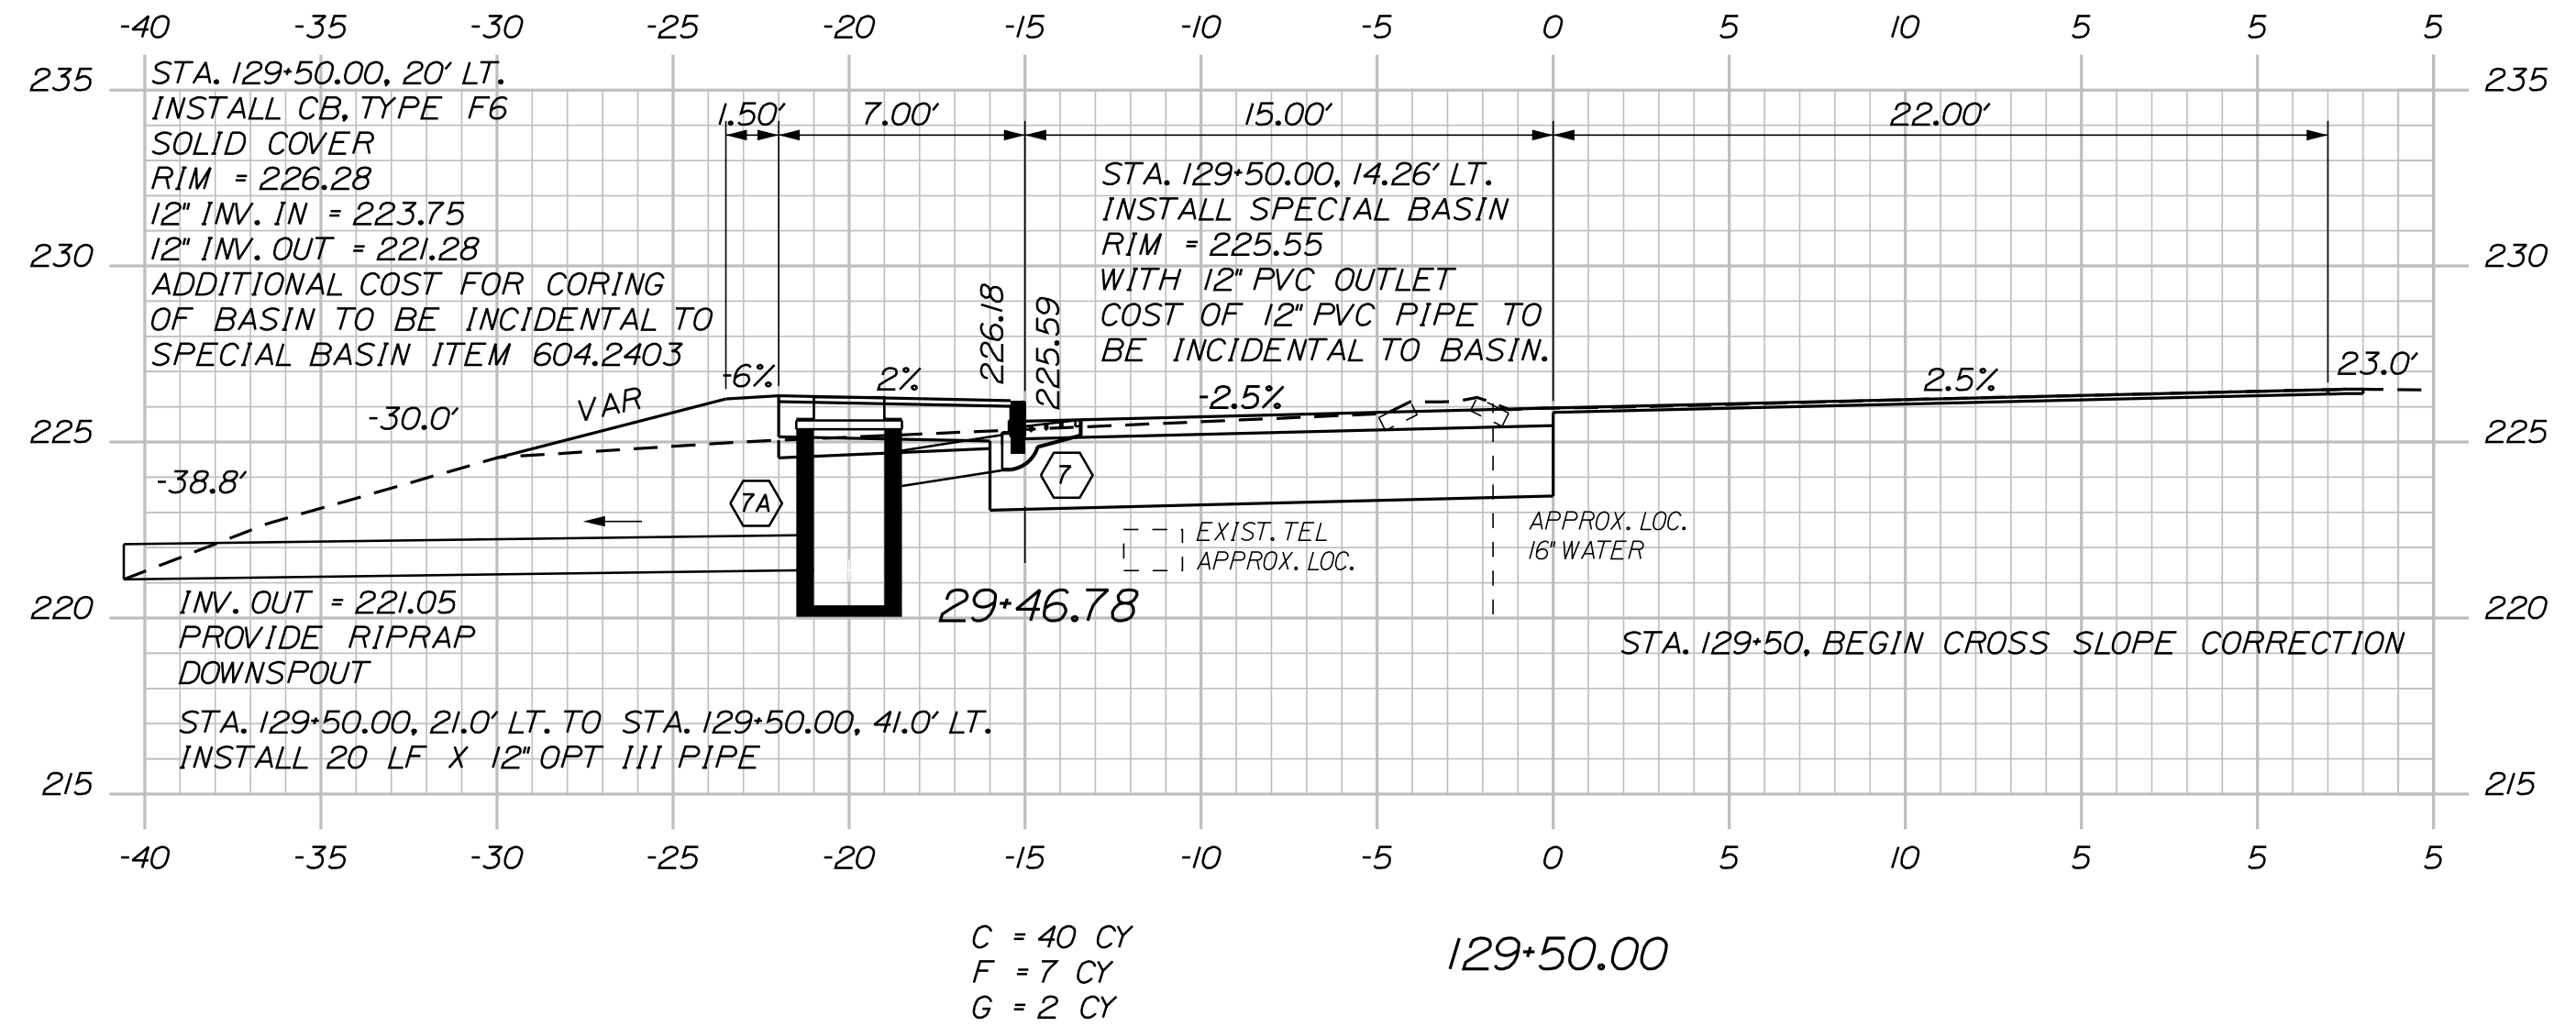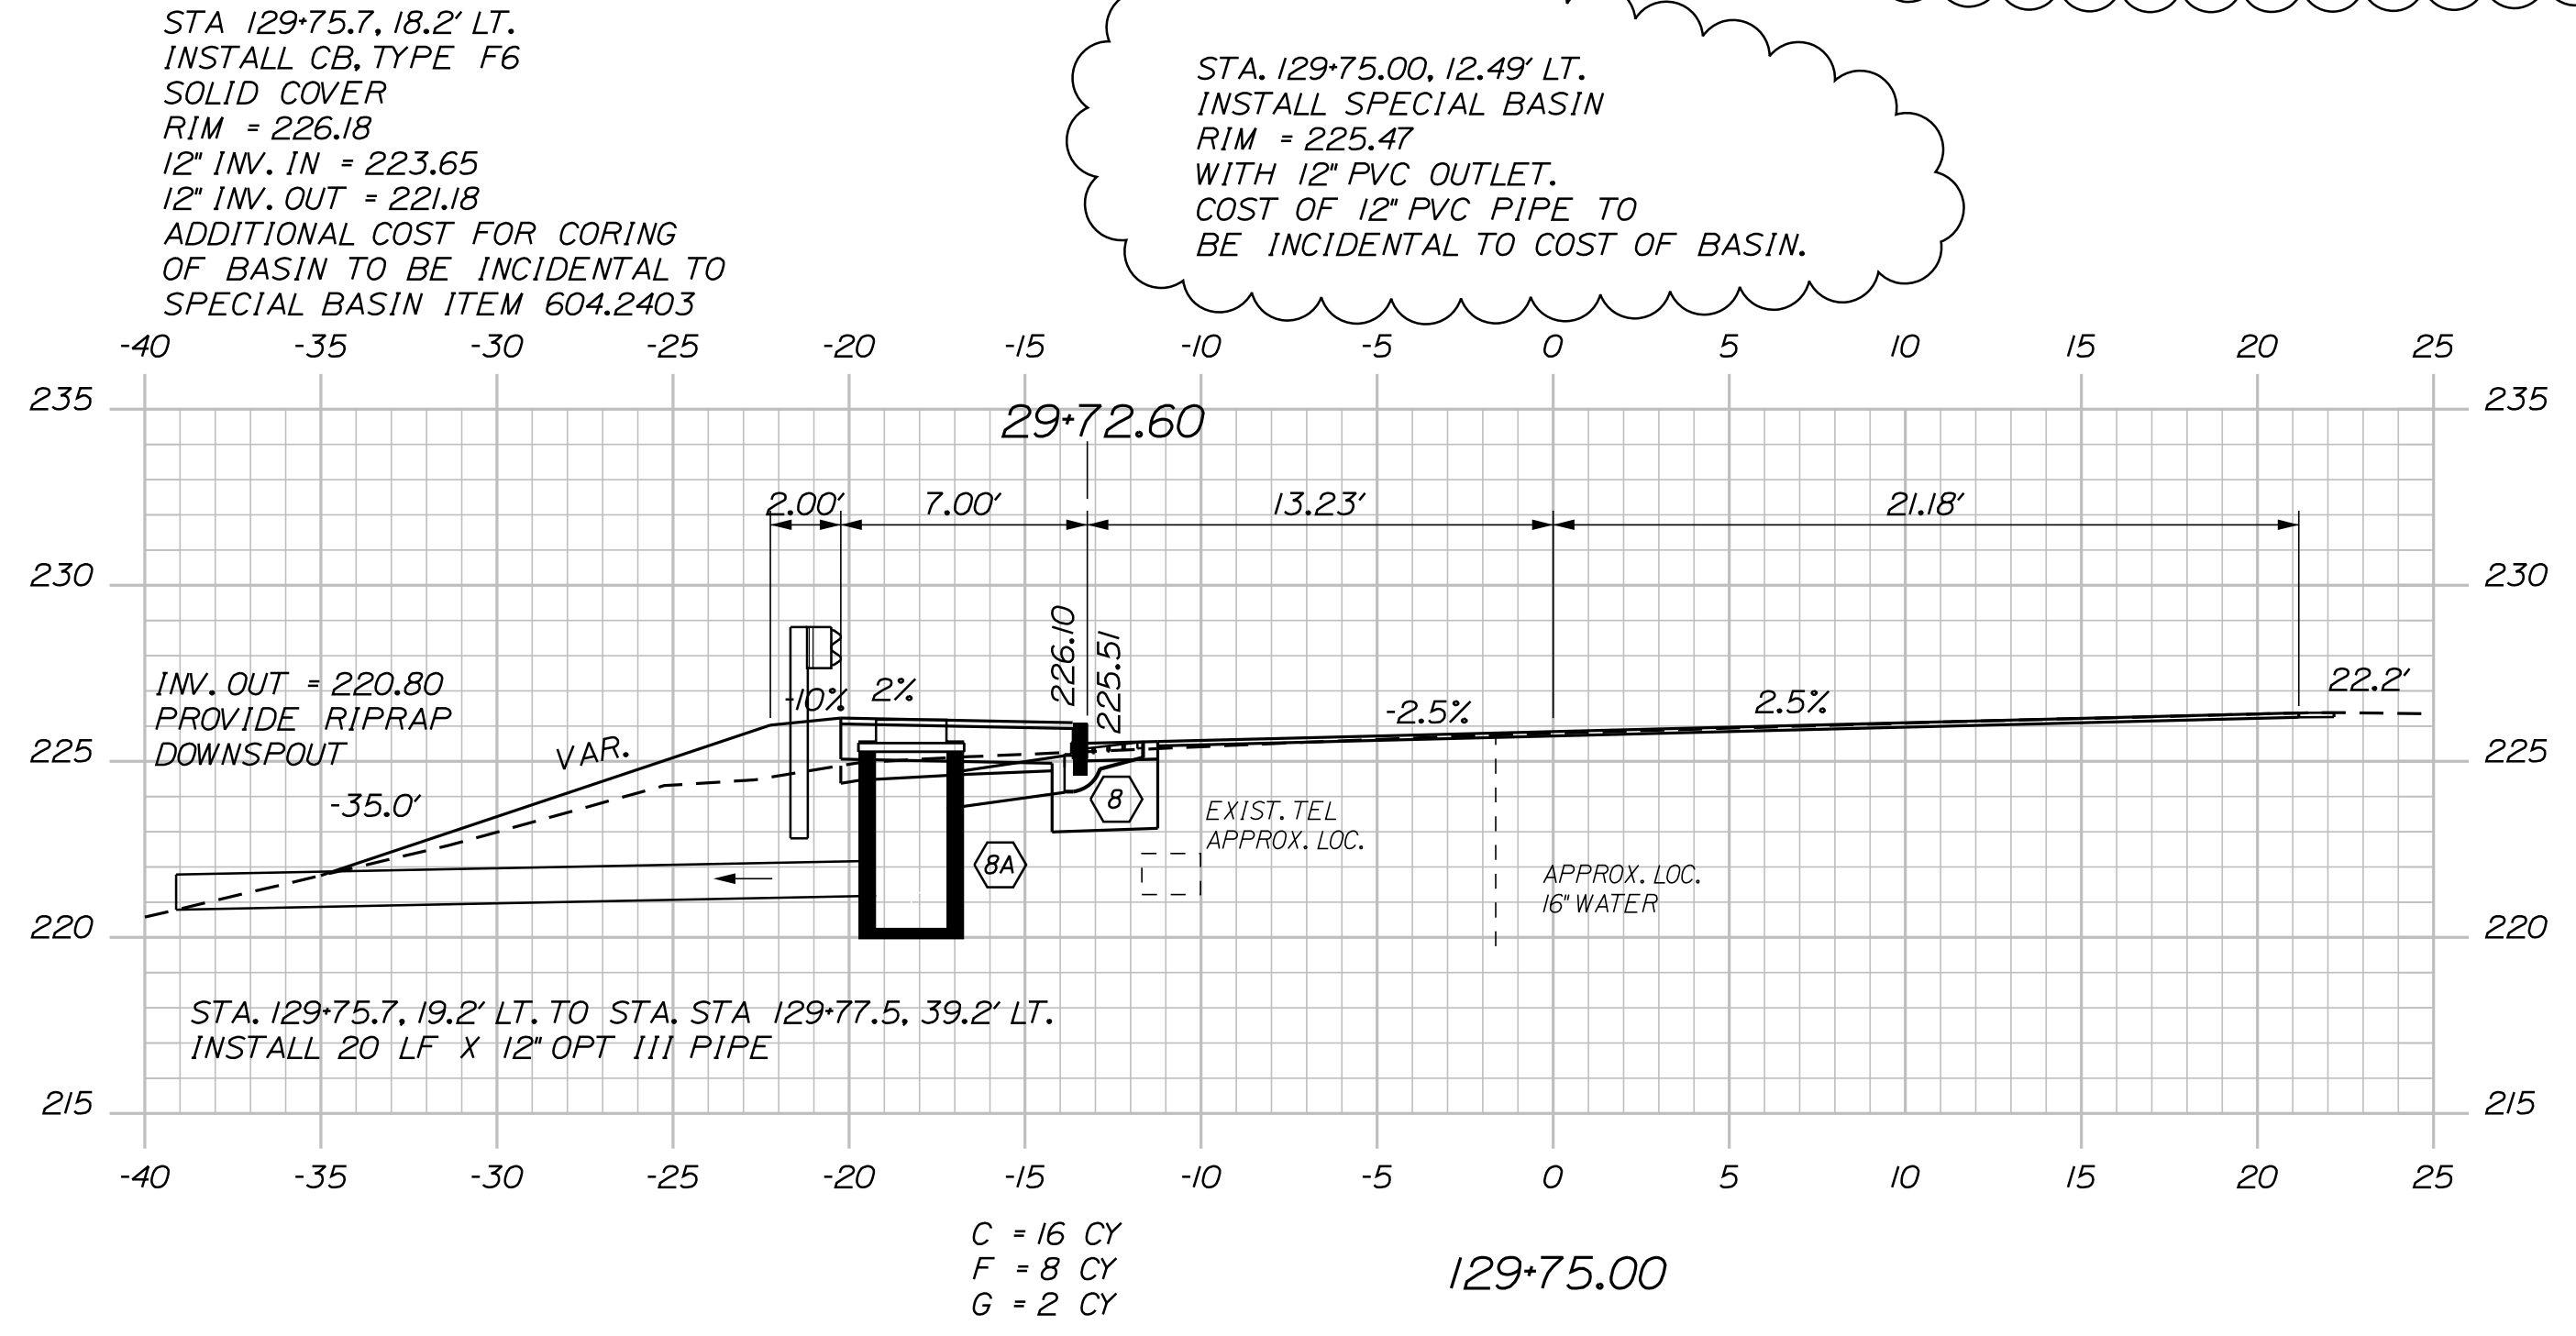

STATE OF MAINE
DEPARTMENT OF TRANSPORTATION
AC-STP-1940(200)X
WIN
019402.00
HIGHWAY PLANS



SIGNATURE
7960
P.E. NUMBER
11/11/19
DATE

PROJ. MANAGER	BY	DATE
A. GORNEAU II	JLE	11-19
DESIGN-DETAILED	ALG	11-19
CHECKED-REVIEWED	ALG	11-19
DESIGN-DETAILED	JLE	
DESIGN-DETAILED	JLE	
REVISIONS 1	RIM ELEV. / TEST PIT	1-6-19
REVISIONS 2		
REVISIONS 3		
REVISIONS 4		
FIELD CHANGES		

AUGUSTA DRIVE
CIVIC CENTER DRIVE
CROSS SECTIONS

SHEET NUMBER
41
OF 52