



STATE OF MAINE  
DEPARTMENT OF TRANSPORTATION  
16 STATE HOUSE STATION  
AUGUSTA, MAINE 04333-0016

Janet T. Mills  
GOVERNOR

Bruce A. Van Note  
COMMISSIONER

April 13, 2022  
Subject: Reconstruct Terminal Apron  
State WIN: 020655.07  
AIP Project No. 3-23-0036-XXX-2022  
Location: **Augusta**  
**Amendment No. 1**

Dear Sir/Ms.:

The following people attended the non-mandatory pre-bid meeting held Tuesday, April 12 at the Augusta State Airport:

John Guimond	Augusta State Airport
Peter Couillard	Augusta State Airport
Rick Dubois	MaineDOT
Tim LeSiege	MaineDOT
Nils Gonzalez	Hoyle Tanner
Chris McGary	Gordon Contracting

Please make the following changes to the Bid Documents:



In the Plan Set:

**REMOVE** DRAWING NO. G1.4, CONSTRUCTION SAFETY AND PHASING PLAN and **REPLACE** with the attached, revised DRAWING NO. G1.4, CONSTRUCTION SAFETY AND PHASING PLAN

Consider these changes and information prior to submitting your bid on **April 20, 2022**.

Sincerely,

George M. A. Macdougall P.E.  
Contracts & Specifications Engineer

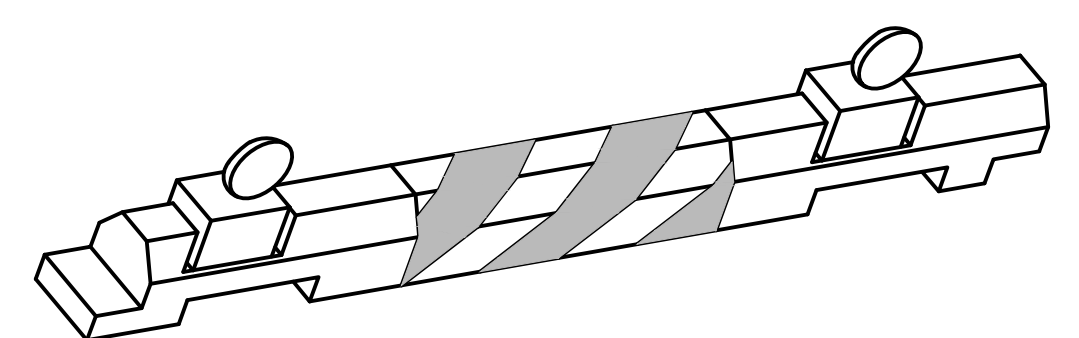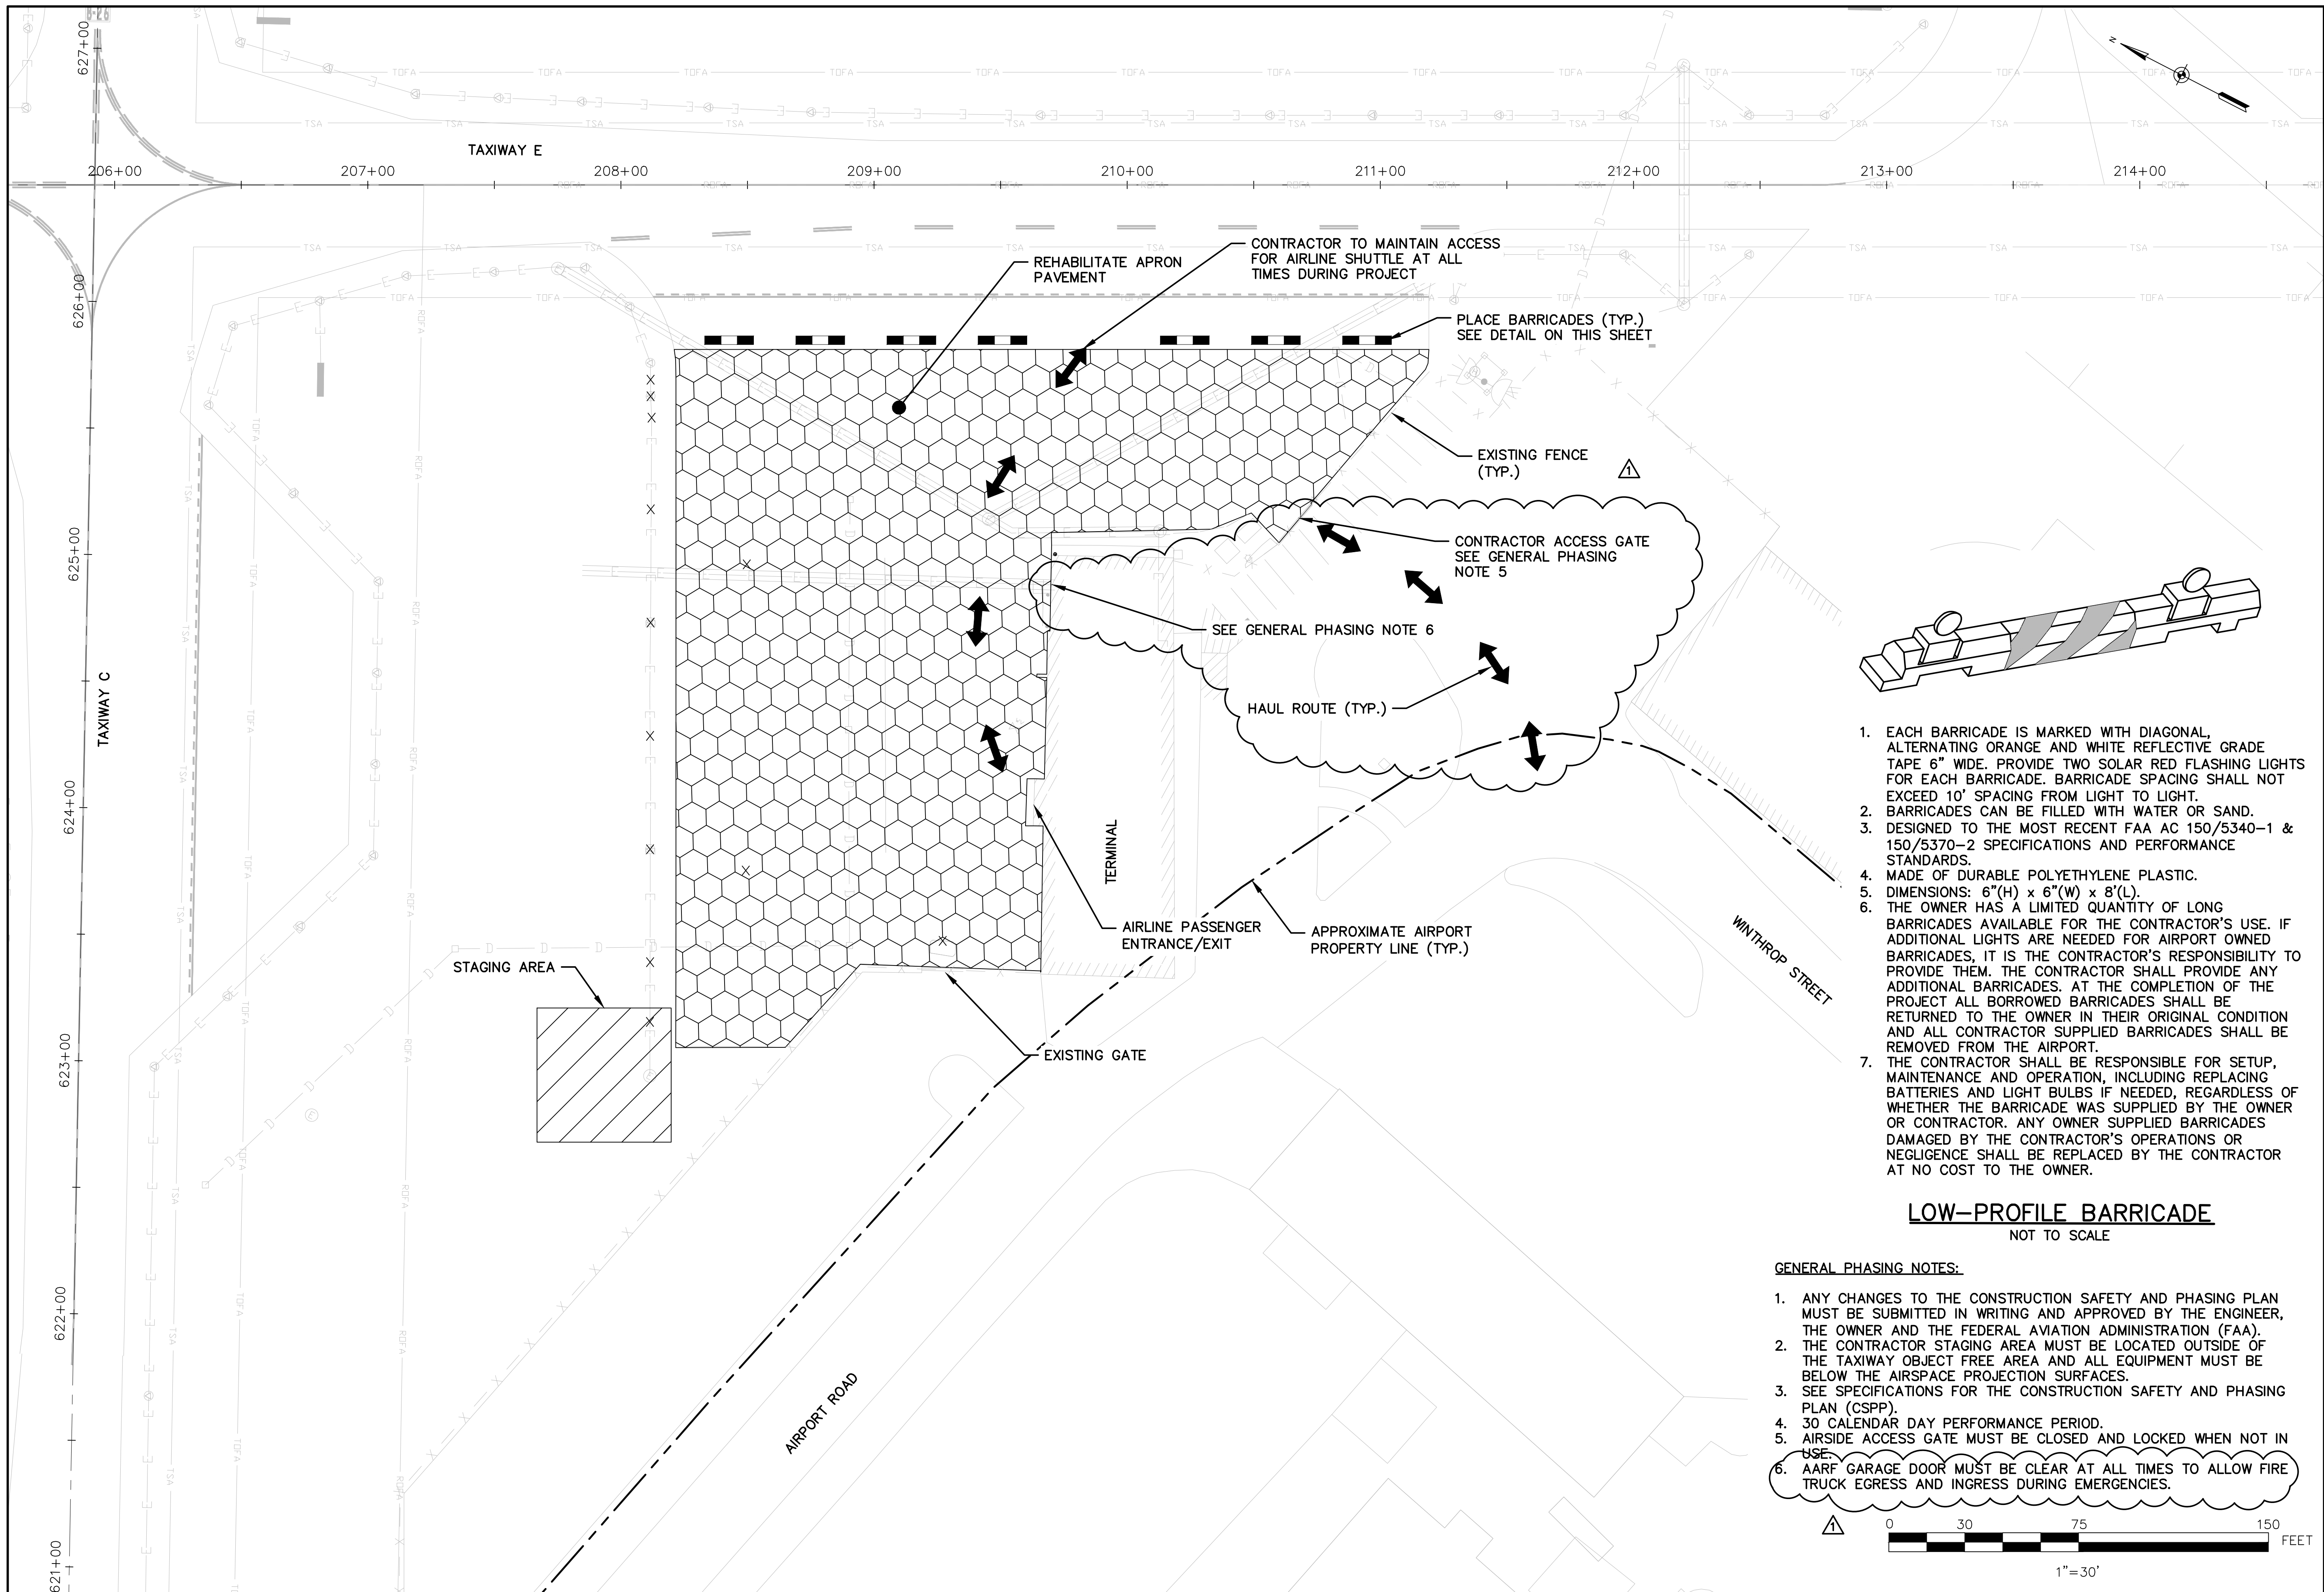


1. EACH BARRICADE IS MARKED WITH DIAGONAL, ALTERNATING ORANGE AND WHITE REFLECTIVE GRADE TAPE 6" WIDE. PROVIDE TWO SOLAR RED FLASHING LIGHTS FOR EACH BARRICADE. BARRICADE SPACING SHALL NOT EXCEED 10' SPACING FROM LIGHT TO LIGHT.
2. BARRICADES CAN BE FILLED WITH WATER OR SAND.
3. DESIGNED TO THE MOST RECENT FAA AC 150/5340-1 & 150/5370-2 SPECIFICATIONS AND PERFORMANCE STANDARDS.
4. MADE OF DURABLE POLYETHYLENE PLASTIC.
5. DIMENSIONS: 6"(H) x 6"(W) x 8"(L).
6. THE OWNER HAS A LIMITED QUANTITY OF LONG BARRICADES AVAILABLE FOR THE CONTRACTOR'S USE. IF ADDITIONAL LIGHTS ARE NEEDED FOR AIRPORT OWNED BARRICADES, IT IS THE CONTRACTOR'S RESPONSIBILITY TO PROVIDE THEM. THE CONTRACTOR SHALL PROVIDE ANY ADDITIONAL BARRICADES. AT THE COMPLETION OF THE PROJECT ALL BORROWED BARRICADES SHALL BE RETURNED TO THE OWNER IN THEIR ORIGINAL CONDITION AND ALL CONTRACTOR SUPPLIED BARRICADES SHALL BE REMOVED FROM THE AIRPORT.
7. THE CONTRACTOR SHALL BE RESPONSIBLE FOR SETUP, MAINTENANCE AND OPERATION, INCLUDING REPLACING BATTERIES AND LIGHT BULBS IF NEEDED, REGARDLESS OF WHETHER THE BARRICADE WAS SUPPLIED BY THE OWNER OR CONTRACTOR. ANY OWNER SUPPLIED BARRICADES DAMAGED BY THE CONTRACTOR'S OPERATIONS OR NEGLIGENCE SHALL BE REPLACED BY THE CONTRACTOR AT NO COST TO THE OWNER.

**LOW-PROFILE BARRICADE**  
NOT TO SCALE

**GENERAL PHASING NOTES:**

1. ANY CHANGES TO THE CONSTRUCTION SAFETY AND PHASING PLAN MUST BE SUBMITTED IN WRITING AND APPROVED BY THE ENGINEER, THE OWNER AND THE FEDERAL AVIATION ADMINISTRATION (FAA).
2. THE CONTRACTOR STAGING AREA MUST BE LOCATED OUTSIDE OF THE TAXIWAY OBJECT FREE AREA AND ALL EQUIPMENT MUST BE BELOW THE AIRSPACE PROJECTION SURFACES.
3. SEE SPECIFICATIONS FOR THE CONSTRUCTION SAFETY AND PHASING PLAN (CSPP).
4. 30 CALENDAR DAY PERFORMANCE PERIOD.
5. AIRSIDE ACCESS GATE MUST BE CLOSED AND LOCKED WHEN NOT IN USE.
6. AARF GARAGE DOOR MUST BE CLEAR AT ALL TIMES TO ALLOW FIRE TRUCK EGRESS AND INGRESS DURING EMERGENCIES.

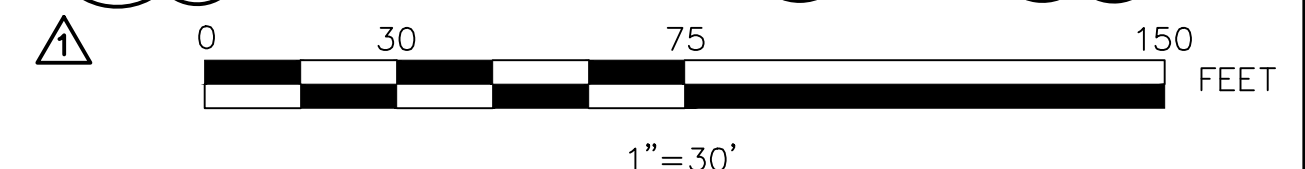

ENGINEER'S SEAL

---

PROJECT DESIGNER  
**HOYLE TANNER**

150 Dow Street  
Manchester, NH 03101-1227  
(603) 669-5555  
www.hoyletanner.com

DESIGNED BY: JAK  
DRAWN BY: JAK  
CHECKED BY: NEG

---

AUGUSTA STATE AIRPORT  
RECONSTRUCT TERMINAL APRON

**CONSTRUCTION SAFETY AND  
PHASING PLAN**

DATE: MARCH 2022  
SCALE: AS SHOWN

REV. NO.	DATE	DESCRIPTION	BY
1	4/12/22	REVISED ACCESS LOC./ARFF NOTE	NEG
2	4/1/2022	BID DOCUMENTS	JAK

PROJ. No.: 302908.01  
AIP: 3-23-0003-XXX-2022

DRAWING NO.  
**G1.4**

SHEET 4 OF 9