



STATE OF MAINE  
DEPARTMENT OF TRANSPORTATION  
16 STATE HOUSE STATION  
AUGUSTA, MAINE 04333-0016

Paul R. LePage  
GOVERNOR

David Bernhardt  
COMMISSIONER

March 15, 2018  
Subject: Large Culvert Replacement  
State WIN: 021770.00  
Location: **China**  
**Amendment No. 1**

Dear Sir/Ms.:

Please make the following changes to the Bid Documents:

In the Plan Set:

**REMOVE** Sheet Number 9 of 10, CROSS SECTIONS, and **REPLACE** with the attached, revised Sheet Number 9 of 10, CROSS SECTIONS

Consider this change and information prior to submitting your bid on **March 21, 2018**.


Sincerely,

A handwritten signature in blue ink that reads "George M. A. Macdougall".

George M. A. Macdougall P.E.  
Contracts & Specifications Engineer



PRINTED ON RECYCLED PAPER

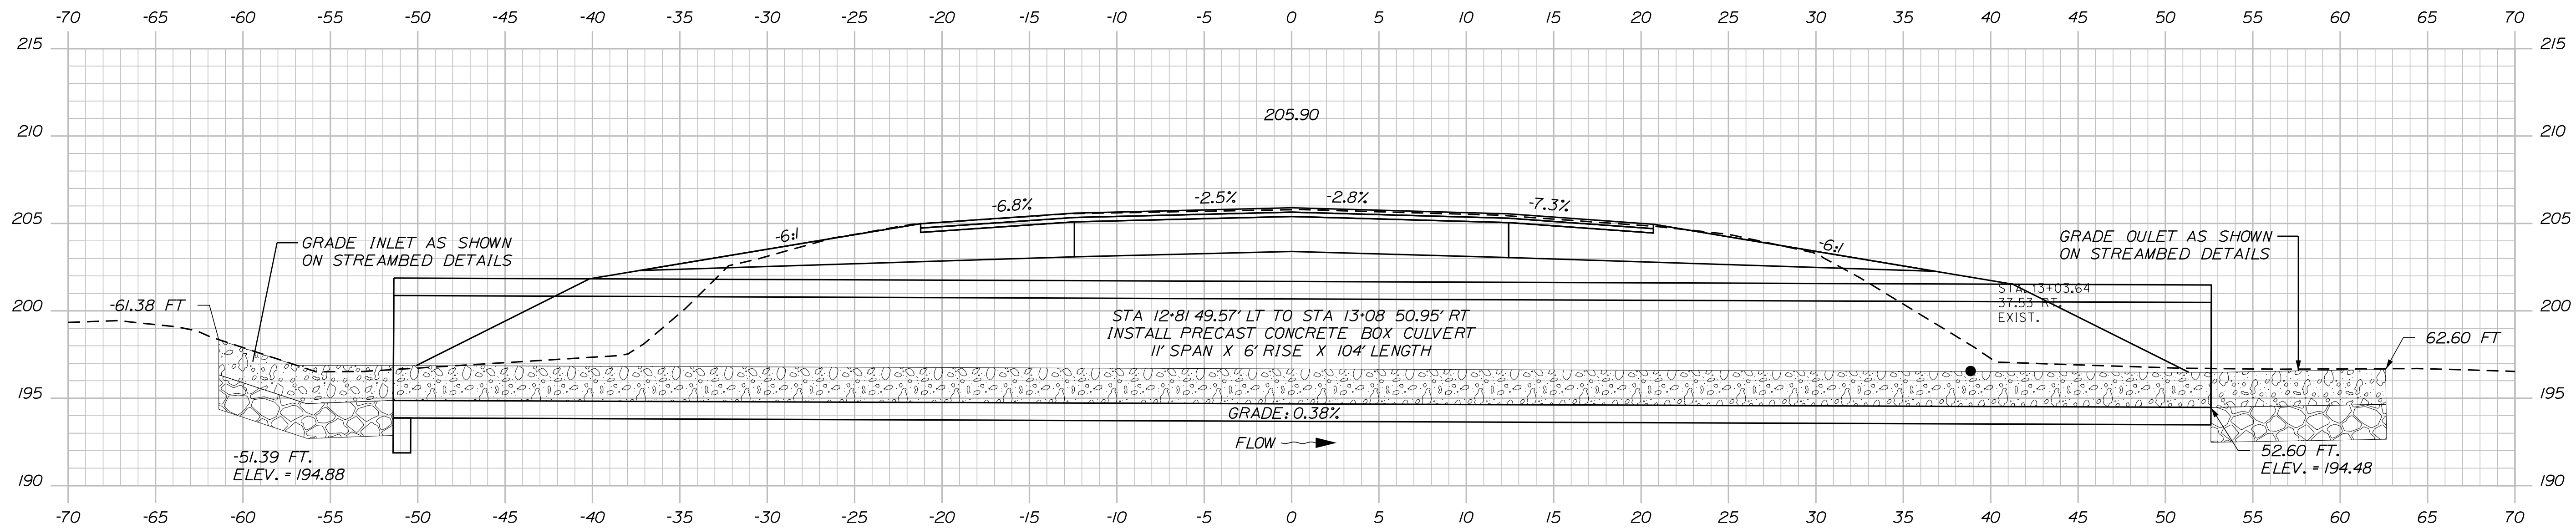

STATE OF MAINE  
DEPARTMENT OF TRANSPORTATION

021770.00

WIN 021770.00 HIGHWAY PLANS

PROJ. MANAGER

CHECKED-REVIEWED

DESIGN-REVIEWED

DESIGN-DETAILED

REVISIONS 1

REVISIONS 2

REVISIONS 3

REVISIONS 4

FIELD CHANGES

DATE

BY

D. COOMBS

N. HARTLEY

C. RUSSELL

T. WHITE

OCT 2017

SIGNATURE

P.E. NUMBER

DATE

CHINA  
ROUTE 3\202  
CROSS SECTIONS

SHEET NUMBER

9

OF 10