# **Mitchell Field Boating Access Improvements**

MaineDOT WIN 23082.00 & 23472.00

Town of Harpswell 263 Mountain Road Harpswell, ME 04079

# Addendum #4

September 4, 2025

This Addendum consists of two (2) pages.

# All Bidders shall acknowledge this Addendum #4 with their proposal submittal.

## A. RESPONSE TO RFI's:

## Question #1

Amendment #3, answer #7 references a detail on Sheet C-01 which does not exist. There is a detail on sheet C-02, but it does not show the HMA. Could you please clarify?

## Answer #1


The paved roadway detail is Detail 1 on Sheet C-04. Answer #7 in Addendum #3 should be corrected to reference Sheet C-04.

#### **Question #2**

Can you please clarify the limits of work for alternates #1 and #2? I cannot find anywhere in the documents where these are designated.

#### Answer #2

Refer to the figure on the following page that clarifies the location of work covered by Bid Alternates 1 and 2. Sheet C-02 which clarifies the location of Alternate Bid #1 and #2. The Alternate Bid Items cover the upper parking area that is along the Mitchell Field access road across from the existing gravel construction access route. All other work is part of the Base Bid items.

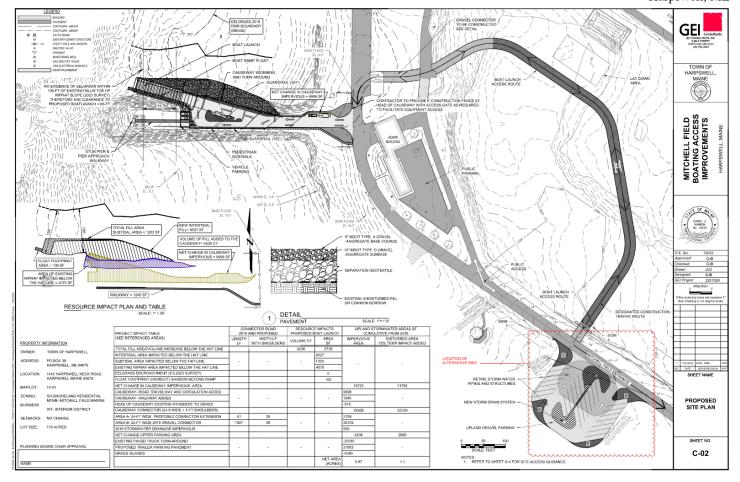

## **Question #3**

Section 02790 of the specification references reflectorized plastic pavement markings as well as paint. Is only paint required?

### Answer #3

Only paint is required. There are no reflectorized plastic pavement markings required for this project.

## **Question #4**

The plans show white directional arrows, are these arrows required to be painted on the pavement?

# Answer #4

The white directional arrows shown on the boat ramp and within the upper parking area are required to be painted on the pavement. Arrows shall be MaineDOT standard straight arrows with a length of 9'-6".

The arrows shown in black along the gravel connector are for reference only. These are not painted. The white arrow shown at the intersection of the road behind the admin building and noted on Sheet C-02 as "Public Access" is also for reference only and is not required to be painted.