



STATE OF MAINE
DEPARTMENT OF TRANSPORTATION
16 STATE HOUSE STATION
AUGUSTA, MAINE 04333-0016

Janet T. Mills
GOVERNOR

Bruce A. Van Note
COMMISSIONER

July 6, 2023
Subject: Robert Garland Wearing Surface
Replacement
State WIN: 023200.00
Location: **Anson**
Amendment No. 1

Dear Sir/Ms.:

Make The following changes to the bid doucmnets

In the Plan Set:

Remove page 3 titled GENERAL PLAN dated 6/22/2023 and **Replace** with the attached GENERAL PLAN dated 7/5/2023

Consider these changes and information prior to submitting your bid on **July 19, 2023**.

Sincerely,

A handwritten signature in blue ink that reads "George Macdougall".


George M. A. Macdougall P.E.
Contracts & Specifications Engineer

Username: David Shaw

Date: 7/5/2023

Division: BRIDGE

Filename: ... \00\BRIDGE\MSTA\003_Plan.dgn

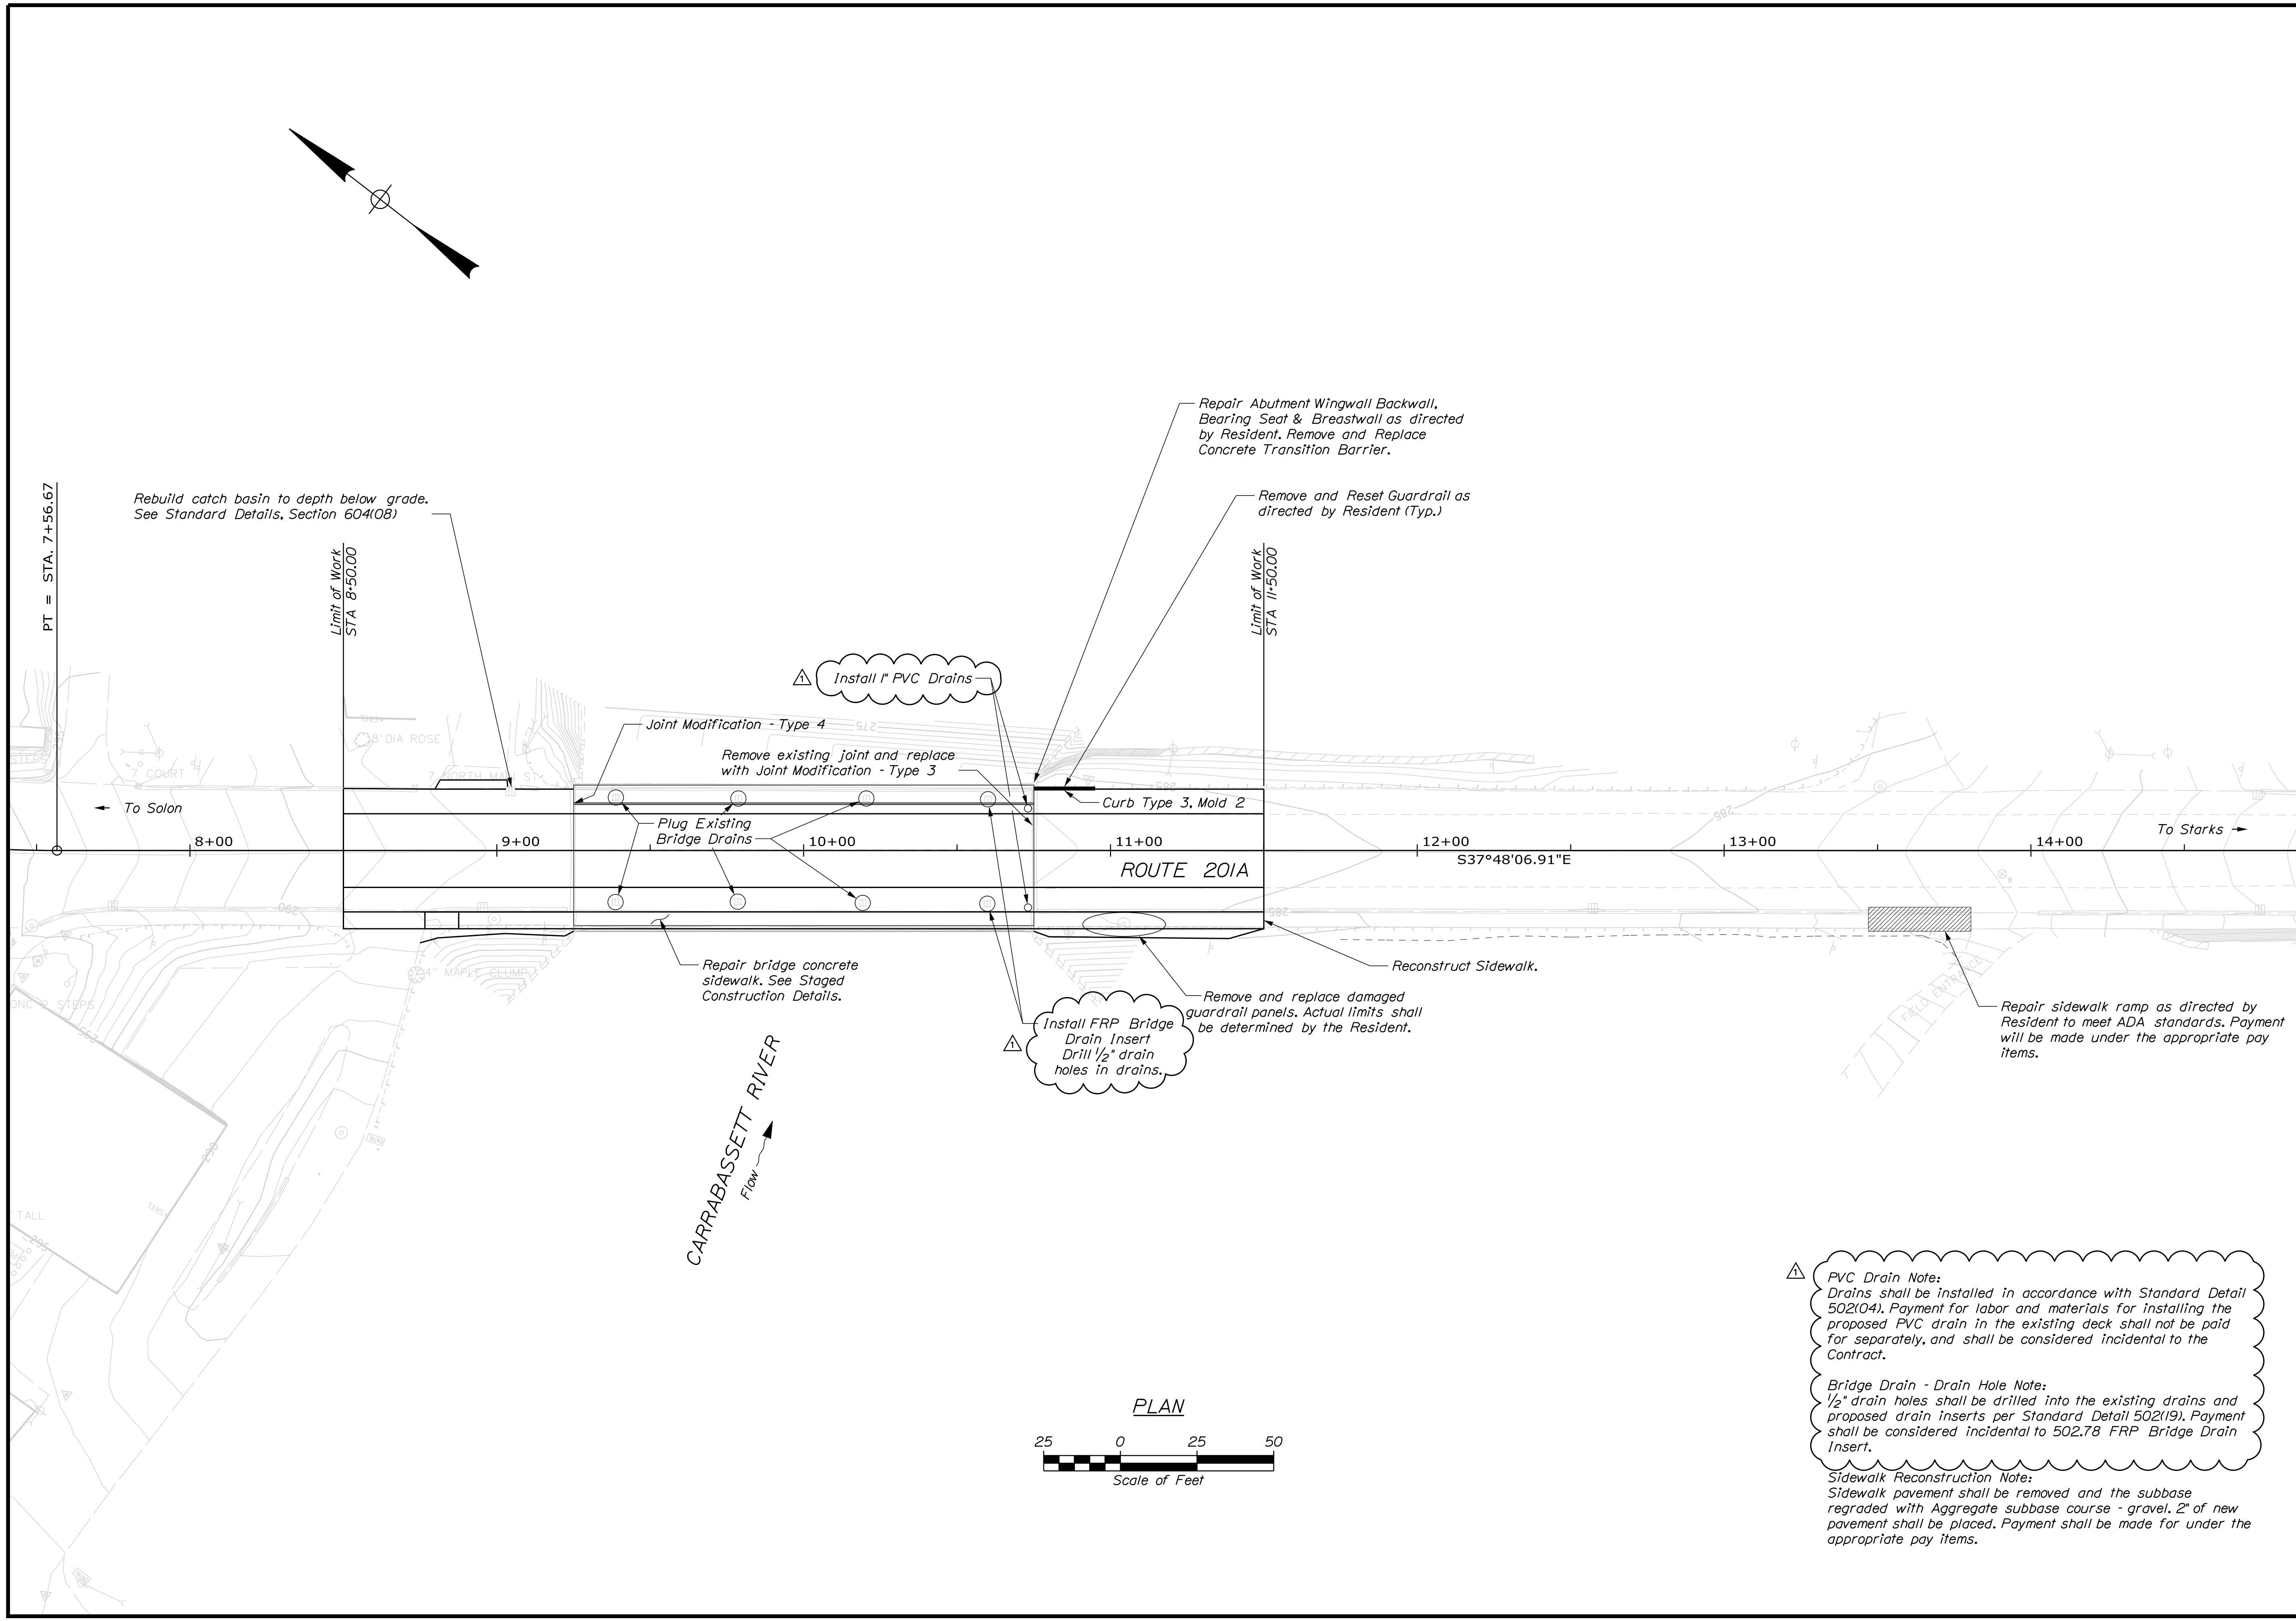

PVC Drain Note:
Drains shall be installed in accordance with Standard Detail 502(04). Payment for labor and materials for installing the proposed PVC drain in the existing deck shall not be paid for separately, and shall be considered incidental to the Contract.

Bridge Drain - Drain Hole Note:
1/2" drain holes shall be drilled into the existing drains and proposed drain inserts per Standard Detail 502(19). Payment shall be considered incidental to 502.78 FRP Bridge Drain Insert.

Sidewalk Reconstruction Note:
Sidewalk pavement shall be removed and the subbase regraded with Aggregate subbase course - gravel. 2" of new pavement shall be placed. Payment shall be made for under the appropriate pay items.

STATE OF MAINE		DEPARTMENT OF TRANSPORTATION		BRIDGE NO. 2615		BRIDGE PLANS	
		23200.00		WIN		23200.00	
ROBERT GARLAND BRIDGE		CARRABASSETT RIVER		SOMERSET COUNTY		ANSON	
PROJ. MANAGER		BY		DATE			
DESIGN DETAILED		J. STETSON		MAY 2023			
CHECKED/REVIEWED		W. CASEY		MAY 2023			
DESIGN DETAILED		T. AGUILAR		JUN 2023		SIGNATURE	
DESIGN DETAILED							
REVISIONS 1		Added notes and 1" drains		JULY 2023		P.E. NUMBER	
REVISIONS 2							
REVISIONS 3							
REVISIONS 4							
FIELD CHANGES						DATE	
SHEET NUMBER		3					
						OF 12	