



STATE OF MAINE
DEPARTMENT OF TRANSPORTATION
16 STATE HOUSE STATION
AUGUSTA, MAINE 04333-0016

Janet T. Mills
GOVERNOR

Bruce A. Van Note
COMMISSIONER

April 13, 2020
Subject: Pavement Milling, HMA Overlay
With Drainage & Safety Improvements
State WIN: 023789.00
Location: **Wayne**
Amendment No. 2

Dear Sir/Ms.:

Please make the following changes to the Bid Documents:

In the Bid Book:

REMOVE page 41, SHEET NUMBER 6 OF 6, TYPICAL SECTIONS, 1 page, and **REPLACE** with the attached, SHEET NUMBER 6A OF 6, TYPICAL SECTIONS.

The following question has been received:

Question: Detail for sidewalk with concrete slipform curb shows the addition of ASCG, could the add an item for this work? If not could the department provide an average depth to be anticipated for in building these sections?

Response: ASCG item will not be added to the bid items. Please see Item 608.45 Construct Sidewalk basis of payment that states: "For construct sidewalk, payment will be for excavation, new aggregate and necessary incidentals to bring the grade to pre-pave grade." The new concrete slipform curb will be placed on milled pavement. Existing pavement below proposed sidewalk will be removed and ASCG will be placed as shown on the revised typical detail. The assumed pavement thickness to be removed under the proposed sidewalk is 6 inches and the average depth of gravel required below the 2" Hot Mix Asphalt is 6 inches. This is consistent with General Note number twelve which states: "All paved walks shall be constructed with 12 inches of aggregate subbase course gravel and 2 inches of hot mix asphalt unless otherwise noted in the Plans or directed by the Resident." Also, see the attached, revised SHEET NUMBER 6A OF 6, TYPICAL SECTIONS.


Consider these changes and information prior to submitting your bid on **April 15, 2020**.

Sincerely,

A handwritten signature in black ink, reading "George M. A. Macdougall". The signature is written in a cursive style with a large initial "G" and "M".

George M. A. Macdougall P.E.
Contracts & Specifications Engineer

SIDEWALK WITH CONCRETE
SLIPFORM CURB

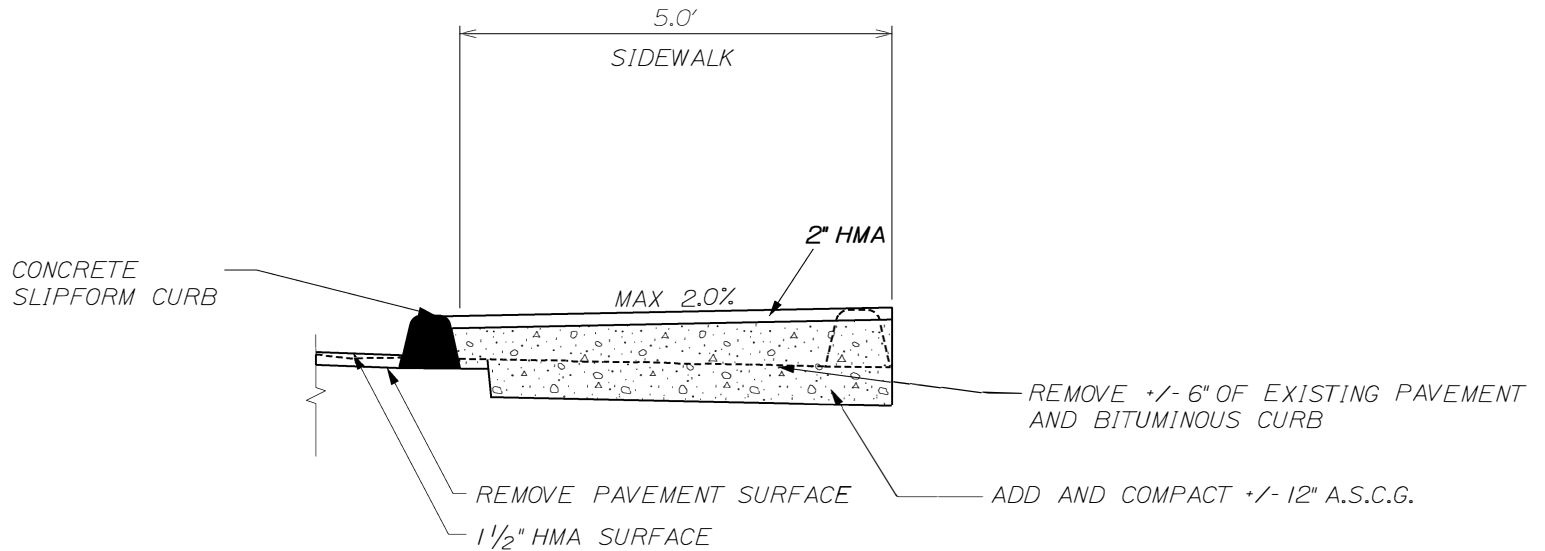

STATION

11+95 - 13+60 LT
13+90 - 14+35 LT
19+75 - 19+97 RT

NOT TO SCALE

WAYNE ROUTE 133	WIN 23789.00	STATE OF MAINE DEPARTMENT OF TRANSPORTATION	SHEET NUMBER
TYPICAL SECTIONS		2378900	HIGHWAY PLANS