



STATE OF MAINE  
DEPARTMENT OF TRANSPORTATION  
16 STATE HOUSE STATION  
AUGUSTA, MAINE 04333-0016

Janet T. Mills  
GOVERNOR

Bruce A. Van Note  
COMMISSIONER

June 23, 2022  
Subject: Pavement Milling, HMA Overlay  
& Ultra-Thin Bonded Wearing Course with  
Safety Improvements  
State WIN: 024171.00  
Location: **Hampden & Hermon**  
**Amendment No. 1**

Dear Sir/Ms.:

Please make the following changes to the Bid Documents:

In the Bid Book:

**REMOVE** page 37, TYPICAL SECTIONS, SHEET NUMBER 3 OF 4, and **REPLACE** with the attached, revised TYPICAL SECTIONS, SHEET NUMBER 3 OF 4.

The following questions have been received:

**Question:** Will Item 403.2081 HMA 12.5mm Polymer Modified HMA be used for the Ramp and Visitor Center only? The quantity does not appear to correspond to its indicated use.

**Response:** The Department has verified that the estimated quantities for the Items in question are accurate. Please review the Typical Sections and Construction notes for more details.

**Question:** The quantity for Item 409.15 Bituminous Tack coat appears to be high based on using it under the shim on the mainline travel way and on 12.5mm on the ramps.

**Response:** The Department has verified that the estimated quantities for the Items in question are accurate. Please review the Typical Sections and Construction notes for more details.


Consider these changes and information prior to submitting your bid on **June 29, 2022**.

Sincerely,

*Kevin Hanlon* for

George M. A. Macdougall P.E.  
Contracts & Specifications Engineer

$\frac{3}{4}$ " MILL & FILL  
 25.0' +/- WIDTH  
 MAINLINE ONLY  
 BRIDGE DECKS

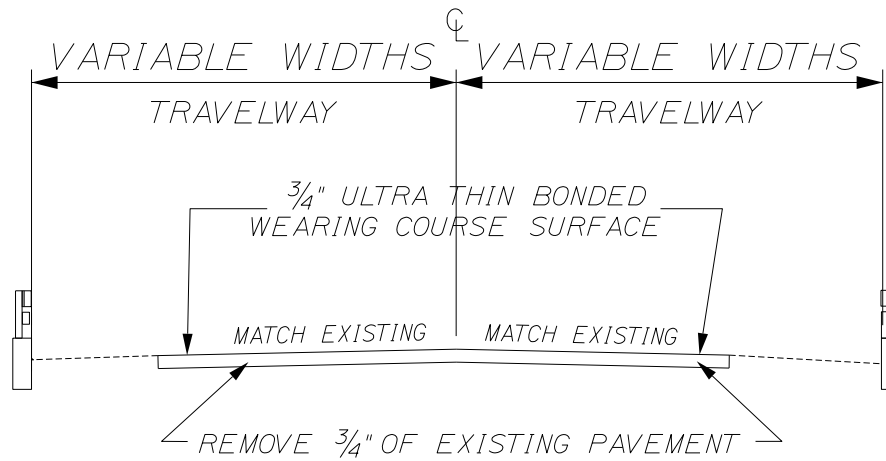

NOT TO SCALE

HAMPDEN-HERMON  
 INTERSTATE 95 NORTHBOUND/SOUTHBOUND  
 TYPICAL SECTIONS

**REVISED 06/09/2022**  
**WIN 24171.00**

STATE OF MAINE  
 DEPARTMENT OF TRANSPORTATION  
**2417100** HIGHWAY PLANS

SHEET NUMBER  
 3 OF 4