



STATE OF MAINE
DEPARTMENT OF TRANSPORTATION
16 STATE HOUSE STATION
AUGUSTA, MAINE 04333-0016

Janet T. Mills
GOVERNOR

Bruce A. Van Note
COMMISSIONER

September 27, 2023
Subject: Crooked River Bridge Deck
Replacement
State WIN: 026122.00
Location: **Albany**
Amendment No. 2

Dear Sir/Ms.:

In reference from amendment #1 find the missing attachments included in this amendment

Consider these changes and information prior to submitting your bid on **October 4, 2023**.

Sincerely

A handwritten signature in blue ink that reads 'George Macdougall'.

George M. A. Macdougall P.E.
Contracts & Specifications Engineer

Maine Department of Transportation

Proposal Schedule of Items

Proposal ID: 026122.00

Project(s): 026122.00

SECTION: 1 INITIAL GROUP

Alt Set ID: Alt Mbr ID:

Contractor: _____

Proposal Line Number	Item ID Description	Approximate Quantity and Units	Unit Price		Bid Amount	
			Dollars	Cents	Dollars	Cents
0010	202.10 REMOVING EXISTING SUPERSTRUCTURE (PROPERTY OF CONTRACTOR)	LUMP SUM				
0020	202.202 REMOVING PAVEMENT SURFACE	570.000 SY				
0030	202.31 PROFILE MILLING CONCRETE WEARING SURFACE	150.000 SY				
0040	203.20 COMMON EXCAVATION	25.000 CY				
0050	304.10 AGGREGATE SUBBASE COURSE - GRAVEL	20.000 CY				
0060	403.208 HOT MIX ASPHALT 12.5 MM HMA SURFACE	50.000 T				
0070	403.213 HOT MIX ASPHALT 12.5 MM BASE	80.000 T				
0080	409.15 BITUMINOUS TACK COAT - APPLIED	50.000 G				
0090	424.304 HIGH MOLECULAR WEIGHT METHACRYLATE CRACK SEALER	15.000 G				
0100	502.26 STRUCTURAL CONCRETE ROADWAY AND SIDEWALK SLABS ON STEEL BRIDGES	LUMP SUM				
0110	502.49 STRUCTURAL CONCRETE CURBS AND SIDEWALKS	LUMP SUM				

Maine Department of Transportation

Proposal Schedule of Items

Proposal ID: 026122.00

Project(s): 026122.00

SECTION: 1 INITIAL GROUP

Alt Set ID: Alt Mbr ID:

Contractor: _____

Proposal Line Number	Item ID Description	Approximate Quantity and Units	Unit Price		Bid Amount	
			Dollars	Cents	Dollars	Cents
0130	503.12 REINFORCING STEEL, FABRICATED AND DELIVERED	13,300.000 LB	_____	 _____	_____	 _____
0140	503.13 REINFORCING STEEL, PLACING	13,300.000 LB	_____	 _____	_____	 _____
0150	503.17 MECHANICAL WELDED SPLICE	183.000 EA	_____	 _____	_____	 _____
0160	505.08 SHEAR CONNECTORS	LUMP SUM		 LUMP SUM	_____	 _____
0170	507.0821 STEEL BRIDGE RAILING, 3 BAR	LUMP SUM		 LUMP SUM	_____	 _____
0180	507.0822 STEEL APPROACH RAILING, 3-BAR	4.000 EA	_____	 _____	_____	 _____
0190	515.21 PROTECTIVE COATING FOR CONCRETE SURFACES	LUMP SUM		 LUMP SUM	_____	 _____
0200	526.301 PORTABLE CONCRETE BARRIER TYPE I	LUMP SUM		 LUMP SUM	_____	 _____
0210	526.304 PORTABLE CONCRETE BARRIER, ANCHORED TYPE 1	LUMP SUM		 LUMP SUM	_____	 _____
0220	527.34 WORK ZONE CRASH CUSHIONS	2.000 UN	_____	 _____	_____	 _____
0230	606.1301 31" W-BM GR, MID-WAY SPLICE-SGL FACED	275.000 LF	_____	 _____	_____	 _____
0240	606.1303 31" W-BM GR, MID-WAY SPLICE-15' RAD AND LESS	50.000 LF	_____	 _____	_____	 _____

Maine Department of Transportation

Proposal Schedule of Items

Proposal ID: 026122.00

Project(s): 026122.00

SECTION: 1 INITIAL GROUP

Alt Set ID: Alt Mbr ID:

Contractor: _____

Proposal Line Number	Item ID Description	Approximate Quantity and Units	Unit Price		Bid Amount	
			Dollars	Cents	Dollars	Cents
0250	606.1305 31" W-BM GR, MID-WAY SPLICE FLARED TERMINAL	2.000 EA	_____	 _____	_____	 _____
0260	606.1721 BRIDGE TRANSITION - TYPE 1	4.000 EA	_____	 _____	_____	 _____
0270	606.265 TERMINAL END - SINGLE RAIL - GALVANIZED STEEL	2.000 EA	_____	 _____	_____	 _____
0280	606.353 REFLECTORIZED FLEXIBLE GUARDRAIL MARKER	8.000 EA	_____	 _____	_____	 _____
0290	613.319 EROSION CONTROL BLANKET	70.000 SY	_____	 _____	_____	 _____
0300	615.07 LOAM	2.000 CY	_____	 _____	_____	 _____
0310	618.14 SEEDING METHOD NUMBER 2	1.000 UN	_____	 _____	_____	 _____
0320	619.12 MULCH	1.000 UN	_____	 _____	_____	 _____
0330	619.14 EROSION CONTROL MIX	3.000 CY	_____	 _____	_____	 _____
0340	627.733 4" WHITE OR YELLOW PAINTED PAVEMENT MARKING LINE	600.000 LF	_____	 _____	_____	 _____
0350	627.77 REMOVING PAVEMENT MARKINGS	350.000 SF	_____	 _____	_____	 _____
0360	627.78 TEMPORARY 4 INCH PAINTED PAVEMENT MARKING LINE, WHITE OR YELLOW	1,040.000 LF	_____	 _____	_____	 _____

Maine Department of Transportation

Proposal Schedule of Items

Proposal ID: 026122.00

Project(s): 026122.00

SECTION: 1 INITIAL GROUP

Alt Set ID: Alt Mbr ID:

Contractor: _____

Proposal Line Number	Item ID Description	Approximate Quantity and Units	Unit Price		Bid Amount	
			Dollars	Cents	Dollars	Cents
0370	629.05 HAND LABOR, STRAIGHT TIME	40.000 HR	_____	 _____	_____	 _____
0380	631.122 MINI ALL-PURPOSE EXCAVATOR (INCLUDING OPERATOR)	20.000 HR	_____	 _____	_____	 _____
0390	631.133 SKID STEER (INCLUDING OPERATOR)	20.000 HR	_____	 _____	_____	 _____
0400	631.172 TRUCK - LARGE (INCLUDING OPERATOR)	20.000 HR	_____	 _____	_____	 _____
0410	639.19 FIELD OFFICE TYPE B	1.000 EA	_____	 _____	_____	 _____
0420	643.72 TEMPORARY TRAFFIC SIGNAL	LUMP SUM		 LUMP SUM	_____	 _____
0430	652.31 TYPE I BARRICADE	10.000 EA	_____	 _____	_____	 _____
0440	652.33 DRUM	20.000 EA	_____	 _____	_____	 _____
0450	652.34 CONE	50.000 EA	_____	 _____	_____	 _____
0460	652.35 CONSTRUCTION SIGNS	300.000 SF	_____	 _____	_____	 _____
0470	652.361 MAINTENANCE OF TRAFFIC CONTROL DEVICES	LUMP SUM		 LUMP SUM	_____	 _____
0480	652.38 FLAGGER	240.000 HR	_____	 _____	_____	 _____

9/26/2023

Maine Department of Transportation

Proposal Schedule of Items

Page 5 of 5

Proposal ID: 026122.00


Project(s): 026122.00

SECTION: 1 INITIAL GROUP


Alt Set ID: Alt Mbr ID:

Contractor: _____


Proposal Line Number	Item ID Description	Approximate Quantity and Units	Unit Price		Bid Amount	
			Dollars	Cents	Dollars	Cents
0490	656.75 TEMPORARY SOIL EROSION AND WATER POLLUTION CONTROL	LUMP SUM	LUMP	SUM	_____	_____
0500	659.10 MOBILIZATION	LUMP SUM	LUMP	SUM	_____	_____
Section: 1			Total:		_____	_____
			Total Bid:		_____	_____

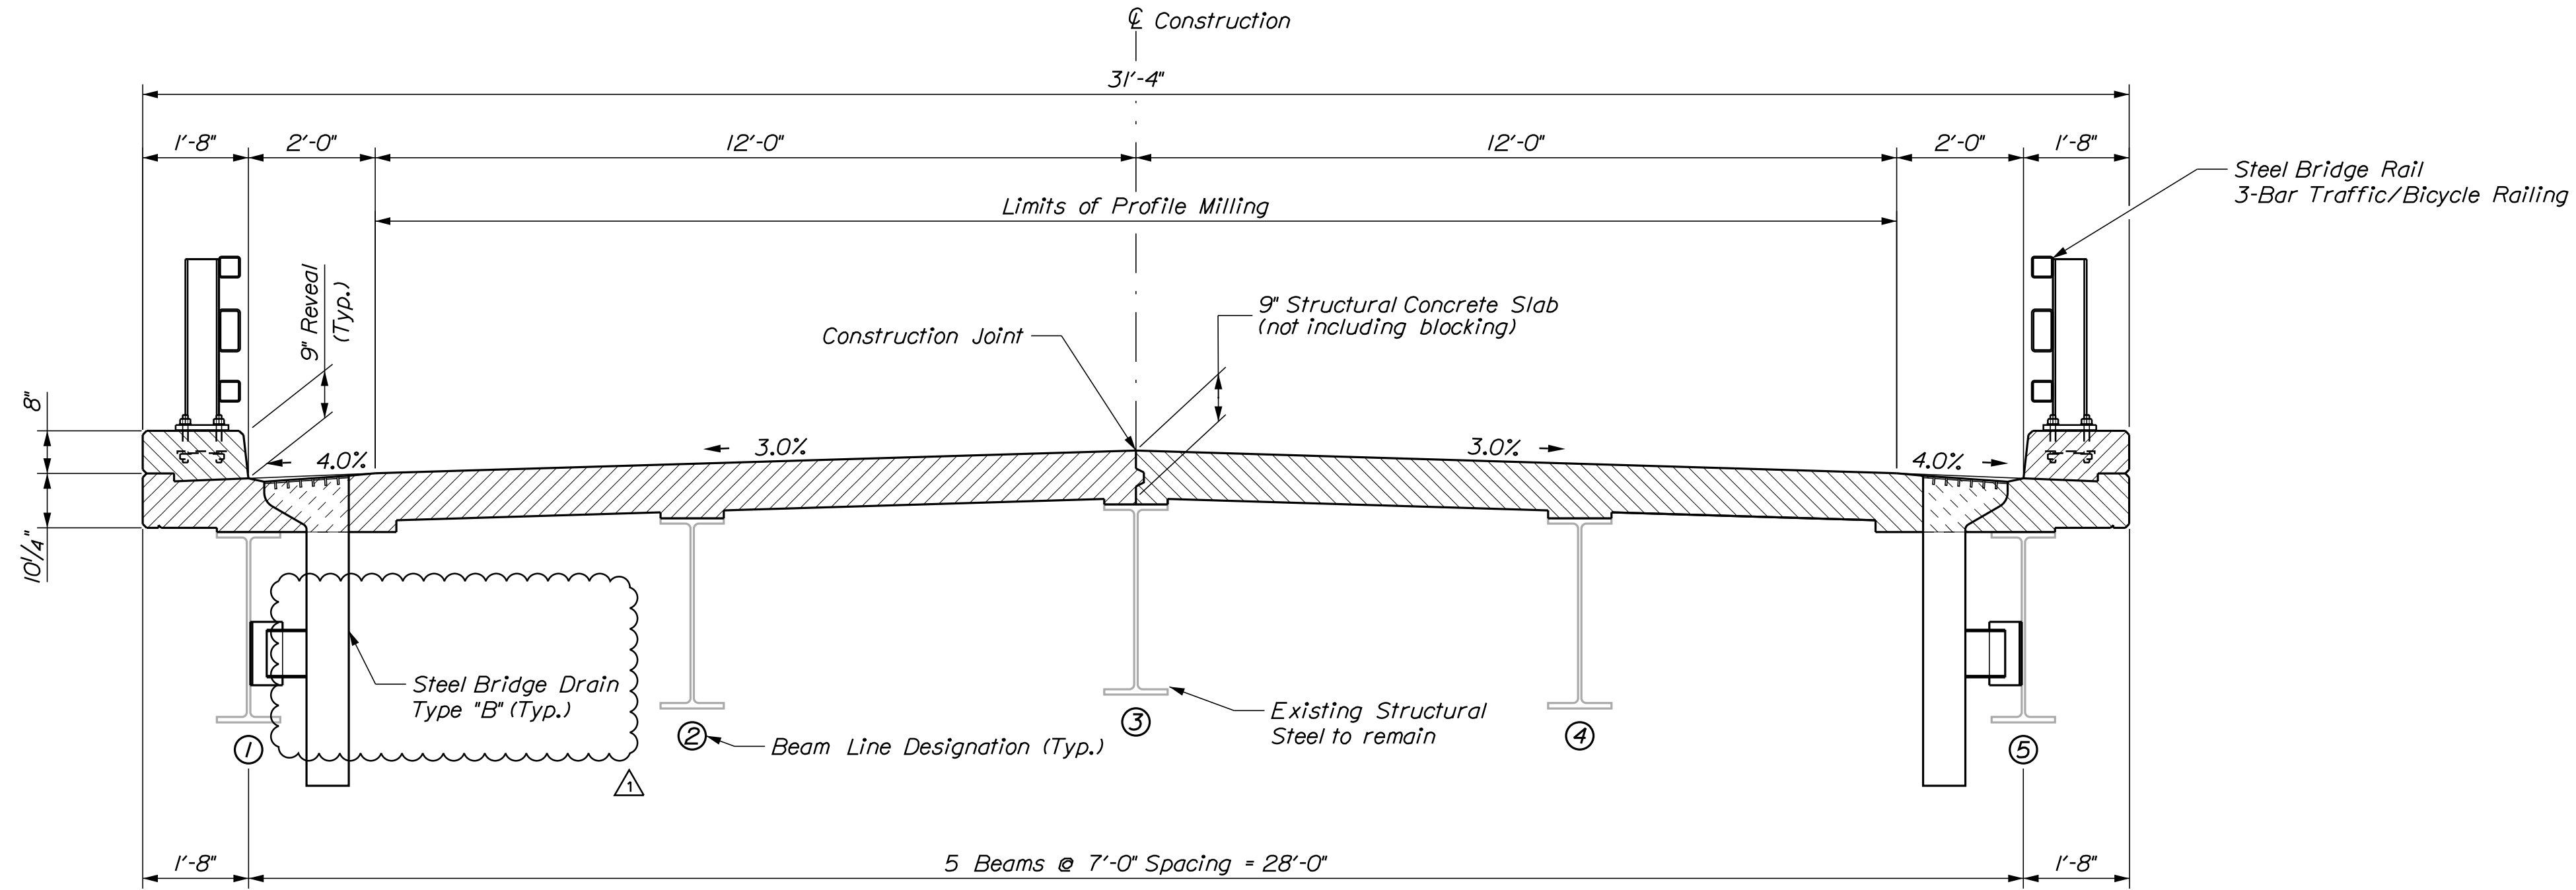

PROPOSED BRIDGE SECTION
Final deck section after profile milling
Flow →

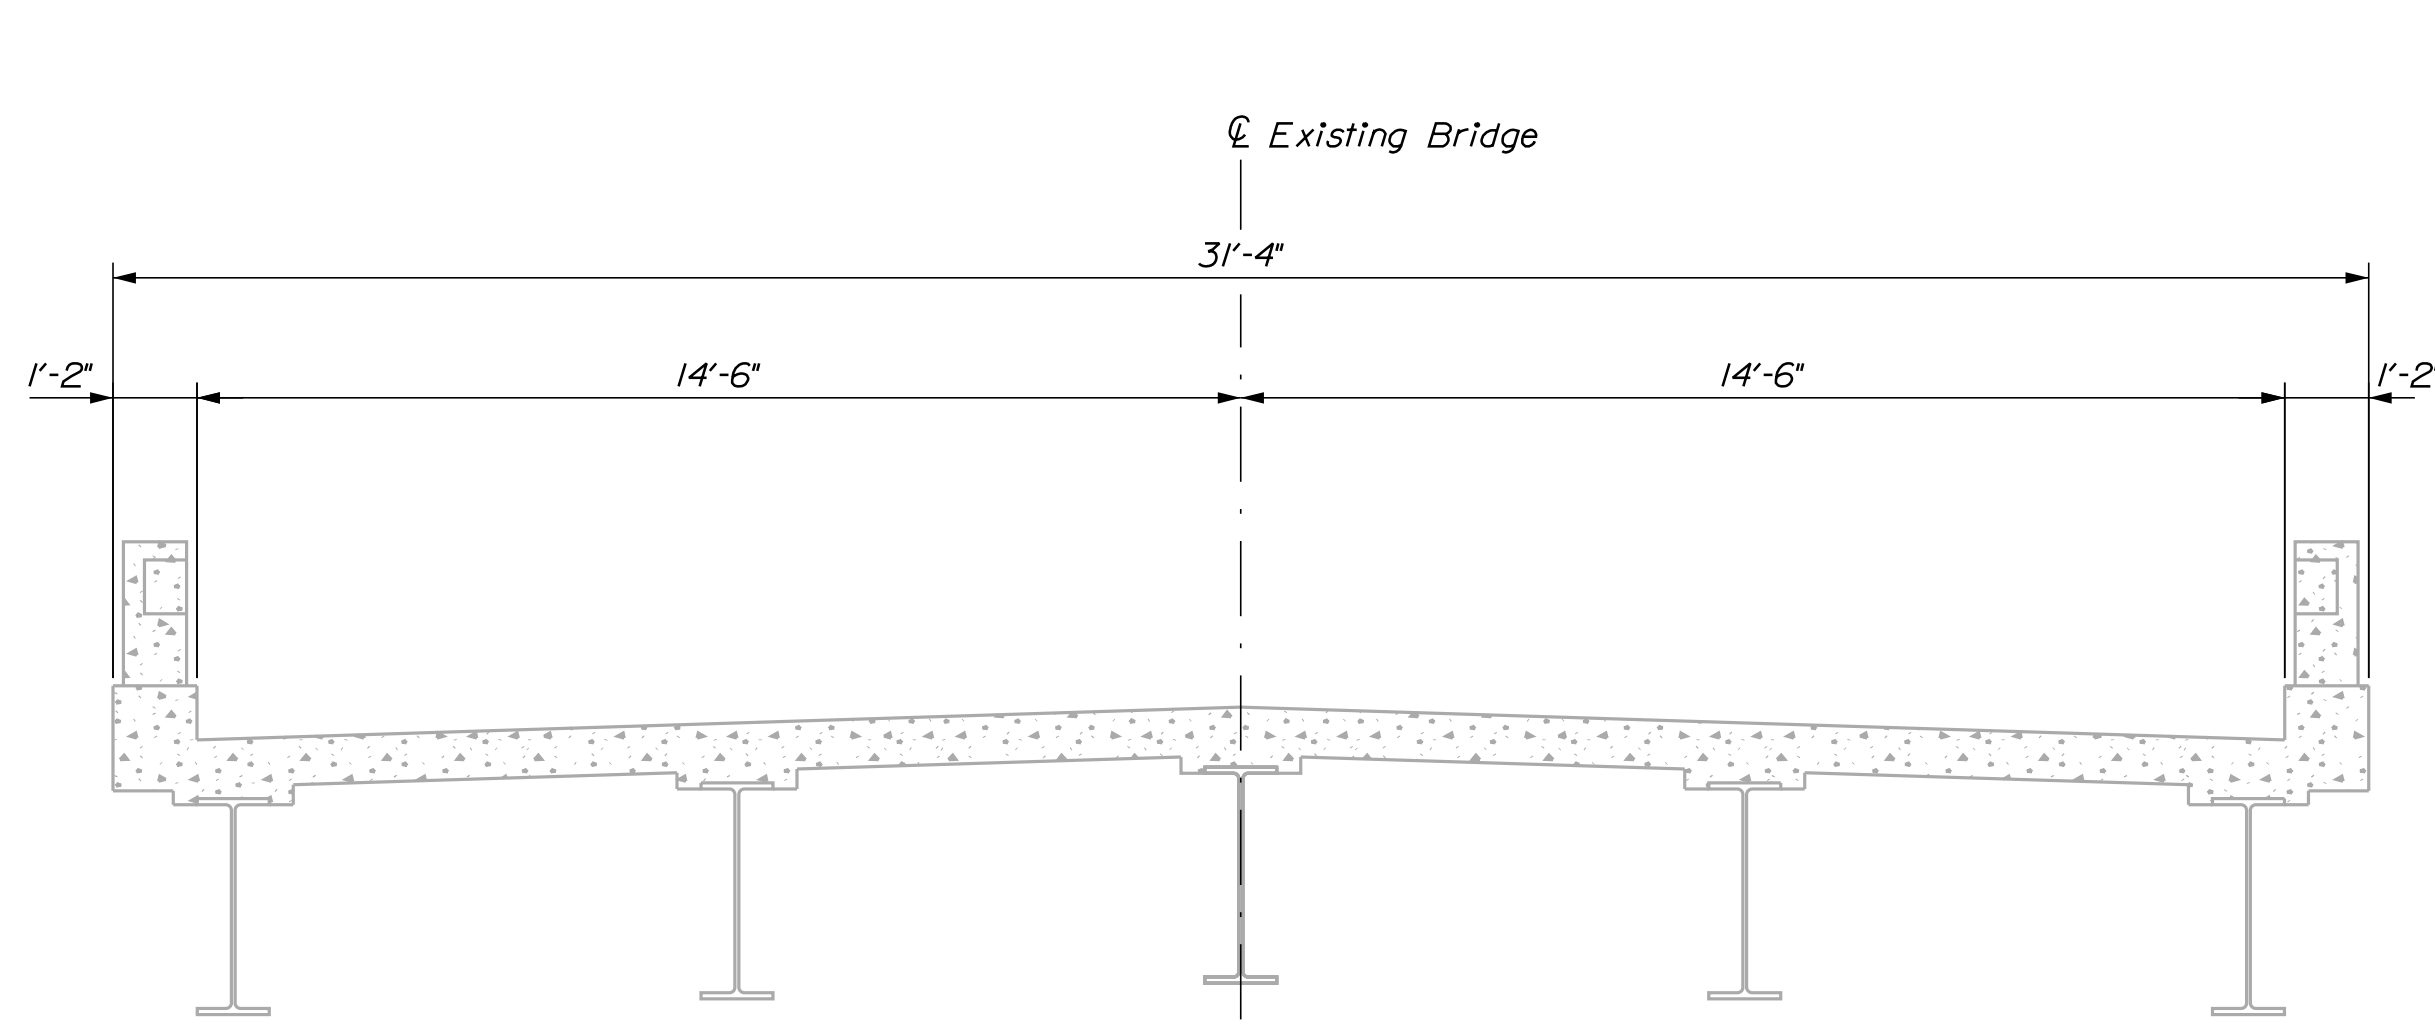

EXISTING BRIDGE SECTION
Flow →
See existing bridge plans for more information

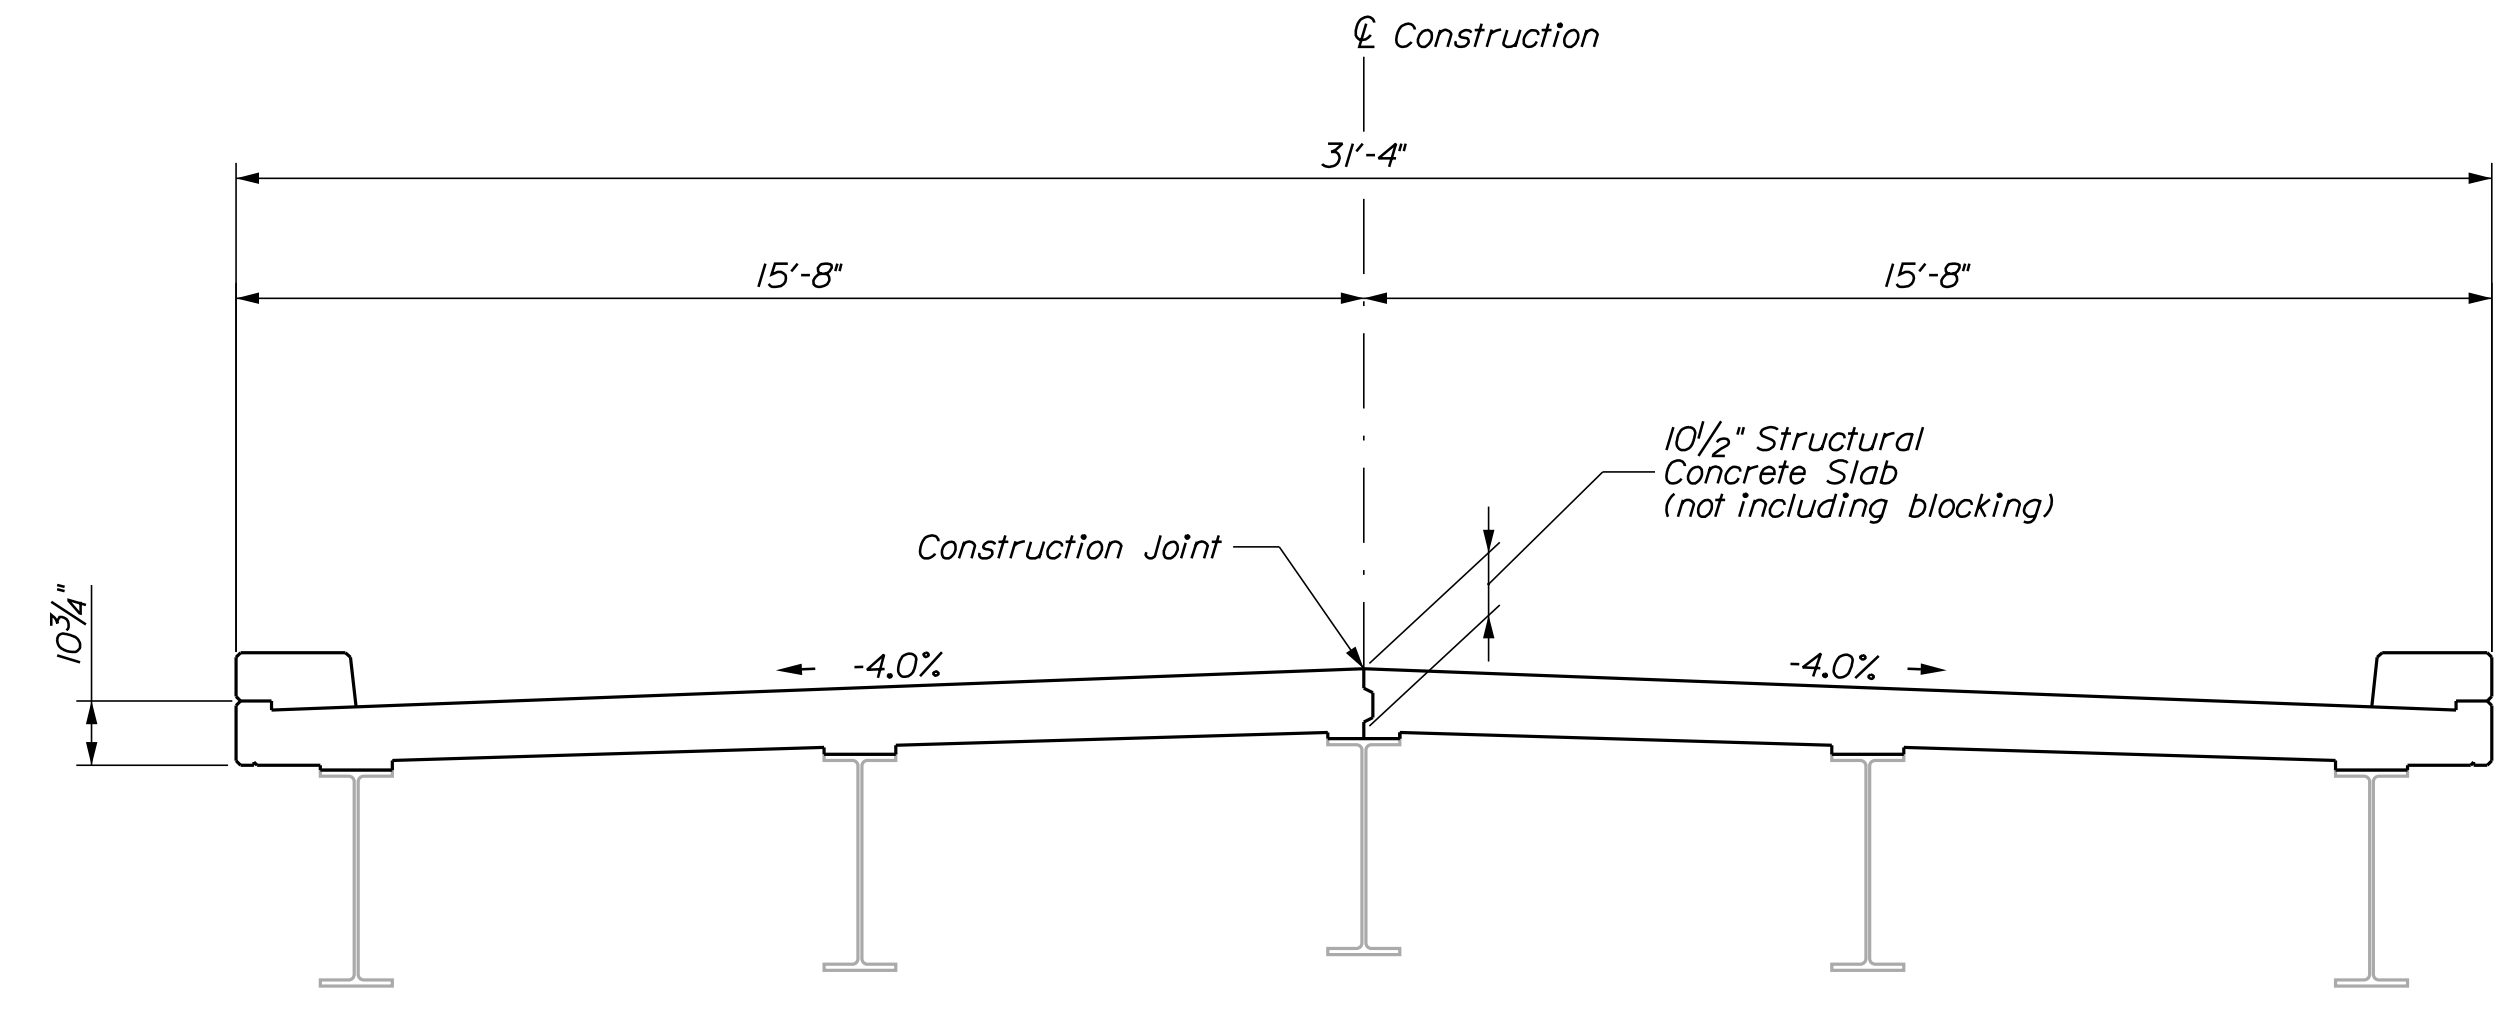

DECK PLACEMENT BRIDGE SECTION
PRIOR TO PROFILE MILLING
Bridge Rail not shown for clarity
Flow →

DESIGN	DATE	SIGNATURE
BY	DATE	P.E. NUMBER
DATE	DATE	DATE

PROJ. MANAGER	B. NICHOLS
DESIGN-DETAILED	RN
CHECKED-REVIEWED	EB
DESIGN-DETAILED	MP
REVISIONS 1	Δ STEEL BRIDGE DRAWS 9/26/23
REVISIONS 2	
REVISIONS 3	
REVISIONS 4	
FIELD CHANGES	