



STATE OF MAINE
DEPARTMENT OF TRANSPORTATION
16 STATE HOUSE STATION
AUGUSTA, MAINE 04333-0016

Janet T. Mills
GOVERNOR

Dale F. Doughty
COMMISSIONER

March 3, 2026
Subject: Sabattus River Bridge
replacement
WIN: 026184.00
Location: **Sabattus**
Amendment No. 4

Dear Sir/Ms.:

In the Contract Plans:

REMOVE sheet 28 titled PRECAST NEXT BEAM REINFORCING dated January 22, 2026 and **REPLACE** with the attached sheet 28 titled PRECAST NEXT BEAM REINFORCING dated March 3, 2026.

The following questions have been received:

Question: Sheet 28 does not provide the length and width for the #4 "C" Bar. Could you please confirm the required length and width?


Response: Please see the aforementioned changes to the Contract Plans.

Consider these changes and information prior to submitting your bid on **March 11, 2026**.


Sincerely,

A handwritten signature in blue ink that reads "George Macdougall".


George M. A. Macdougall P.E.
Contracts & Specifications Engineer

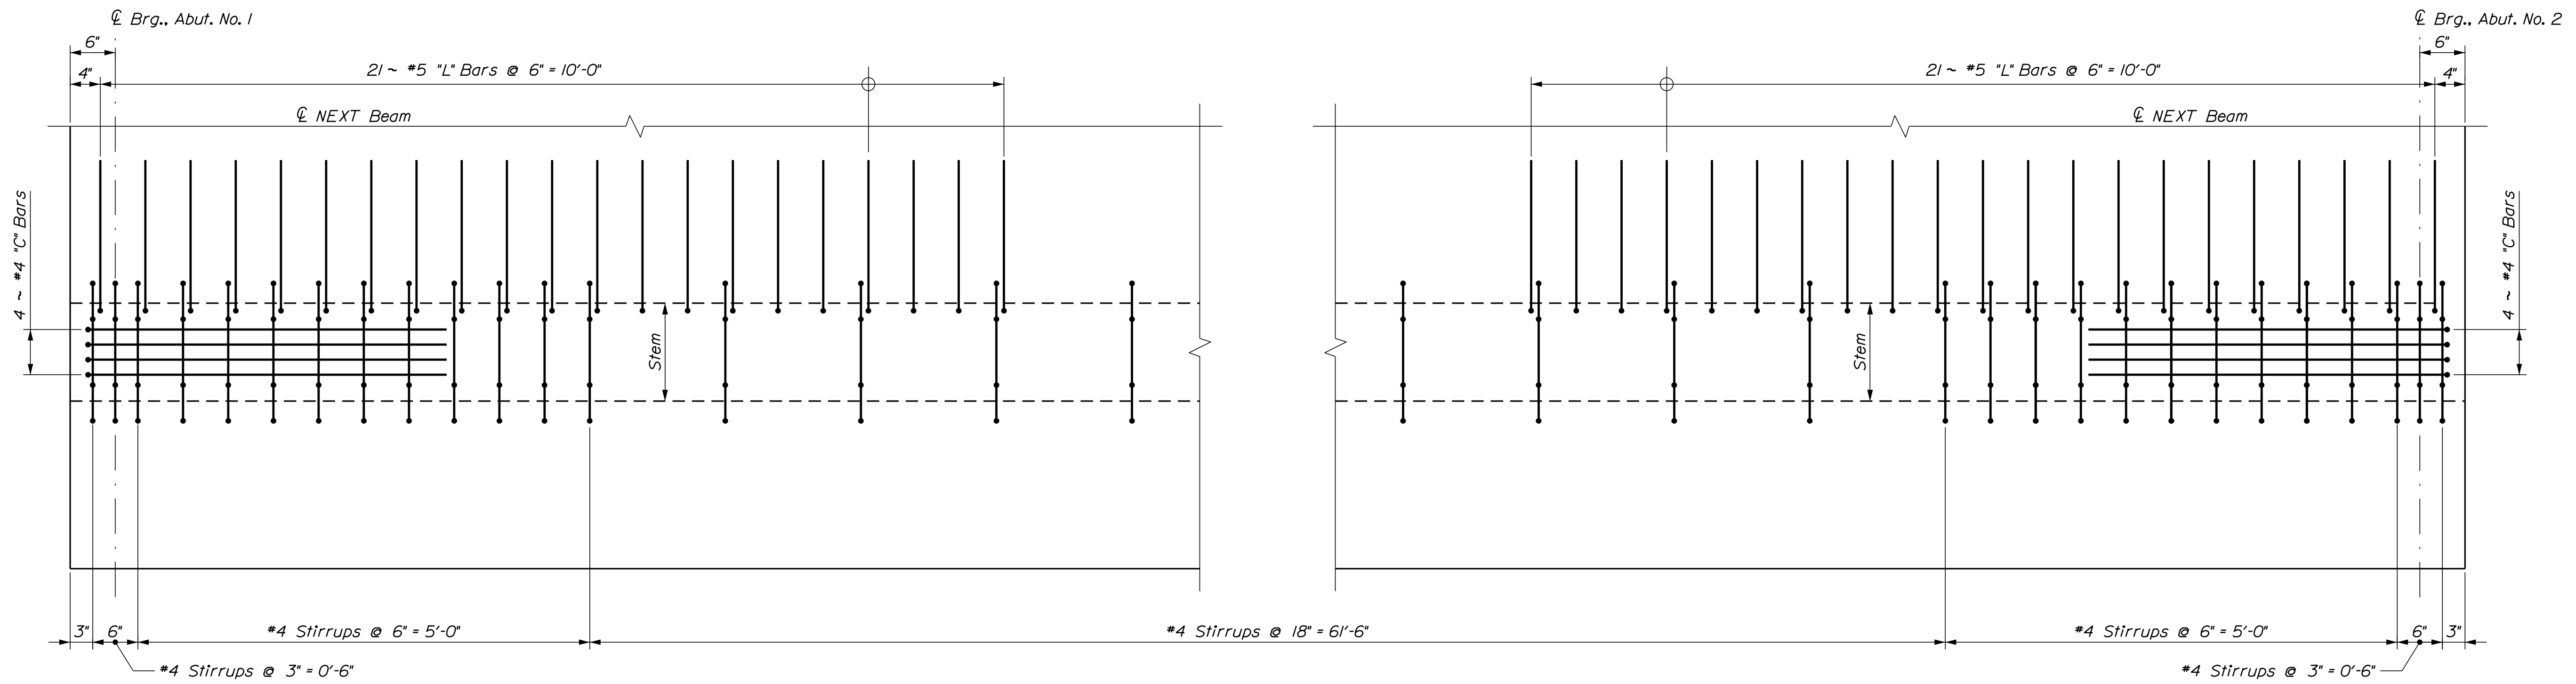

PARTIAL TOP FLANGE REINFORCING PLAN
Welded Wire Fabric & Prestressing Strands Not Shown

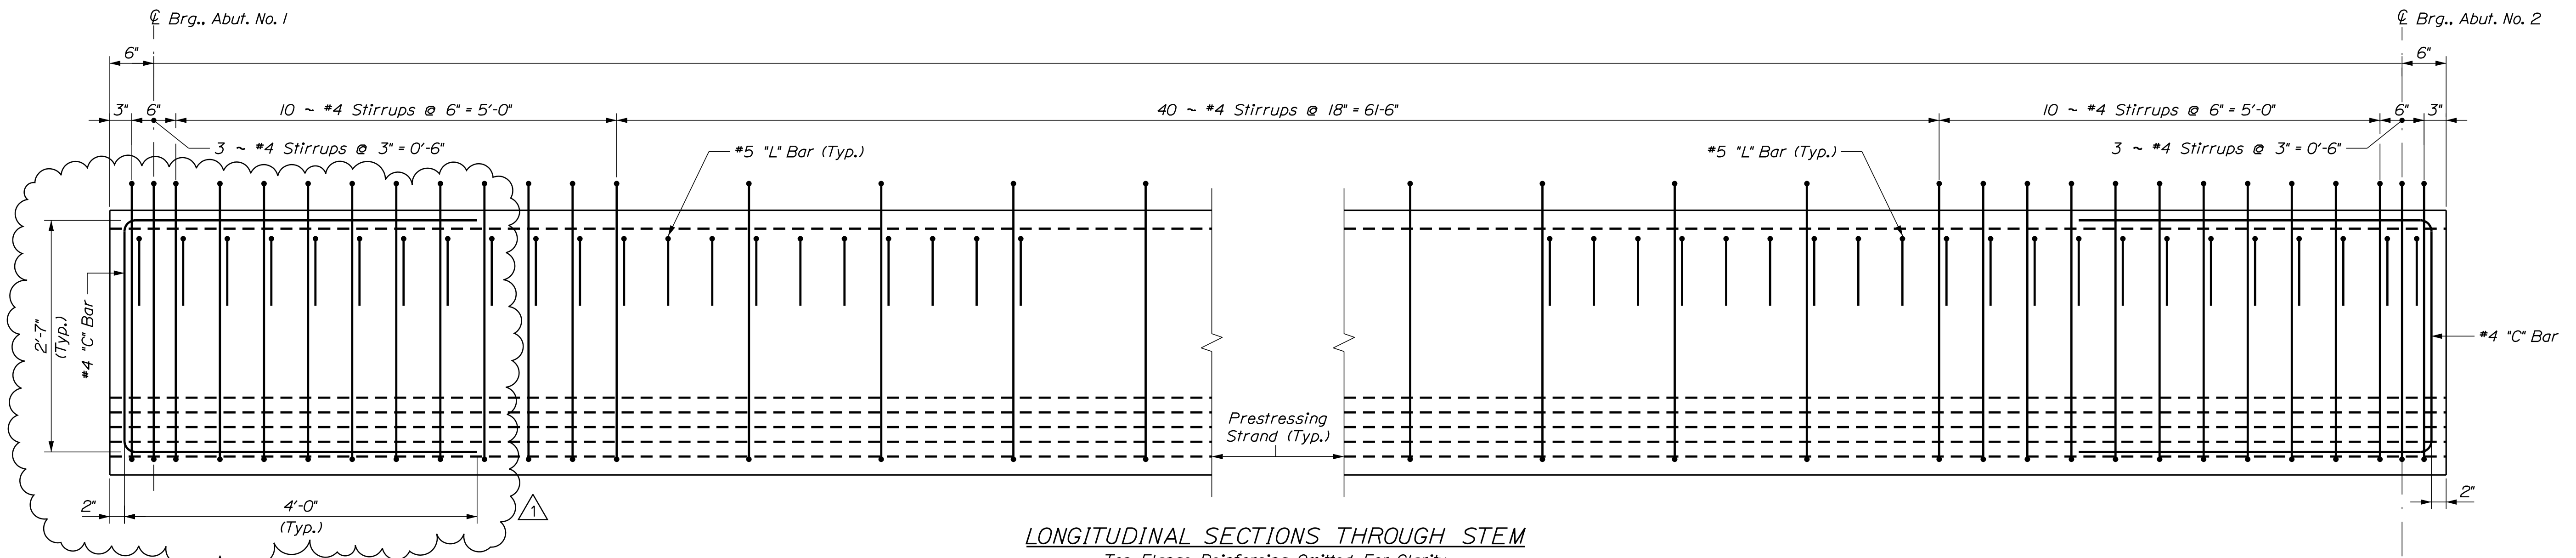


LONGITUDINAL SECTIONS THROUGH STEM
Top Flange Reinforcing Omitted For Clarity

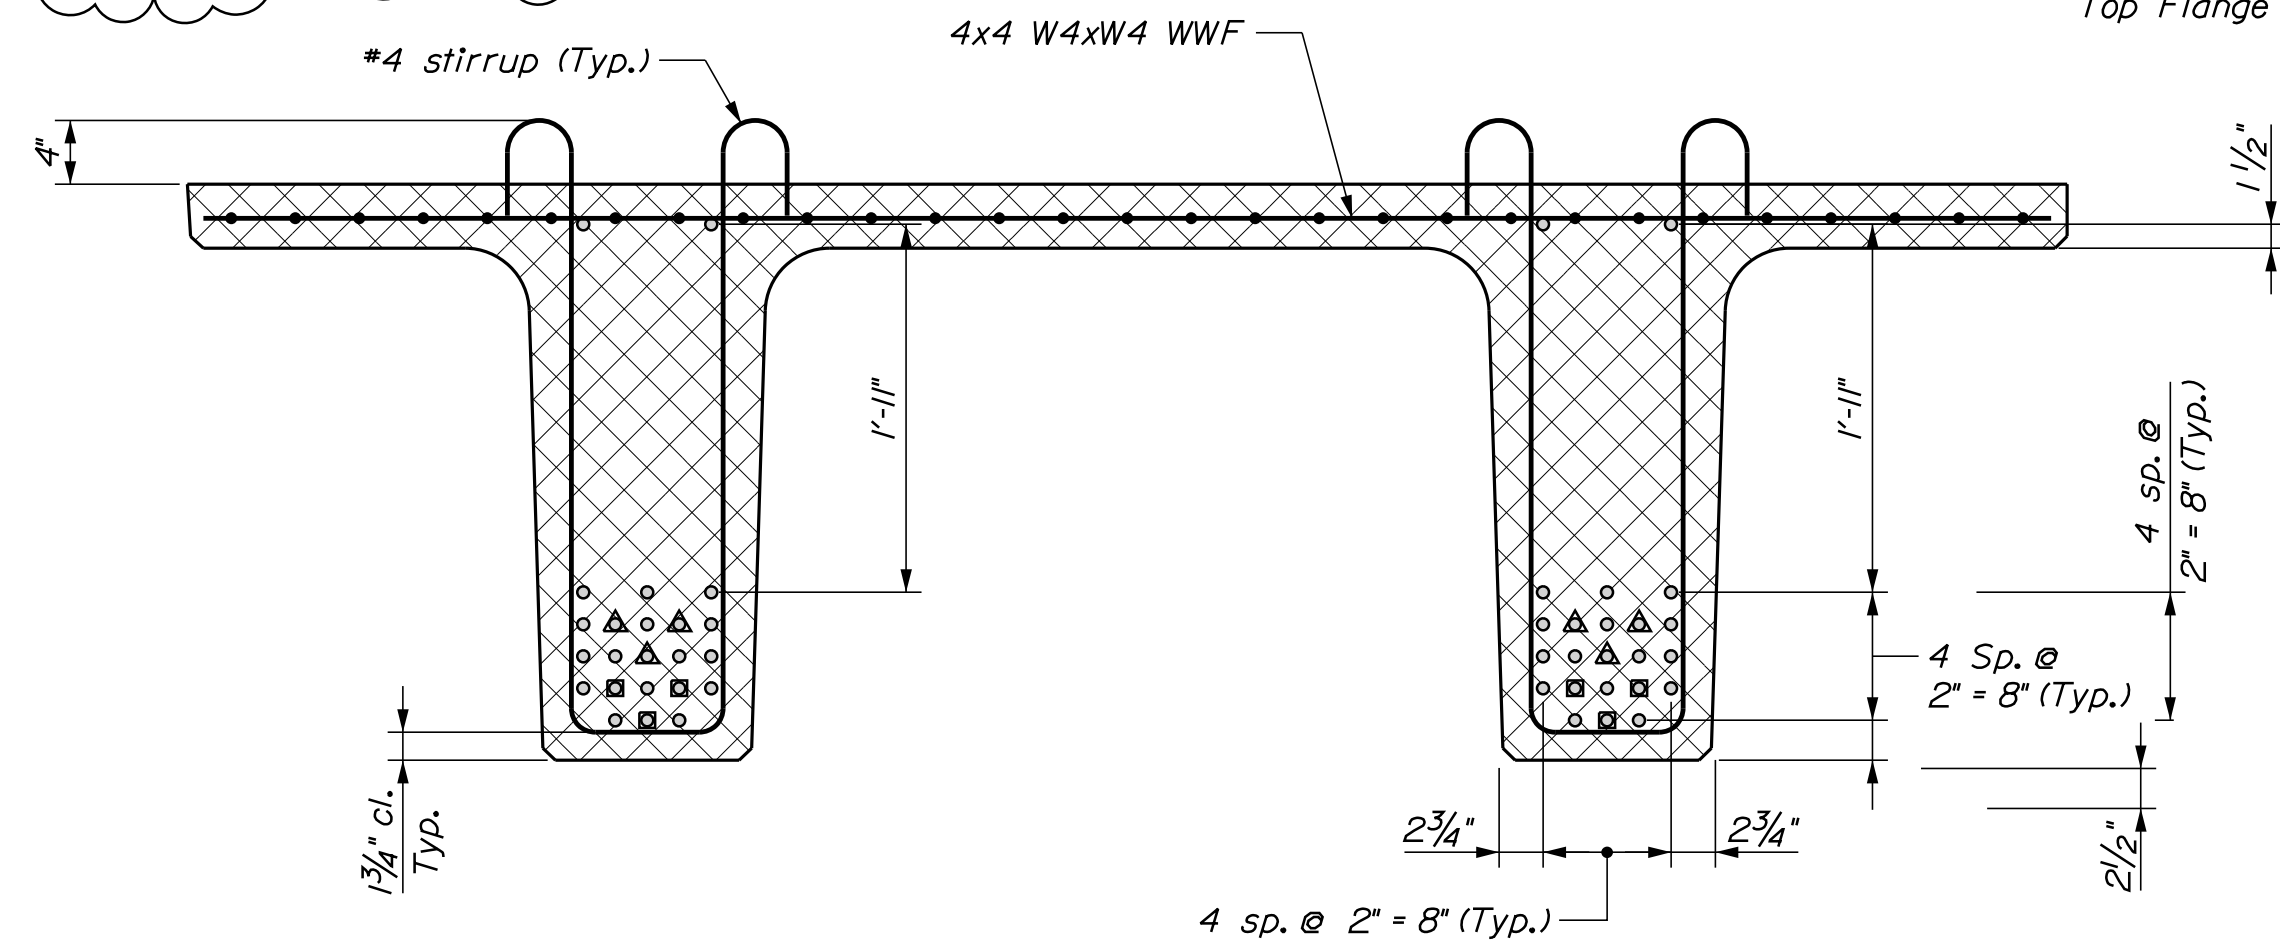

NEXT F BEAM TYPICAL REINFORCING SECTION

\blacktriangle Strands Debonded 3 ft.
 \blacksquare Strands Debonded 6 ft.

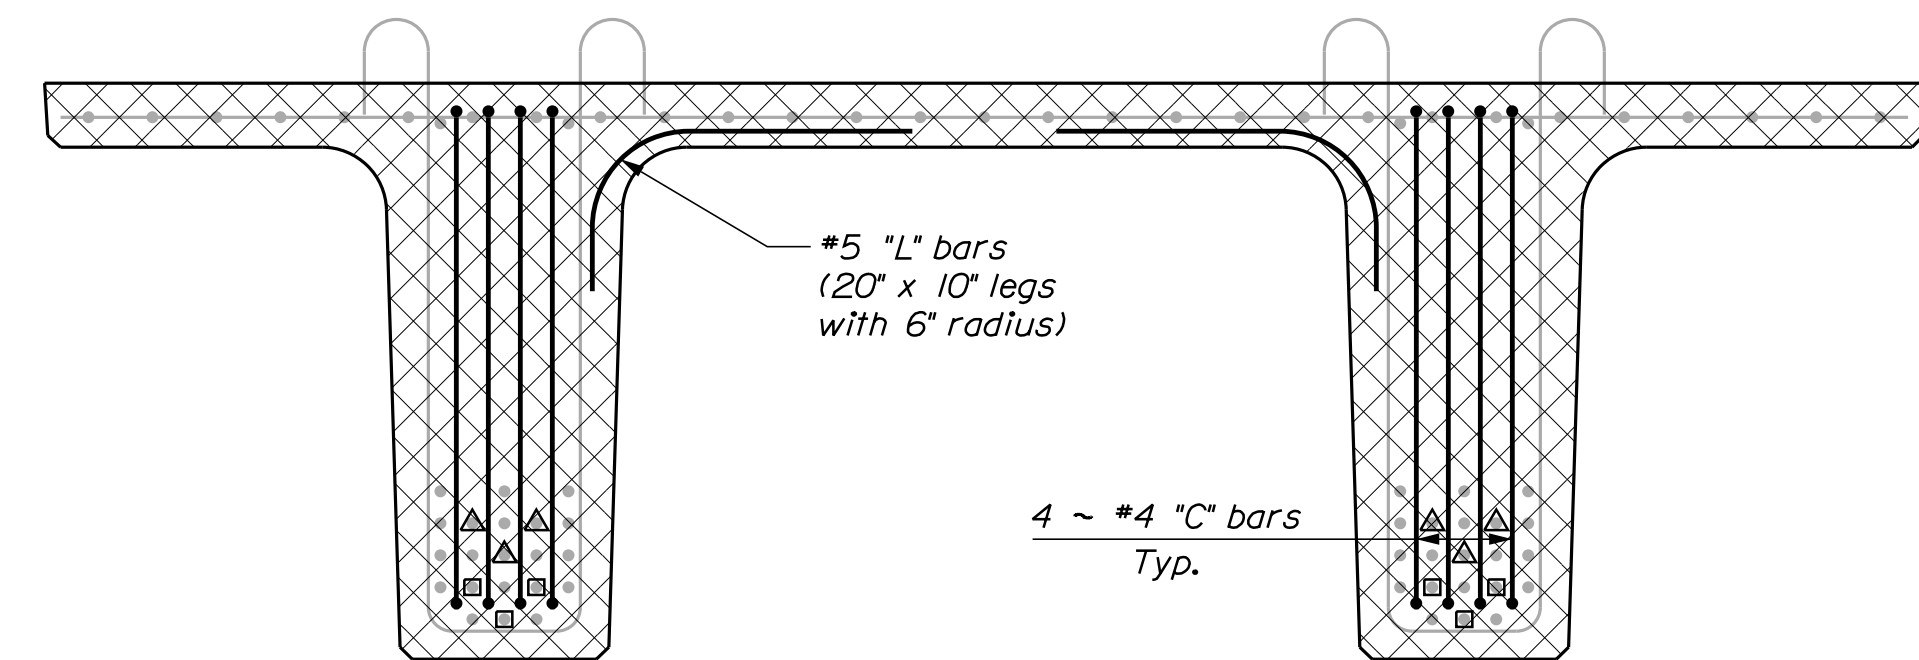

NEXT F BEAM END REINFORCING SECTION

\blacktriangle Strands Debonded 3 ft.
 \blacksquare Strands Debonded 6 ft.

DATE	BY	REVISIONS	P.E. NUMBER	DATE
JAN 2026	J.P.	DESIGN-DETAILED		
JAN 2026	J.P.	CHECKED-REVIEWED		
JAN 2026	J.P.	DESIGNS-DETAILED		
MAR 2026	J.P.	REVISIONS		
		REVISIONS		
		REVISIONS		
		FIELD CHANGES		

PROJ. MANAGER	J. BRASK	DATE
DESIGN-DETAILED	J.P.	JAN 2026
CHECKED-REVIEWED	J.P.	JAN 2026
DESIGNS-DETAILED	J.P.	JAN 2026
REVISIONS	J.P.	MAR 2026
REVISIONS	J.P.	
REVISIONS	J.P.	
FIELD CHANGES	J.P.	

SABATTUS RIVER BRIDGE
 SABATTUS RIVER
 SABATTUS ANDROSCOGGIN COUNTY
PRECAST NEXT BEAM REINFORCING

SHEET NUMBER

28