



Janet T. Mills
GOVERNOR

STATE OF MAINE
DEPARTMENT OF TRANSPORTATION
16 STATE HOUSE STATION
AUGUSTA, MAINE 04333-0016

Dale F. Doughty
ACTING COMMISSIONER

September 23, 2025
Subject: Installation of Road
Weather Information System &
Curve Warning Systems
State WIN: 026630.13
Location: **Calais**
Amendment No. 3

Dear Sir/Ms.:

Please make the following changes to the Bid Documents:

In the Plan Set:

REMOVE Plan Sheet 4 of 17 titled DETAILS (01 OF 02) and **REPLACE** with the attached Plan Sheet 4 of 17 titled DETAILS (01 OF 02).

The following questions have been received:

Question: Is a remote power management (RPM) unit required in the cabinets? It is listed on plan sheet 4 of 17, but no mention in the specification or on the schedule of items.


Response: Plan Sheet 4 has been updated to remove reference to a remote power management (RPM) unit. No RPM unit is expected to be provided as part of the Micro-Climate Road Weather Information Station.

Consider these changes and information prior to submitting your bid on **September 24, 2025**


Sincerely,

A handwritten signature in blue ink that reads 'George Macdougall'.

George M. A. Macdougall P.E.
Contracts & Specifications Engineer

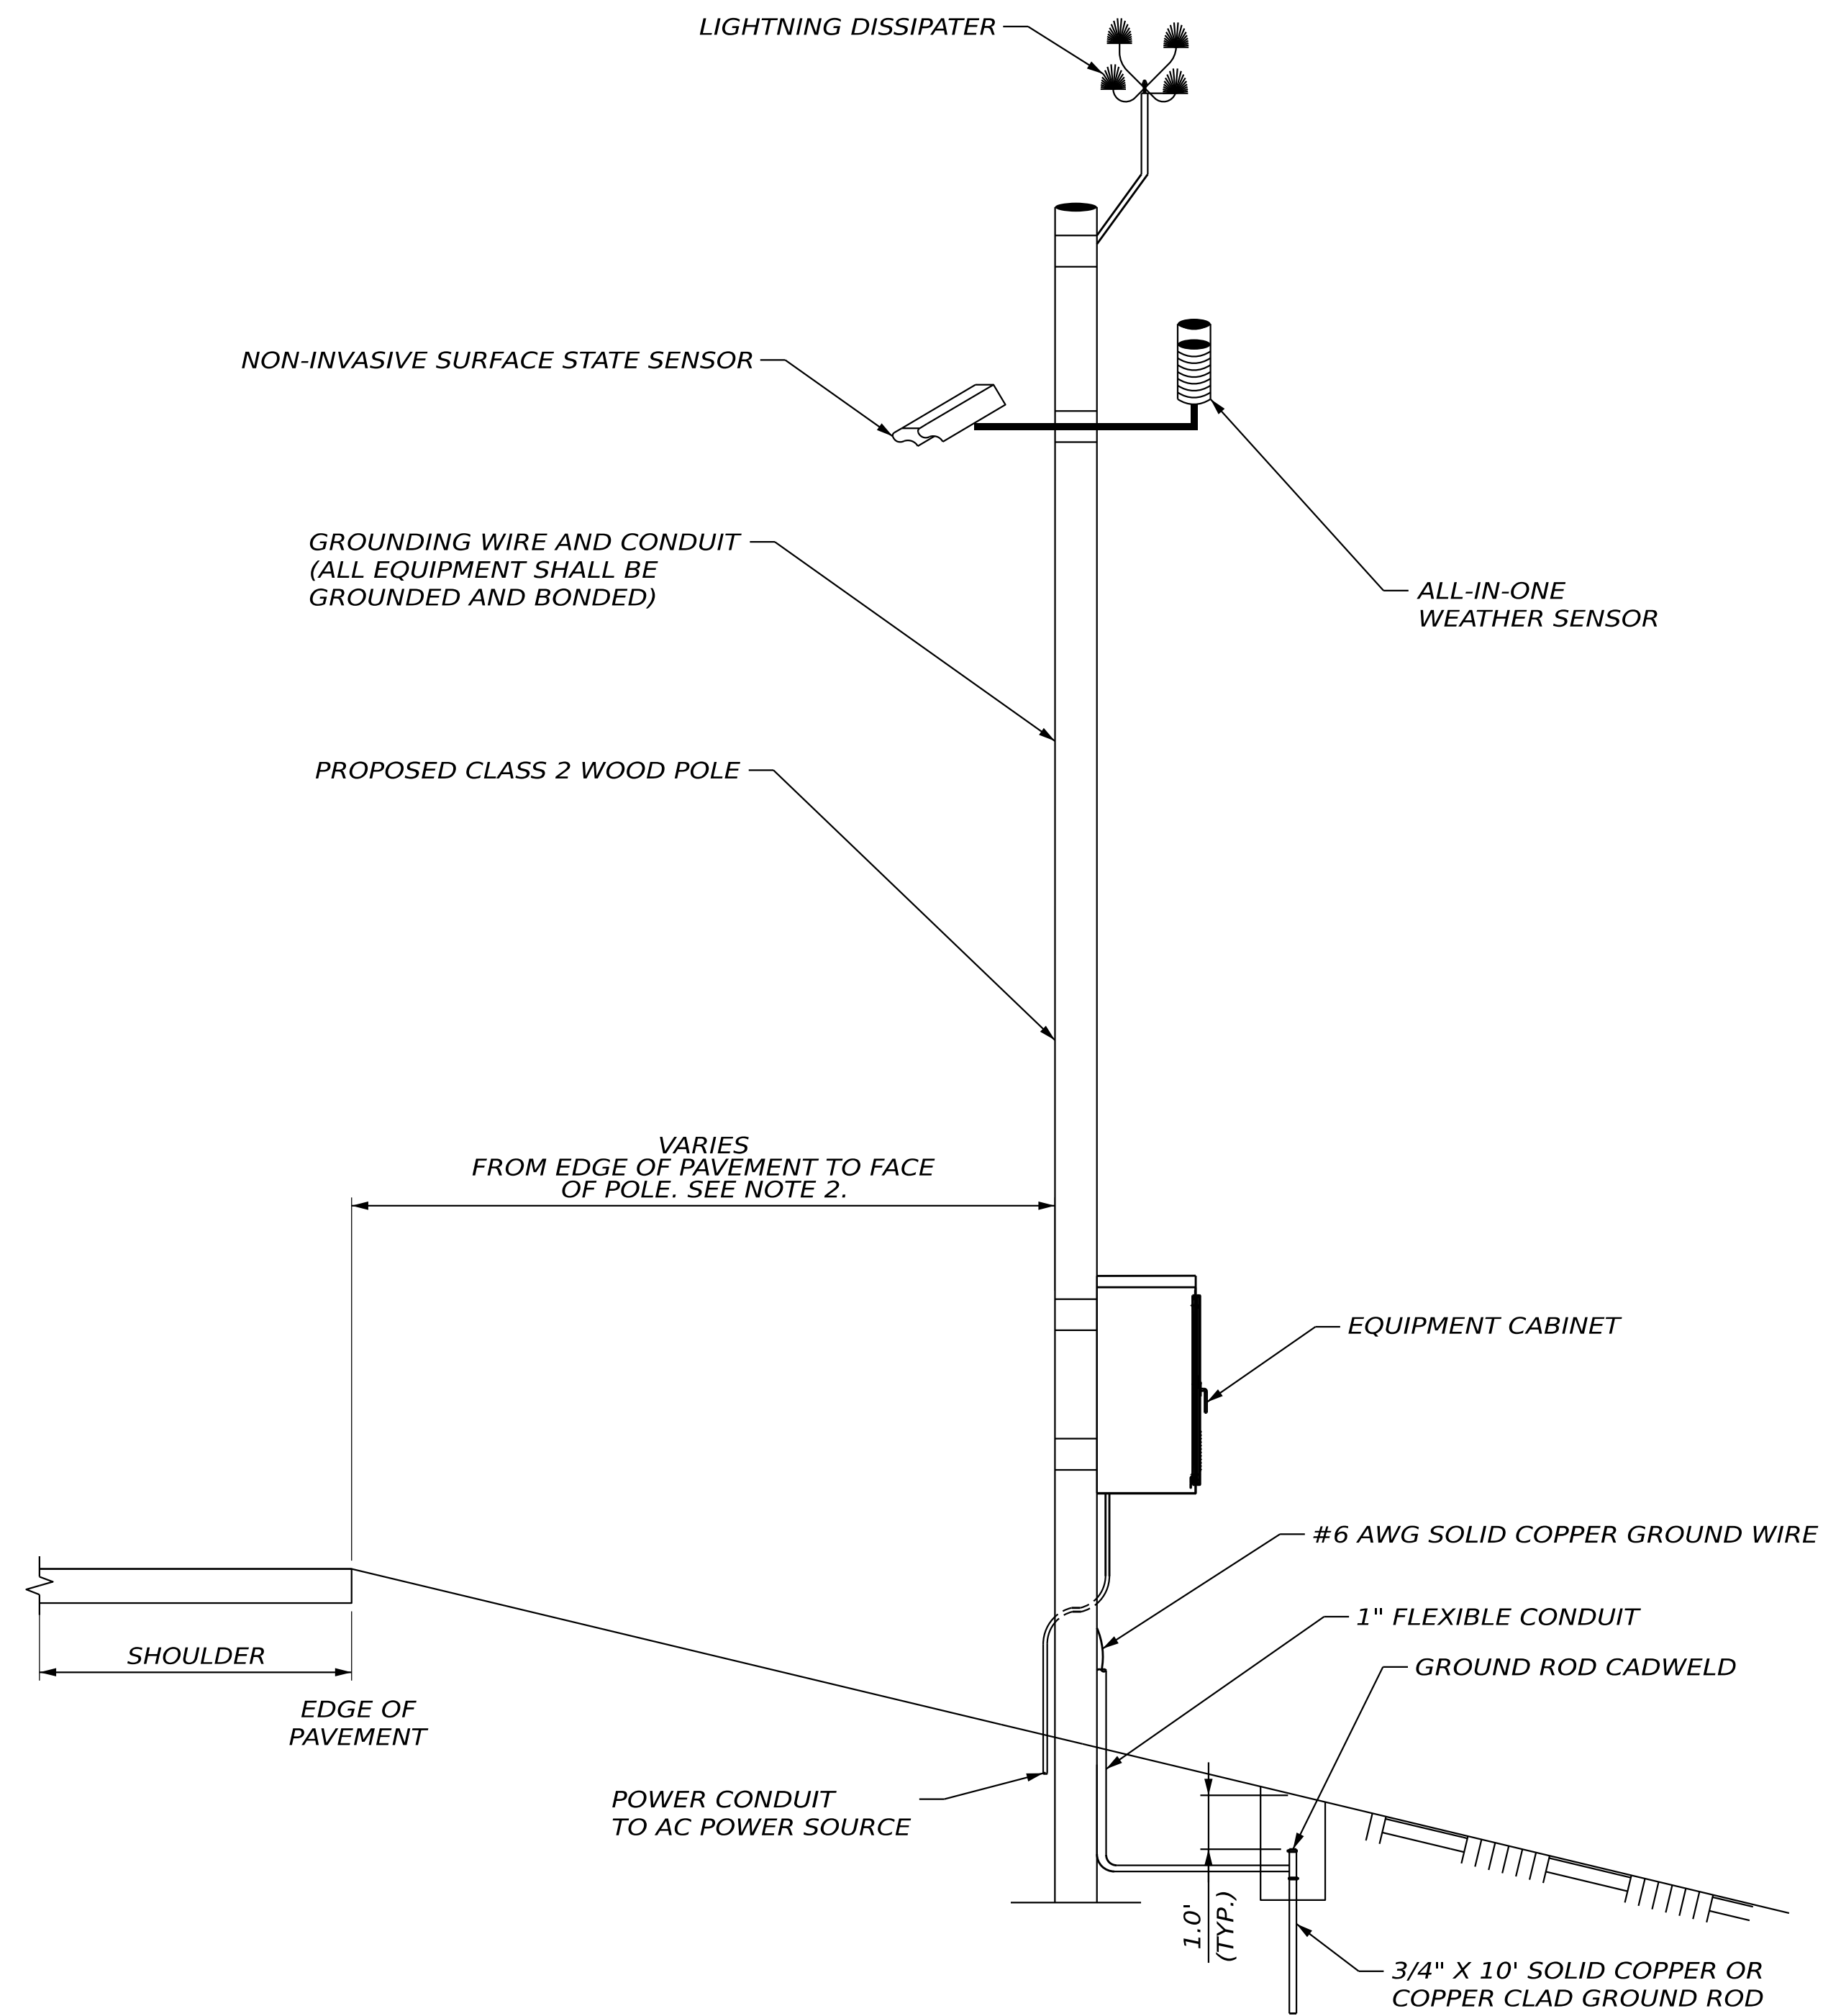


MICRO-CLIMATE ROAD WEATHER INFORMATION STATION WOOD POLE DETAIL
NOT TO SCALE

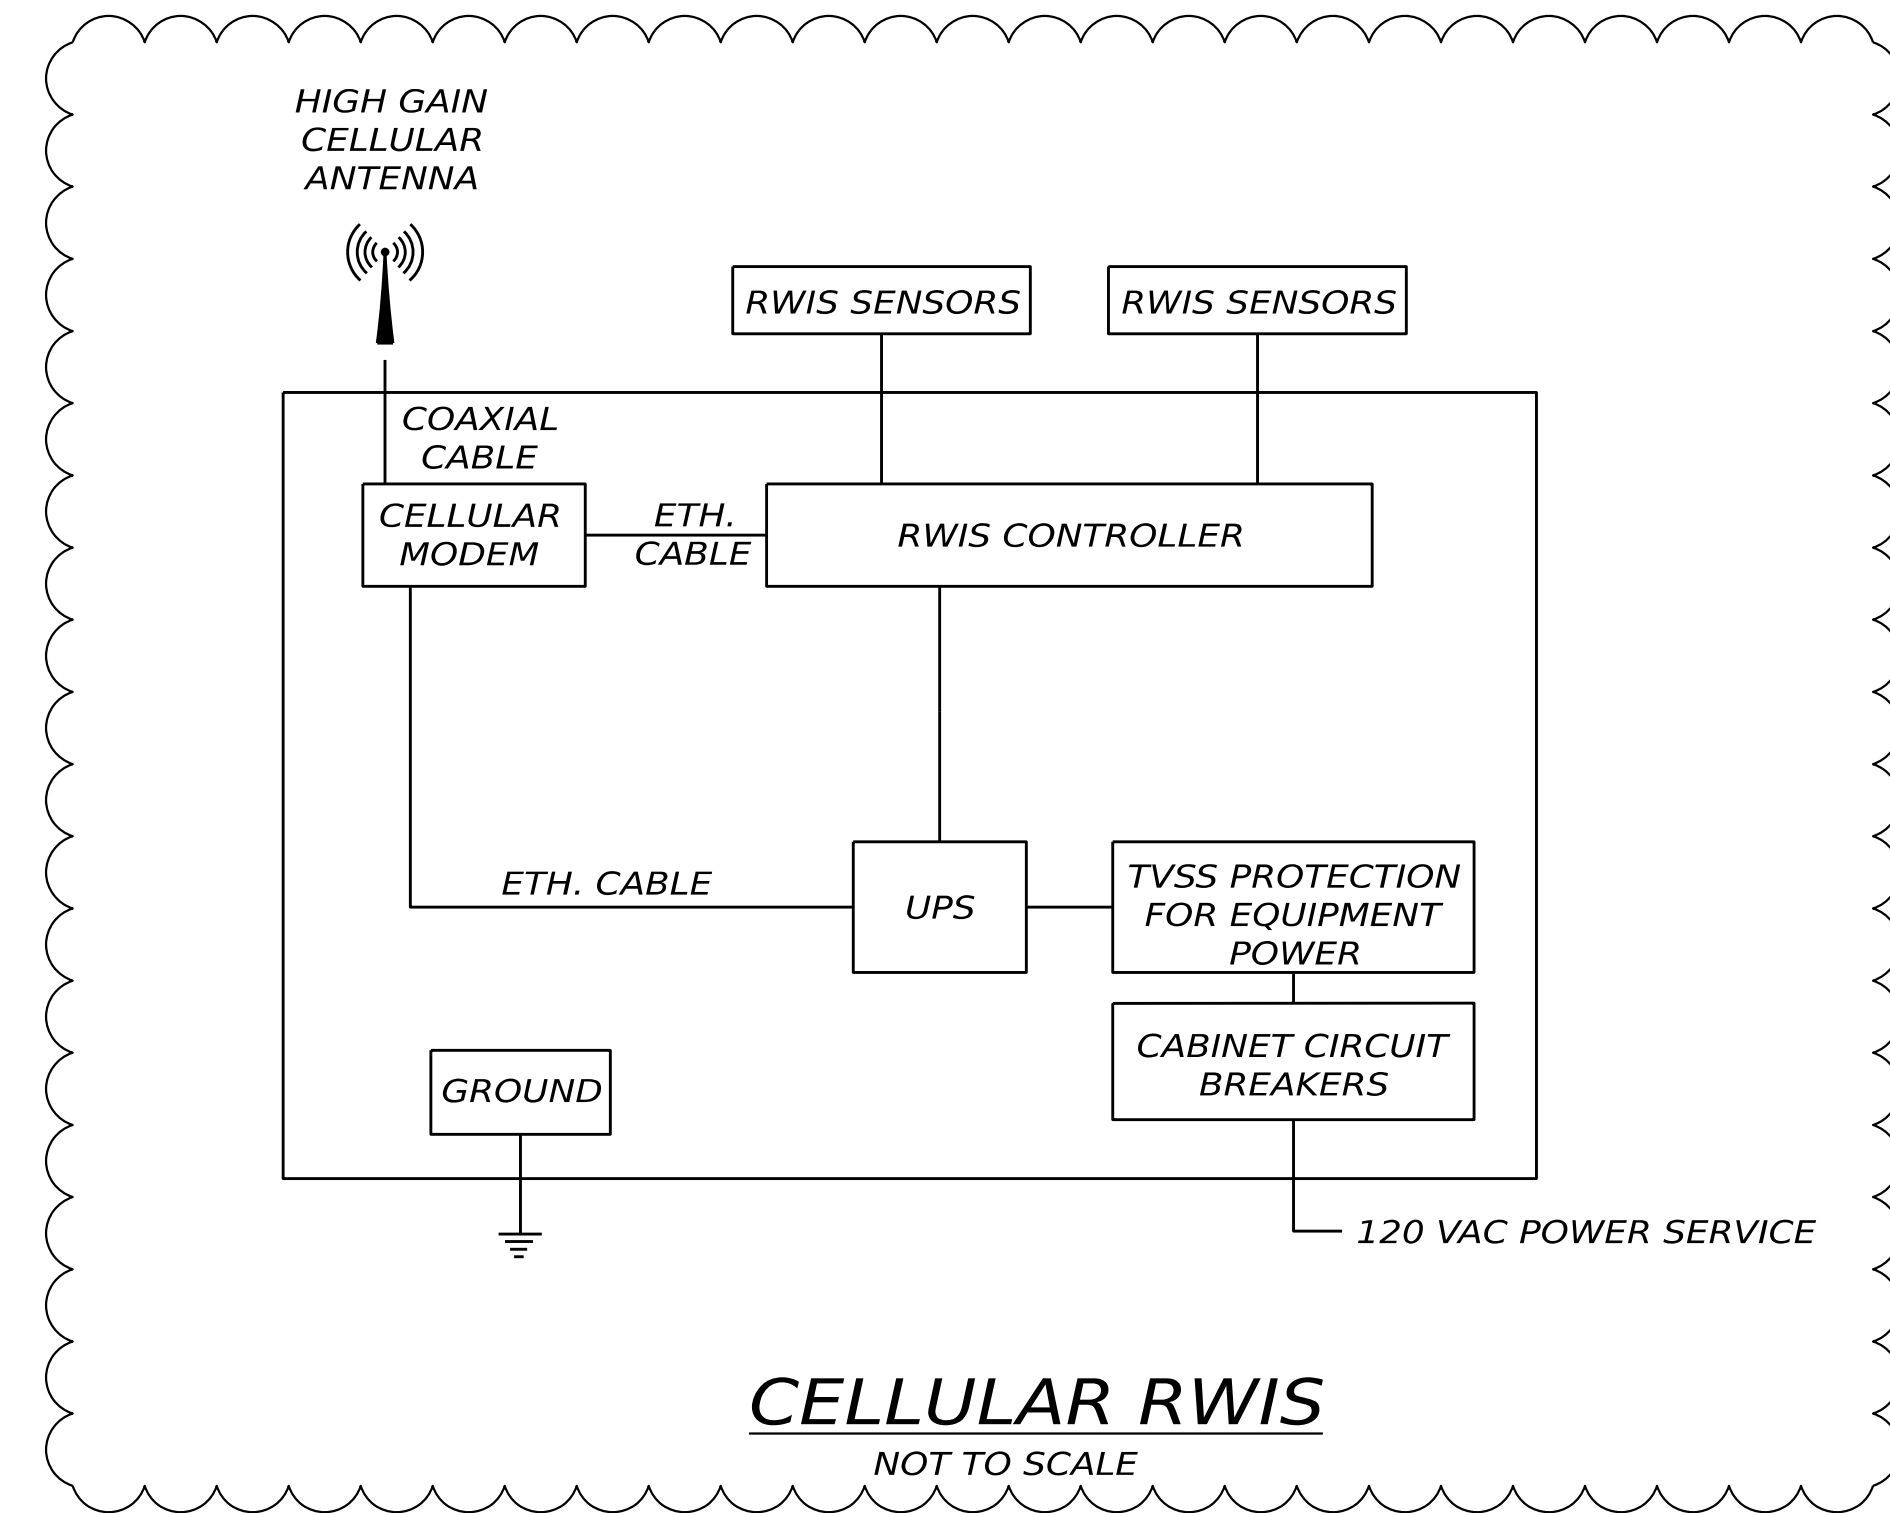

CELLULAR RWIS
NOT TO SCALE

1

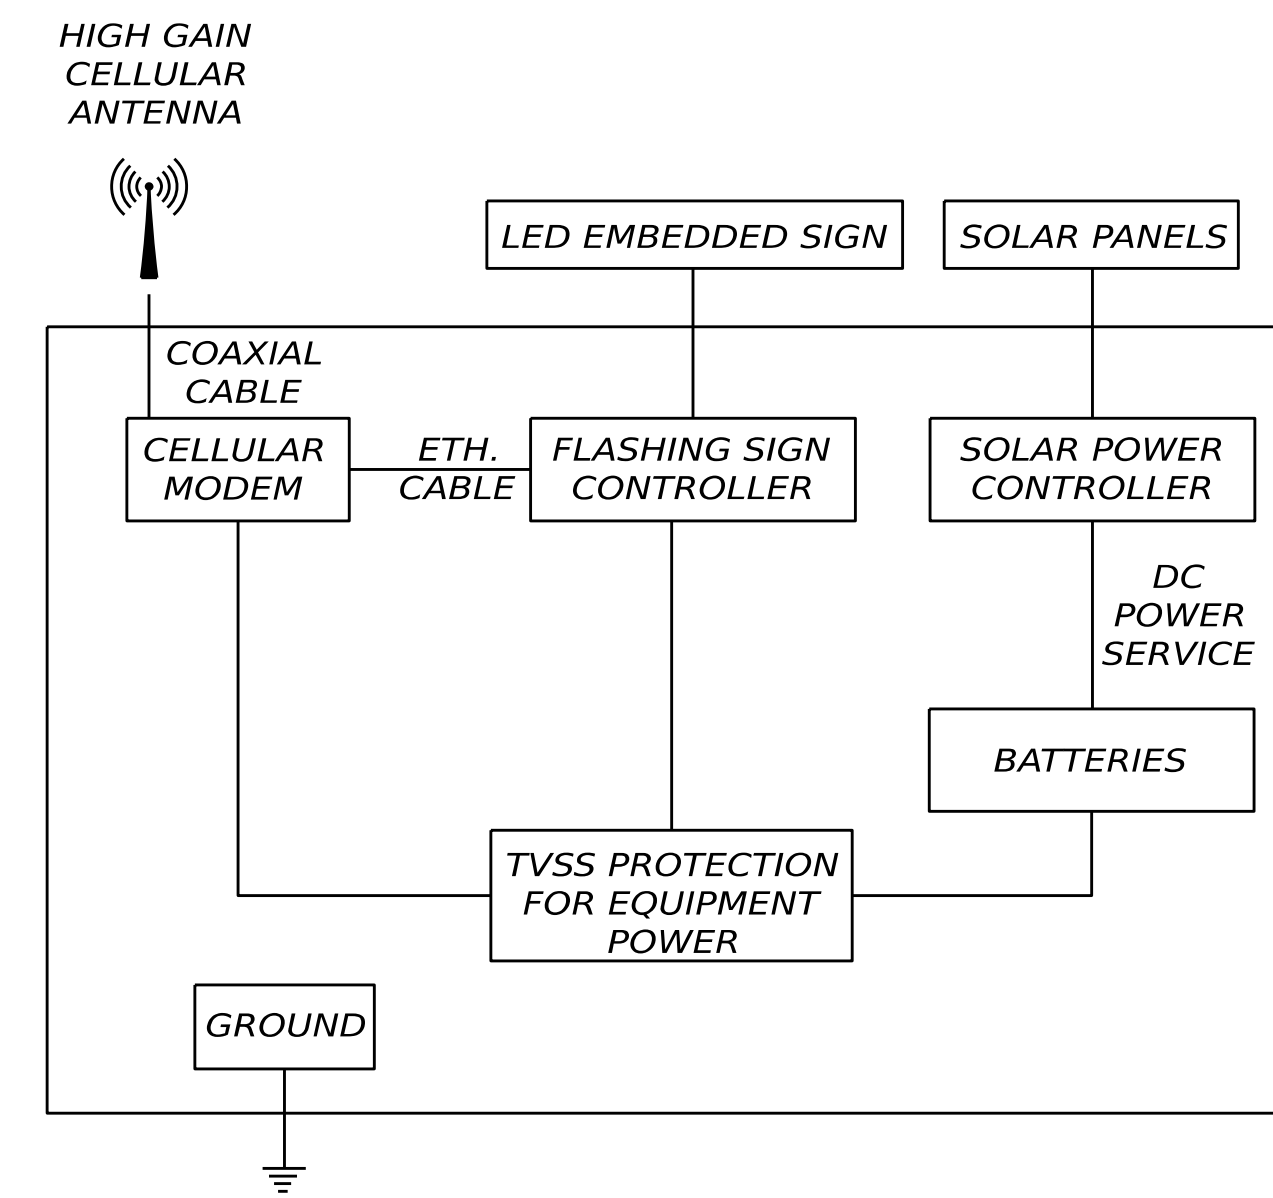

CELLULAR ICY CURVE WARNING SIGN
NOT TO SCALE

- NOTES:**
1. HEIGHT OF EQUIPMENT PER MANUFACTURER'S STANDARDS AND RECOMMENDATION. THE CONTRACTOR'S SUBMITTAL SHALL INCLUDE THE PROPOSED HEIGHTS OF THE RWIS SUPPORT POLES.
 2. SEE INDIVIDUAL RWIS PLAN SHEETS FOR MORE DETAILS ON OFFSET FROM EDGE OF PAVEMENT.



PROJ. MANAGER	R. BARROWS	BY	DATE
DESIGN-DETAILED	D. SCHANDEL	J. ROBERT	8/15/2025
CHECKED-REVIEWED	D. SCHANDEL	M. SUENINEN	8/15/2025
DESIGN-DETAILED02			
DESIGN-DETAILED03	ADDENDUM 1		9/22/2025
REVISIONS 1			
REVISIONS 2			
REVISIONS 3			
REVISIONS 4			
FIELD CHANGES			