

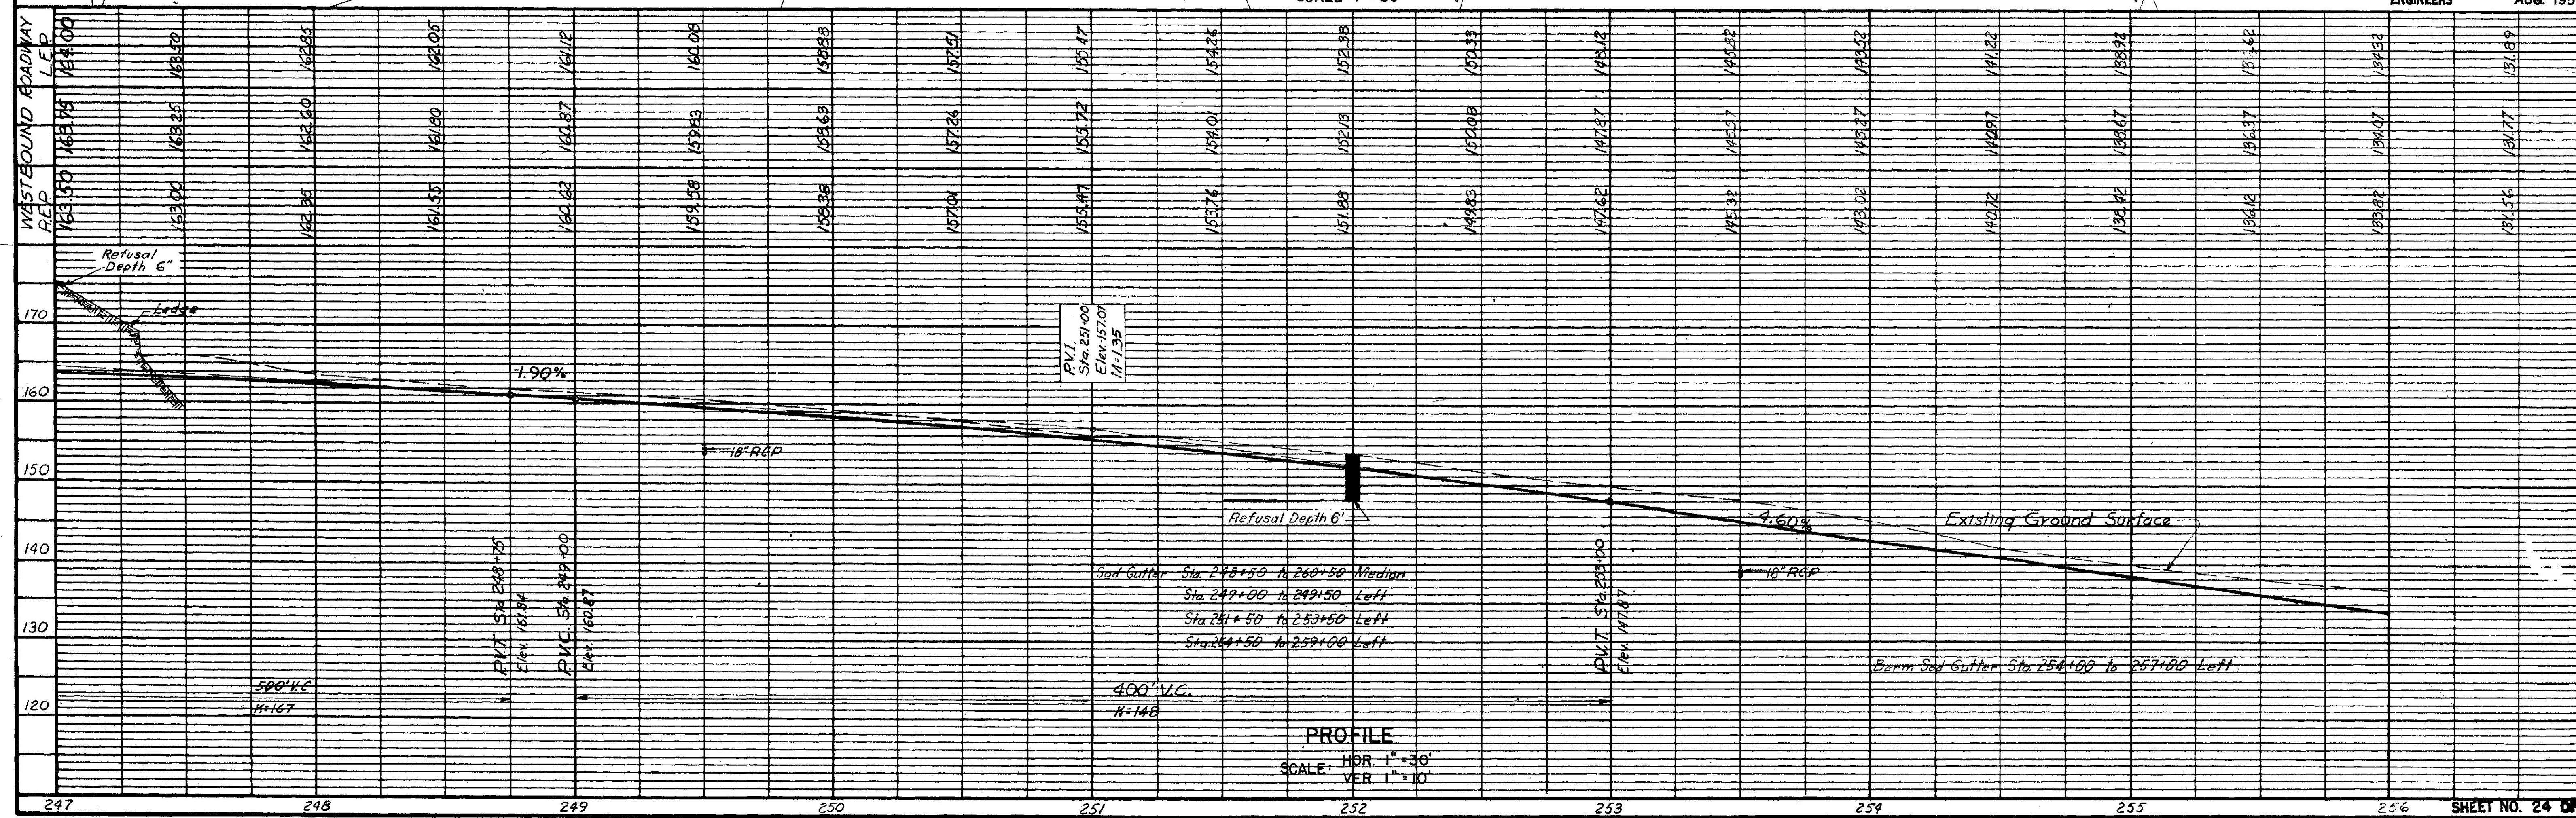


STATE HIGHWAY COMMISSION
AUGUSTA, MAINE
FREEPORT BY PASS
WESTBOUND ROADWAY
PLAN AND PROFILE
STA. 247+00 to STA. 256+00
FAY, SPOFFORD & THORNDIKE, INC.
ENGINEERS
AUG. 1956

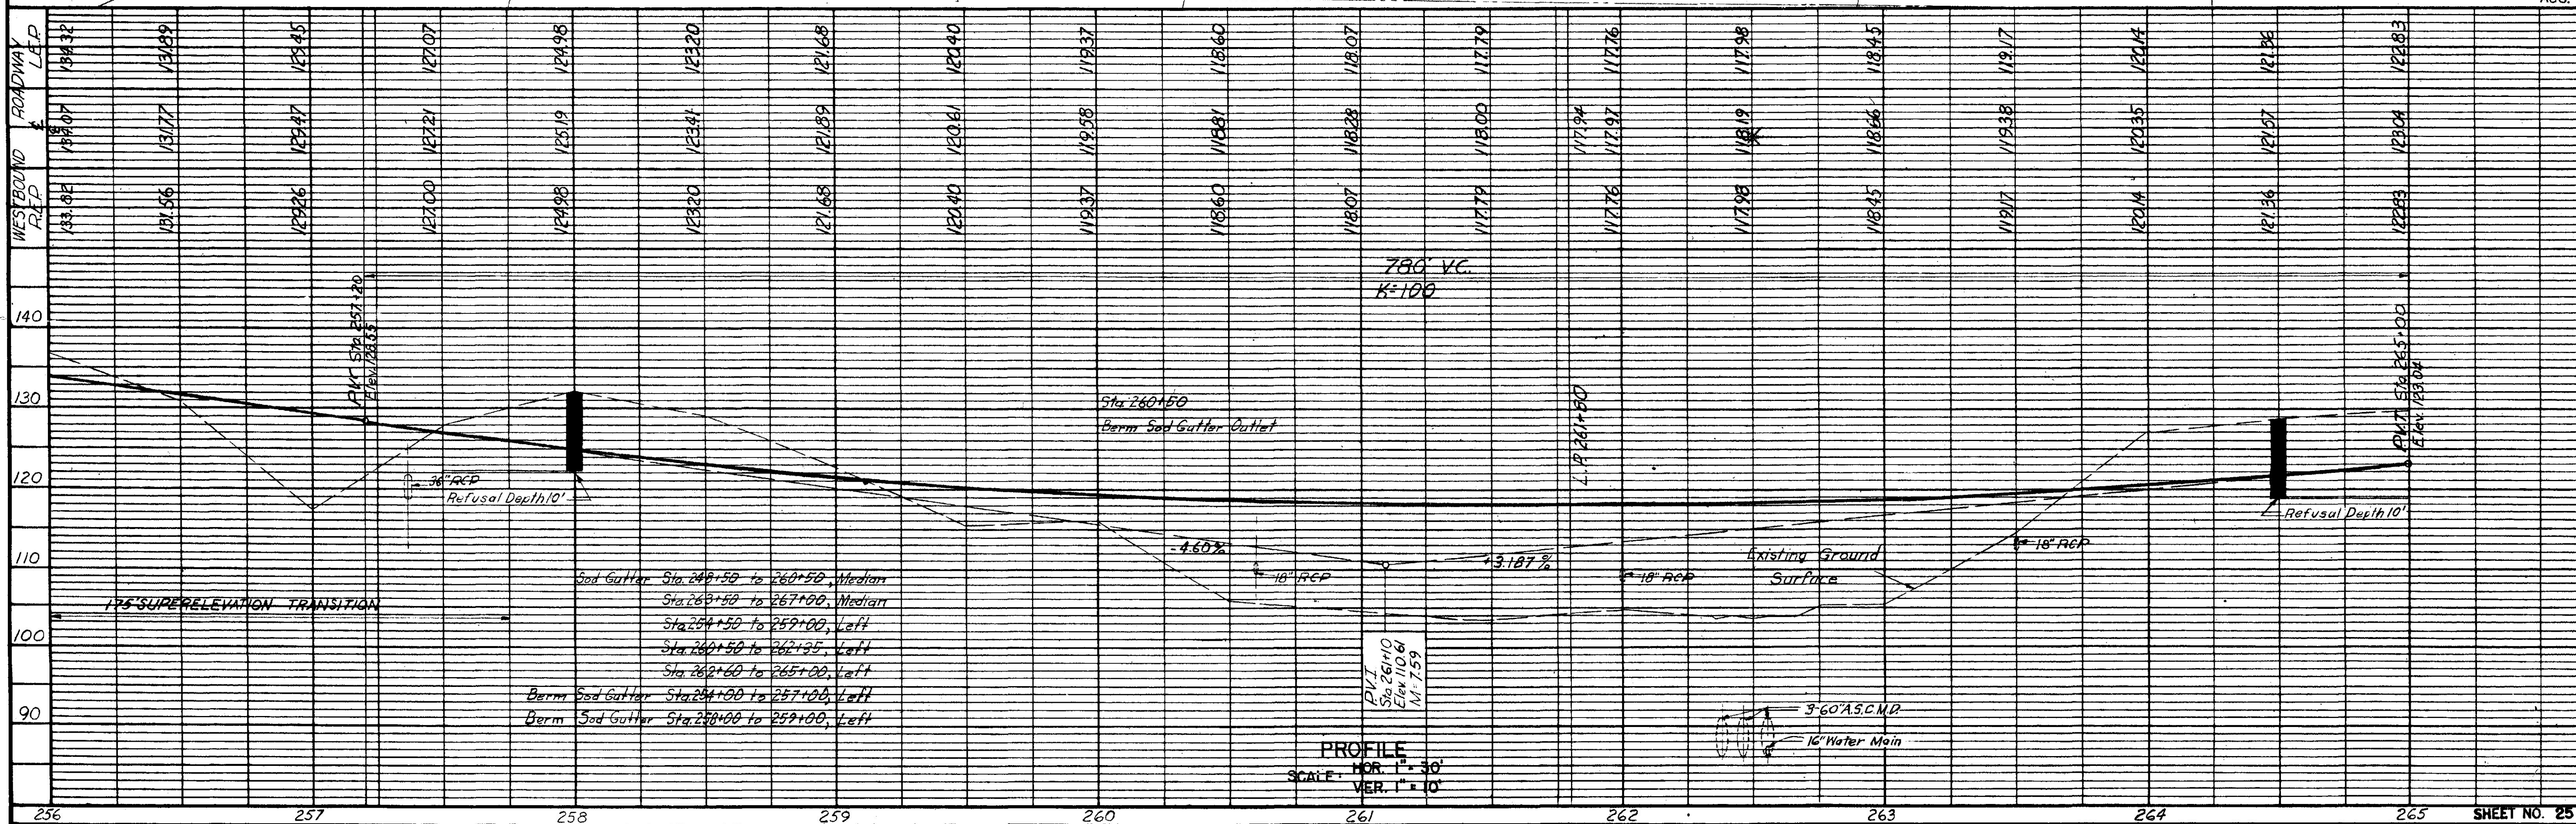

Qm-12
35


DES.	H.W.
DR.	J.R.C.
IN.	J.R.C.
CHK.	C.H.F.
APP.	H.W.

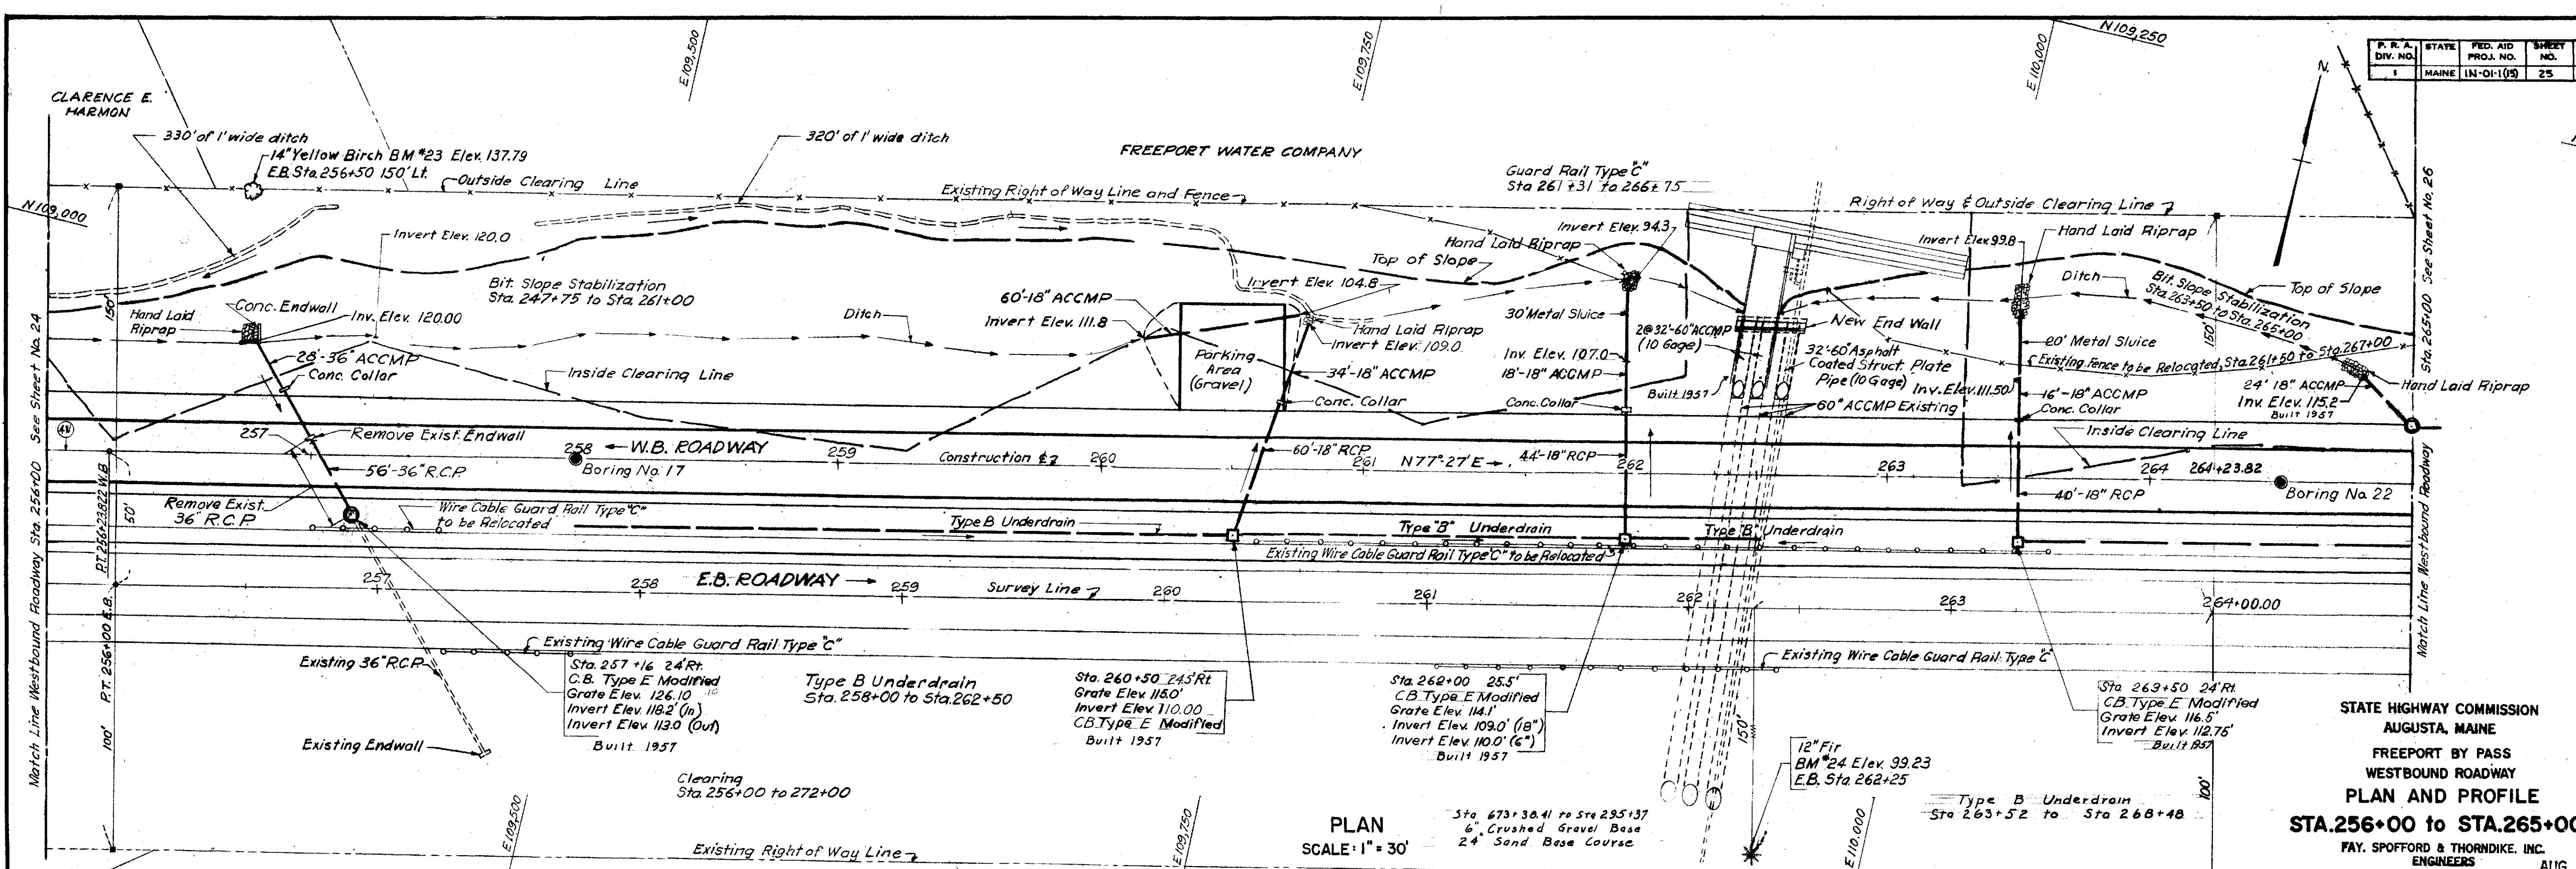


Qm-12
36

DES.	H.H.J.
DR.	W.W.
TH.	W.W.
CHK.	CHF
APP.	H.H.J.



STATE HIGHWAY COMMISSION
AUGUSTA, MAINE
FREEPORT BY PASS
WESTBOUND ROADWAY
PLAN AND PROFILE
STA.256+00 to STA.265+00
FAY, SPOFFORD & THORNDIKE, INC.
ENGINEERS
AUG. 1

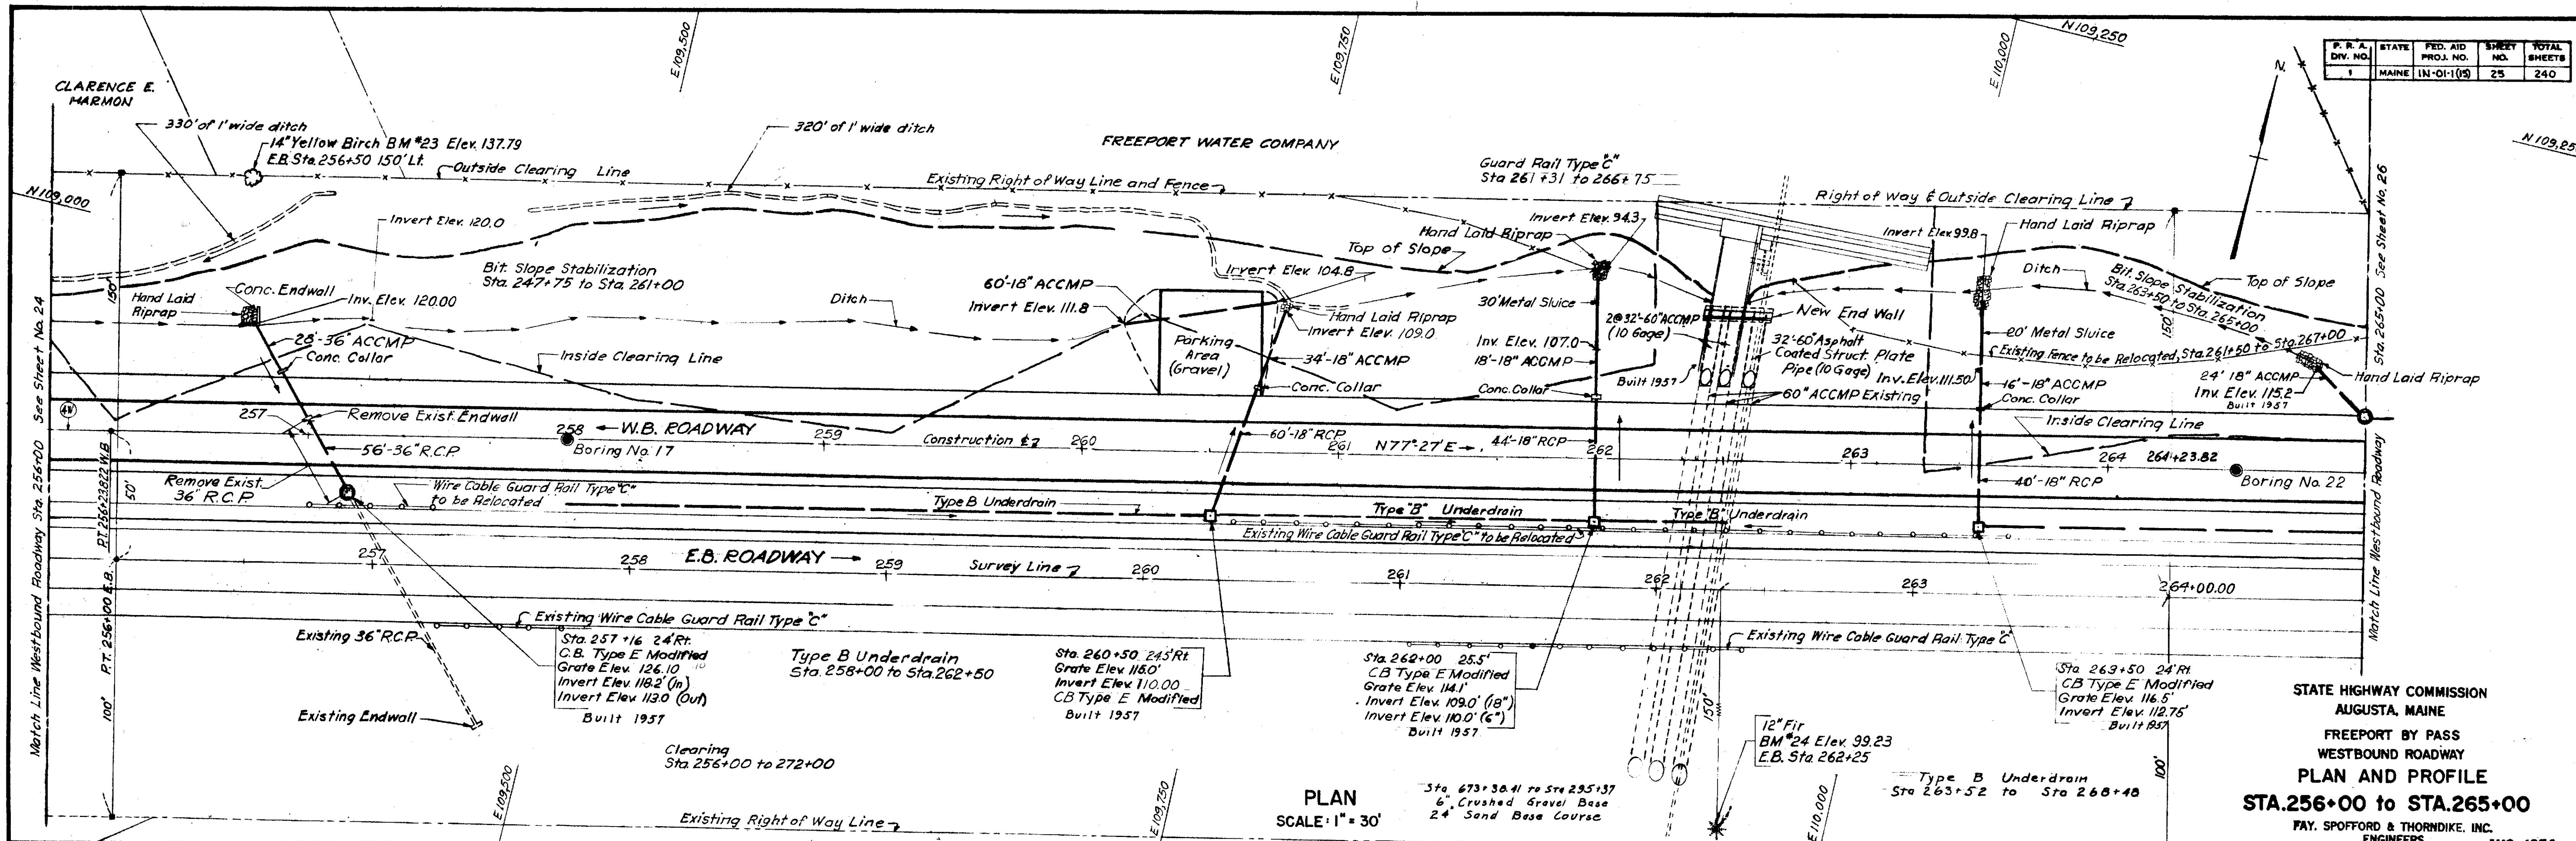

STATE HIGHWAY COMMISSION
AUGUSTA, MAINE
FREEPORT BY PASS
WESTBOUND ROADWAY
PLAN AND PROFILE
STA. 256+00 to STA. 265+00
FAY, SPOFFORD & THORNDIKE, INC.
ENGINEERS
AUG. 1956

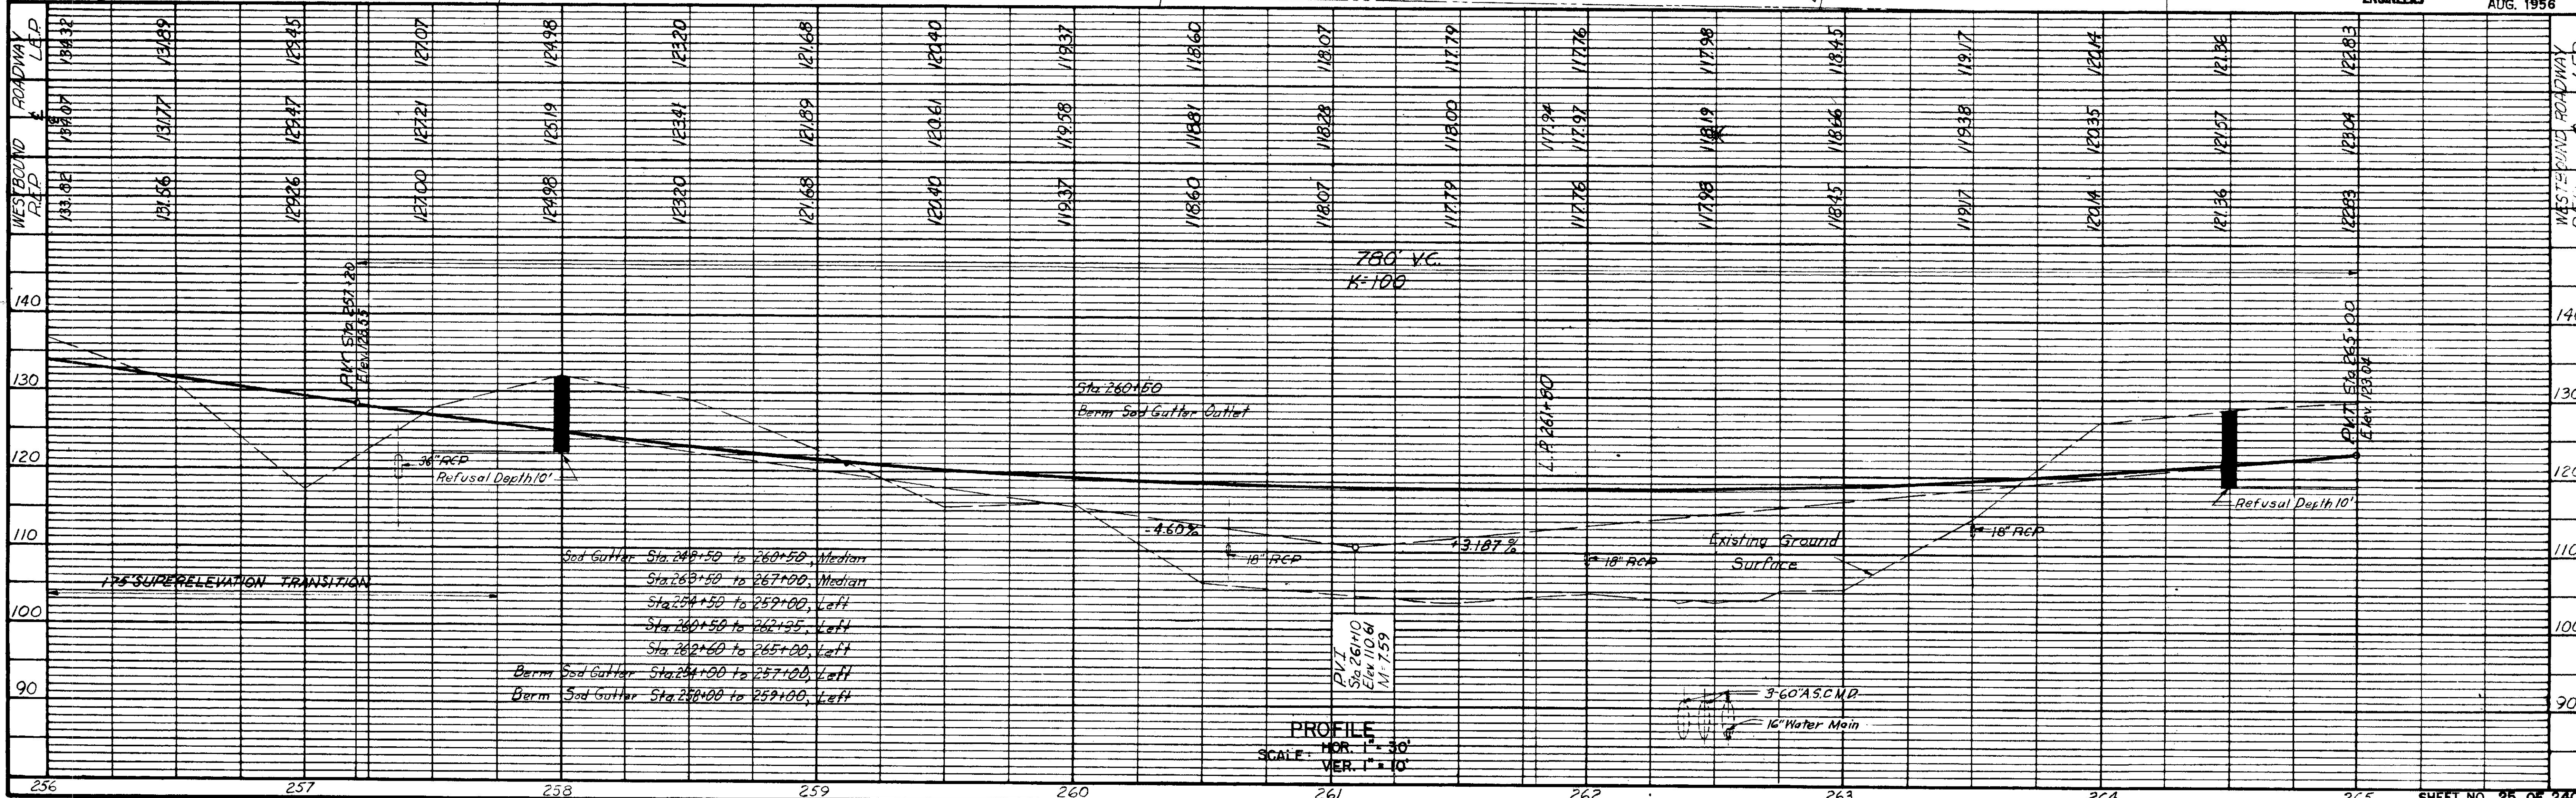


P. R. A. DIV. NO.	STATE	FED. AID PROJ. NO.	SHEET NO.	TOTAL SHEETS
1	MAINE	IN-011(15)	26	240

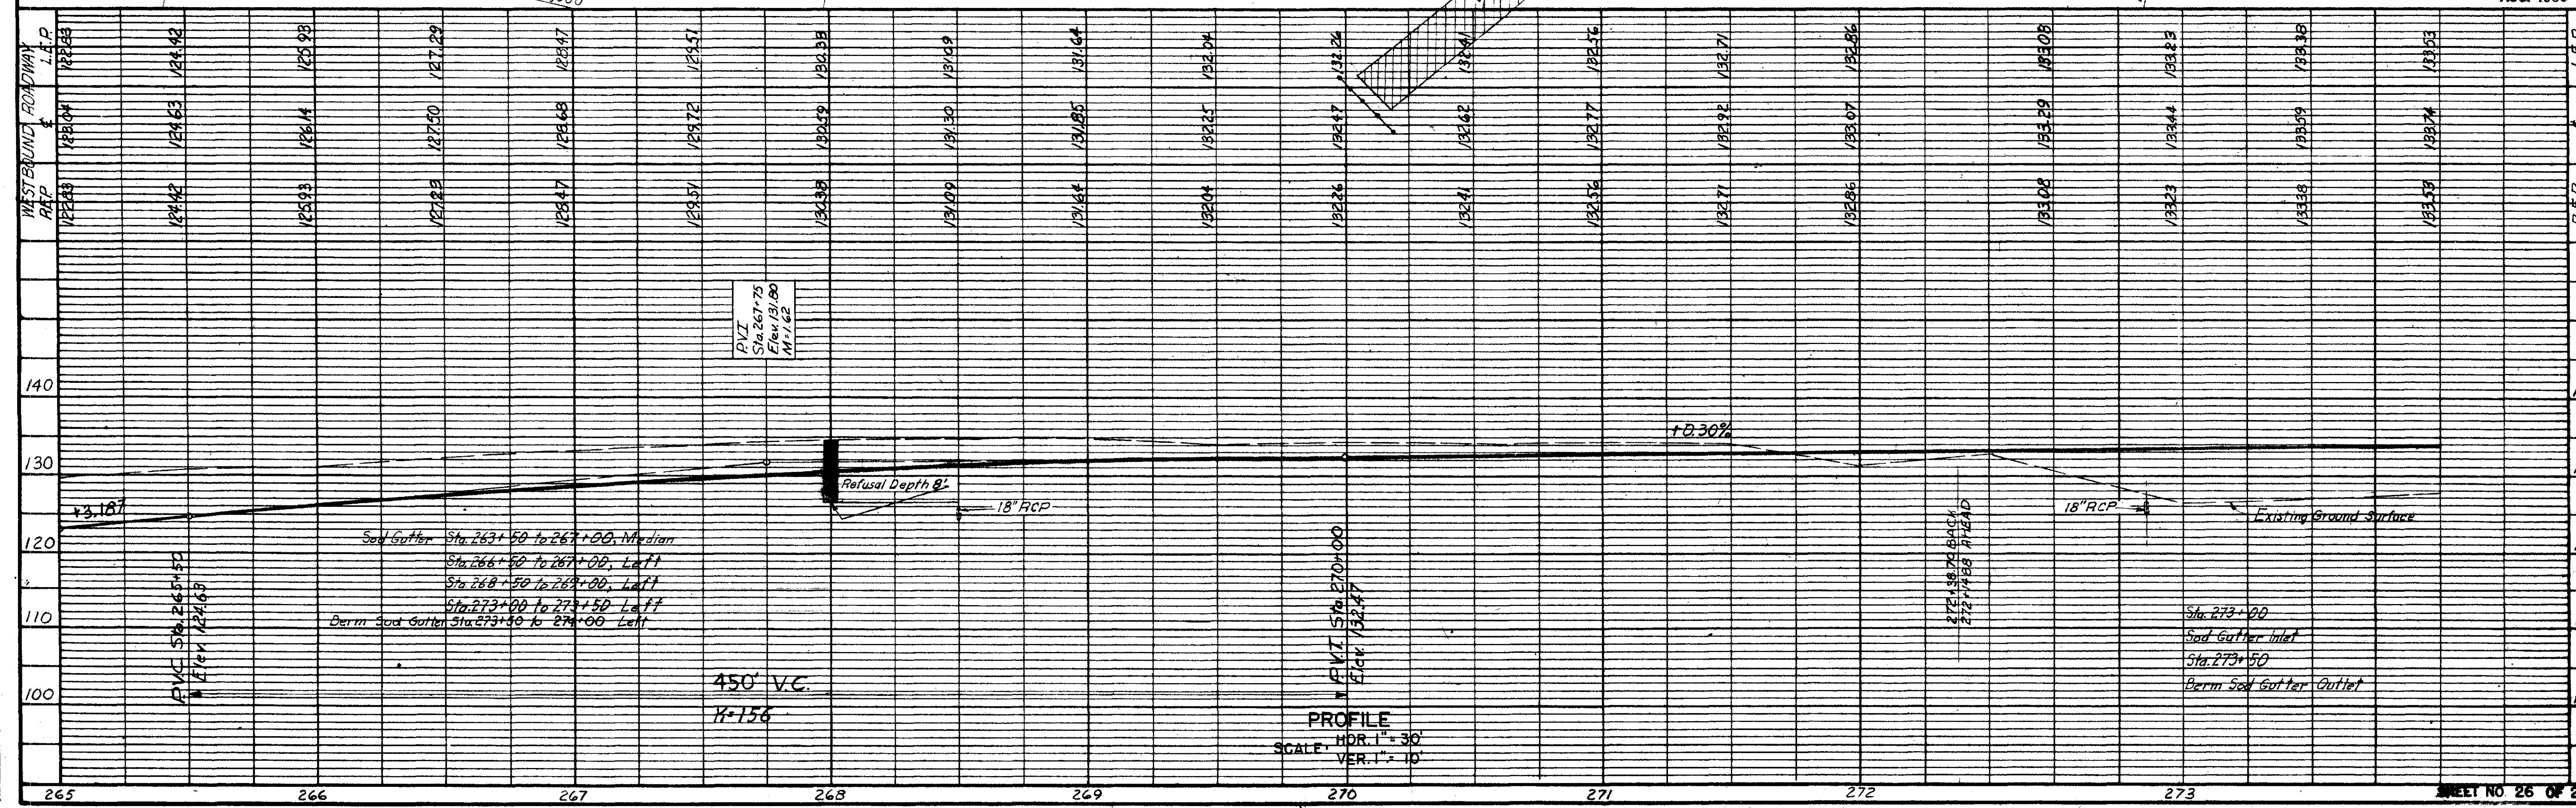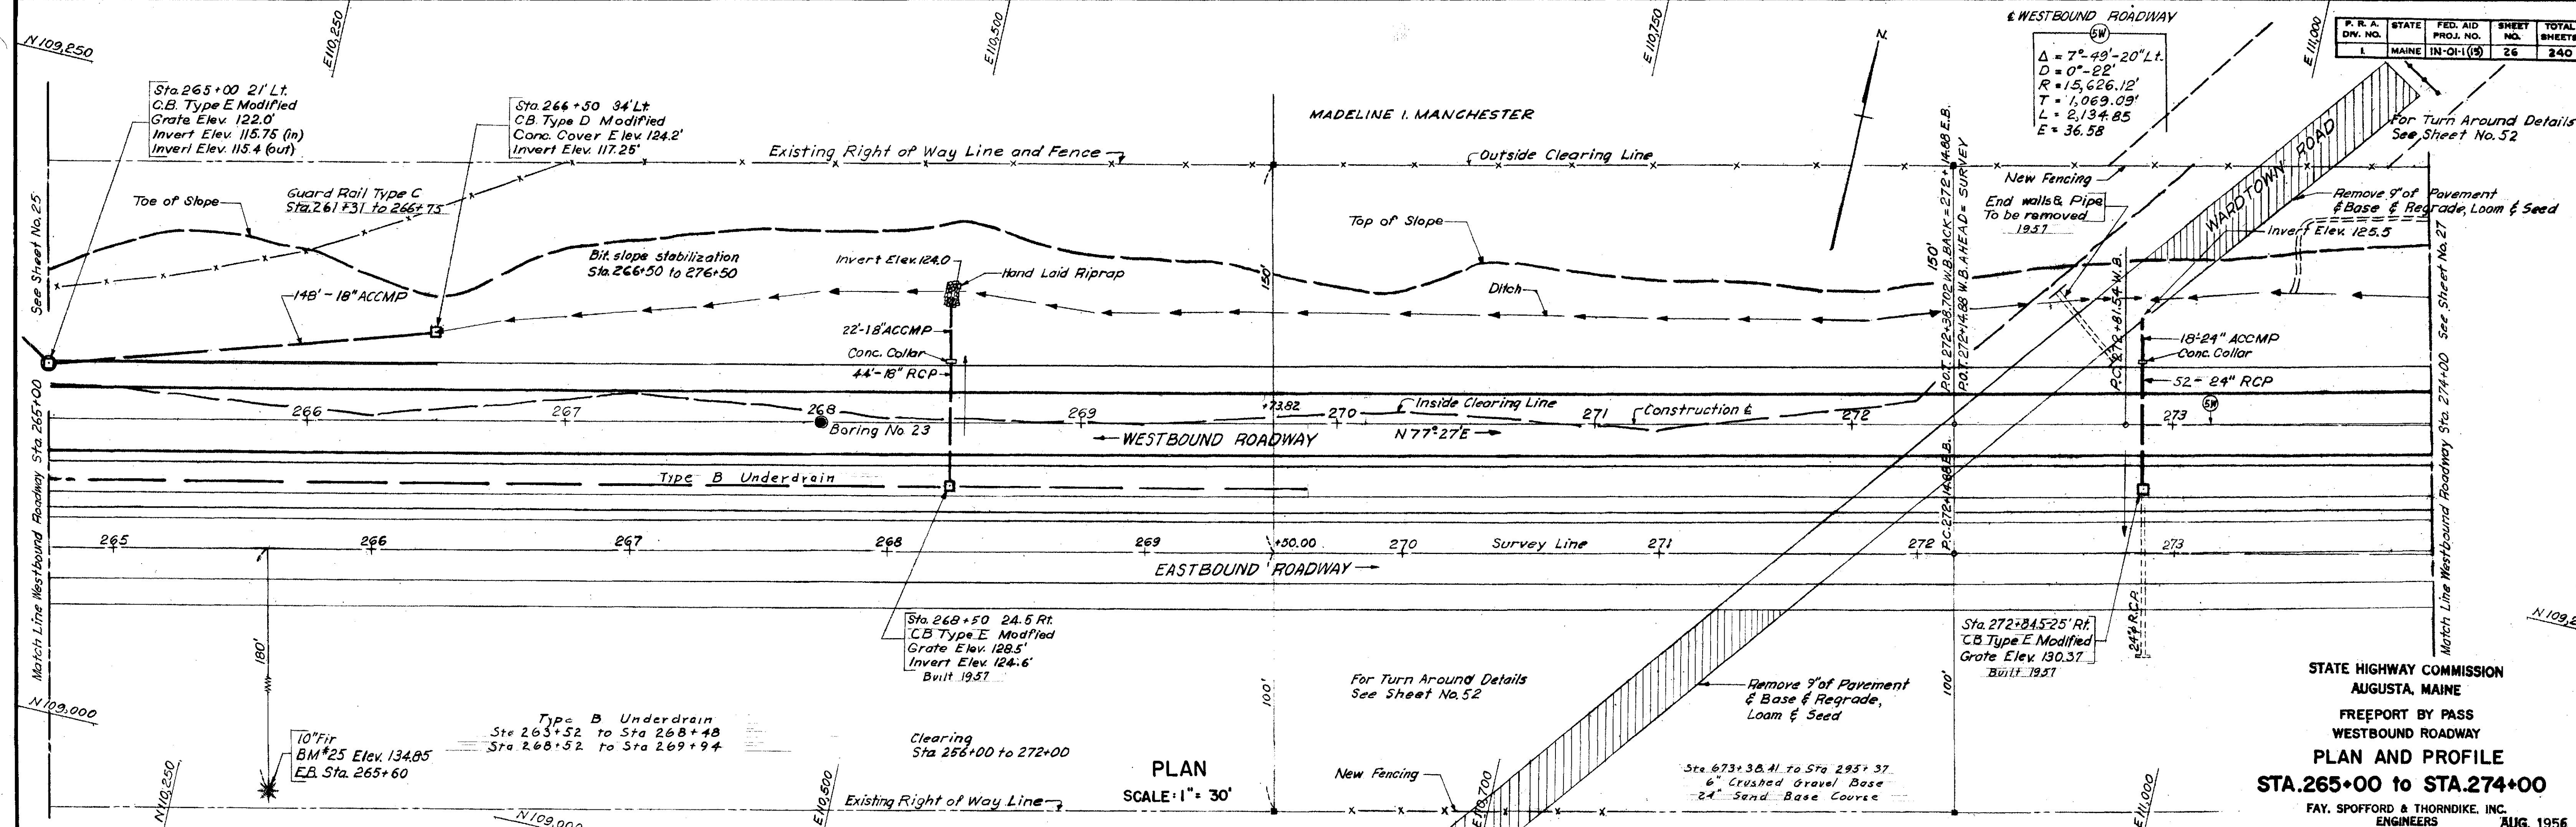


STATE HIGHWAY COMMISSION
AUGUSTA, MAINE
FREEPORT BY PASS
WESTBOUND ROADWAY
PLAN AND PROFILE
STA. 265+00 to STA. 274+00
FAY, SPOFFORD & THORNDIKE, INC.
ENGINEERS
AUG. 1956

Qm-12
37
DES. H.H.J.
DR. R.P.P.
TR. R.P.P.
CHK. C.H.F.
APP. H.H.J.

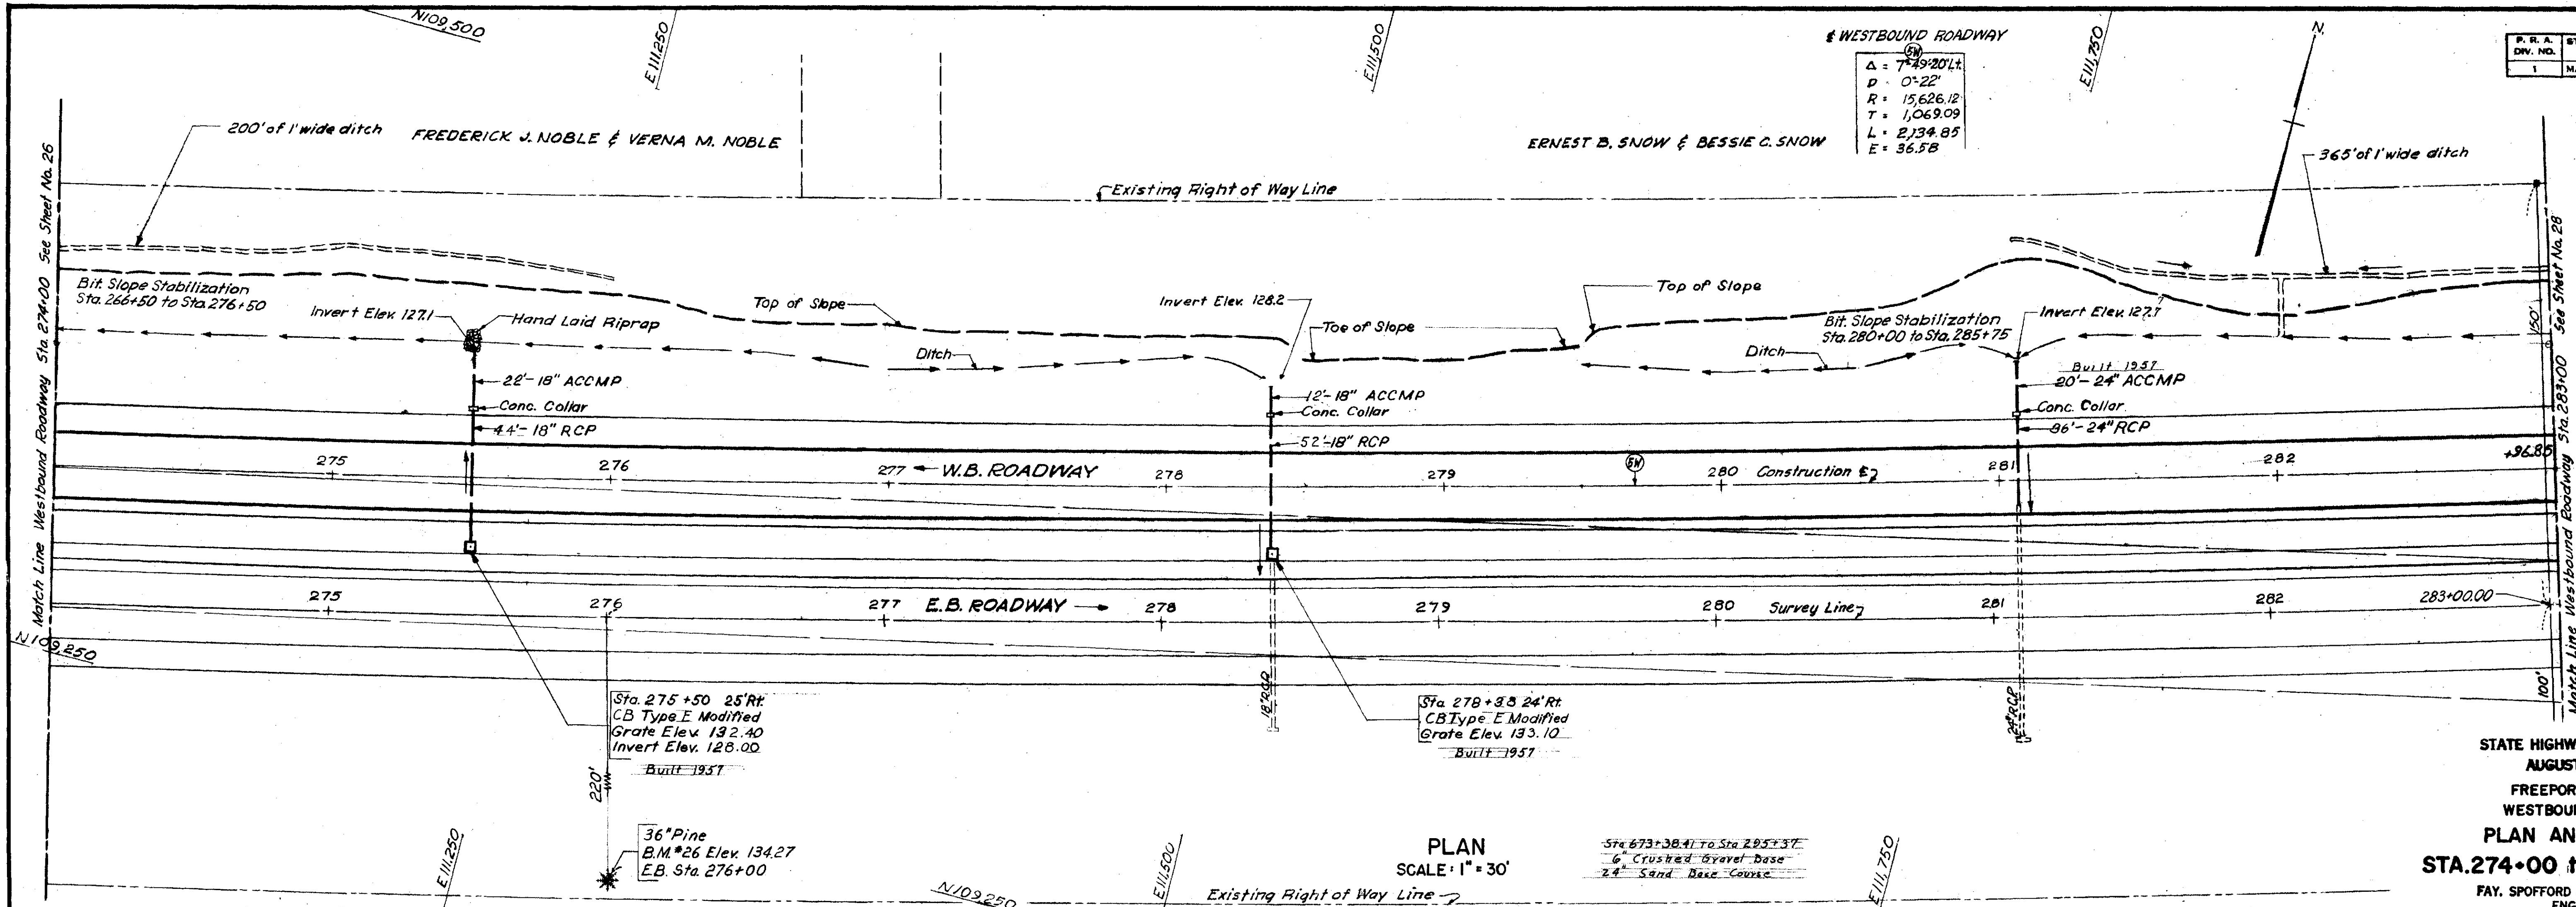


STATE HIGHWAY COMMISSION
AUGUSTA, MAINE
FREEPORT BY PASS
WESTBOUND ROADWAY
PLAN AND PROFILE
STA. 274+00 to STA. 283+00
FAY, SPOFFORD & THORNDIKE, INC.
ENGINEERS
AUG. 1956

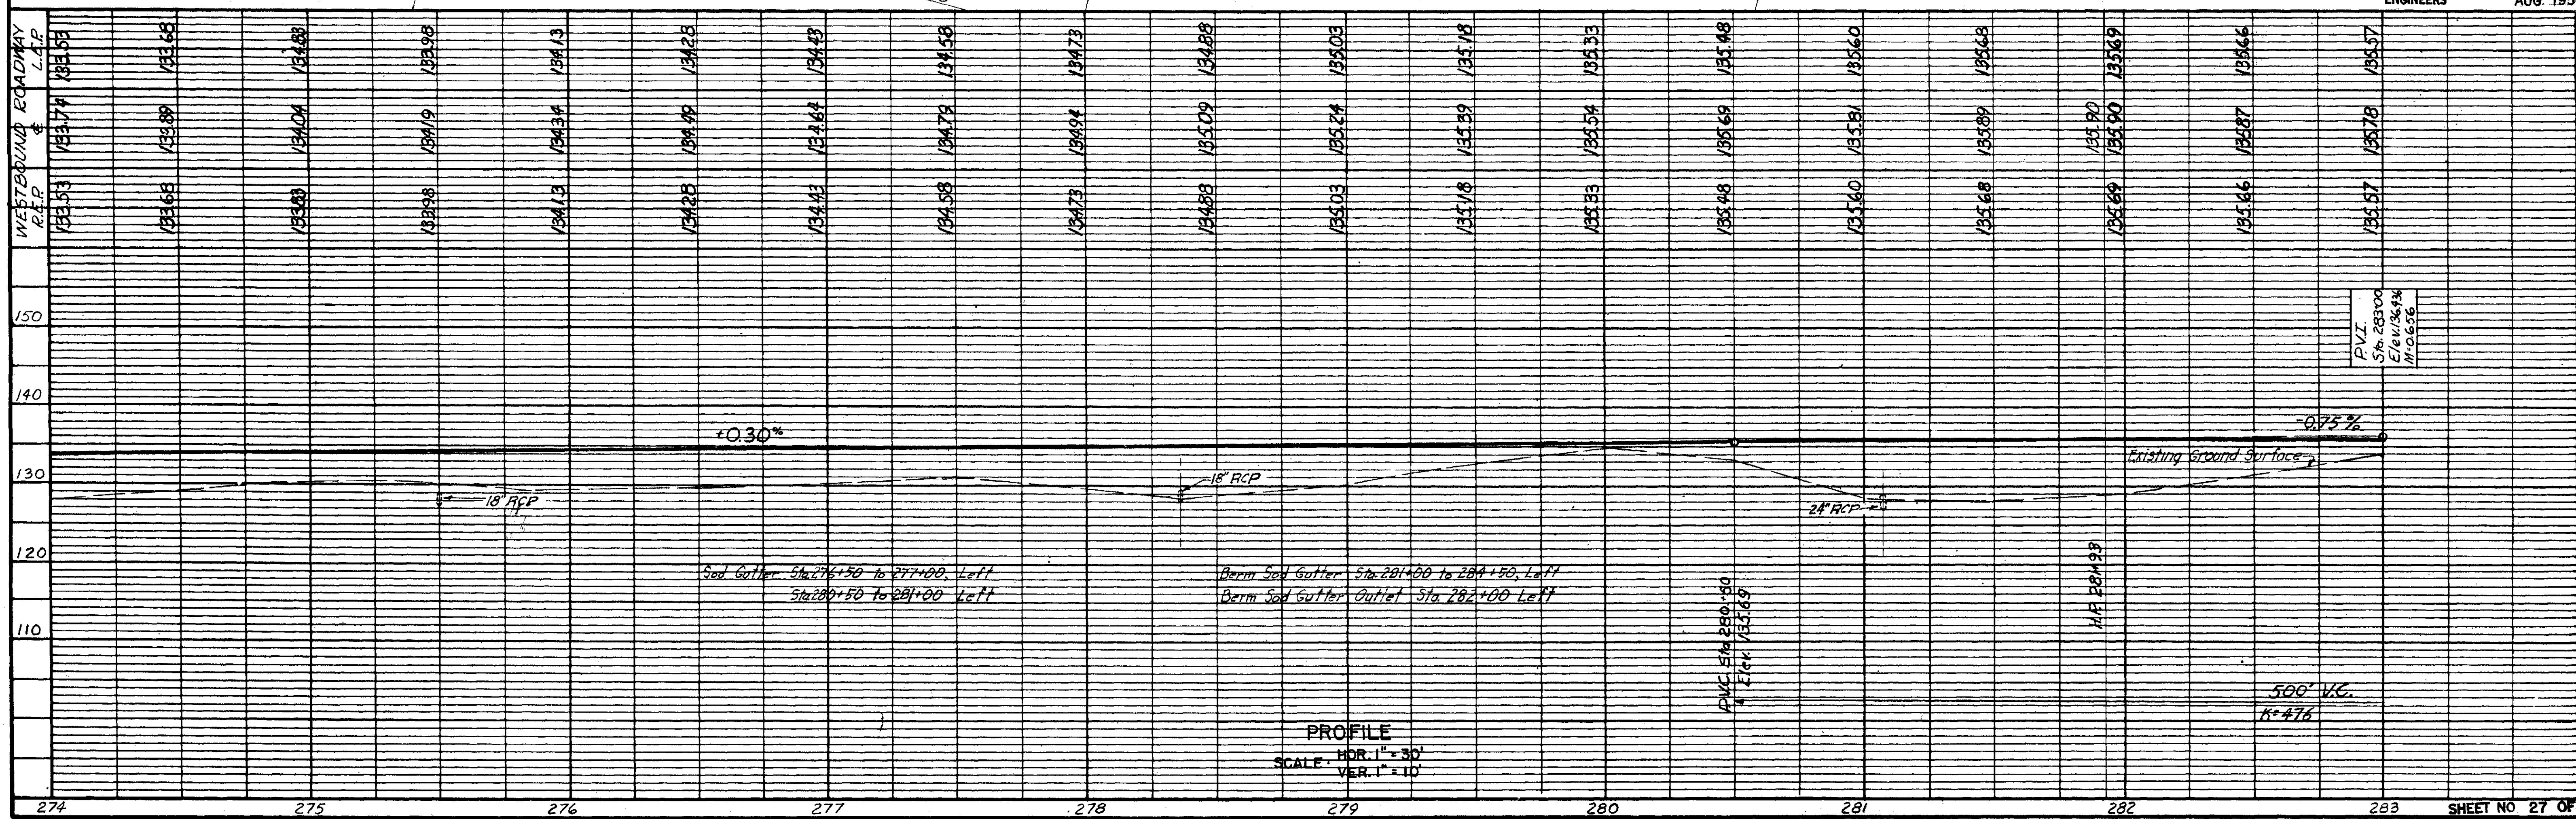


Qm-12
38
DES. H.H.J.
DR. H.F.
TR. H.F.
CHK. C.H.F.
APPD. H.H.J.

P. R. A.	STATE	FED. AID	SHEET	TOTAL
NO.	NO.	NO.	NO.	SHEETS
1	MAINE	IN-011 (5)	27	240

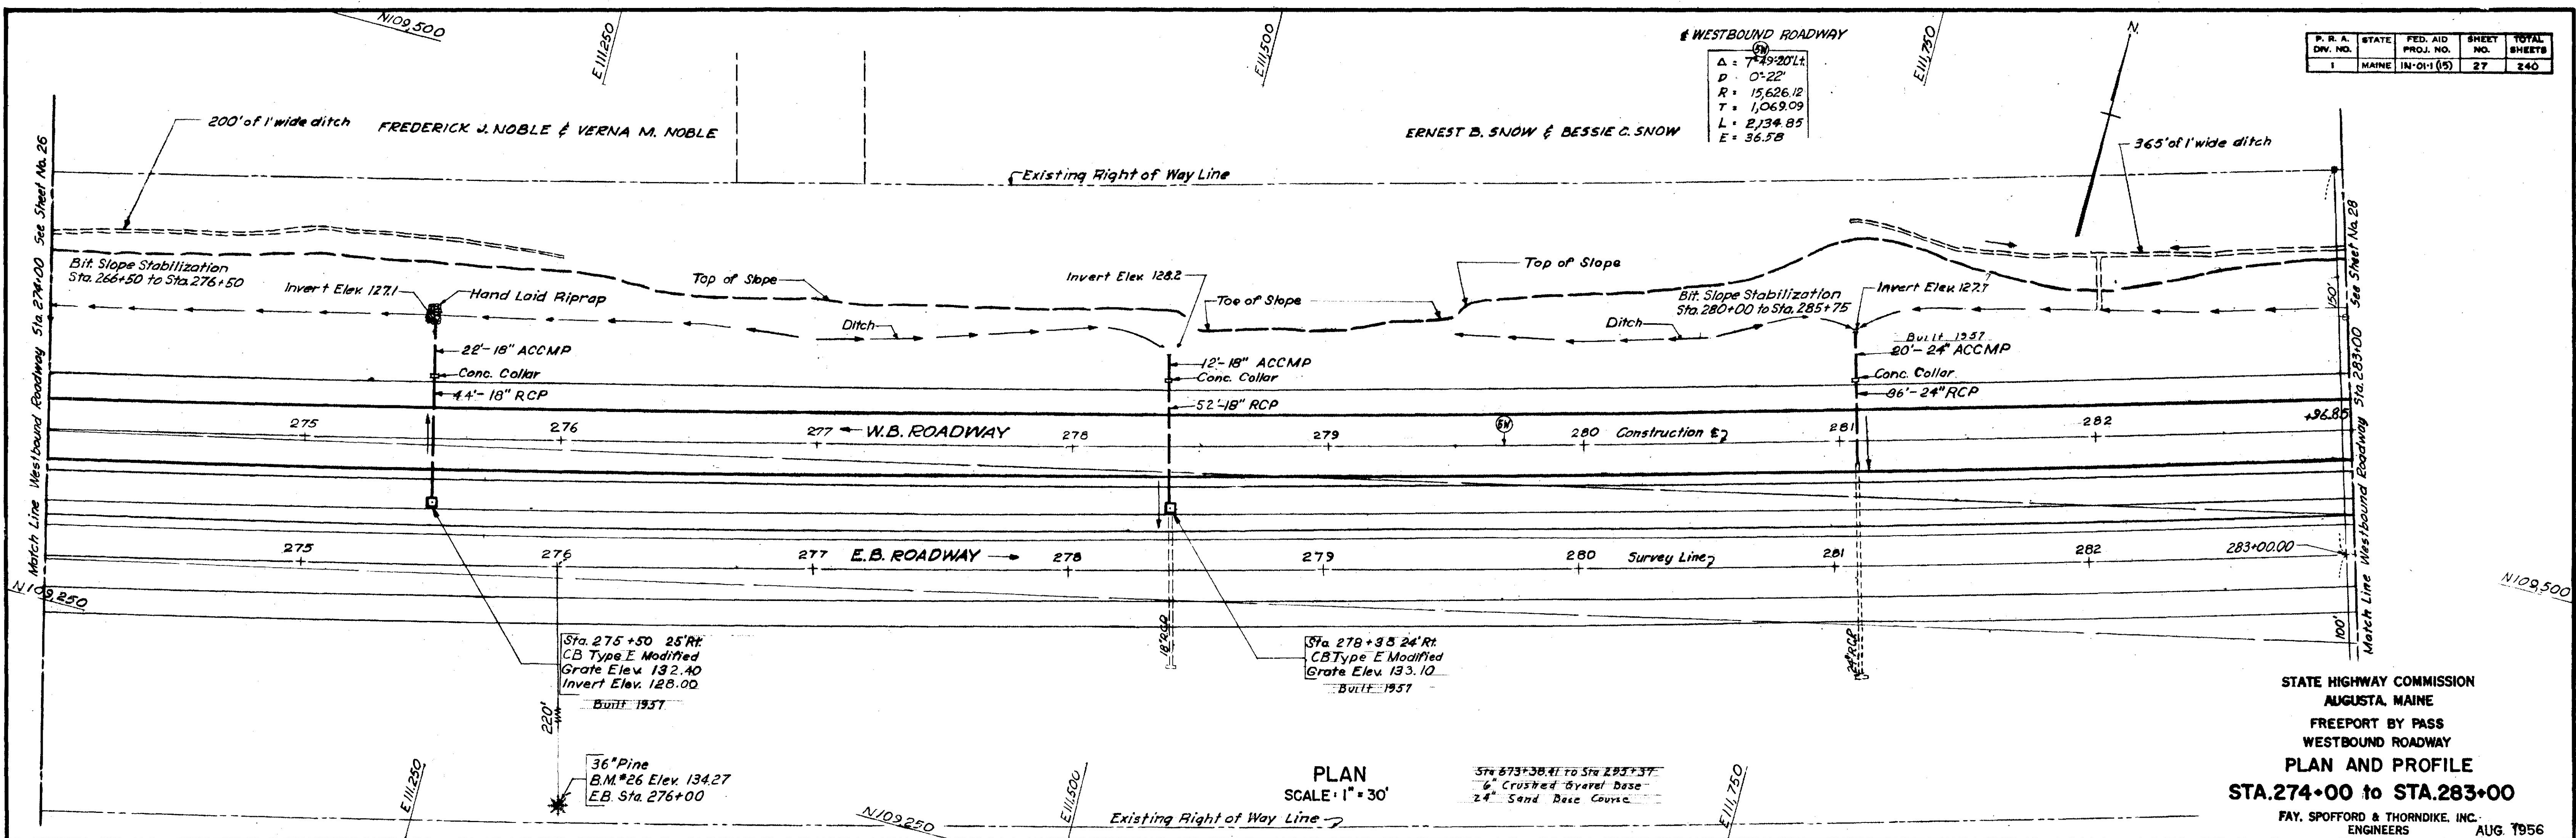


PLAN
SCALE: 1" = 30'

STATE HIGHWAY COMMISSION
AUGUSTA, MAINE
FREEPORT BY PASS
WESTBOUND ROADWAY
PLAN AND PROFILE
STA. 274+00 to STA. 283+00
FAY, SPOFFORD & THORNDIKE, INC.
ENGINEERS
AUG. 1956

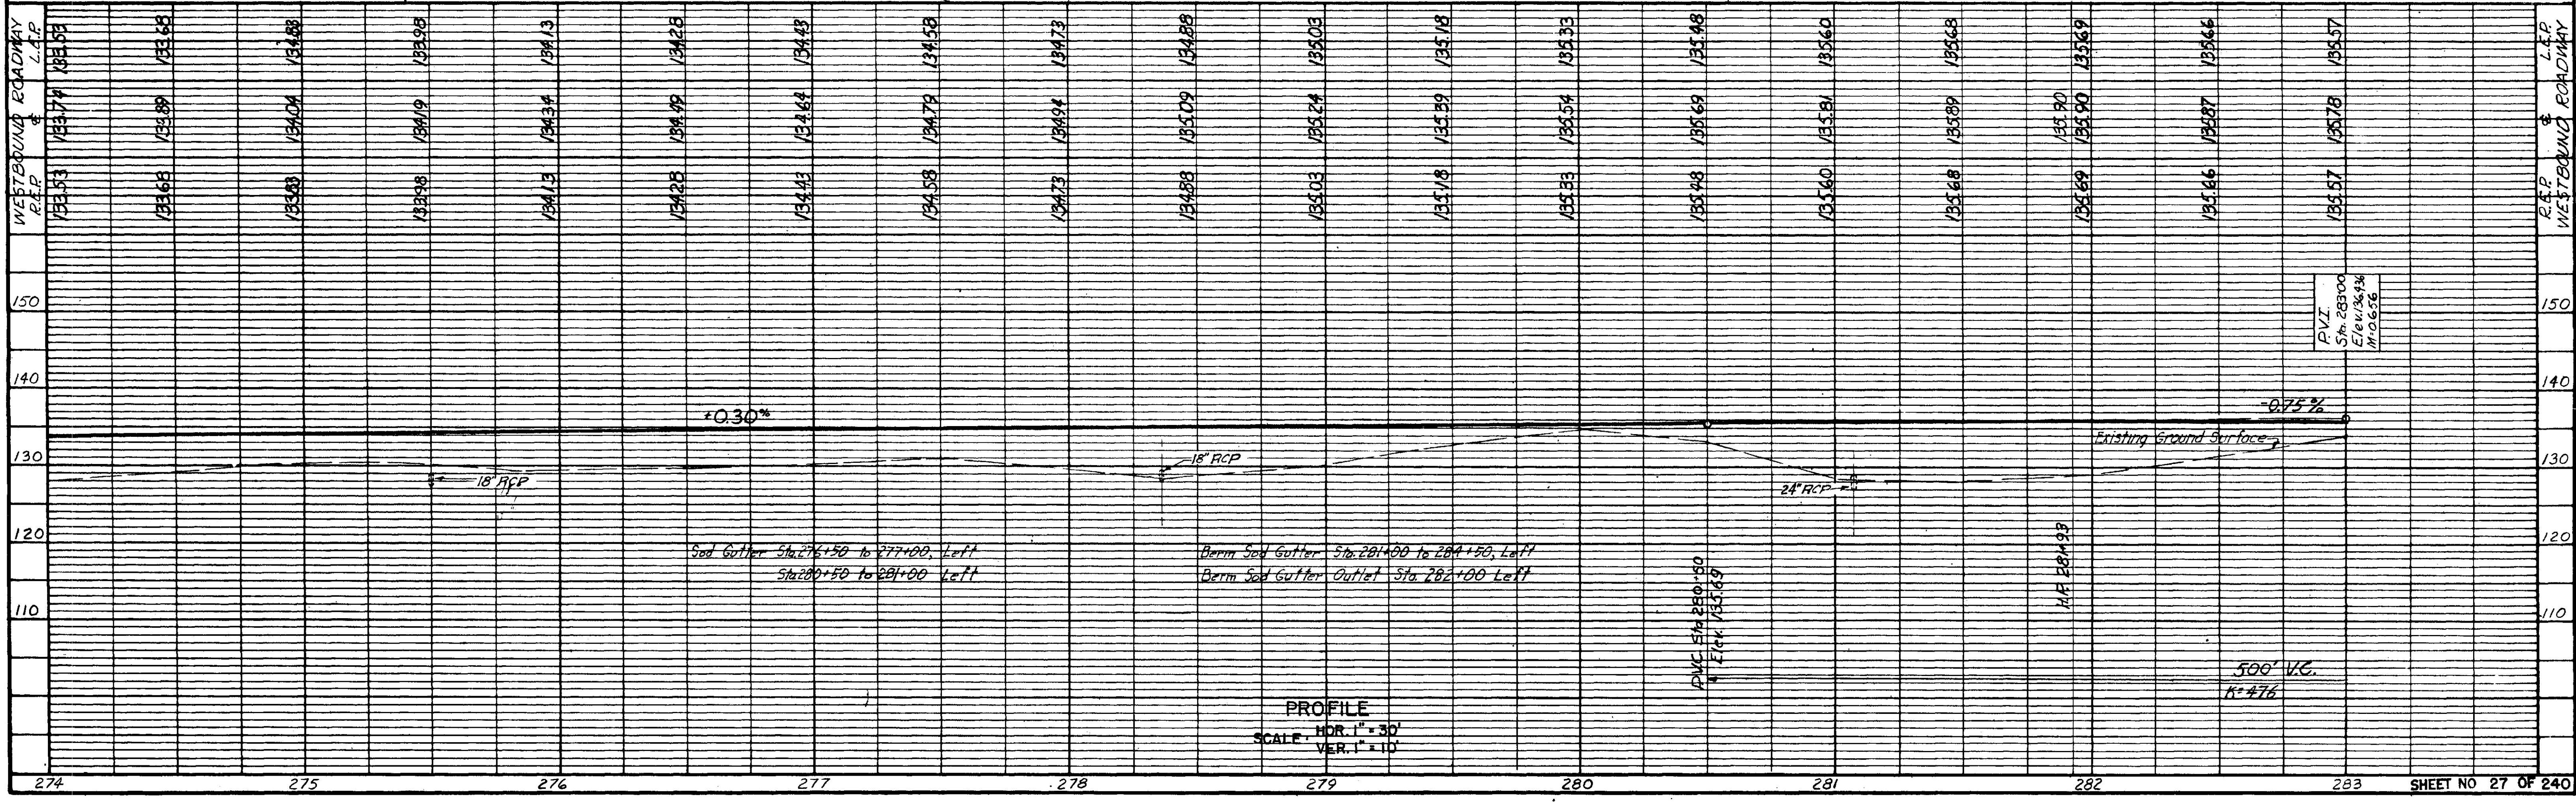


PROFILE
SCALE: HOR. 1" = 30'
VER. 1" = 10'

Qm-12
38
DW: H.H.J.
EN: H.F.
TR: H.F.
CHK: C.H.F.
BY: J.W.

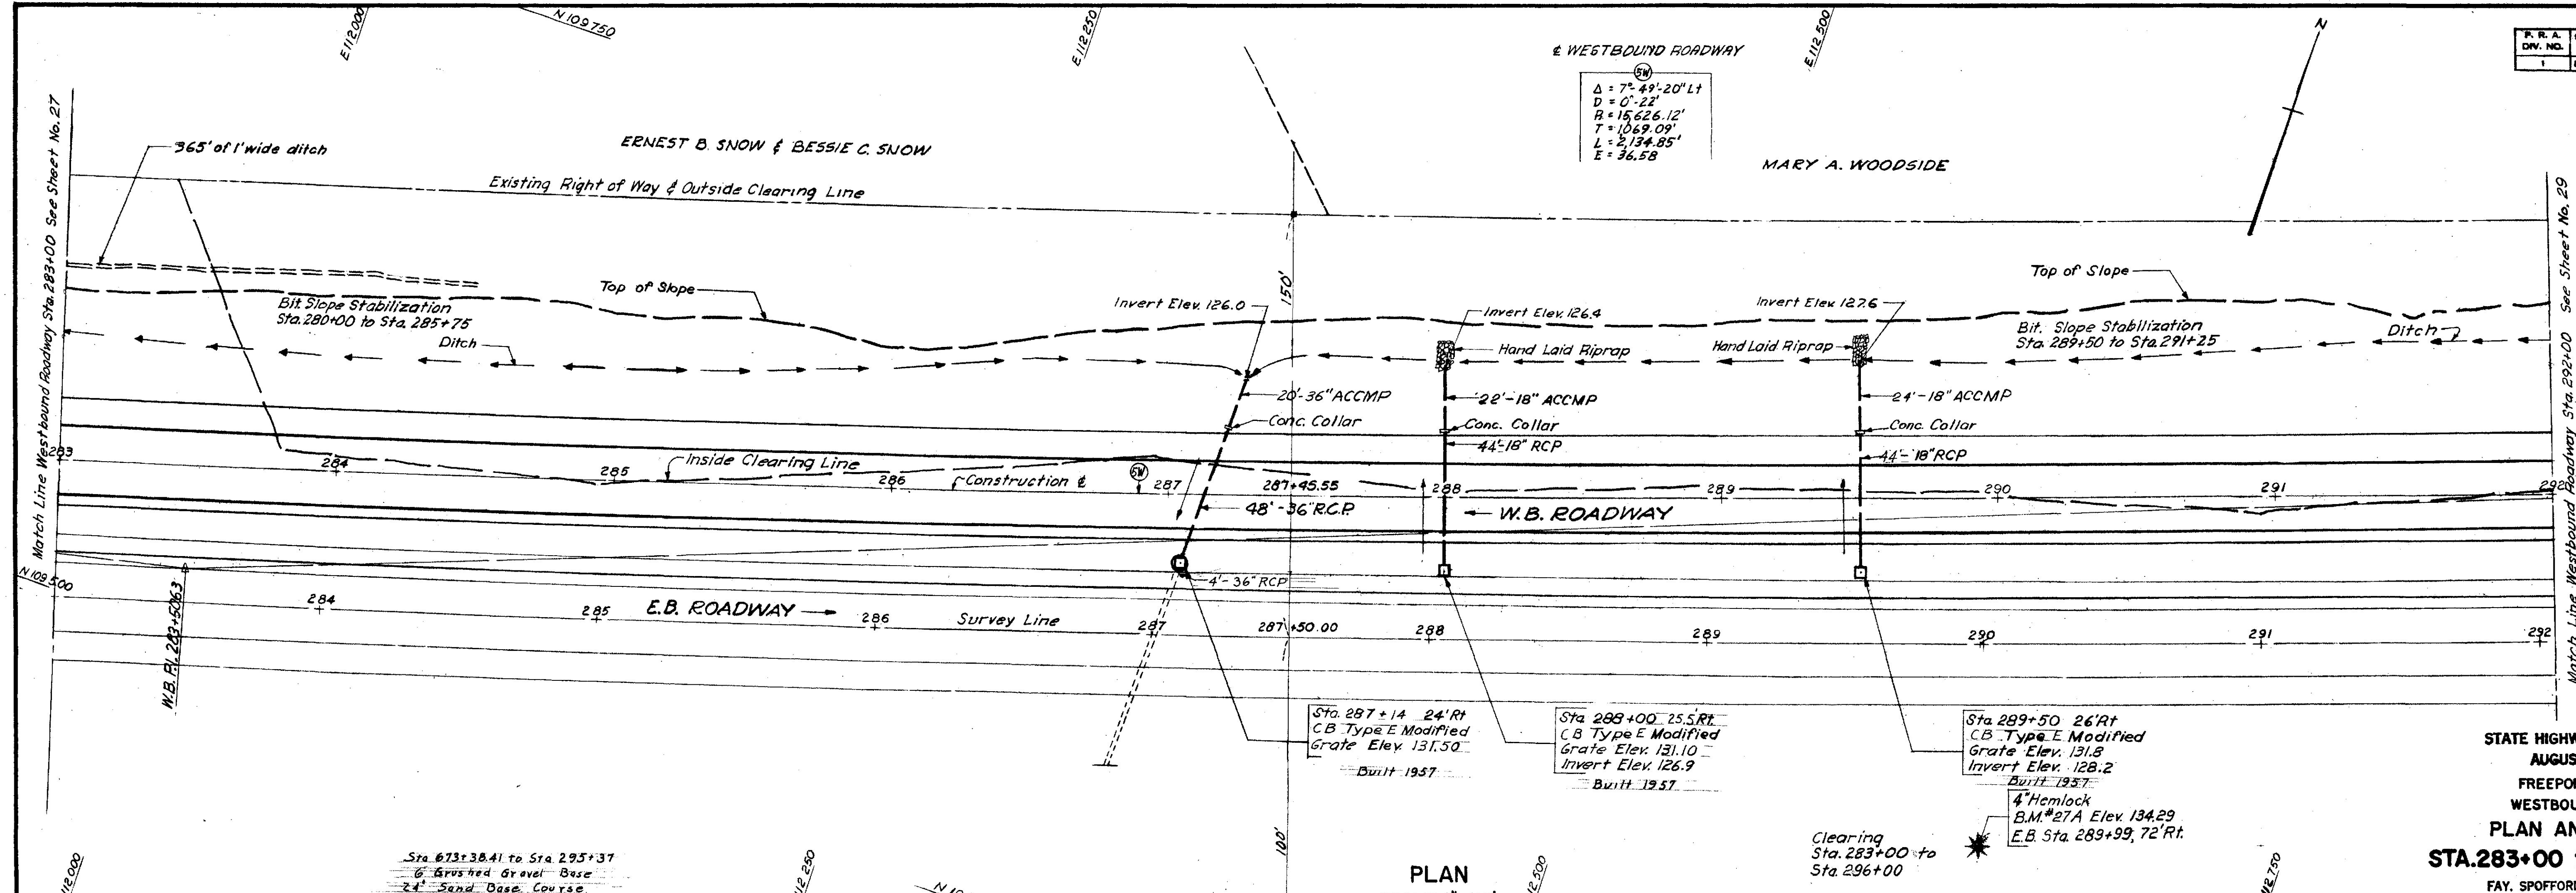

STATE HIGHWAY COMMISSION
AUGUSTA, MAINE
FREEPORT BY PASS
WESTBOUND ROADWAY
PLAN AND PROFILE
STA. 283+00 to STA. 292+00
FAY, SPOFFORD & THORNDIKE, INC.
ENGINEERS
AUG.

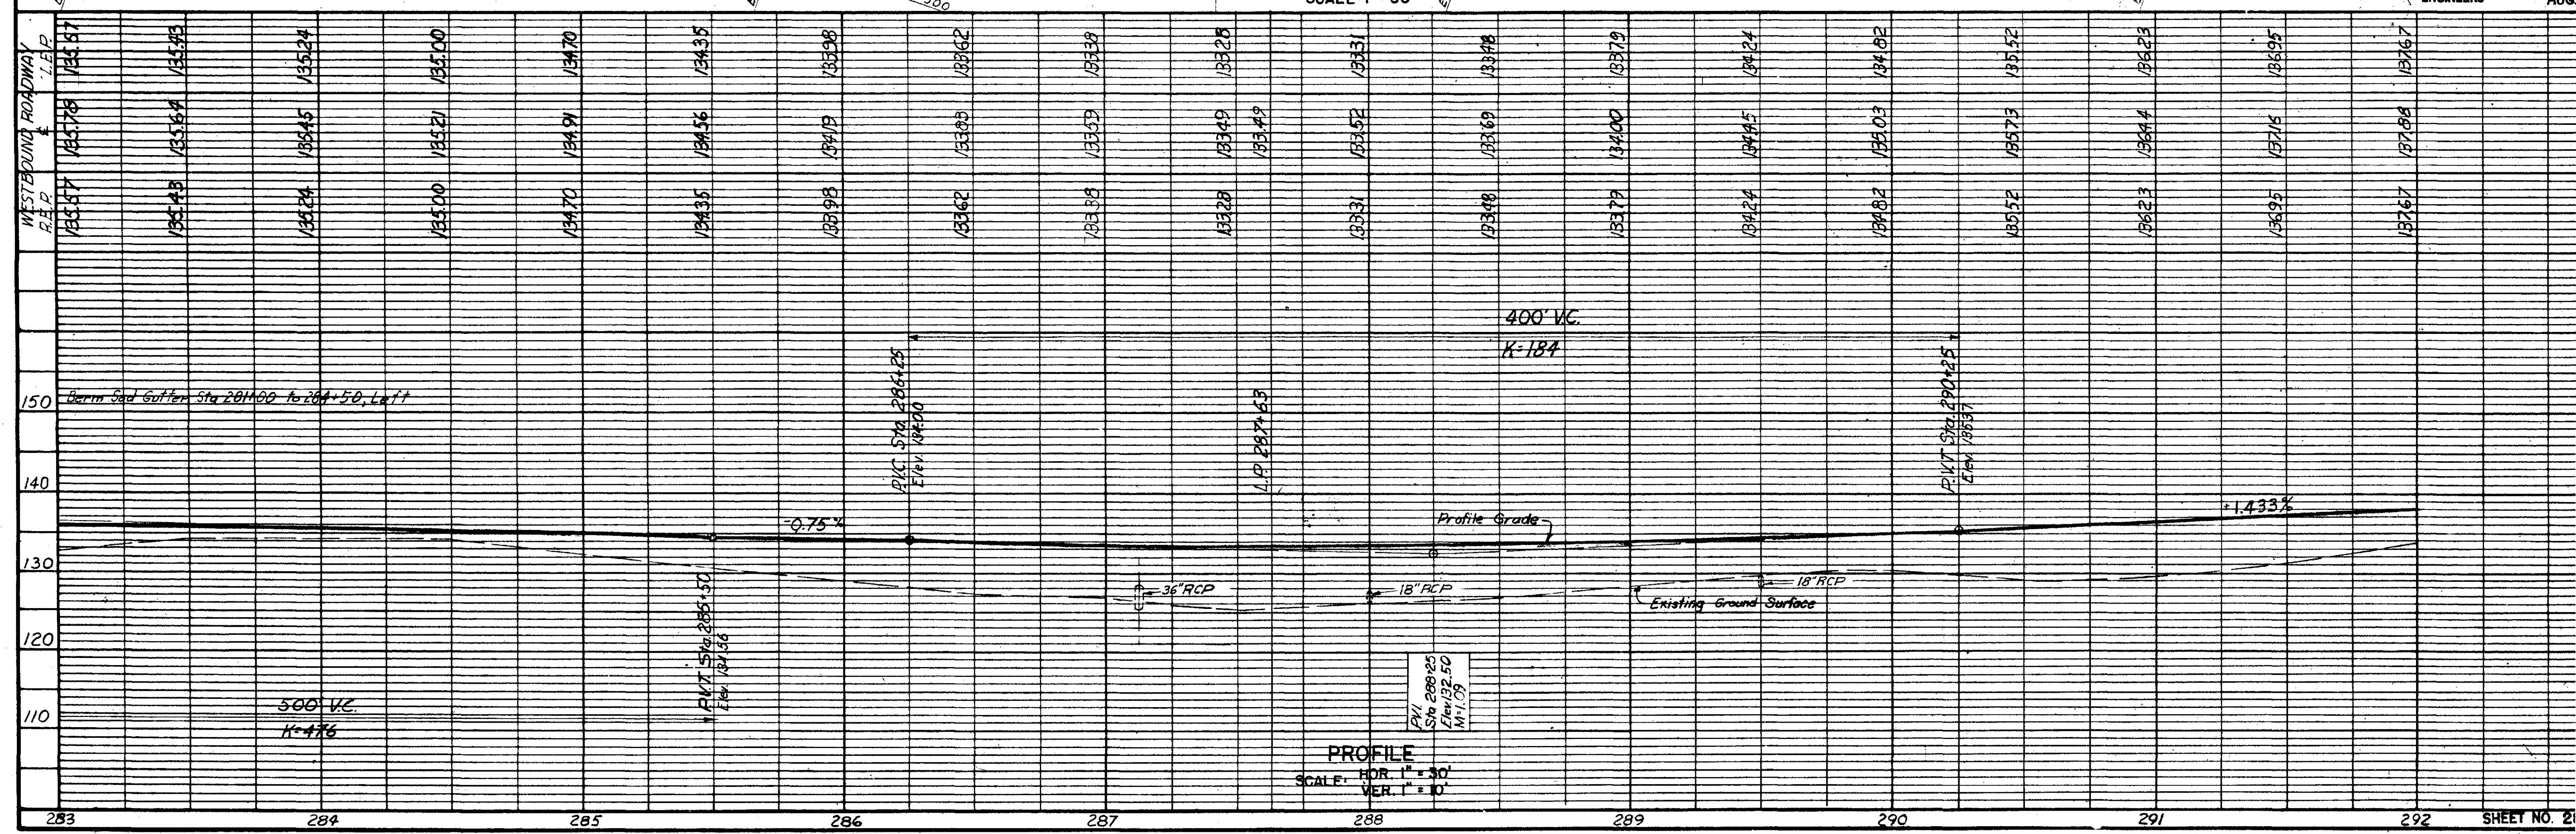

Qm-12
39

DES.	H.H.W.
DR.	L.P.
IN.	L.P.
CHK.	C.H.F.
APP.	H.J.W.