
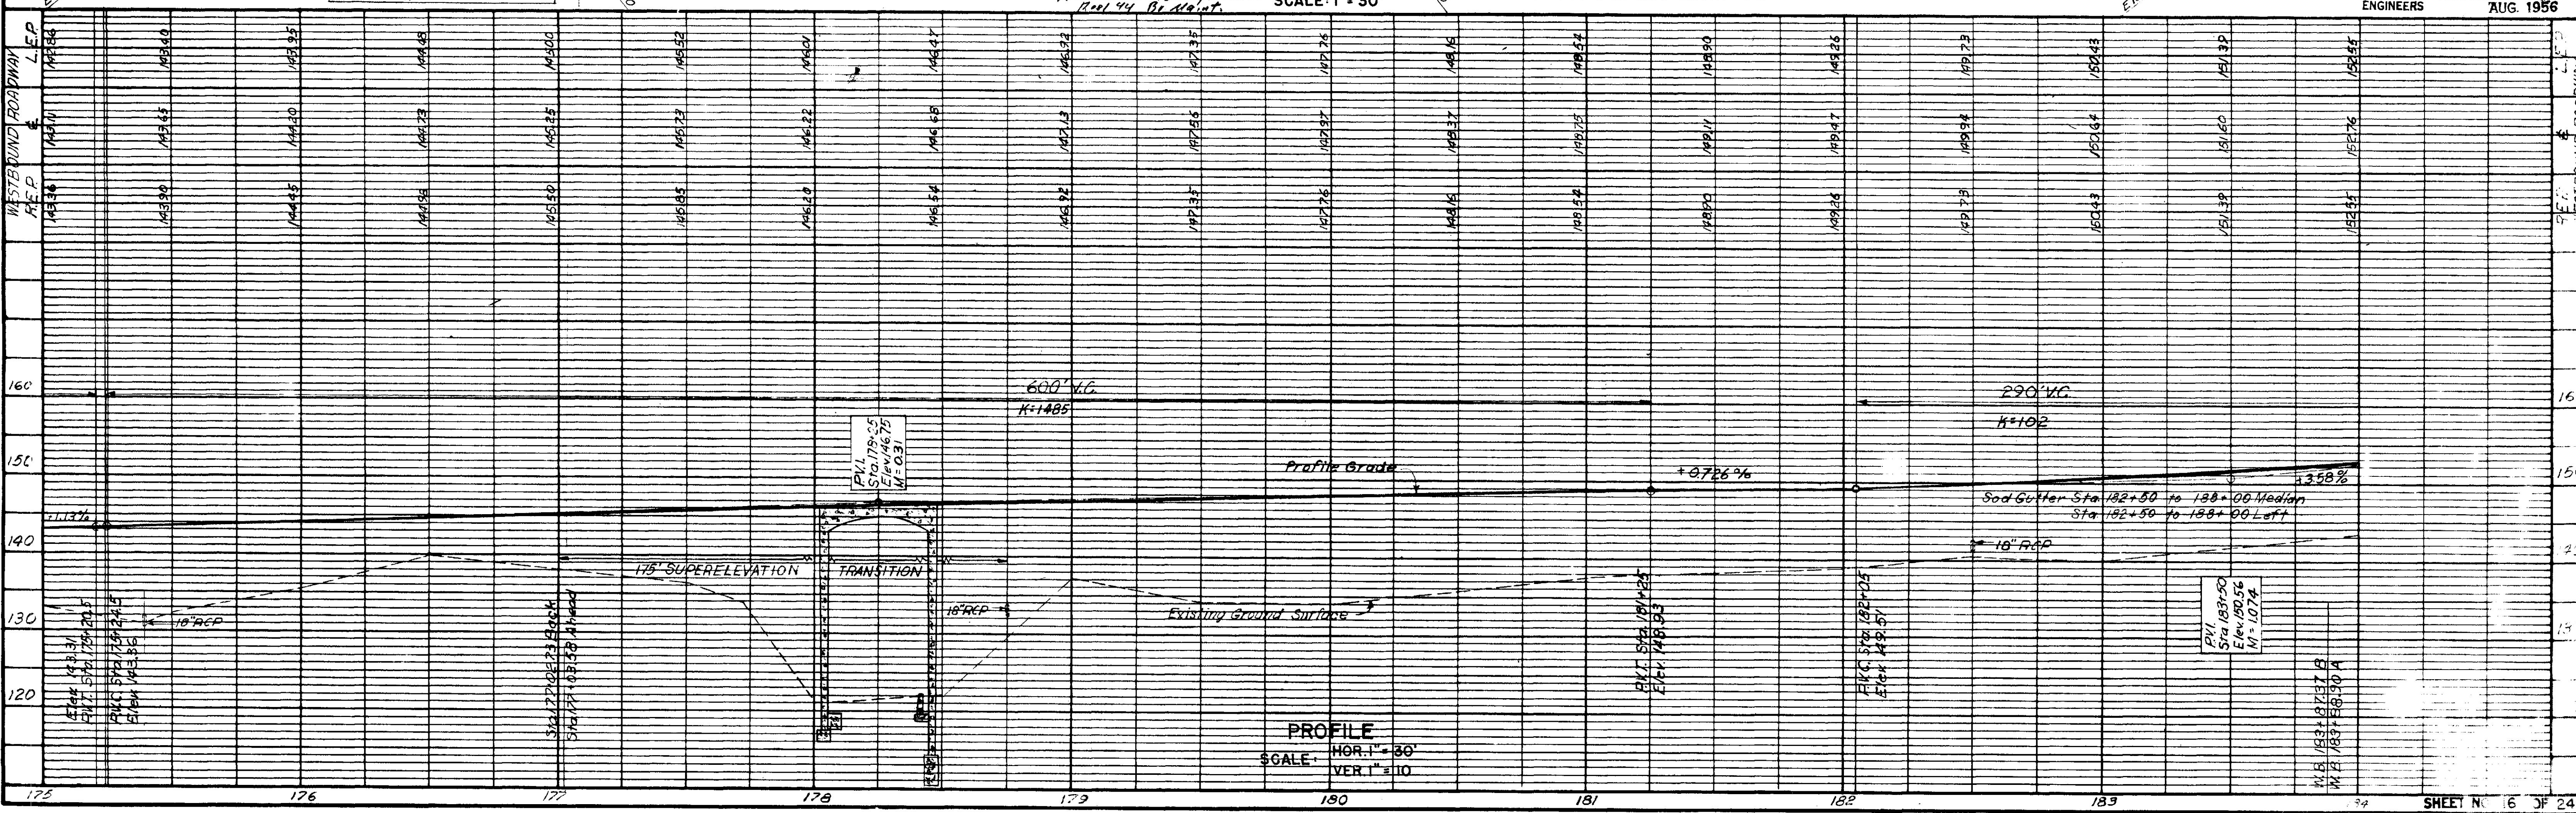


Qm-12
26

DES.	H.H.V.
DR.	R.B.
IR.	R.B.
CHK.	C.H.F.
APPD.	H.U.W.


DD16

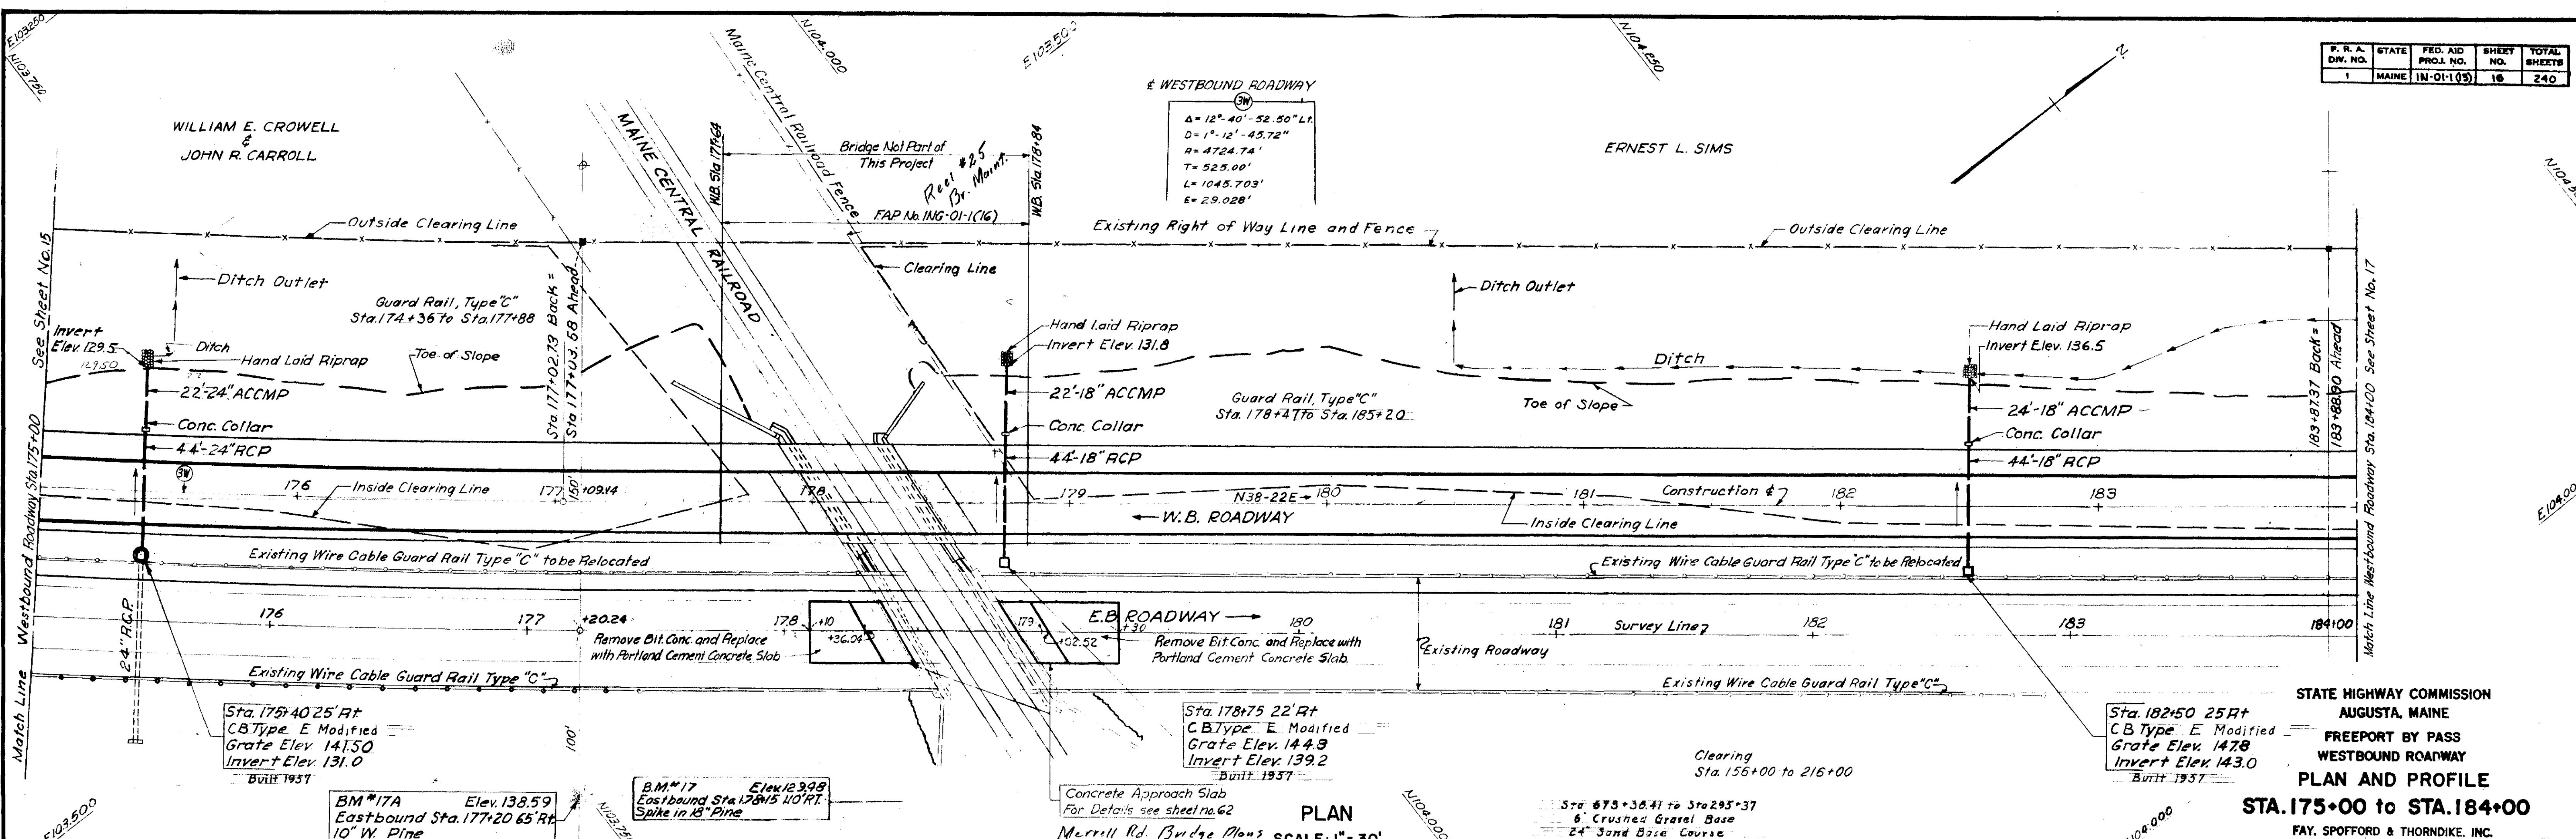


27

DES.	H.M.J.
TR.	L.V.
CHK.	C.H.F.
APP.	H.J.W.

R. R. A. DIV. NO.	STATE	FED. AID PROJ. NO.	SHEET NO.	TOTAL SHEETS
1	MAINE	IN-01-1(15)	17	240

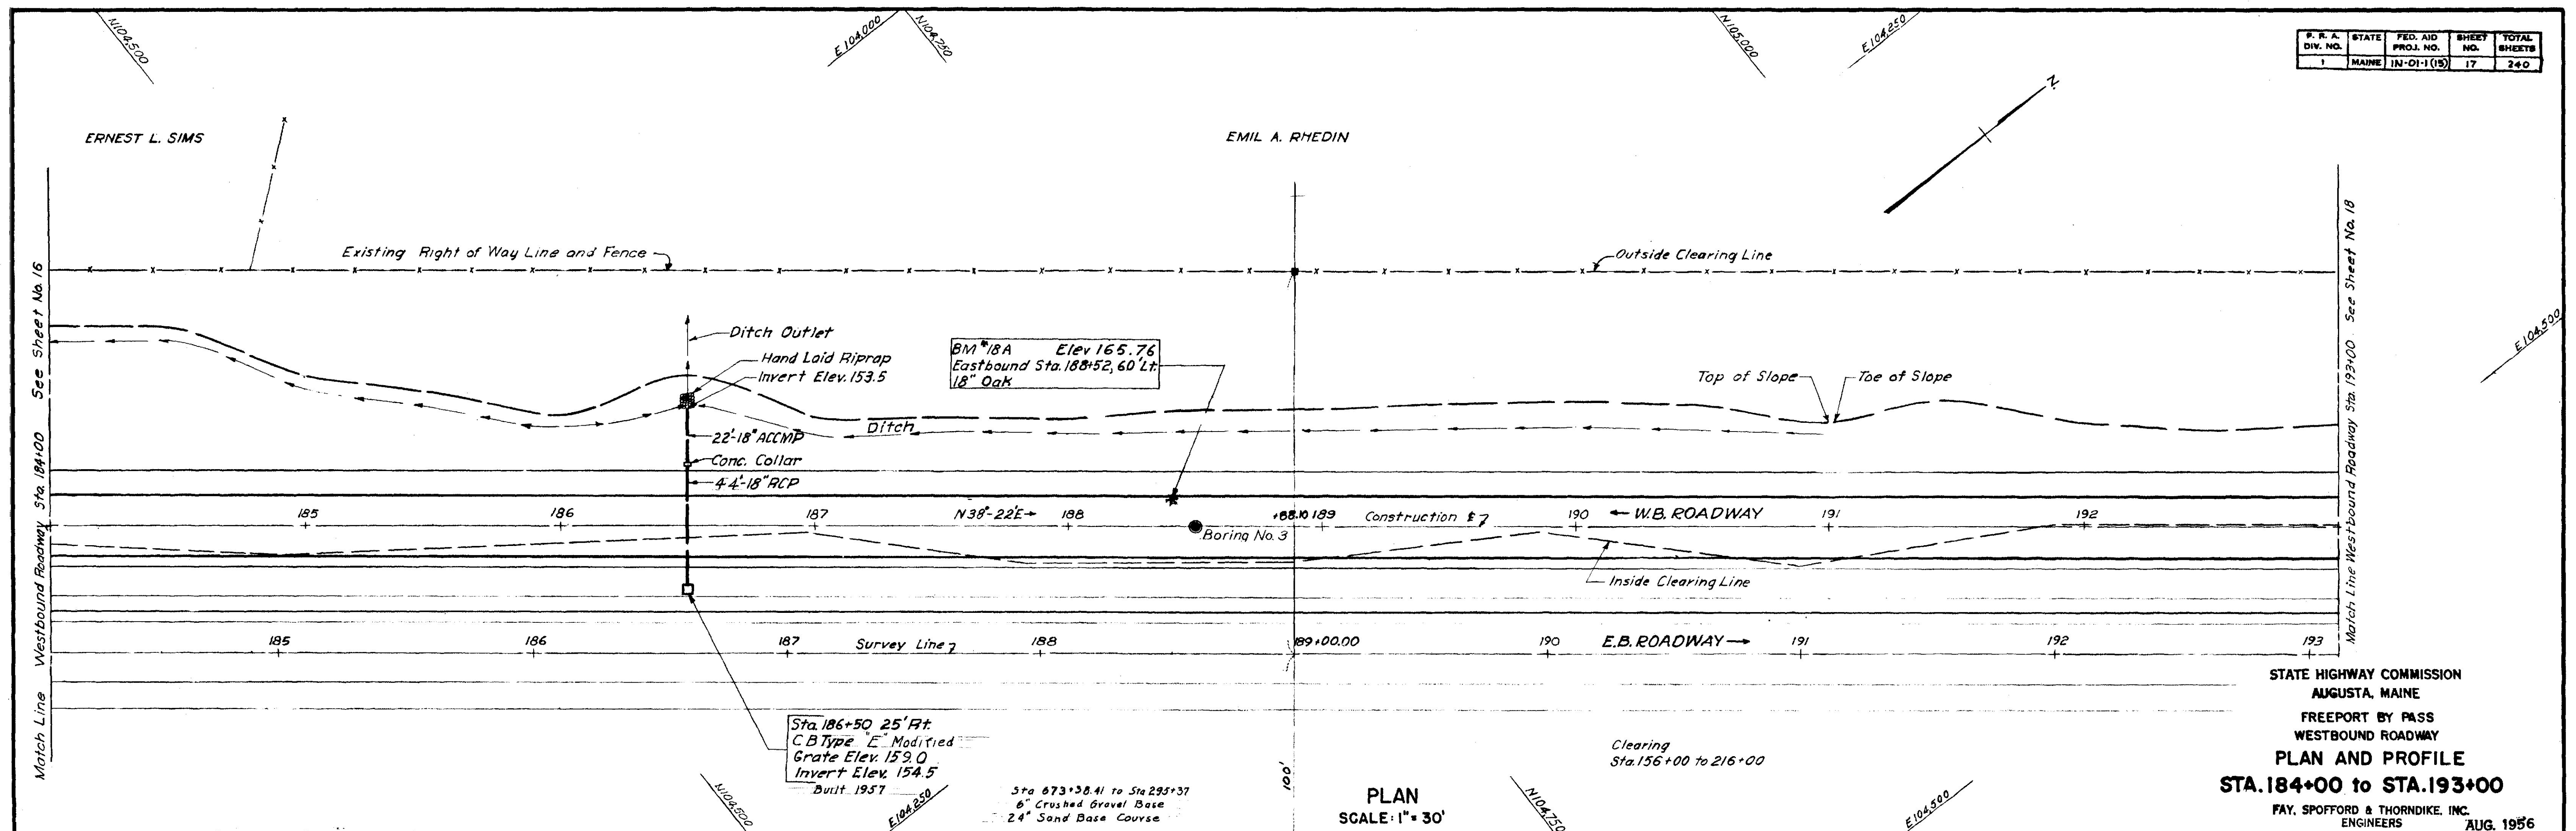


STATE HIGHWAY COMMISSION
AUGUSTA, MAINE
FREEPORT BY PASS
WESTBOUND ROADWAY
PLAN AND PROFILE
STA. 184+00 to STA. 193+00
PAY, SPOFFORD & THORNDIKE, INC.
ENGINEERS
AUG. 1956

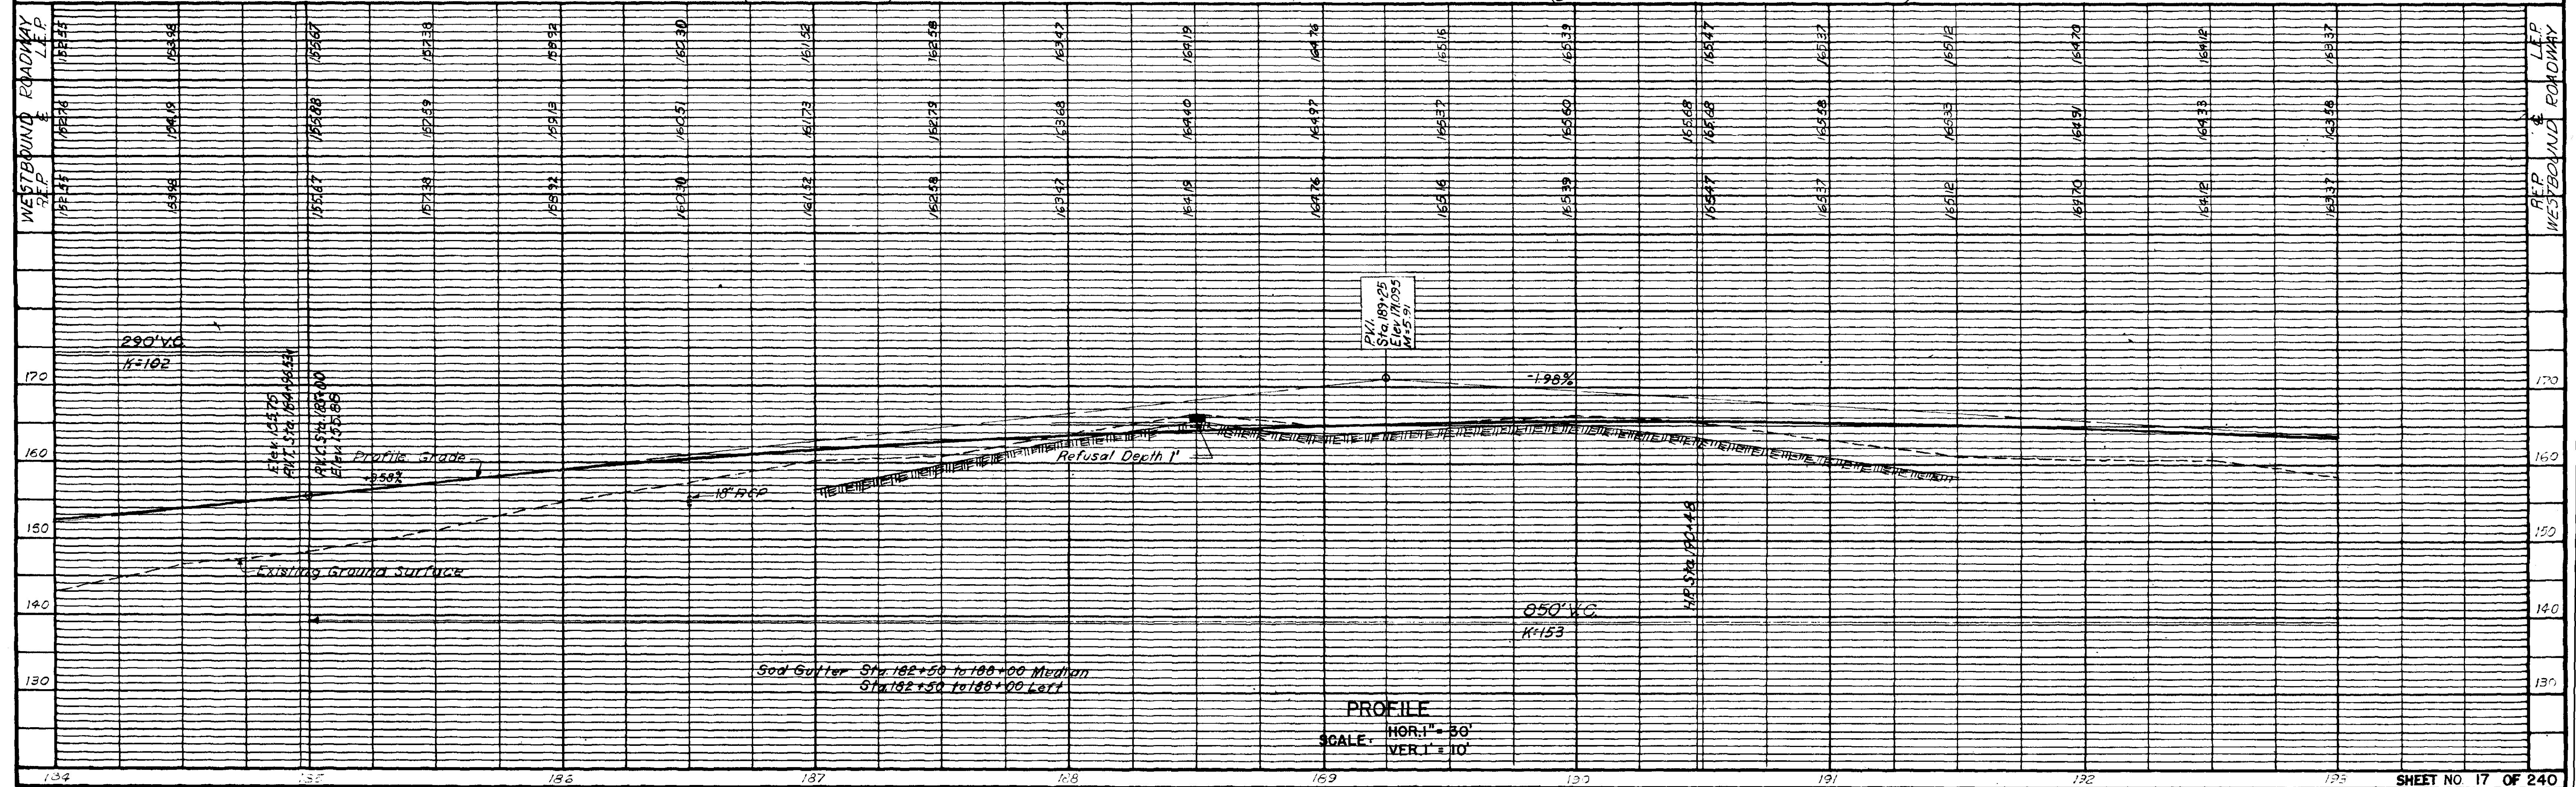

Qm-2
28


DES.	H.H.J.
CHK.	R.J.C.
APP.	H.J.W.

STATE	FED. AID	SHEET	TOTAL

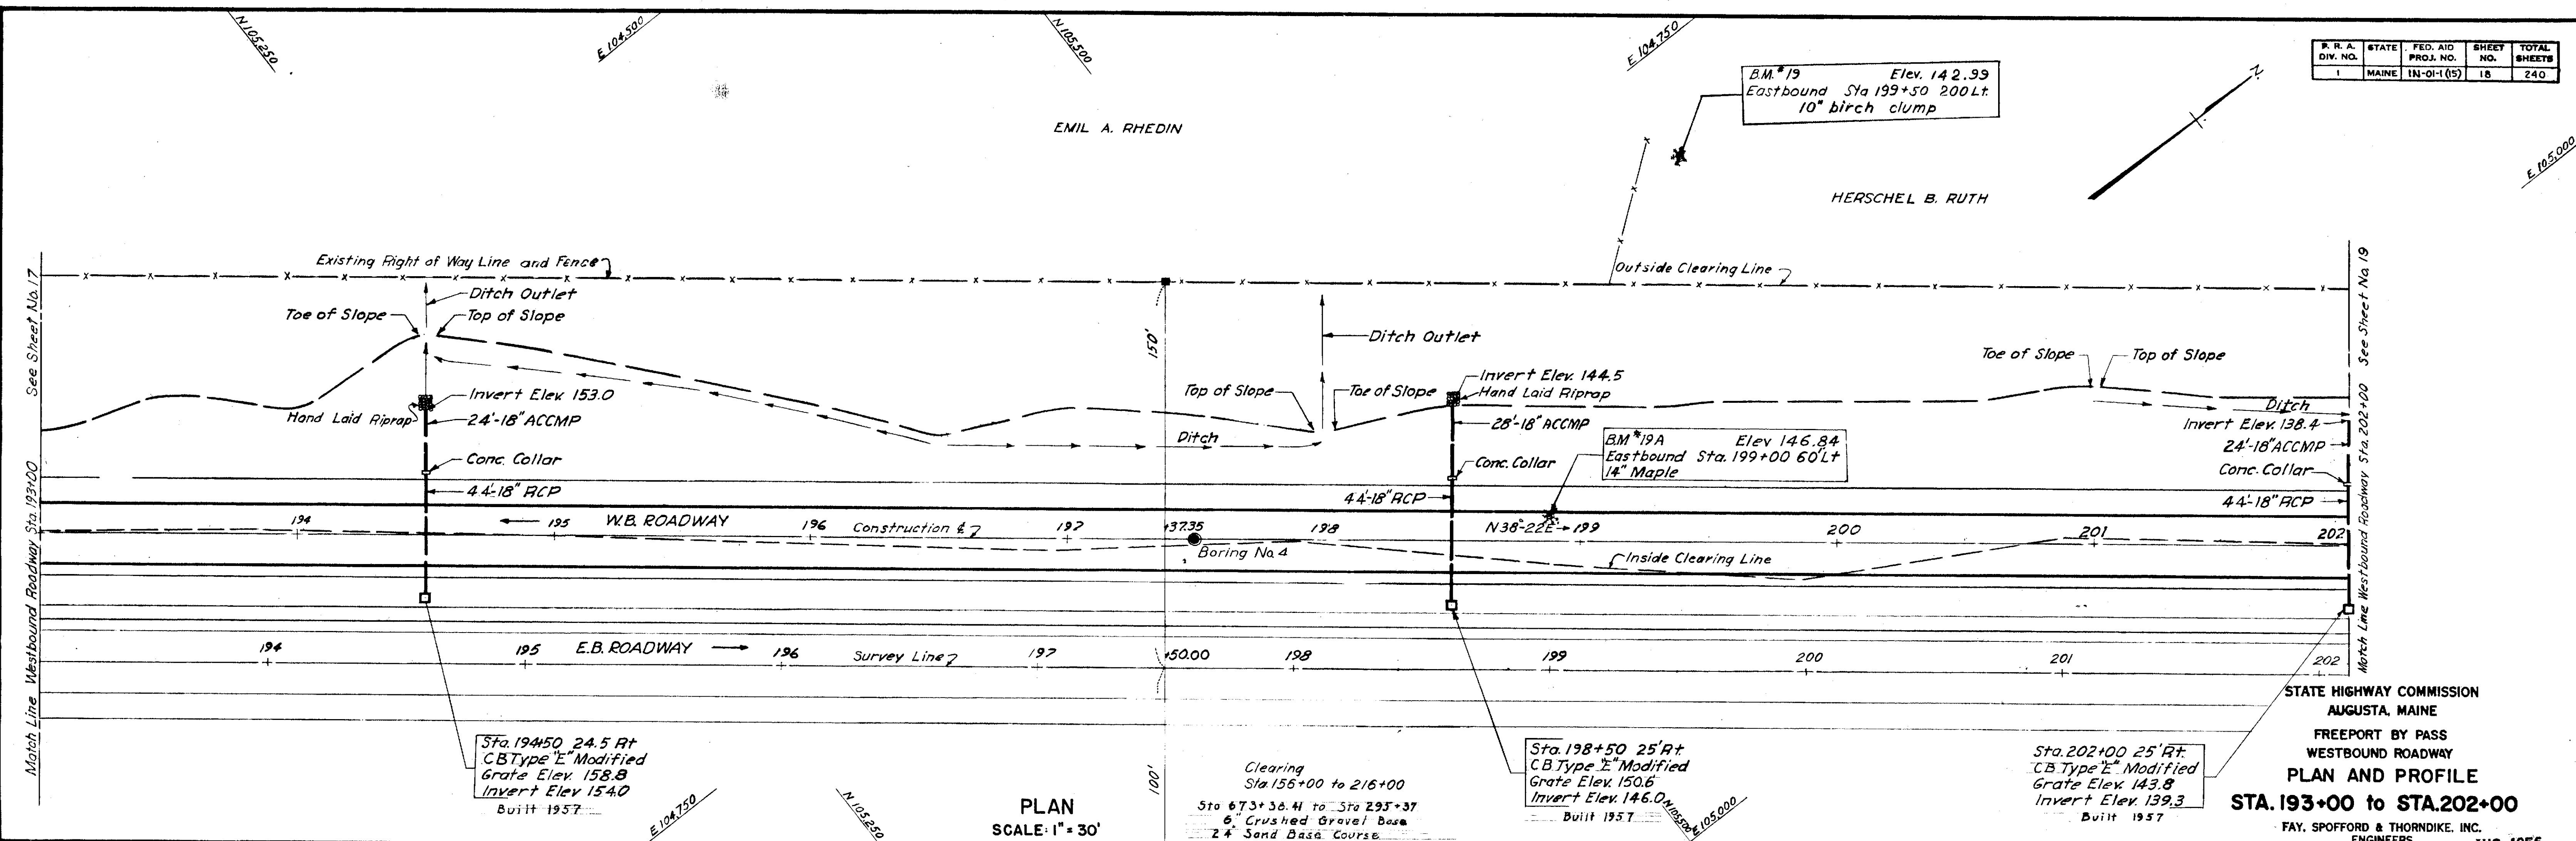

PLAN
SCALE: 1" = 30'

STATE HIGHWAY COMMISSION
AUGUSTA, MAINE
FREEPORT BY PASS
WESTBOUND ROADWAY
PLAN AND PROFILE
STA. 193+00 to STA. 202+00
FAY, SPOFFORD & THORNDIKE, INC.
ENGINEERS
AUG. 1956

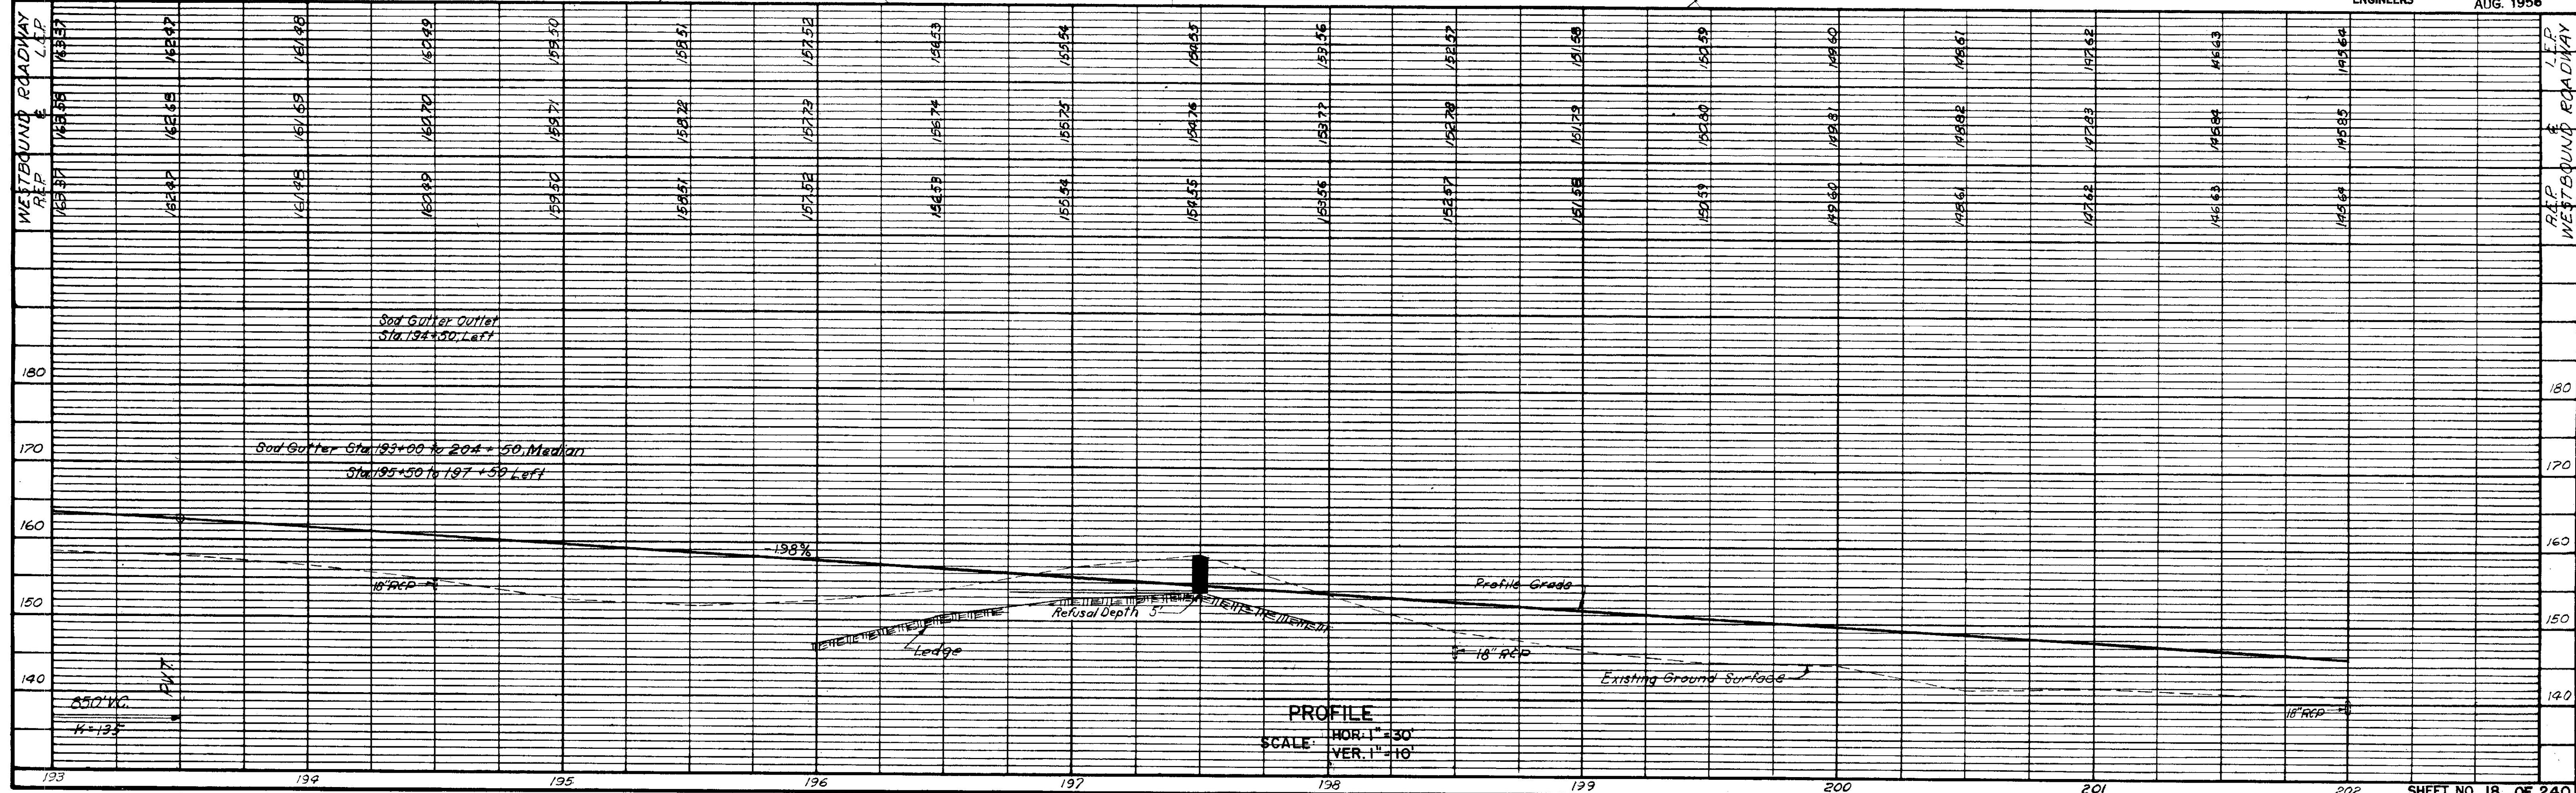


PROFILE
SCALE: HOR. 1" = 30'
VER. 1" = 10'

Qm-12
29

DES.	H.H.J.
SA.	R.V.C.
IB.	R.V.C.
CHK.	C.H.F.
APP.	H.J.W.

S. R. A. DIV. NO.	STATE	FED. AID PROJ. NO.	SHEET NO.	TOTAL SHEETS
1	MAINE	IN-01-1 (15)	19	240


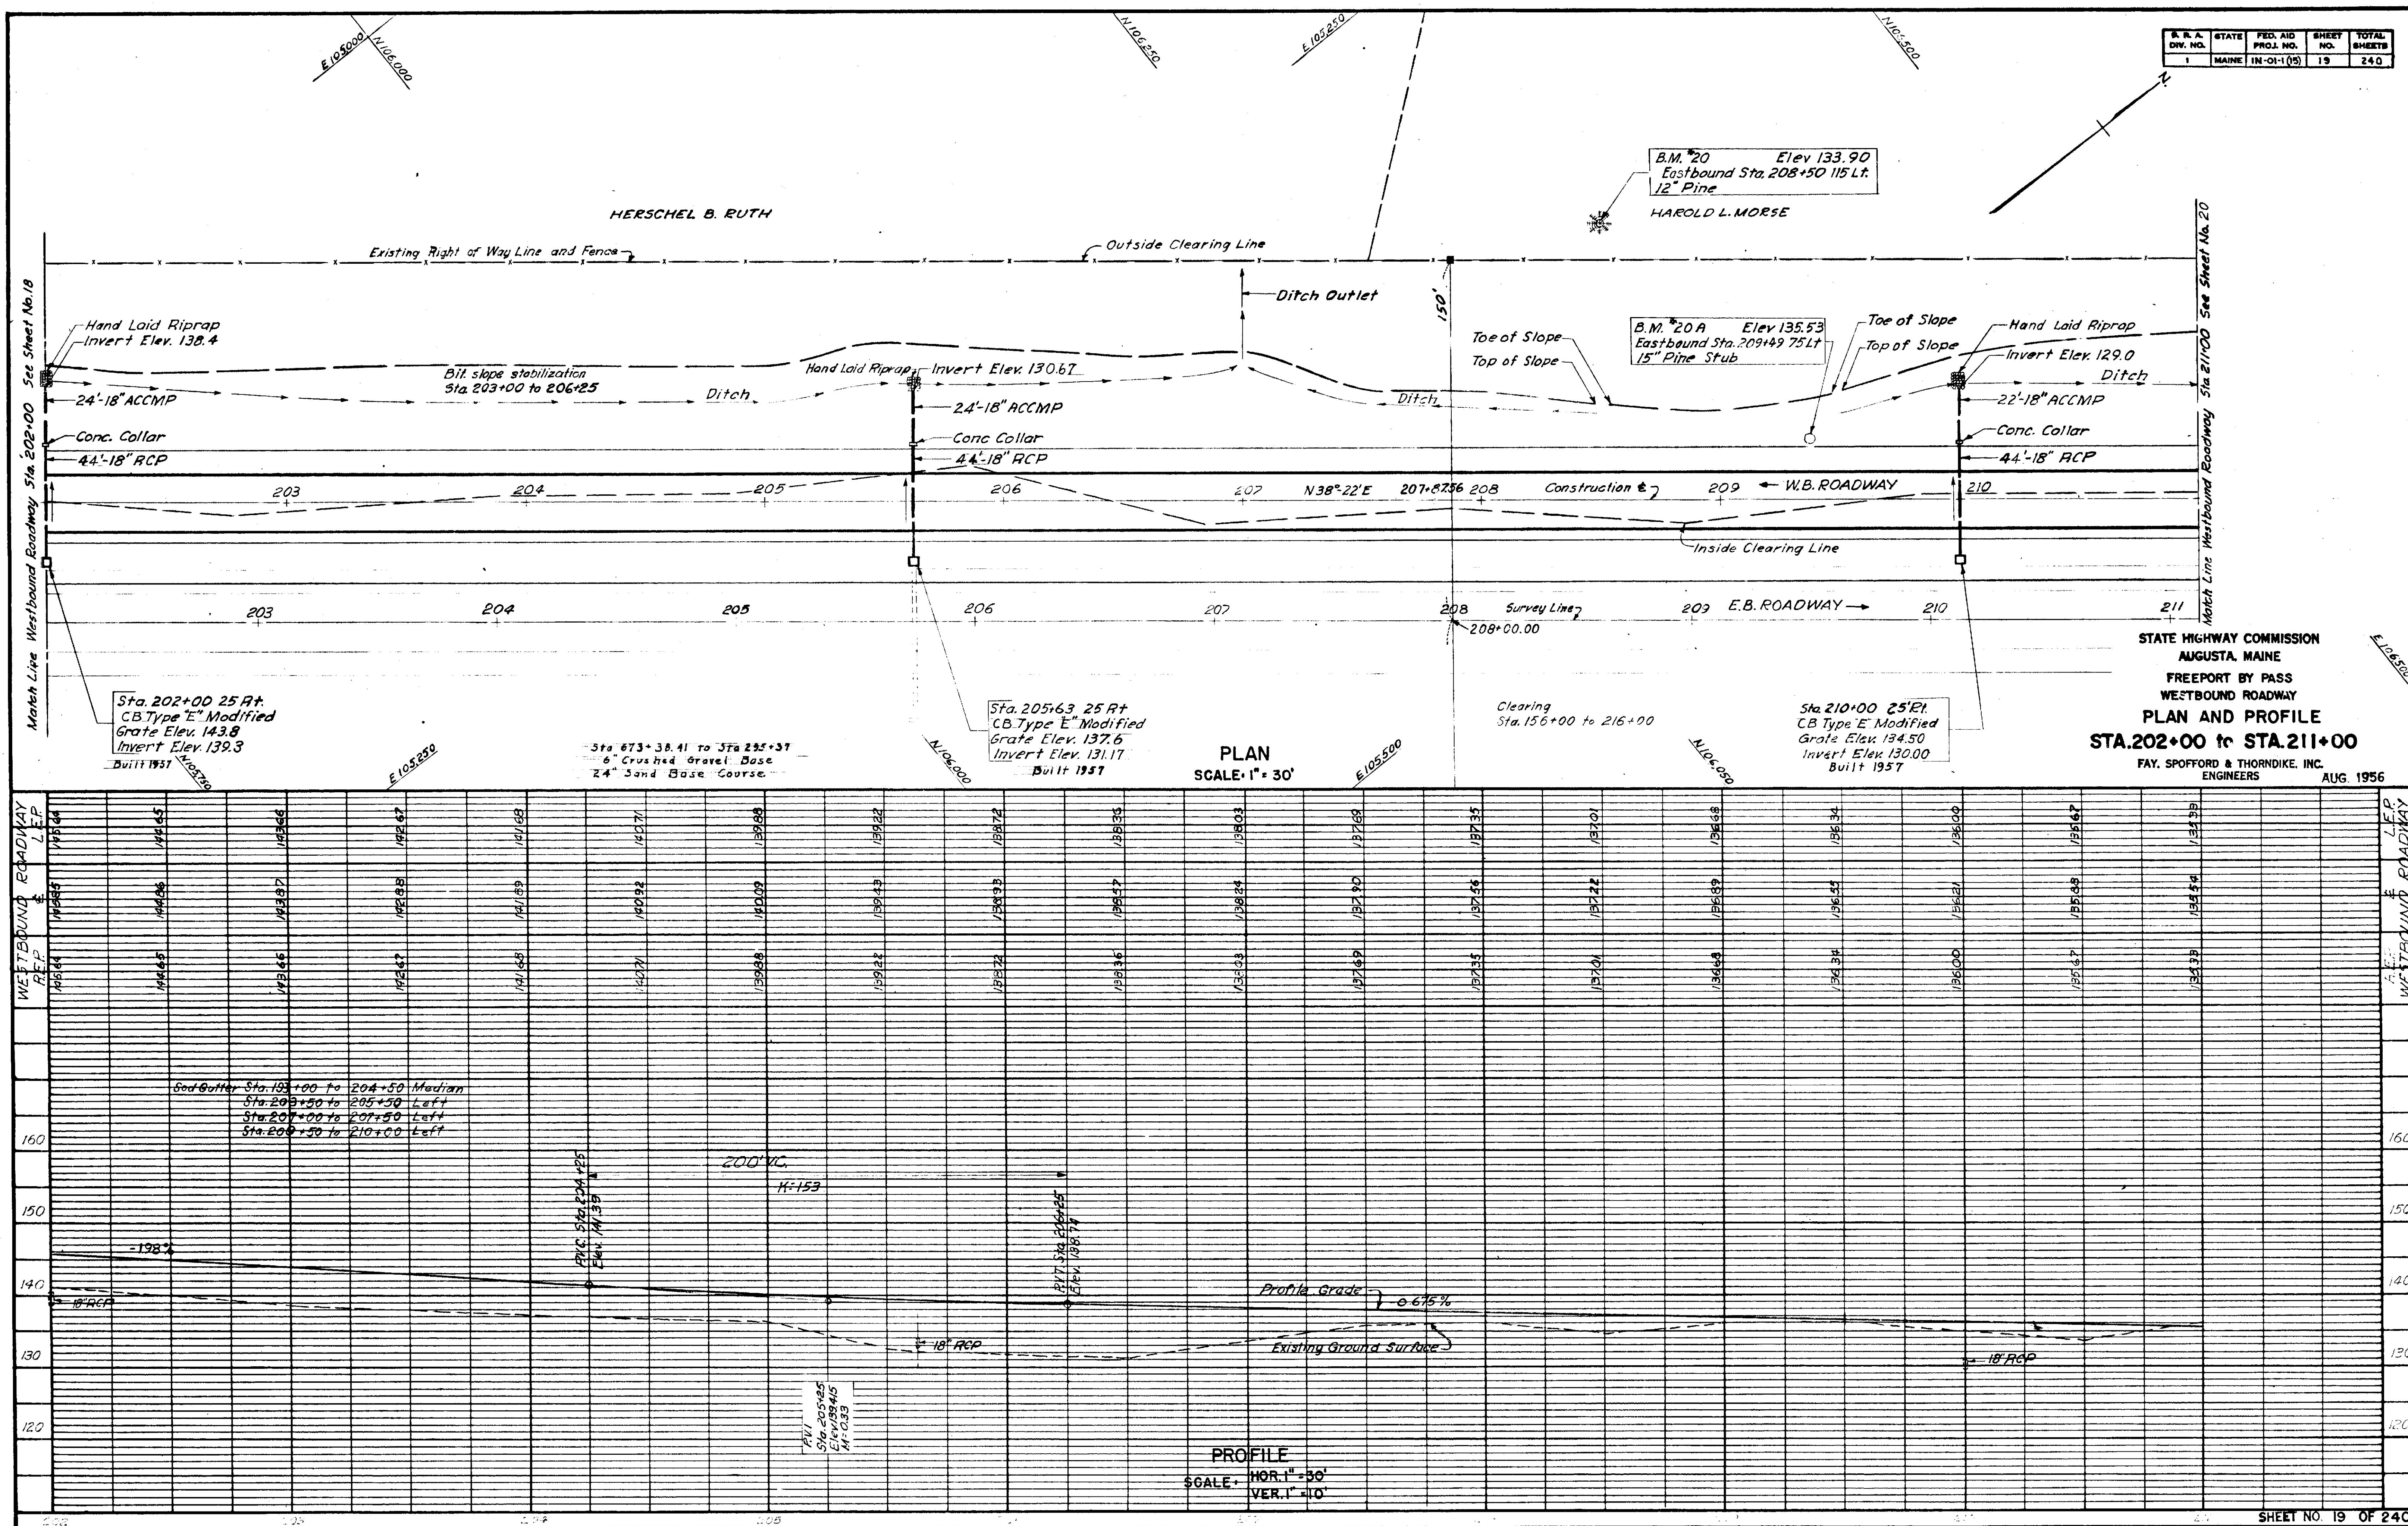


STATE HIGHWAY COMMISSION
AUGUSTA, MAINE
FREEPORT BY PASS
WESTBOUND
PLAN AND PROFILE
STA.202+00 to STA.211+00
FAY, SPOFFORD & THORNDIKE, INC.
ENGINEERS
AUG. 1956



AUG. 1956

SHEET NO. 19 OF 240

STATE	FED. AID	PROJ. NO.	SHEET NO.	TOTAL SHEETS
MAINE	IN-01 (15)		20	240

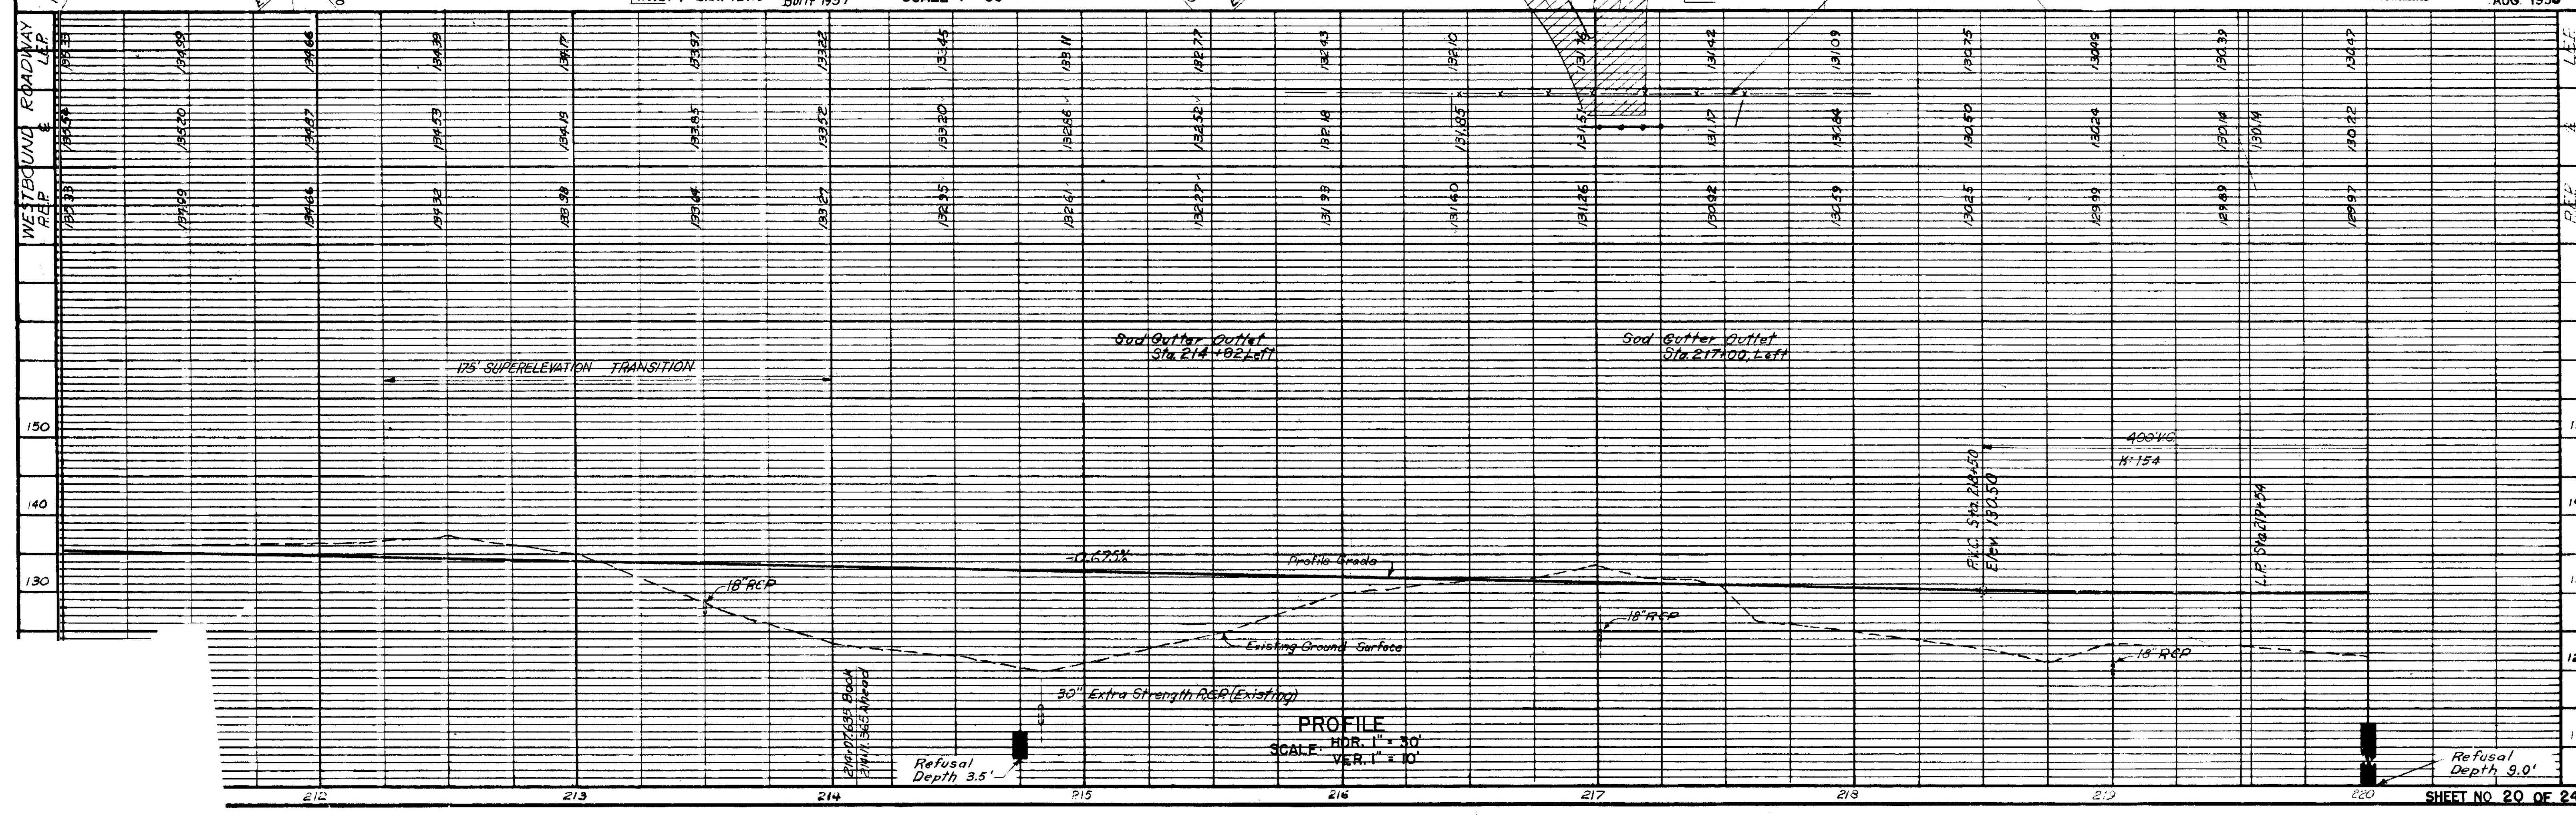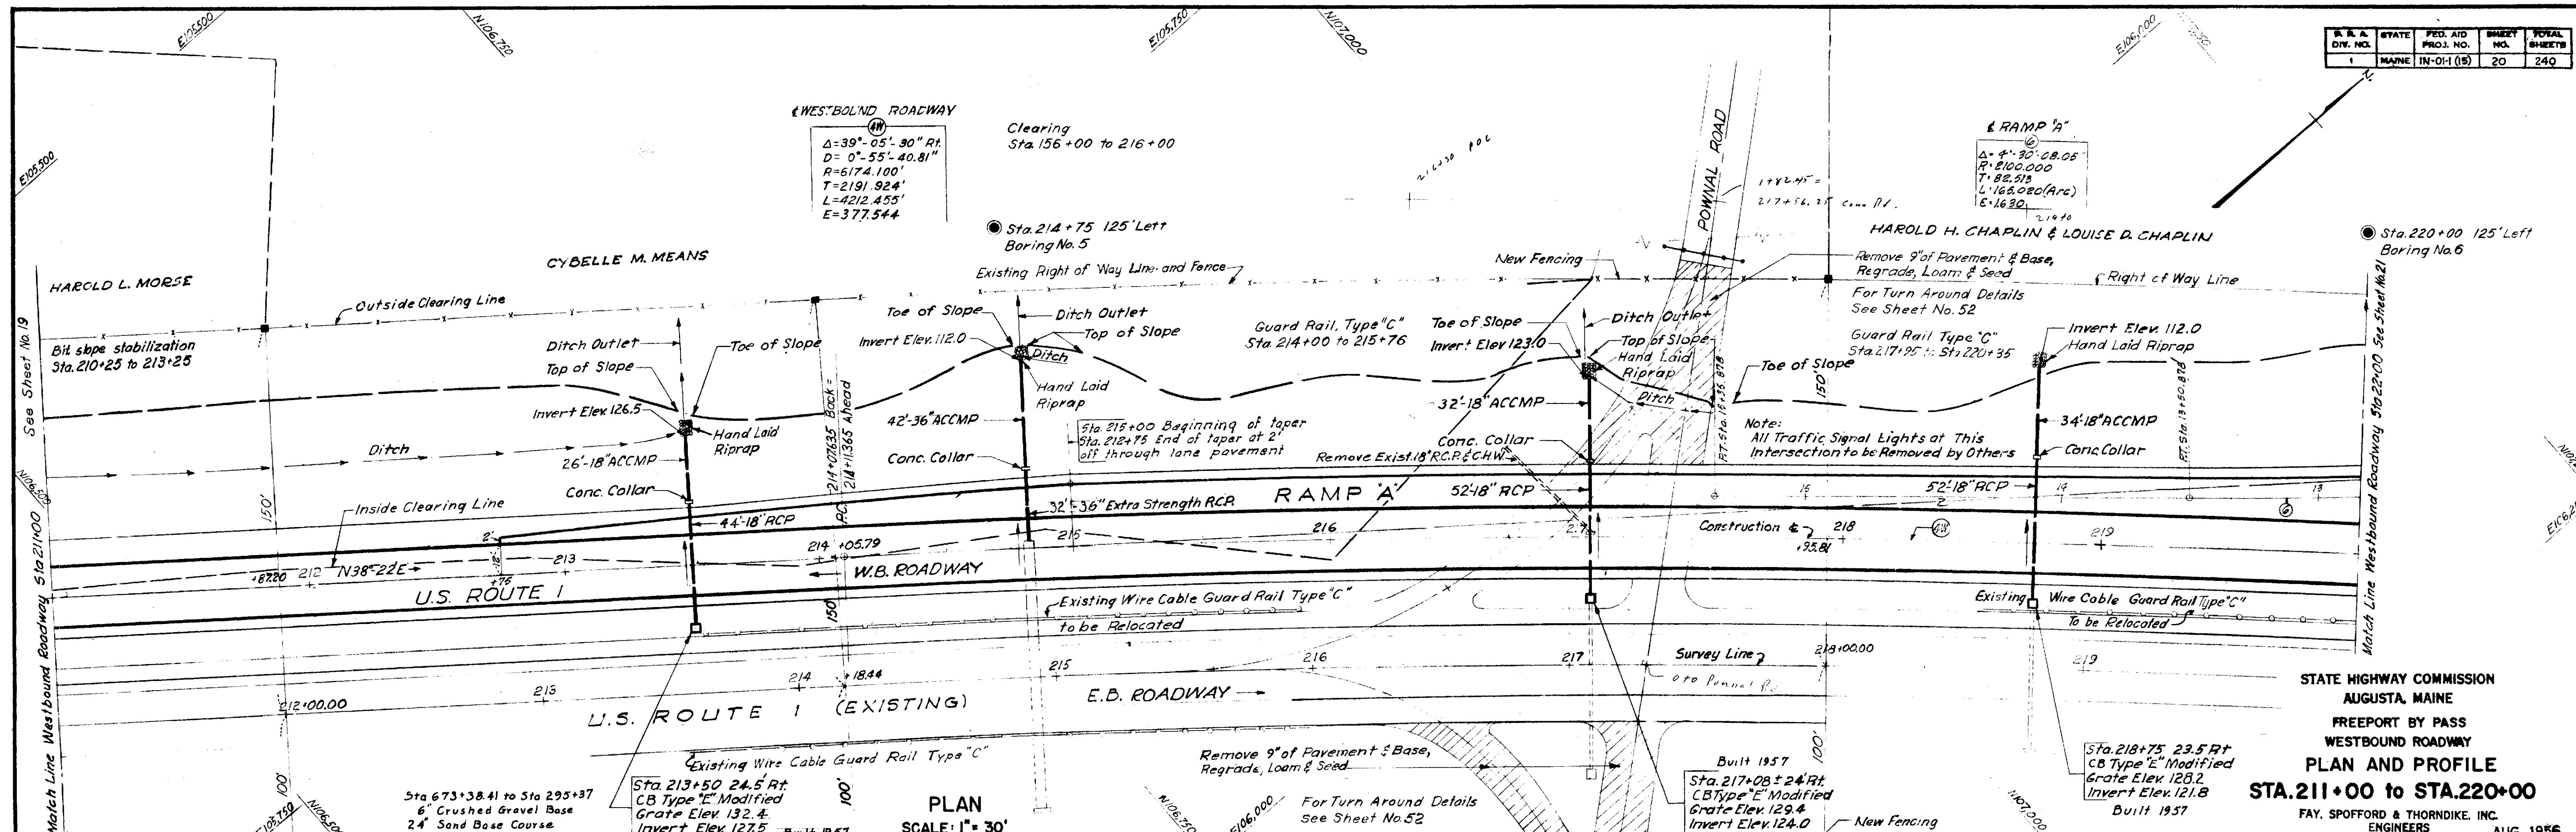


R. R. A. DIV. NO.	STATE	FED. AID PROJ. NO.	SHEET NO.	TOTAL SHEETS
1	MAINE	IN-01-1 (5)	21	240

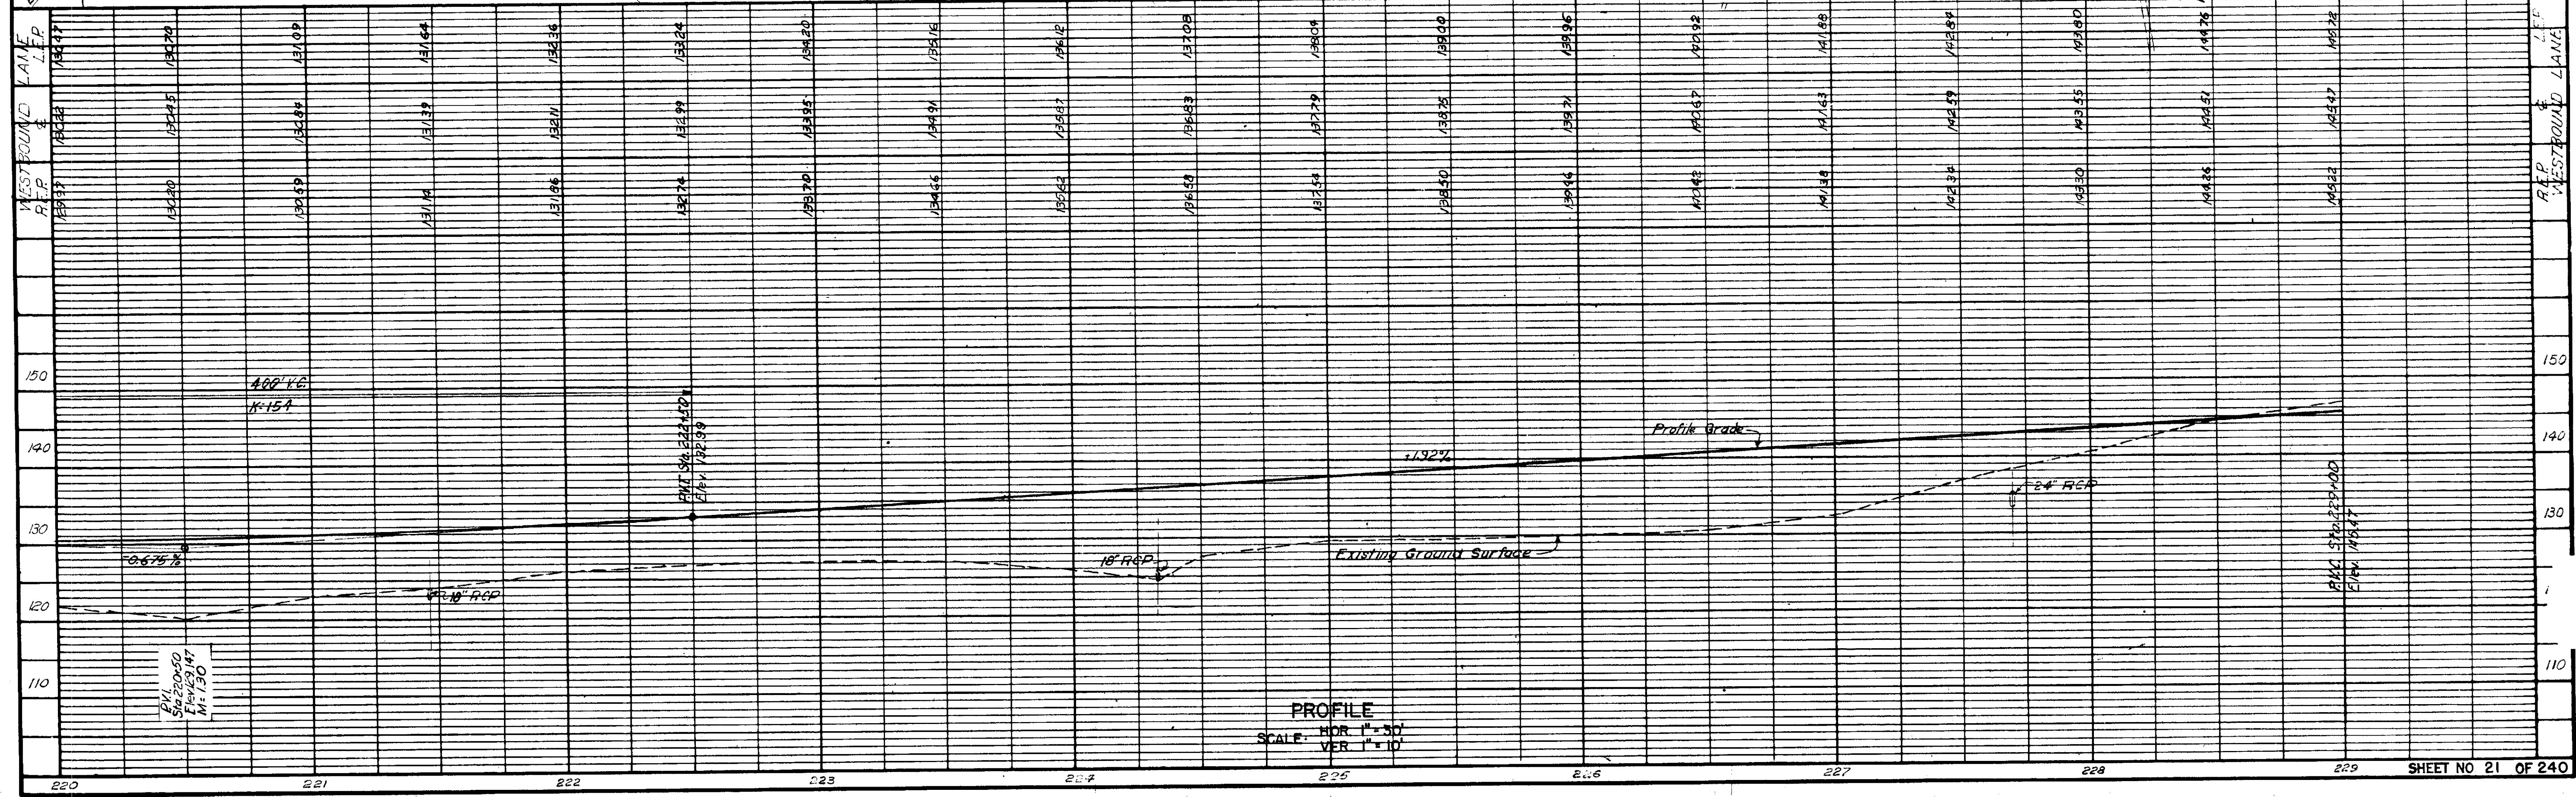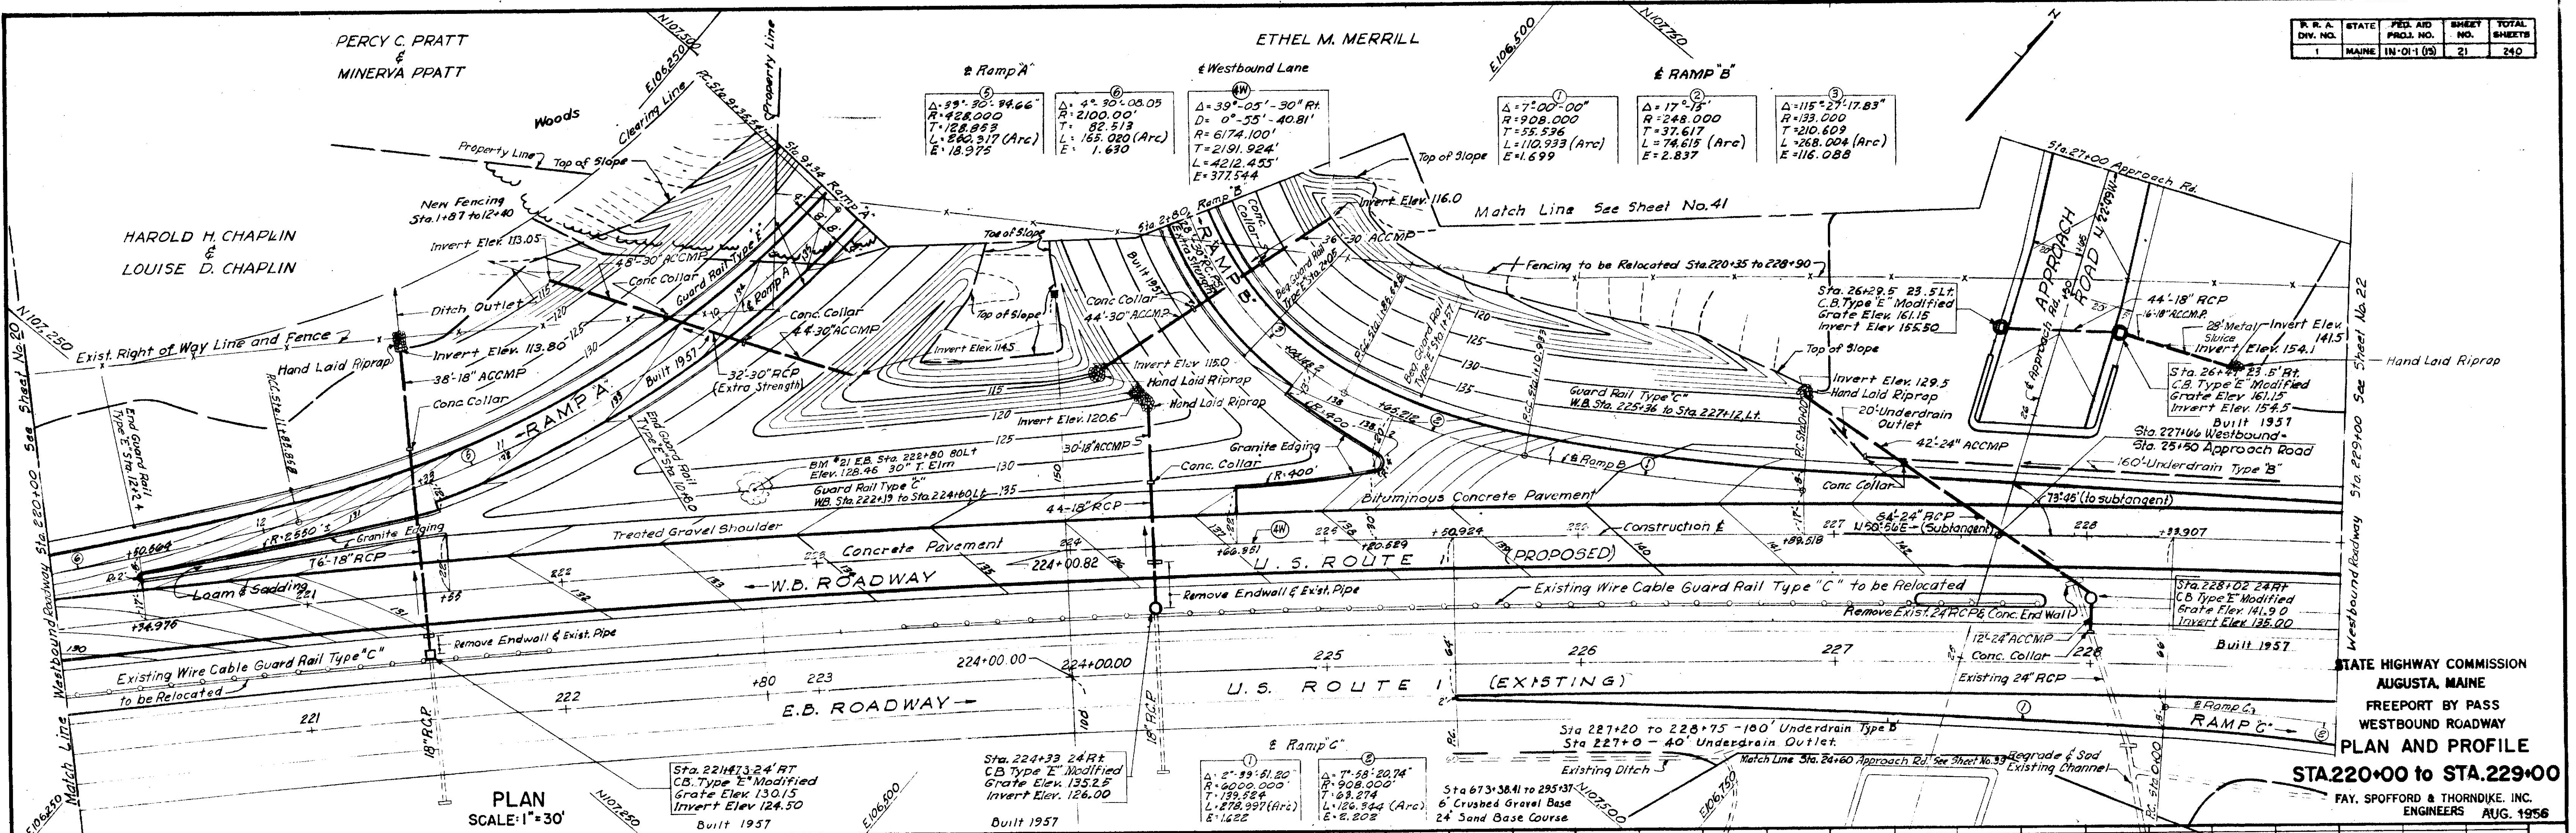


DES.	H.H.J.
DR.	W.W.
TR.	W.W.
CIV.	C.H.F.
CHK.	H.U.W.

R.R.A. DIV. NO.	STATE	PROJ. NO.	SHEET NO.	TOTAL SHEETS
1	MAINE	IN-01-109	22	240

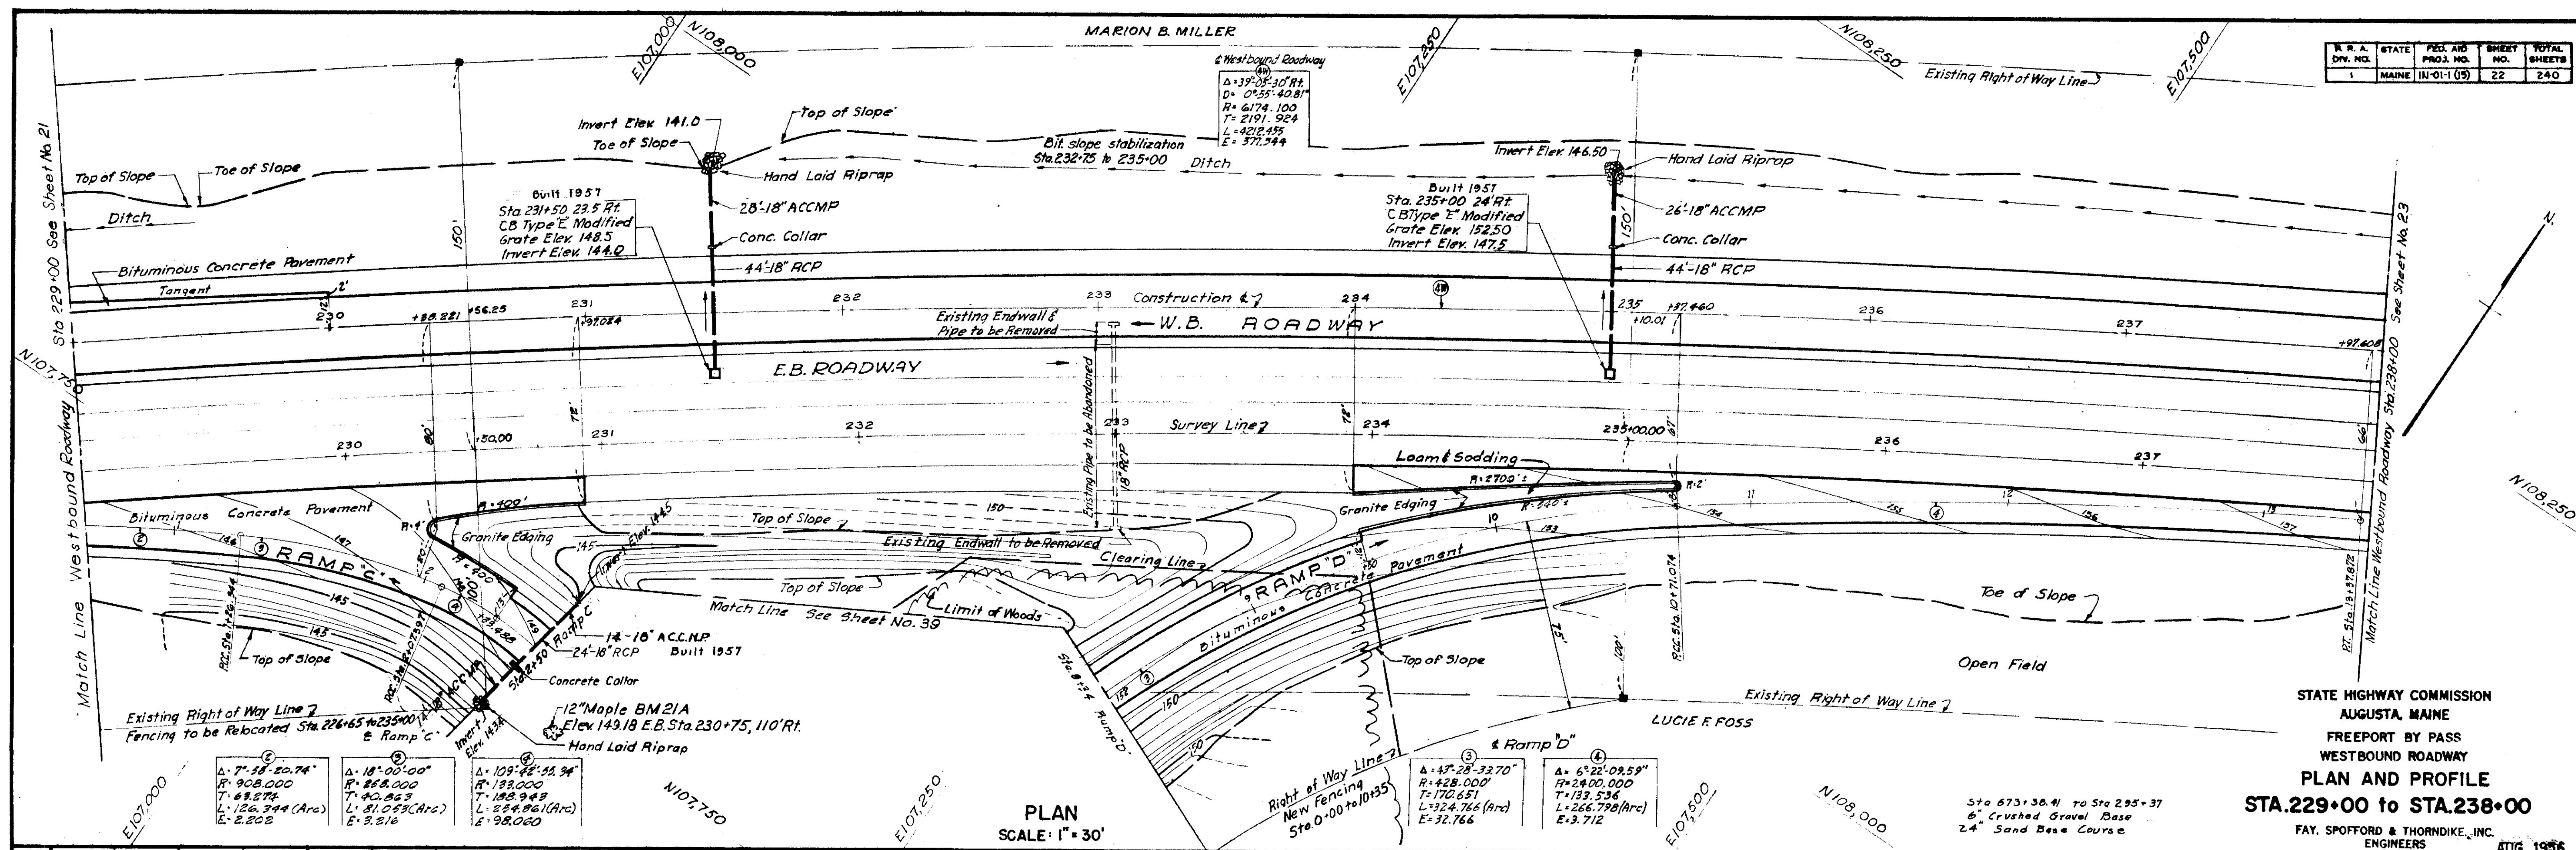


STATE HIGHWAY COMMISSION
AUGUSTA, MAINE
FREEPORT BY PASS
WESTBOUND ROADWAY
PLAN AND PROFILE
STA. 229+00 to STA. 238+00
FAY, SPOFFORD & THORNDIKE, INC.
ENGINEERS
AUG. 1956

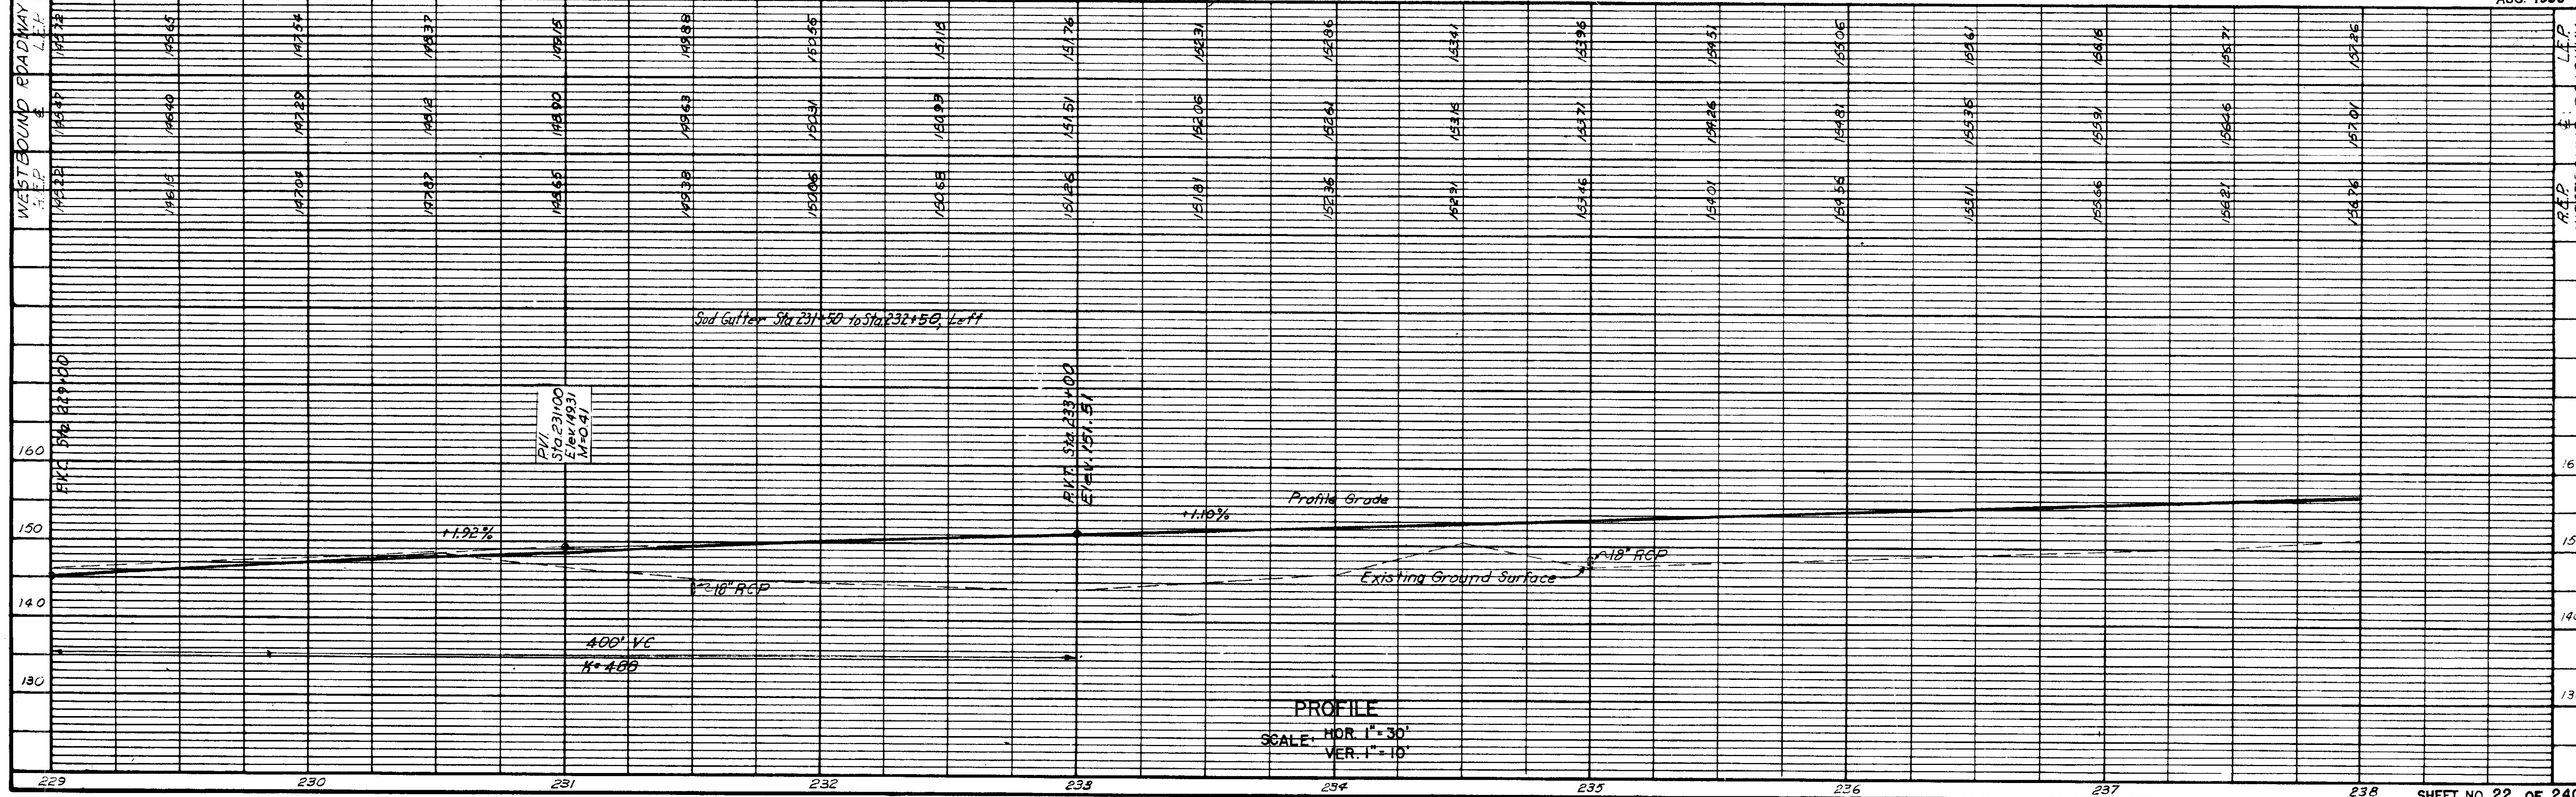


Qm-12
33

DES. H.M.J.
DR. R.P.P.
TR. R.P.P.
CHK. C.H.E.
APPD. H.U.W.

R. & A.	STATE	FED. AID	PROJ. NO.	SHEET NO.	TOTAL SHEETS
1	MAINE	IN-01-1(5)	23	240	

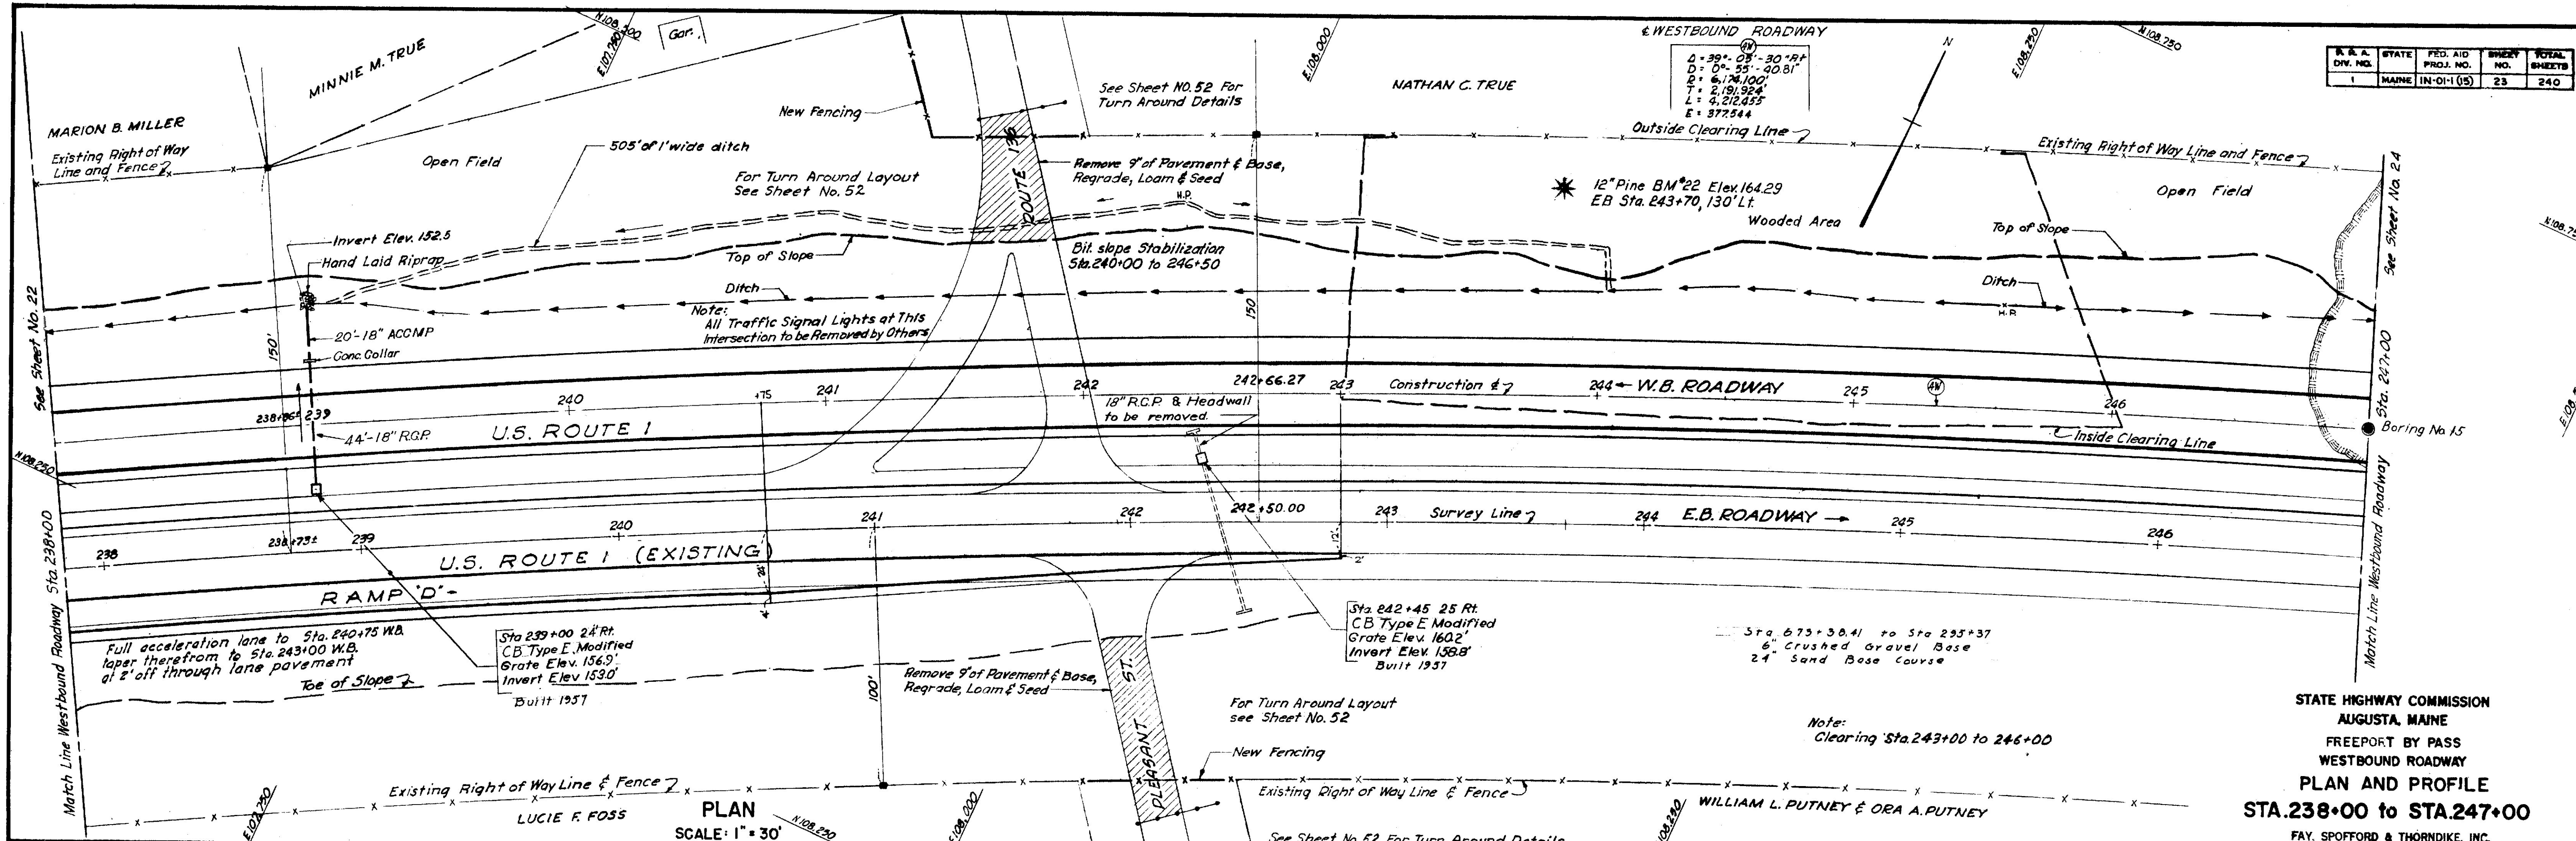

STATE HIGHWAY COMMISSION
AUGUSTA, MAINE
FREEPORT BY PASS
WESTBOUND ROADWAY
PLAN AND PROFILE
STA. 238+00 to STA. 247+00
FAY, SPOFFORD & THORNDIKE, INC.
ENGINEERS
AUG. 1956

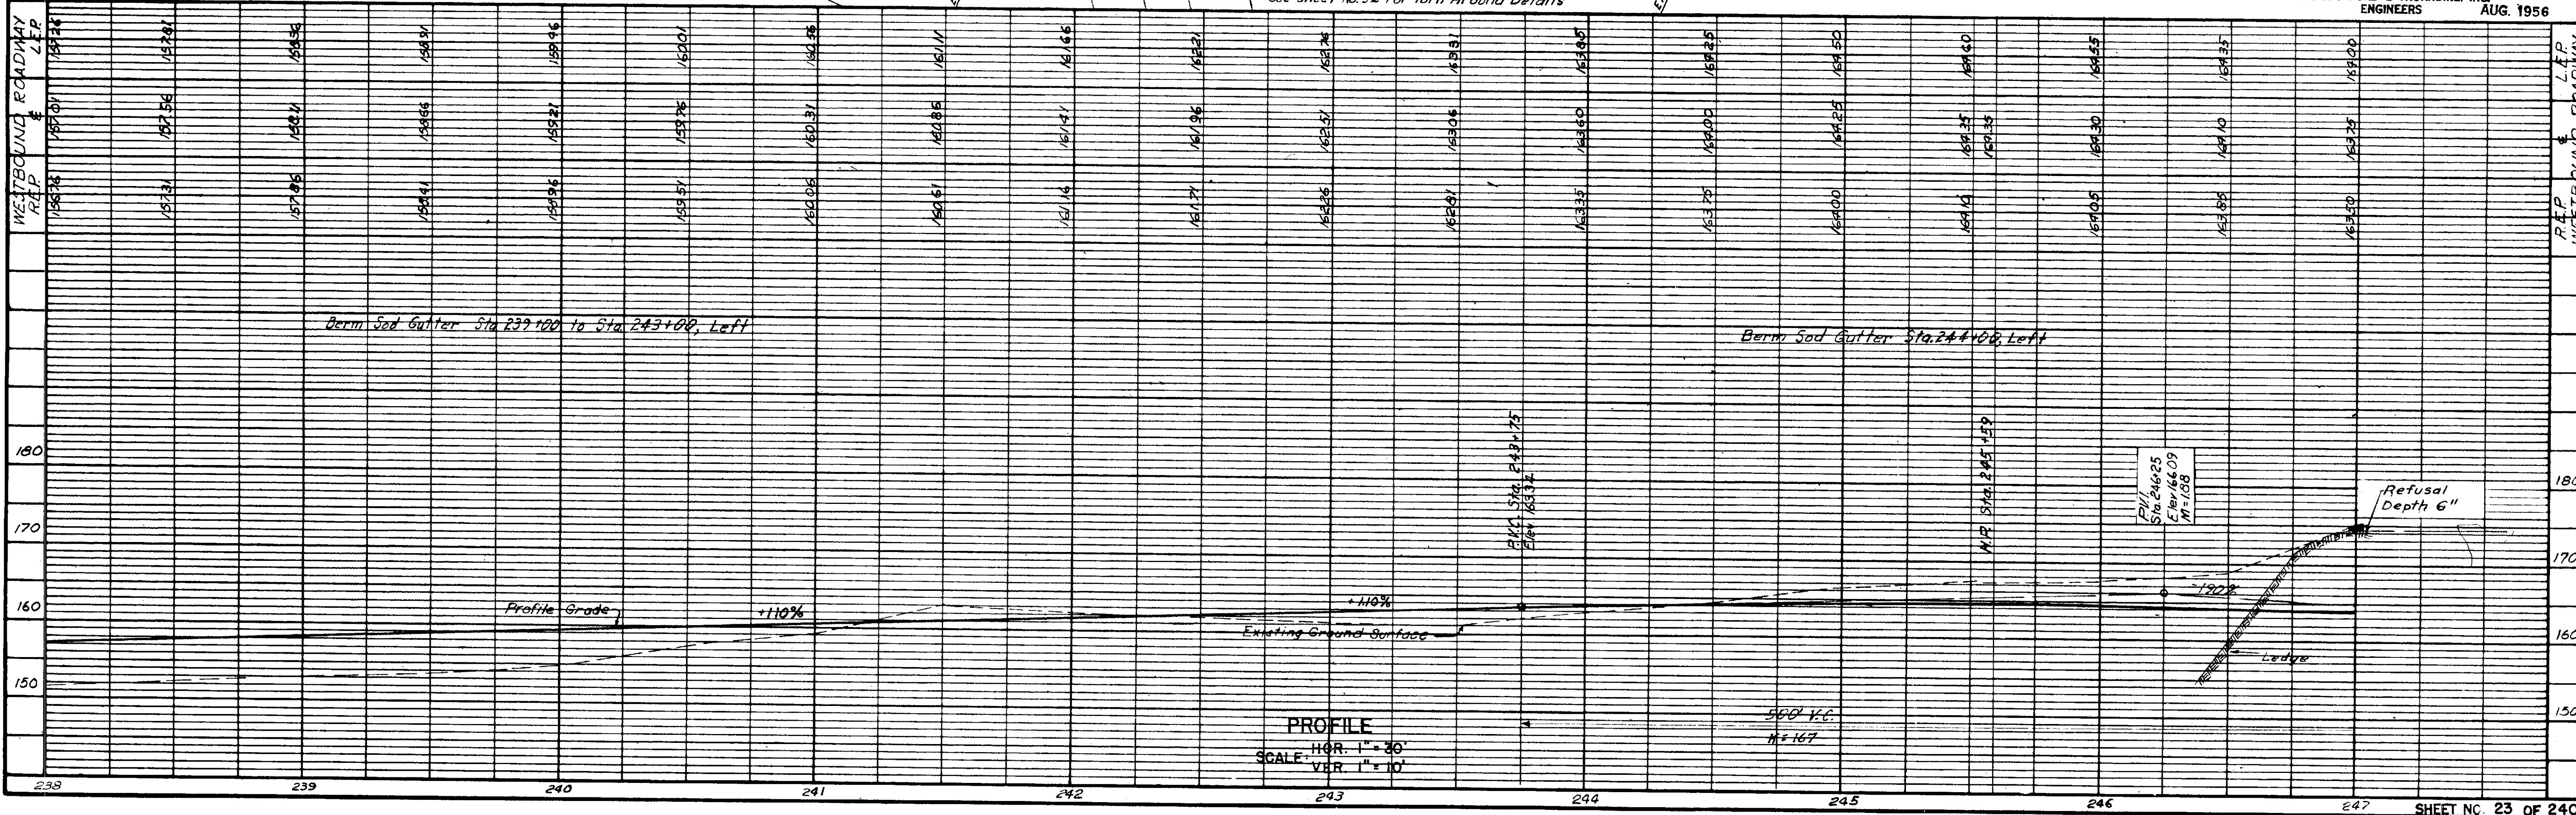

Qm-12
34

DES.	H.H.J.
DR.	R.B.
TR.	R.B.
COR.	CH.F.
NOTED	H.U.W.