




P. R. A.	STATE	FED. AID	SHEET	TOTAL
DN. NO.	PROJ. NO.	NO.	NO.	SHEETS
1	MAINE	IN-01-1(15)	34	240

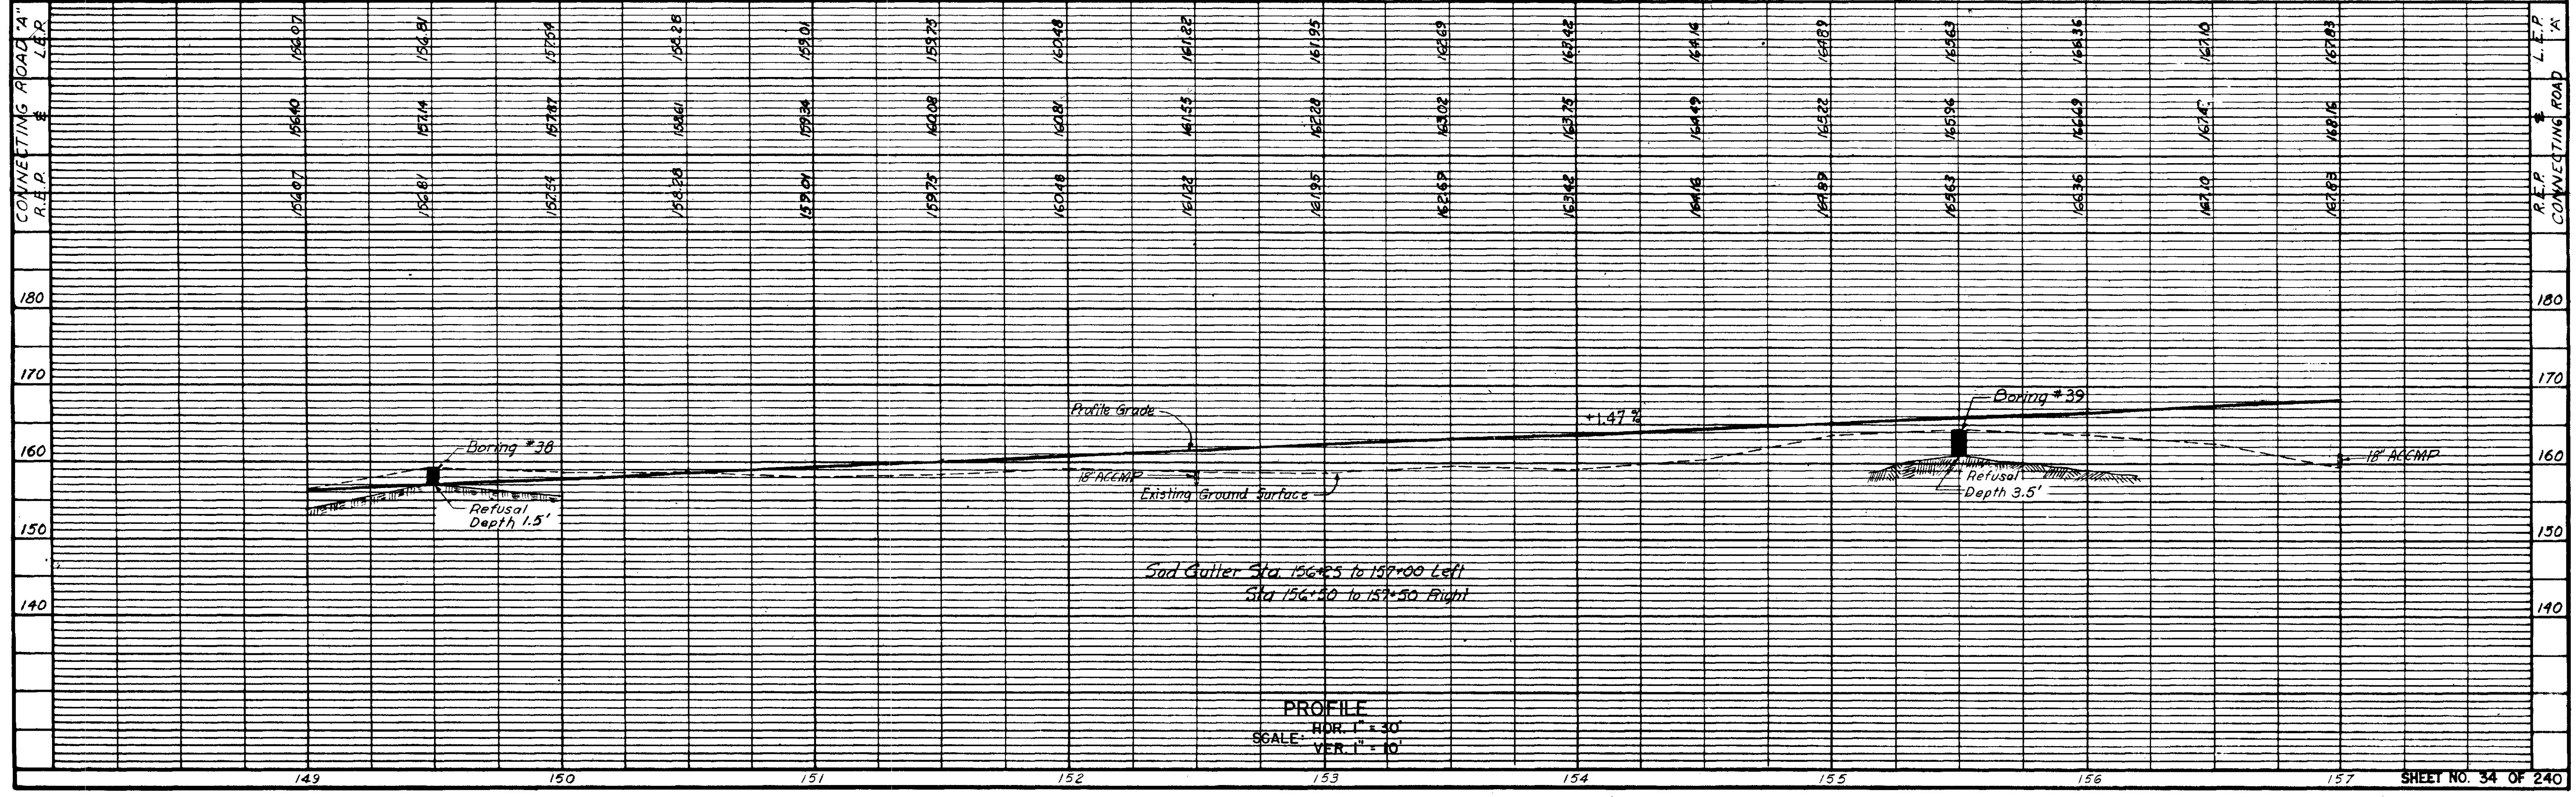

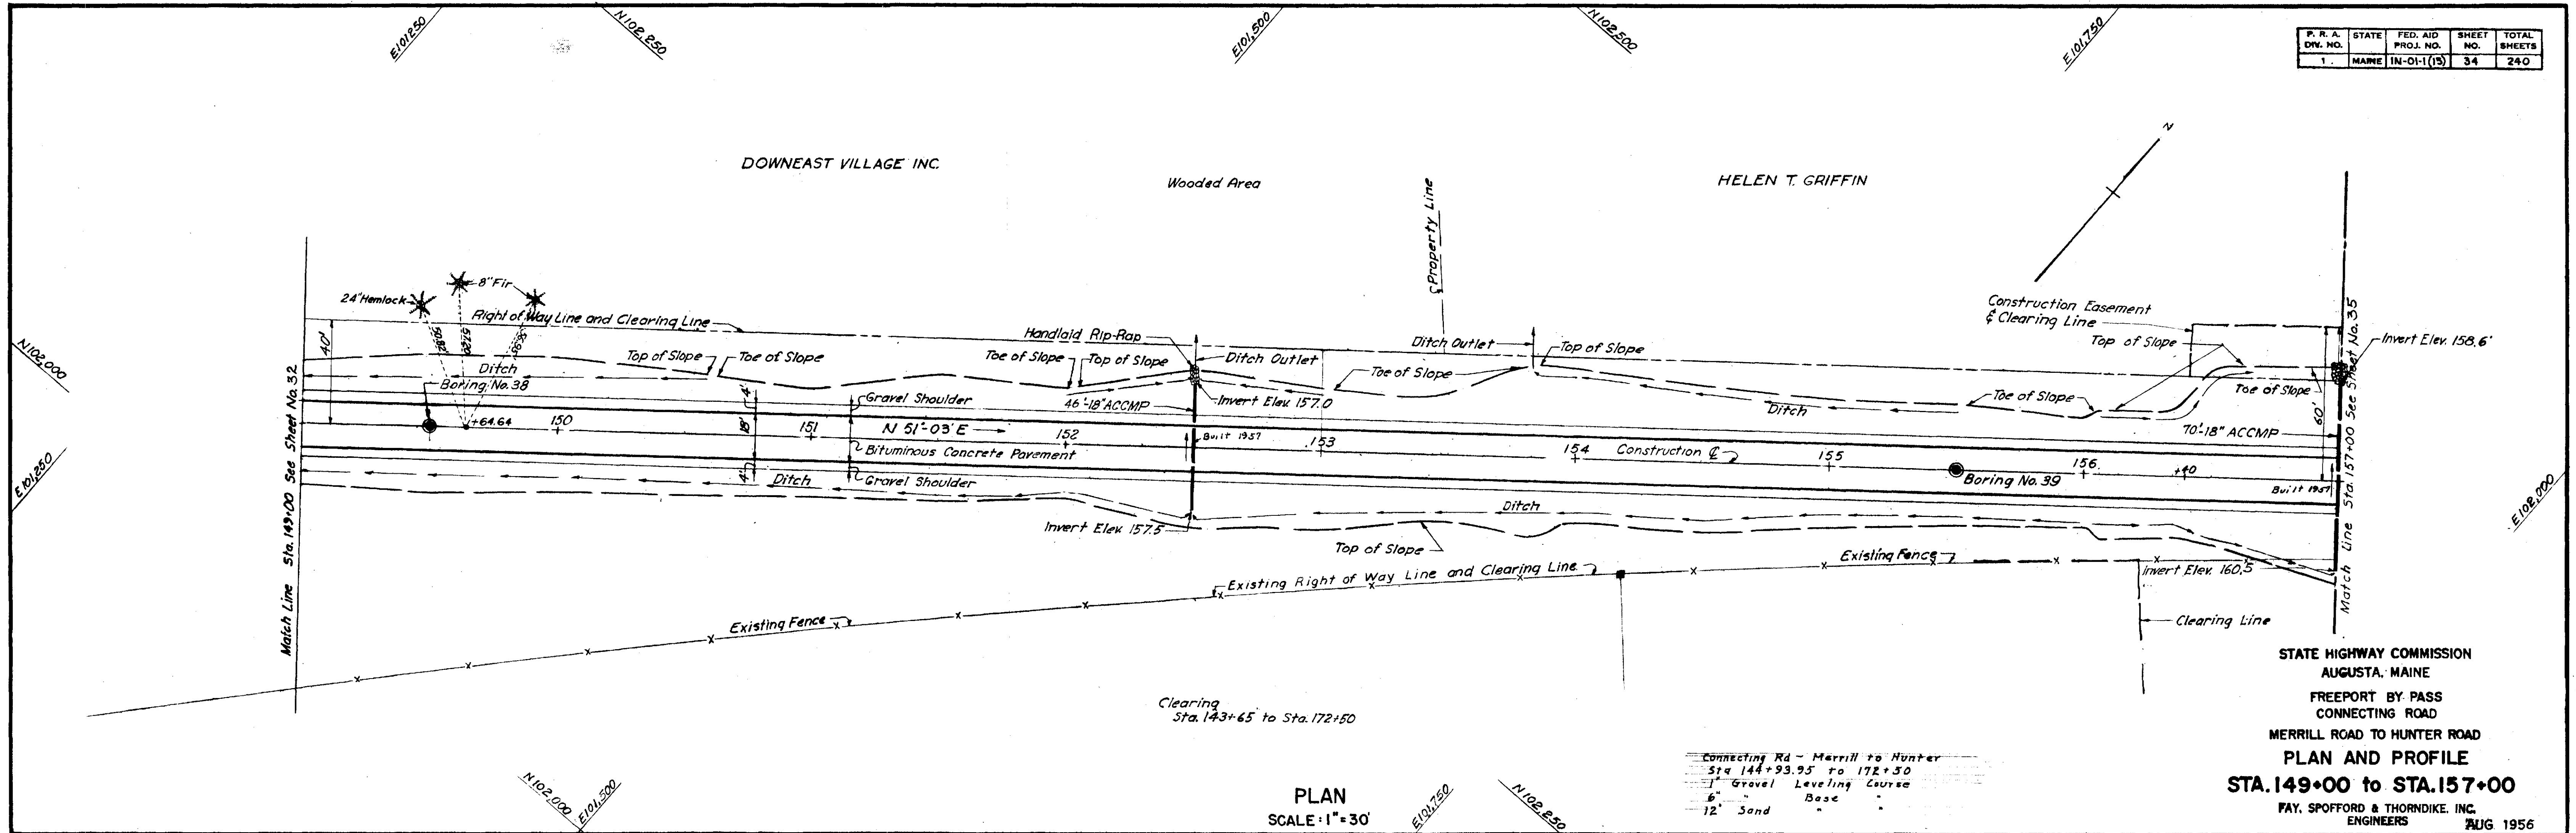

HELEN T. GRIFFIN


Wooded Area

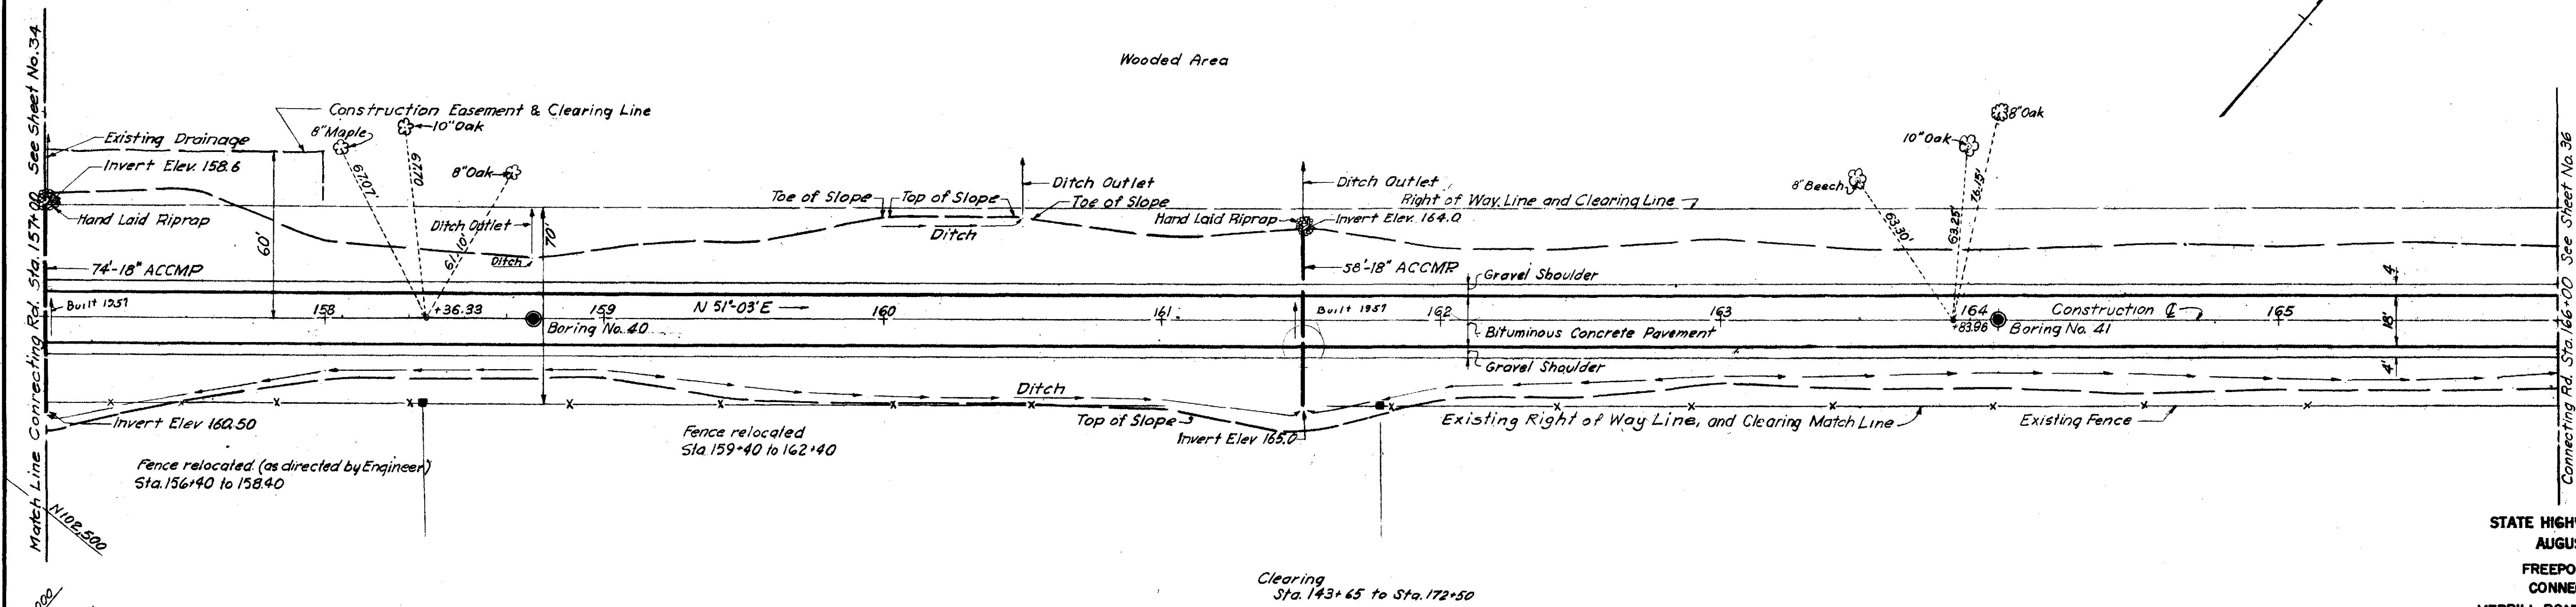

PLAN

SCALE: 1" = 30'

STATE HIGHWAY COMMISSION  
AUGUSTA, MAINE  
FREEPORT BY PASS  
CONNECTING ROAD  
MERRILL ROAD TO HUNTER ROAD  
PLAN AND PROFILE  
STA. 157+00 to STA. 166+00  
FAY, SPOFFORD & THORNDIKE, INC.  
ENGINEERS  
AUG. 1956

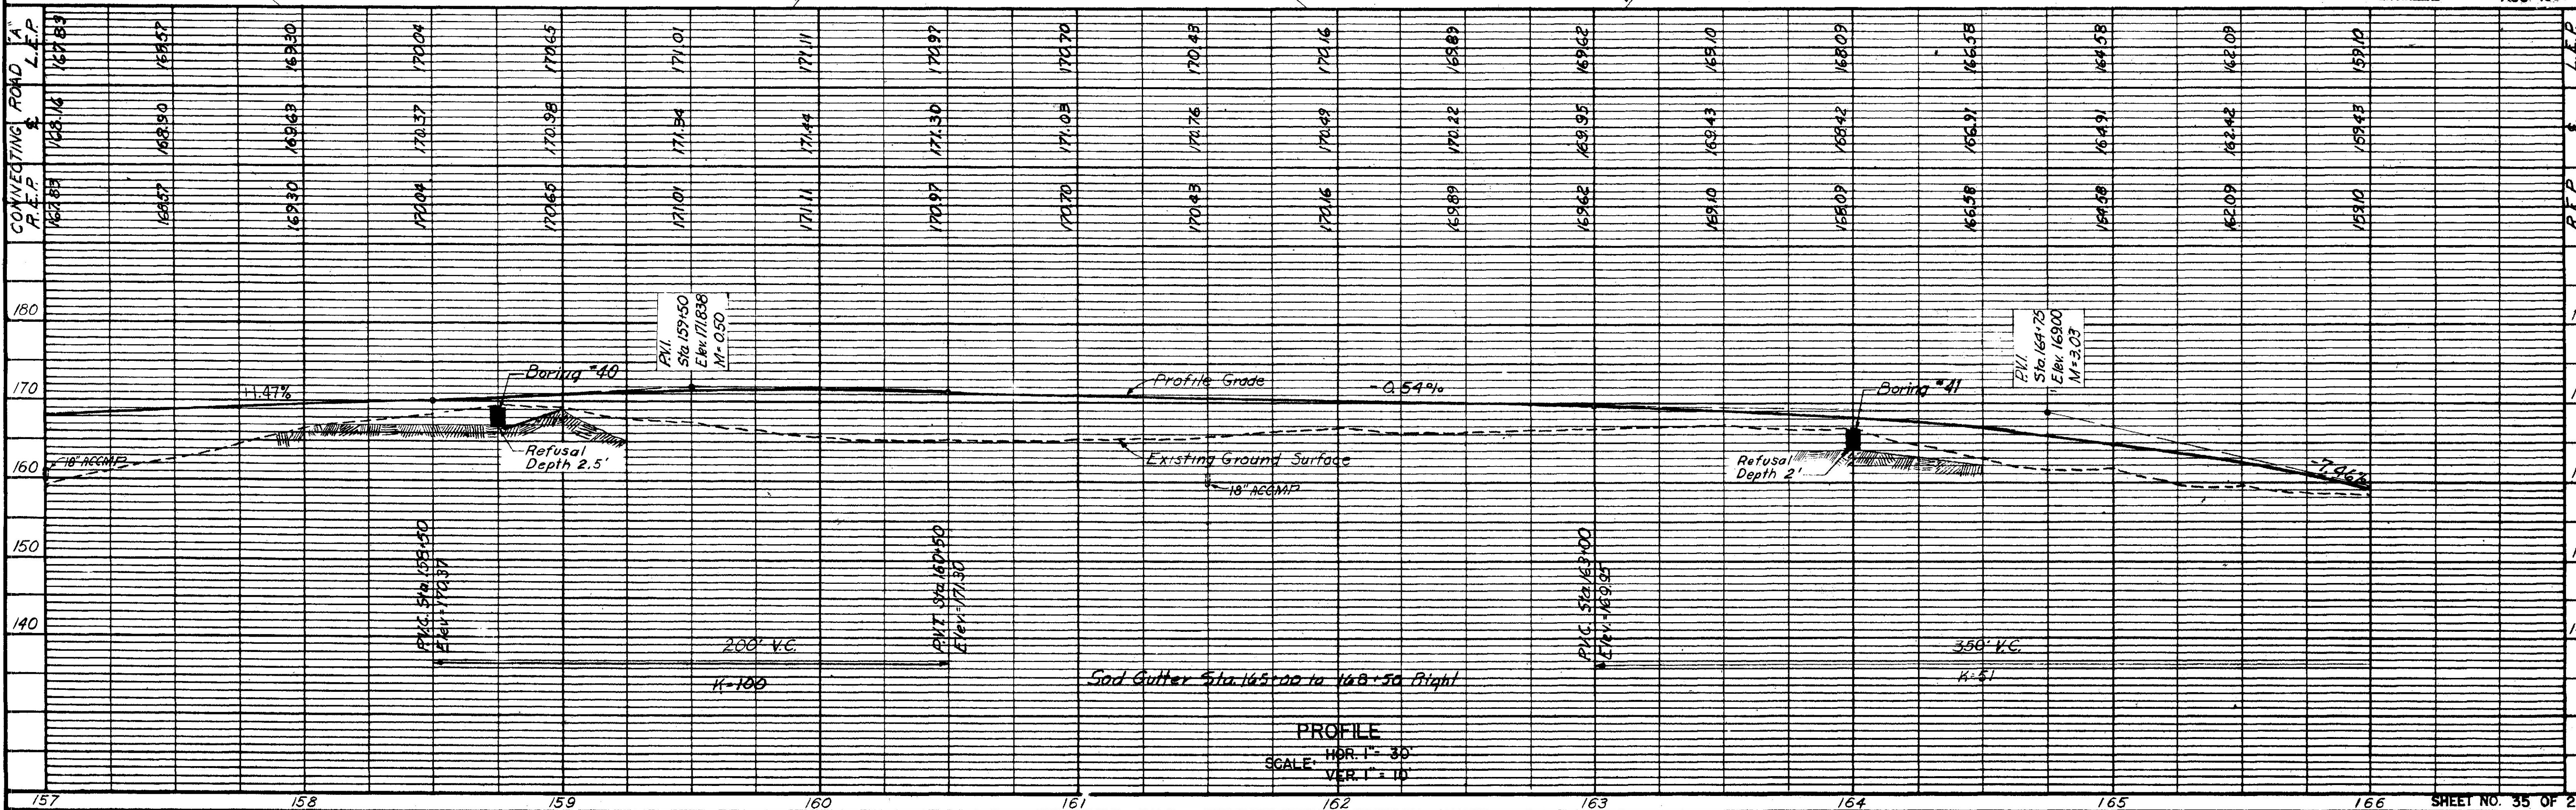

PROFILE


SCALE: HOR. 1" = 30'  
VER. 1" = 10'

46

DES.	H.H.J.
DR.	P.D.
IN.	P.D.
CHK.	C.W.F.
APP.	H.J.W.




P. R. A. DIV. NO.	STATE	FED. AID PROJ. NO.	SHEET NO.	TOTAL SHEETS

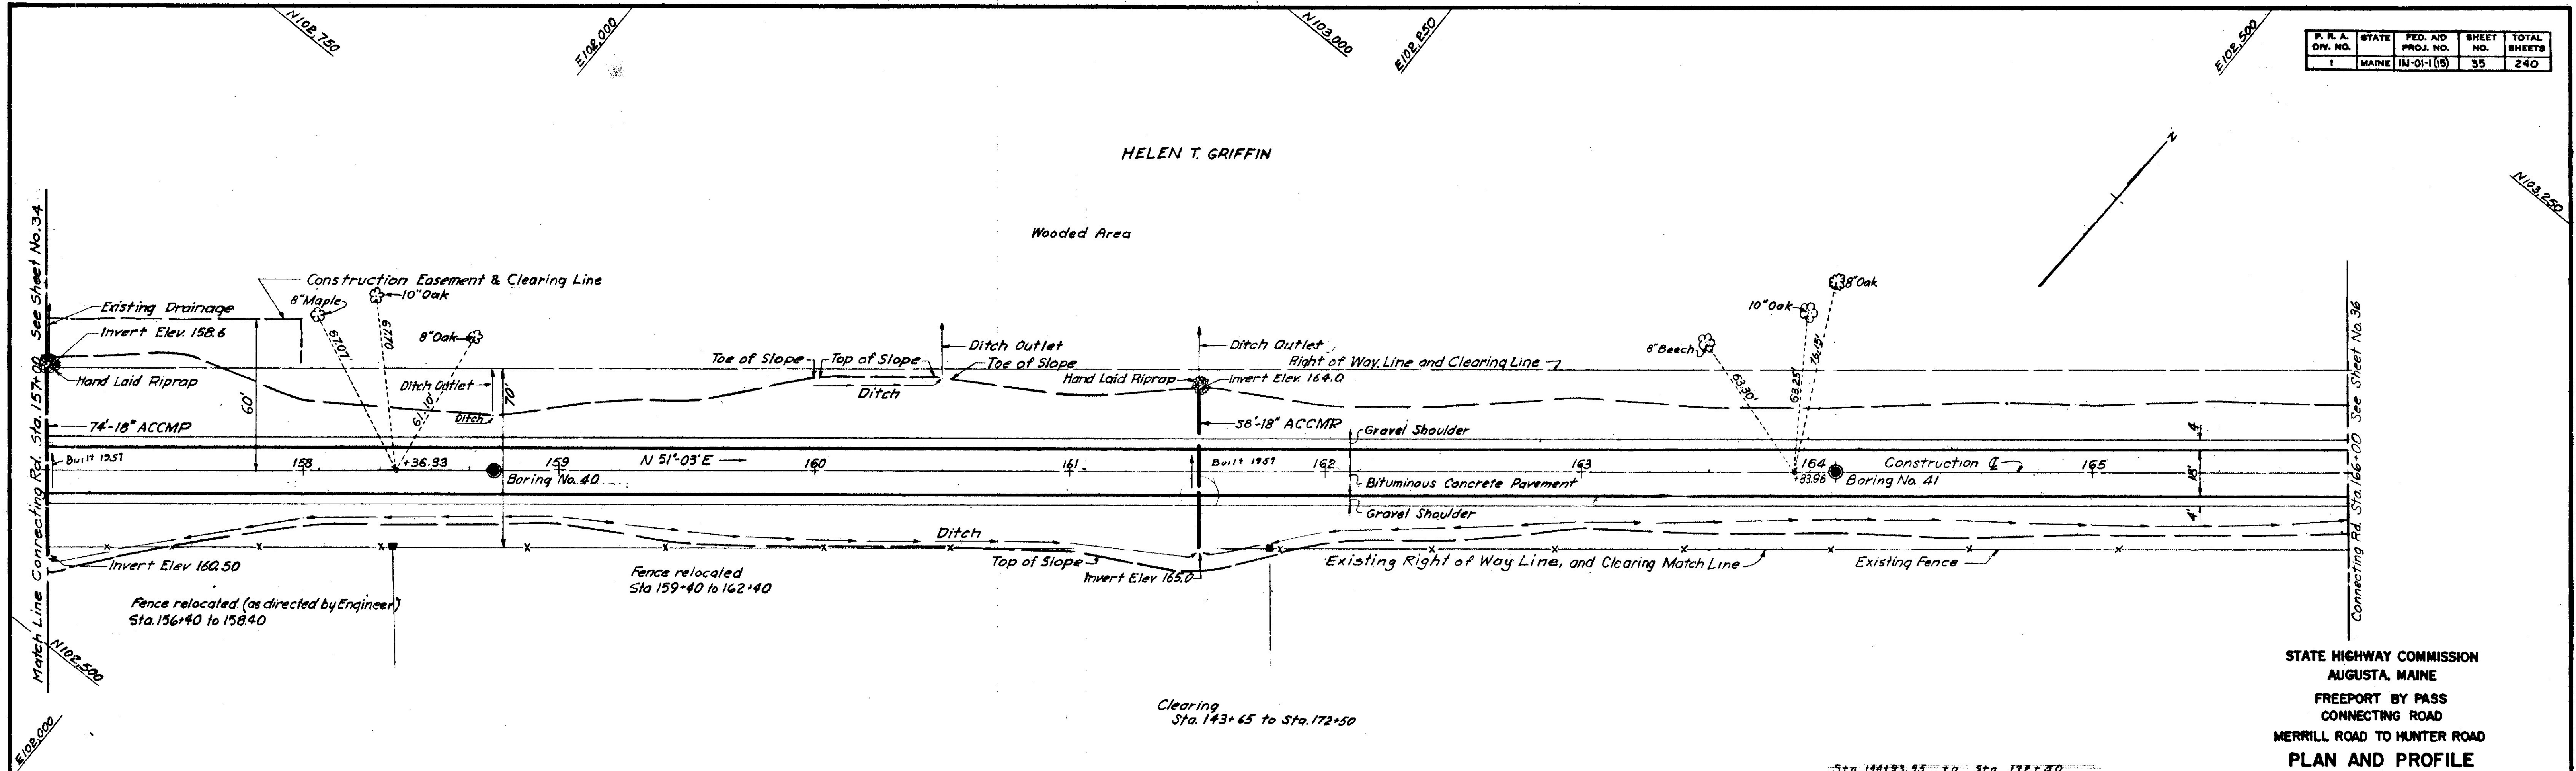


PLAN  
SCALE: 1" = 30'

STATE HIGHWAY COMMISSION  
AUGUSTA, MAINE  
FREEPORT BY PASS  
CONNECTING ROAD  
MERRILL ROAD TO HUNTER ROAD  
PLAN AND PROFILE  
STA. 157+00 to STA. 166+00  
FAY, SPOFFORD & THORNDIKE, INC.  
ENGINEERS  
AUG 1956

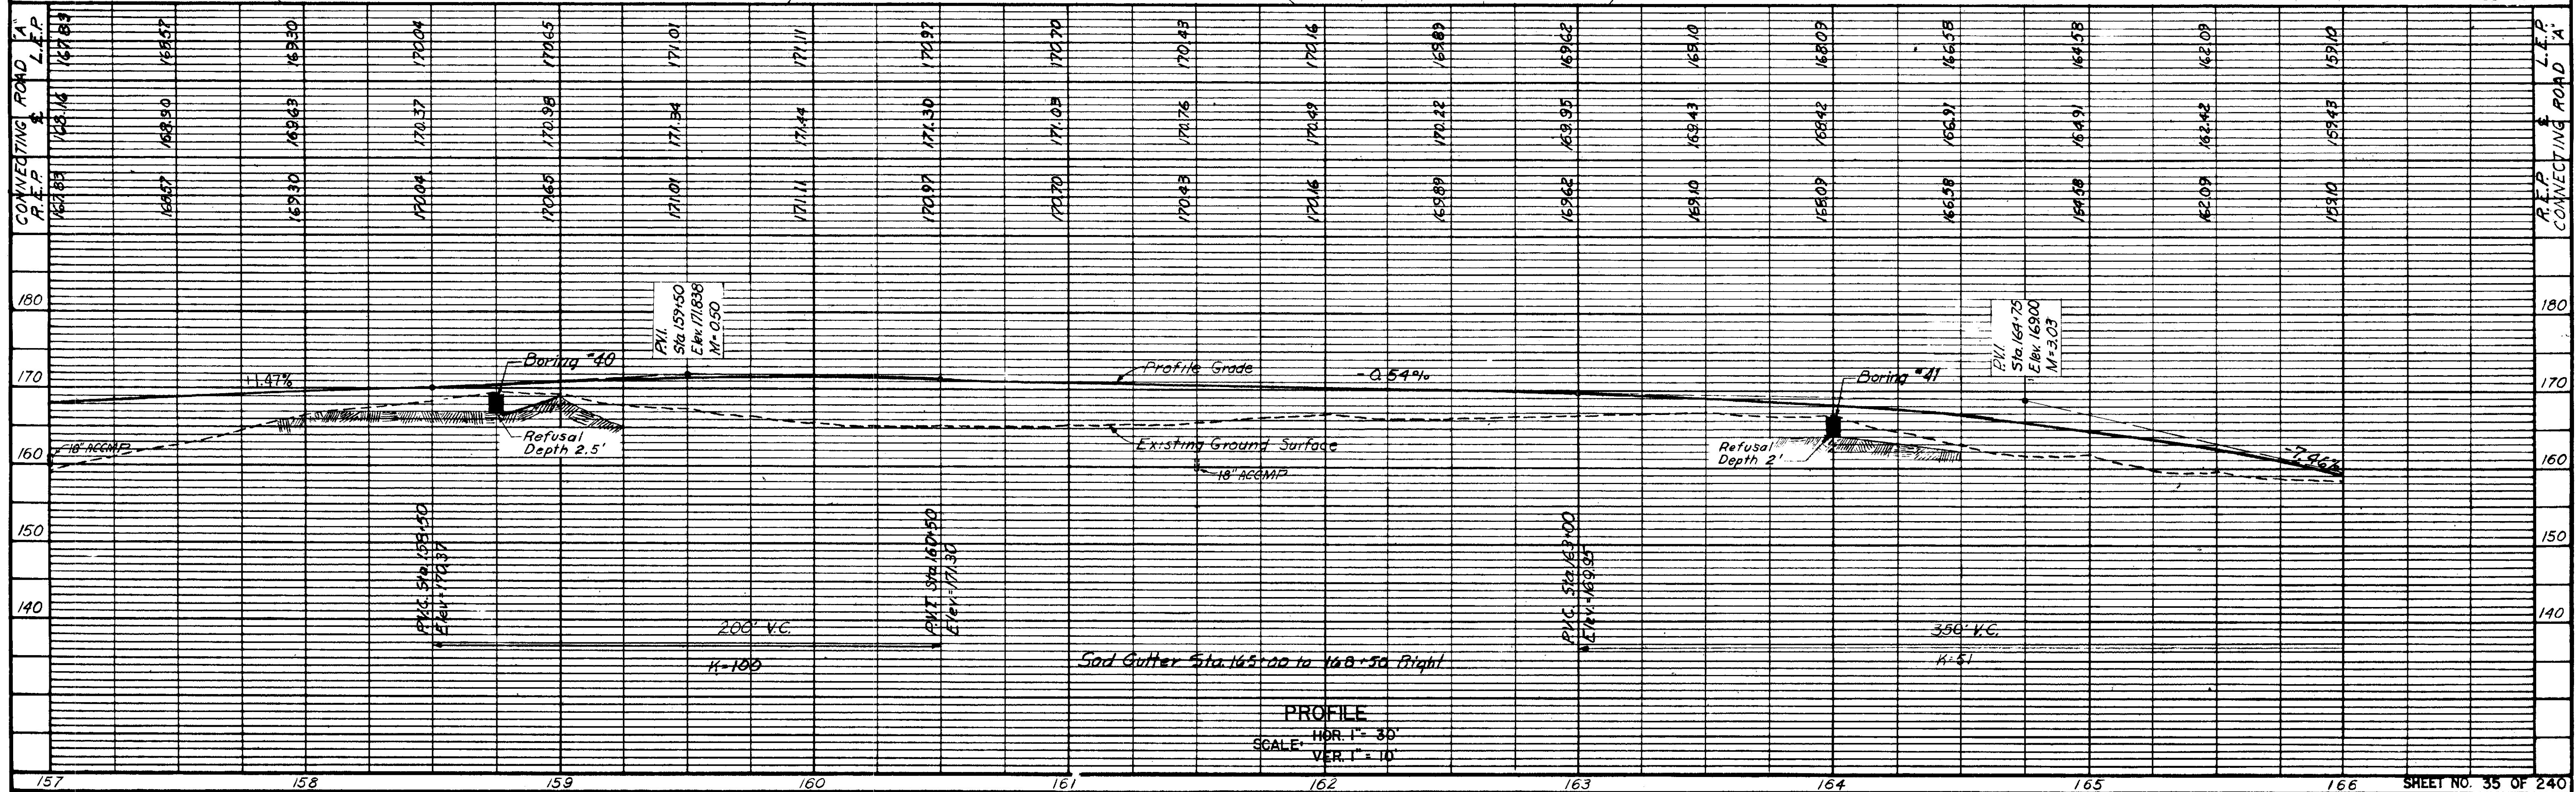


PROFILE  
SCALE: HOR. 1" = 30'  
VER. 1" = 10'



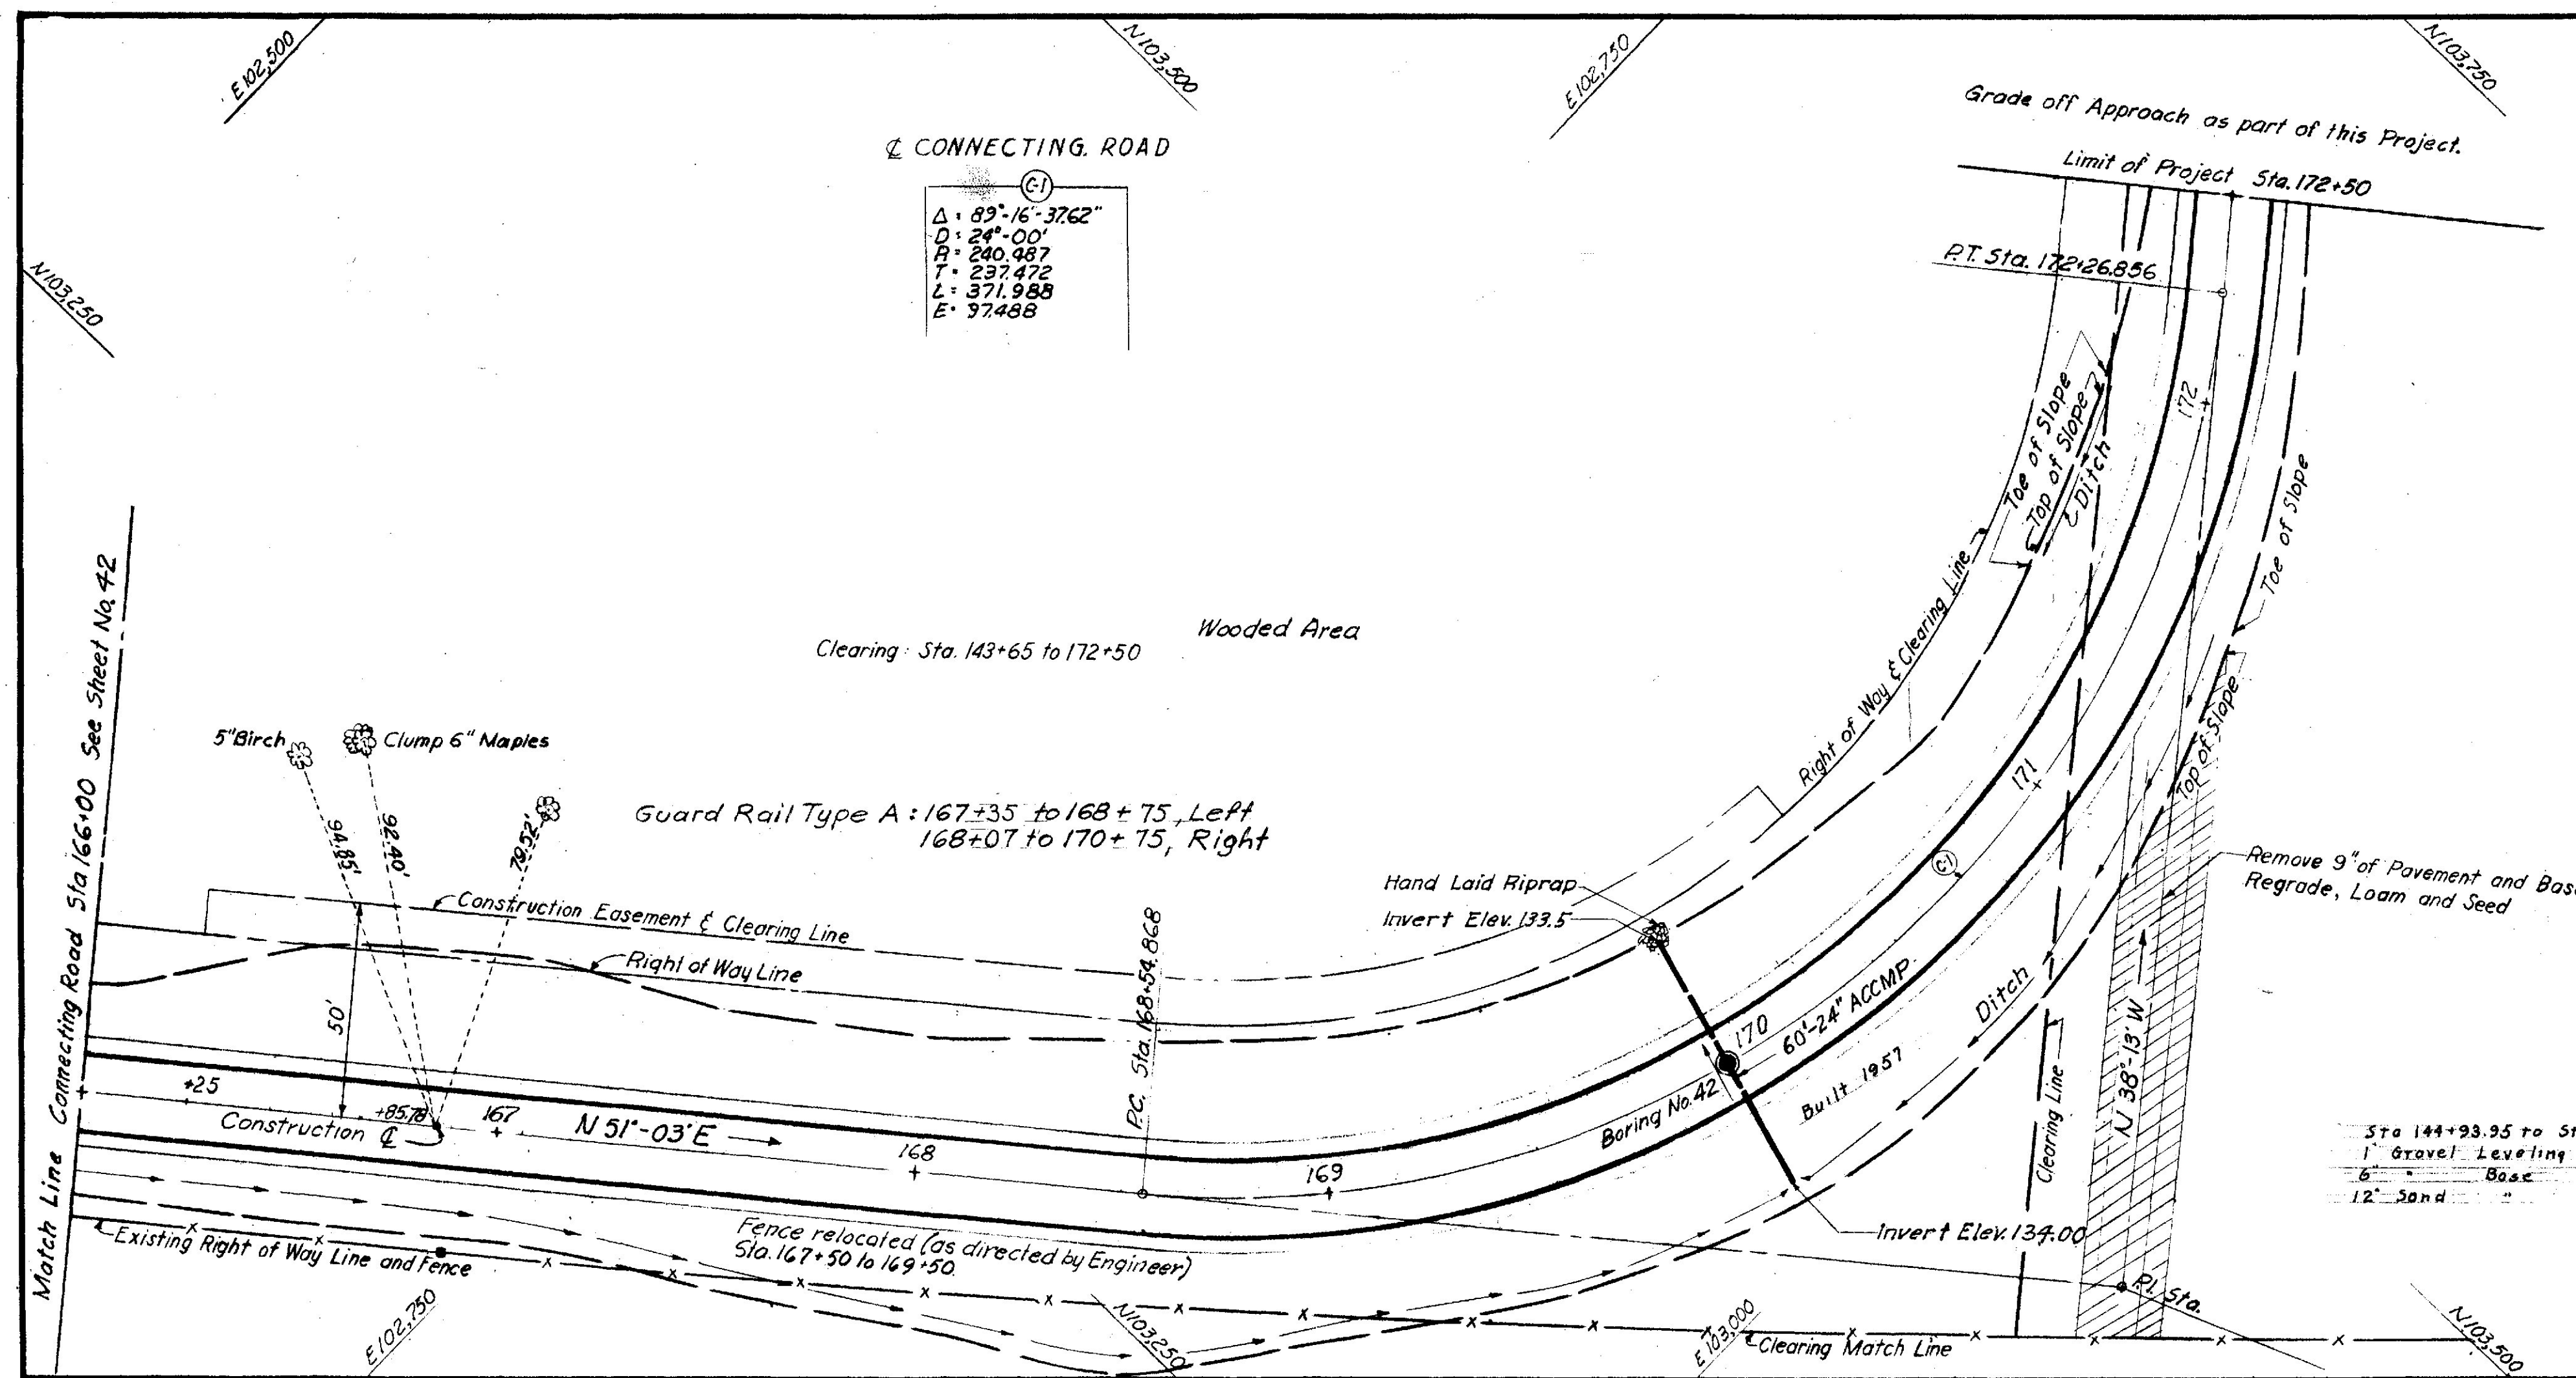

PLAN  
SCALE: 1" = 30'


STATE HIGHWAY COMMISSION  
AUGUSTA, MAINE  
FREEPORT BY PASS  
CONNECTING ROAD  
MERRILL ROAD TO HUNTER ROAD  
**PLAN AND PROFILE**  
**STA. 166+00 to STA. 172+50**  
FAY, SPOFFORD & THORNDIKE, INC.  
ENGINEERS  
AUG.

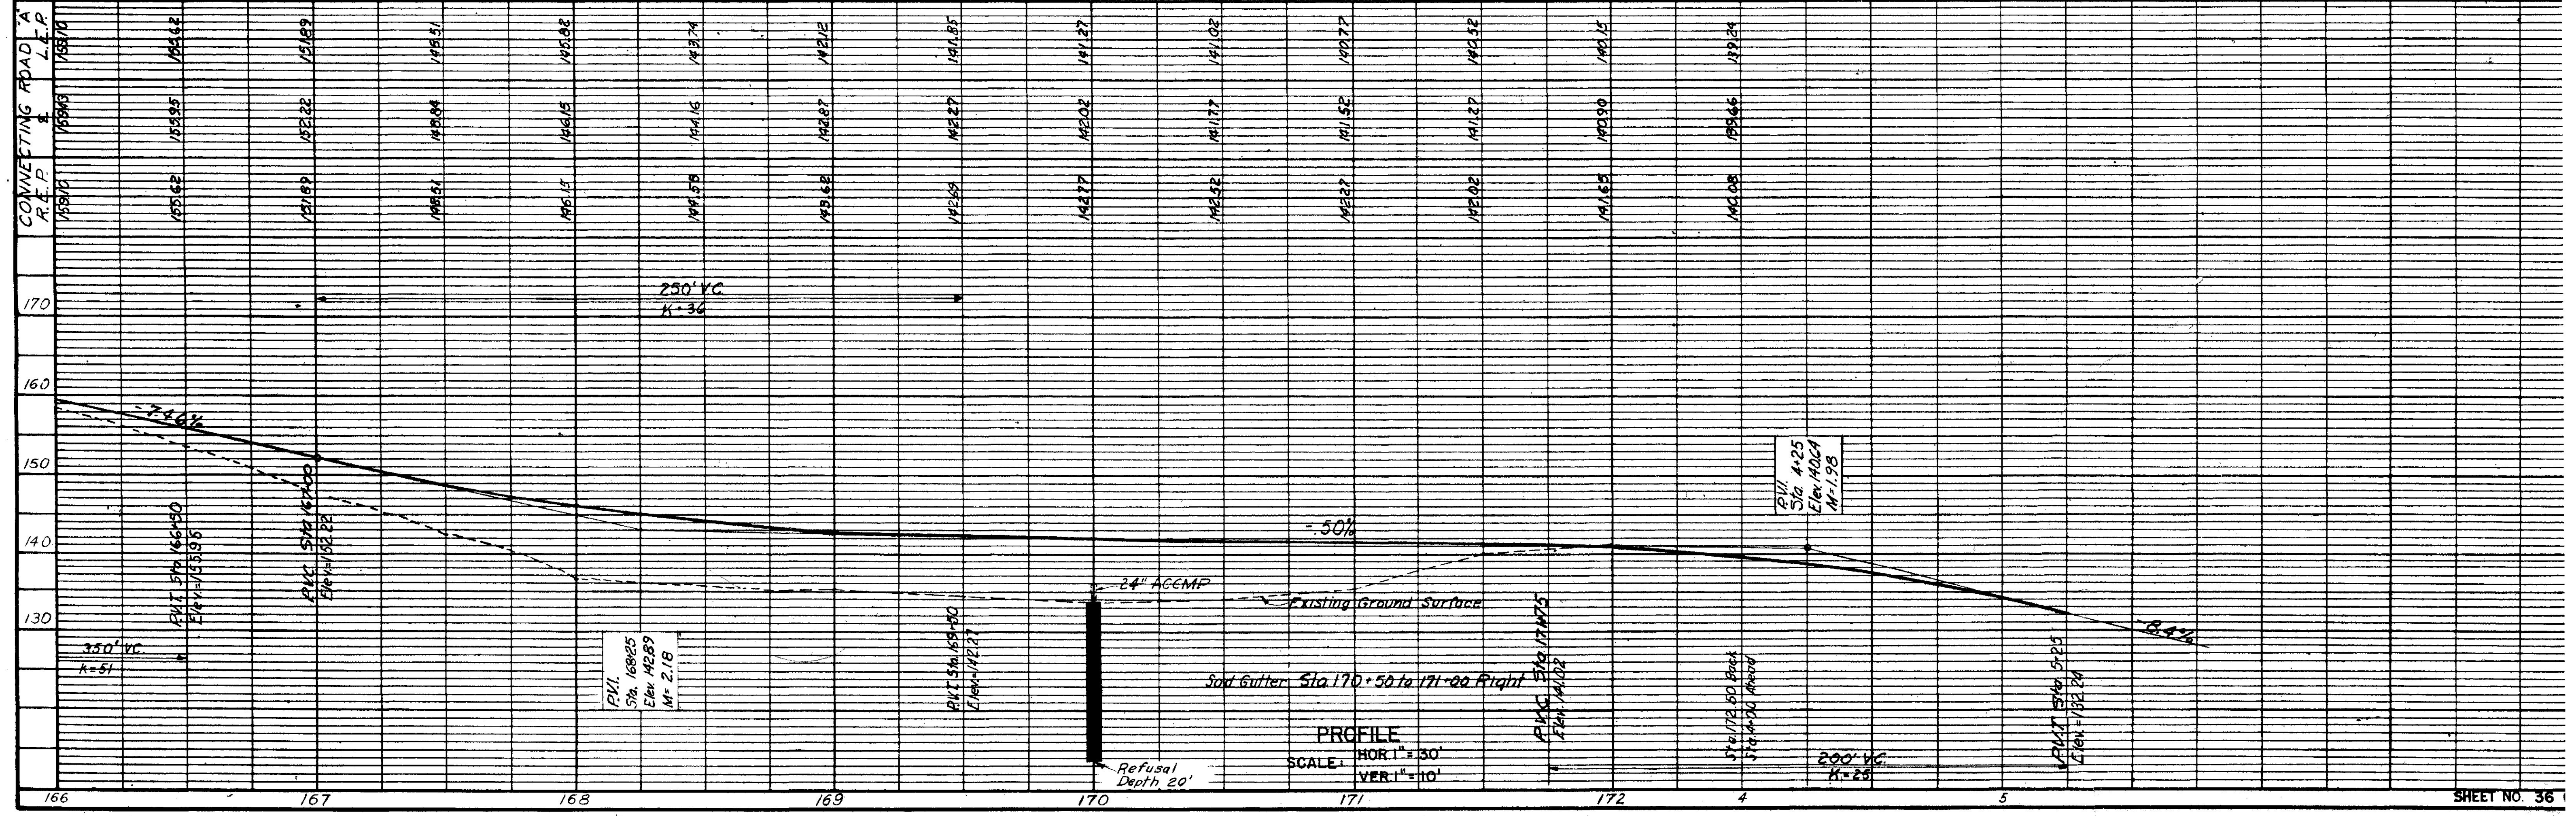

PROFILE  
SCALE: HOR. 1" = 30'  
VER. 1" = 10'




R. R. A.	STATE	FED. AID	SHEET	TOTAL
NO.	NO.	NO.	NO.	SHEETS
1	MAINE	IN-01-1 (15)	36	240

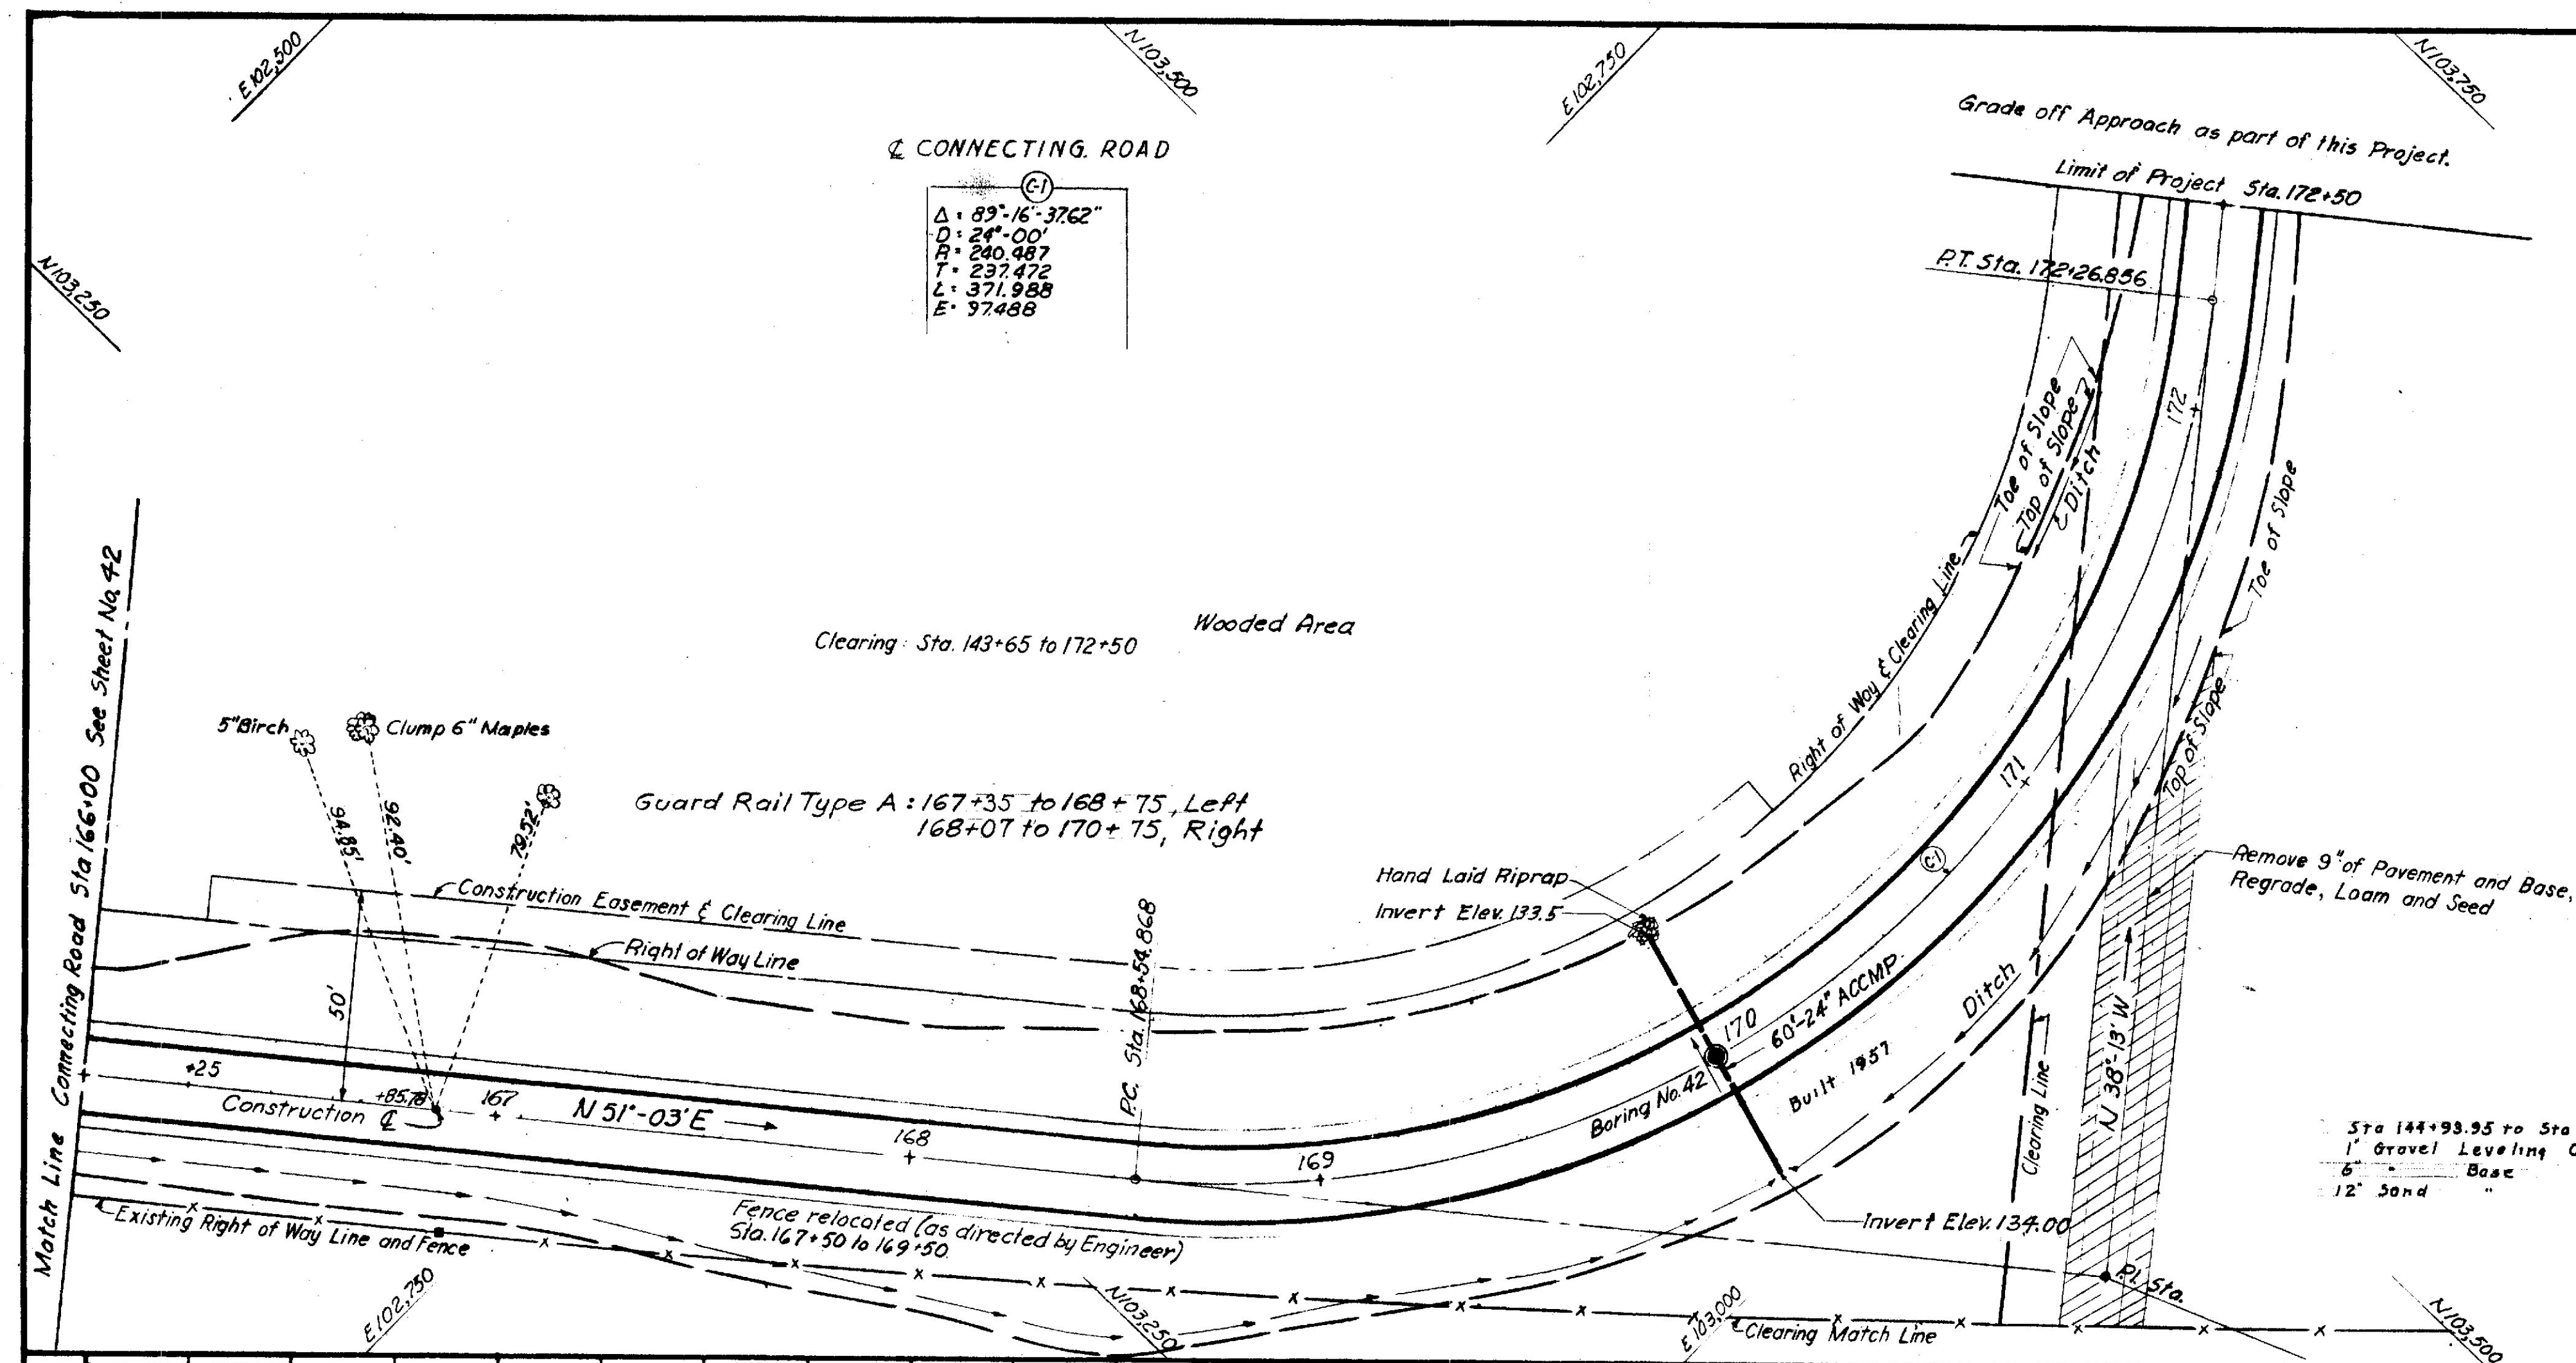



PLAN  
SCALE: 1" = 30'

STATE HIGHWAY COMMISSION  
AUGUSTA, MAINE  
FREEPORT BY PASS  
CONNECTING ROAD  
MERRILL ROAD TO HUNTER ROAD  
PLAN AND PROFILE  
STA. 166+00 to STA. 172+50  
FAY, SPOFFORD & THORNDIKE, INC.  
ENGINEERS  
AUG. 1956

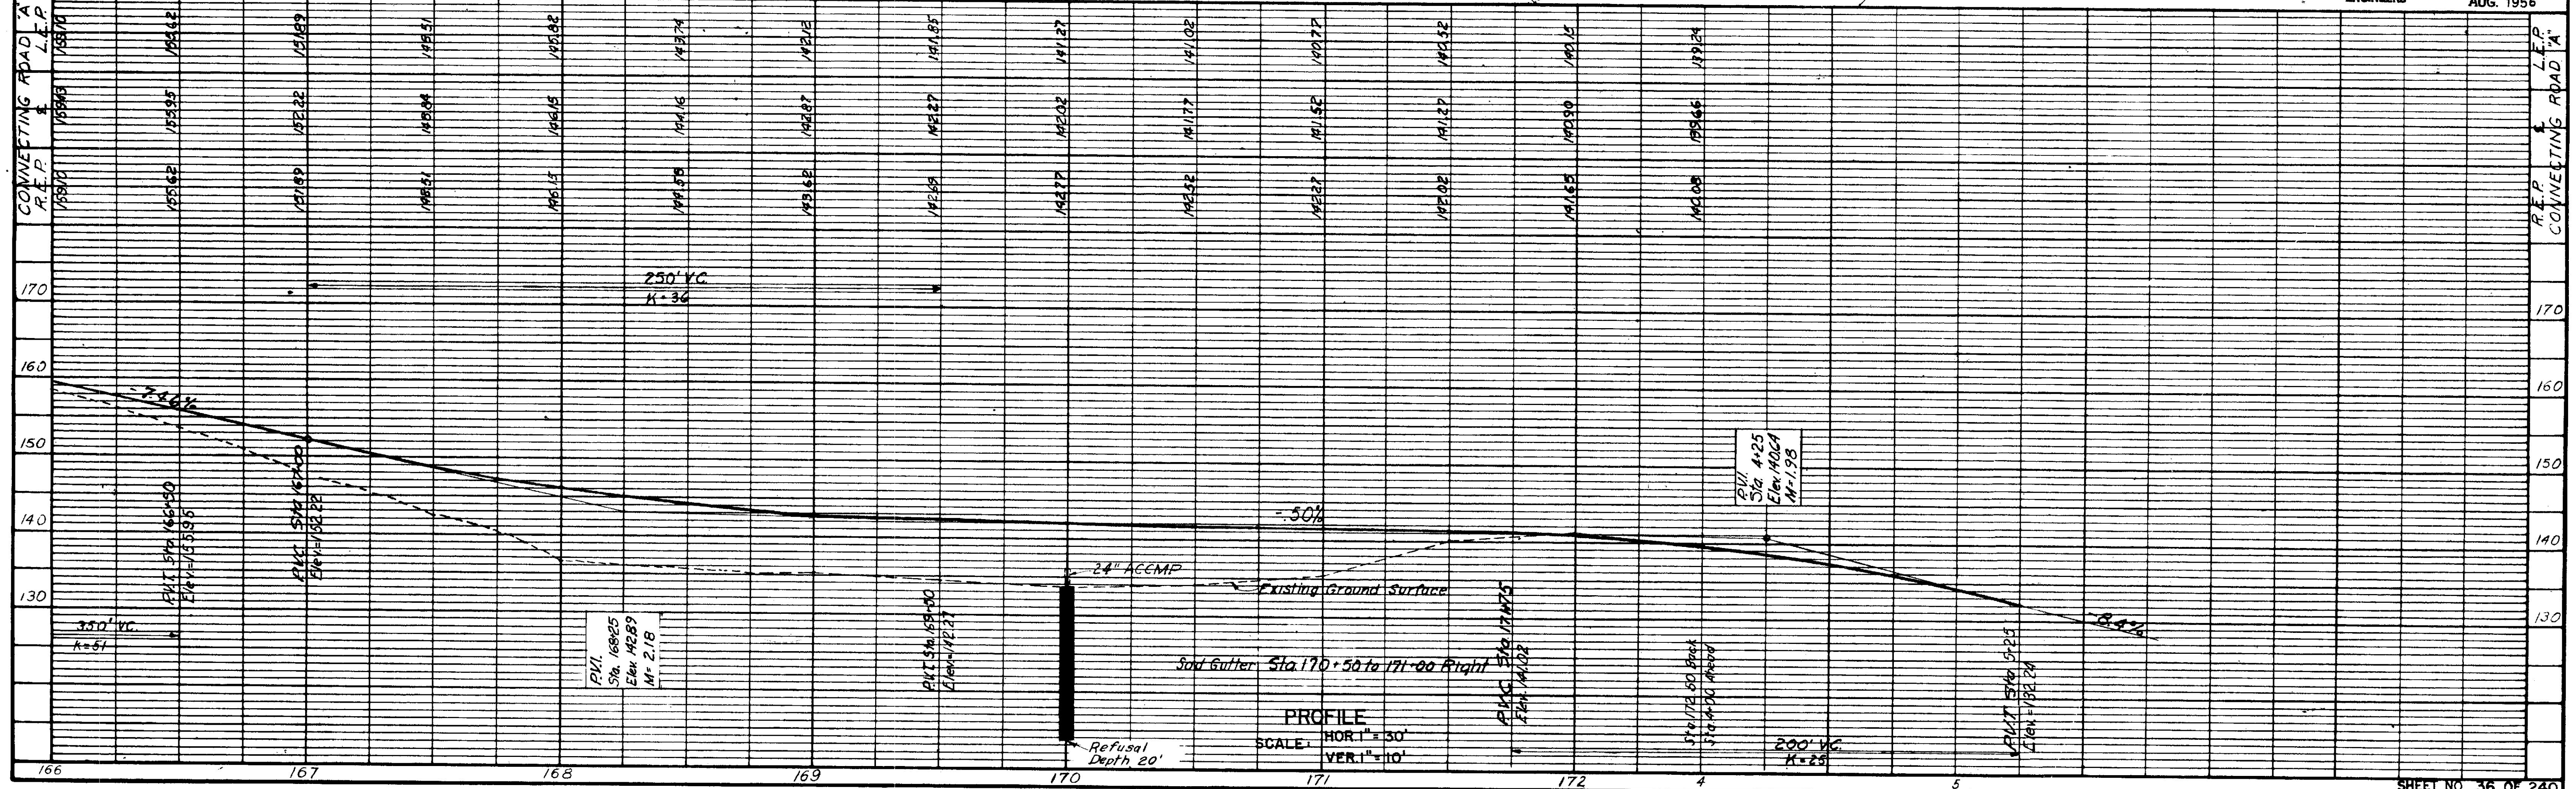



PROFILE  
SCALE: HOR. 1" = 30'  
VER. 1" = 10'



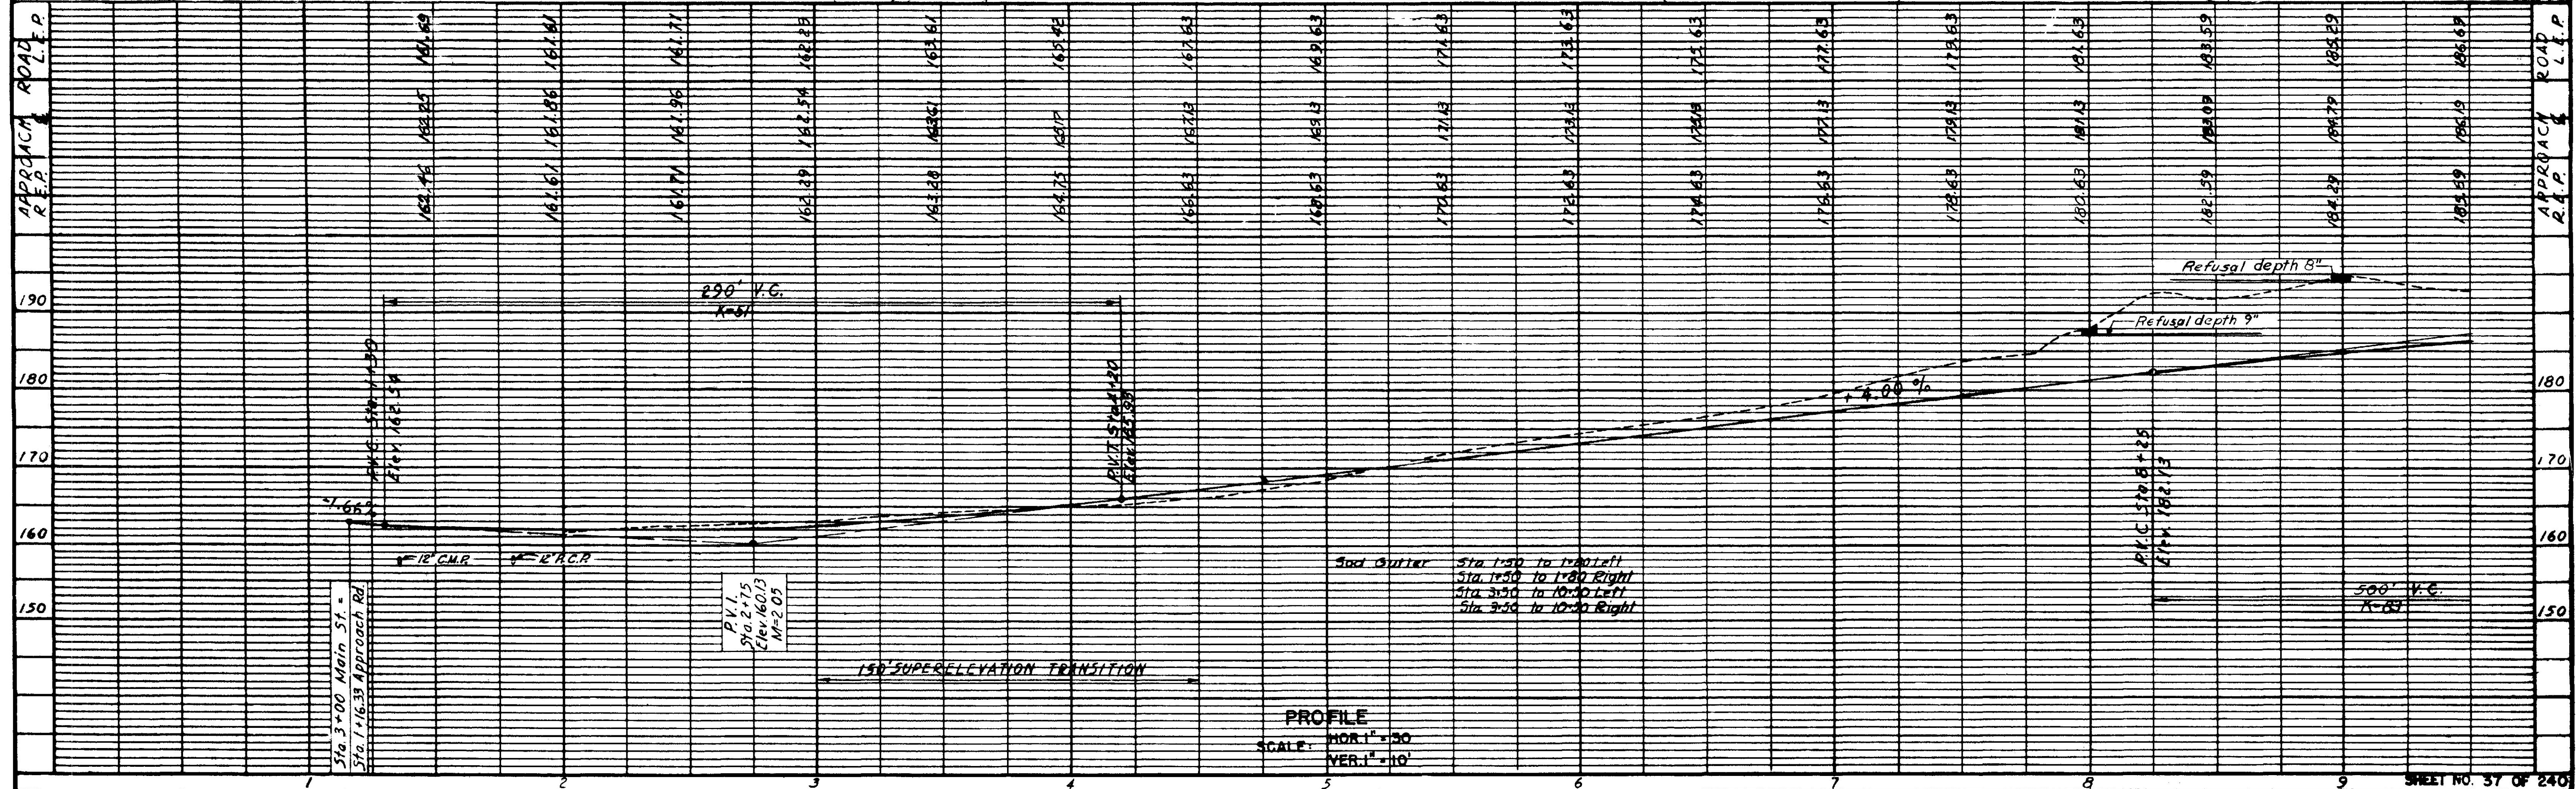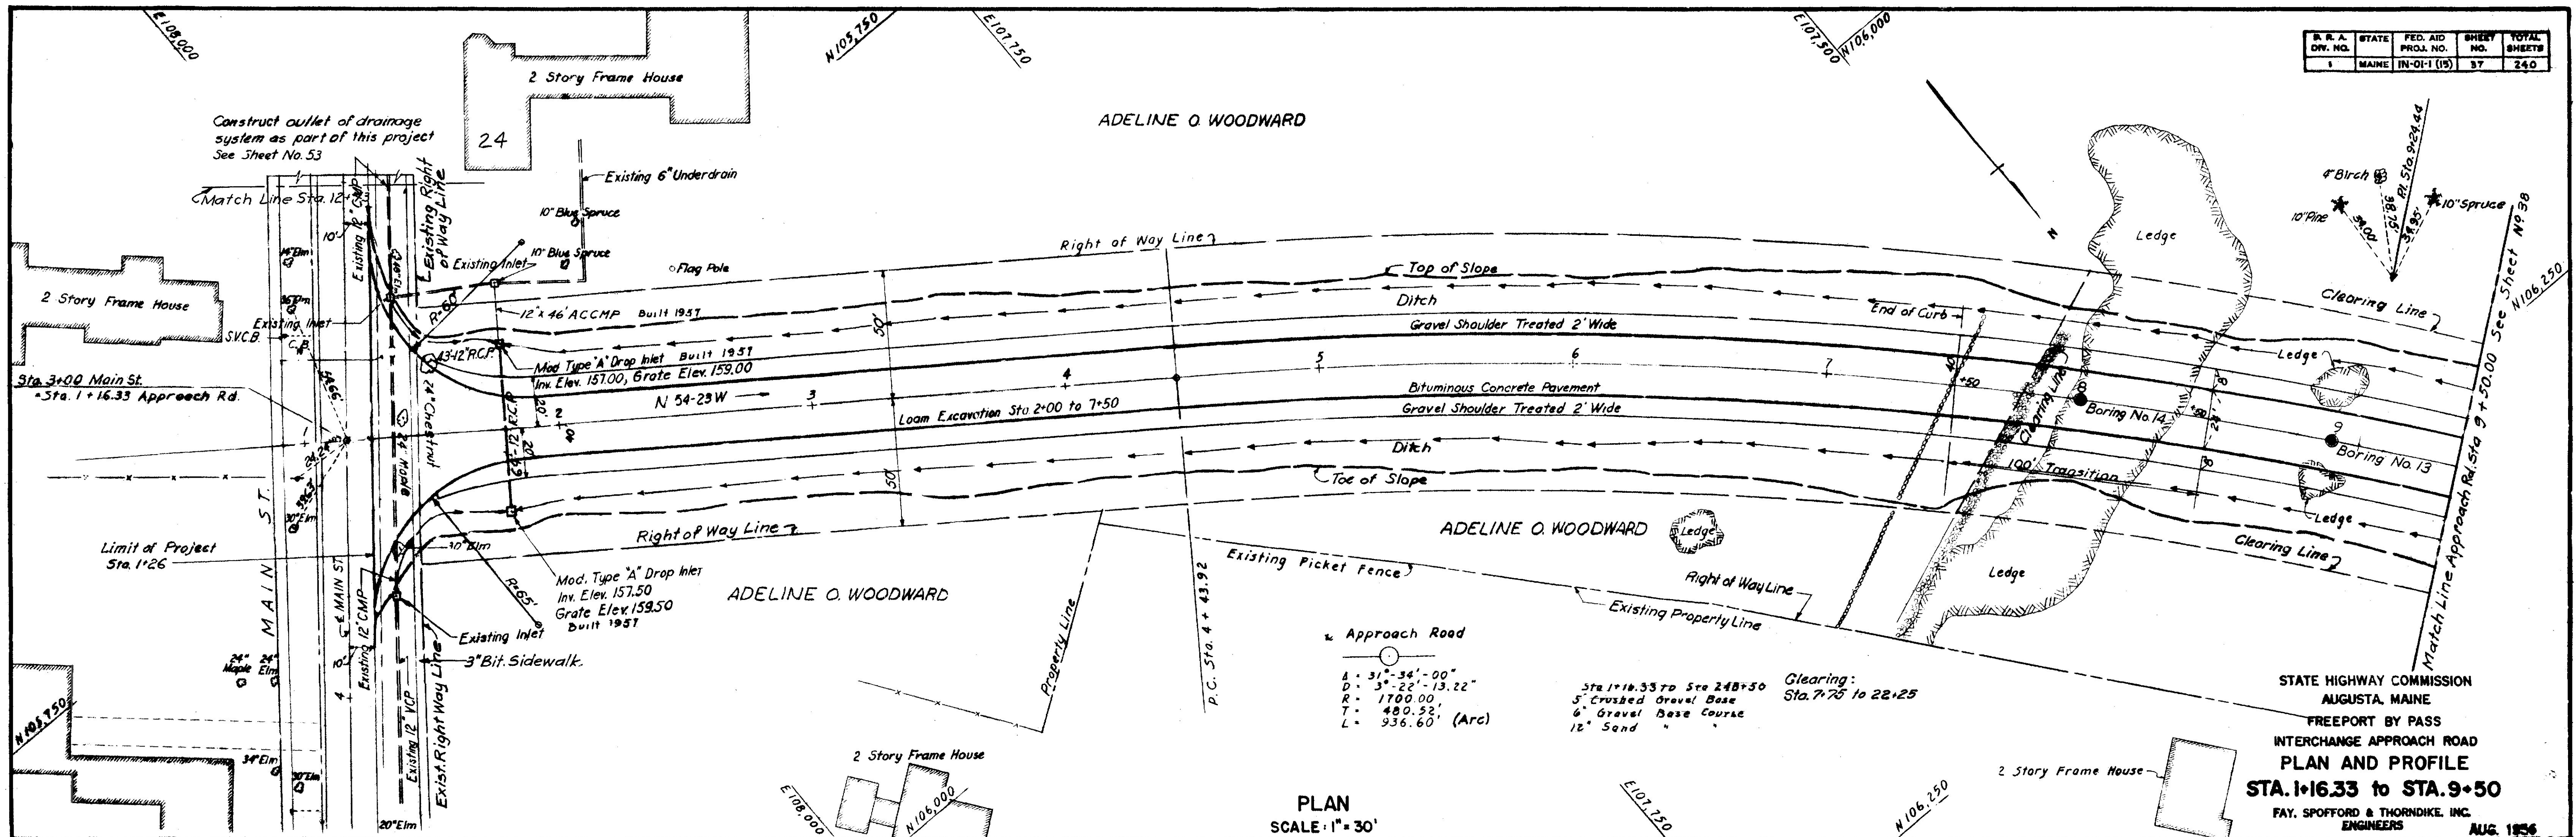





R. R. A. OFF. NO.	STATE	FED. AID PROJ. NO.	SHEET NO.	TOTAL SHEETS
1	MAINE	IN-01-1 (15)	37	240

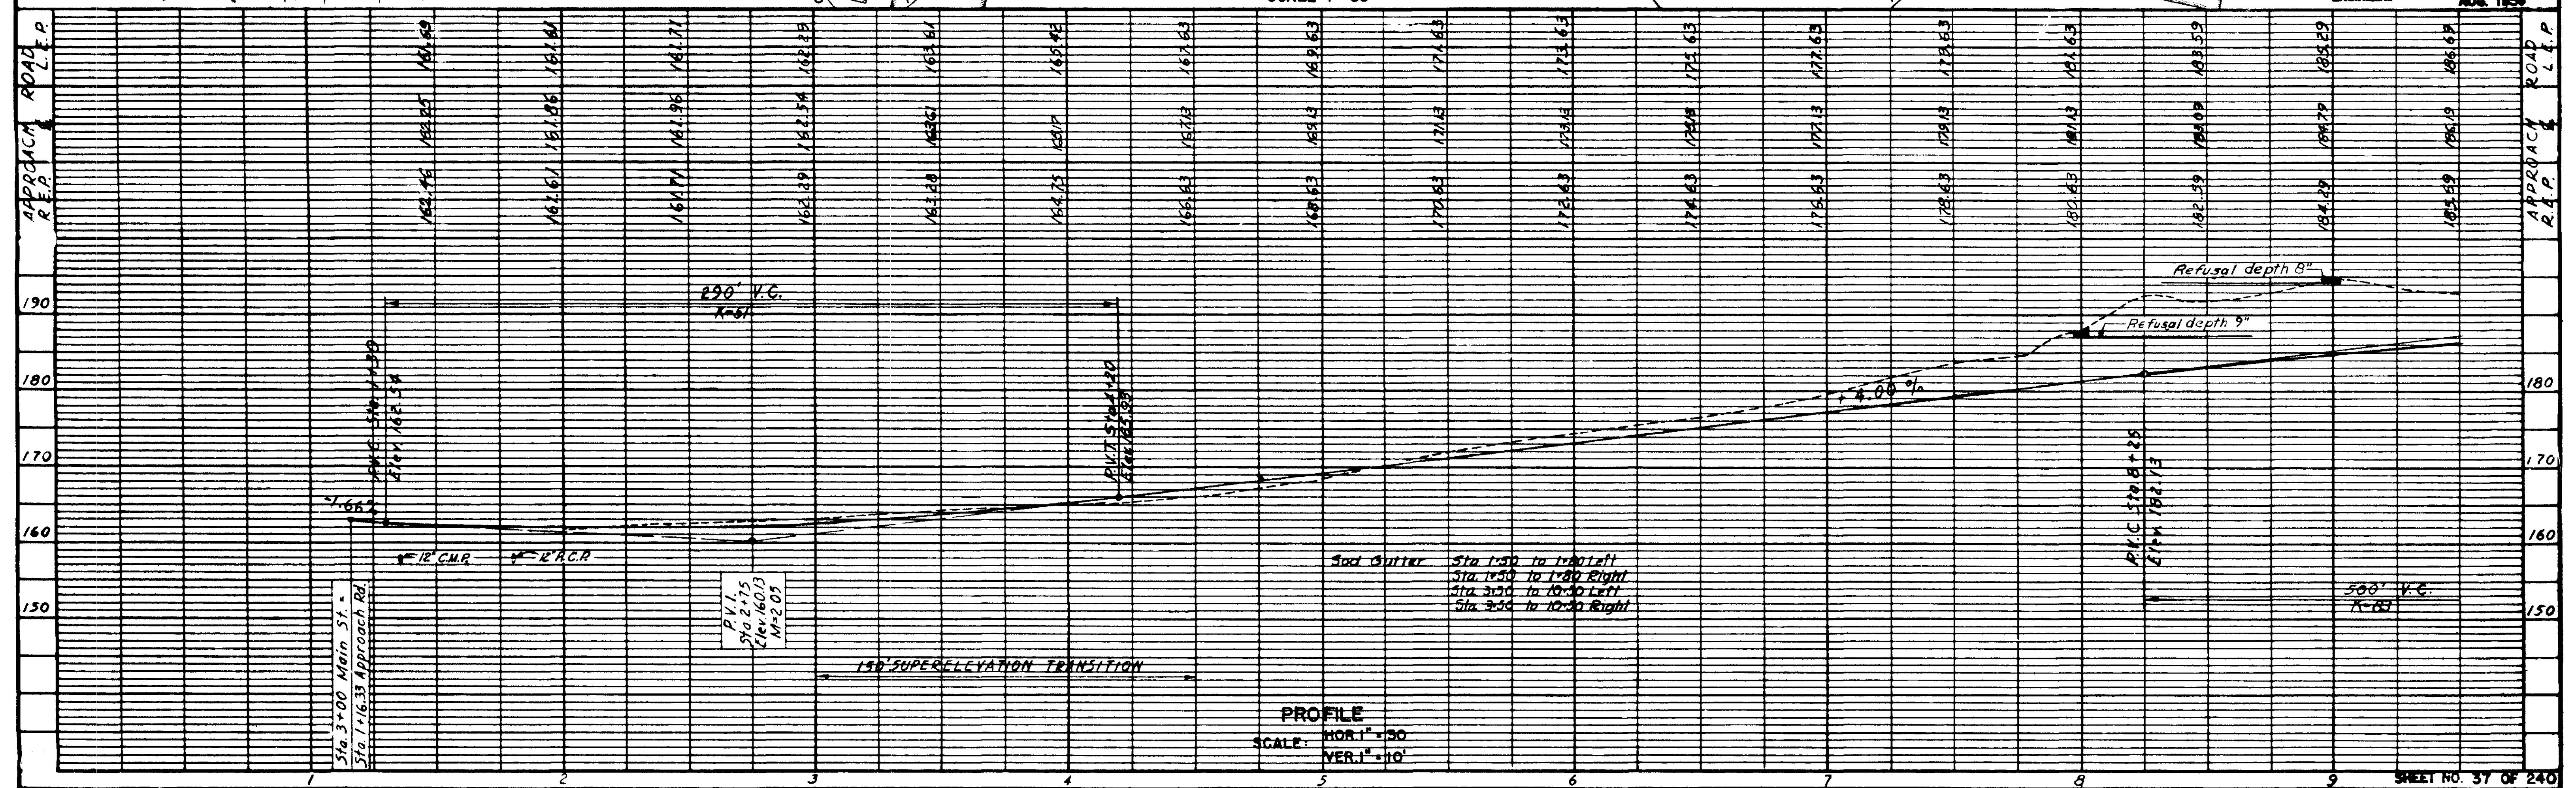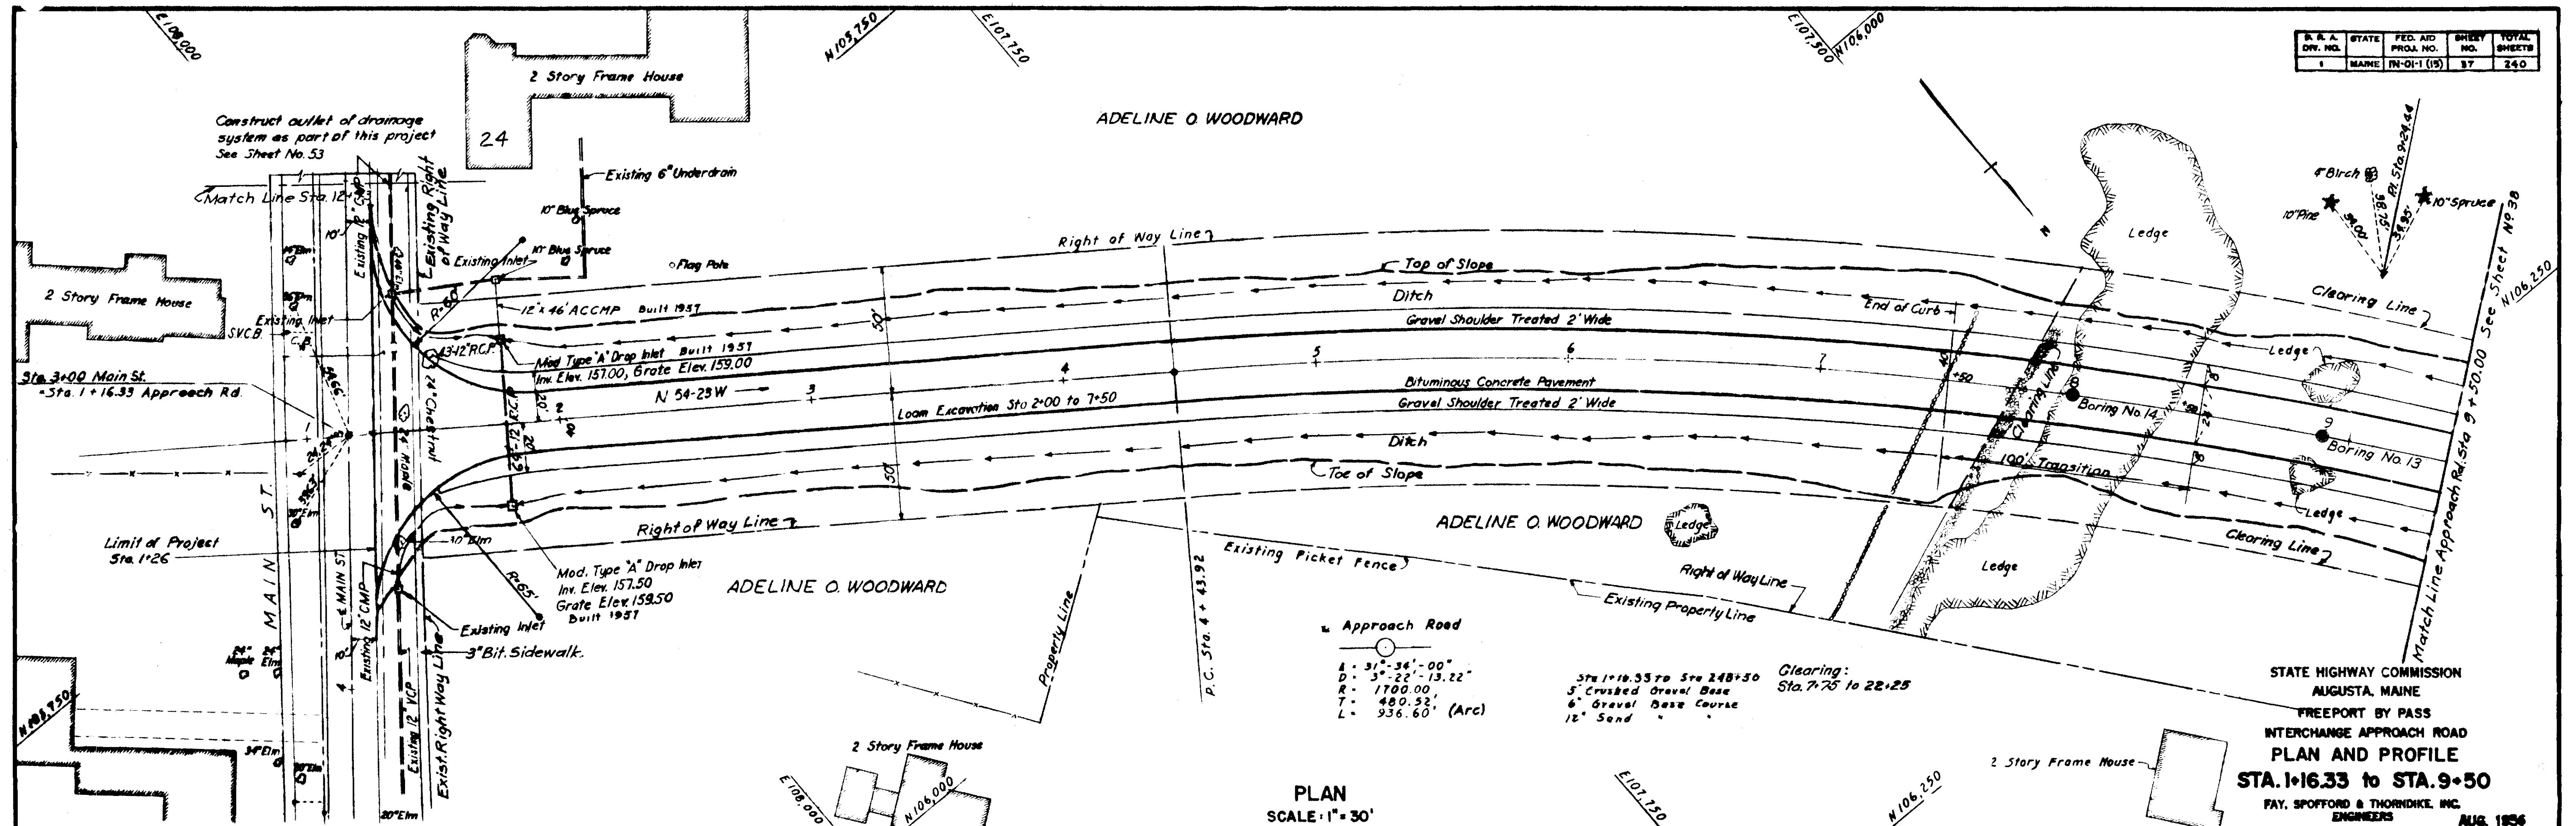




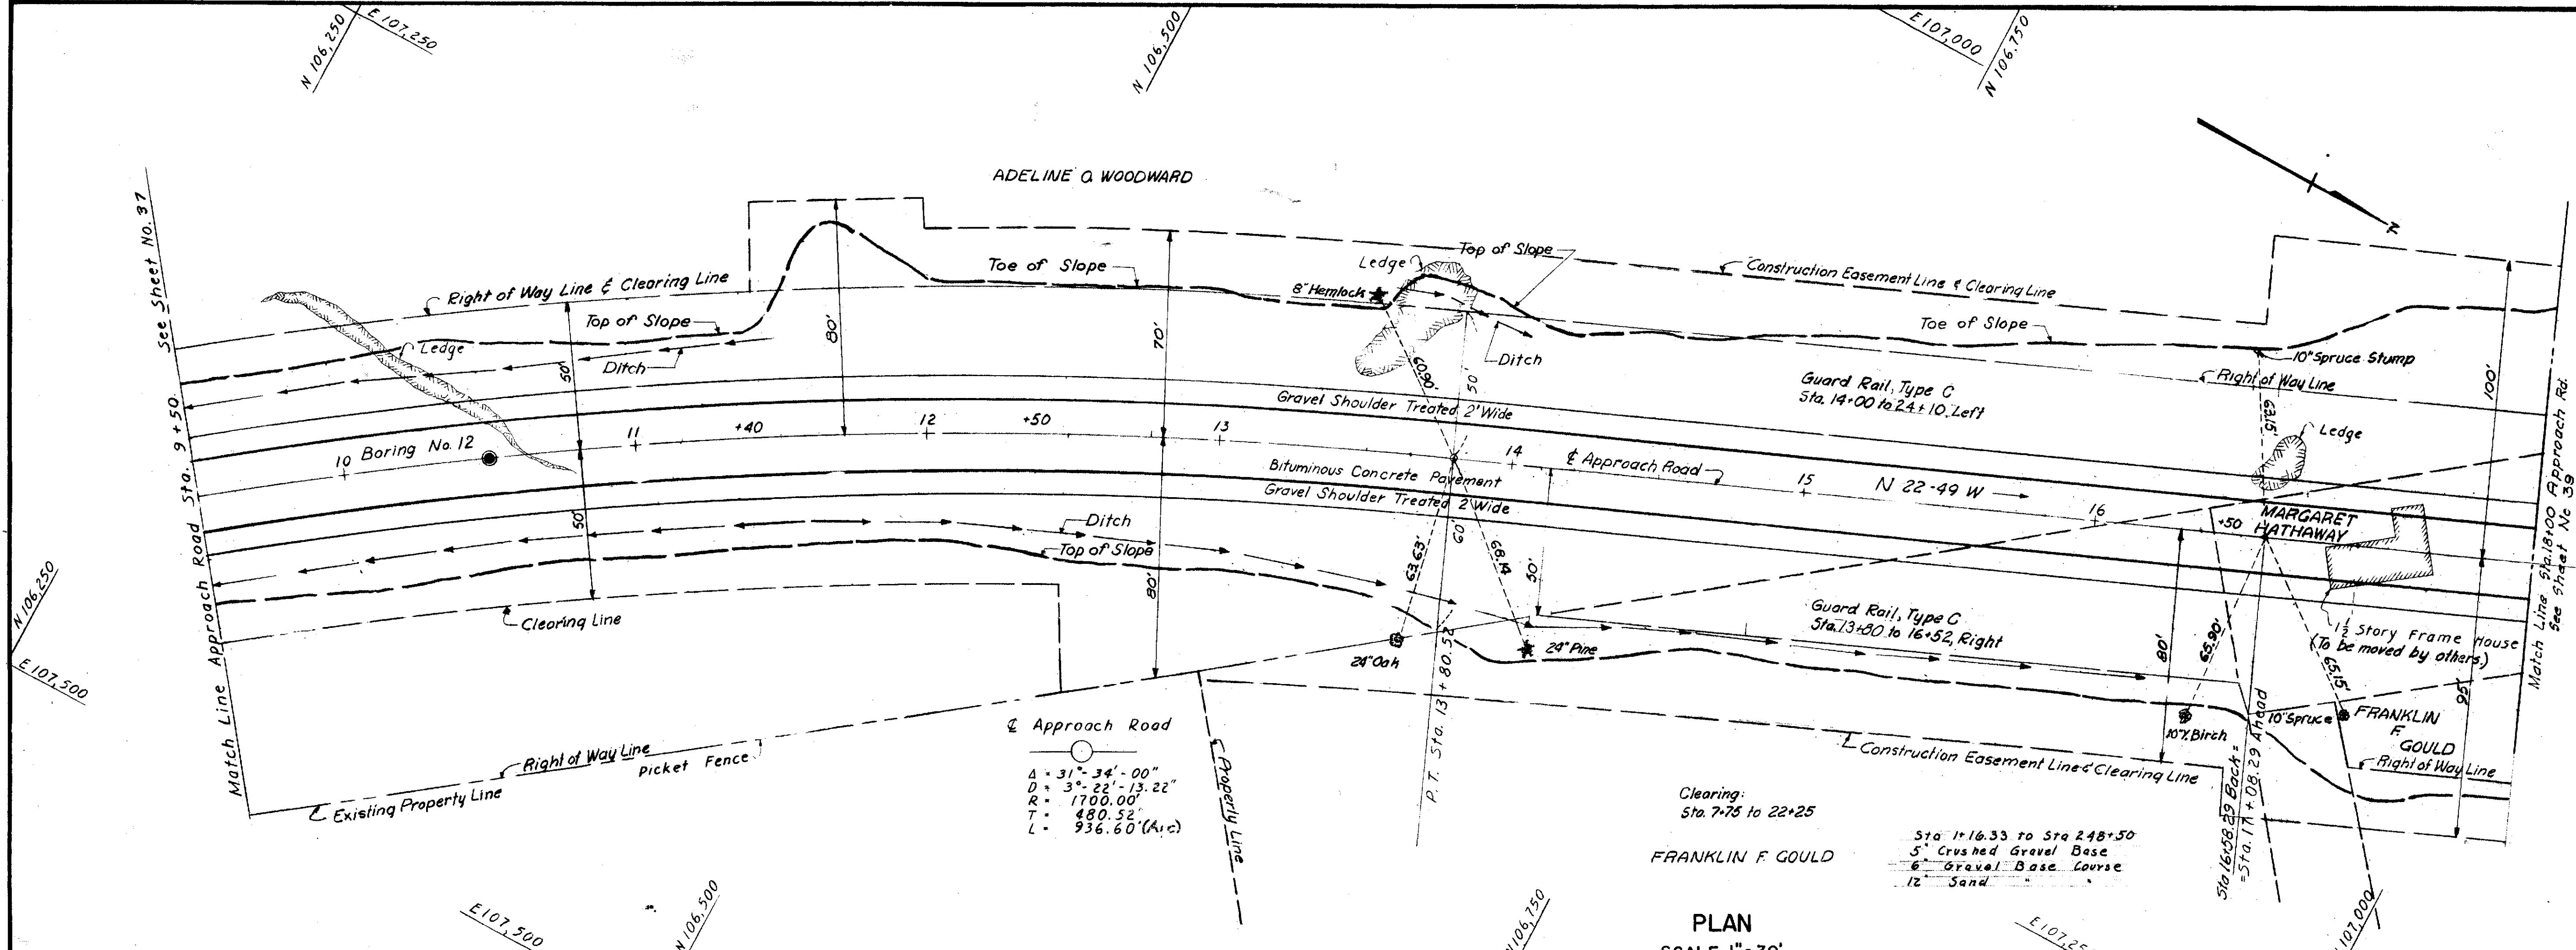

STATE HIGHWAY COMMISSION  
 AUGUSTA, MAINE  
 FREEPORT BY PASS  
 INTERCHANGE APPROACH ROAD  
 PLAN AND PROFILE  
 STA. 9+50 to STA. 18+00  
 FAY, SPOFFORD & THORNDIKE, INC.  
 ENGINEERS  
 AUG 1956

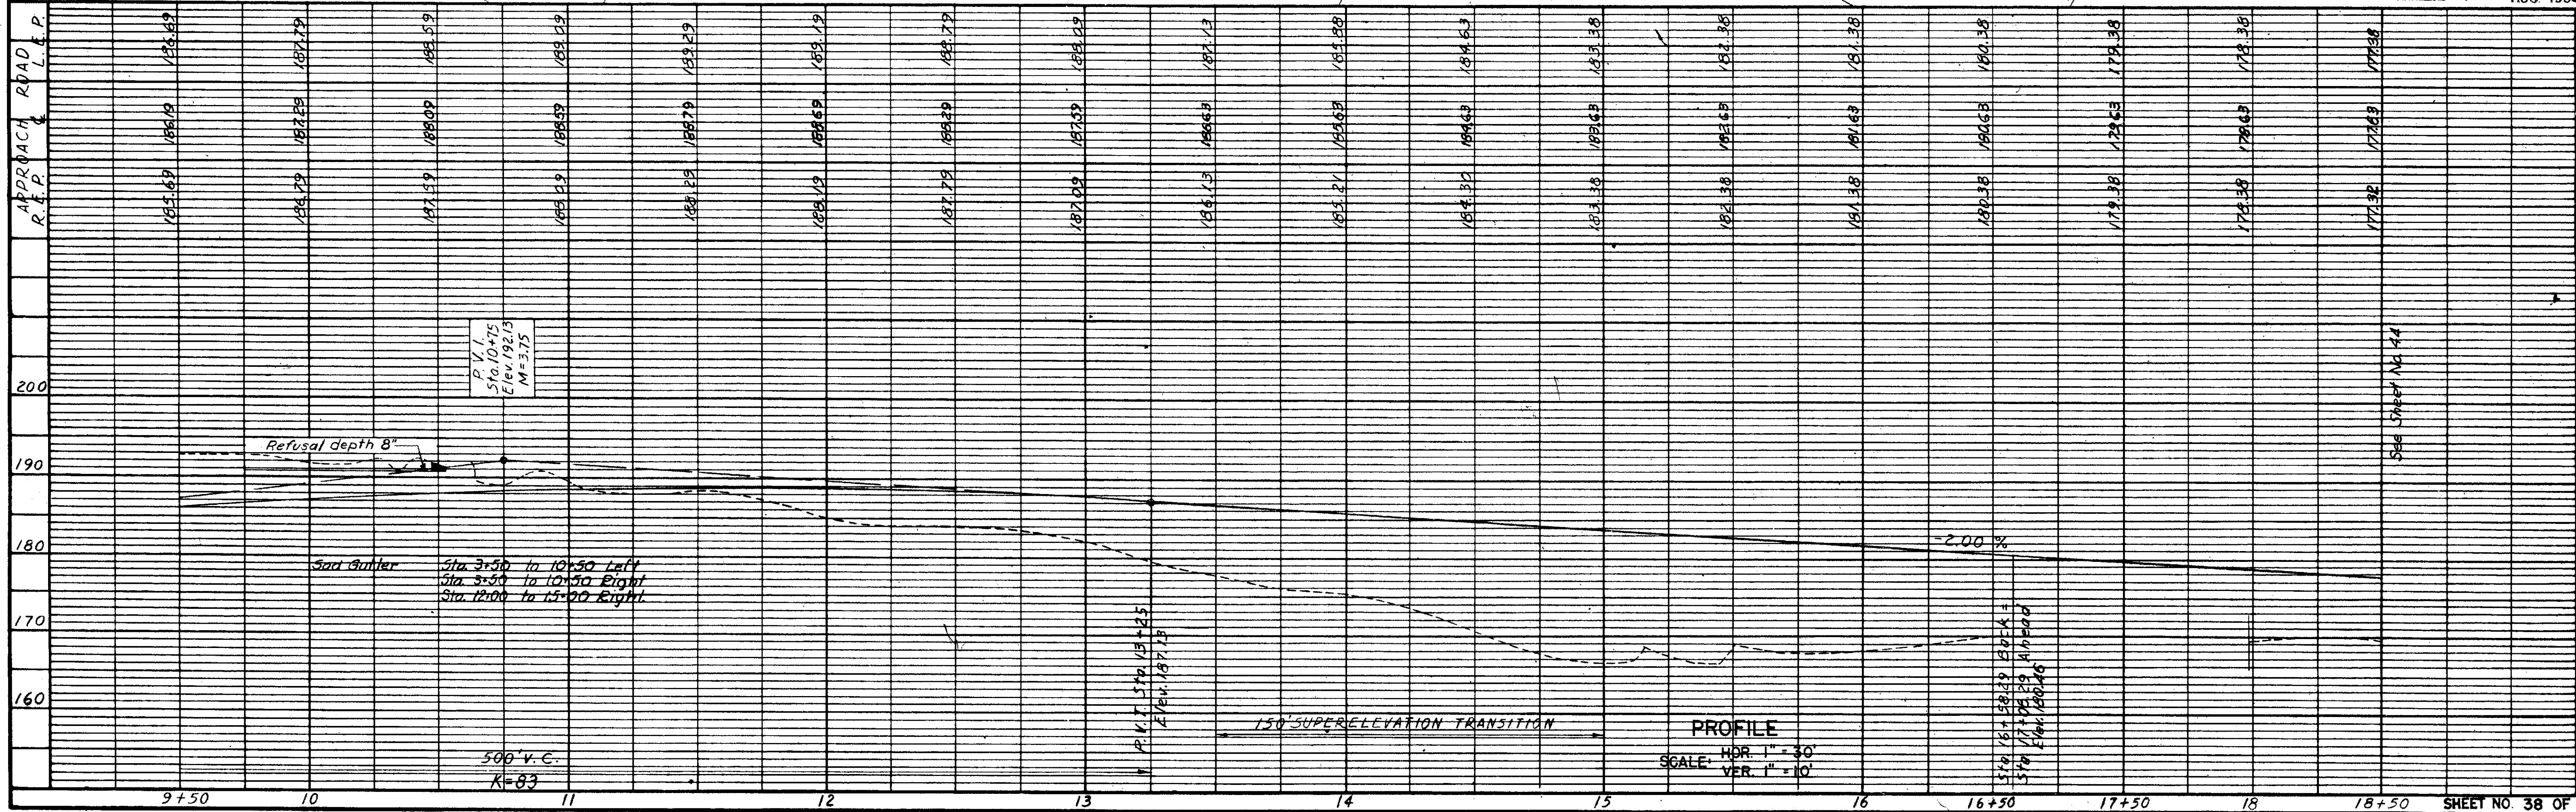



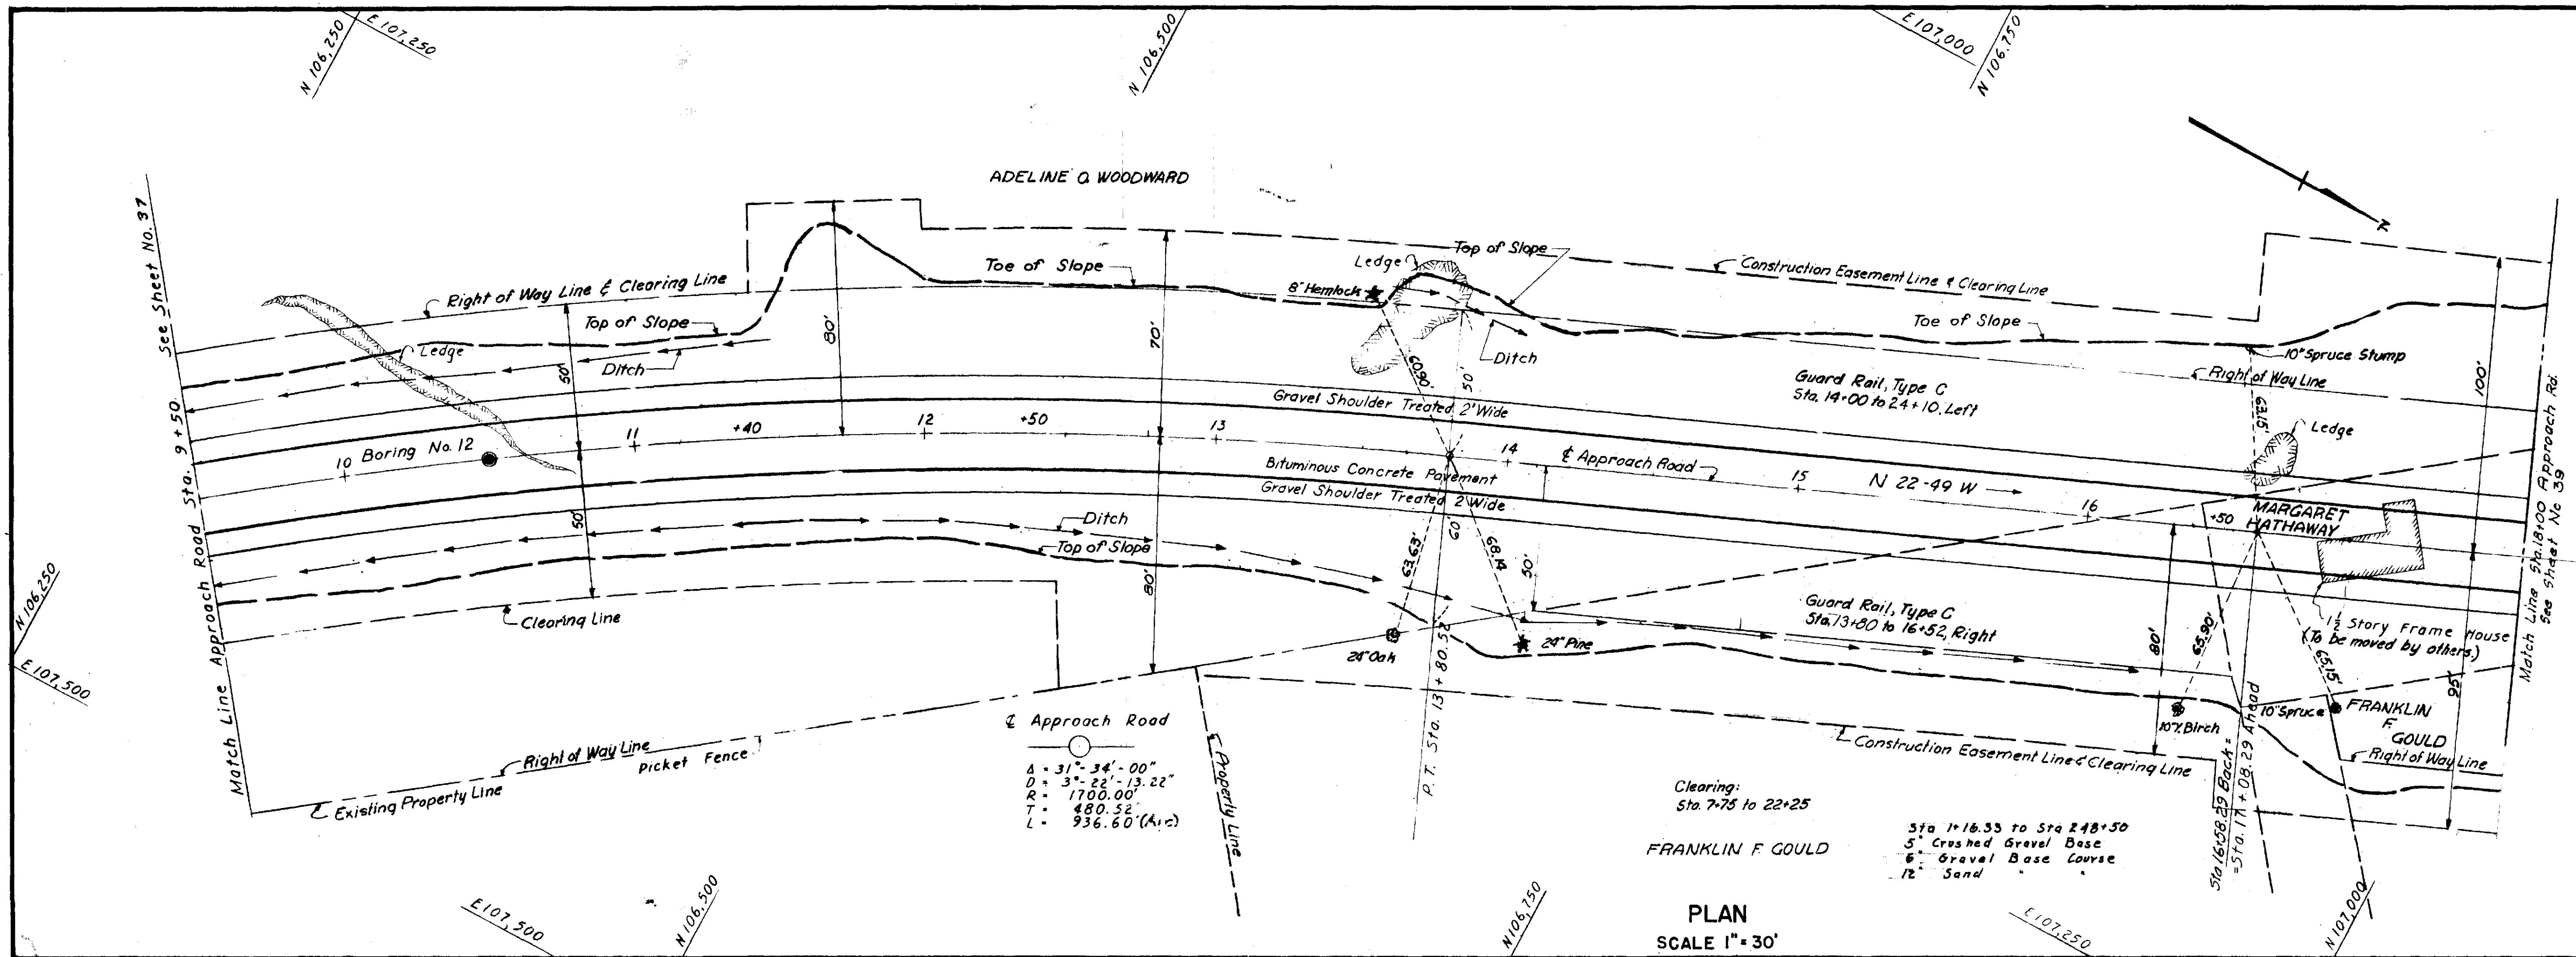

STATE HIGHWAY COMMISSION  
AUGUSTA, MAINE  
FREEPORT BY PASS  
INTERCHANGE APPROACH ROAD  
PLAN AND PROFILE  
STA. 9+50 to STA. 18+00  
FAY, SPOFFORD & THORNDIKE, INC.  
ENGINEERS  
AUG 1956

