
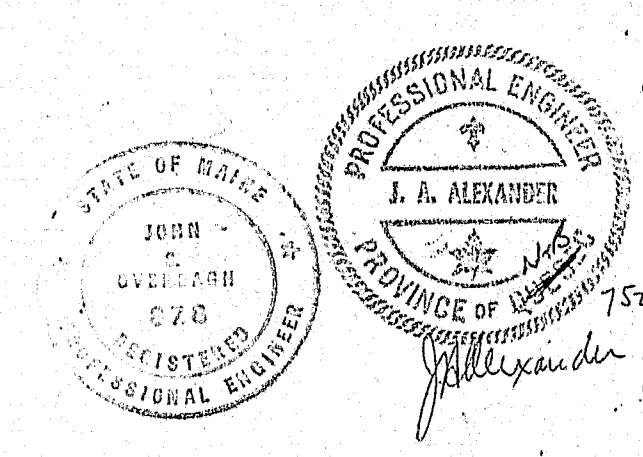
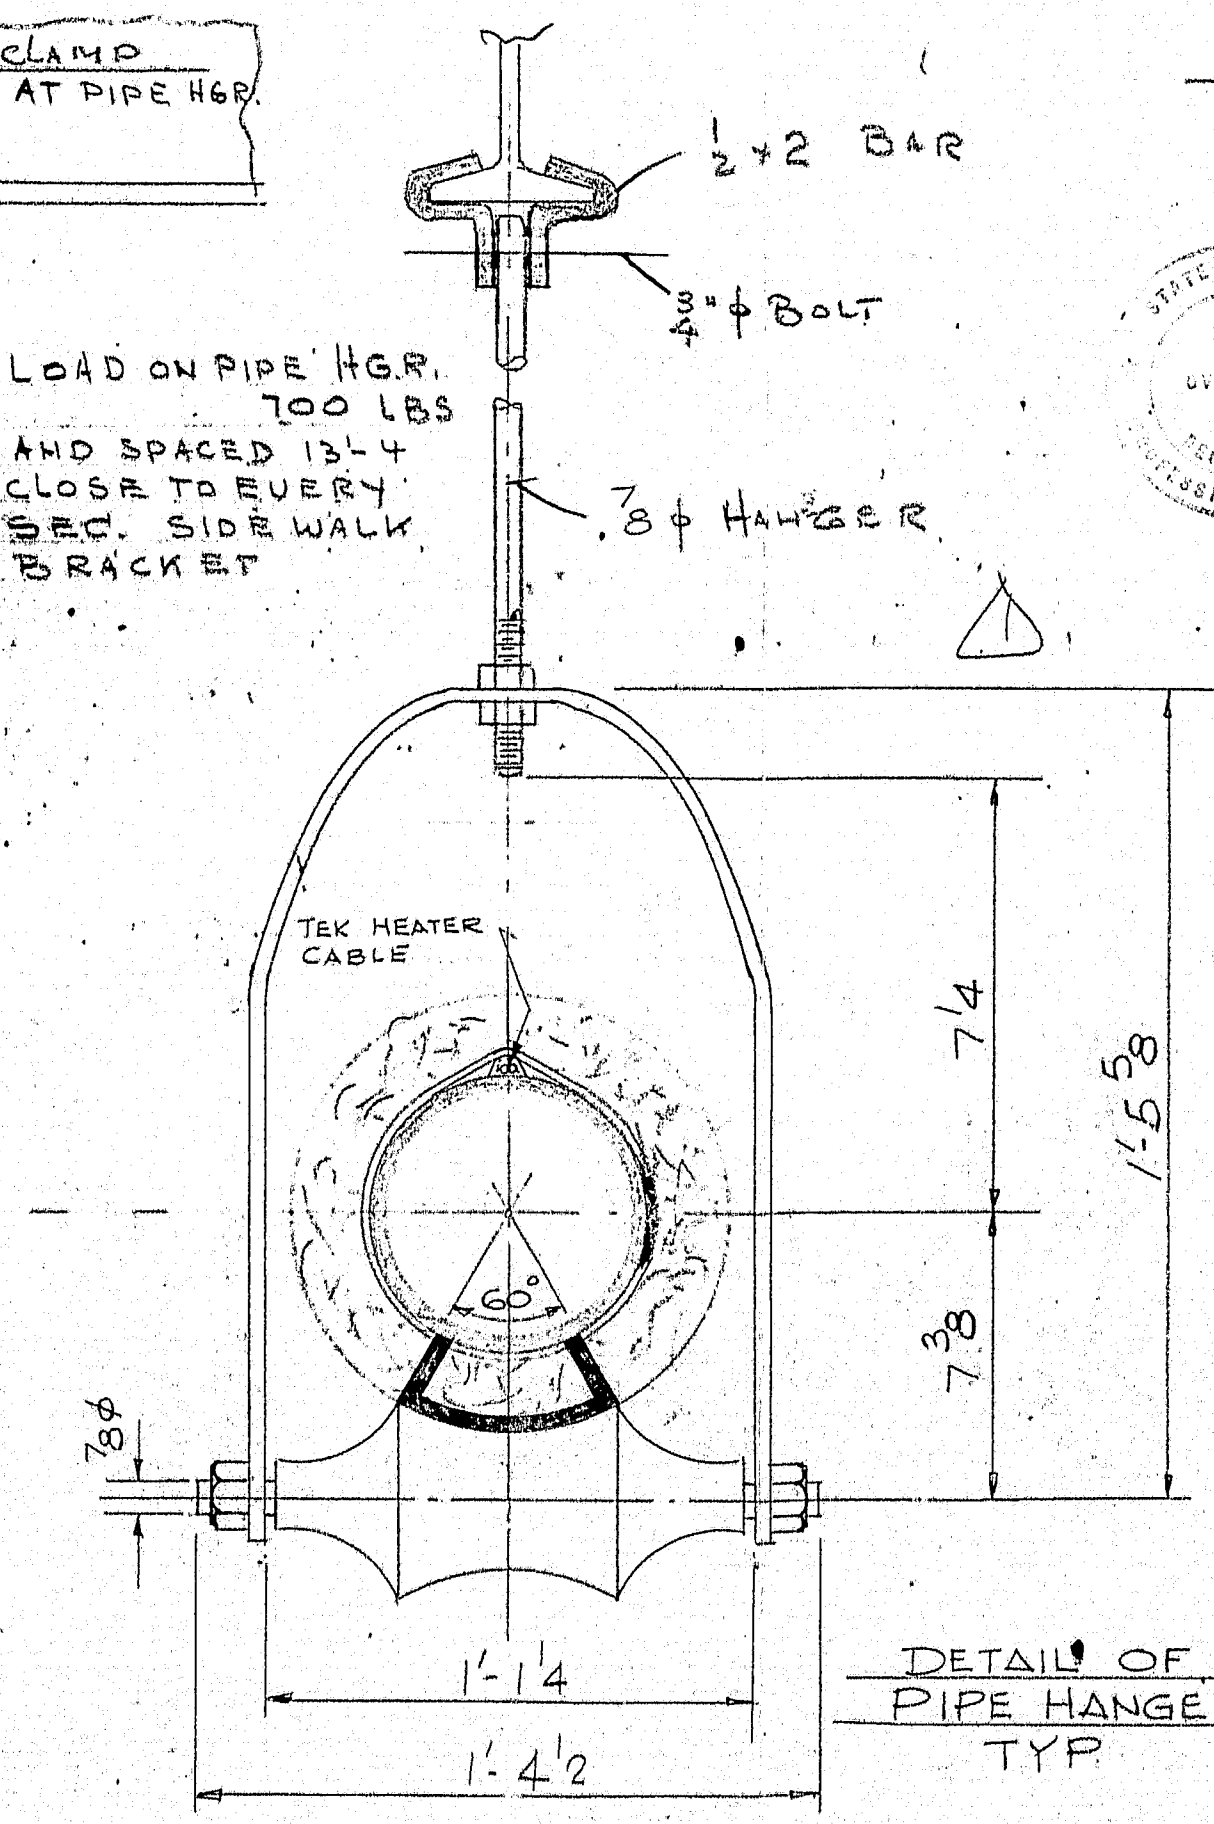


**NOTES**

6" OIL LINE TO CONSIST OF 6" SCH. 40 PIPE API SL GRD. A OR B SEAMLESS OR ERW STEEL PIPE WITH 550 VOLT EL. TRACER AND 2" OF THERMOBESTOS INSULATION WATERPROOFED W/STEEL-304 CLADDING.

LINE CONTENTS BUNGER "C" 180° FLASH WORKG. PRESSURE 150 PSIG @ 140°-150° F.

TOTAL WT. PER FOOT LINE ~ 48 LBS

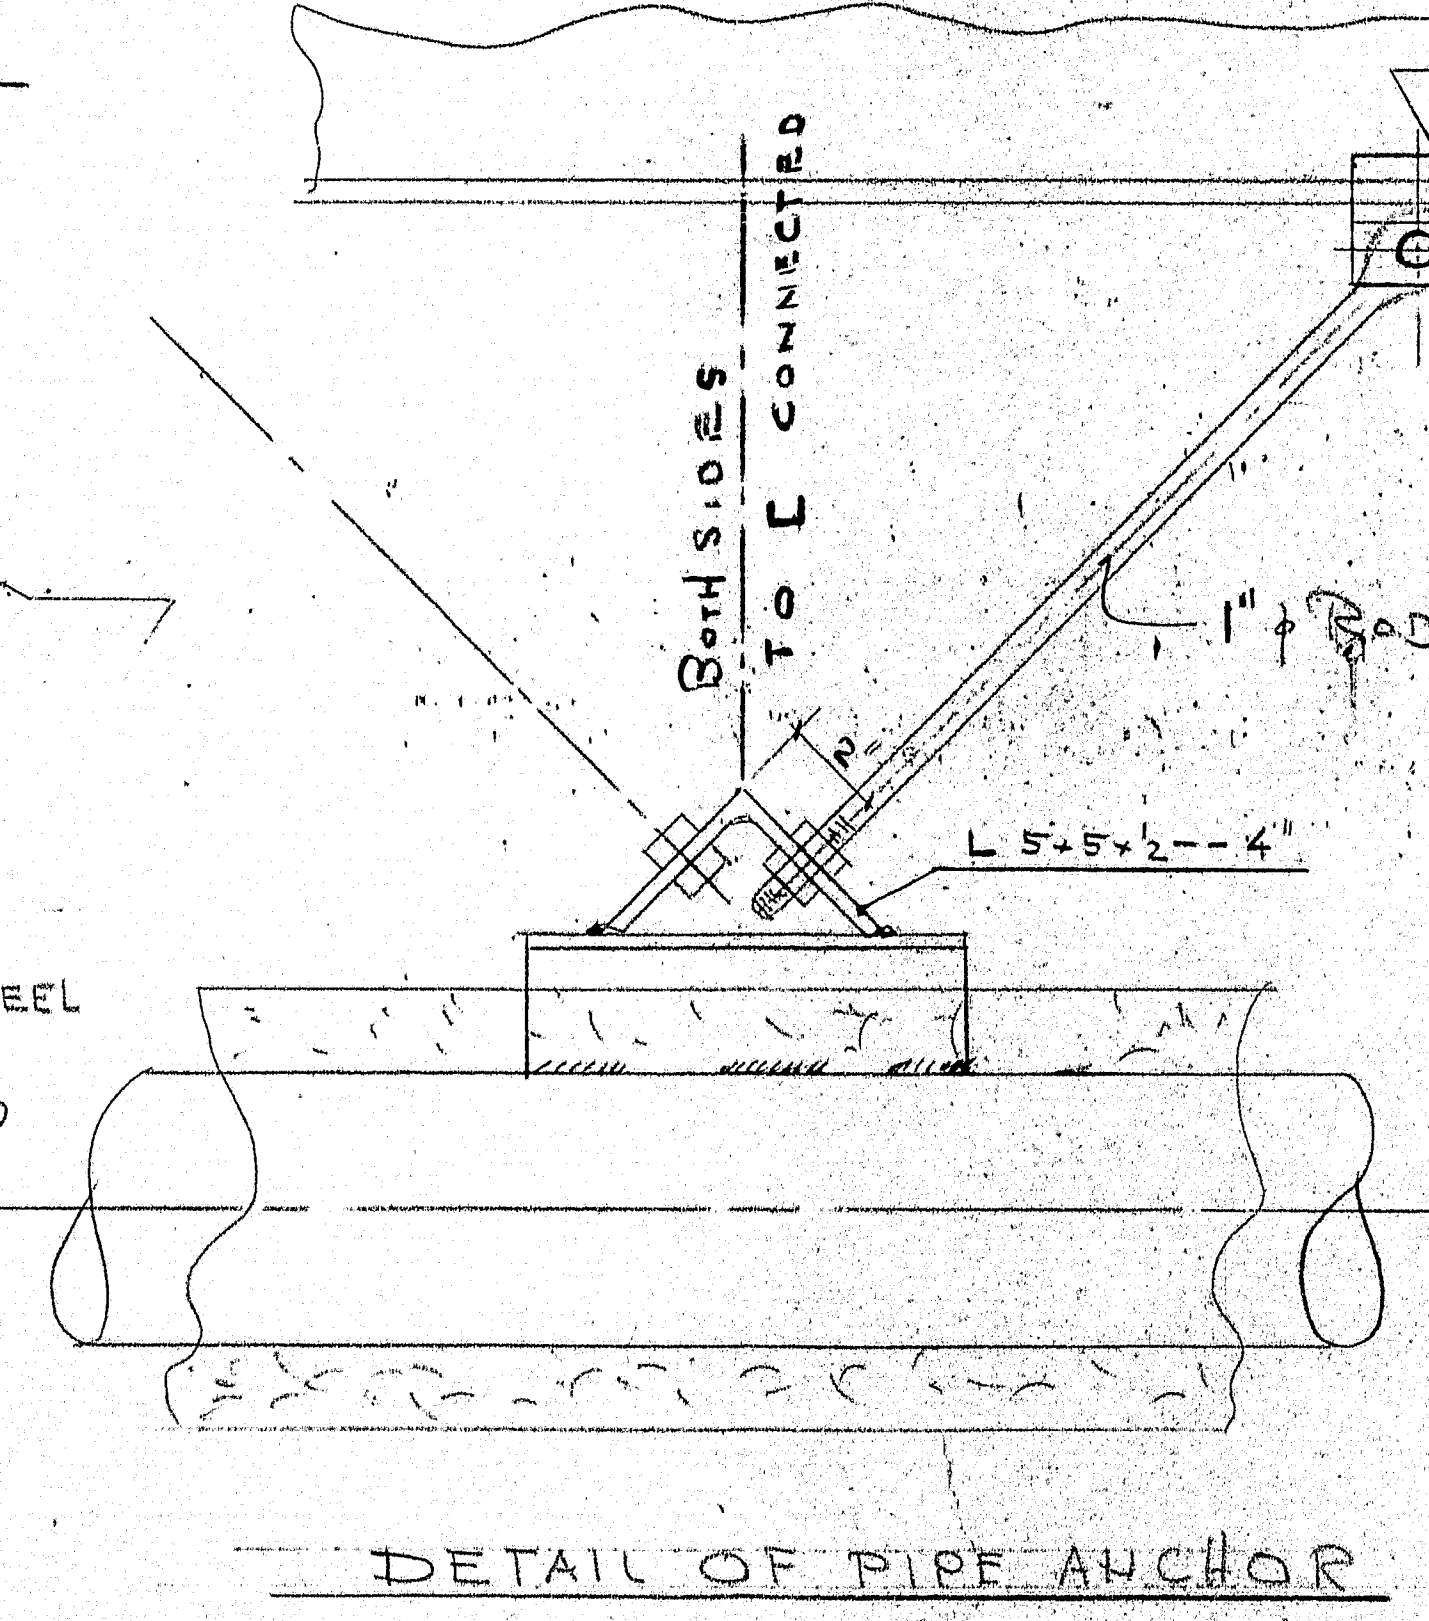

HANGER REVISED		FEB 27/70 D.F.	
NO.	REVISION	DATE	BY
MATERIAL		FIELD BOLTS	
PAINT			
HOLES			
DRAWN	JAN. 70		
CHECKED	FEB 27/70		
APPROVED	FEB 27/70	REF. DRWG.	
ARCH. OR CORR. ENG.		CUSTOMER:	
		FEASER CO. LTD.	
		EDMUNDSTON, N.B.	
<p>THIS PRINT IS THE PROPERTY OF OCEAN STEEL &amp; CONSTRUCTION LTD. AND IS LOANED WITHOUT OTHER CONSIDERATION THAN THE AGREEMENT AND THE CONDITION THAT IT IS NOT REPRODUCED, COPIED OR OTHERWISE DISPOSED OF, DIRECTLY OR INDIRECTLY, AND IS NOT TO BE USED IN WHOLE OR IN PART TO ASSIST IN MAKING OR TO FURNISH ANY INFORMATION FOR THE MAKING OF DRAWINGS, PRINTS, APPARATUS OR PARTS THEREOF.</p> <p>THE ACCEPTANCE OF THIS PRINT WILL BE CONSIDERED AS AN ACCEPTANCE OF THE FOREGOING CONDITIONS AND AS AN ADMISSION OF THE EXCLUSIVE OWNERSHIP OF OCEAN STEEL &amp; CONSTRUCTION LTD. IN AND TO THE PRINT WHICH IS SUBJECT TO RETURN UPON DEMAND.</p>			
OCEAN STEEL & CONSTRUCTION LTD. SAINT JOHN, NEW BRUNSWICK.			
PROPOSED 6" OIL LINE OVER MADAWASKA BRIDGE		CONTRACT NO. E-315	Rev.
		Drawn No. P-1	



CANADA

UNITED STATES

6" DIA. OIL LINE WITH 2" INSULATION  
TOTAL WEIGHT PER FOOT = 55 LBS

15'-0" x 15'-0" EXPANSION LOOP

15'-0" x 15'-0" EXPANSION LOOP

PLAN OF PROPOSED LOCATION OF 6"  $\phi$  OIL LINE

TRUSS

TRUSS

STANDARD I BEAM CLAMP  
ROD HANGERS  
STANDARD PIPE CLAMP

AT EXPANSION LOOPS  
PIPE TO HAVE STAINLESS STEEL CLADDING TO ENSURE WEATHER PROOFING UNDER ROAD SURFACE

HANGERS TO BE SPACED AT 20'-0" C/L APPROX. AND LOCATED AS CLOSE AS POSSIBLE TO CANTILEVERED SIDEWALK SUPPORT BRACKETS

SECTION A-A

THIS PRINT IS THE PROPERTY OF FERRO-CHEMI-CRETE ENGINEERING LIMITED, AND IS LOANED WITHOUT OTHER CONSIDERATION THAN THE AGREEMENT AND THE CONDITION THAT IT IS NOT REPRODUCED, COPIED OR OTHERWISE DISPOSED OF, DIRECTLY OR INDIRECTLY, AND IS NOT TO BE USED IN WHOLE OR IN PART TO ASSIST IN MAKING OR TO FURNISH ANY INFORMATION FOR THE MAKING OF DRAWINGS, PRINTS, APPARATUS OR PARTS THEREOF. THE ACCEPTANCE OF THIS PRINT WILL BE CONSTRUED AS AN ACCEPTANCE OF THE FOREGOING CONDITIONS AND AS AN ADMISSION OF THE EXCLUSIVE OWNERSHIP OF FERRO-CHEMI-CRETE ENGINEERING LIMITED IN AND TO THE PRINT WHICH IS SUBJECT TO RETURN UPON DEMAND.

CUSTOMER:  
FERRIS PAPER CO.

ARCHT. OR CONS. ENG.  
F.C.C.

NO. \_\_\_\_\_ REVISION \_\_\_\_\_ DATE \_\_\_\_\_ BY \_\_\_\_\_ CHKD \_\_\_\_\_ APPVD \_\_\_\_\_

DATE \_\_\_\_\_ DRW. \_\_\_\_\_ CHECKED \_\_\_\_\_ APPR. \_\_\_\_\_

FERRO-CHEMI-CRETE ENGINEERING LIMITED  
408 GRESLEY STREET SAINT JOHN, N. B.

PROPOSED 6"  $\phi$  OIL LINE  

CONTRACT NO. \_\_\_\_\_  
DRWG. NO. 132:189