

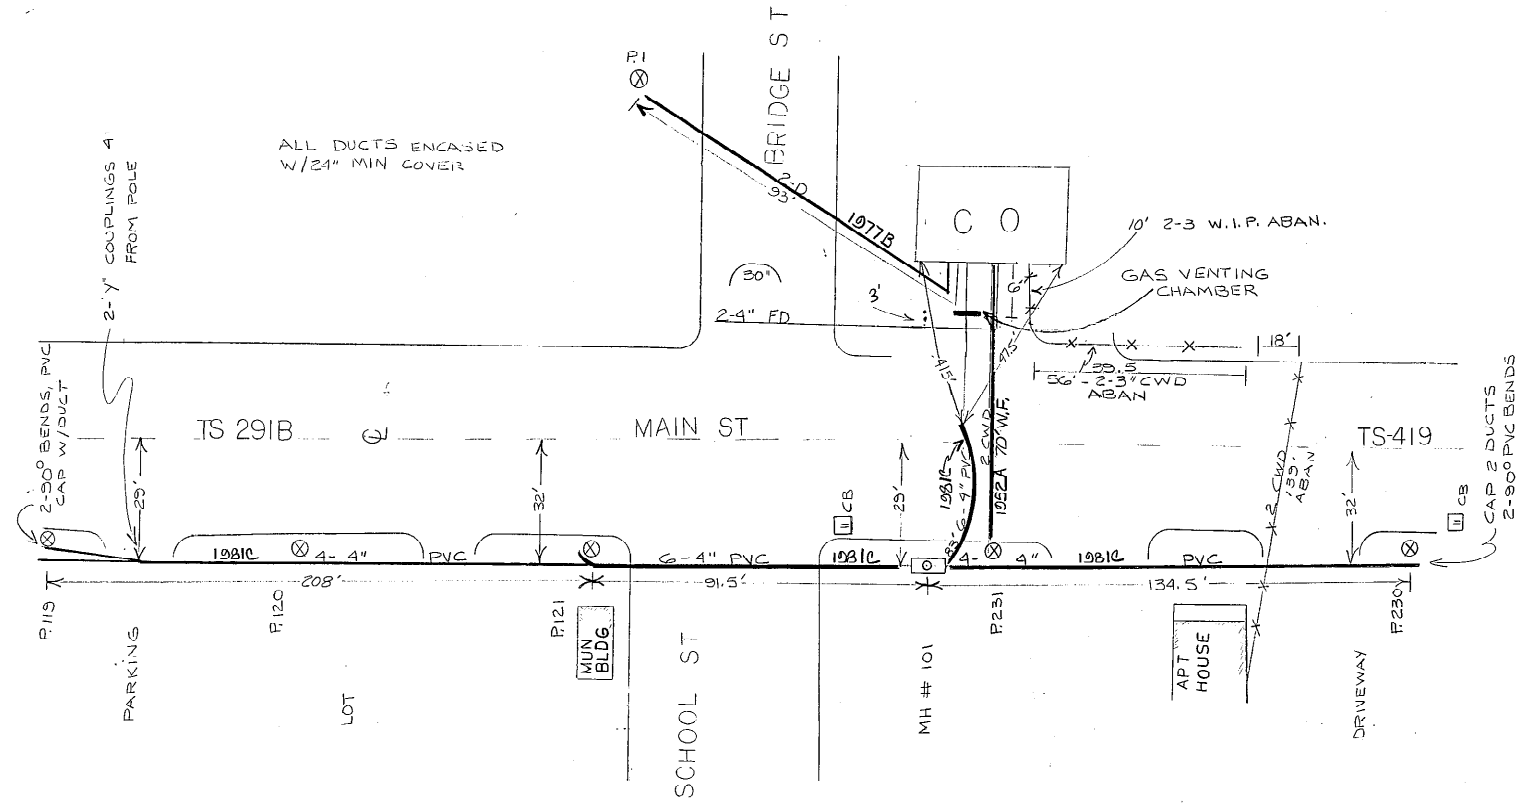


| IN EFFECT |             |             |     |
|-----------|-------------|-------------|-----|
| CORRECTED |             |             |     |
| Order No. | Date Issued | Date Posted | By  |
| D-2530    |             | 2-22-39     |     |
| E-9308    | A           | 4-22-55     |     |
| 928274    | B           | 3-31-70     | LMR |
| 217947    | C           | 3-3-82      | LMR |
|           | DM          | 3-31-82     |     |

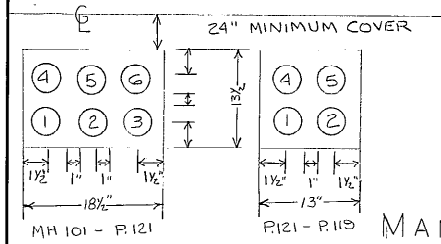

NOTE: 4' WIDE SIDEWALK  
 W/6' SLOPE TO EDGE  
 OF STREET

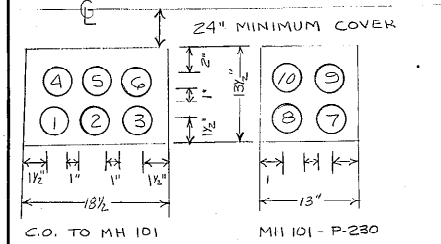

MANHOLES

MAIN CONDUIT


LATERALS

| M. H. | INSIDE WIDTHS<br>L. W. HD. DIA. | MIN. OPENING | SHAPE | EXCESS AT DUCTS | TOTAL DEPTH EXCAV. | WALLS | ROOF | FLOOR | OUTER COVER<br>SHAPE | WT. | WT. INSIDE COVER | WT. FRAME | DRAIN      | DATE | SPECIAL CONST.      |
|-------|---------------------------------|--------------|-------|-----------------|--------------------|-------|------|-------|----------------------|-----|------------------|-----------|------------|------|---------------------|
| 101   | 12'x6'x7'                       | 30           | 0     | NO              | 13'2"              | 5"    | 6"   | 5"    | O                    | NO  |                  |           | 2<br>SUMPS |      | 387-4046-1<br>TYP A |

| FROM M. H. | TO AND INCL. M. H. | ORIGINAL PAYE | SUB SURFACE | DATE | REMARKS   |
|------------|--------------------|---------------|-------------|------|-----------|
| C.O.       | POLE               | DIRT          | DIRT        | 1916 | ABAN 1935 |
| C.O.       | 101                | BIT CON       | GRAV        | 1981 |           |
| 101        | P230               | BIT CON       | GRAV        | 1981 |           |
| 101        | P119               | BIT CON       | GRAV        | 1981 |           |

| No. | ORIGINAL PAVE | SUB SURFACE | DATE | REMARKS         |
|-----|---------------|-------------|------|-----------------|
| 1   | SOD           | DIRT        | 1939 | ABAN 1952 E9308 |
| 2   | GRAV          | GRAV        | 1932 |                 |

4C

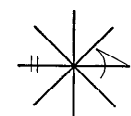

PROPERTY OF NEW ENGLAND TELEPHONE & TELEGRAPH COMPANY

LOADED } ALL U. G. CABLE, EXCH. CODE 5  
 } ALL CONNECTIONS, EXCH. CODE \_\_\_\_\_  
 } ALL AERIAL CABLE, EXCH. CODE \_\_\_\_\_ } UNLESS NOTED OTHERWISE

LOCATION MAIN SCHOOL BRIDGE, TS-291B, TS-419

EXCHANGE WASHBURN ME

EXCH. CODE 7178 (MASS. ONLY) MUNIC. CODE \_\_\_\_\_