


F.H.W.A. REG. NO.	STATE	PROJECT NUMBER	SHEET NO.	TOTAL SHEETS
1	MAINE			

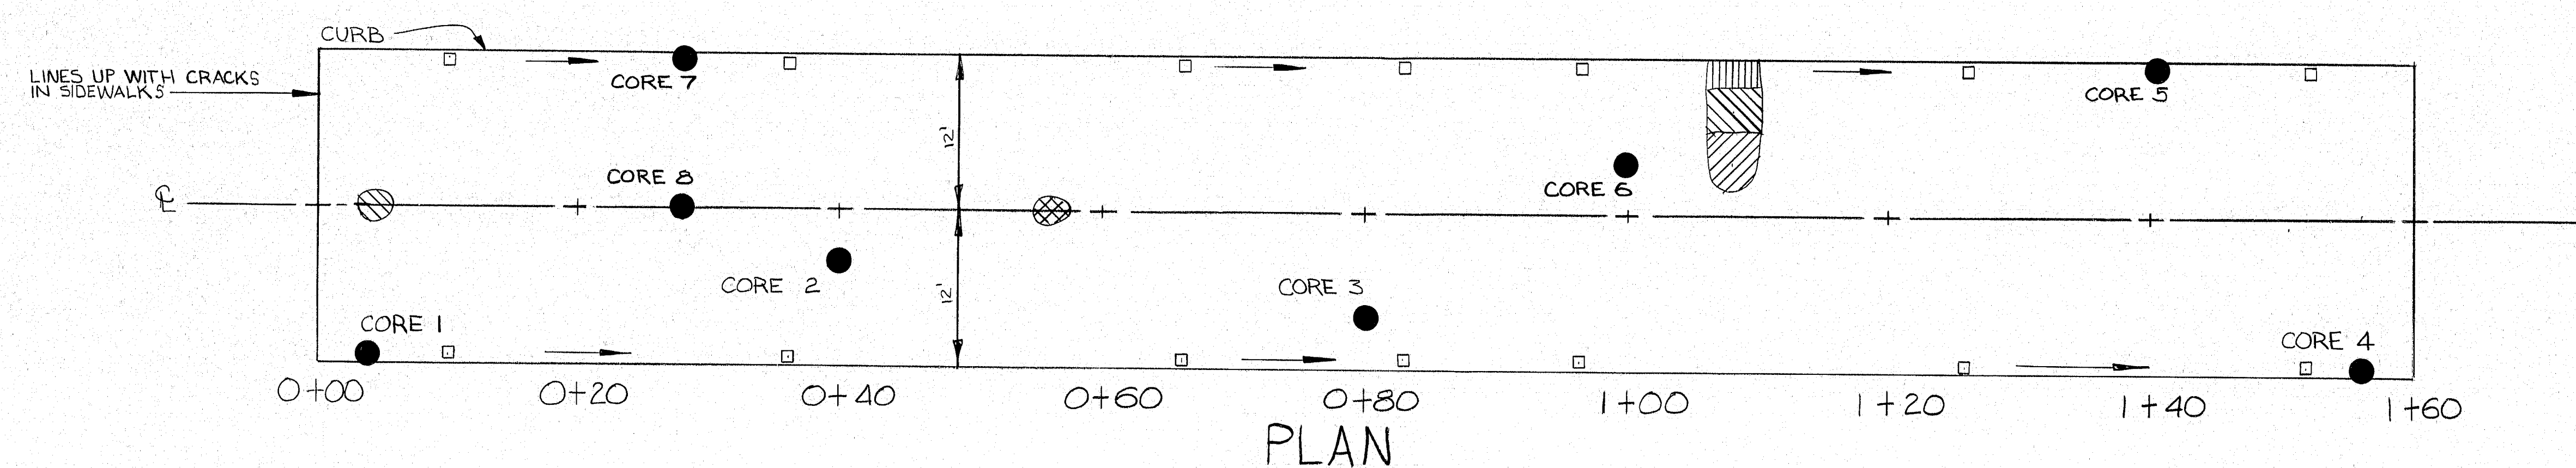


### LEGEND

← DIRECTION OF DRAINAGE

□ BRIDGE DRAIN

0.30-0.39 VOLTS	0.60-0.69 VOLTS
0.40-0.49 VOLTS	0.70-0.79 VOLTS
0.50-0.59 VOLTS	0.80-0.89 VOLTS

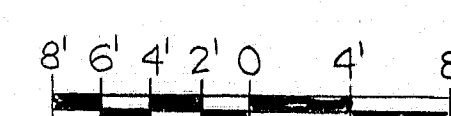

PERCENT OF DECK READINGS						
STATIONING	ALL READINGS ABOVE THESE VOLTS					
	0.30	0.40	0.50	0.60	0.70	0.80
0+00-1+60	2%	1%	1%	0.3%	0.3%	—

NOTE: AVERAGE OF ALL READINGS ON THE BRIDGE IS 0.05

119-384

STATE OF MAINE  
DEPARTMENT OF TRANSPORTATION

BRIDGE DECK EVALUATION  
(VOLT-METER SURVEY)  
COVERED BRIDGE  
OVER  
NARRAGUAGUS RIVER  
IN THE TOWN OF  
CHERRYFIELD

SHEET 1 OF 1 AUGUSTA, MAINE JULY 1984

PROJECT DESIGN ENGINEER	BY	DATE
DESIGN - DETAILED	CDH	12-83
REVISIONS	EDH	12-83
FIELD CHANGES		

BRUNING 44132 40710