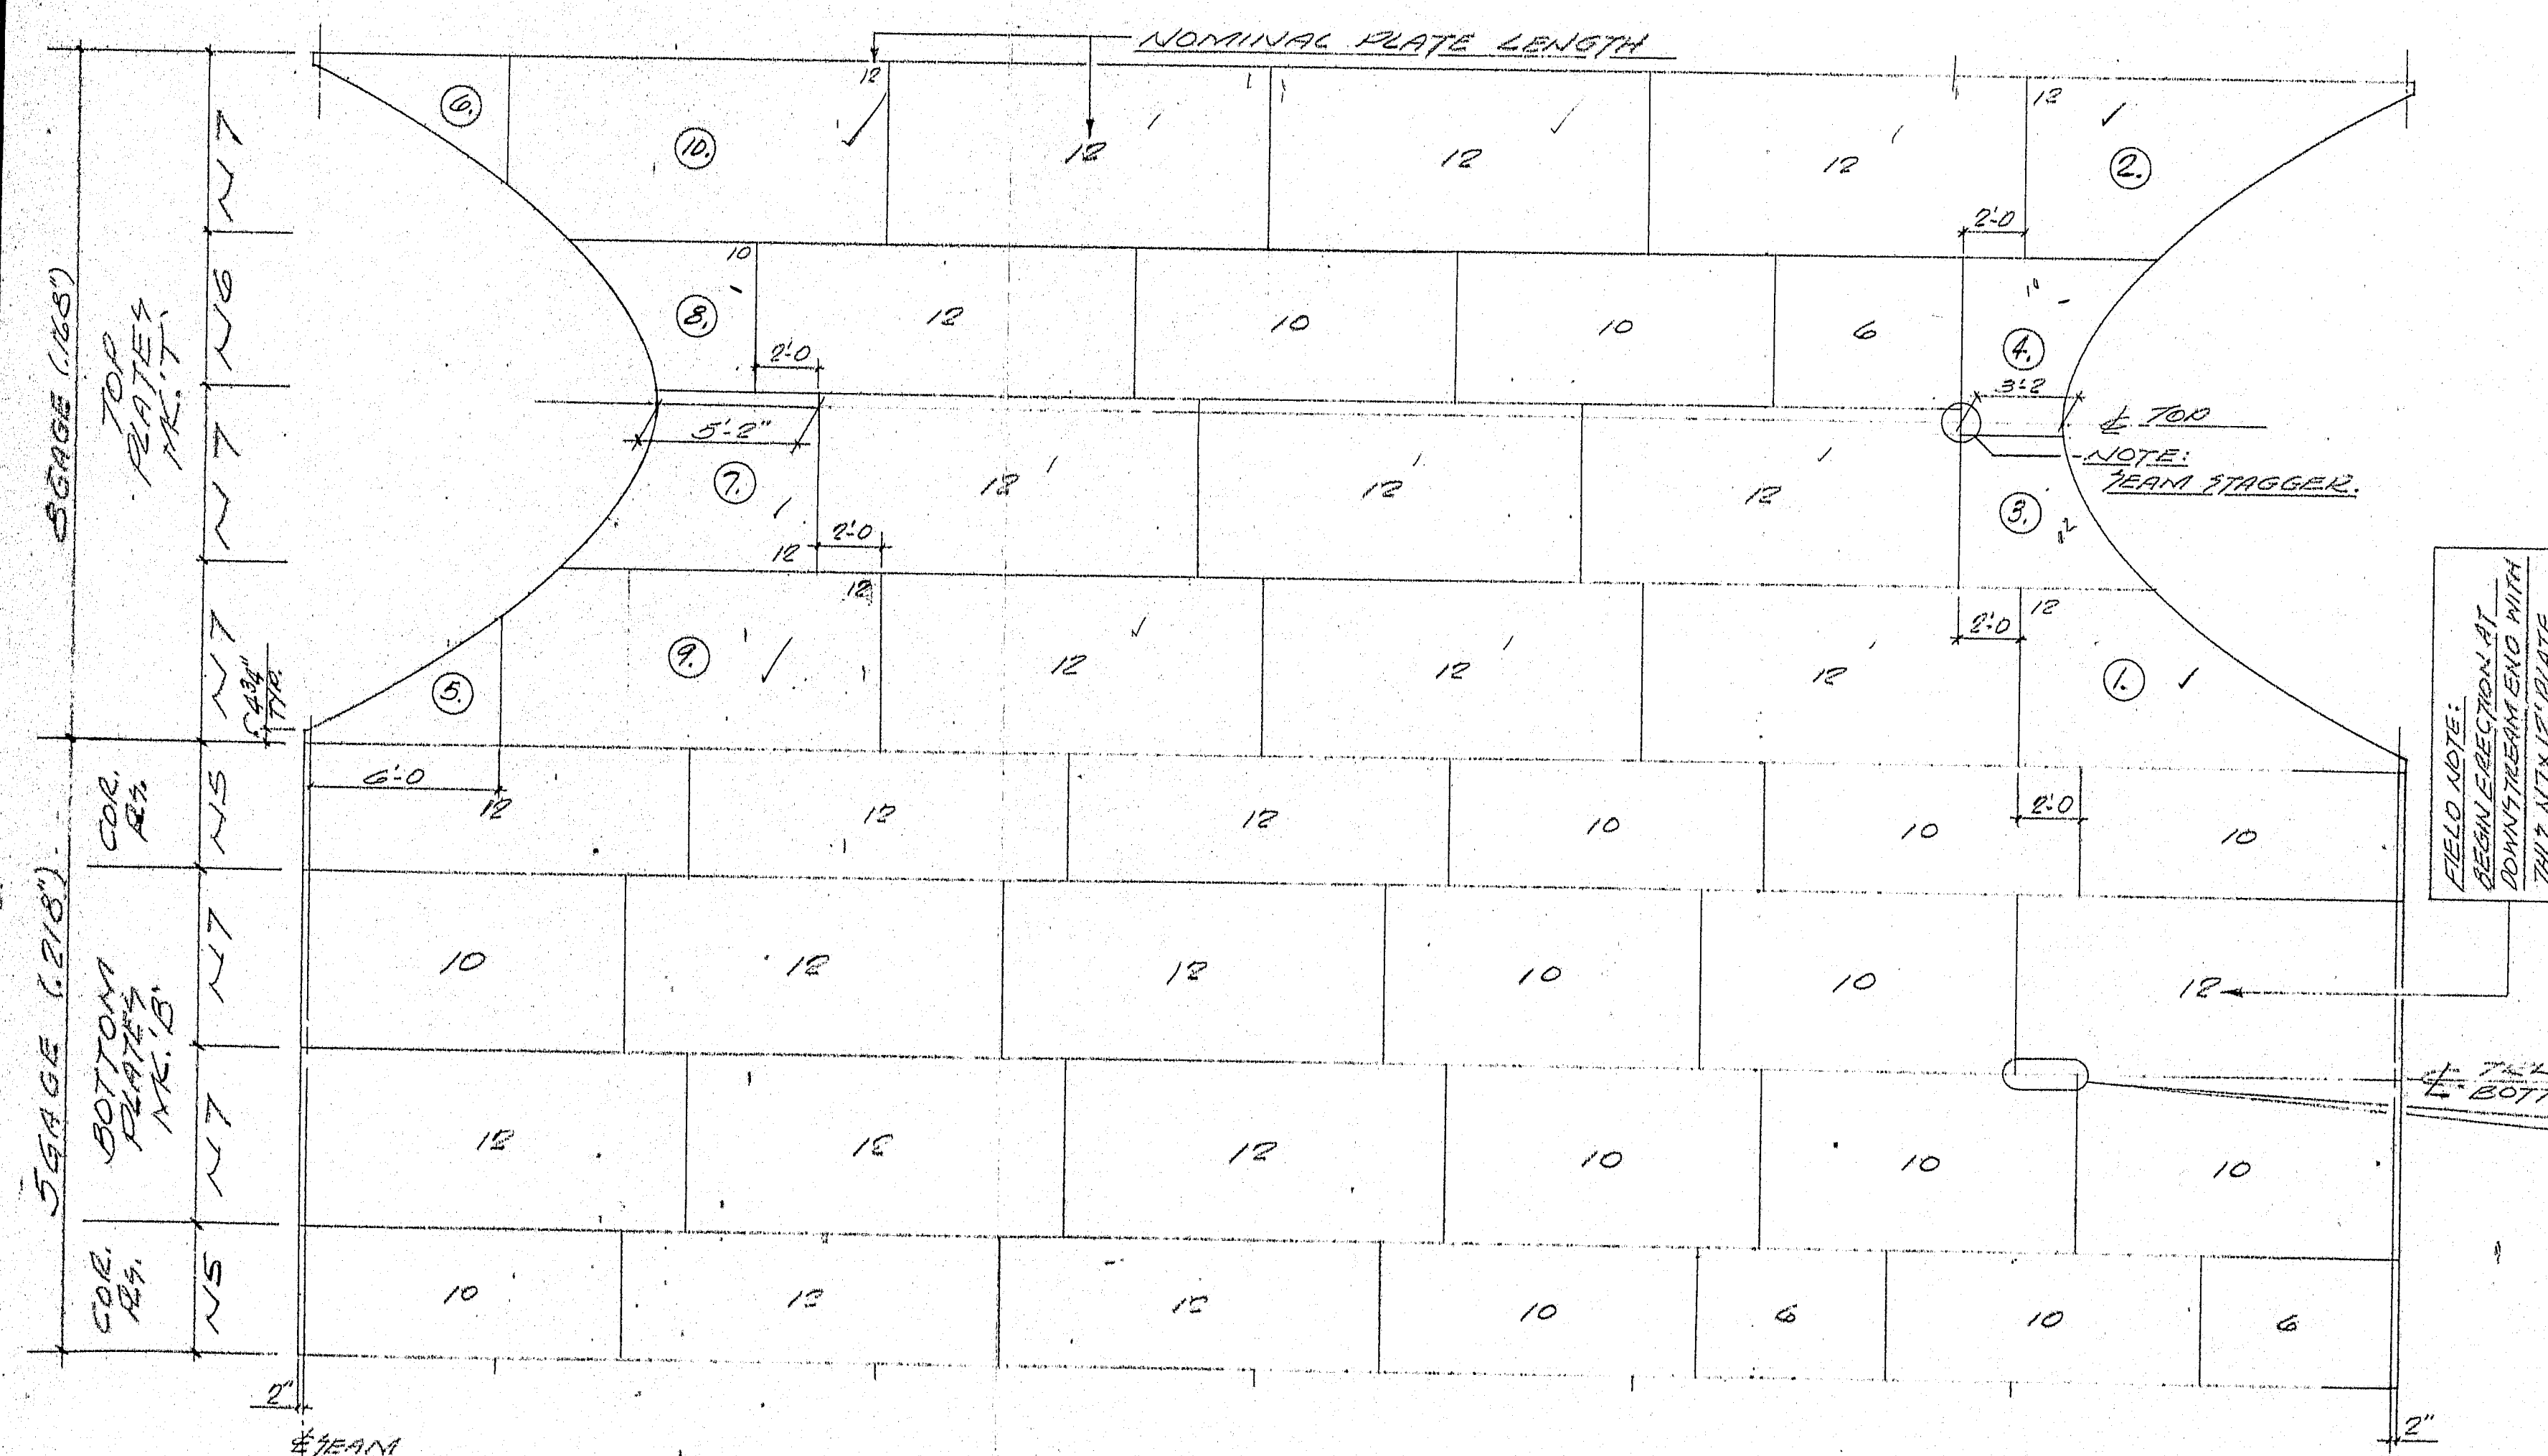
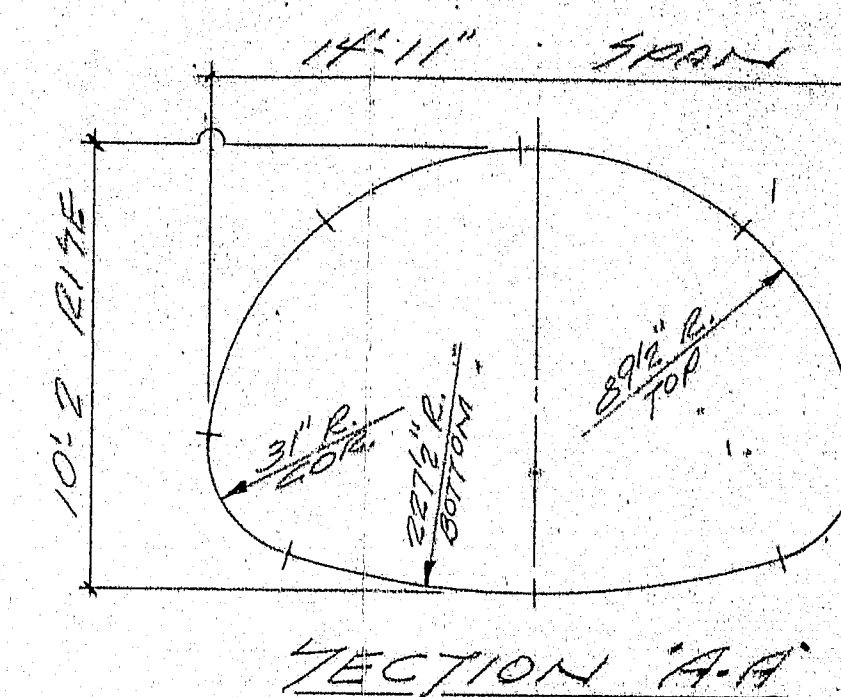


[illegible]

Creek Bridge, Lovell

GENERAL NOTE: *Q1M 3334*

ISSUANCE OF THIS DRAWING FOR APPROVAL DOES NOT CONSTITUTE ACCEPTANCE OF CUSTOMER'S ORDER BY REPUBLIC STEEL. THIS DRAWING IS TO BE USED IN PLACING MATERIALS SOLD UNDER THIS CONTRACT ONLY.

CONTRACTOR TO CHECK DIMENSIONS AT JOBSite AS REPUBLIC STEEL CORPORATION ASSUMES NO RESPONSIBILITY FOR GENERAL BUILDING CONSTRUCTION.

THE DRAWING IS LOANED WITH THE EXPRESSED AGREEMENT THAT THE DRAWING AND INFORMATION THEREIN CONTAINS NO WARRANTIES OR GUARANTEES. THE DRAWING IS NOT TO BE REPRODUCED, COPIED, REPRODUCED, OR USED FOR ANY MATCH FOR THE MAKING OF DRAWINGS, PRINTS OR OTHER REPRODUCTIONS. IT IS MADE NO TO SUPPLY ANY INFORMATION FOR ANY OTHER PROJECTS.

APPROVAL OF THIS DRAWING BY THE ARCHITECT OR ENGINEER SHALL CONSTITUTE A FINAL INTERPRETATION OF ALL OTHERS. THE ACCEPTANCE OF THIS DRAWING WILL BE CONSIDERED AS ACCEPTANCE OF THE FOREGOING AGREEMENT.

DEVELOPED PLAN ——— INSIDE VIEW

5 GAGE (.163") TOP PLATES

5 GAGE (.213") BOTTOM & CORNER PLATES

PLAIN GALVANIZED

① ——— STRUCTURE

**Br. # 3582**

**R88-58**