

R95-101

FED. ROAD DIST. NO.	STATE	FED. AID PROJ. NO.
1	ME	116-315-8(2)176

FIGURING PLAN - SPANS 1 & 2

I-395 BRIDGE OVER PENOBSCOT RIVER

I-395 BRIDGE STA. 164+60.00

PENOBSCOT COUNTY

STATE OF MAINE



DEPARTMENT OF TRANSPORTATION

STATE CONTRACT OR REF. NO. 6 CONTRACTOR CANERO CORP.

IN CHARGE: HINKLE MADE BY: BJK CHK'D BY: JLC DATE: 5-2-84

CONTRACT NUMBER: ME-84088-1 DRAWING NUMBER: WS1



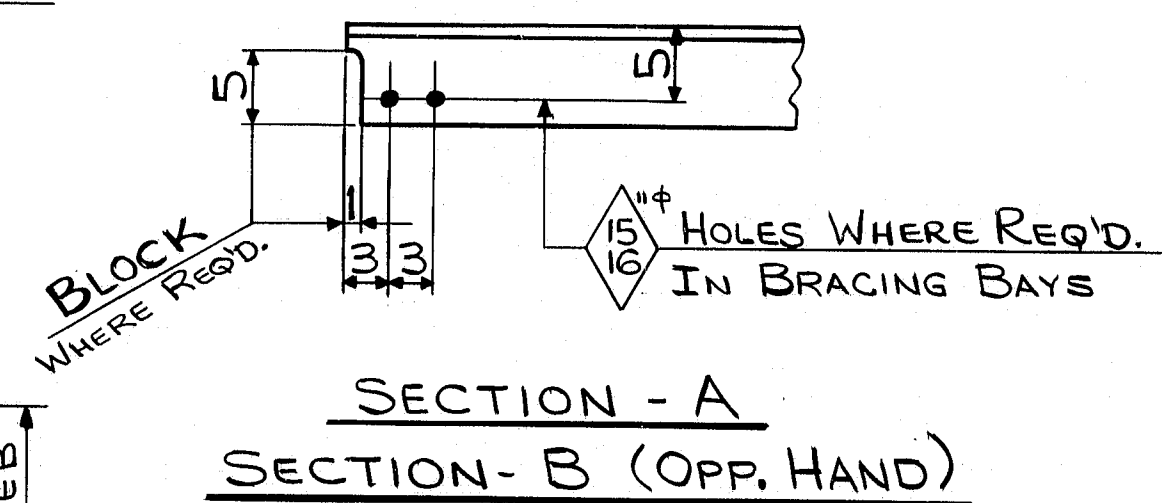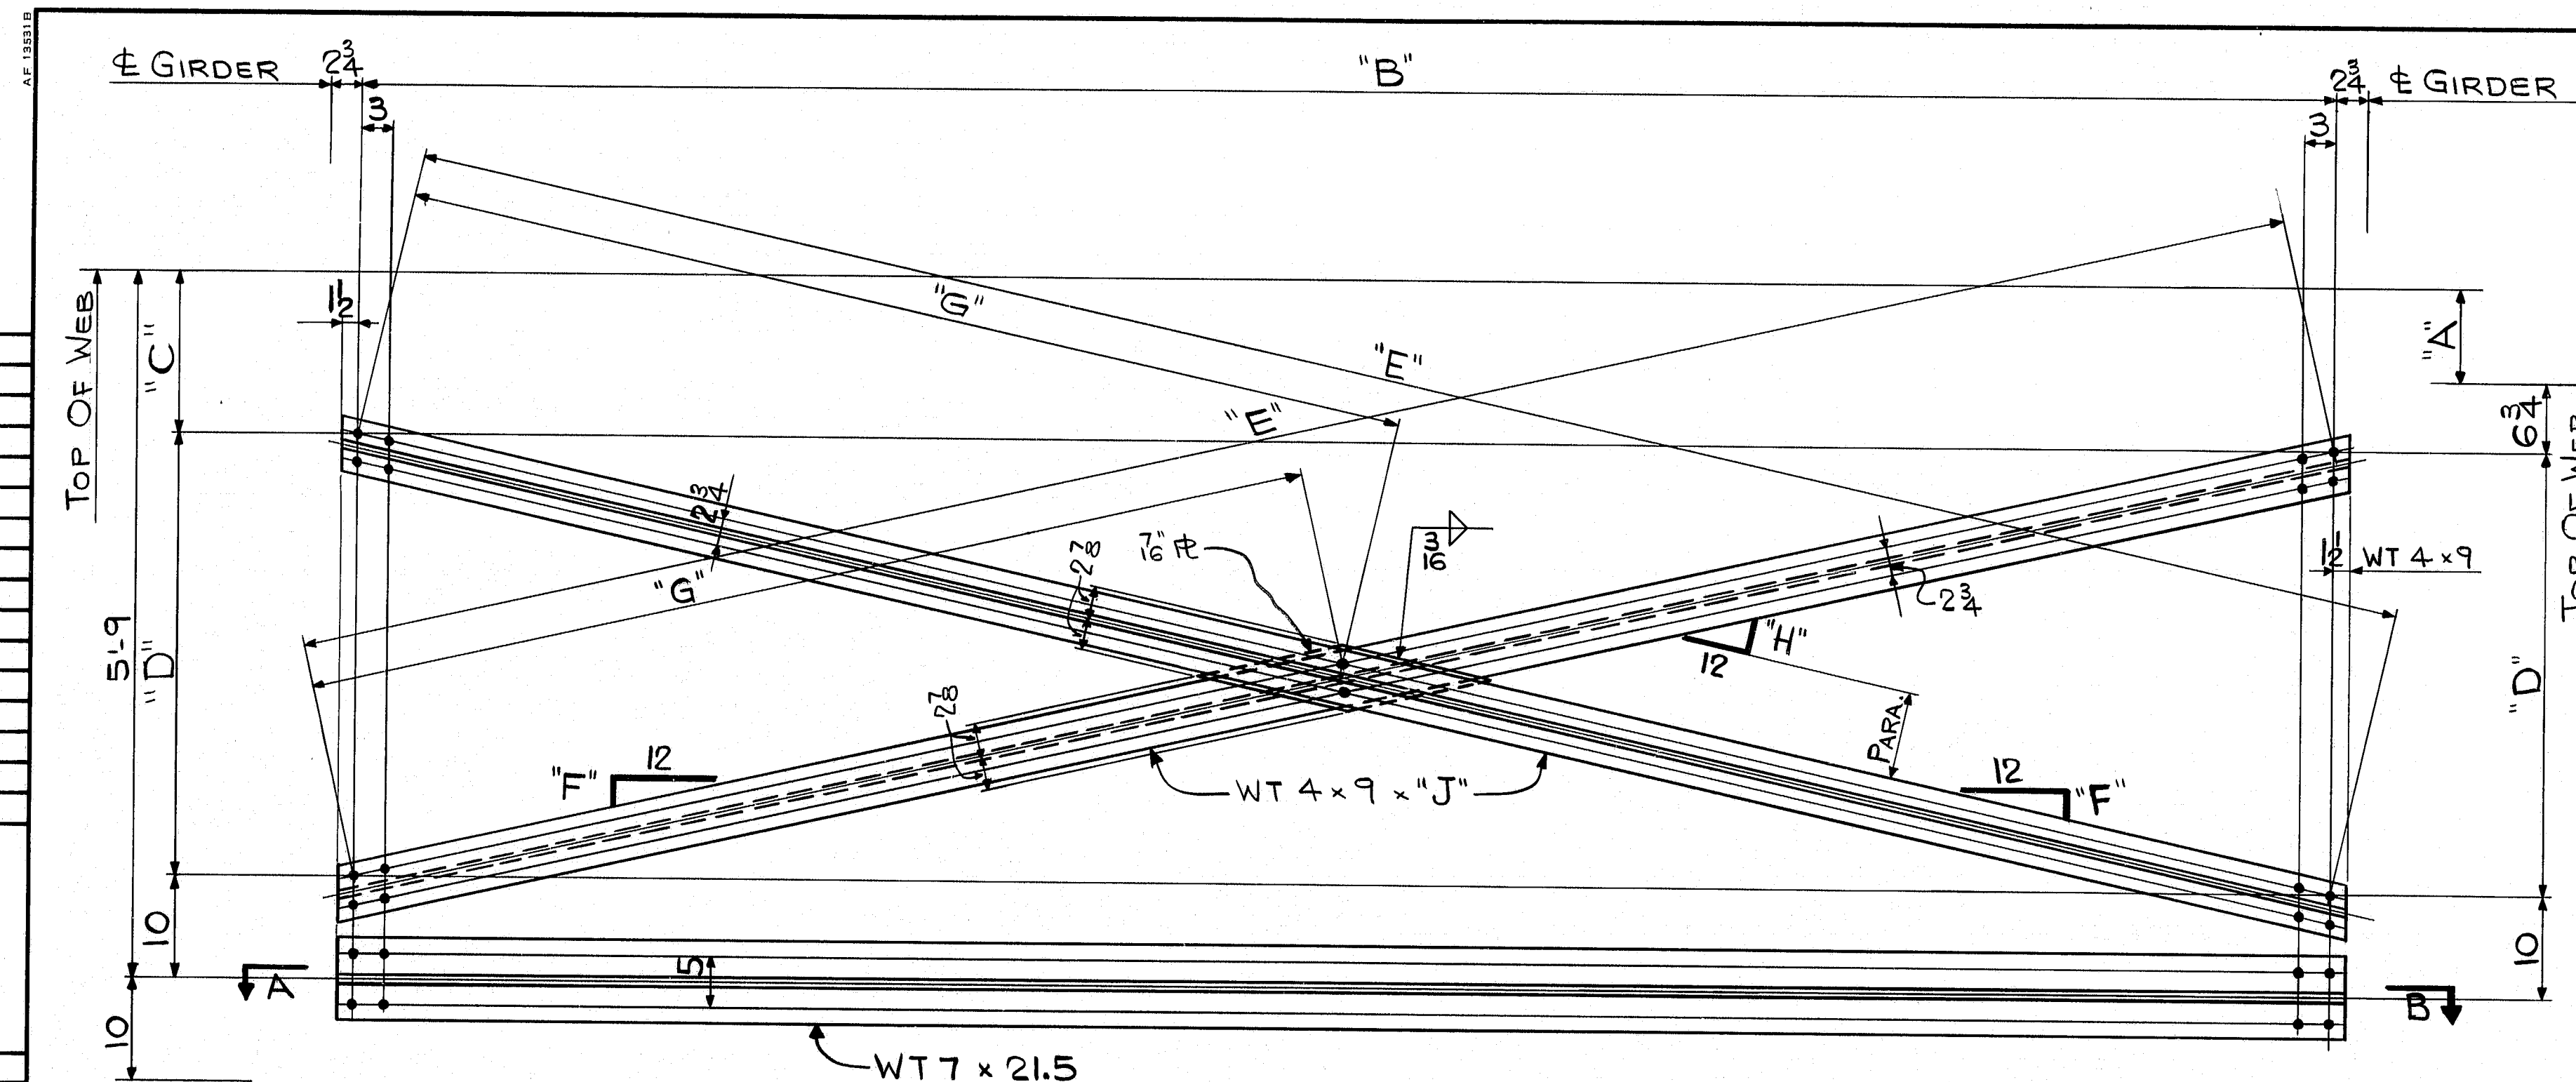

FED. ROAD DIST. NO.	STATE	FED. AID PROJ. NO.
1	ME	116-395-8 (82) 176

a	
b	
c	
d	
e	
f	
g	
h	
k	
m	
n	
p	
s	
t	
w	
y	

a	
b	
c	
d	
e	
f	
g	
h	
k	
m	
n	
p	
s	
t	
w	
y	

a	
b	
c	
d	
e	
f	
g	
h	
k	
m	
n	
p	
s	
t	
w	
y	

"A"	"B"	"C"	"D"	"E"	"F"	"G"	"H"	"J"
8	14'4 1/2	1'2 3/4	3'8 1/4	14'10 1/2	3'6	7'5 1/2	6'1 1/2	15'2 1/2
8	14'4 1/4	1'2 3/4	3'8 1/4	14'10 1/2	3'6	7'5 1/2	6'1 1/2	15'2 1/4
7 3/4	14'4 1/4	1'2 1/2	3'8 1/2	14'10 1/2	3'6	7'5 1/4	6'5/8	15'2 1/8
7 3/4	14'4 1/5	1'2 1/2	3'8 1/2	14'10 3/8	3'6	7'5 1/8	6'5/8	15'3 1/8
8	14'8 3/4	1'2 3/4	3'8 1/4	15'2 1/2	3	7'7 1/8	6'7/8	15'6 5/8
8 1/2	14'9 1/2	1'2 3/8	3'8 1/8	15'2 1/2	3	7'7 1/4	6'3/4	15'6 3/8
8 1/4	14'9 1/2	1'3	3'8	15'2 1/2	3	7'7 3/8	6'3/4	15'7 1/8
8 1/4	14'9 3/8	1'3	3'8	15'3	3	7'7 1/2	6'5/8	15'7 3/8
8 3/8	15'0 1/2	1'3 3/8	3'7 3/8	15'5 1/2	2 3/8	7'8 1/2	6'7/8	15'10 1/2
8 3/8	15'0 3/8	1'3 3/8	3'7 3/8	15'5 1/2	2 3/8	7'8 1/2	6'7/8	15'10 3/8
8 1/4	15'0 3/8	1'3	3'8	15'6 3/8	2 1/2	7'9 1/2	6'7/8	15'10 1/2
7 1/2	15'0 3/8	1'2 3/8	3'8 3/8	15'6 1/4	2 1/2	7'9 1/8	6'4	15'10 3/8
8 3/4	15'5 1/4	1'3 1/2	3'7 1/2	15'10 3/4	2 1/2	7'11 3/8	5'15/8	16'1 3/8
8 3/4	15'5 1/2	1'3 1/2	3'7 1/2	15'10 3/4	2 1/2	7'11 1/2	5'15/8	16'1 3/8
8 3/4	15'5 1/2	1'3 1/2	3'7 1/2	15'10 1/2	2 1/2	7'11 1/2	5'15/8	16'1 3/4
8 3/8	15'6 1/2	1'3 3/8	3'7 3/8	15'11 1/8	2 1/2	7'11 1/2	5'15/8	16'1 3/4
9	15'8 1/2	1'3 3/4	3'7 1/4	16'1 1/2	2 3/4	8'0 1/2	5'15/8	16'5 1/2
8 3/8	15'8 3/8	1'3 3/8	3'7 3/8	16'1 1/2	2 3/4	8'0 3/8	5'13/8	16'6 1/2
8 3/8	15'9 1/2	1'3 3/8	3'7 3/8	16'2	2 3/4	8'1	5'13/8	16'6 1/4
8 3/4	15'9 1/4	1'3 1/2	3'7 1/2	16'2 1/2	2 3/4	8'1 1/2	5'13/8	16'6 1/2
7 3/8	15'10 1/2	1'2 3/8	3'8 3/8	16'3 1/8	2 1/2	8'1 1/2	5'13/8	16'8 1/2
8 5/8	15'10 1/2	1'3 3/8	3'7 3/8	16'3 3/8	2 3/4	8'1 1/2	5'13/8	16'7 3/8
9 1/2	15'10 1/2	1'4 1/4	3'6 3/4	16'3 3/8	2 1/2	8'1 1/2	5'11/8	16'7 1/2
8 3/8	16'0 1/2	1'3 3/8	3'7 3/8	16'4 1/2	2 1/2	8'2 1/2	5'11/8	16'9 1/2
8 3/8	16'0 1/2	1'3 3/8	3'7 3/8	16'5	2 1/2	8'2 1/2	5'11/8	16'9 1/4
9	16'0 1/4	1'3 3/4	3'7 1/4	16'5 1/2	2 1/2	8'2 1/2	5'11/8	16'9 1/2
9 3/8	16'0 3/8	1'3 3/8	3'7 3/8	16'5 3/8	2 1/2	8'2 1/2	5'11/8	16'9 3/8
7 1/2	16'5 1/2	1'1 1/2	3'9 1/2	16'10 3/8	2 3/4	8'5 1/2	5'13/8	17'2 1/2
9 3/8	16'5 1/2	1'3 3/8	3'7 3/8	16'10 3/8	2 3/8	8'5 3/8	5'13/8	17'2 1/2
10 3/8	16'5 1/2	1'4 3/8	3'6 3/8	16'10	2 7/8	8'5	5'3/8	17'2 1/2
8 3/4	16'6 1/2	1'3 1/2	3'7 1/2	16'10 3/8	2 3/8	8'5 1/2	5'13/8	17'3 1/2
9	16'6 3/8	1'3 3/4	3'7 1/4	16'10 1/2	2 5/8	8'5 3/8	5'13/8	17'3
9 3/8	16'6 3/8	1'4 3/8	3'6 3/8	16'10 1/2	2 5/8	8'5 3/8	5'13/8	17'2 1/2
8 3/8	16'9 3/8	1'3 3/8	3'7 3/8	17'2 1/2	2 5/8	8'7 1/4	5'13/8	17'6 3/4
9 3/8	16'9 3/8	1'3 3/8	3'7 3/8	17'2 1/2	2 5/8	8'7 3/8	5'3/8	17'6 3/8


"A"	"B"	"C"	"D"	"E"	"F"	"G"	"H"	"J"
9 5/8	16'9 3/8	1'4 3/8	3'6 3/8	17'2 1/2	2 7/8	8'7 3/8	5'13/8	17'6 1/2
7 3/4	17'6 1/2	1'2 1/2	3'8 1/2	17'11 1/2	2 7/8	8'11 5/8	5'5/8	18'3 3/8
9	17'6 1/2	1'3 3/4	3'7 1/4	17'10 1/2	2 7/8	8'11 1/2	5'5/8	18'3 3/8
10	17'6 1/2	1'4 3/4	3'6 1/4	17'10 3/4	2 7/8	8'11 3/8	5	18'2 3/8
7 1/4	17'9 1/4	1'2	3'9	18'1 1/2	2 7/8	9'0 1/2	5'13/8	18'5 3/4
8 3/8	17'9 1/4	1'3 3/8	3'7 3/8	18'1 1/2	2 7/8	9'0 1/2	5'13/8	18'5 3/4
10 3/8	17'9 1/4	1'4 3/8	3'6 3/8	18'1 1/2	2 7/8	9'0 1/2	4'15/8	18'5 1/2
6 3/8	17'9 1/2	1'0 3/8	3'10 3/8	18'2 3/8	2 7/8	9'1 1/2	5'13/8	18'6 1/2
10	17'9 1/2	1'4 3/4	3'6 1/4	18'1 1/2	2 3/8	9'0 1/2	4'15/8	18'5 1/2
11 1/4	17'9 1/2	1'6	3'5	18'1 1/2	2 7/8	9'0 1/2	4'15/8	18'5 3/8
5 3/4	18'3 1/4	1'0 1/2	3'10 1/2	18'8 3/8	2 7/8	9'4 1/2	5'13/8	19'0 1/2
10 1/2	18'3 1/4	1'5 1/4	3'5 3/4	18'7 1/2	2 7/8	9'3 3/8	4'3/4	18'11 1/4
11 3/4	18'3 1/4	1'6 1/2	3'4 1/2	18'6 1/2	2 7/8	9'3 1/2	4'15/8	18'11

WORK THIS DWG. WITH DWGS. WSI & WS4

R95-102

NO.	REVISION	DATE
HIGH STEEL STRUCTURES, INC. 1905 Old Philadelphia Pike Lancaster, Pennsylvania 17603 Phone 717/299-5211 A Subsidiary of High Industries, Inc.		
INT. CROSSFRAME LAYOUTS I-395 BRIDGE OVER PENOBSCOT RIVER I-395 BRIDGE STA. 164+60.00 PENOBSCOT COUNTY STATE OF MAINE DEPARTMENT OF TRANSPORTATION		
STATE CONTRACT OR REF. NO.	CONTRACTOR CIANBRO CORP.	
IN CHARGE: HINKLE	MADE BY: JLC	CHK'D BY: BJK DATE: 5-7-84
CONTRACT NUMBER: ME-84088-1	DRAWING NUMBER: WS2	

FED. ROAD DIST. NO.	STATE	FED. AID PROJ. NO.
I	ME	I-16-395-8(82)176

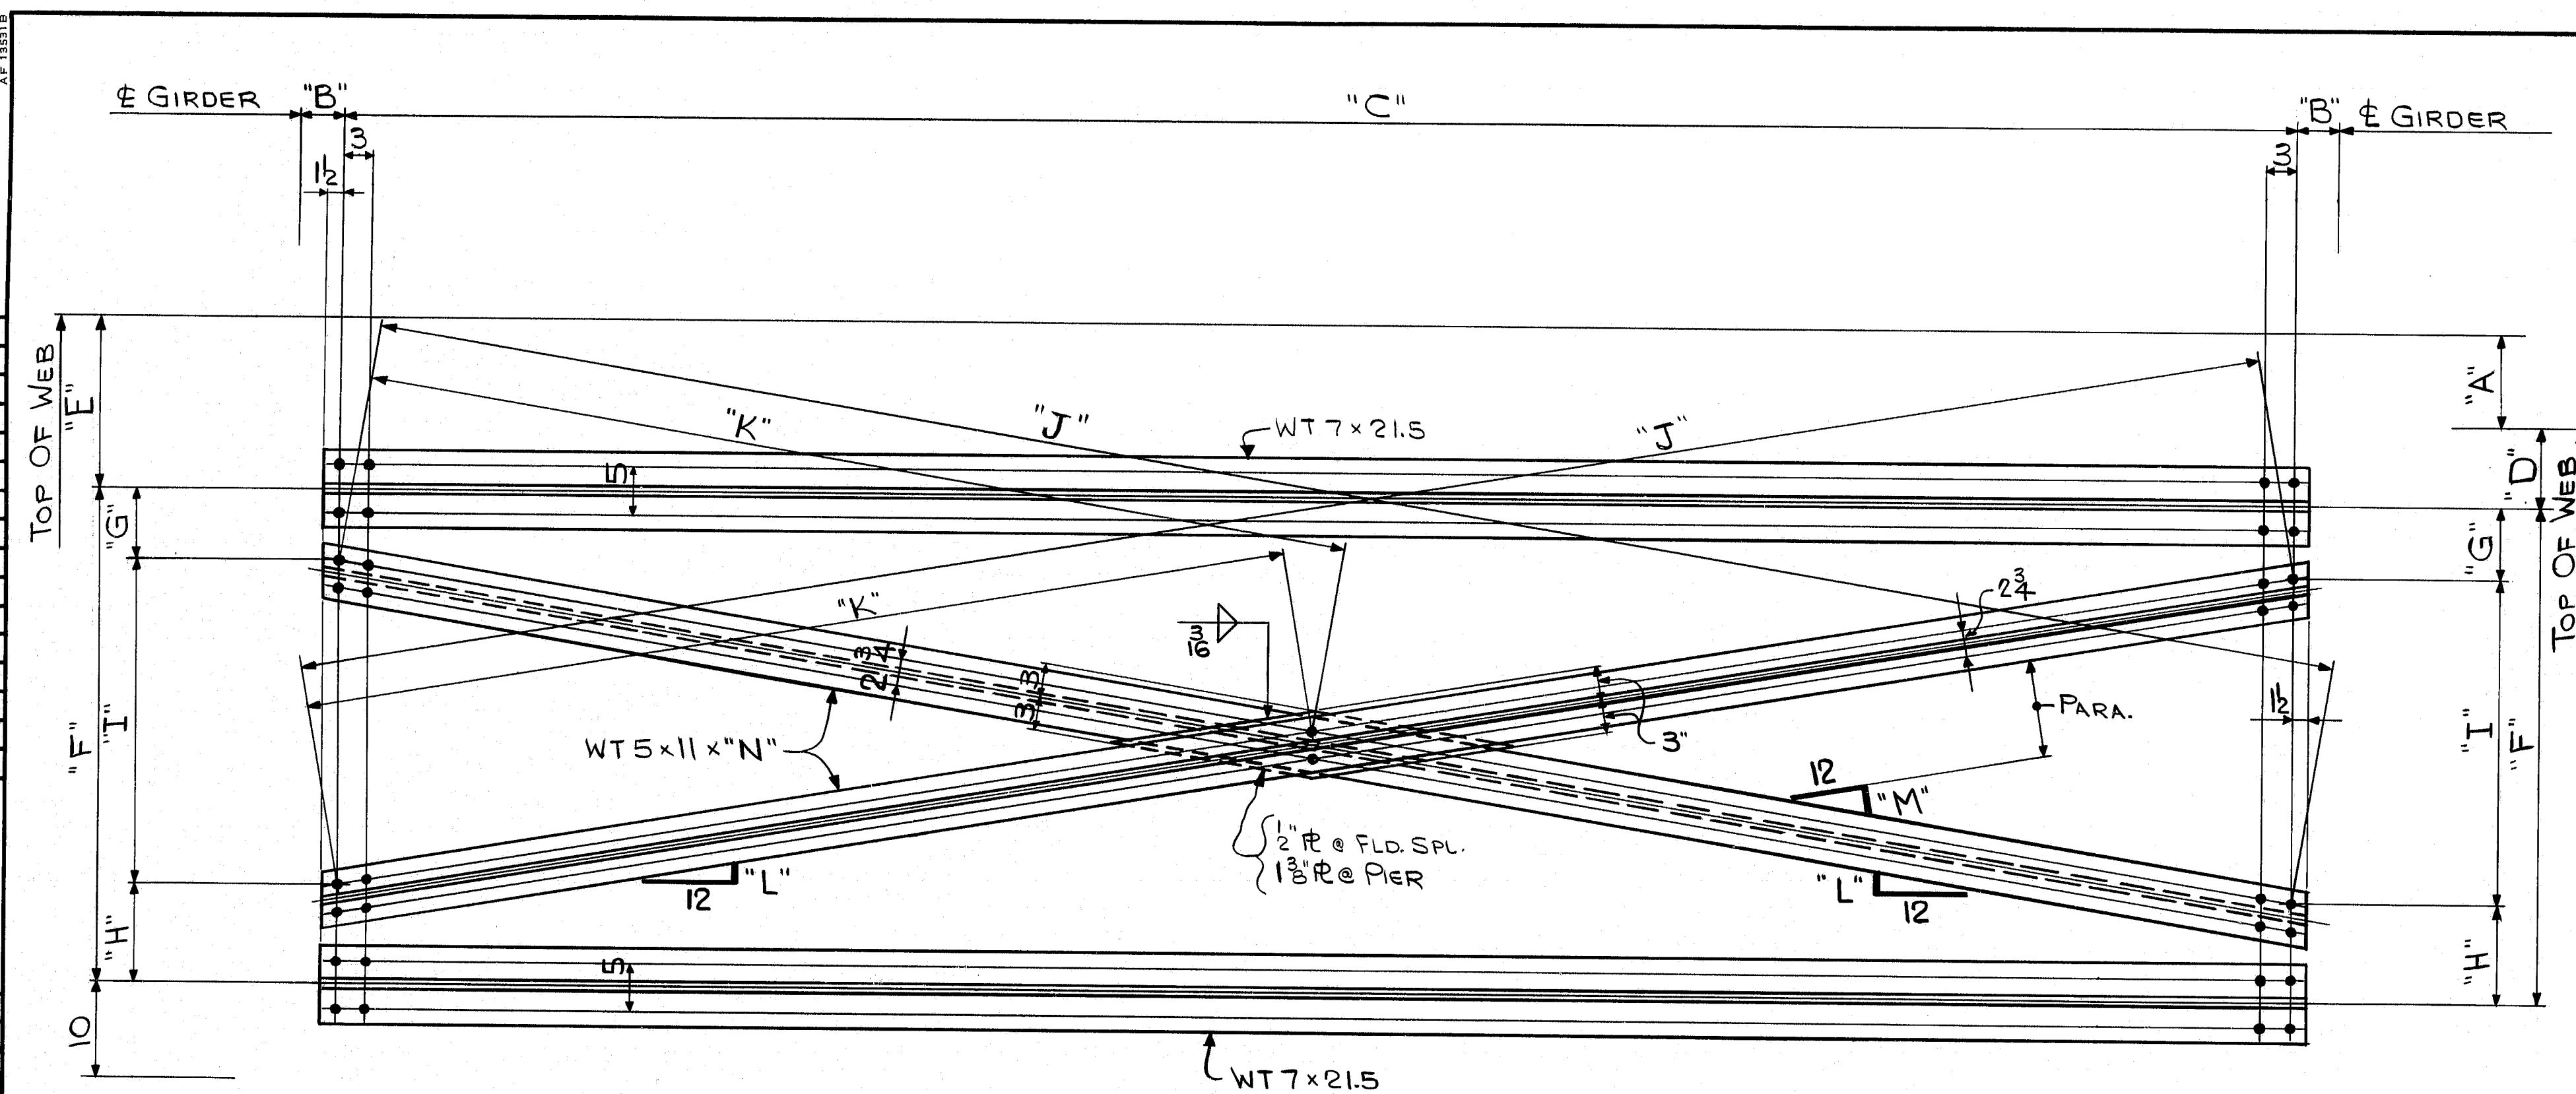

NOTE: SEE BRACING LAYOUTS FOR HOLE LOCATIONS IN BOTTOM CROSSFRAME MEMBERS.

"A"	"B"	"C"	"D"	"E"	"F"	"G"	"H"	"I"	"J"	"K"	"L"	"M"	"N"
8 <sup>3</sup> / <sub>8</sub>	4 <sup>1</sup> / <sub>4</sub>	15'-2 <sup>1</sup> / <sub>2</sub>	8 <sup>1</sup> / <sub>4</sub>	1'-4 <sup>3</sup> / <sub>8</sub>	4'-4 <sup>3</sup> / <sub>8</sub>	7 <sup>1</sup> / <sub>2</sub>	10 <sup>1</sup> / <sub>4</sub>	2'-10 <sup>5</sup> / <sub>8</sub>	15'-5 <sup>3</sup> / <sub>4</sub>	7'-8 <sup>3</sup> / <sub>8</sub>	2 <sup>1</sup> / <sub>4</sub>	4 <sup>3</sup> / <sub>4</sub>	15'-9 <sup>1</sup> / <sub>8</sub>
8 <sup>3</sup> / <sub>8</sub>	4 <sup>1</sup> / <sub>4</sub>	15'-2 <sup>1</sup> / <sub>2</sub>	8 <sup>1</sup> / <sub>4</sub>	1'-5 <sup>5</sup> / <sub>8</sub>	4'-3 <sup>3</sup> / <sub>8</sub>	7 <sup>1</sup> / <sub>2</sub>	10 <sup>1</sup> / <sub>4</sub>	2'-10 <sup>5</sup> / <sub>8</sub>	15'-5 <sup>1</sup> / <sub>8</sub>	7'-8 <sup>1</sup> / <sub>8</sub>	2 <sup>1</sup> / <sub>4</sub>	4 <sup>5</sup> / <sub>8</sub>	15'-9 <sup>1</sup> / <sub>8</sub>
7 <sup>1</sup> / <sub>4</sub>	7 <sup>3</sup> / <sub>4</sub>	15'-4 <sup>1</sup> / <sub>8</sub>	7 <sup>1</sup> / <sub>2</sub>	1'-2 <sup>3</sup> / <sub>4</sub>	4'-6 <sup>1</sup> / <sub>4</sub>	8 <sup>1</sup> / <sub>4</sub>	11	2'-11	15'-7 <sup>1</sup> / <sub>8</sub>	7'-9 <sup>1</sup> / <sub>8</sub>	2 <sup>5</sup> / <sub>8</sub>	4 <sup>3</sup> / <sub>4</sub>	15'-11 <sup>7</sup> / <sub>8</sub>
8 <sup>3</sup> / <sub>8</sub>	7 <sup>3</sup> / <sub>4</sub>	15'-4 <sup>1</sup> / <sub>8</sub>	7 <sup>1</sup> / <sub>2</sub>	1'-4 <sup>3</sup> / <sub>8</sub>	4'-4 <sup>3</sup> / <sub>8</sub>	8 <sup>1</sup> / <sub>4</sub>	11	2'-9 <sup>3</sup> / <sub>8</sub>	15'-7 <sup>3</sup> / <sub>8</sub>	7'-9 <sup>3</sup> / <sub>8</sub>	2 <sup>3</sup> / <sub>8</sub>	4 <sup>1</sup> / <sub>2</sub>	15'-11 <sup>1</sup> / <sub>4</sub>
10	7 <sup>3</sup> / <sub>4</sub>	15'-4 <sup>1</sup> / <sub>8</sub>	7 <sup>1</sup> / <sub>2</sub>	1'-5 <sup>1</sup> / <sub>2</sub>	4'-3 <sup>1</sup> / <sub>2</sub>	8 <sup>1</sup> / <sub>4</sub>	11	2'-8 <sup>1</sup> / <sub>4</sub>	15'-6 <sup>1</sup> / <sub>8</sub>	7'-9 <sup>1</sup> / <sub>8</sub>	2 <sup>3</sup> / <sub>8</sub>	4 <sup>5</sup> / <sub>8</sub>	15'-11
8 <sup>3</sup> / <sub>4</sub>	4 <sup>1</sup> / <sub>4</sub>	16'-0 <sup>3</sup> / <sub>8</sub>	8 <sup>1</sup> / <sub>4</sub>	1'-5	4'-4	7 <sup>1</sup> / <sub>2</sub>	10 <sup>1</sup> / <sub>4</sub>	2'-10 <sup>1</sup> / <sub>4</sub>	16'-3 <sup>3</sup> / <sub>8</sub>	8'-1 <sup>1</sup> / <sub>8</sub>	2 <sup>3</sup> / <sub>8</sub>	4 <sup>7</sup> / <sub>8</sub>	16'-7 <sup>1</sup> / <sub>4</sub>
9 <sup>3</sup> / <sub>8</sub>	4 <sup>1</sup> / <sub>4</sub>	16'-0 <sup>3</sup> / <sub>8</sub>	8 <sup>1</sup> / <sub>4</sub>	1'-5 <sup>3</sup> / <sub>8</sub>	4'-3 <sup>5</sup> / <sub>8</sub>	7 <sup>1</sup> / <sub>2</sub>	10 <sup>1</sup> / <sub>4</sub>	2'-9 <sup>3</sup> / <sub>8</sub>	16'-3 <sup>1</sup> / <sub>8</sub>	8'-1 <sup>1</sup> / <sub>8</sub>	2 <sup>3</sup> / <sub>8</sub>	4 <sup>3</sup> / <sub>8</sub>	16'-7 <sup>3</sup> / <sub>8</sub>
8 <sup>1</sup> / <sub>2</sub>	7 <sup>3</sup> / <sub>4</sub>	15'-10	7 <sup>1</sup> / <sub>2</sub>	1'-4	4'-5	8 <sup>1</sup> / <sub>4</sub>	11	2'-9 <sup>3</sup> / <sub>4</sub>	16'-1	8'-0 <sup>1</sup> / <sub>2</sub>	2 <sup>3</sup> / <sub>8</sub>	4 <sup>3</sup> / <sub>8</sub>	16'-5 <sup>1</sup> / <sub>8</sub>
8 <sup>3</sup> / <sub>4</sub>	7 <sup>3</sup> / <sub>4</sub>	15'-10	7 <sup>1</sup> / <sub>2</sub>	1'-4 <sup>1</sup> / <sub>4</sub>	4'-4 <sup>3</sup> / <sub>4</sub>	8 <sup>1</sup> / <sub>4</sub>	11	2'-9 <sup>1</sup> / <sub>2</sub>	16'-0 <sup>1</sup> / <sub>8</sub>	8'-0 <sup>1</sup> / <sub>8</sub>	2 <sup>3</sup> / <sub>8</sub>	4 <sup>3</sup> / <sub>8</sub>	16'-5
9 <sup>3</sup> / <sub>8</sub>	7 <sup>3</sup> / <sub>4</sub>	15'-10	7 <sup>1</sup> / <sub>2</sub>	1'-4 <sup>5</sup> / <sub>8</sub>	4'-4 <sup>3</sup> / <sub>8</sub>	8 <sup>1</sup> / <sub>4</sub>	11	2'-9 <sup>3</sup> / <sub>8</sub>	16'-0 <sup>3</sup> / <sub>8</sub>	8'-0 <sup>3</sup> / <sub>8</sub>	2 <sup>3</sup> / <sub>8</sub>	4 <sup>3</sup> / <sub>8</sub>	16'-4 <sup>1</sup> / <sub>8</sub>
6 <sup>3</sup> / <sub>4</sub>	4 <sup>1</sup> / <sub>4</sub>	16'-6 <sup>1</sup> / <sub>8</sub>	8 <sup>1</sup> / <sub>4</sub>	1'-3	4'-6	7 <sup>1</sup> / <sub>2</sub>	10 <sup>1</sup> / <sub>4</sub>	3'-0 <sup>1</sup> / <sub>4</sub>	16'-9 <sup>3</sup> / <sub>8</sub>	8'-4 <sup>1</sup> / <sub>8</sub>	2 <sup>3</sup> / <sub>8</sub>	4 <sup>7</sup> / <sub>8</sub>	17'-1 <sup>1</sup> / <sub>8</sub>
9 <sup>3</sup> / <sub>8</sub>		16'-6 <sup>1</sup> / <sub>8</sub>		1'-5 <sup>3</sup> / <sub>8</sub>	4'-3 <sup>5</sup> / <sub>8</sub>			2'-9 <sup>3</sup> / <sub>8</sub>	16'-9 <sup>1</sup> / <sub>8</sub>	8'-4 <sup>1</sup> / <sub>8</sub>	2 <sup>3</sup> / <sub>8</sub>	4 <sup>7</sup> / <sub>8</sub>	17'-1 <sup>1</sup> / <sub>8</sub>
10 <sup>1</sup> / <sub>4</sub>		16'-6 <sup>1</sup> / <sub>8</sub>		1'-6 <sup>1</sup> / <sub>2</sub>	4'-2 <sup>1</sup> / <sub>2</sub>			2'-8 <sup>3</sup> / <sub>4</sub>	16'-9 <sup>1</sup> / <sub>4</sub>	8'-4 <sup>5</sup> / <sub>8</sub>	2	4 <sup>1</sup> / <sub>8</sub>	17'-1 <sup>1</sup> / <sub>4</sub>
8 <sup>1</sup> / <sub>4</sub>		16'-9 <sup>3</sup> / <sub>8</sub>		1'-4 <sup>1</sup> / <sub>2</sub>	4'-4 <sup>1</sup> / <sub>2</sub>			2'-10 <sup>3</sup> / <sub>4</sub>	17'-0 <sup>3</sup> / <sub>8</sub>	8'-6 <sup>1</sup> / <sub>8</sub>	2 <sup>1</sup> / <sub>8</sub>	4 <sup>1</sup> / <sub>4</sub>	17'-4 <sup>3</sup> / <sub>8</sub>
9		16'-9 <sup>3</sup> / <sub>8</sub>		1'-5 <sup>1</sup> / <sub>4</sub>	4'-3 <sup>3</sup> / <sub>4</sub>			2'-10	17'-0 <sup>1</sup> / <sub>8</sub>	8'-6 <sup>3</sup> / <sub>8</sub>	2	4 <sup>1</sup> / <sub>8</sub>	17'-4 <sup>3</sup> / <sub>4</sub>
9 <sup>5</sup> / <sub>8</sub>		16'-9 <sup>3</sup> / <sub>8</sub>		1'-5 <sup>3</sup> / <sub>8</sub>	4'-3 <sup>3</sup> / <sub>8</sub>			2'-9 <sup>3</sup> / <sub>8</sub>	17'-0 <sup>3</sup> / <sub>8</sub>	8'-6 <sup>3</sup> / <sub>8</sub>	2	4 <sup>1</sup> / <sub>8</sub>	17'-4 <sup>3</sup> / <sub>8</sub>
7 <sup>1</sup> / <sub>2</sub>		15'-2 <sup>1</sup> / <sub>2</sub>		1'-3 <sup>3</sup> / <sub>4</sub>	4'-5 <sup>1</sup> / <sub>4</sub>			2'-11 <sup>1</sup> / <sub>2</sub>	15'-5 <sup>1</sup> / <sub>8</sub>	7'-8 <sup>1</sup> / <sub>8</sub>	2 <sup>3</sup> / <sub>8</sub>	4 <sup>3</sup> / <sub>8</sub>	15'-10 <sup>3</sup> / <sub>8</sub>
8 <sup>3</sup> / <sub>8</sub>		15'-2 <sup>1</sup> / <sub>2</sub>		1'-5 <sup>5</sup> / <sub>8</sub>	4'-3 <sup>3</sup> / <sub>8</sub>			2'-10 <sup>5</sup> / <sub>8</sub>	15'-5 <sup>1</sup> / <sub>8</sub>	7'-8 <sup>1</sup> / <sub>8</sub>	2 <sup>1</sup> / <sub>4</sub>	4 <sup>3</sup> / <sub>8</sub>	15'-9 <sup>1</sup> / <sub>8</sub>
8 <sup>3</sup> / <sub>4</sub>		16'-0 <sup>3</sup> / <sub>8</sub>		1'-5	4'-4			2'-10 <sup>1</sup> / <sub>4</sub>	16'-3 <sup>3</sup> / <sub>8</sub>	8'-1 <sup>1</sup> / <sub>8</sub>	2 <sup>3</sup> / <sub>8</sub>	4 <sup>7</sup> / <sub>8</sub>	16'-7 <sup>1</sup> / <sub>4</sub>
9 <sup>3</sup> / <sub>8</sub>	4 <sup>1</sup> / <sub>4</sub>	16'-0 <sup>3</sup> / <sub>8</sub>	8 <sup>1</sup> / <sub>4</sub>	1'-5 <sup>3</sup> / <sub>8</sub>	4'-3 <sup>5</sup> / <sub>8</sub>	7 <sup>1</sup> / <sub>2</sub>	10 <sup>1</sup> / <sub>4</sub>	2'-9 <sup>3</sup> / <sub>8</sub>	16'-3 <sup>1</sup> / <sub>8</sub>	8'-1 <sup>1</sup> / <sub>8</sub>	2 <sup>3</sup> / <sub>8</sub>	4 <sup>3</sup> / <sub>8</sub>	16'-7 <sup>3</sup> / <sub>8</sub>


OPR  
HAND

WORK THIS DWG. WITH DWGS. WSI & WS4


NO.	REVISION	DATE
HIGH STEEL STRUCTURES, INC.		
1905 Old Philadelphia Pike Lancaster, Pennsylvania 17603 Phone 717/299-5211 A Subsidiary of High Industries, Inc.		
CROSSFRAME LAYOUTS I-395 BRIDGE OVER PENOBSCOT RIVER I-395 BRIDGE STA. 164+60.00 PENOBSCOT COUNTY STATE OF MAINE DEPARTMENT OF TRANSPORTATION		
STATE CONTRACT OR REF. NO.	6	CONTRACTOR CIANBRO CORP.
IN CHARGE	HINKLE	MADE BY JLC
CHK'D BY	BJK	DATE: 5-9-84
CONTRACT NUMBER	ME-84088-1	DRAWING NUMBER WS3

R95-103




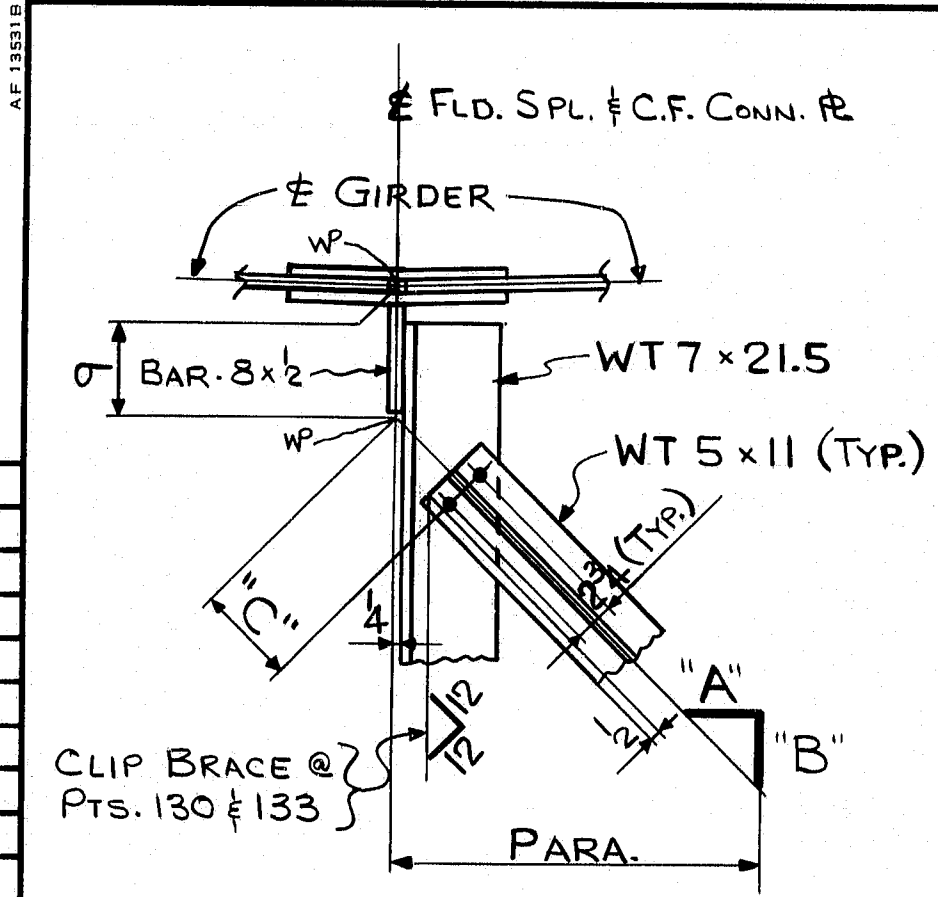


POINT	"A"	"B"	"C"
130	11 1/8	12	6 3/8
133	12	11 1/8	6 3/8
135		8 1/8	5 1/2
138		8 1/8	5 1/2
141		9 1/4	5 3/8
144		8 1/8	5 1/2
146		8 1/8	5 1/2
149	12	8 1/8	5 1/2

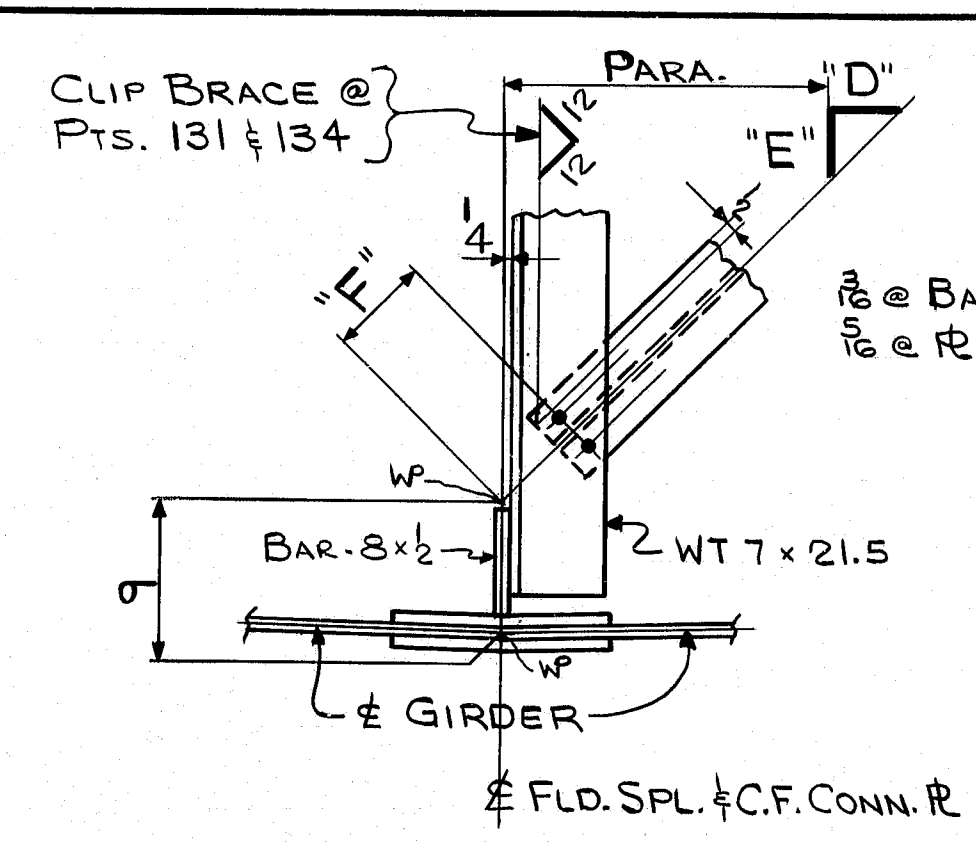


POINT	"D"	"E"	"F"
131	12	11 1/8	6 3/8
134	11 1/8	12	6 3/8
136	12	9 1/8	5 1/8
139		10 1/4	5 1/8
140		8 3/8	5 1/2
143		9 1/8	5 1/8
145		9 1/2	5 3/4
148	12	9 1/8	5 1/8

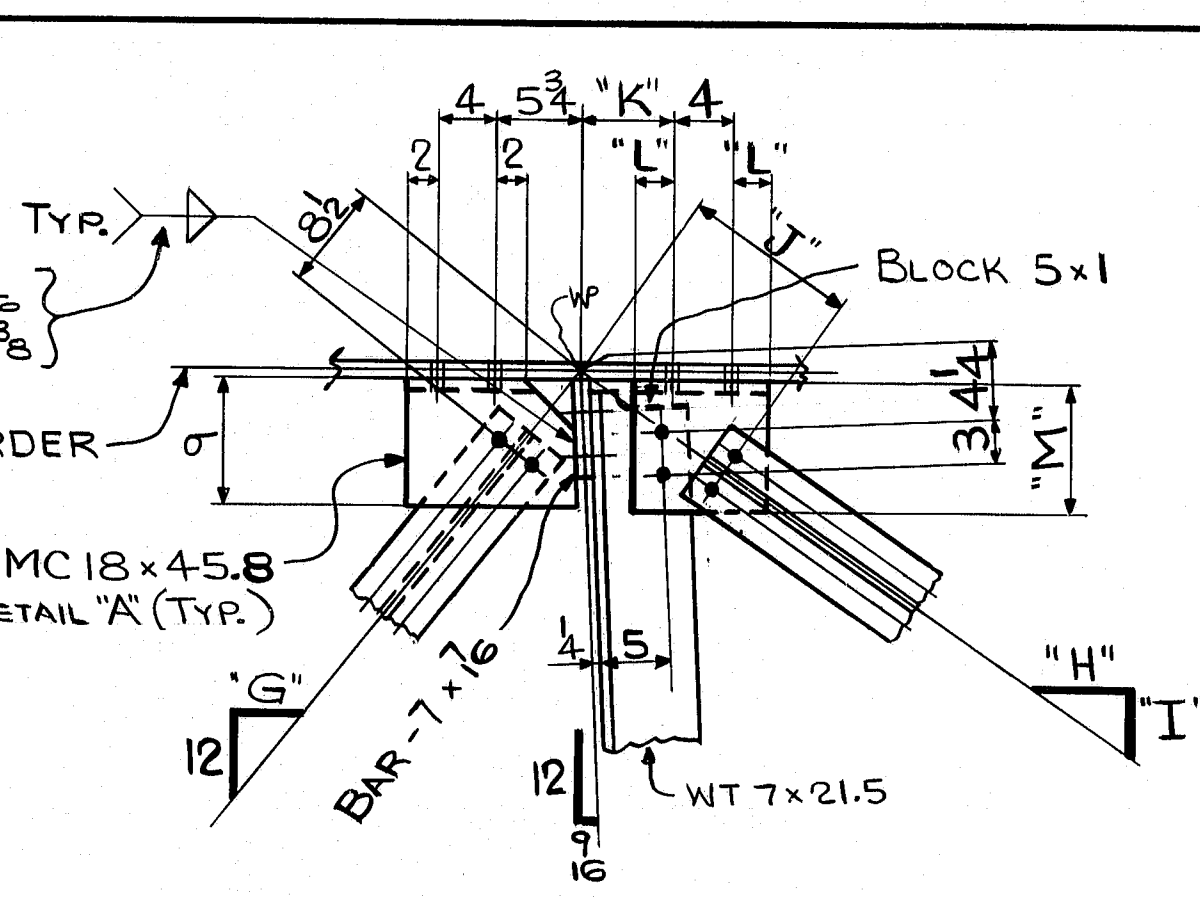



POINT	"G"	"H"	"I"	"J"	"K"	"L"	"M"
80	11 1/8	10 5/8	12	1-3 1/2	6 3/8	2 5/8	1-2
90	9 1/8	12	8 3/8	1-0	6	2 1/4	9 1/4

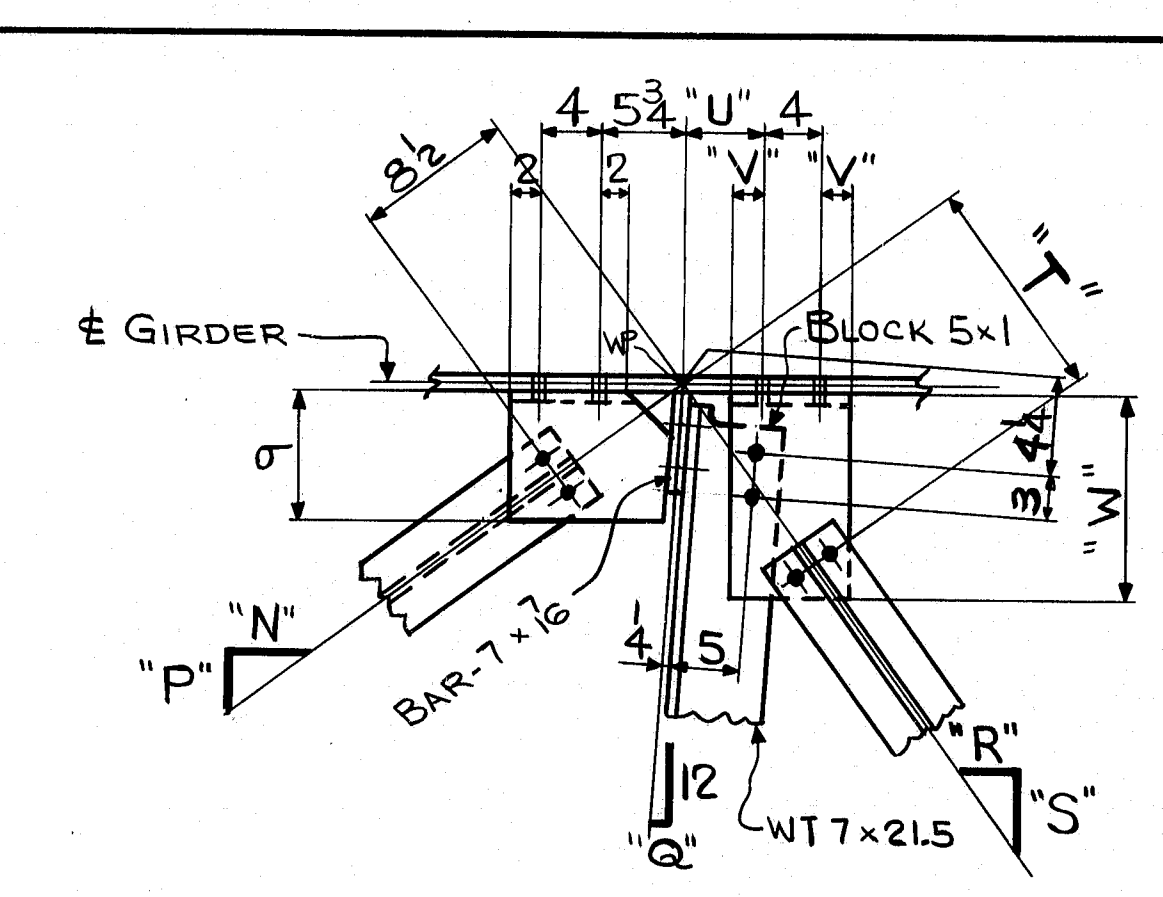


POINT	"N"	"P"	"Q"	"R"	"S"	"T"	"U"	"V"	"W"
83	11 1/8	12	9 1/8	12	1-3	5 1/8	2 1/4	1-1 3/4	
85	12	9 1/8	7 1/8	9	1-3	5 1/8	2 1/8	1-2 1/4	
88	12	8 3/8	8 3/8	12	1-3	5 1/4	2 1/8	1-2 1/4	
93	10 1/8	12	8 1/8	12	8 3/4	1-0	5 1/8	2 1/4	9 1/2
95	9 1/8	12	7 1/8	12	9 1/8	1-0	5 1/4	2 1/4	9 3/4
98	10 1/8	12	8 1/8	12	9 3/8	1-0	5 1/2	2 1/4	9 3/4

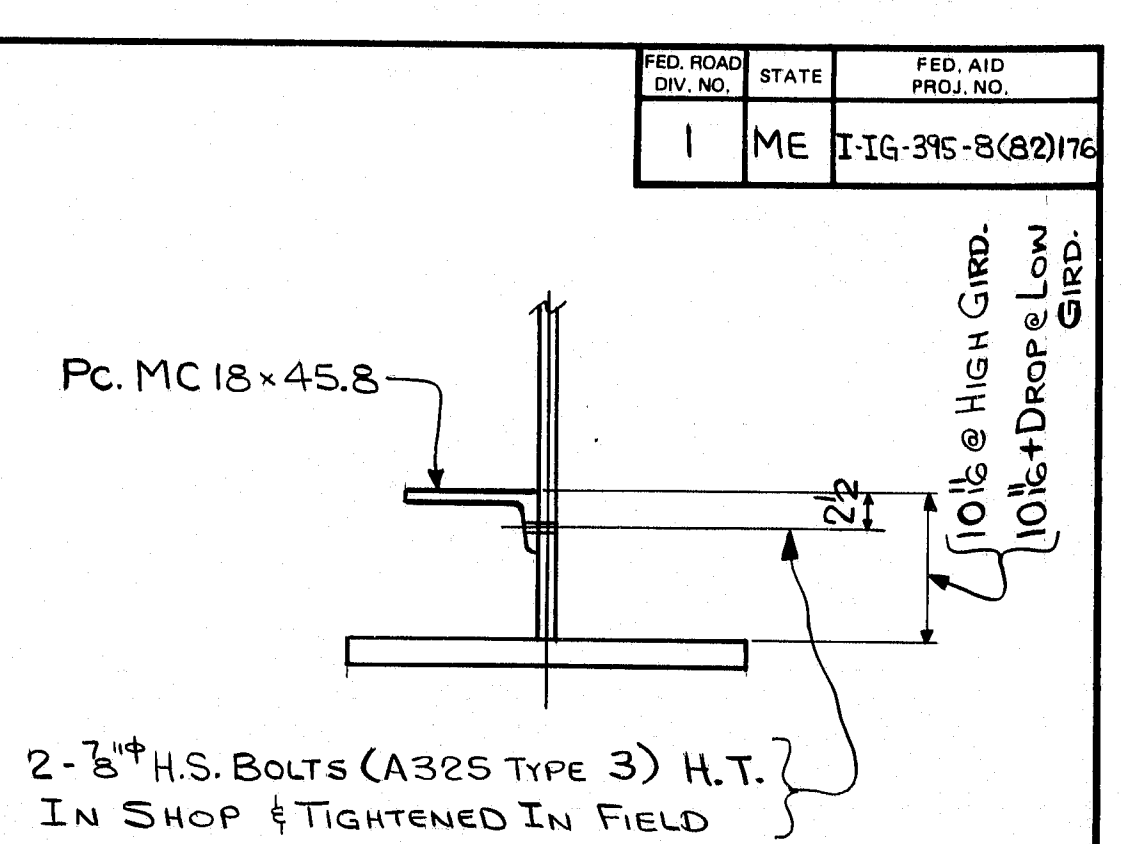


DETAIL "A"

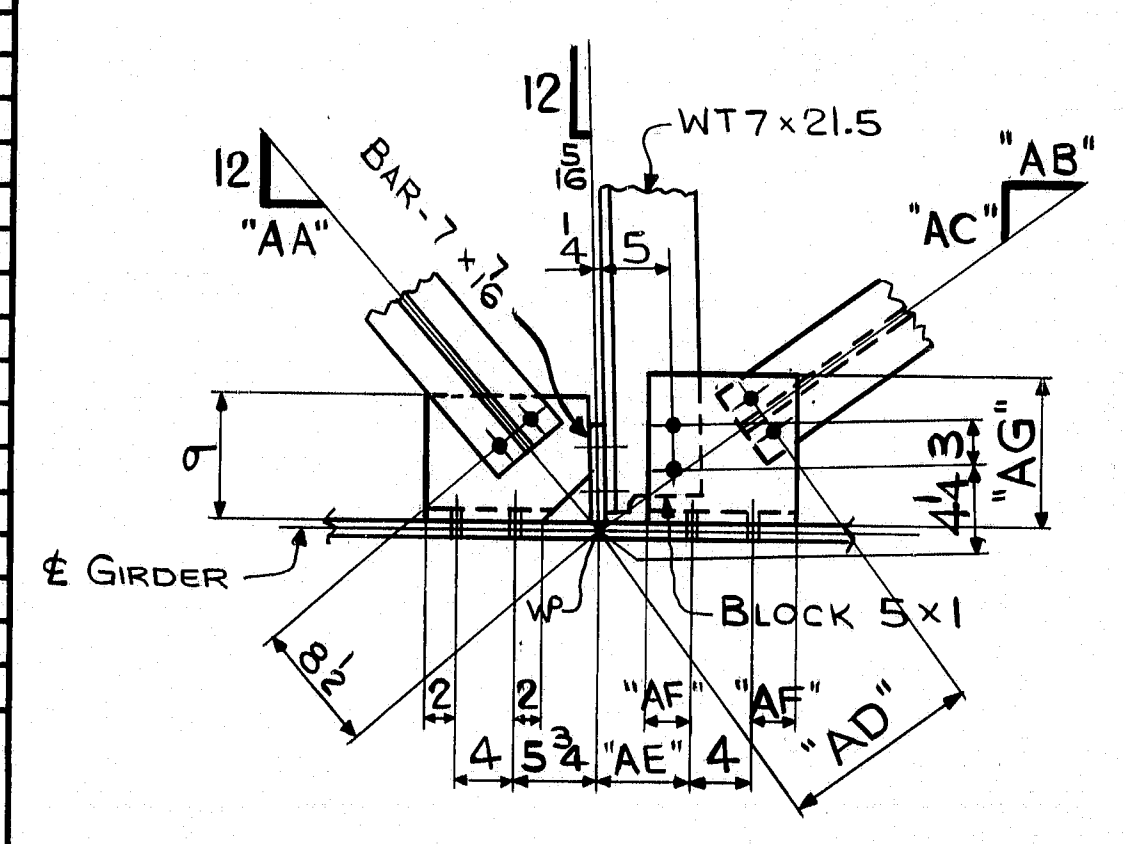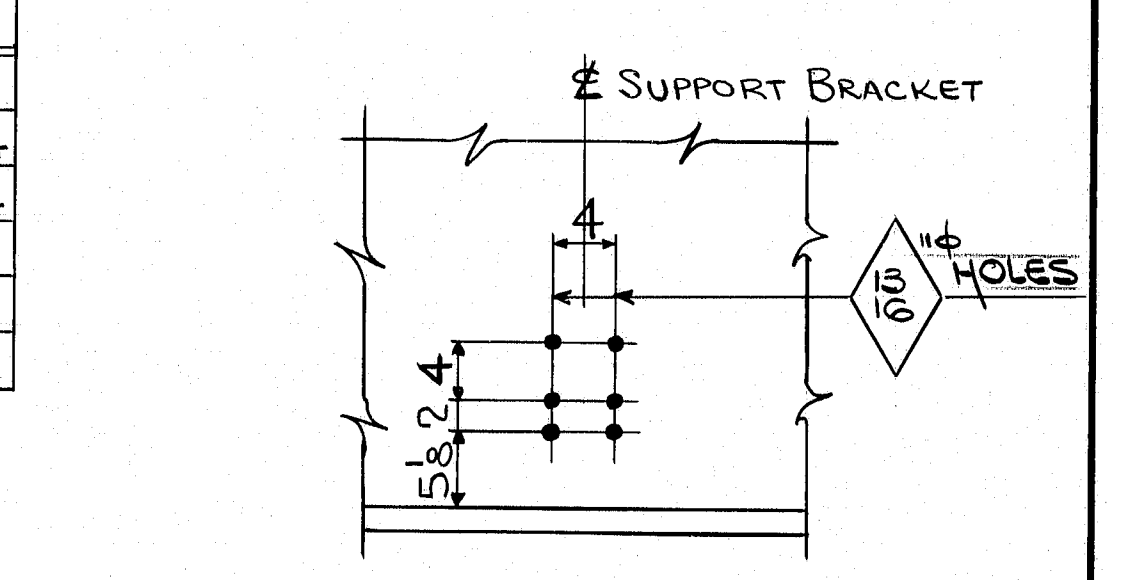


POINT	"AA"	"AB"	"AC"	"AD"	"AE"	"AF"	"AG"
81	11 1/8	9 1/8	12	1-5 1/4	6 5/8	3 1/8	1-3 1/2
91	10 3/8	12	8 1/8	1-1 1/4	6 3/8	2 3/8	10 1/4

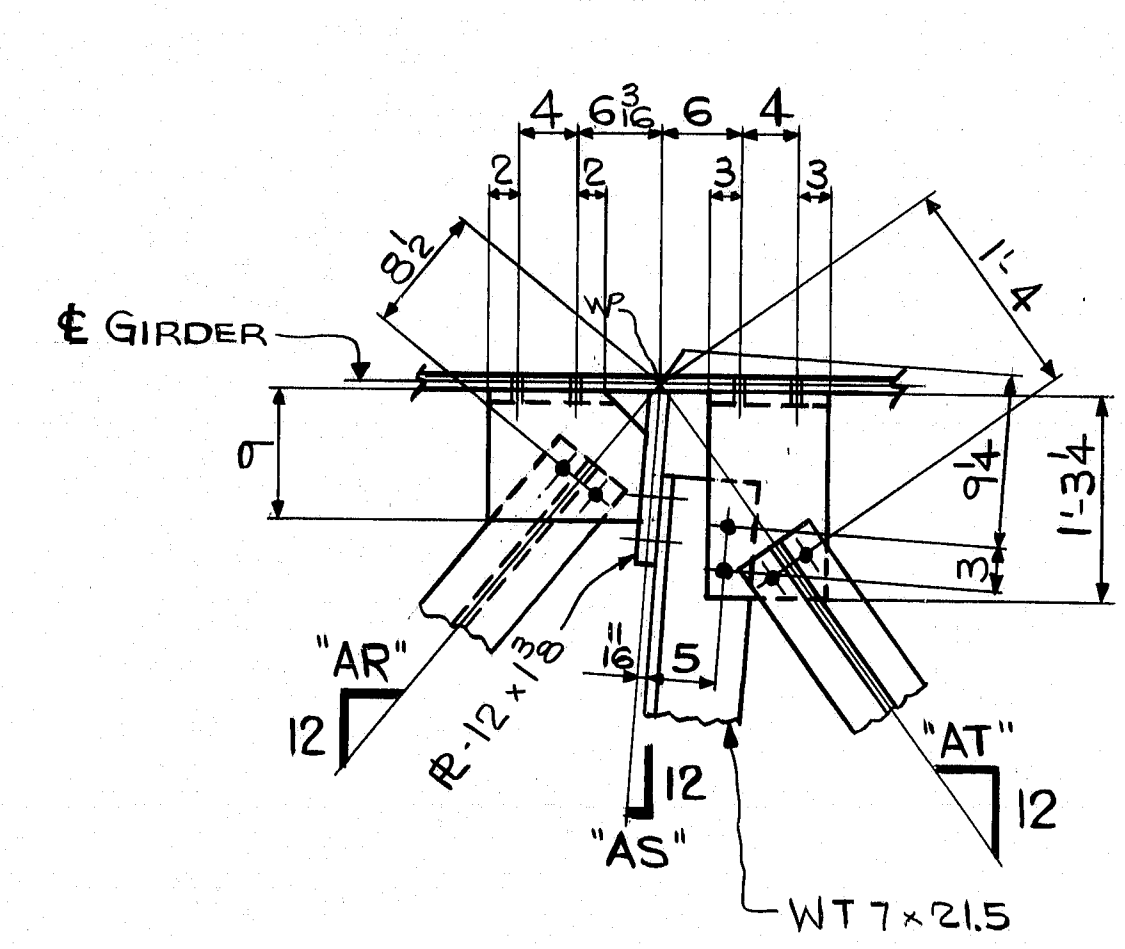


POINT	"AR"	"AS"	"AT"
33	10 1/8	7 1/8	10 1/8
35	9 1/8	7 1/8	9 1/8
38	10 1/4	8	8 1/8

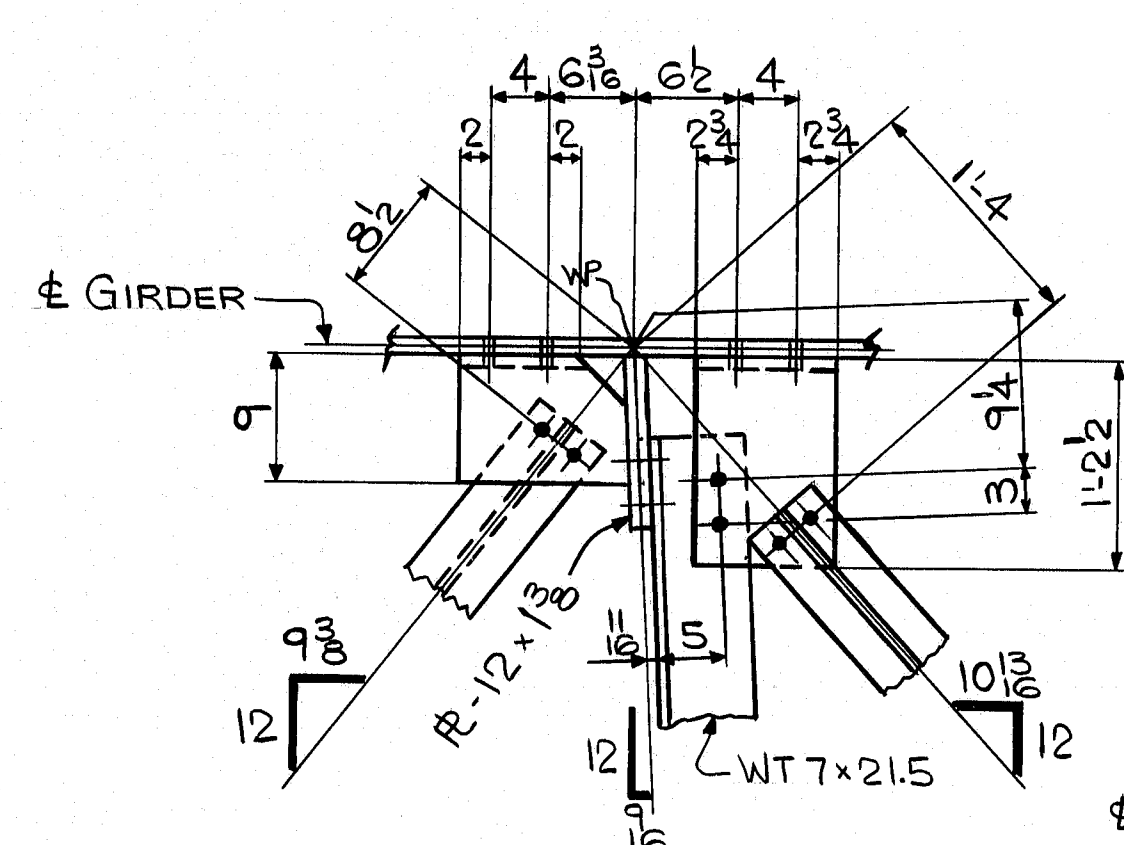


POINT - 30

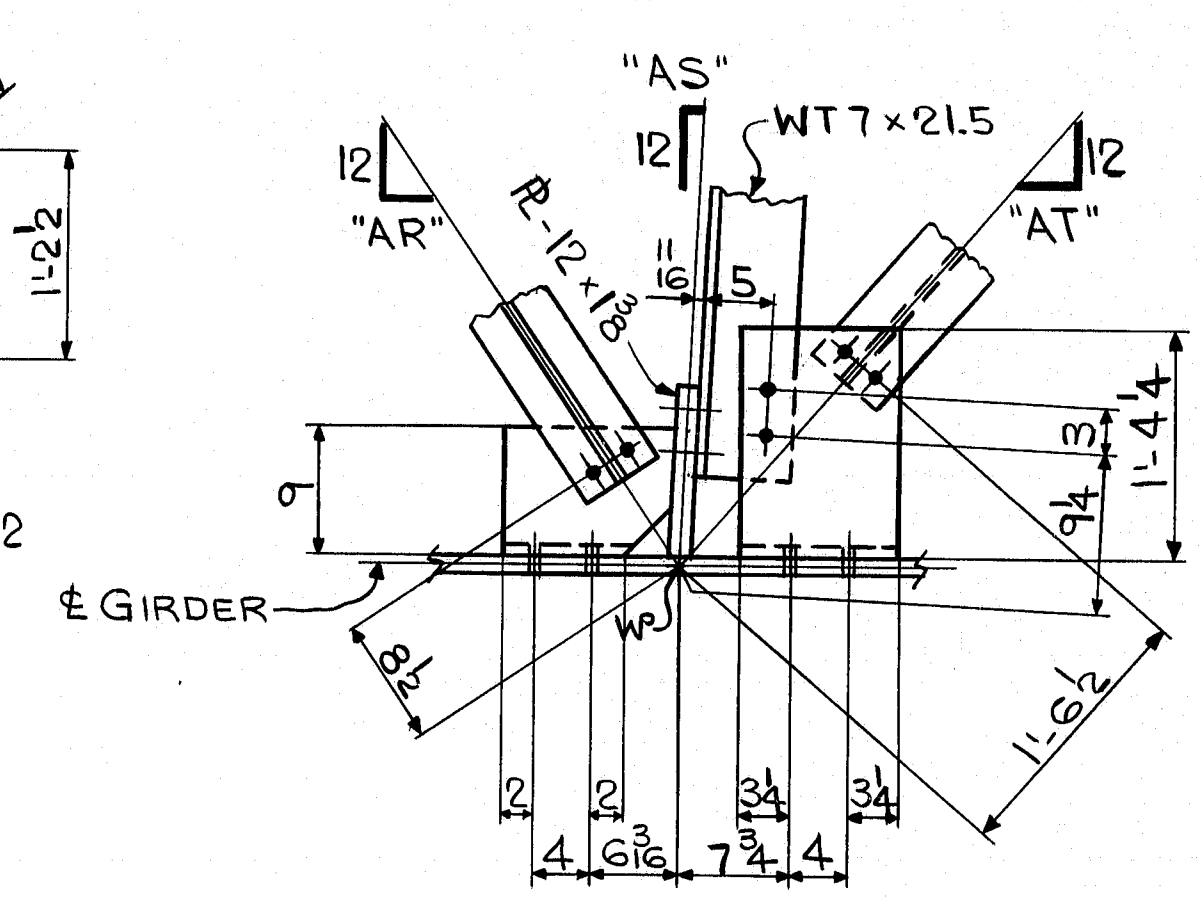


POINT	"AR"	"AS"	"AT"
34	9 1/2	7 1/8	10 3/4
36	8 1/8	7 1/8	10 1/8
39	8 1/8	1	10 1/8

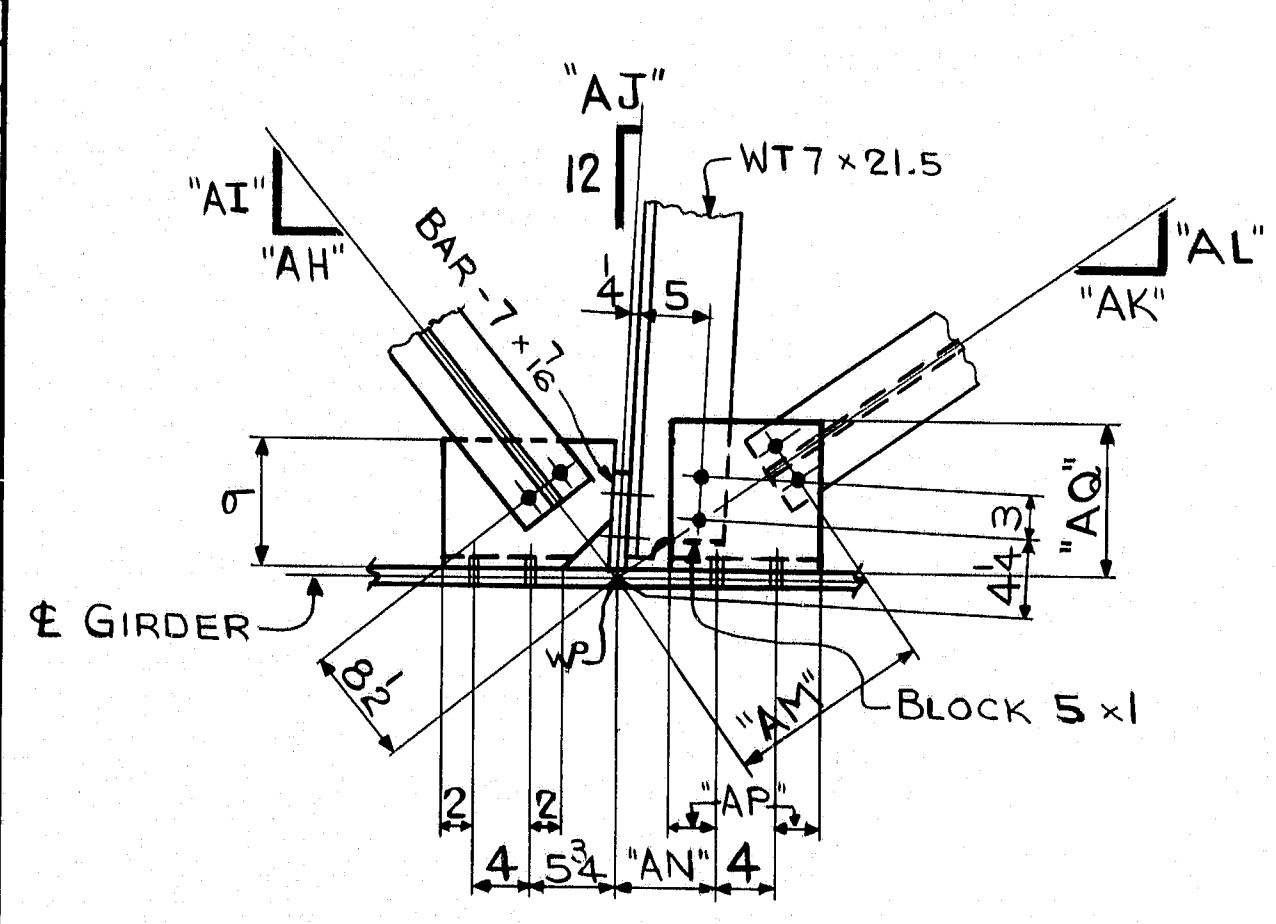

POINT	"AH"	"AI"	"AJ"	"AK"	"AL"	"AM"	"AN"	"AP"	"AQ"
84	11 1/8	12	16	10 1/4	12	1-5 3/4	7	3 1/4	1-3 1/2
86	12	9 1/8	16	10 1/4	12	1-5 3/4	6 3/8	3 1/8	1-3 3/4
89	12	9 1/8	1	10 1/2	12	1-5 3/4	7	3 1/4	1-3 3/4
94	9 3/8	12	7 1/8	12	8 1/8	1-2 1/2			
96	8 3/8	12	7 1/8	12	8 1/8	1-2 1/2			
99	8 1/2	12	1	12	8 3/8	1-2 1/2	7	3 1/4	

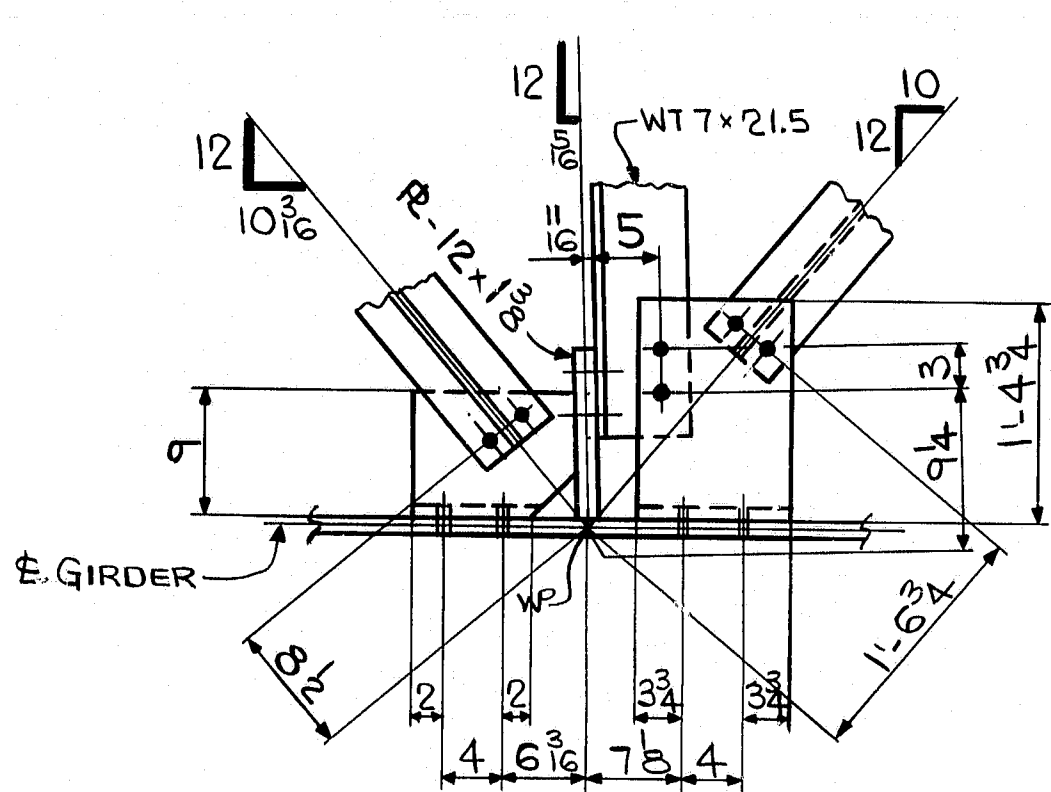

POINT - 31

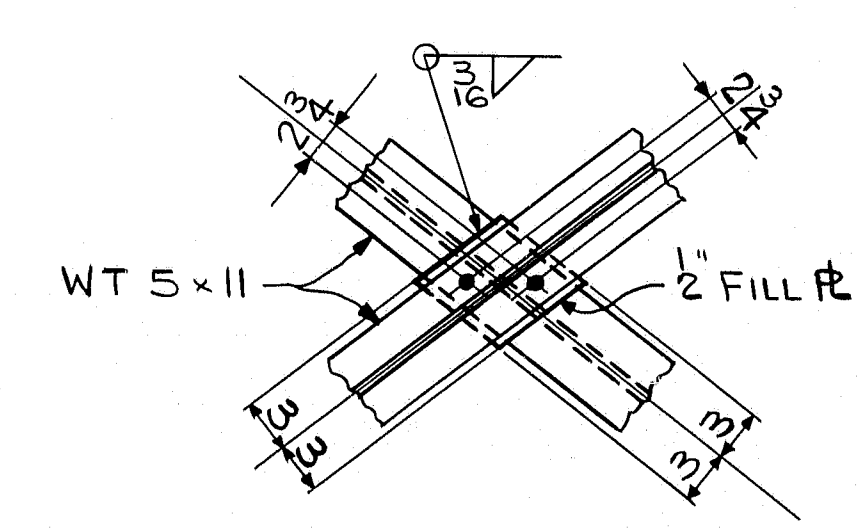

TYP. BRACING INTERSECTION CONN.



R95-104

WORK THIS DWG. WITH DWGS. - WS1, WS2, & WS3

NO.	REVISION	DATE
<b>HIGH STEEL STRUCTURES, INC.</b> <small>1905 Old Philadelphia Pike Lancaster, Pennsylvania 17603 Phone 717/298-8211 A Subsidiary of High Industries, Inc.</small>		
BRACING LAYOUTS		
I-395 BRIDGE OVER PENOBSCOT RIVER		
I-395 BRIDGE STA. 164+60.00		
PENOBSCOT COUNTY		
STATE OF MAINE		
DEPARTMENT OF TRANSPORTATION		
STATE CONTRACT OR REF. NO.	CONTRACTOR	DATE
G	CIANBRO CORP.	5/21/84
IN CHARGE: HINKLE	MADE BY: JLC	CHK'D BY: CS
CONTRACT ME-84088-1		DRAWING NUMBER: WS4




FED. ROAD DIV. NO.	STATE	FED. AID PROJ. NO.
1	ME	114-395-8(82)76

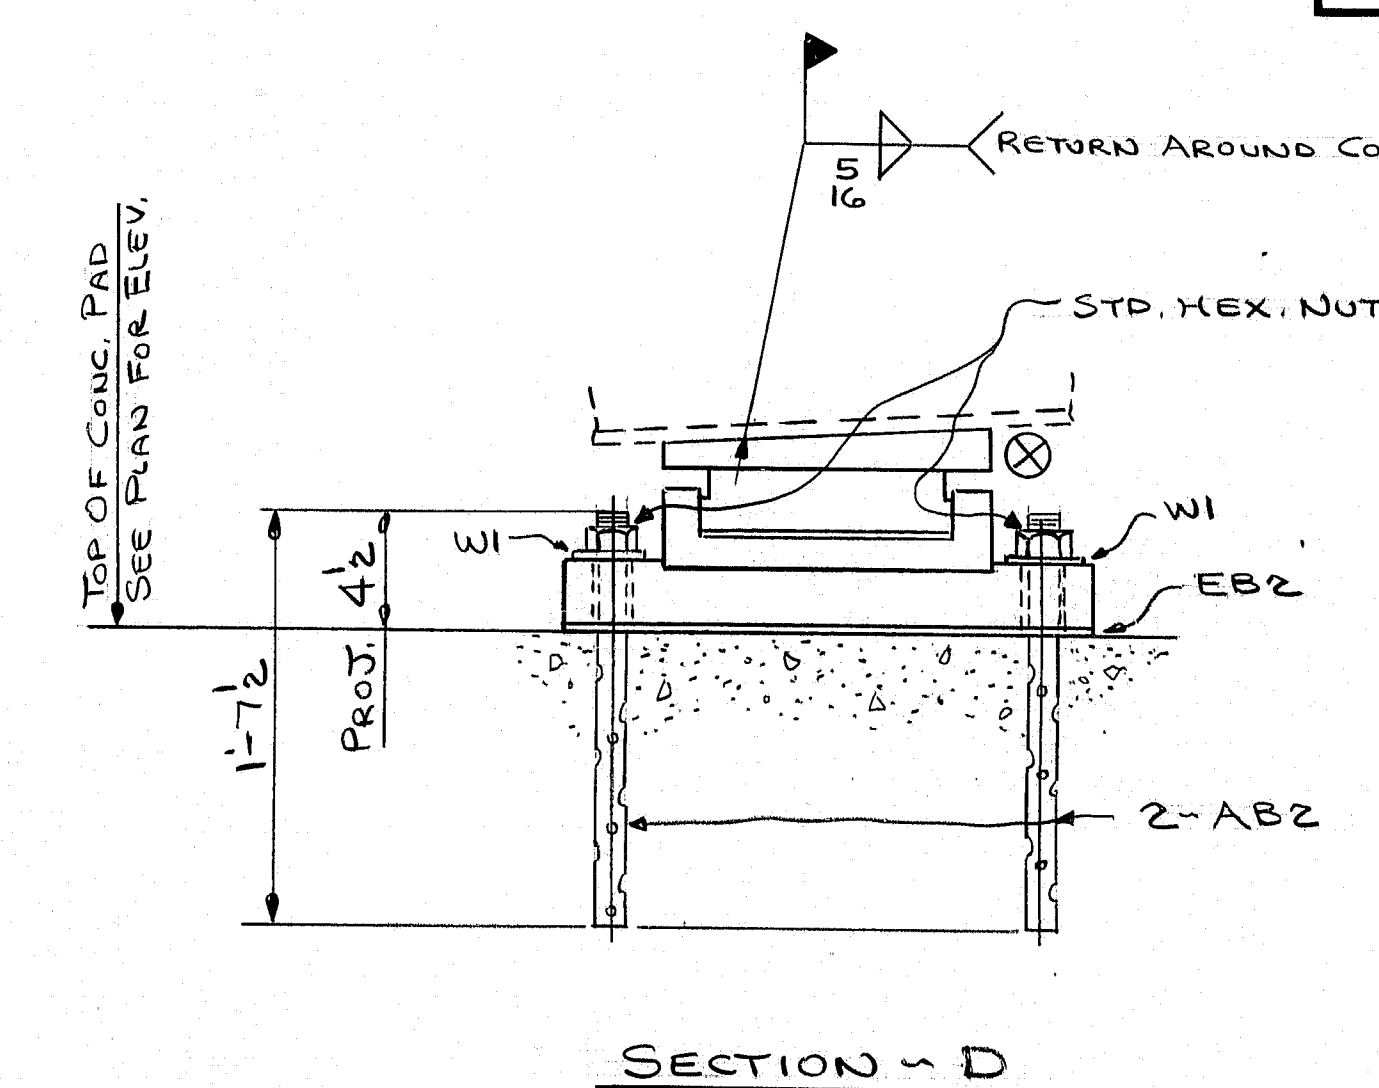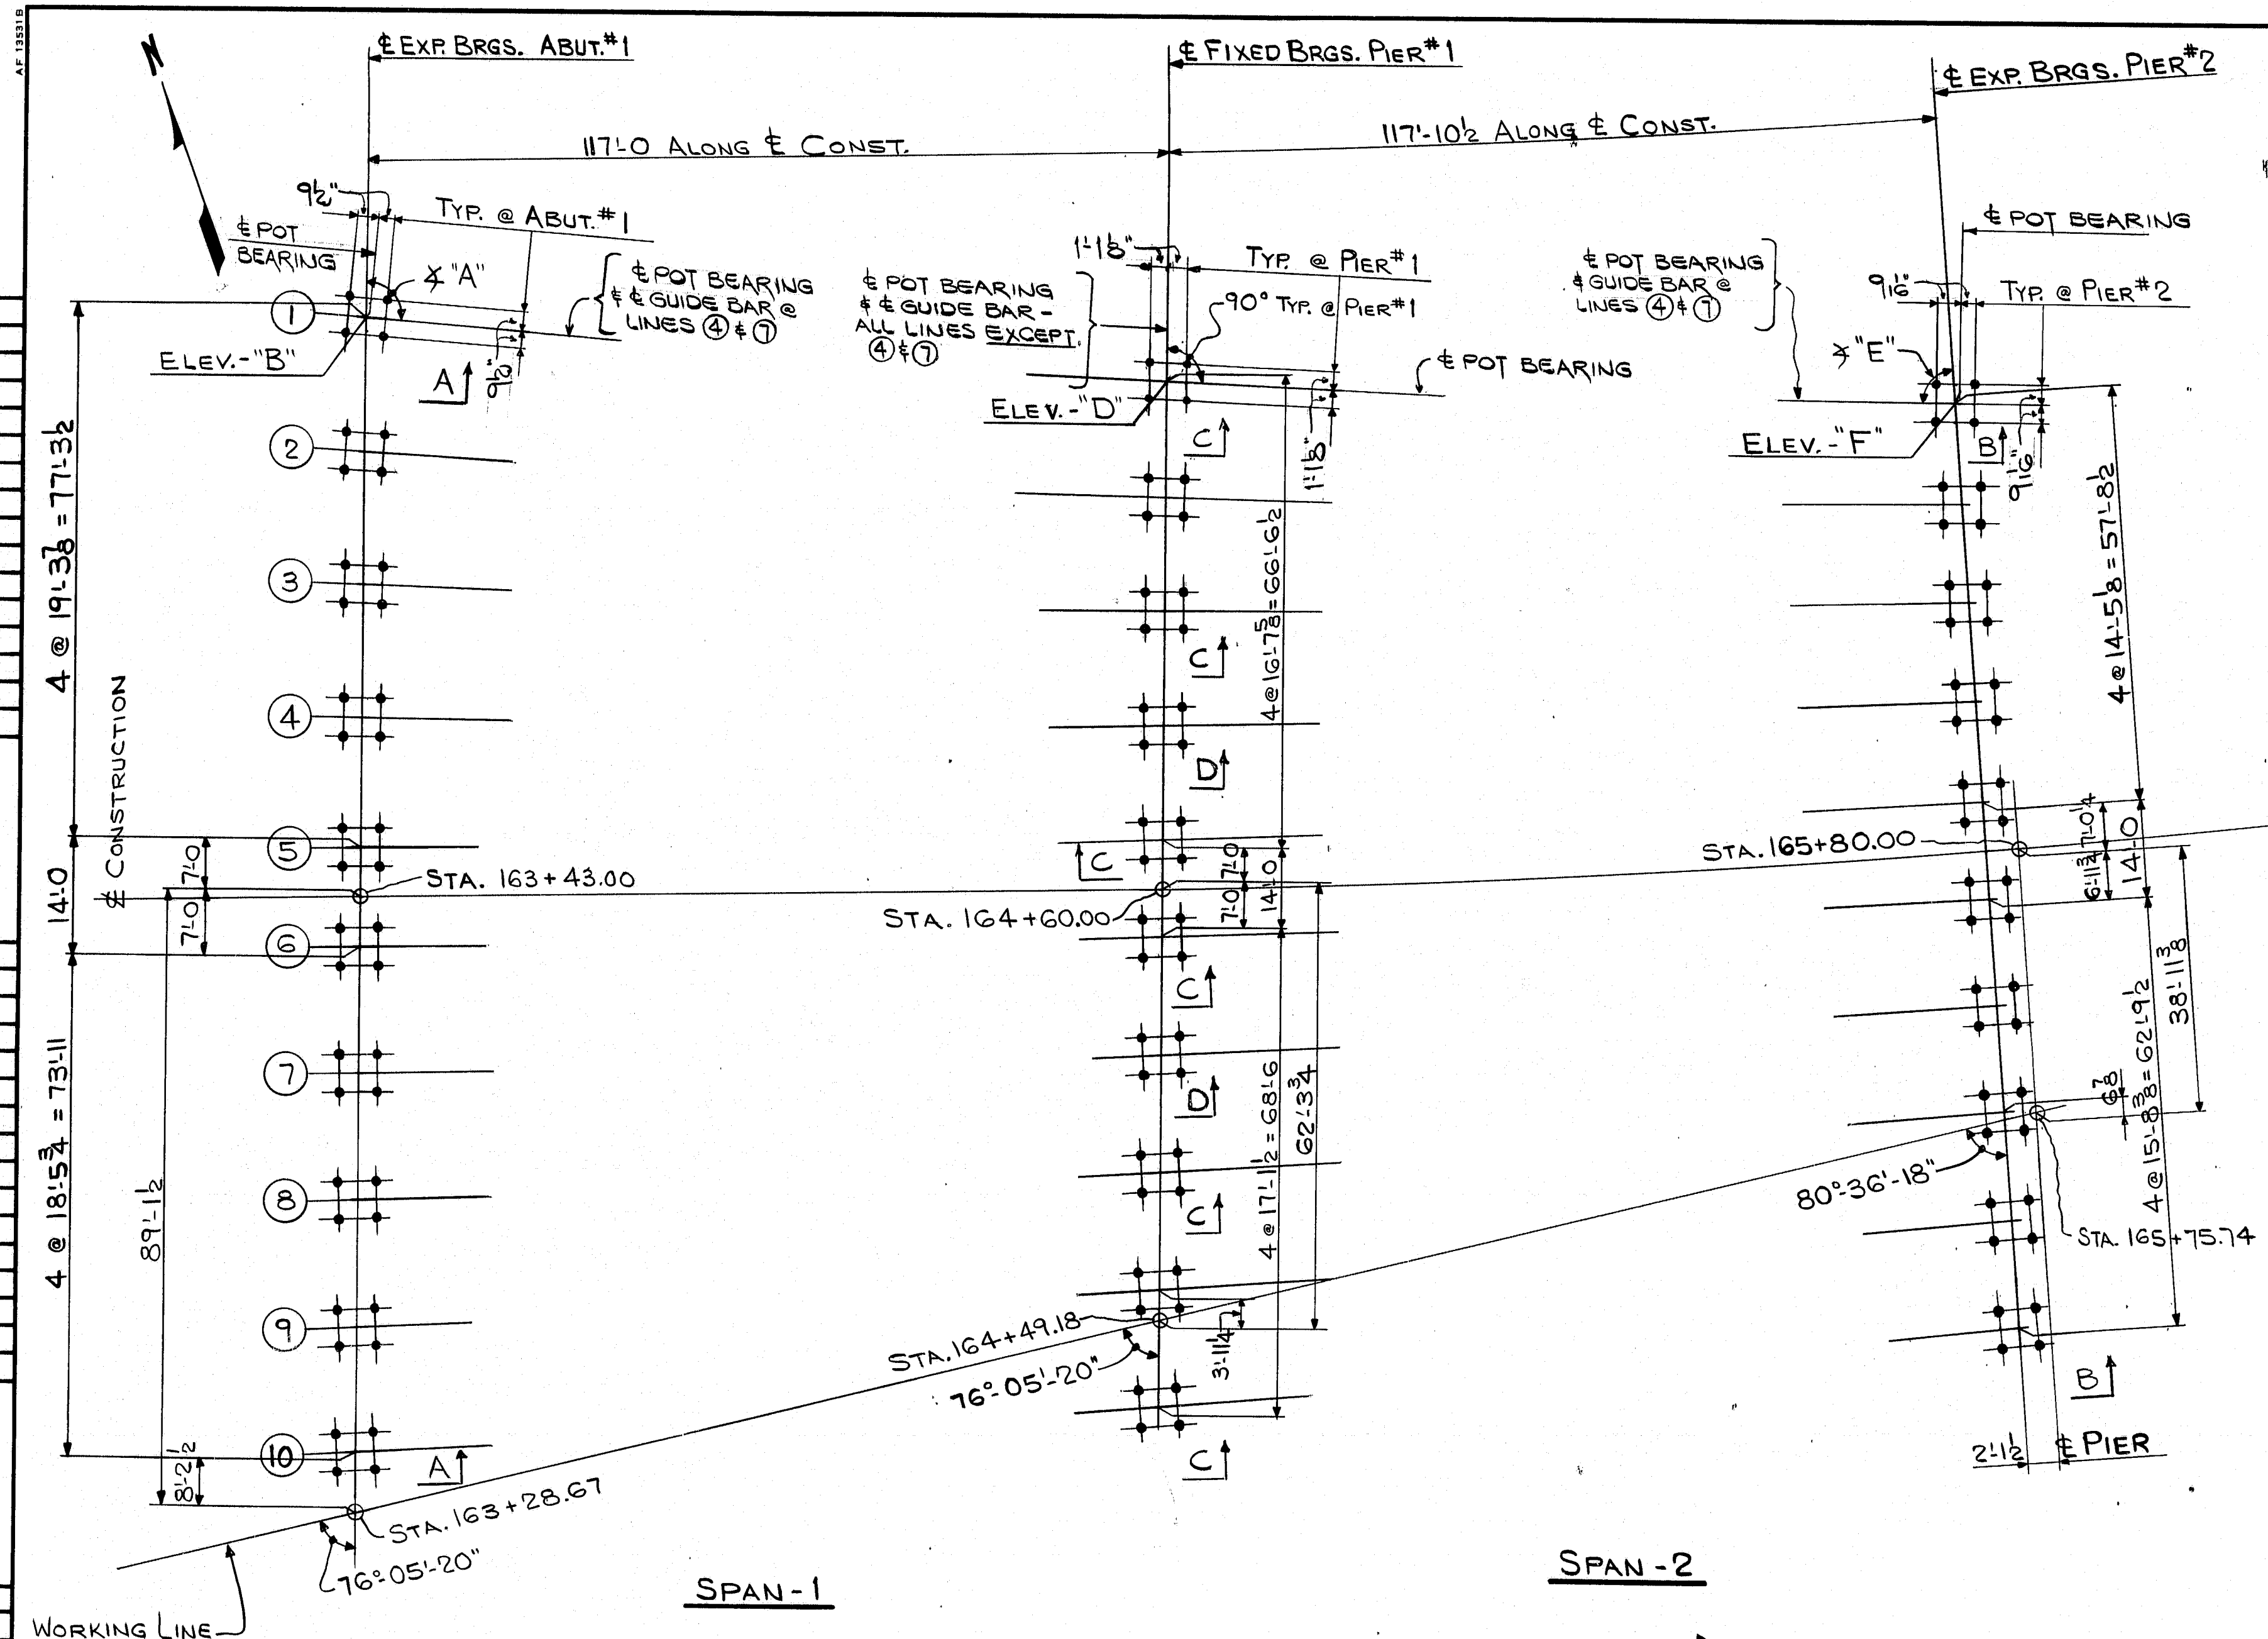

- NOTES:
1. All dimensions are given horizontally.
  2. Elevations are given to top of concrete pad.
  3. Anchor bolt settings must be exact in every detail in accordance with this drawing.
  4. Anchor bolts are furnished by High Steel Structures, Inc., and set by others.
  5. FOR POT BEARINGS: SEE DRAWINGS D-1001-1A THRU D-1001-1F & D-1003-1A.
  6. THICKEST EDGE OF SOLE PLATE MARKED THUS ⊗
  7. TOP OF CONCRETE ELEVATIONS & ANCHOR BOLT SPACINGS HAVE BEEN MADE TO CONFORM TO BEARING DETAILS ON DWS D-1001-1A.
  8. SPECIAL BRIDGE SEAT PREPARATION & GROUTING OF ANCHOR BOLT HOLES, REQUIRED BY CONTRACT DOCUMENTS, BY OTHERS THAN HIGH STEEL STRUCTURES, INC.
  9. UPSET THREADS ABOVE NUT FOR ALL ANCHOR BOLTS. (AB MARKS)



LINE	"A"	"B"	"D"	"E"	"F"
1	94°00'00"	74.86	78.10	84°20'49"	81.15
2	92°53'20"	75.92	78.93	85°29'36"	81.80
3	91°34'28"	76.97	79.76	86°37'02"	82.45
4	90°15'31"	77.90	80.57	87°43'05"	83.10
5	88°56'32"	78.34	81.10	88°47'46"	83.75
6	88°56'32"	78.35	81.11	88°47'11"	83.78
7	88°16'46"	78.89	81.89	89°27'26"	84.49
8	87°37'01"	79.43	82.53	90°06'34"	85.20
9	86°57'19"	80.13	83.26	90°45'18"	85.90
10	86°15'39"	80.96	84.02	91°22'57"	86.61

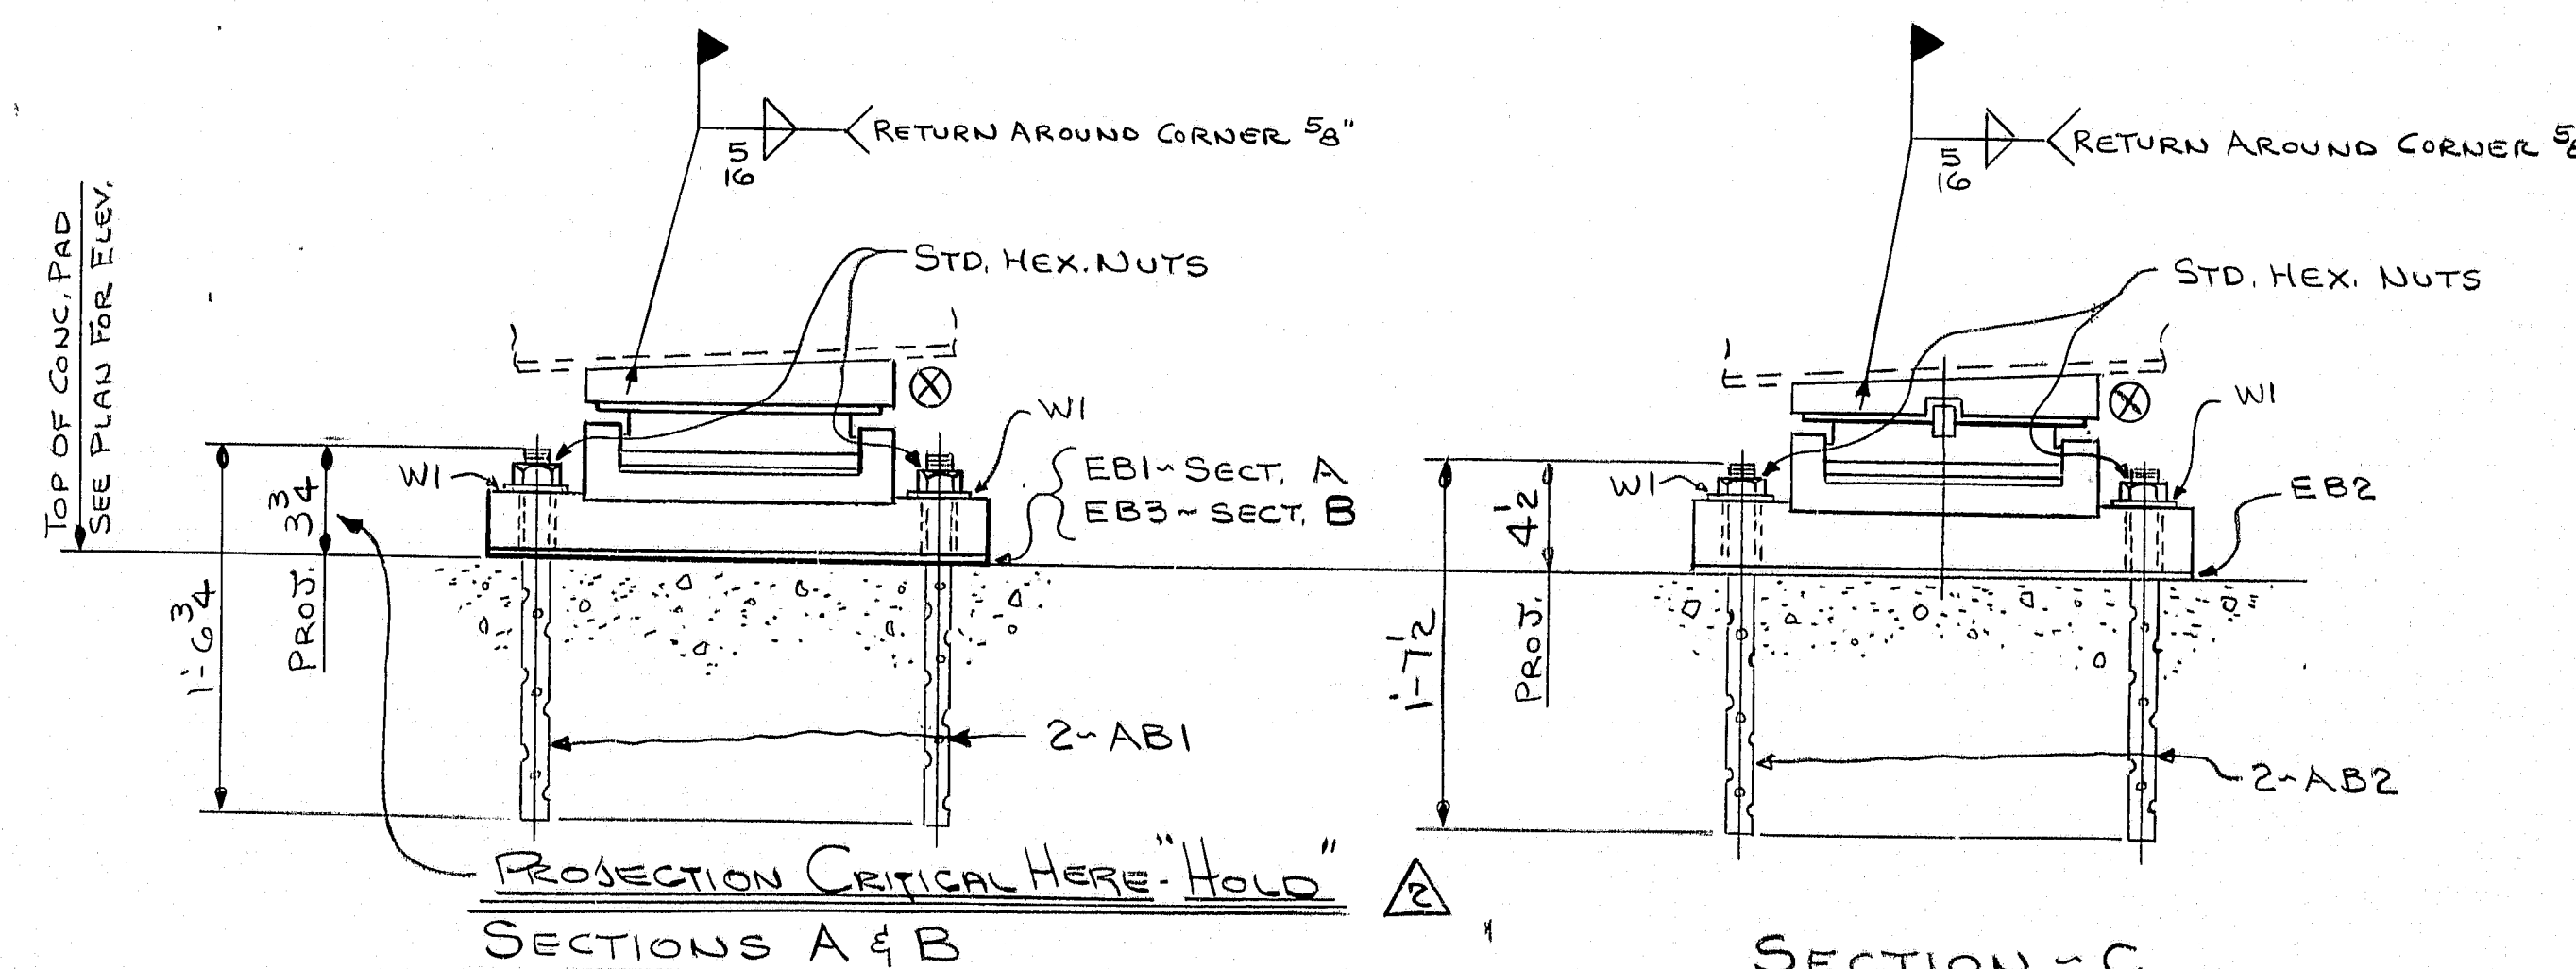

10-11 APRIL NOTES			
NO. 1	REVISION	REVISED ELEVATIONS AS PER DES. REV.	DATE 9-28-84
NO. 2	REVISION	GENERAL REVISION TO AGREE WITH POT BEARINGS	DATE 10-17-84
<b>HIGH STEEL STRUCTURES, INC.</b> 1905 Old Philadelphia Pike Lancaster, Pennsylvania 17603 Phone 717/298-5211 A Subsidiary of High Industries, Inc.			
<b>ANCHOR BOLT PLAN</b> <b>I-395 BRIDGE OVER PENOBSCOT RIVER</b> <b>I-395 BRIDGE STA. 164+60.00</b> <b>PENOBSCOT COUNTY</b> <b>STATE OF MAINE</b> <b>DEPARTMENT OF TRANSPORTATION</b>			
STATE CONTRACT OR REF. NO.	6	CONTRACTOR	CIAMBRO CORP.
IN CHARGE	HINKLE	MADE BY	J.L.C. CHK'D BY CS
CONTRACT NUMBER	ME-84088-1	DRAWING NUMBER	E1A

R95-105



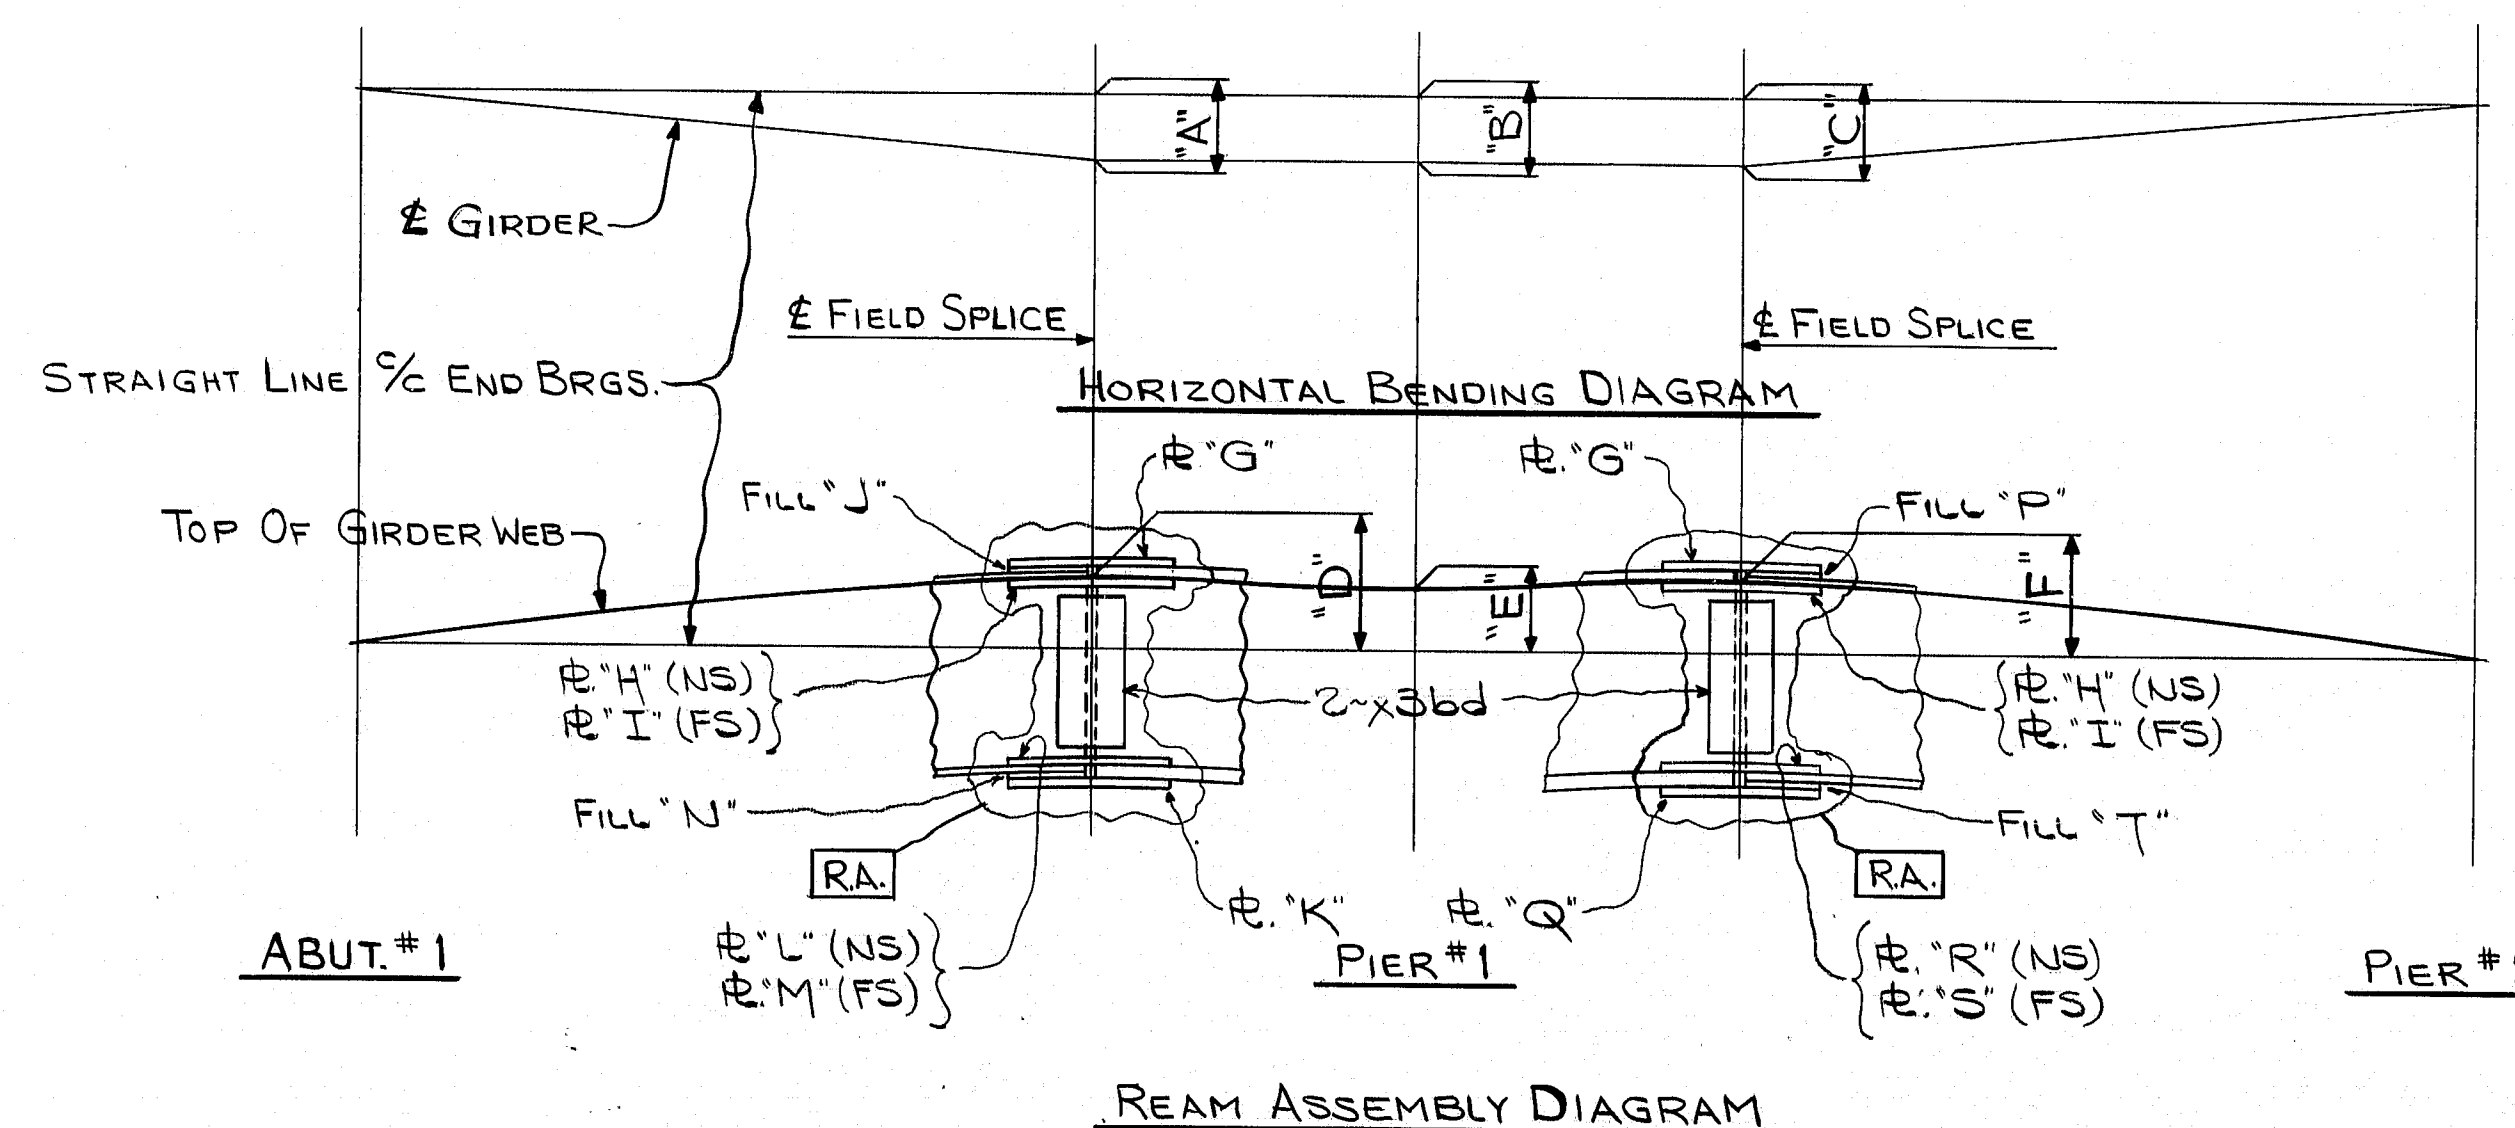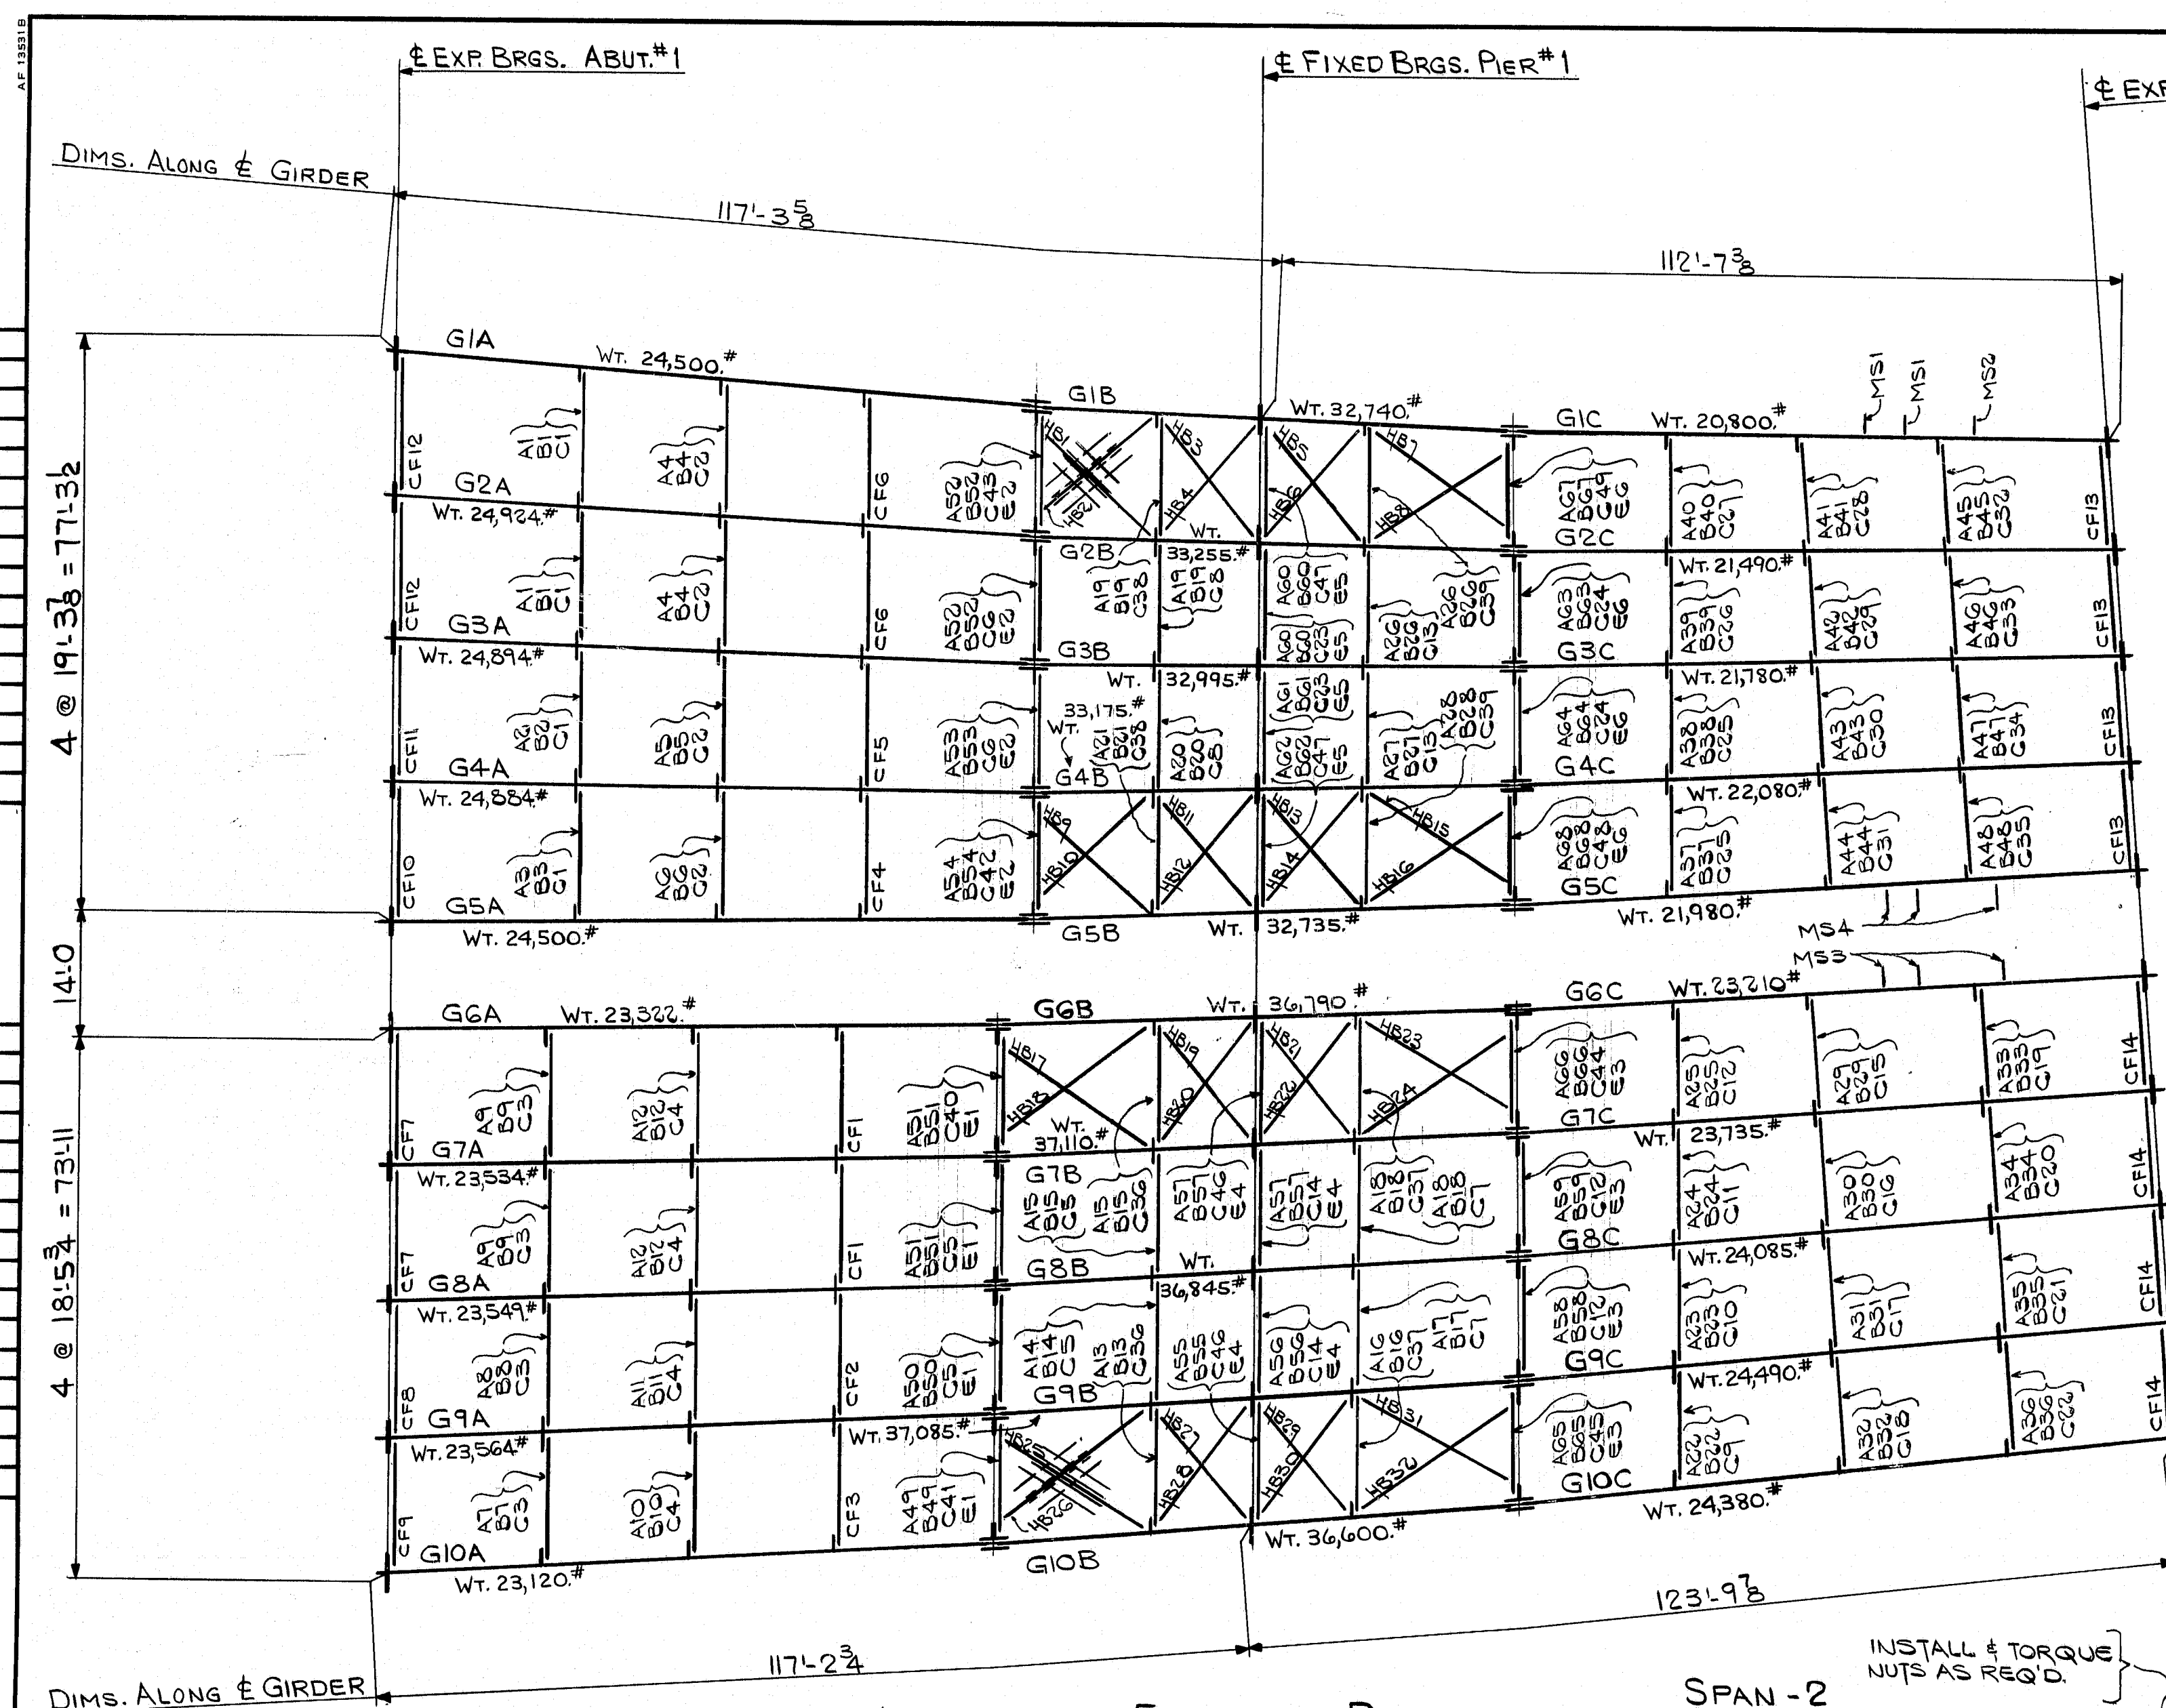

GIRDER	A	B	C	D	E	F	G	H	I	J	K	L	M	N	P	Q	R	S	T

### FIELD BOLT SUMMARY

HIGH STRENGTH (A325 TYPE 3) BOLTS  
W/ H.V. HEX. HD. & A563 GRADE CS H.V. HEX. NUT


1045-3" H.S. Bolts x 0'-2" LG.  
1230-  
320-  
135-  
1730-  
135-  
20-  
420-  
335-  
335-3" H.S. Bolts x 0'-5" LG.

5705-HARD FLAT WASH. FOR 3" H.S. BOLTS (F436 WEATHERING)


75-H.V. HEX. NUTS FOR 1" H.S. BOLTS (A563 GR. CS)  
75-HARD FLAT WASH. FOR 1" H.S. BOLTS (F436 WEATHERING)

### NOTES:

1. ALL DIMENSIONS ARE GIVEN HORIZONTALLY.
2. ALL STEEL TO BE A588 (U.N.) UNPAINTED.
3. ALL FIELD CONNECTIONS ARE TO BE MADE WITH 7/8" H.S. BOLTS A325 TYPE-3.
4. FOR BEARING ASSEMBLIES SEE DWG. E1.
5. STUD SHEAR CONNECTORS, EXPANSION DAM MATERIAL, AND CATWALK FRAMING NOT BY H.S.S. INC.
6. FOR GENERAL NOTES SEE DWG. N1.
7. BOLTS FOR GUSSET CHANNELS TO BE TORQUED IN FIELD.

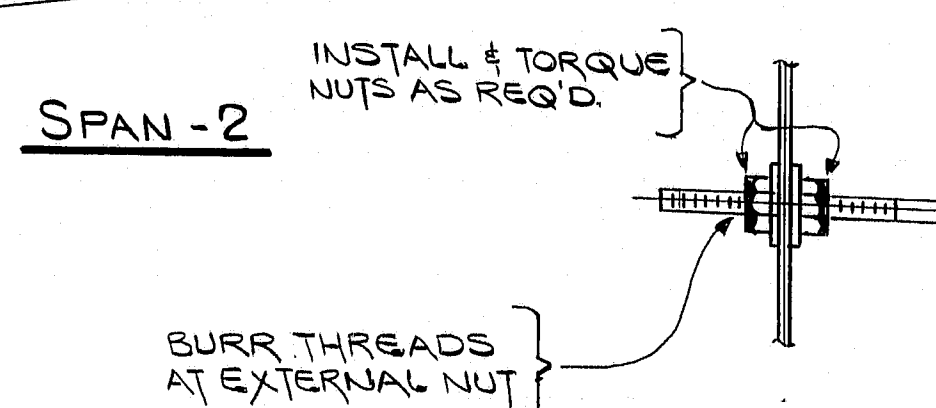

### HANDRAIL TERMINATION

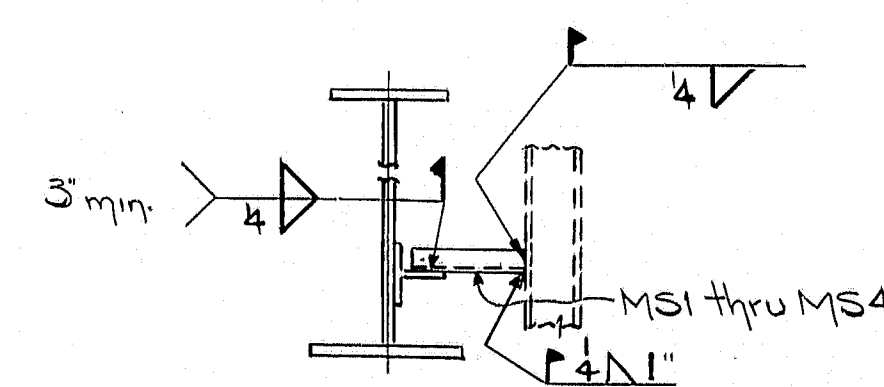

### FIELD WELD FOR SCUPPER ANGLES

### ERECTION NOTE:


No credit will be allowed for work performed by others in replacing or correcting materials or workmanship covered by this drawing unless expressly authorized by High Steel Structures, Inc.

NO.	REVISION	CONTRACT REVISION	DATE
1	1	1	10-24
HIGH STEEL STRUCTURES, INC.			
1900 Old Philadelphia Pike Lancaster, Pennsylvania 17603 Phone 717/299-5211			
A Subsidiary of High Industries, Inc.			
ERECTION PLAN			
I-95 BRIDGE OVER PENOBSCOT RIVER			
I-95 BRIDGE STA. 164+60.00			
PENOBSCOT COUNTY			
STATE OF MAINE			
DEPARTMENT OF TRANSPORTATION			
STATE CONTRACT OR REF. NO.	CONTRACTOR	DATE	
6	DIAMOND CORP.	10-24	
IN CHARGE:	BY:	CHK'D BY:	DATE:
HINKLE	CS	G.F.E.	7-6-84
CONTRACT NUMBER:	DRAWING NUMBER:	E2	
ME-84088-1			

R95-106



FED. ROAD DIST. NO.	STATE	FED. AID PROJ. NO.
1	ME	114-395-8(82) MC

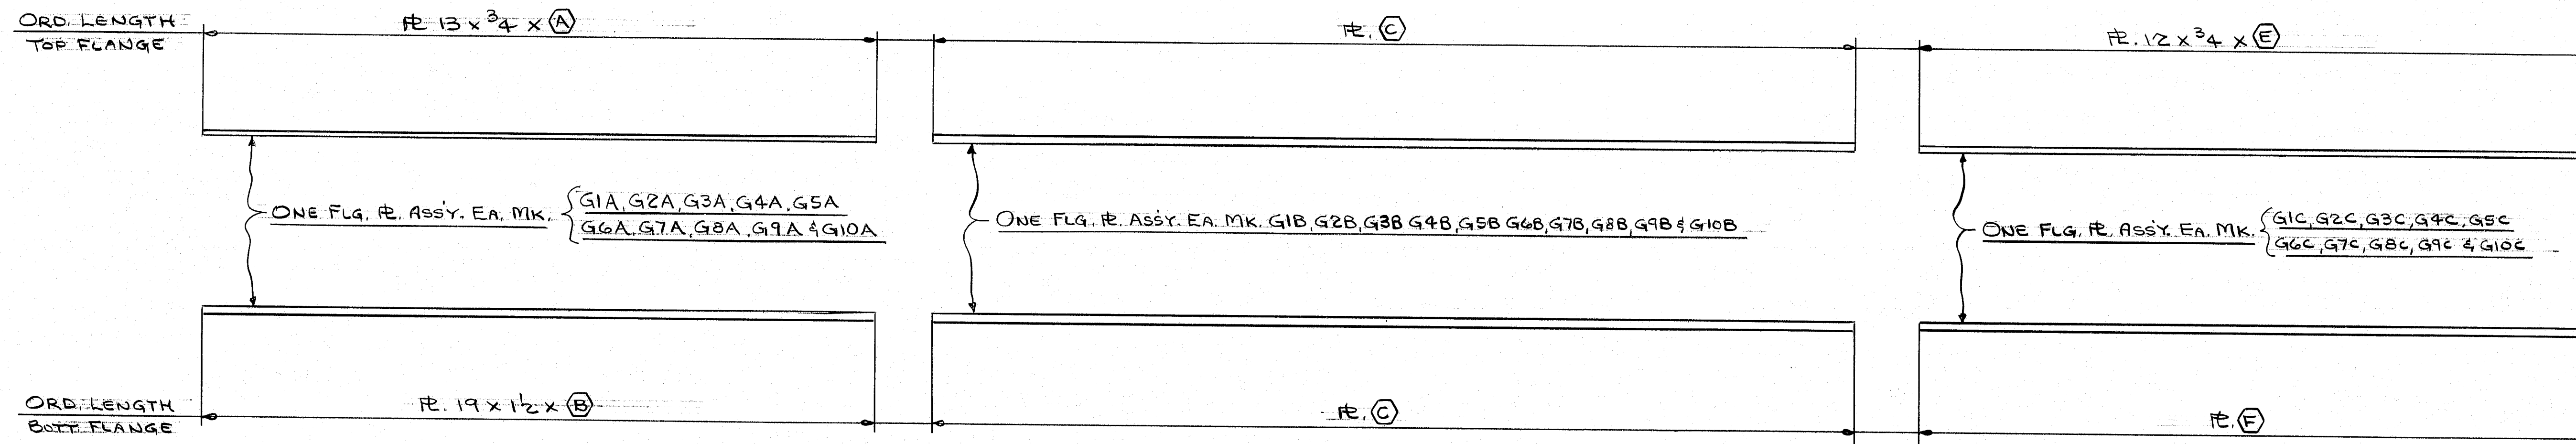

MARK	(A)	(B)
G1A	88'-4 1/16	88'-5 1/8
G2A	↑	↑
G3A	↓	↓
G4A	↓	↓
G5A	88'-4 1/16	88'-5 1/8
G6A	83'-3 1/17	83'-4 1/2 1/19
G7A	↑	↑
G8A	↓	↓
G9A	↓	↓
G10A	83'-3 1/17	83'-4 1/2 1/19

MARK	(C)
G1B	27 x 1 1/8 x 65'-2 1/20
G2B	↑
G3B	↓
G4B	↓
G5B	27 x 1 1/8 x 65'-2 1/20
G6B	27 x 1 3/4 x 70'-2 1/21
G7B	↑
G8B	↓
G9B	↓
G10B	27 x 1 3/4 x 70'-2 1/21

MARK	(E)	(F)
G1C	78'-11 1/2 1/22	18 x 1 3/8 x 78'-9 1/2
G2C	80'-0 1/2 1/23	18 x 1 3/8 x 79'-10 1/2 3/3
G3C	81'-2 1/2 1/24	18 x 1 3/8 x 81'-0 1/4
G4C	82'-4 1/2 1/25	18 x 1 3/8 x 82'-2 1/2 2/5
G5C	83'-7 1/2 1/26	18 x 1 3/8 x 83'-5 1/2 1/6
G6C	84'-9 1/2 1/27	18 x 1 1/2 x 84'-6 1/2 3/7
G7C	86'-1 1/2 1/28	18 x 1 1/2 x 85'-10 1/2 1/8
G8C	87'-5 1/2 1/29	18 x 1 1/2 x 87'-2 1/2 3/9
G9C	88'-9 1/2 1/30	18 x 1 1/2 x 88'-7 1/10
G10C	90'-1 1/2 1/31	18 x 1 1/2 x 89'-11 1/2 1/11

# NOTES:

FOR GENERAL NOTES, SEE DWG. N1.  
ALL STEEL TO BE A.S.T.M. A588  
WITH CHARPY V-NOTCH TEST REQ'D.


R95-107

CODE: 4000


NO.	REVISION	DATE
<p>1905 Old Philadelphia Pike Lancaster, Pennsylvania 17603 Phone 717/299-5211</p> <p><b>HIGH STEEL STRUCTURES, INC.</b></p> <p>A Subsidiary of High Industries, Inc.</p>		
<p>FLANGE PLATE DETAILS</p> <p>I-395 BRIDGE OVER PENOBSCOT RIVER</p> <p>I-395 BRIDGE STA. 164+60.00</p> <p>PENOBSCOT COUNTY</p> <p>STATE OF MAINE</p> <p>DEPARTMENT OF TRANSPORTATION</p>		
STATE CONTRACT OR REF. NO.	CONTRACTOR: CLANERO CORP.	
IN CHARGE: HINKLE	MADE BY: G.F.Z.	CHK'D BY: B.J.K. DATE: 5-10-84
CONTRACT NUMBER: ME-84088-	DRAWING NUMBER: FSI	




11-15-51

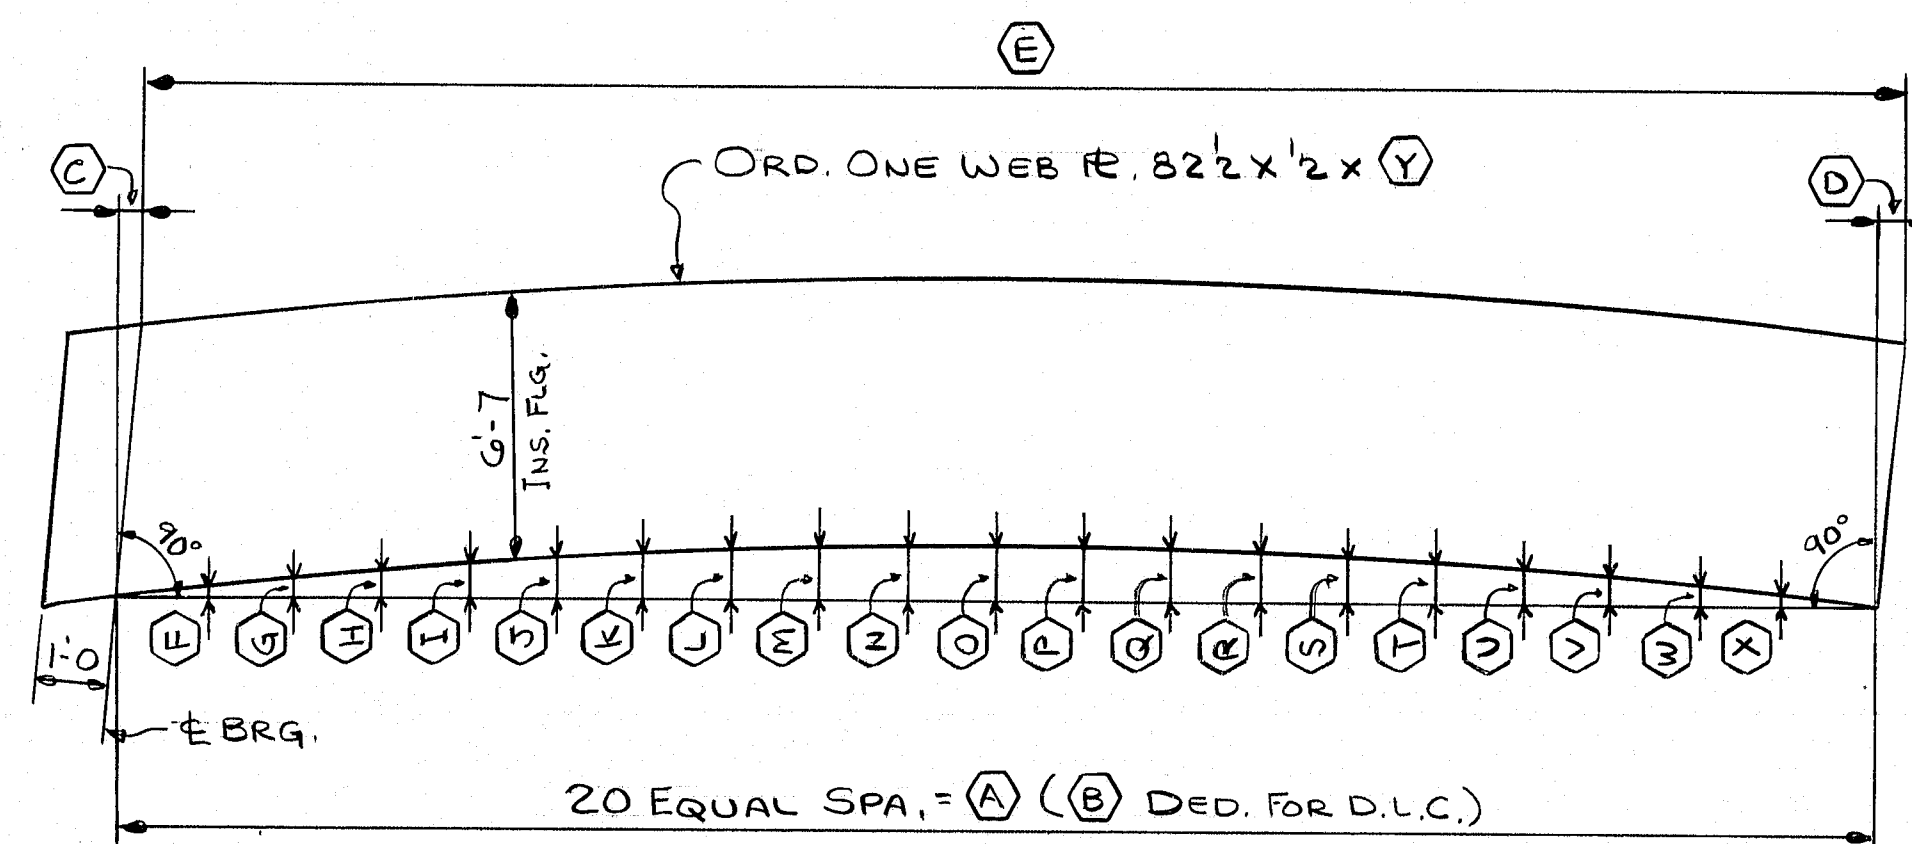

MK.	(A)	(B)	(C)	(D)	(E)	(F)	(G)	(H)	(I)	(J)	(K)	(L)	(M)	(N)	(O)	(P)	(Q)	(R)	(S)	(T)	(U)	(V)	(W)	(X)	(Y)
G1A	87-38	10	11	12	87-24	38	34	11	13	13	12	21	28	21	28	21	28	21	14	11	11	1	11	38	88-6(1/2)

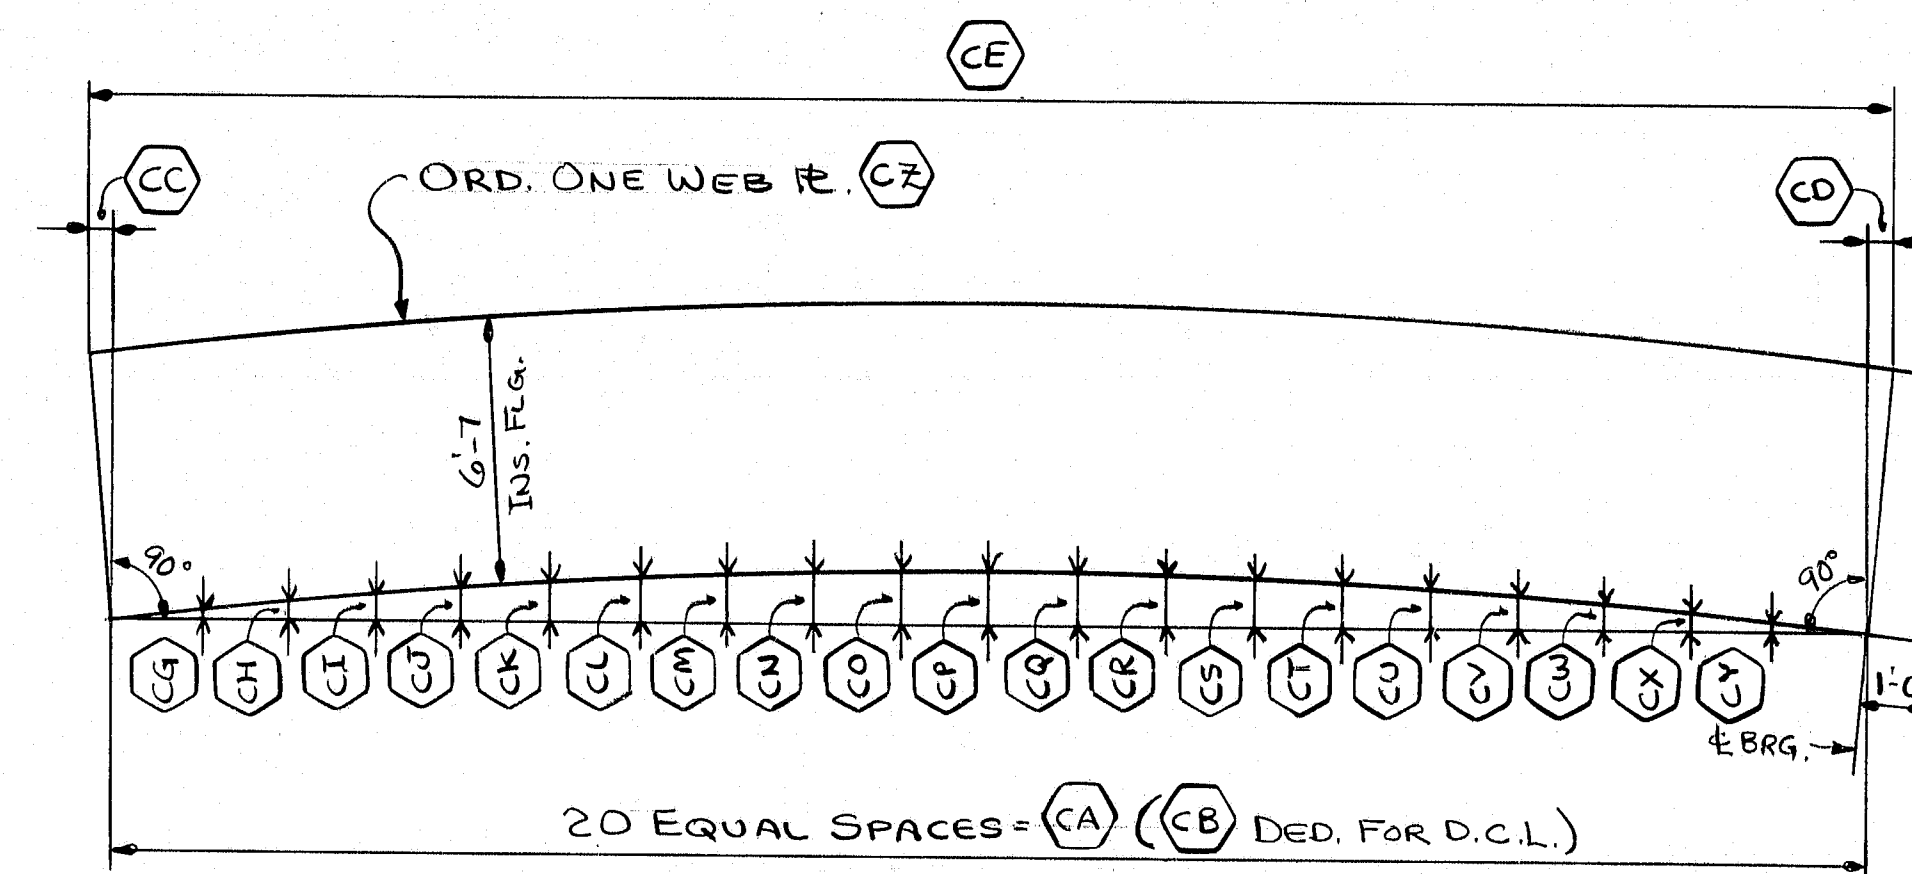

MK.	(CA)	(CB)	(CC)	(CD)	(CE)	(CF)	(CG)	(CH)	(CI)	(CJ)	(CK)	(CL)	(CM)	(CN)	(CO)	(CP)	(CQ)	(CR)	(CS)	(CT)	(CU)	(CV)	(CW)	(CX)	(CY)	(CZ)

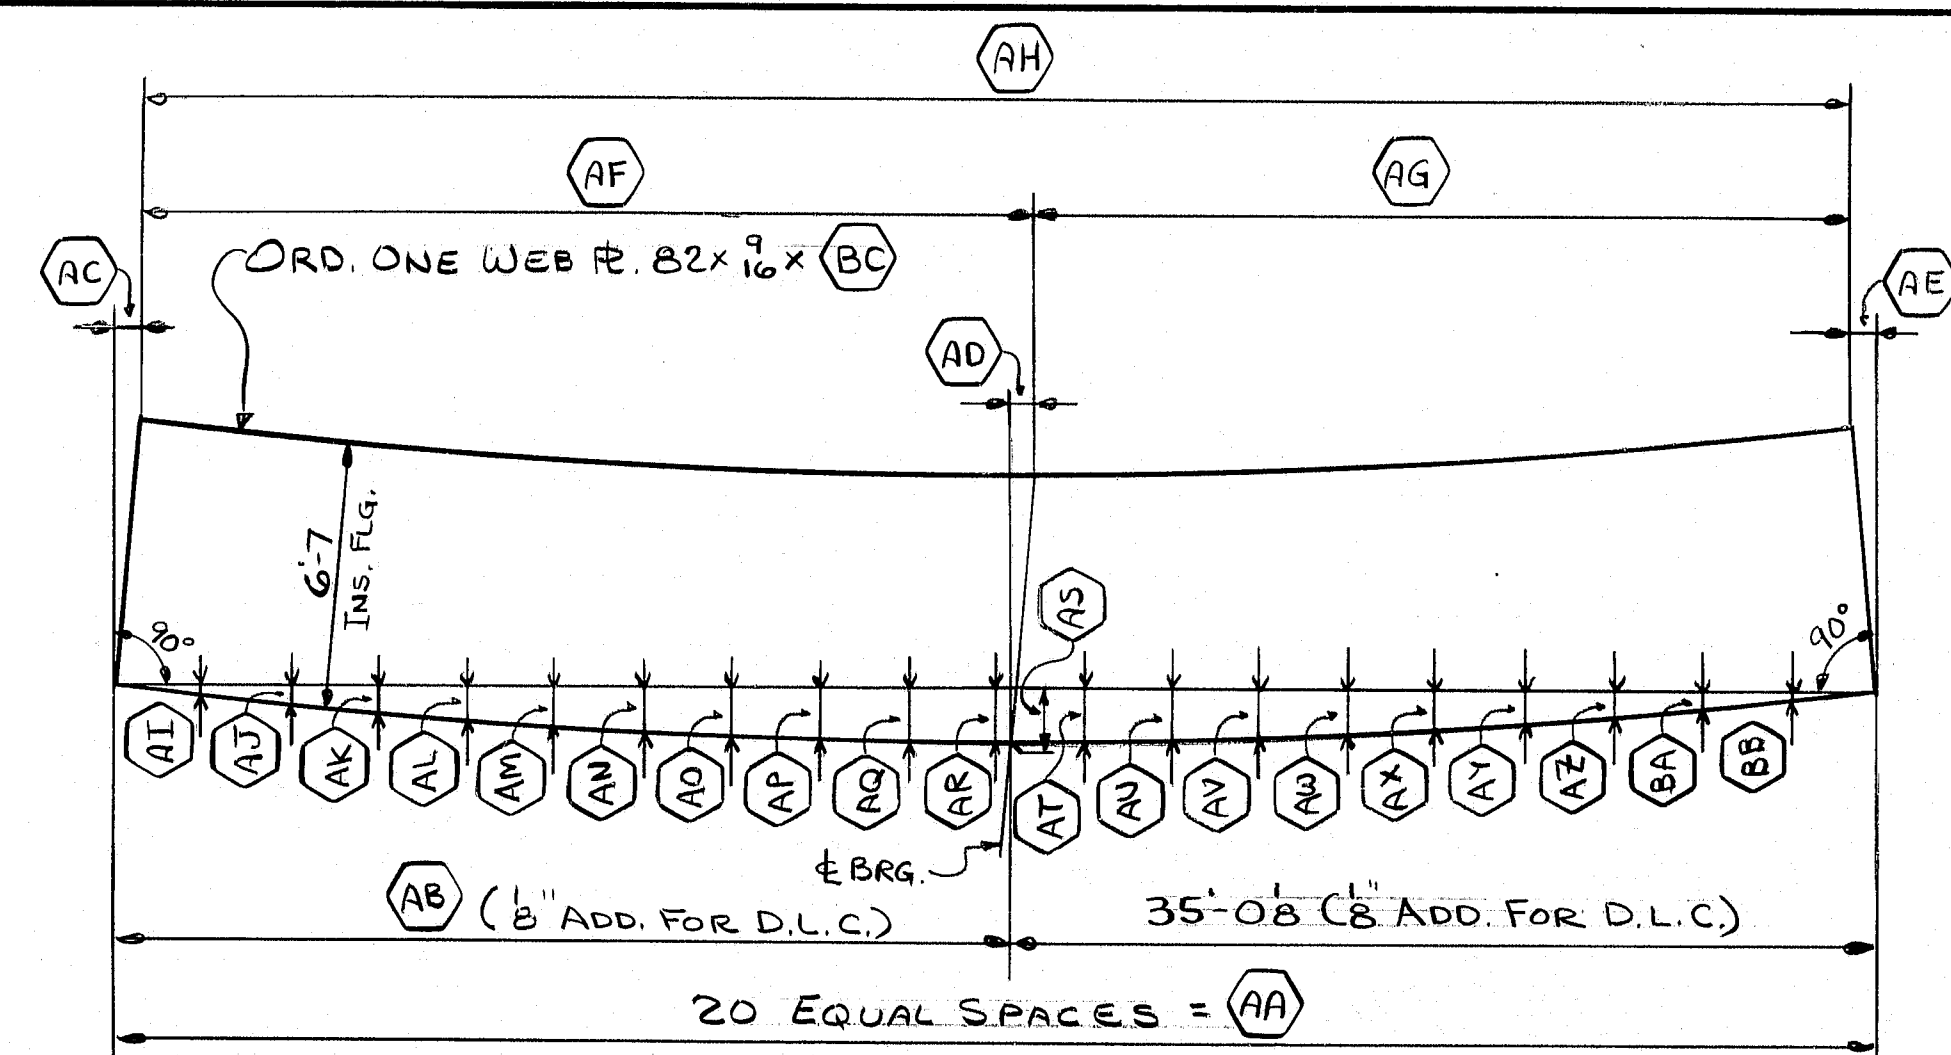

MK.	(AA)	(AB)	(AC)	
G1B	65-04	30-08	11	21	11	30-28	34-91	64-11	11	14	38	12	58	34	13	78	15	15	15	78	13	34	58	16	78	15	16	16	65-28
G5B	65-04	30-08	11	11	11	30-13	34-10	64-11	11	14	38	12	58	34	13	78	15	15	15	78	13	34	58	16	78	15	16	16	65-28
G6B	70-01	35-01	11	11	11	35-13	34-10	64-11	11	14	38	12	58	34	13	78	15	15	15	78	13	34	58	16	78	15	16	16	70-28
G10B	70-01	35-01	11	11	11	35-13	34-10	64-11	11	14	38	12	58	34	13	78	15	15	15	78	13	34	58	16	78	15	16	16	70-28


NOTES:  
FOR GENERAL NOTES, SEE DWG. N1.  
ALL STEEL TO BE A.S.T.M. A588  
WITH CHARPY V. NOTCH TEST REQD.  
SHOP INSPECTION BY MAINE D.O.T.  
OR THEIR REPRESENTATIVE.

R95-108

NO.	REVISION	DATE
HIGH STEEL STRUCTURES, INC.		
1905 Old Philadelphia Pike Lancaster, Pennsylvania 17603 Phone 717/299-5211 A Subsidiary of High Industries, Inc.		
WEB CAMBER DIAGRAM		
I-395 BRIDGE OVER PENOBSCOT RIVER		
I-395 BRIDGE STA. 164+60.00		
PENOBSCOT COUNTY		
STATE OF MAINE		
DEPARTMENT OF TRANSPORTATION		
STATE CONTRACT OR REF. NO.	CONTRACTOR	DATE
6	CIAERO CORP.	5-10-84
IN CHARGE: HINKLE	MADE BY: G.F.Z.	CHK'D BY: B.J.K.
CONTRACT NUMBER: ME-84088-1	DRAWING NUMBER: WCI	



FED. ROAD DIV. NO.	STATE	FED. AID PROJ. NO.
1	ME	I-16-395-8(82)112

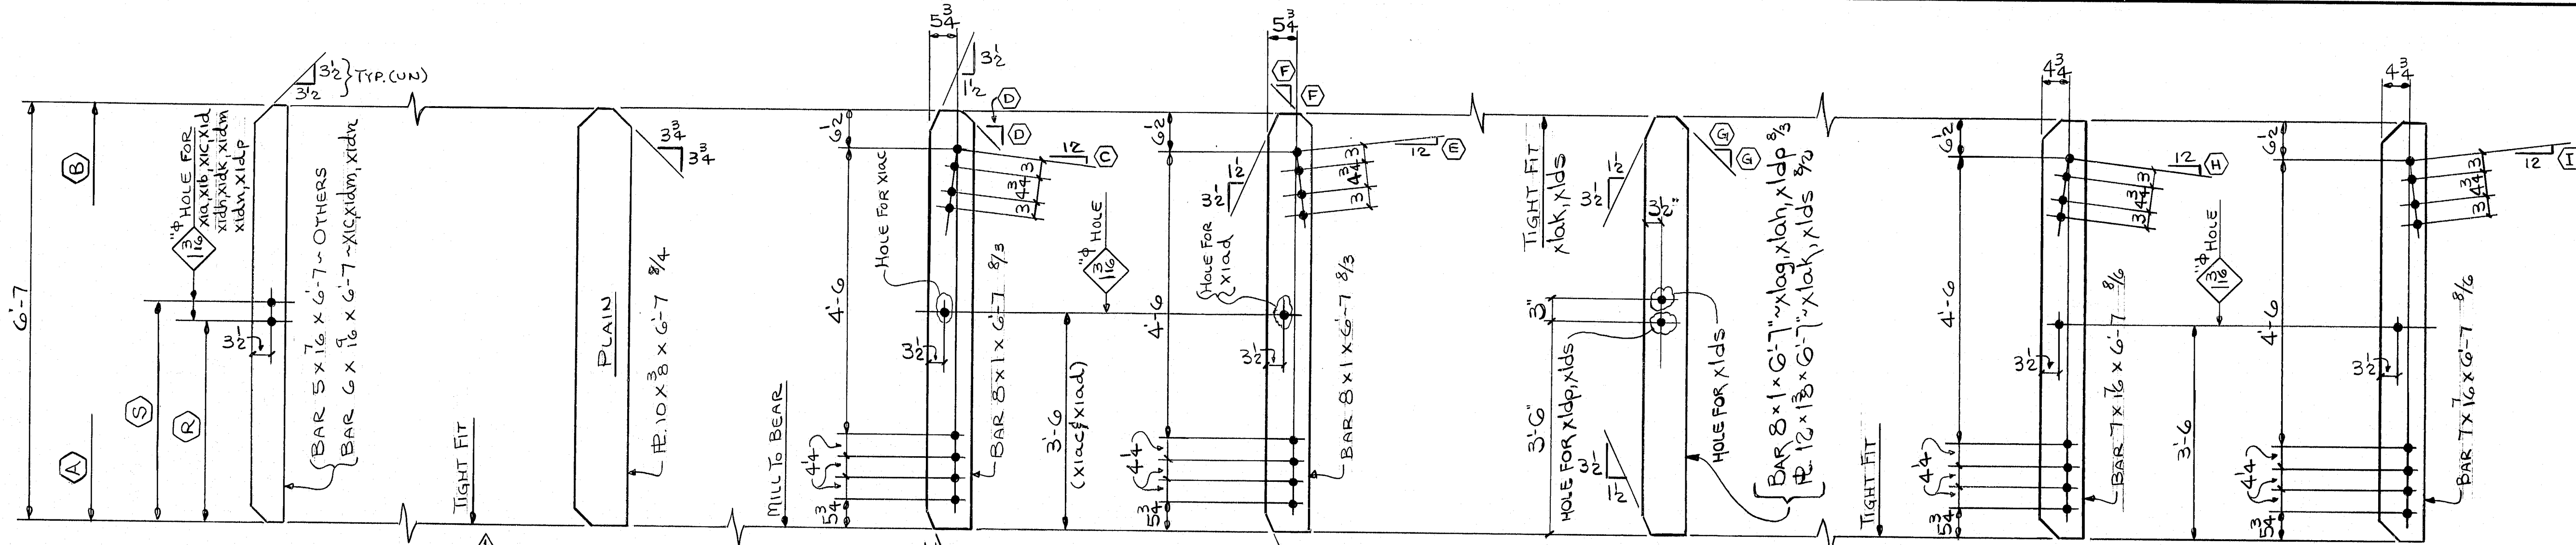

REQ'D.	MARK	(A)	(B)	(R)	(S)	Item
60	X10	TIGHT FIT	3'-6"	1	8/8	
19	X10h	TIGHT FIT	3'-6"	1	8/9	
23	X10b	TIGHT FIT	3'-6"	1	8/9	
19	X10c	TIGHT FIT	3'-6"	1	8/7	
10	X10d	TIGHT FIT	3'-6"	1	8/8	
25	X10e	TIGHT FIT	3'-6"	1	8/8	
5	X10f	TIGHT FIT	3'-6"	1	8/7	


REQ'D.	MARK	(C)	(D)
ONE	X13	16	14
ONE	X1K	12	
2	X1N	38	
ONE	X1S	5	
2	X1Aa	11	14
8	X1Ac	16	24

REQ'D.	MARK	(E)	(F)
ONE	X1h	16	14
2	X1P	38	
ONE	X1T	16	
ONE	X1Y	5	
2	X1Ab	16	14
8	X1Ad	16	24


REQ'D.	MARK	(G)
4	X1ag	14
3	X1ah	24
3	X1ak	
ONE	X1dp	24
ONE	X1ds	

REQ'D.	MARK	(H)
2	X1am	16
3	X1ap	12
ONE	X1at	38
2	X1ay	58

REQ'D.	MARK	(I)
2	X1an	16
3	X1as	12
ONE	X1aw	38
2	X1ba	58

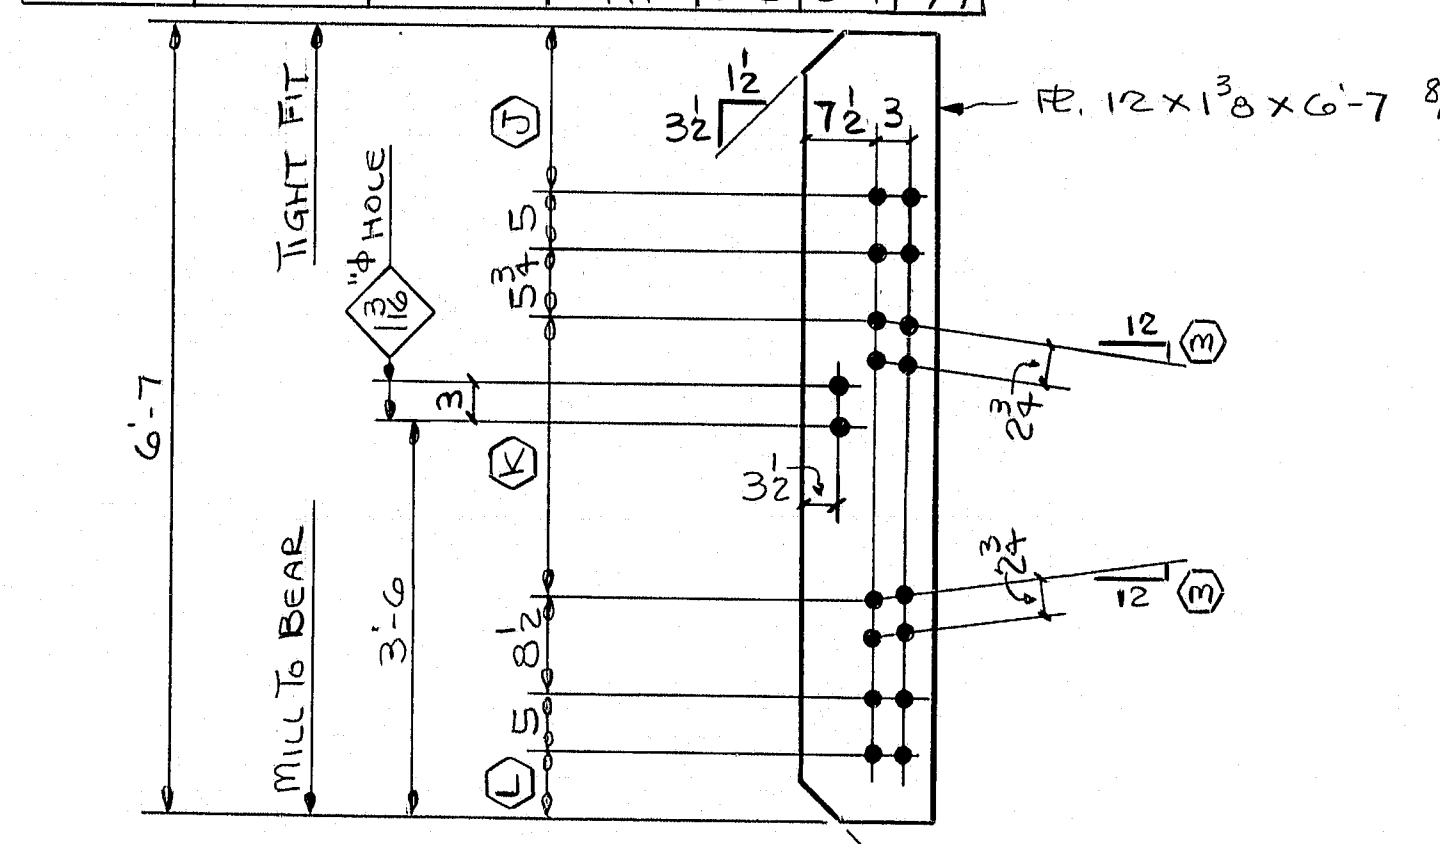


REQ'D.	MARK	(J)	(K)	(L)	(M)
ONE	X1bb	1'-2"	2'-9"	7/2	2/16
↑	X1bc	5	2'-9"	1'-4"	2/16
↑	X1bd	1'-1"	2'-9"	7/2	2/8
ONE	X1bf	5	2'-9"	1'-4"	
2	X1bg	1'-1"	2'-9"	7/2	
2	X1bh	5	2'-9"	1'-4"	2/8
ONE	X1bk	1'-0"	2'-11"	7/2	2/16
↑	X1bm	5	2'-11"	1'-2"	2/16
↑	X1bn	1'-1"	2'-9"	7/2	2/16
ONE	X1bp	5	2'-9"	1'-4"	2/16
2	X1bs	1'-3"	2'-8"	7/2	2/8
2	X1bt	5	2'-8"	1'-5"	2/8

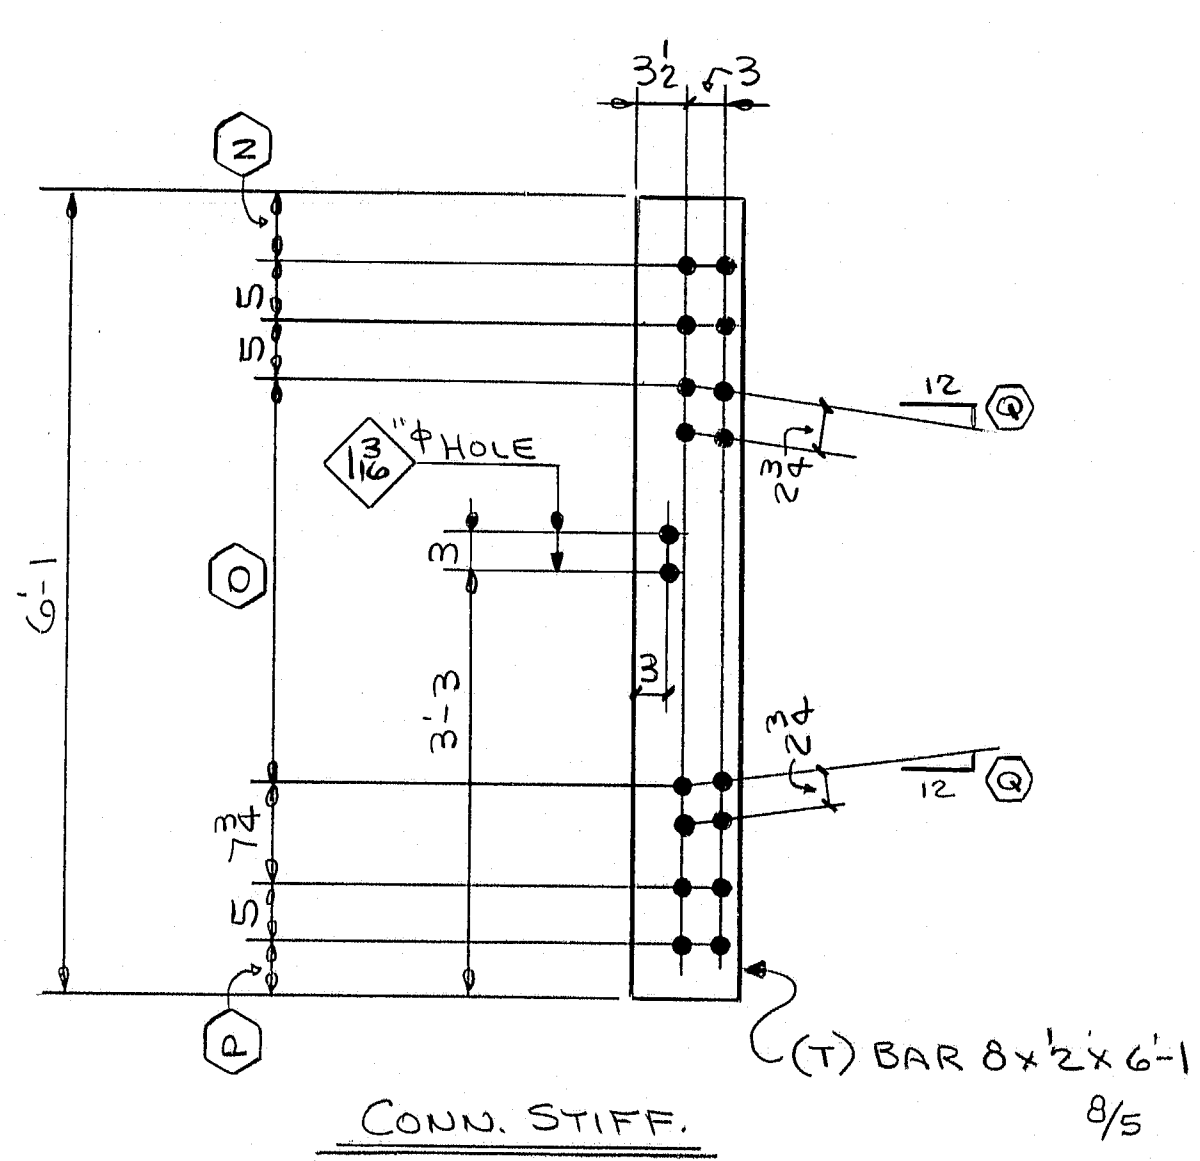

CONN. STIFF.  
SEE SCHEDULE @ RIGHT

REQ'D.	MARK	(N)	(O)	(P)	(Q)
ONE	X1bw	1'-0"	2'-9"	4/2	2
↑	X1by	2/4	2'-9"	1'-2"	↑
↑	X1ca	11/4	2'-10"	4/2	↑
ONE	X1cb	2/4	2'-10"	1'-12"	2
2	X1cc	11	2'-10"	4/2	2/16
2	X1cd	2/4	2'-10"	1'-0"	2/16
ONE	X1cf	9/2	3'-0"	4/2	2/16
↑	X1cg	2/4	3'-0"	11/4	2/16
↑	X1ch	11/8	2'-9"	4/2	2/16
ONE	X1ck	2/4	2'-9"	1'-1"	2/16
2	X1cm	1'-1"	2'-8"	4/2	2
↑	X1cn	2/4	2'-8"	1'-2"	2
↑	X1cp	11/8	2'-9"	4/2	2/8
↑	X1cs	2/4	2'-9"	1'-1"	↑
↑	X1ct	11/2	2'-10"	4/2	↑
2	X1cw	2/4	2'-10"	1'-1"	2/8
ONE	X1cy	10/4	2'-11"	4/2	2/16
ONE	X1da	2/4	2'-11"	1'-0"	2/16
2	X1db	11/8	2'-10"	4/2	2/4
2	X1dc	2/4	2'-10"	1'-1"	↑
ONE	X1dd	11/8	2'-10"	4/2	↑
ONE	X1df	2/4	2'-10"	1'-0"	2/4

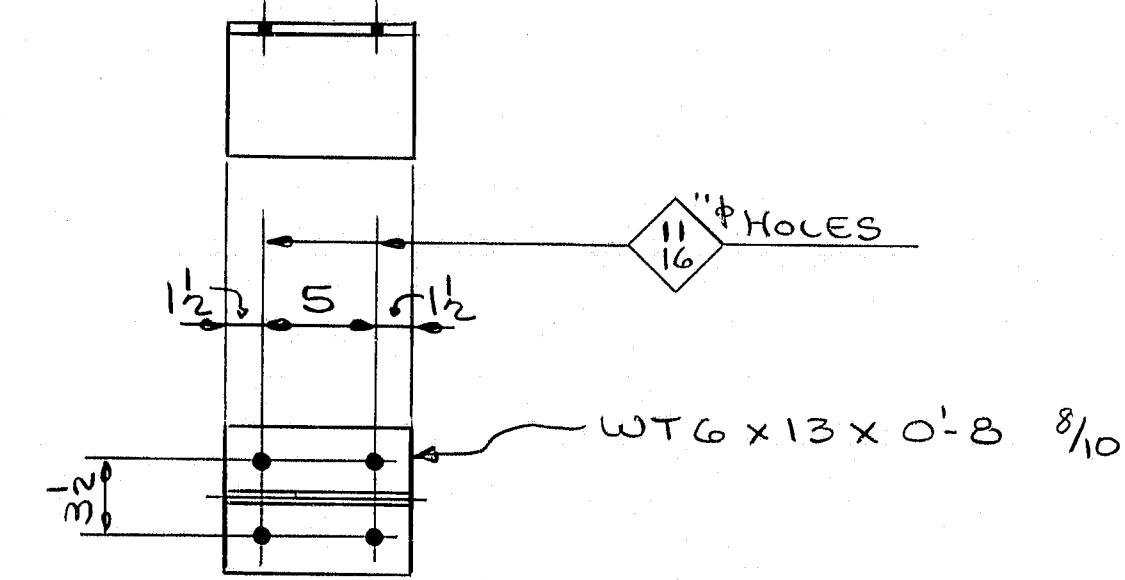

9 - SCUPPER CONN. - MK. X1dg

SHOP NOTE  
HOLES: 1/2" (U.N.)  
BOLTS: NONE  
PAINT: NONE


FOR GENERAL NOTES, SEE DWG. N1.  
ALL STEEL TO BE A.S.T.M. A588.  
(T) INDICATES CHARPY-V NOTCH TEST REQ'D.

NO.	REVISION	CONTRACT REVISION	DATE
1	14		9-10-84
HIGH STEEL STRUCTURES, INC.			
1905 Old Philadelphia Pike Lancaster, Pennsylvania 17603 Phone 717/299-5211			
A Subsidiary of High Industries, Inc.			
JOB STANDARDS			
I-395 BRIDGE OVER PENOBSCOT RIVER			
I-395 BRIDGE STA. 164+60.00			
PENOBSCOT COUNTY			
STATE OF MAINE			
DEPARTMENT OF TRANSPORTATION			
STATE CONTRACT OR REF. NO.	6	CONTRACTOR	CIANERO CORP.
IN CHARGE	HINKLE	MADE BY	G.F.Z. CHK'D BY J.L.C. DATE: 5-23-84
CONTRACT NUMBER	ME-84088-1	DRAWING NUMBER	X1



R95-109



a			
b			
c			
d			
f			
g			
h			
k			
m			
n			
p			
s			
t			
w			
y			

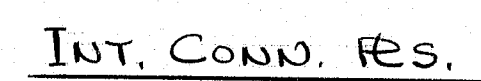

REQD.	MARK	(A)	(B)	(C)	(D)	(E)	(F)	(G)	(H)	(I)
ONE	X2bd	G <sup>3</sup> / <sub>4</sub>	3'-7 <sup>1</sup> / <sub>8</sub>	-	1'-4 <sup>5</sup> / <sub>8</sub>	2 <sup>5</sup> / <sub>8</sub>	-	TIGHT FIT	-	3'-
2	X2bf	1'-4 <sup>1</sup> / <sub>8</sub>	3'-6 <sup>8</sup> / <sub>8</sub>	-	7 <sup>1</sup> / <sub>2</sub>	2 <sup>1</sup> / <sub>8</sub>	-	↑	-	3'-
2	X2bg	G <sup>3</sup> / <sub>4</sub>	3'-6 <sup>8</sup> / <sub>8</sub>	-	1'-5 <sup>5</sup> / <sub>8</sub>	2 <sup>1</sup> / <sub>8</sub>	-	↑	-	3'-
ONE	X2bh	1'-4 <sup>1</sup> / <sub>8</sub>	3'-6 <sup>8</sup> / <sub>8</sub>	-	7 <sup>1</sup> / <sub>2</sub>	2 <sup>5</sup> / <sub>8</sub>	-	↑	3'-6	-
↑	X2bk	G <sup>3</sup> / <sub>4</sub>	3'-6 <sup>8</sup> / <sub>8</sub>	-	1'-4 <sup>1</sup> / <sub>8</sub>	↑	-	↑	-	-
↓	X2bm	1'-3 <sup>3</sup> / <sub>4</sub>	3'-7 <sup>1</sup> / <sub>4</sub>	-	7 <sup>1</sup> / <sub>2</sub>	-	-	↑	-	-
ONE	X2bn	G <sup>3</sup> / <sub>4</sub>	3'-7 <sup>1</sup> / <sub>4</sub>	-	1'-4 <sup>1</sup> / <sub>2</sub>	-	-	↑	-	-
2	X2bp	1'-3 <sup>1</sup> / <sub>2</sub>	3'-7 <sup>1</sup> / <sub>2</sub>	-	7 <sup>1</sup> / <sub>2</sub>	↓	-	↑	-	-
2	X2bs	G <sup>3</sup> / <sub>4</sub>	3'-7 <sup>1</sup> / <sub>2</sub>	-	1'-4 <sup>1</sup> / <sub>4</sub>	2 <sup>5</sup> / <sub>8</sub>	-	↑	-	-
ONE	X2bt	1'-2 <sup>1</sup> / <sub>8</sub>	3'-8 <sup>3</sup> / <sub>8</sub>	-	7 <sup>1</sup> / <sub>2</sub>	2 <sup>1</sup> / <sub>8</sub>	-	↑	-	-
↑	X2bw	G <sup>3</sup> / <sub>4</sub>	3'-8 <sup>3</sup> / <sub>8</sub>	-	1'-2 <sup>1</sup> / <sub>8</sub>	2 <sup>1</sup> / <sub>8</sub>	-	↑	-	-
↑	X2by	1'-3 <sup>3</sup> / <sub>8</sub>	3'-7 <sup>5</sup> / <sub>8</sub>	-	7 <sup>1</sup> / <sub>2</sub>	2 <sup>3</sup> / <sub>4</sub>	-	↑	-	-
ONE	X2ca	G <sup>3</sup> / <sub>4</sub>	3'-7 <sup>5</sup> / <sub>8</sub>	-	1'-4 <sup>1</sup> / <sub>8</sub>	2 <sup>3</sup> / <sub>4</sub>	-	↑	-	-
2	X2cb	1'-4 <sup>1</sup> / <sub>4</sub>	3'-6 <sup>3</sup> / <sub>4</sub>	-	7 <sup>1</sup> / <sub>2</sub>	2 <sup>1</sup> / <sub>8</sub>	-	↑	-	-
2	X2cc	G <sup>3</sup> / <sub>4</sub>	3'-6 <sup>3</sup> / <sub>4</sub>	-	1'-5	↑	-	TIGHT FIT	3'-6	-
ONE	X2cd	1'-3 <sup>3</sup> / <sub>8</sub>	3'-7 <sup>1</sup> / <sub>8</sub>	1'-4	7 <sup>1</sup> / <sub>2</sub>	↑	TIGHT FIT	-	-	3'-
↑	X2cf	G <sup>3</sup> / <sub>4</sub>	3'-7 <sup>1</sup> / <sub>8</sub>	↑	1'-4 <sup>5</sup> / <sub>8</sub>	↑	↑	-	-	↑
↑	X2cg	1'-3 <sup>3</sup> / <sub>4</sub>	3'-7 <sup>1</sup> / <sub>4</sub>	-	7 <sup>1</sup> / <sub>2</sub>	-	↑	-	-	↑
ONE	X2ch	G <sup>3</sup> / <sub>4</sub>	3'-7 <sup>1</sup> / <sub>4</sub>	-	1'-4 <sup>1</sup> / <sub>2</sub>	-	↑	-	-	↑
2	X2ck	1'-3 <sup>5</sup> / <sub>8</sub>	3'-7 <sup>3</sup> / <sub>8</sub>	-	7 <sup>1</sup> / <sub>2</sub>	↓	-	-	-	-
2	X2cm	G <sup>3</sup> / <sub>4</sub>	3'-7 <sup>3</sup> / <sub>8</sub>	-	1'-4 <sup>3</sup> / <sub>8</sub>	2 <sup>1</sup> / <sub>8</sub>	-	-	-	-
ONE	X2cn	1'-2 <sup>5</sup> / <sub>8</sub>	3'-8 <sup>3</sup> / <sub>8</sub>	-	7 <sup>1</sup> / <sub>2</sub>	2 <sup>1</sup> / <sub>8</sub>	-	-	-	-
↑	X2cp	G <sup>3</sup> / <sub>4</sub>	3'-8 <sup>3</sup> / <sub>8</sub>	-	1'-3 <sup>3</sup> / <sub>8</sub>	↑	↑	-	-	-
↑	X2cs	1'-3	3'-8	-	7 <sup>1</sup> / <sub>2</sub>	↑	↑	-	-	-
ONE	X2ct	G <sup>3</sup> / <sub>4</sub>	3'-8	-	1'-3 <sup>3</sup> / <sub>4</sub>	2 <sup>1</sup> / <sub>8</sub>	-	-	-	-
2	X2cw	1'-3 <sup>3</sup> / <sub>8</sub>	3'-7 <sup>5</sup> / <sub>8</sub>	-	7 <sup>1</sup> / <sub>2</sub>	2 <sup>7</sup> / <sub>8</sub>	-	-	-	-
2	X2cy	G <sup>3</sup> / <sub>4</sub>	3'-7 <sup>5</sup> / <sub>8</sub>	-	1'-4 <sup>1</sup> / <sub>8</sub>	2 <sup>7</sup> / <sub>8</sub>	-	-	-	-
ONE	X2da	1'-3 <sup>3</sup> / <sub>4</sub>	3'-7 <sup>1</sup> / <sub>4</sub>	-	7 <sup>1</sup> / <sub>2</sub>	2 <sup>3</sup> / <sub>4</sub>	-	-	3'-6	-
ONE	X2db	G <sup>3</sup> / <sub>4</sub>	3'-7 <sup>1</sup> / <sub>4</sub>	-	1'-4 <sup>1</sup> / <sub>2</sub>	↑	-	-	↑	-
2	X2dc	1'-3 <sup>5</sup> / <sub>8</sub>	3'-7 <sup>3</sup> / <sub>8</sub>	-	7 <sup>1</sup> / <sub>2</sub>	-	-	-	-	-
2	X2dd	G <sup>3</sup> / <sub>4</sub>	3'-7 <sup>3</sup> / <sub>8</sub>	-	1'-4 <sup>3</sup> / <sub>8</sub>	-	-	-	-	-
ONE	X2df	1'-3 <sup>1</sup> / <sub>2</sub>	3'-7 <sup>1</sup> / <sub>2</sub>	-	7 <sup>1</sup> / <sub>2</sub>	↓	-	-	-	-
↑	X2dg	G <sup>3</sup> / <sub>4</sub>	3'-7 <sup>1</sup> / <sub>2</sub>	-	1'-4 <sup>1</sup> / <sub>4</sub>	2 <sup>3</sup> / <sub>4</sub>	-	-	-	-
↑	X2dh	1'-2 <sup>3</sup> / <sub>4</sub>	3'-8 <sup>1</sup> / <sub>4</sub>	-	7 <sup>1</sup> / <sub>2</sub>	3	-	-	-	-
↑	X2dk	G <sup>3</sup> / <sub>4</sub>	3'-8 <sup>1</sup> / <sub>4</sub>	-	1'-3 <sup>1</sup> / <sub>2</sub>	↑	-	-	-	-
↓	X2dm	1'-2 <sup>1</sup> / <sub>8</sub>	3'-8 <sup>1</sup> / <sub>8</sub>	-	7 <sup>1</sup> / <sub>2</sub>	↑	-	-	-	-
ONE	X2dn	G <sup>3</sup> / <sub>4</sub>	3'-8 <sup>1</sup> / <sub>8</sub>	-	1'-3 <sup>5</sup> / <sub>8</sub>	↑	-	-	-	-
2	X2dp	1'-3	3'-8	-	7 <sup>1</sup> / <sub>2</sub>	↓	-	-	-	↓
2	X2ds	G <sup>3</sup> / <sub>4</sub>	3'-8	-	1'-3 <sup>3</sup> / <sub>4</sub>	3	-	-	-	3'-
3	X2dt	1'-3 <sup>1</sup> / <sub>2</sub>	3'-7 <sup>1</sup> / <sub>2</sub>	-	7 <sup>1</sup> / <sub>2</sub>	2 <sup>1</sup> / <sub>8</sub>	-	-	-	-
3	X2dw	G <sup>3</sup> / <sub>4</sub>	3'-7 <sup>1</sup> / <sub>2</sub>	-	1'-4 <sup>1</sup> / <sub>4</sub>	↑	-	-	-	-
ONE	X2dy	1'-3 <sup>3</sup> / <sub>8</sub>	3'-7 <sup>5</sup> / <sub>8</sub>	-	7 <sup>1</sup> / <sub>2</sub>	↑	-	-	-	-
ONE	X2fa	G <sup>3</sup> / <sub>4</sub>	3'-7 <sup>5</sup> / <sub>8</sub>	-	1'-4 <sup>1</sup> / <sub>8</sub>	2 <sup>1</sup> / <sub>8</sub>	-	-	-	-
2	X2fb	1'-2 <sup>3</sup> / <sub>4</sub>	3'-8 <sup>1</sup> / <sub>4</sub>	-	7 <sup>1</sup> / <sub>2</sub>	3 <sup>1</sup> / <sub>8</sub>	-	-	-	-
↑	X2fc	G <sup>3</sup> / <sub>4</sub>	3'-8 <sup>1</sup> / <sub>4</sub>	-	1'-3 <sup>1</sup> / <sub>2</sub>	↑	-	-	-	-
↓	X2fd	1'-2 <sup>1</sup> / <sub>2</sub>	3'-8 <sup>1</sup> / <sub>2</sub>	↓	7 <sup>1</sup> / <sub>2</sub>	↑	-	-	-	-
2	X2ff	G <sup>3</sup> / <sub>4</sub>	3'-8 <sup>1</sup> / <sub>2</sub>	1'-4	1'-3 <sup>1</sup> / <sub>4</sub>	3 <sup>1</sup> / <sub>8</sub>	TIGHT FIT	-	3'-6	-

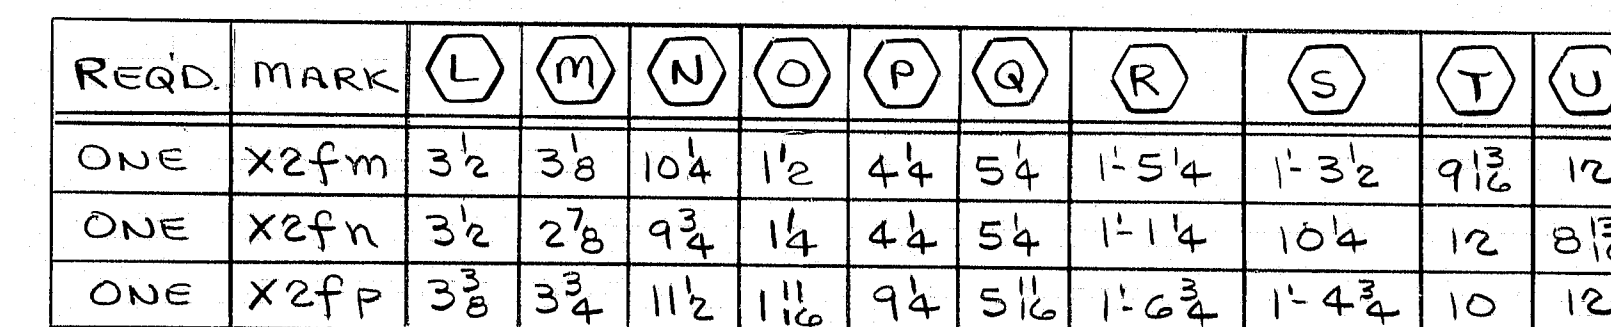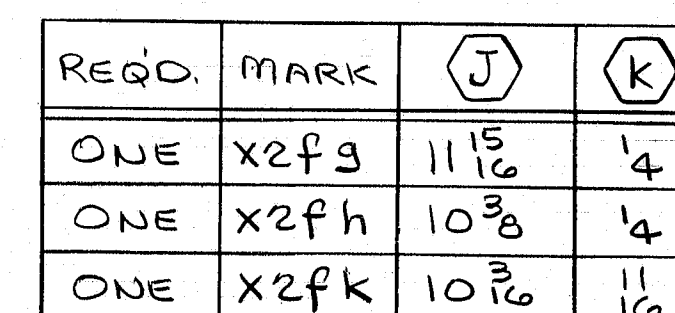


REQD.	MARK.	(V)	(W)	(X)	(Y)	(Z)
ONE	X2fs	12	11 <sup>3</sup> <sub>16</sub>	7 <sub>16</sub>	4	11 <sup>13</sup> <sub>16</sub>
↑	X2ft	9 <sup>11</sup> <sub>16</sub>	12	9 <sub>16</sub>	↑	11 <sup>15</sup> <sub>16</sub>
	X2fw	9 <sup>15</sup> <sub>16</sub>	12	1 <sub>16</sub>		1·04
	X2fy	12	9 <sup>8</sup> <sub>16</sub>	7 <sub>16</sub>		11 <sup>13</sup> <sub>16</sub>
	X2ga	↑	8 <sup>8</sup> <sub>16</sub>	9 <sub>16</sub>	↓	11 <sup>15</sup> <sub>16</sub>
	X2gb		8 <sub>16</sub>	1 <sub>16</sub>	1 <sub>16</sub>	1·04
	X2gc		9 <sub>16</sub>	7 <sub>16</sub>	11 <sub>16</sub>	11 <sup>13</sup> <sub>16</sub>
↓	X2gd	↓	8 <sup>13</sup> <sub>16</sub>	9 <sub>16</sub>	11 <sub>16</sub>	11 <sup>15</sup> <sub>16</sub>
ONE	X2gf	12	8 <sup>16</sup> <sub>16</sub>	1 <sub>16</sub>	1 <sub>16</sub>	1·04



HOLES: 15"  $\phi$  (U.N.)  
BOLTS: NONE  
PAINT: NONE




FOR GENERAL NOTES, SEE DWG. N1.  
ALL STEEL TO BE A.S.T.M. A588.

R95-110 CODE: 4000

NO.	REVISION	DATE
<b>HIGH STEEL STRUCTURES, INC.</b> 		1905 Old Philadelphia Pike Lancaster, Pennsylvania 17603 Phone 717/299-5211
		A Subsidiary of High Industries, Inc.
JOB STANDARDS		
I-395 BRIDGE OVER PENOBSCOT RIVER		
I-395 BRIDGE STA. 164+160.00		
PENOBSCOT COUNTY		
STATE OF MAINE		
DEPARTMENT OF TRANSPORTATION		
STATE CONTRACT OR REF. NO.	6	CONTRACTOR
		CIANBRO CORP.
IN CHARGE:	HINKLE	MADE BY: G.F.Z. CHK.D. BY: JLC
CONTRACT NUMBER:	ME-84088-1	DRAWING NUMBER: X2
		DATE: 5-22-88




FED. ROAD DIV. NO.	STATE	FED. AID PROJ. NO.
1	ME	114-395-8(82)176

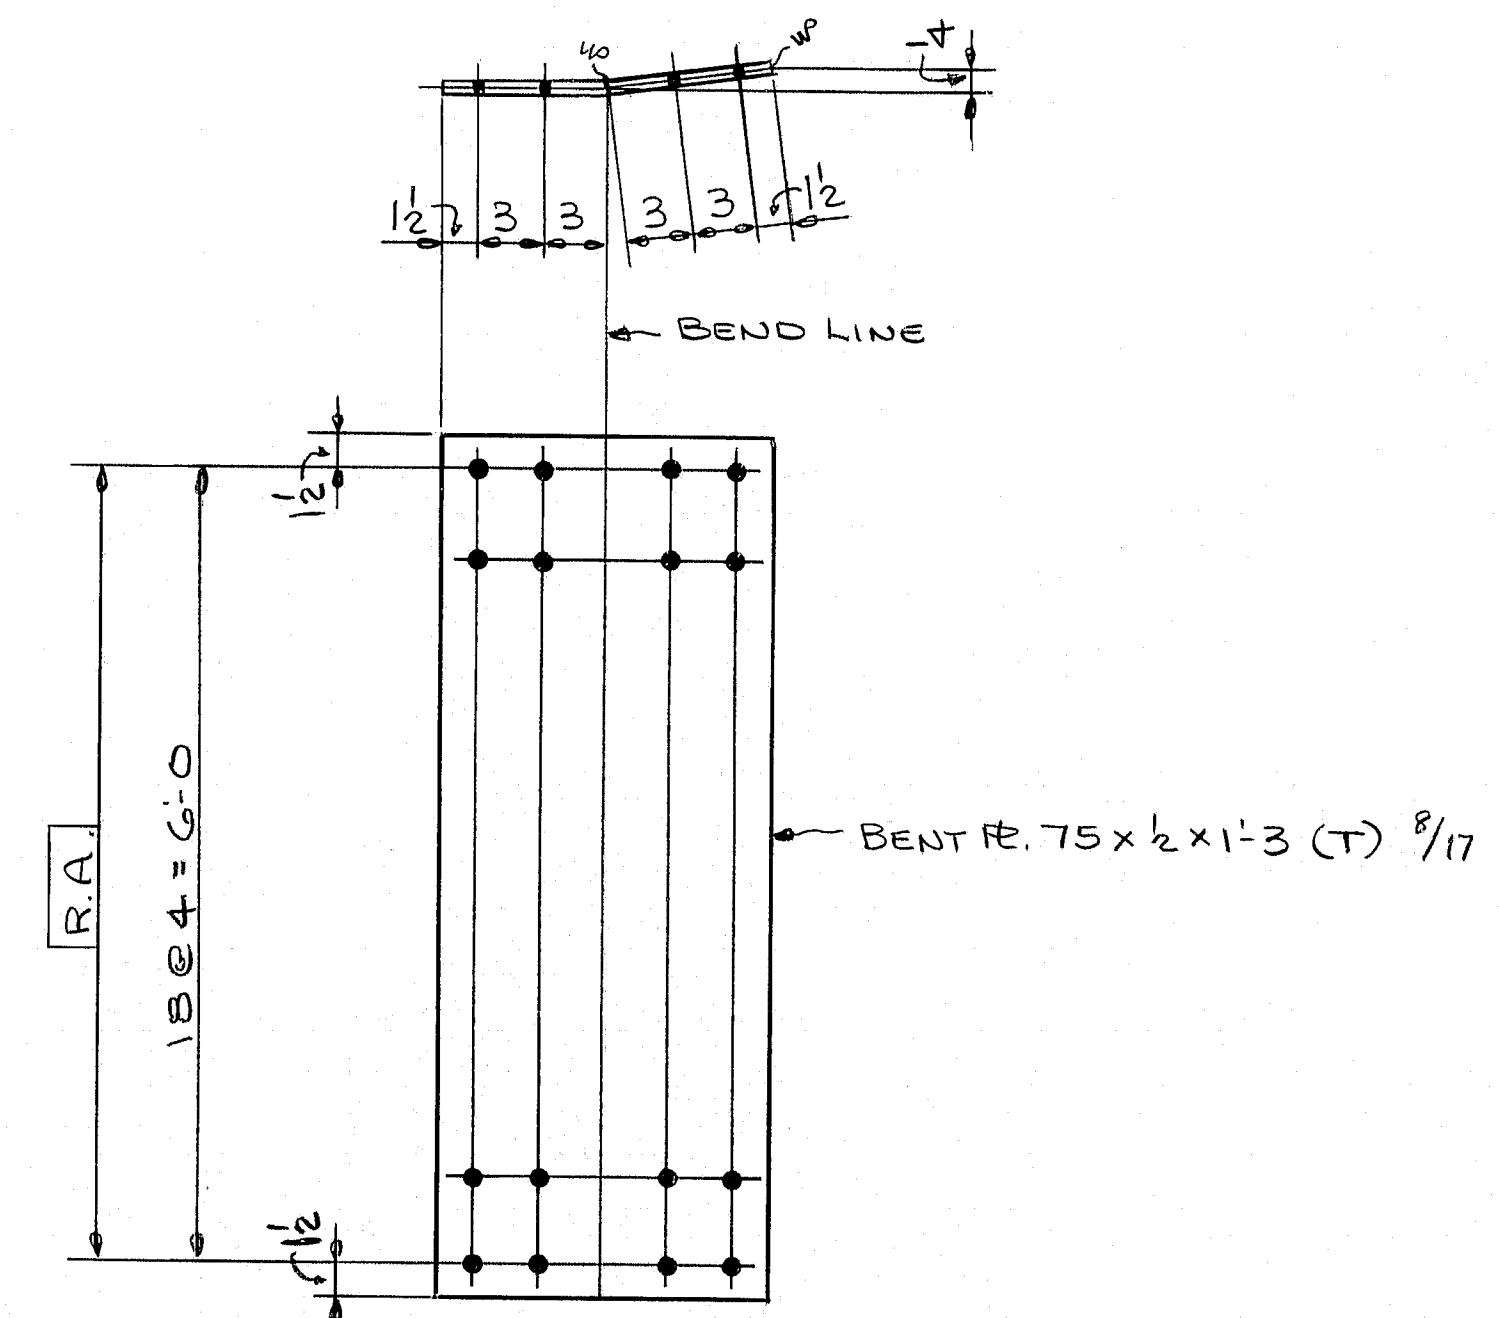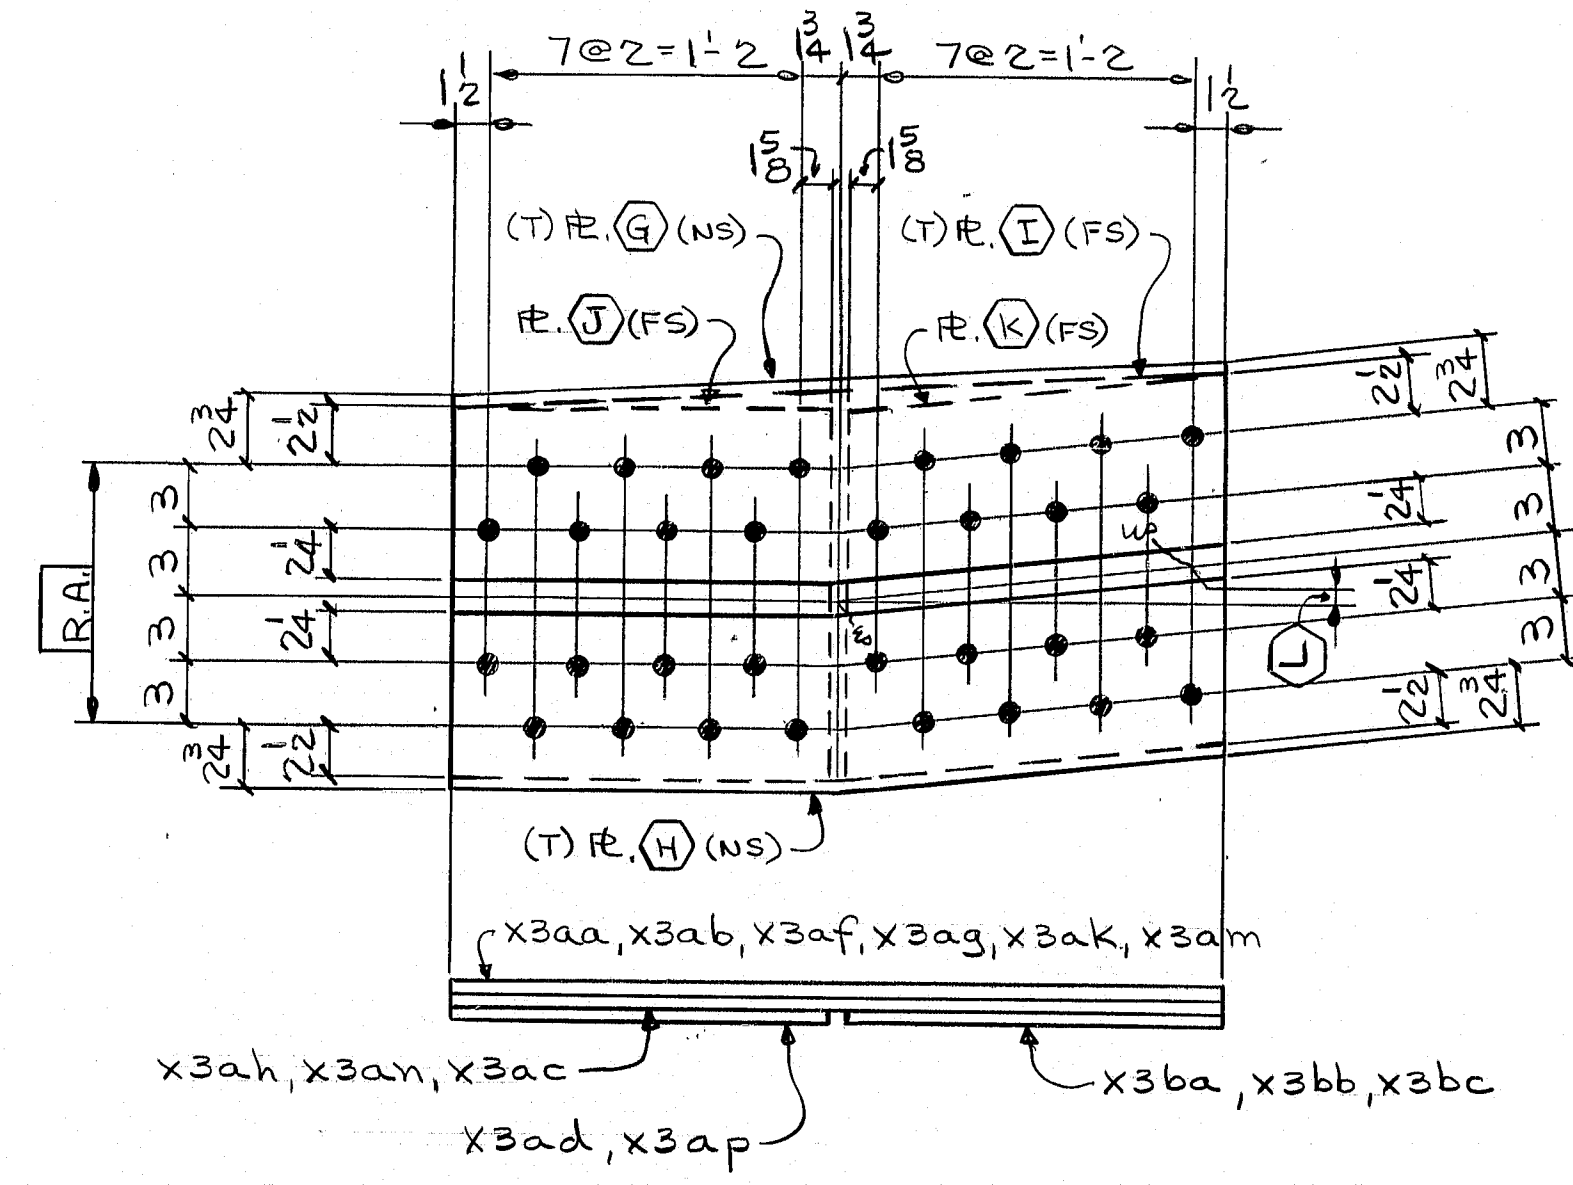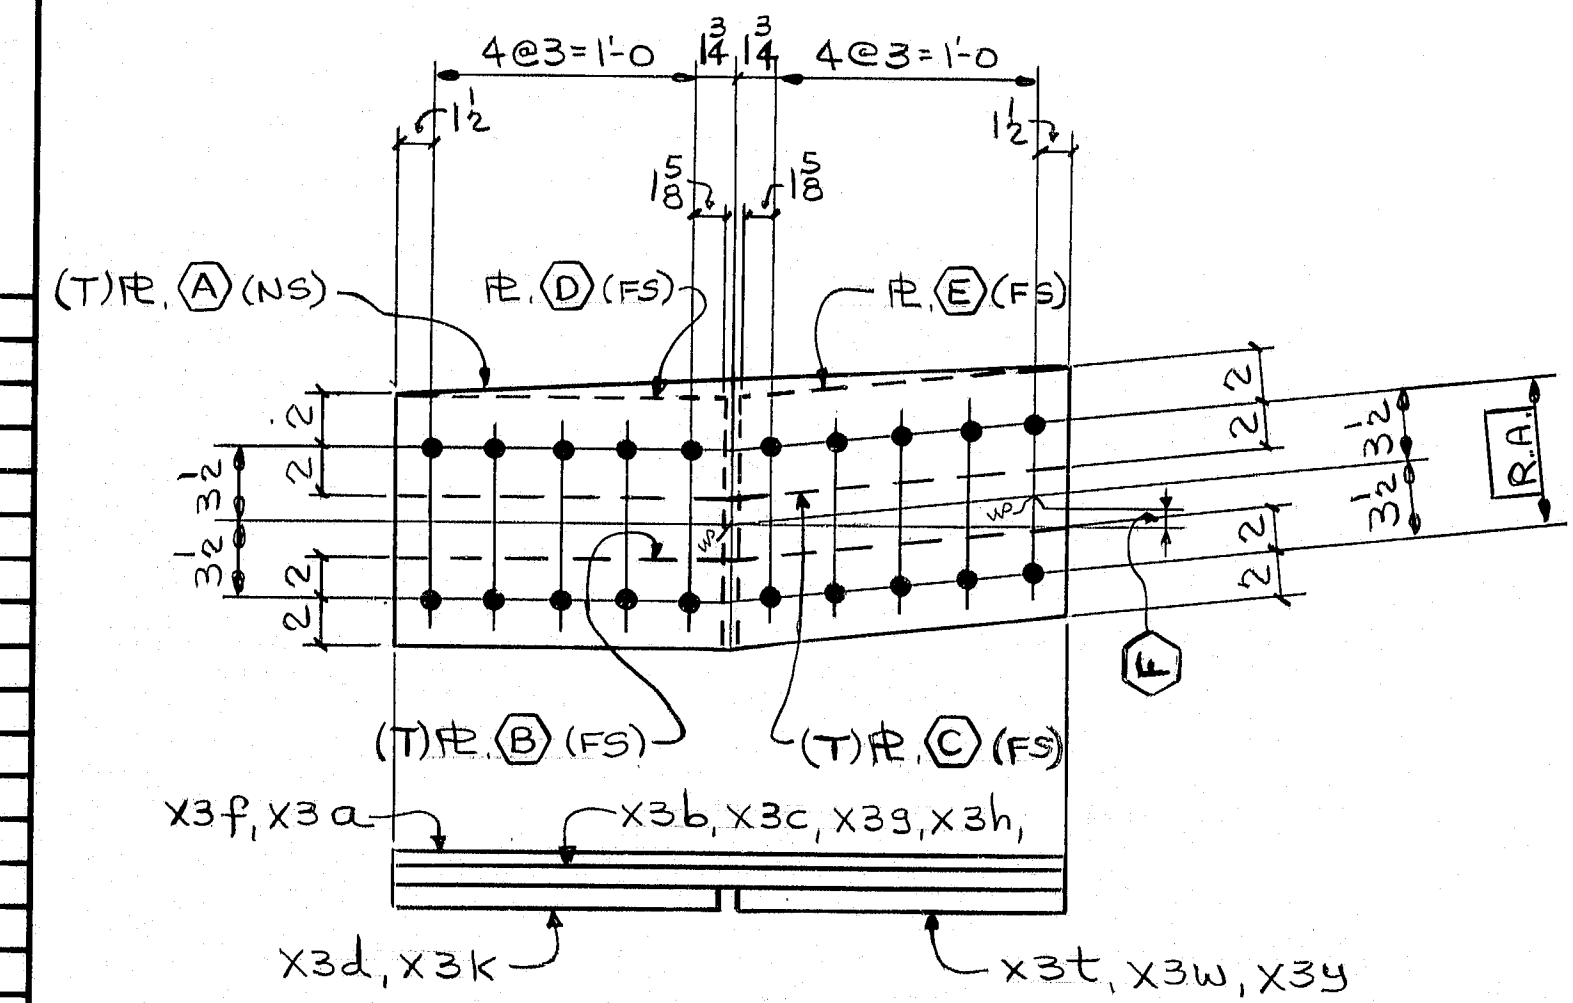


REQD.	MARK	(A)	(B)	(C)	(D)	(E)	(F)
6	X3a	11 1/2 x 1/2 x 2' 6 1/2 3/16					
6	X3b		4 1/2 x 3/4 x 2' 6 1/2 3/16				1/2
6	X3c			4 1/2 x 3/4 x 2' 6 1/2 3/16			
5	X3d				11 x 7/8 x 1' 3 1/2 3/16		
14	X3f	11 3/8 x 1/2 x 2' 6 1/2 3/16					
14	X3g		4 3/8 x 3/4 x 2' 6 1/2 3/16				3/8
14	X3h			4 3/8 x 3/4 x 2' 6 1/2 3/16			
5	X3k				11 x 1' x 1' 3 1/2 3/16		
3	X3t					11 1/2 x 7/8 x 1' 3 1/2 3/16	1/2
2	X3w					11 3/8 x 7/8 x 1' 3 1/2 3/16	
5	X3y					11 3/8 x 1' x 1' 3 1/2 3/16	3/8

REQD.	MARK	(G)	(H)	(I)	(J)	(K)	(L)
2	X3aa	8 5/8 x 1 x 2' 10 1/2 3/16					
2	X3ab		8 5/8 x 1 x 2' 10 1/2 3/16				3/8
2	X3ac			17 3/8 x 3/4 x 2' 10 1/2 3/16			
5	X3ad				17 x 3/4 x 1' 5 1/2 3/16		
11	X3af	8 1/2 x 1 x 2' 10 1/2 3/16					
11	X3ag		8 1/2 x 1 x 2' 10 1/2 3/16				1/2
11	X3ah			17 3/8 x 3/4 x 2' 10 1/2 3/16			
7	X3ak	8 3/8 x 1 x 2' 10 1/2 3/16					
7	X3am		8 3/8 x 1 x 2' 10 1/2 3/16				3/8
7	X3an			17 3/8 x 3/4 x 2' 10 1/2 3/16			
5	X3ap				17 x 3/4 x 1' 5 1/2 3/16		
ONE	X3ba					17 5/8 x 4 x 1' 5 1/2 3/16	5/8
8	X3bb					17 1/2 x 4 x 1' 5 1/2 3/16	1/2
ONE	X3bc					17 3/8 x 4 x 1' 5 1/2 3/16	3/8

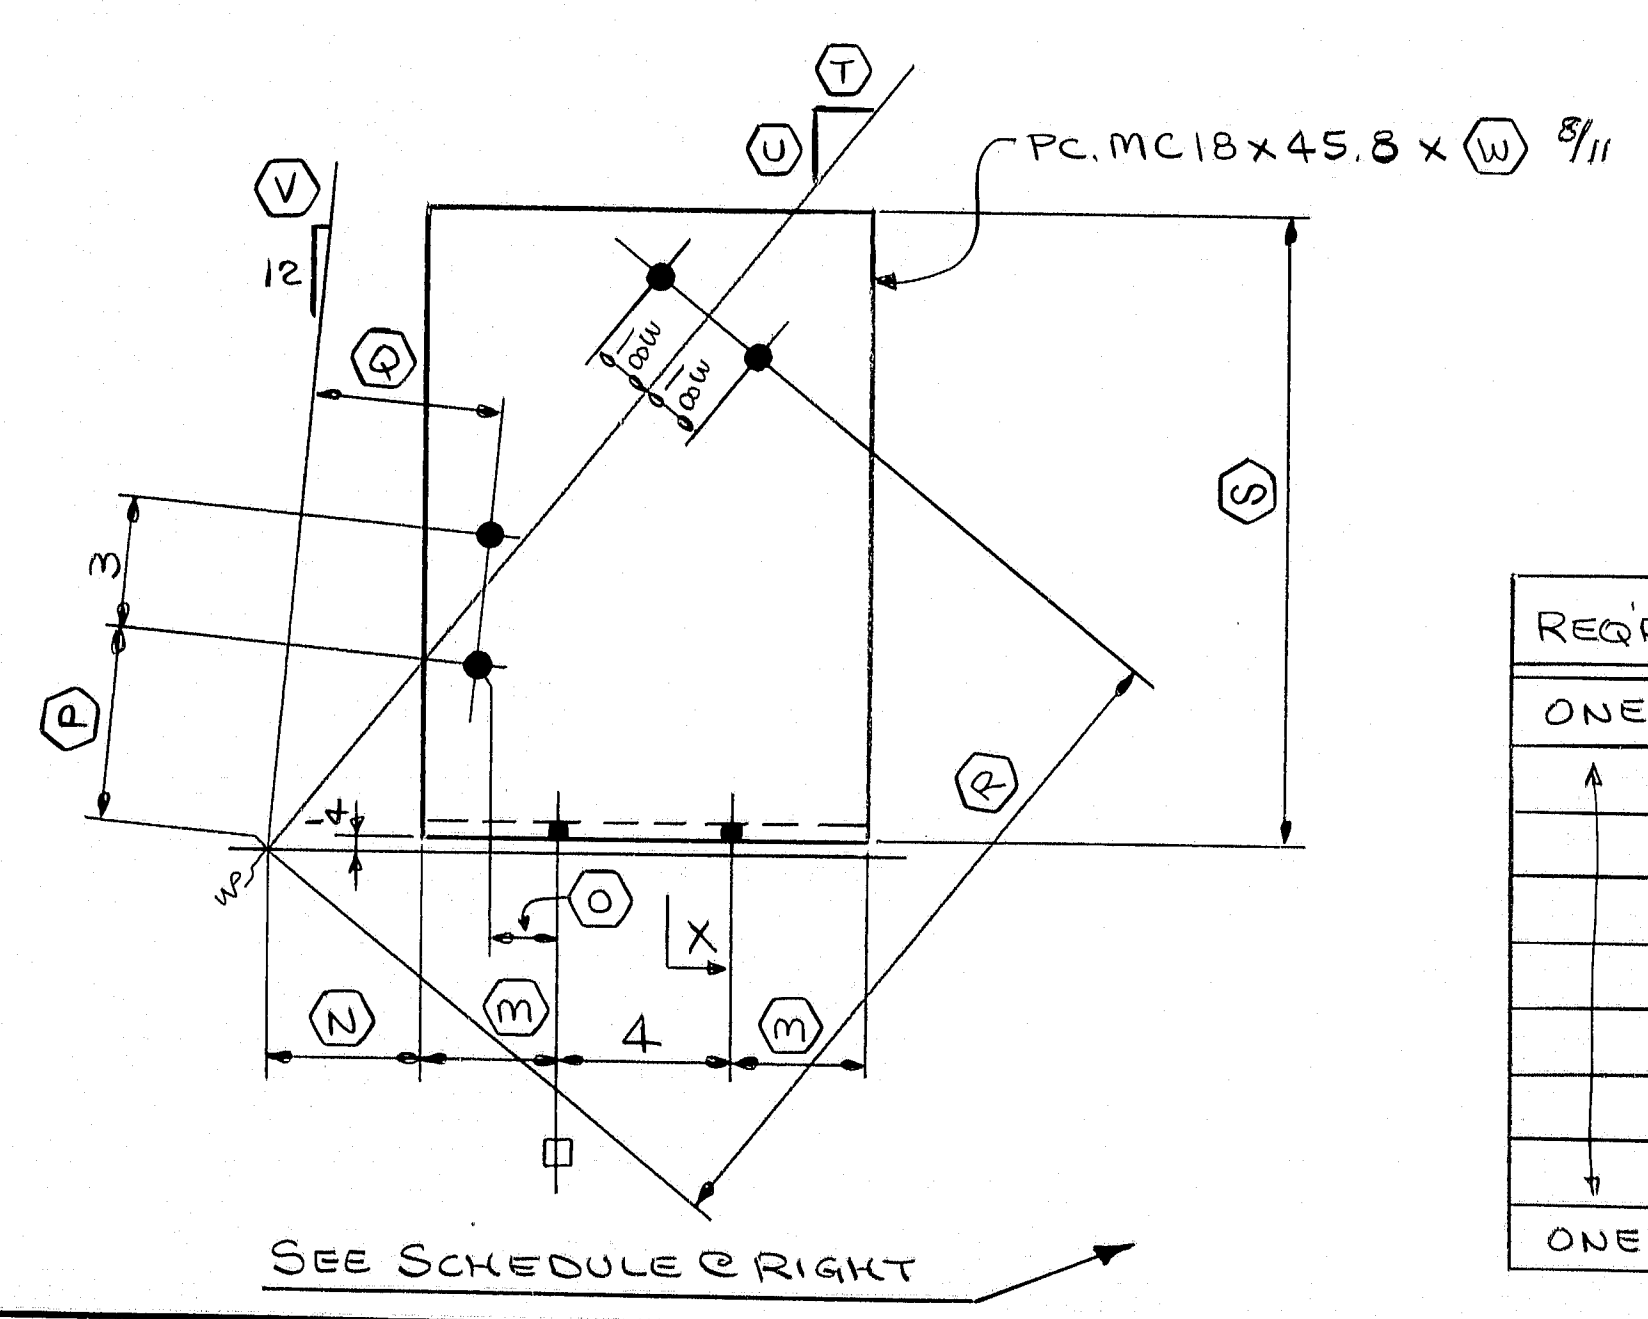

REQD.	MARK	(M)	(N)	(O)	(P)	(Q)	(R)	(S)	(T)	(U)	(V)	(W)
ONE	X3bg	3' 4	3' 4	1' 5 3/4	4' 4	5' 4	1' 5 3/4	1' 3 1/2	10' 1/2	12	1' 6	10' 1/2
	X3bh	3' 8	1' 7 1/2	1' 5 3/4	1' 3 3/4	10' 1/2	12	1' 6	10' 4			
	X3bk	3' 4	1' 6	1' 5 3/4	1' 3 3/4	10' 1/2	12	1"	10' 1/2			
	X3bm		1' 5 3/4	1' 2 1/2	11	12	8' 1/2	1' 6				
	X3bn		1' 6	1' 2 1/2	11	12	8' 1/2	1' 6				
	X3bp	3' 4	1' 6	4' 4	5' 4	1' 2 1/2	11	12	8' 3/4	1"		
	X3bs	4' 1/2	1' 3 1/4	9' 4	5' 1/2	1' 6 1/2	1' 4 4	10' 3/4	12	1' 6		
	X3bt	4' 1/2	1' 5 3/8	9' 4	5' 1/2	1' 6 1/2	1' 4 4	10' 3/4	12	1' 6		
ONE	X3bw	3' 4	4' 1/2	1' 5 3/8	9' 4	5' 1/2	1' 6 1/2	1' 4 4	10' 1/2	12	1"	10' 1/2

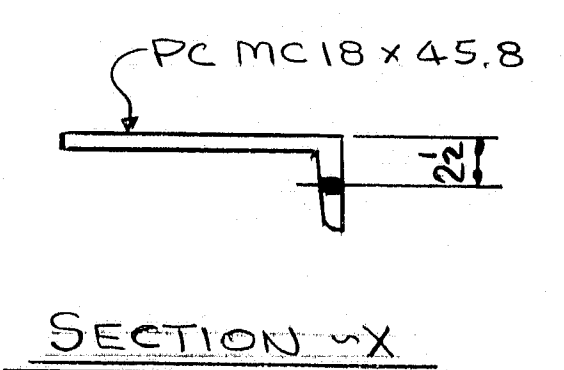

SHOP NOTE  
HOLES: 1 1/2" (UN)  
BOLTS: NONE  
PAINT: NONE

FOR GENERAL NOTES, SEE DWG. N1.  
ALL STEEL TO BE A.S.T.M. A588.  
(T) INDICATES CHARPY-V NOTCH TEST REQD.


R95-111

NO.	REVISION	DATE
HIGH STEEL STRUCTURES, INC.		
1905 Old Philadelphia Pike Lancaster, Pennsylvania 17603 Phone 717/298-5211		
A Subsidiary of High Industries, Inc.		
JOB STANDARDS		
I-395 BRIDGE OVER PENOBSCOT RIVER		
I-395 BRIDGE STA. 164+60.00		
PENOBSCOT COUNTY		
STATE OF MAINE		
DEPARTMENT OF TRANSPORTATION		
STATE CONTRACT OR REF. NO.	CONTRACTOR	DATE
6	CANBRO CORP.	
IN CHARGE:	MADE BY:	CHECKED BY:
HINKLE	G.F.X.	J.L.C.
CONTRACT NUMBER:	DRAWING NUMBER:	DATE:
ME-84088-1	X3	5-22-84






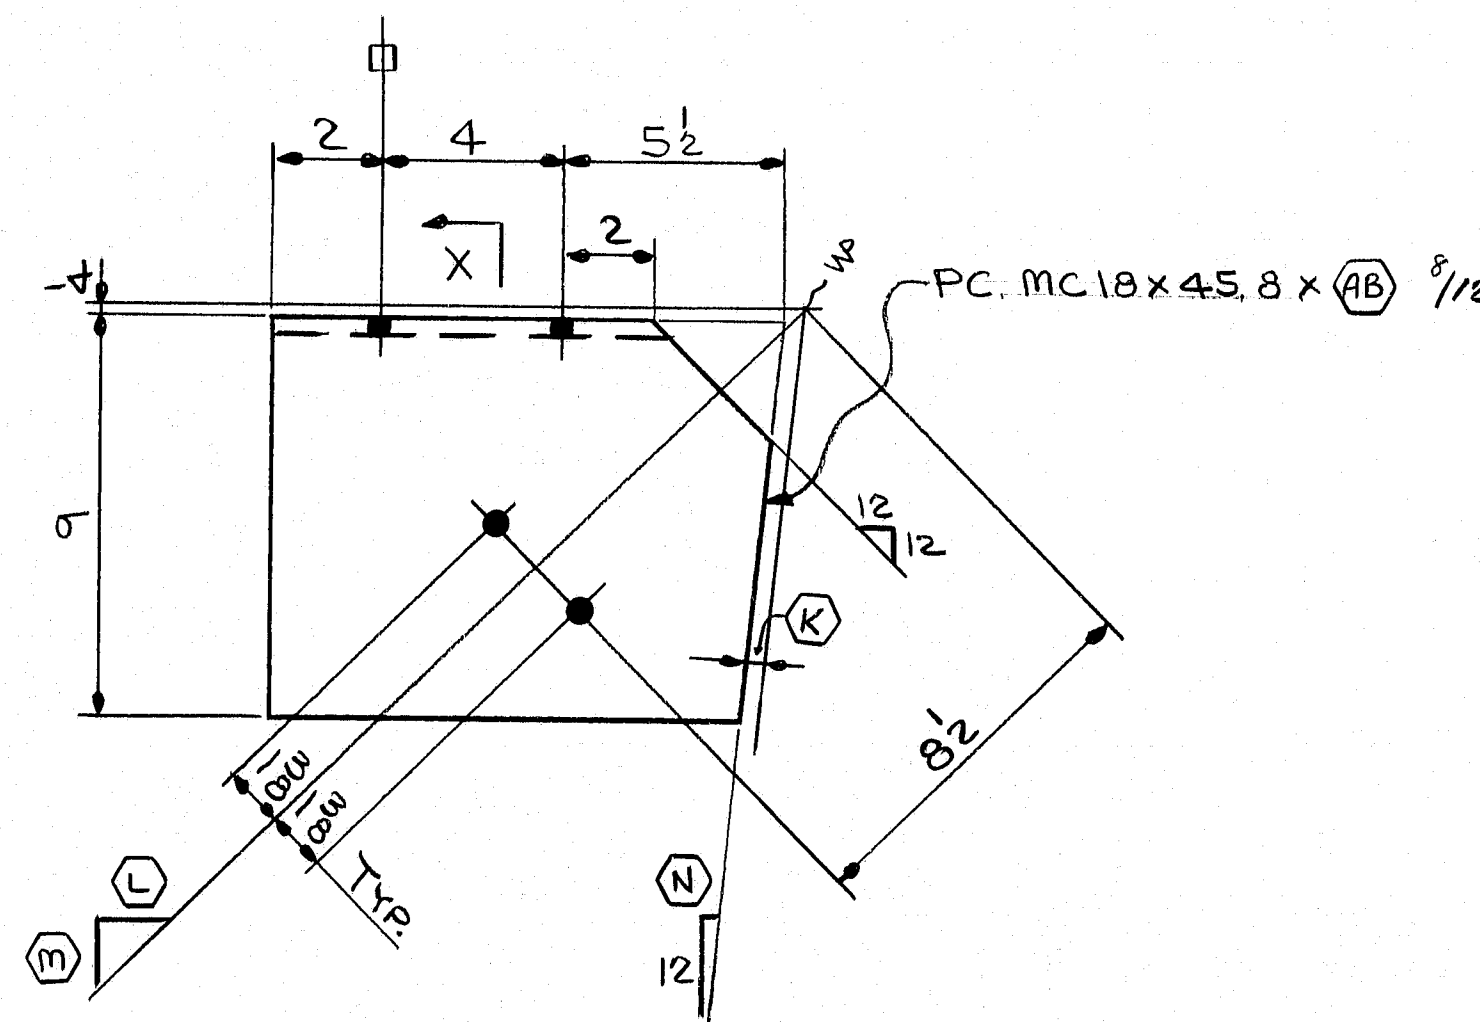


REQ'D	MARK	(K)	(L)	(M)	(N)	(AB)
ONE	X4a	11 1/16	10 1/8	12	7 3/8	11 1/16
	X4b	11 1/16	9 1/16		7 1/16	11 3/8
	X4c	11 1/16	10 1/4		7 1/8	11 1/4
	X4d	14	11 1/16	12	7 3/8	11 1/16
	X4f		12	9 3/8	7 1/16	11 3/8
	X4g		12	8 3/8	7 1/8	11 1/4
	X4h		10 1/16	12	7 3/8	11 1/16
	X4K		9 3/8	12	7 1/16	11 3/8
ONE	X4m	14	10 1/16	12	7 1/8	11 1/4

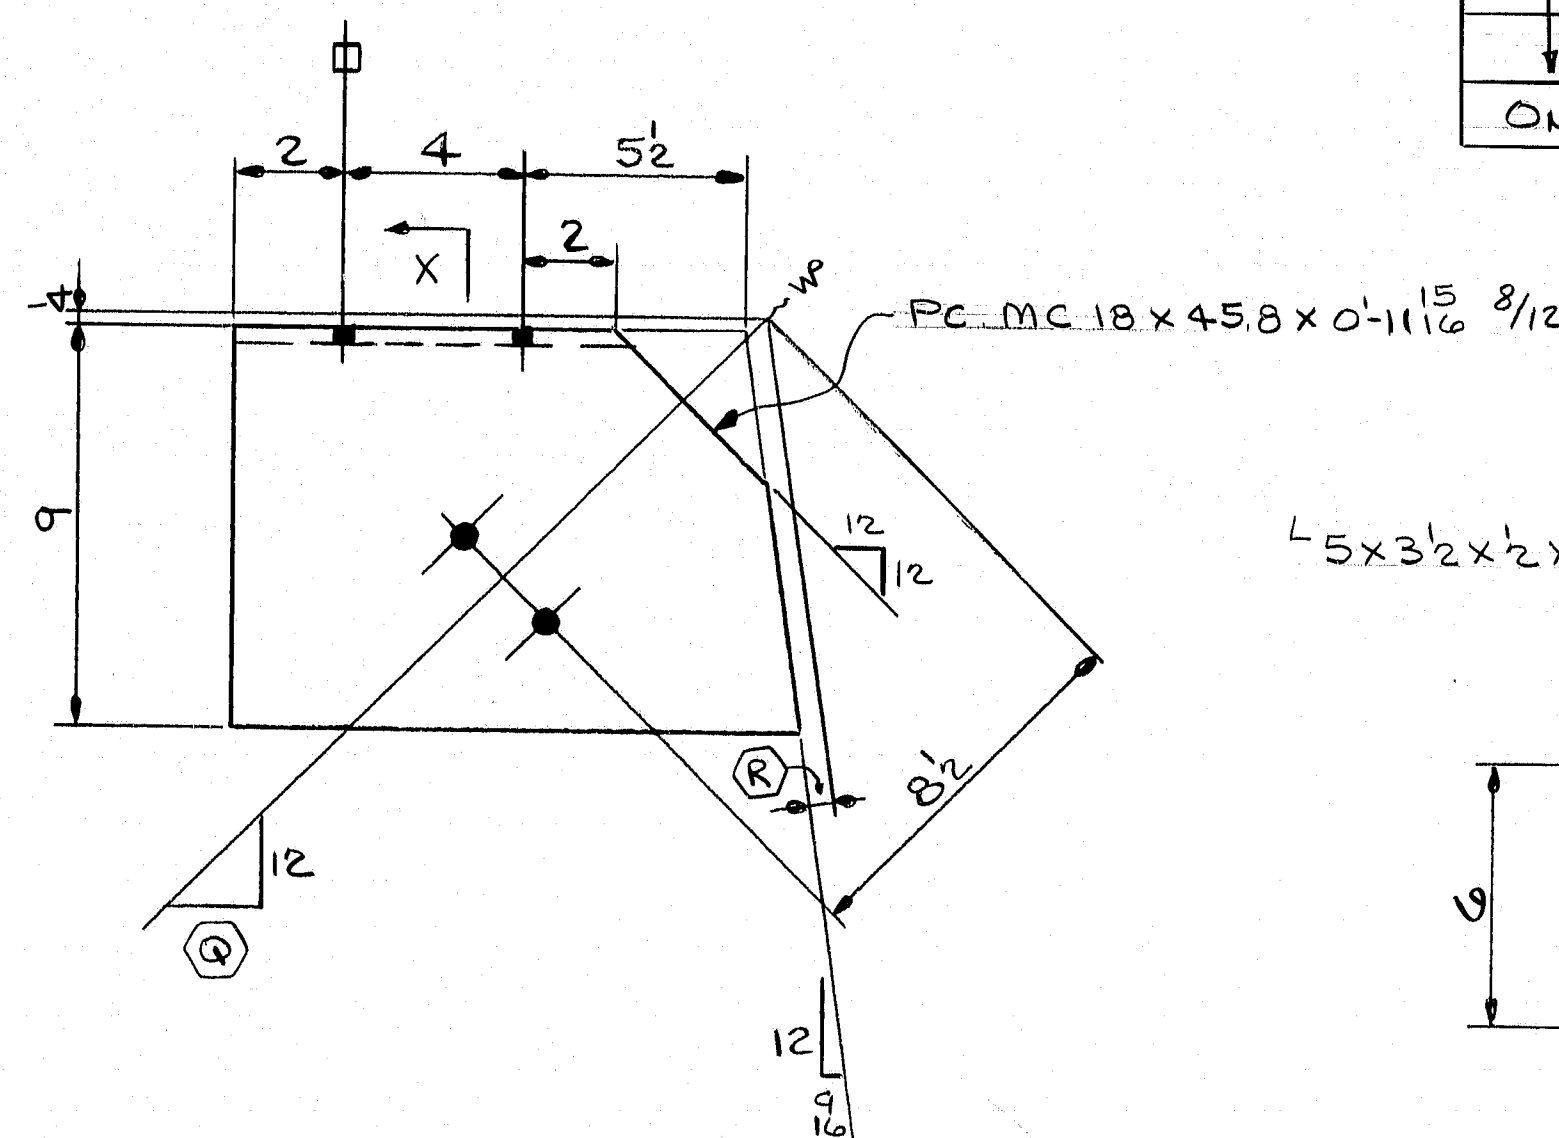


REQ'D	MARK	(Q)	(R)
ONE	X4ad	11 1/8	14
ONE	X4af	9 1/16	14
ONE	X4ag	9 3/8	11 1/16

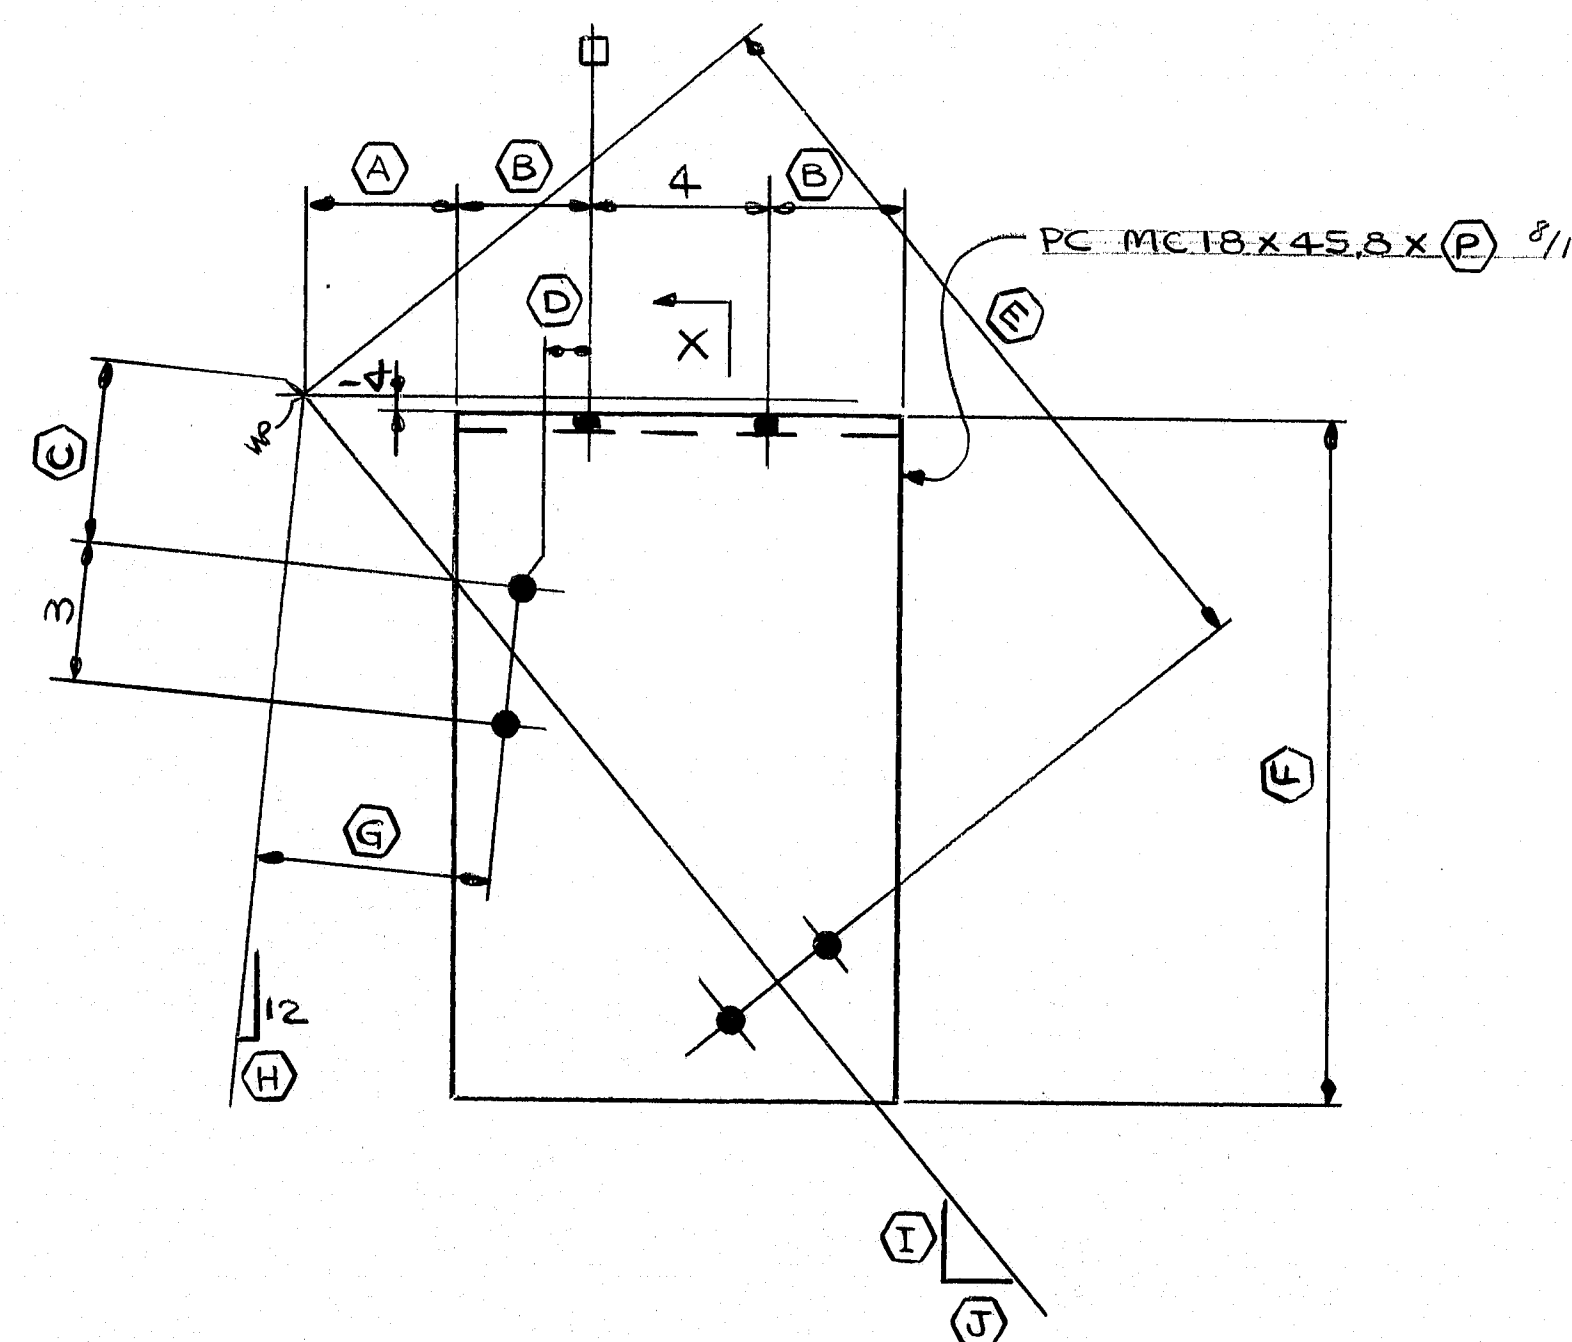



REQ'D	MARK	(A)	(B)	(C)	(D)	(E)	(F)	(G)	(H)	(I)	(J)	(P)
ONE	X4n	3	3	9 1/4	1 1/2	1-4	1-3 1/4	5 1/16	3 1/16	12	10 1/16	10
	X4p	3	3	9 1/4	5/8	1-4	1-3 1/4	5 1/16	1 1/16		9 1/8	10
	X4s	3	3	9 1/4	1"	1-4	1-3 1/4	5 1/16	7/8		8 1/16	10
	X4t	3 3/8	2 1/4	4 1/4	1 1/16	1-3	1-1 3/4	5 1/4	3 1/8		9 3/8	8 1/2
	X4w	3 1/2	2 3/8		1/2	1-3	1-2 1/4		1 1/16		9	8 1/4
	X4y	3 3/8	2 3/8		5/16	1-3	1-2 1/4		7/8	12	8 5/8	8 1/4
	X4aa	3 3/8	2 1/4		1 1/16	1-0	9 1/2		3 1/8	12	8 3/4	8 1/2
	X4ab	3 1/2	2 1/4		5/8	1-0	9 3/4		1 1/16	12	8 3/4	8 1/2
ONE	X4ac	3 1/4	2 1/4	4 1/4	9 1/16	1-0	9 3/4	5 1/4	7/8	9 3/8	12	8 1/2

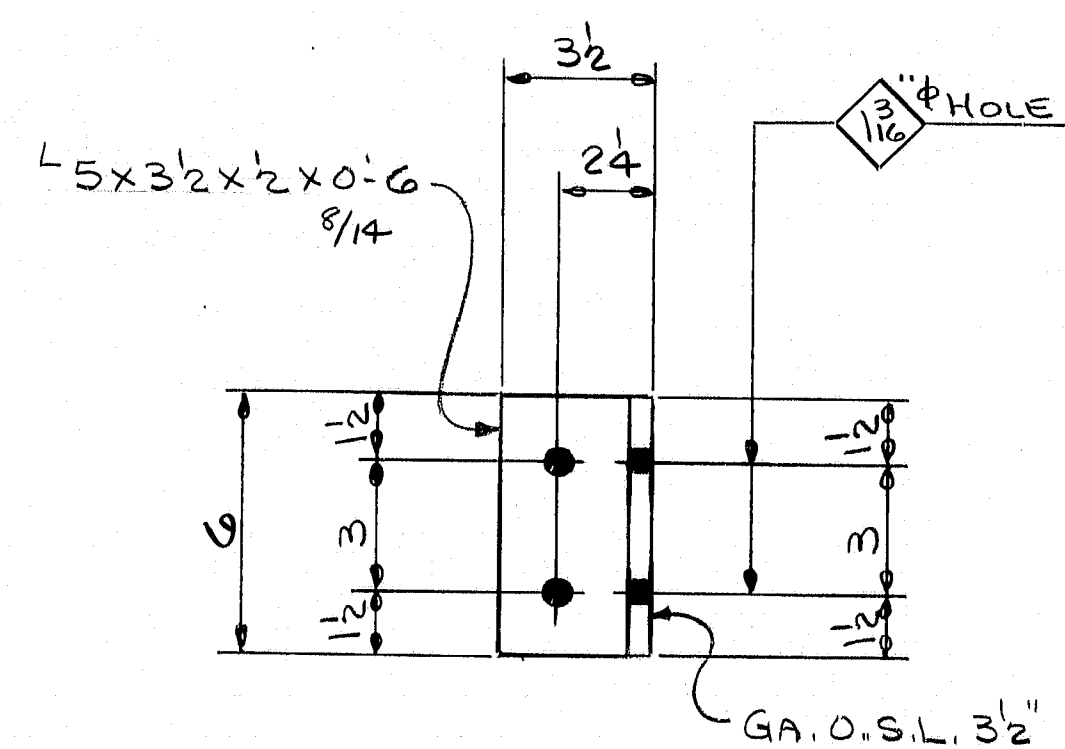


4 - ANGLE - MK. X4an

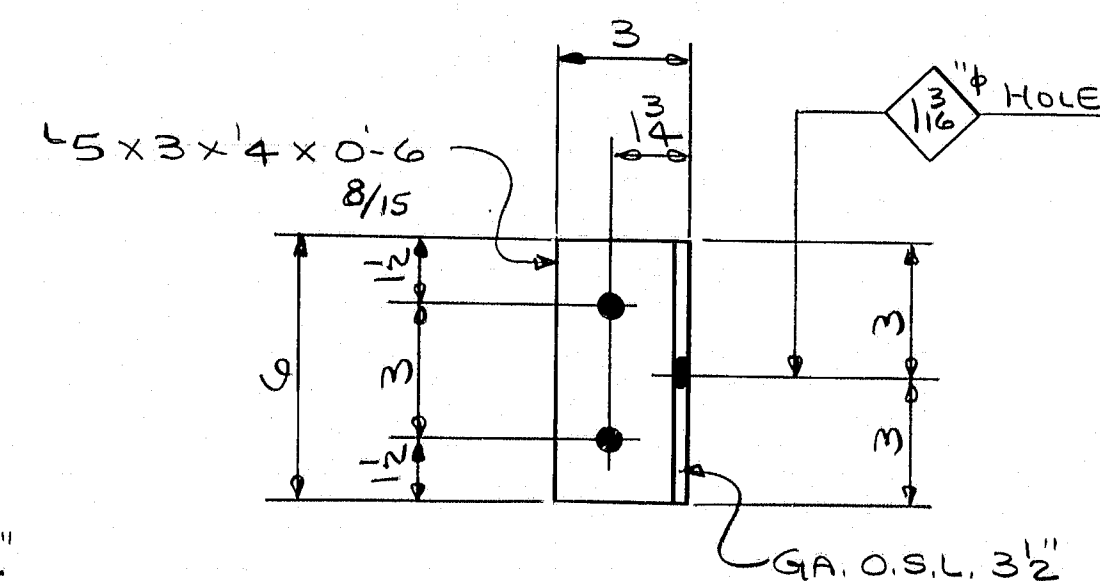


7 - ANGLE - MK. X4ap

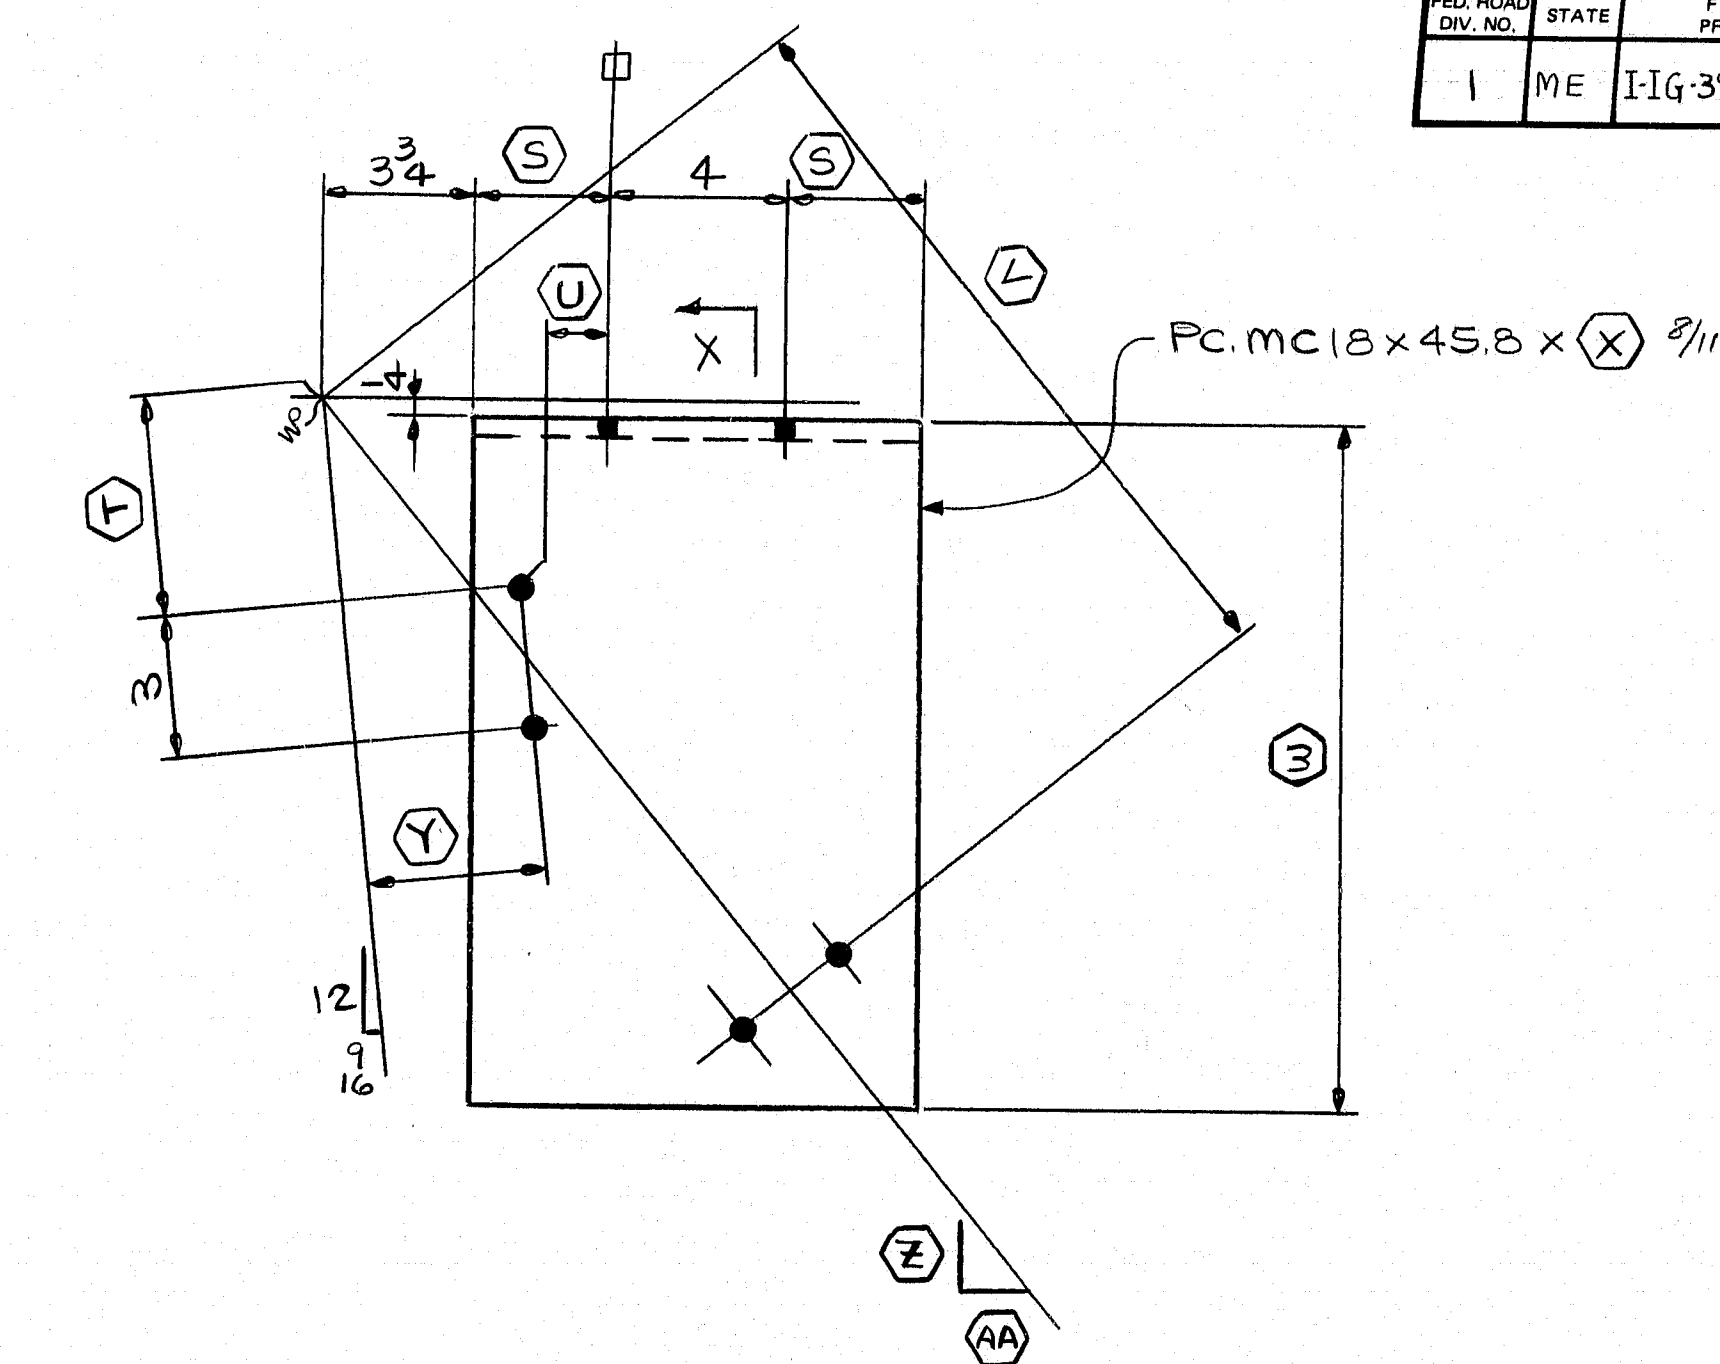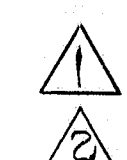

REQ'D	MARK	(S)	(T)	(U)	(V)	(W)	(X)	(Y)	(Z)	(AA)
ONE	X4ah	2 3/8	4 1/4	1 1/16	1-3 1/2	1-2	9 1/4	5 1/4	12	10 5/8
ONE	X4ak	2 1/4	4 1/4	9 1/16	1-0	9 1/4	8 1/2	5 1/4	8 3/8	12
ONE	X4am	2 3/4	9 1/4	3 1/8	1-4	1-2 1/2	9 1/2	5 1/16	12	10 1/16

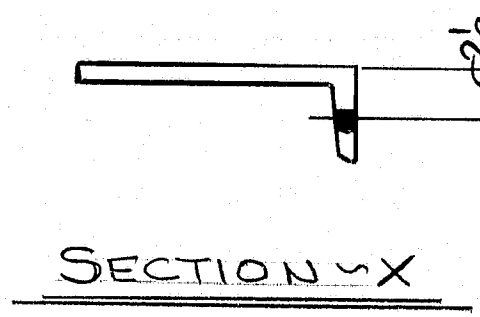

SECTION X-X

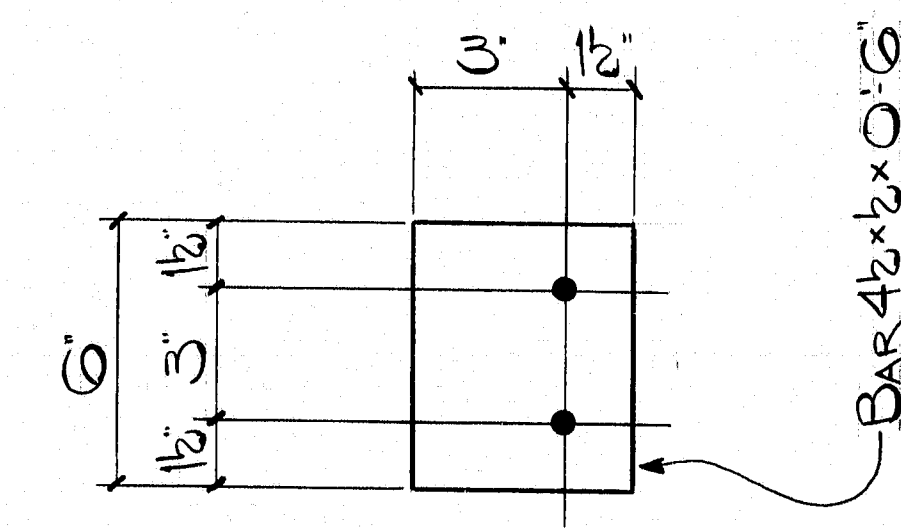

2 - CONN. BARS - MK. X4as

SHOP NOTE

HOLES: 1 1/2" (U.N.)  
BOLTS: NONE  
PAINT: NONE

FOR GENERAL NOTES, SEE DWG. N1.  
ALL STEEL TO BE A.S.T.M. A588.

R95-112 CODE:4000

changed quantities		12-14-84
NO. 1	REVISION contract revision control # 14	DATE 9-10-84
HIGH STEEL STRUCTURES, INC.		
1905 Old Philadelphia Pike Lancaster, Pennsylvania 17603 Phone 717/299-5211		
A Subsidiary of High Industries, Inc.		
JOB STANDARDS		
I-395 BRIDGE OVER PENOBSCOT RIVER		
I-395 BRIDGE STA. 164+60.00		
PENOBSCOT COUNTY		
STATE OF MAINE		
DEPARTMENT OF TRANSPORTATION		
STATE CONTRACT OR REF. NO. 6	CONTRACTOR GIANBRO CORP.	
IN CHARGE: HINKLE	MADE BY: G.F.F. CHK'D BY: JLC	DATE: 5-22-84
CONTRACT NUMBER: ME-84088-1	DRAWING NUMBER: X4	



GIRDERS "G"									
	A	B	C						
1	7	17	27						
2	8	18	28						
3	9	19	29						
4	10	20	30						
5	11	21	31						
6	12	22	32						
7	13	23	33						
8	14	24	34						
9	15	25	35						
10	16	26	36						

CROSSFRAMES "CF"										
	0	1	2	3	4	5	6	7	8	9
0		X	2							2
1		2			2					
2										
3										
4										
5										
6										
7										
8										
9										

	0	1	2	3	4	5	6	7	8	9
0										
1										
2										
3										
4										
5										
6										
7										
8										
9										

	0	1	2	3	4	5	6	7	8	9
0										
1										
2										
3										
4										
5										
6										
7										
8										
9										

	0	1	2	3	4	5	6	7	8	9
0										
1										
2										
3										
4										
5										
6										
7										
8										
9										

	0	1	2	3	4	5	6	7	8	9
0										
1										
2										
3										
4										
5										
6										
7										
8										
9										

CROSSFRAMES (KNOCKED DOWN)										
	0	1	2	3	4	5	6	7	8	9
0										
1	A1	thru	A68	-DET'D	ON	DWG.	#3			
2										
3	B1	thru	B48	-DET'D	ON	DWG.	#4			
4										
5	B49	thru	B68	-DET'D	ON	DWG.	#5			
6										
7	C1	thru	C49	-DET'D	ON	DWG.	#6			
8										
9	E1	thru	E6	-DET'D	ON	DWG.	#5			

	0	1	2	3	4	5	6	7	8	9
0										
1										
2										
3										
4										
5										
6										
7										
8										
9										

	0	1	2	3	4	5	6	7	8	9
0										
1										
HORIZONTAL BRACING "HB"										
	0	1	2	3	4	5	6	7	8	9
0										
1	HB thru HB32 def. allows									
2										
3										
4										
5										
6										
7										
8										
9										

	0	1	2	3	4	5	6	7	8	9
0										
1										
2										
3										
4										
5										
6										
7										
8										
9										

	0	1	2	3	4	5	6	7	8	9
0										
1										
2										
3										
4										
5										
6										
7										
8										
9										

	0	1	2	3	4	5	6	7	8	9
0										
1										
2										
3										
4										
5										
6										
7										
8										
9										

MISCELLANEOUS										
	0	1	2	3	4	5	6	7	8	9
0										
1										
2										
3										
4										
5										
6										
7										
8										
9										

	0	1	2	3	4	5	6	7	8	9
0										
1										
2										
3										
4										
5										
6										
7										
8										

# GENERAL SHOP NOTES

FED. ROAD DIV. NO.	STATE	FED. AID PROJ. NO.
1	ME.	I-10-395-8(82)176

SPECIFICATIONS:  
MAINE DEPARTMENT OF TRANSPORTATION STANDARD SPECIFICATIONS  
HIGHWAYS AND BRIDGES (REVISION OF JUNE 1981)  
AND SUPPLEMENTALS THERETO, EXCEPT AS MODIFIED ON THE  
PLANS AND IN THE SPECIAL PROVISIONS.

MATERIAL:  
UNLESS NOTED OTHERWISE, ALL STEEL TO BE ASTM A588, GRADE A, B, FOR G  $\Delta$   
(T) INDICATES CHARPY V-NOTCH TESTING REQUIRED.  
SHOP BOLTS TO BE ASTM A325 TYPE 3 HEAVY HEX. HEAD.  
WITH 1 A563 GR. C3 HEAVY HEX. NUT AND 1 F436 WEATHERING WASHER EACH.  
HANDRAIL NUTS: A563 GR. C3 HEX. NUT  
WASHERS: F436 WEATHERING

NON-DESTRUCTIVE TESTING:  
FLANGE AND WEB PLATE SPLICES TO BE RADIOGRAPHICALLY TESTED, AS CALLED FOR ON  
DRAWINGS PREFIXED 'FS' AND 'WC', BY A QUALIFIED TECHNICIAN.

MAGNETIC PARTICLE INSPECTION IS REQUIRED ON 10% OF ALL FILLET WELDS IN MAIN MEMBERS. (INCLUDING BEARINGS)  $\Delta$   
ALL TESTING TO BE DONE UNDER THE SUPERVISION OF MAINE DEPT. OF  
TRANSPORTATION INSPECTION PERSONNEL.

REAMING:  
HOLES MARKED  $\square$  ON DETAIL DRAWINGS TO BE SUB-PUNCHED  $\frac{1}{16}$ "  $\phi$  AND REAMED TO  
 $\frac{1}{16}$ "  $\phi$  WITH CONNECTING PARTS ASSEMBLED AND MATCH MARKED.

CLEANING: BLAST CLEAN TO SSPC-SP6. FLANGE TO WEB WELD AREAS TO BE  
CLEANED TO SSPC-SP6 PRIOR TO WELDING.


PAINTING: NONE

SHOP PROCEDURE:  
ALL FLANGE AND WEB PLATE BUTT WELDED SPLICES TO BE MADE BEFORE FINAL  
FITTING AND WELDING INTO GIRDER.  
CAMBER TOLERANCE:  $-0$  TO  $+3/4$   
ALL RE-ENTRANT CUTS TO HAVE  $3/4$  MIN. RADIUS.  
 $\phi$  INDICATES SET LINE.  
NO DIE STAMPING ALLOWED ON ANY PART OF MAIN STRESS CARRYING MEMBERS.  
ALL WEB AND FLANGE BUTT JOINTS SHALL BE GROUND SMOOTH PRIOR  
TO TESTING AND FITTING.

DRAWING REFERENCE:  
FLANGE SPLICES -PREFIXED 'FS'  
WEB CAMBERS -PREFIXED 'WC'  
GIRDER JOB STANDARDS -PREFIXED 'X'  
  
REAM ASSEMBLY -DWG. 'E'  
  
WELDING PROCEDURE -DWG. 'WP'

INSPECTION:  
SHOP INSPECTION BY: JERSEY TESTING LAB

WELDING:  
ALL WELDING IS TO CONFORM TO AWS D1.1-80 AS MODIFIED BY THE 1981 AASHTO  
SPECIFICATIONS, AND SUPPLEMENTAL SPECIFICATIONS, SECTION 504, STRUCTURAL STEEL WELDING.  
NOTATIONS W1X, W2X, ETC. FOLLOWING WELDING SYMBOLS ON DETAIL DRAWINGS, REFER TO THE  
CORRESPONDING WELDING PROCEDURE TO BE USED FOR THAT JOINT.

NO. $\Delta$	REVISION ALTERED AS PER 10-11 APP'LC	DATE 10-17-84
NO. $\Delta$	REVISION ALTERED AS PER 1-17 APP'LC	DATE 8-17-84
<b>HIGH STEEL STRUCTURES, INC.</b>  1805 Old Philadelphia Pike Lancaster, Pennsylvania 17603 Phone 717/299-528 A Subsidiary of High Industries, Inc.		
GENERAL SHOP NOTES		
I-395 BRIDGE OVER PENOBSCOT RIVER		
I-395 BRIDGE STA. 164+60.00		
PENOBSCOT COUNTY		
STATE OF MAINE		
DEPARTMENT OF TRANSPORTATION		
STATE CONTRACT OR REF. NO.	6	CONTRACTOR CIAMBRO CORP.
IN CHARGE HINKLE	MADE BY J.L.C.	CHK'D BY J.C.H. DATE 5-22-84
CONTRACT NUMBER ME-84088-1,2,3	DRAWING NUMBER NI	

R95-114



R95-115






WELDING PROCEDURE FOR STAINLESS STEEL ON ME-84088										WELDING PROCEDURE FOR AWS PREQUALIFIED JOINTS W29ME										WELDING PROCEDURE FOR AWS PREQUALIFIED JOINTS W31ME										FED. ROAD DIV. NO. STATE FED. AID PROJ. NO.	
W4ME										W29ME										W31ME	
PROCEDURE SPECIFICATIONS										PROCEDURE SPECIFICATIONS										PROCEDURE SPECIFICATIONS	
MATERIAL SPECIFICATION.....ASTM A-308, A240 Type 304 WELDING PROCESS.....Manual GTAW POSITION OF WELDING.....2F ELECTRODE SPECIFICATION.....AWS A5.12-69 FILLER METAL.....E6010 (24 Thoriated) GAS SHIELDING.....Argon ELECTRODE SIZE.....1/16" NOZZLE SIZE.....5/16" (3/8") POLARITY.....DC- ELECTRICAL STICK OUT.....3/4" ROOT TREATMENT.....Manual Cleaning PREHEAT AND INTERPASS TEMPERATURE.....None										MATERIAL SPECIFICATION.....ASTM A-36, A-514, A-588 WELDING PROCESS.....SUBMERGED ARC MANUAL OR MACHINE.....MACHINE OR (SEMI-AUTOMATIC) POSITION OF WELDING.....WFLAT FILLER METAL SPECIFICATION.....AWS A5.17-88 FILLER METAL CLASSIFICATION.....F7A2-EM12K FLUX.....LINCOLN 850 SINGLE OR MULTIPLE ARC.....LINCOLN L61 SINGLE ELECTRODE POLARITY.....DC- ELECTRICAL STICK OUT.....STANDARD 1" ROOT TREATMENT.....MANUAL CLEANING PREHEAT AND INTERPASS TEMPERATURE.....SEE ATTACHED PREHEAT CHART OPEN CIRCUIT VOLTAGE.....68										MATERIAL SPECIFICATION.....ASTM A-36, A-514, A-588 WELDING PROCESS.....SAW, SINGLE ELECTRODE MANUAL OR MACHINE.....MACHINE OR SEMIAUTOMATIC POSITION OF WELDING.....10 (FLAT) FILLER METAL SPECIFICATION.....AWS A5.17-88 WELD METAL CLASSIFICATION.....F7A2-EM12K FLUX/WIRE.....LINCOLN 868/L61 POLARITY.....DC- ELECTRICAL STICK OUT (INCHES).....1 ROOT TREATMENT.....MANUAL CLEANING PREHEAT AND INTERPASS TEMPERATURE.....SEE PREHEAT CHART OPEN CIRCUIT VOLTAGE.....60	
<b>WELDING PROCEDURE</b> <table border="1"> <thead> <tr> <th>PASS</th> <th>WIRE NO.</th> <th>WIRE SIZE</th> <th>WELDING CURRENT</th> <th>TRAVEL</th> <th>GAS FLOW</th> <th>JOINT DETAIL</th> </tr> <tr> <th></th> <th></th> <th></th> <th>AMPS</th> <th>VOLTS</th> <th>IPM</th> <th>CFH</th> </tr> </thead> <tbody> <tr> <td>1</td> <td>1/16</td> <td>60</td> <td>12</td> <td>4</td> <td>20</td> <td rowspan="2"> </td> </tr> <tr> <td colspan="6">           TOLERANCES:            AMPS: 94-66            VOLTS: 11.2-12.8            TRAVEL SPEED: 3-5            GAS FLOW: 18-25            TIP ANGLE: 17°            TIP RADIUS: 1/32 (0072)         </td> </tr> </tbody> </table>										PASS	WIRE NO.	WIRE SIZE	WELDING CURRENT	TRAVEL	GAS FLOW	JOINT DETAIL				AMPS	VOLTS	IPM	CFH	1	1/16	60	12	4	20		TOLERANCES: AMPS: 94-66 VOLTS: 11.2-12.8 TRAVEL SPEED: 3-5 GAS FLOW: 18-25 TIP ANGLE: 17° TIP RADIUS: 1/32 (0072)						<b>WELDING PROCEDURE</b> <table border="1"> <thead> <tr> <th>PASS</th> <th>WIRE NO.</th> <th>WIRE SIZE</th> <th>WELDING CURRENT</th> <th>TRAVEL</th> <th>JOINT DETAIL</th> </tr> <tr> <th></th> <th></th> <th></th> <th>AMPS</th> <th>VOLTS</th> <th>IPM</th> </tr> </thead> <tbody> <tr> <td>1-3</td> <td>1/2</td> <td>458</td> <td>37</td> <td>17</td> <td rowspan="2"> </td> </tr> <tr> <td colspan="5">           TOLERANCES:            AMPS: 485-495            VOLTS: 34.5-39.5            WIRE FEED SPEED: 82-187            TRAVEL SPEED: 14.5-19.5         </td> </tr> </tbody> </table>										PASS	WIRE NO.	WIRE SIZE	WELDING CURRENT	TRAVEL	JOINT DETAIL				AMPS	VOLTS	IPM	1-3	1/2	458	37	17		TOLERANCES: AMPS: 485-495 VOLTS: 34.5-39.5 WIRE FEED SPEED: 82-187 TRAVEL SPEED: 14.5-19.5					<b>WELDING PROCEDURE</b> <table border="1"> <thead> <tr> <th>PASS</th> <th>WIRE NO.</th> <th>WIRE SIZE</th> <th>WELDING CURRENT</th> <th>TRAVEL</th> <th>JOINT DETAIL</th> </tr> <tr> <th></th> <th></th> <th></th> <th>AMPS</th> <th>VOLTS</th> <th>IPM</th> </tr> </thead> <tbody> <tr> <td>1-3</td> <td>1/2</td> <td>458</td> <td>37</td> <td>17</td> <td rowspan="2"> </td> </tr> <tr> <td colspan="5">           TOLERANCES:            AMPS: 485-495            WIRE FEED SPEED: 82-187            VOLTS: 34.5-39.5            TRAVEL SPEED: 14.5-19.5         </td> </tr> </tbody> </table>										PASS	WIRE NO.	WIRE SIZE	WELDING CURRENT	TRAVEL	JOINT DETAIL				AMPS	VOLTS	IPM	1-3	1/2	458	37	17		TOLERANCES: AMPS: 485-495 WIRE FEED SPEED: 82-187 VOLTS: 34.5-39.5 TRAVEL SPEED: 14.5-19.5								
PASS	WIRE NO.	WIRE SIZE	WELDING CURRENT	TRAVEL	GAS FLOW	JOINT DETAIL	
			AMPS	VOLTS	IPM	CFH	
1	1/16	60	12	4	20	
TOLERANCES: AMPS: 94-66 VOLTS: 11.2-12.8 TRAVEL SPEED: 3-5 GAS FLOW: 18-25 TIP ANGLE: 17° TIP RADIUS: 1/32 (0072)	
PASS	WIRE NO.	WIRE SIZE	WELDING CURRENT	TRAVEL	JOINT DETAIL	
			AMPS	VOLTS	IPM	
1-3	1/2	458	37	17	
TOLERANCES: AMPS: 485-495 VOLTS: 34.5-39.5 WIRE FEED SPEED: 82-187 TRAVEL SPEED: 14.5-19.5	
PASS	WIRE NO.	WIRE SIZE	WELDING CURRENT	TRAVEL	JOINT DETAIL	
			AMPS	VOLTS	IPM	
1-3	1/2	458	37	17	
TOLERANCES: AMPS: 485-495 WIRE FEED SPEED: 82-187 VOLTS: 34.5-39.5 TRAVEL SPEED: 14.5-19.5	
THIS PROCEDURE MAY VARY DUE TO FABRICATION SEQUENCE, FIT-UP, PASS SIZE, ETC.										THIS PROCEDURE MAY VARY DUE TO FABRICATION SEQUENCE, FIT-UP, PASS SIZE, ETC. WITHIN THE "LIMITATION OF VARIABLES" GIVEN IN THE AMERICAN WELDING SOCIETY CODE, A.W.S. D11.										THIS PROCEDURE MAY VARY DUE TO FABRICATION SEQUENCE, FIT-UP, PASS SIZE, ETC. WITHIN THE "LIMITATION OF VARIABLES" GIVEN IN THE AMERICAN WELDING SOCIETY CODE, A.W.S. D11.	

SHIELDED METAL-ARC WELDING  
WITH LOW HYDROGEN ELECTRODES OR  
SUBMERGED ARC WELDING

MINIMUM PREHEAT AND INTERPASS TEMPERATURE

THICKNESS OF THICKEST PART AT POINT OF WELDING	M183 (ASTM A36) M223 (A572, GR. 50)	M222 (A588)
INCHES	DEGREES (F)	DEGREES (F)
TO 3/8	50	100
OVER 3/8 TO 1 1/2	70	200
OVER 1 1/2 TO 2 1/2	150	300
OVER 2 1/2	225	350

Preheat & Interpass Temperatures for 1" Thick ASTM A514

Minimum Preheat and Interpass Temperature 125°F.  
Maximum Preheat and Interpass Temperature 250°F.

NO PREHEAT REQUIRED FOR A240 TYPE 304 STAINLESS STEEL.

NO.	REVISION	DATE
1	REVISED W4ME	12-13-84
2	added 10-11-84 app'l not. deleted W31ME added W31ME	10-17-84
3	revision added 7-12-84 app'l not. 1 W31ME procedure	DATE 8-17-84

HIGH STEEL STRUCTURES, INC.

1906 Old Philadelphia Pike  
Lancaster, Pennsylvania 17604  
Phone 717/299-5211

A Subsidiary of High Industries, Inc.

WELDING PROCEDURES FOR FBT BEARINGS  
I-945 BRIDGE OVER PENOBSCOT RIVER  
I-945 BRIDGE STA 164+60.00  
PENOBSCOT COUNTY  
STATE OF MAINE  
DEPARTMENT OF TRANSPORTATION

STATE CONTRACT OR REF. NO. 6 CONTRACTOR CHANERO CORP.

CHARGE: J.M. MADE BY: S.J.A. DATE: 6-22-84


CONTRACT NO. ME-84088-123 DRAWING NO. WP2

R95-116






AF 2283A

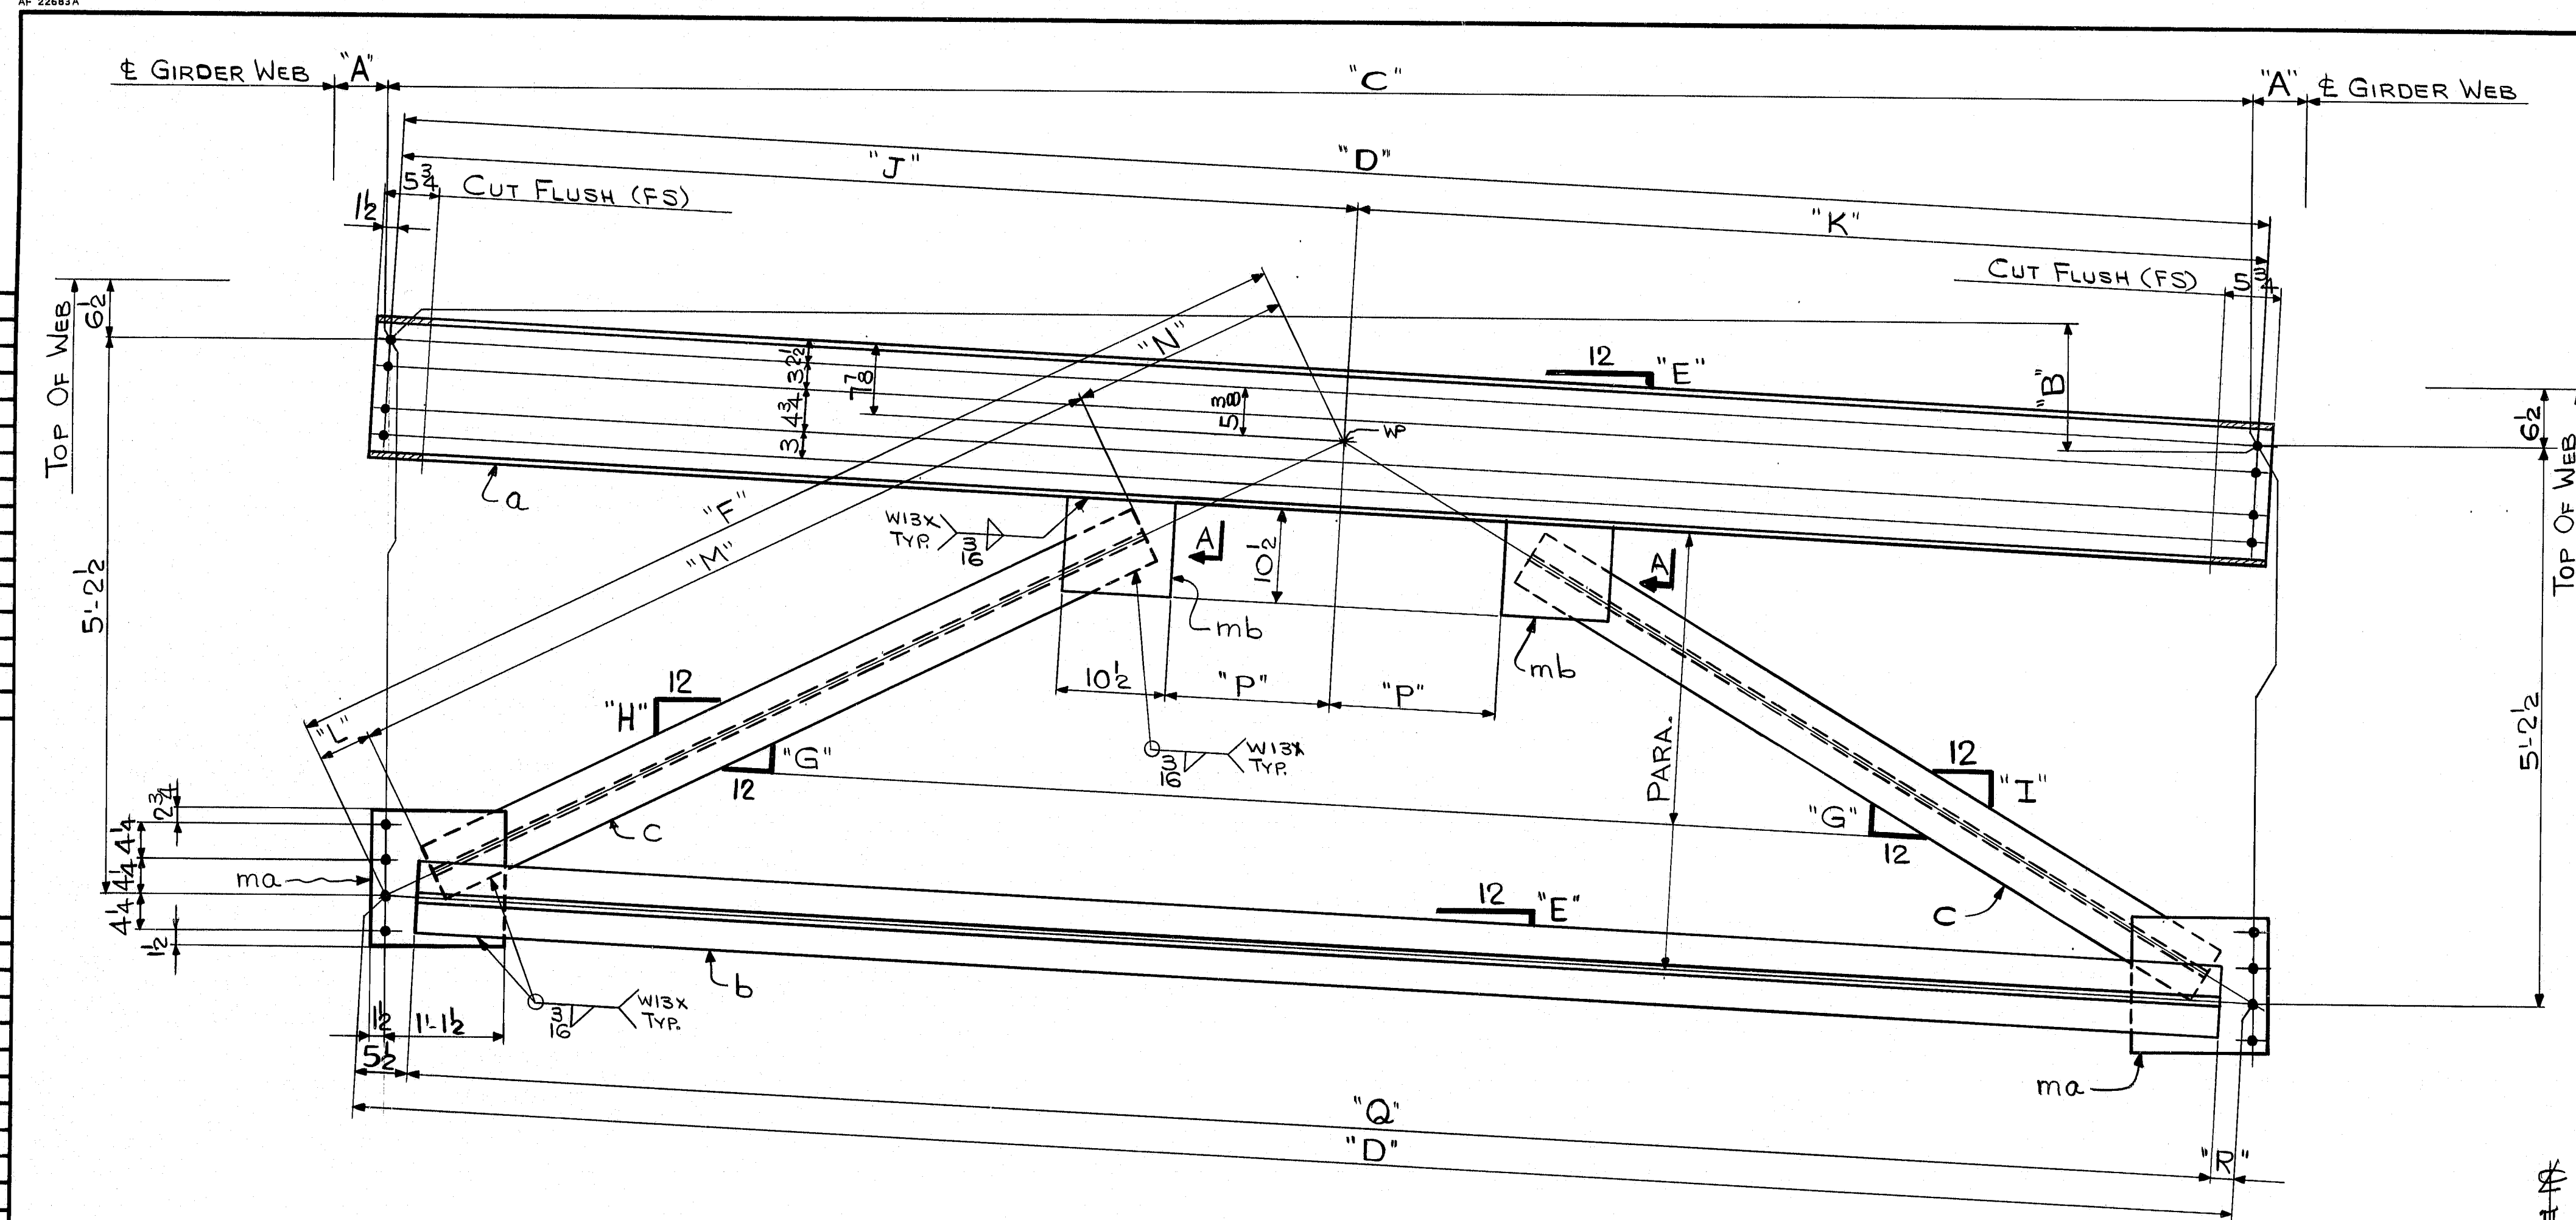

MARK	"A"	"B"	"C"	"D"	"E"	"F"	"G"	"H"	"I"	"J"	"K"	"L"	"M"	"N"	"P"	"Q"	"R"
CF1	5	8 1/2	16'-11 1/2"	16'-11 1/2"	2	9'-8 5/8"	6 3/4	6 3/4	7 3/8	8'-8 1/4"	8'-3 3/4"	5 1/8	7'-2 3/4"	2'-0"	1'-6 1/4"	16'-0 1/2"	5 1/2
CF2		9	16'-11 1/2"	16'-11 1/2"	2	9'-8 1/6"		6 1/6	7 1/6	8'-8 1/2"	8'-3"	5 1/8				16'-0 1/2"	5 1/2
CF3		9 1/2	16'-11 1/2"	16'-11 1/2"	9	9'-8 1/6"		6	7 1/2	8'-8 1/2"	8'-2 3/4"	5 1/8				16'-0 1/2"	5 1/2
CF4		6 1/2	16'-11 1/2"	16'-11 1/2"	3	9'-8 3/4"		6 1/4	7 1/4	8'-7 1/8"	8'-3 1/2"	6				16'-0 1/2"	5 1/2
CF5		9 3/8	16'-11 1/2"	16'-11 1/2"	1	9'-8 3/4"	6 3/4	6	7 1/2	8'-8 1/8"	8'-2 1/2"	6				16'-0 1/2"	5 1/2
CF6	5	10 3/4	16'-11 1/2"	16'-11 1/2"	5	9'-8 1/8"	6 1/6	5 1/6	7 1/6	8'-9 1/4"	8'-2 1/2"	6 1/6	7'-2 3/4"	2'-0"	1'-6 1/4"	16'-0 1/2"	5 1/2
CF7	6	6 1/2	17'-5 3/4"	17'-5 3/4"	3	9'-11 1/6"	6 1/2	6 1/6	7	8'-10 1/8"	8'-7"	5 1/6	7'-4 3/4"	2'-1"	1'-7 1/2"	16'-0 1/2"	5 1/2
CF8		8 3/8	17'-5 3/4"	17'-5 1/8"	2	9'-11 1/2"	6 1/2	5 1/6	7 1/6	8'-11 1/6"	8'-6 1/2"	5 3/4	7'-4 3/4"	2'-1"	1'-7 1/2"	16'-0 1/2"	5 1/2
CF9		10	17'-5 3/4"	17'-6"	1	9'-11 1/2"	6 1/2	5 1/6	7 1/6	9'-0"	8'-6"	5 3/4	7'-4 3/4"	2'-1"	1'-7 1/2"	16'-0 1/2"	5 1/2
CF10		5 1/4	18'-3 3/8"	18'-3 3/8"	10	10'-3 1/2"	6 1/4	5 3/8	6 3/8	9'-3 1/6"	9'-0 1/2"	5 1/6	7'-8 1/4"	2'-2"	1'-8 1/2"	17'-4 3/8"	5 1/2
CF11		11 3/8	18'-3 3/8"	18'-4 3/8"	5	10'-4"	6 1/4	5 1/2	7	9'-5 1/4"	8'-10 1/8"	5 3/4	7'-8 1/4"	2'-2"	1'-8 1/2"	17'-4 3/8"	5 1/2
CF12		11 0 5/8	18'-3 3/8"	18'-4 1/4"	1	10'-4"	6 1/6	5 3/8	7 3/8	9'-5 1/6"	8'-10 1/6"	5 3/4	7'-8 1/4"	2'-2"	1'-8 1/2"	17'-5 1/4"	5 1/2
CF13		7 3/4	13'-5 3/8"	13'-5 3/8"	1	8'-2 1/2"	6 1/2	7 3/8	9 3/8	6'-11 1/6"	6'-5 3/8"	6 1/6	6'-0"	1'-8"	1'-1 1/2"	12'-6 1/4"	5 1/2
CF14		8 1/2	14'-8 3/8"	14'-8 3/8"	1	8'-9 1/8"	7 1/4	6 1/2	8 3/8	7'-7 1/6"	7'-1 1/4"	6 3/8	6'-5 1/4"	1'-9 1/2"	1'-3 1/4"	13'-9 1/2"	5 1/2
OPR. HO.																	

OPP. HD.

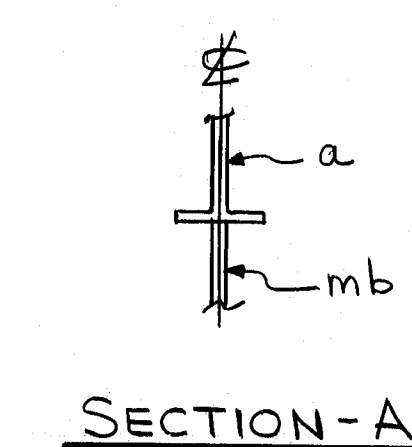

SECTION-A


**SHOP NOTE**  
 HOLES: 15" φ  
 BOLTS: NONE  
 PAINT: NONE  
 FOR GENERAL NOTES SEE DWG. N1

**R95-118** CODE: 5300

BILL OF MATERIAL					
NO.	MARK	DESCRIPTION	LENGTH	REMARKS	ITEM
2	CF1	CROSSFRAME			1059.
ONE	CF2				1059.
1	CF3				1059.
2	CF4				1059.
ONE	CF5				1060.
2	CF6				1061.
2	CF7				1089.
ONE	CF8				1089.
1	CF9				1089.
ONE	CF10				1136.
2	CF11				1137.
2	CF12				1137.
4	CF13			(OPP. HAND)	860.
4	CF14	CROSSFRAME		(OPP. HAND)	932.
3	a	W16 x 26	17 2 1/2	CF1, CF2	3/2
2			17 2 1/2	CF3, CF4	3/3
1			17 2 1/2	CF5	3/4
2			17 3	CF6	3/5
2			17 8 1/2	CF7	3/6
2			17 9	CF8, CF9	3/7
1			18 7	CF10	3/8
1			18 7 1/2	CF11	3/9
2			18 7 1/2	CF12	3/10
4			13 8 3/8	CF13	3/11
4	a	W16 x 26	14 11 3/8	CF14	3/12
4	b	WT 7 x 21.5	16 0 1/2	CF1, CF2, CF3	4/12
1			16 0 1/2	CF4	4/13
1			16 0 3/4	CF5	4/14
2			16 0 3/8	CF6	4/15
3			16 6 1/2	CF7, CF8	4/21
1			16 7	CF9	4/22
1			17 4 1/2	CF10	4/27
1			17 5 1/2	CF11	4/28
2			17 5 1/2	CF12	4/29
4			12 6 1/4	CF13	3/21
4	b	WT 7 x 21.5	13 9 1/2	CF14	3/22
16	c	WT 6 x 13	7 2 3/4	CF1, CF2, CF3, CF4, CF5, CF6	3/3
8			7 4 3/4	CF7, CF8, CF9	3/4
8			7 8 1/4	CF10, CF11, CF12	3/5
8			6 0	CF13	3/6
8	c	WT 6 x 13	6 5 1/4	CF14	3/7
48	ma	φ 15 x 3/8	1 5		5/10
48	mb	φ 10 1/2 x 3/8	0 10 1/2		5/11

NO.	REVISION	DATE
<p><b>HIGH STEEL STRUCTURES, INC.</b></p> <p>1905 Old Philadelphia Pike              Lehigh, Pennsylvania 17033              Phone 717/299-5211</p> <p>A Subsidiary of High Industries, Inc.</p>		
CROSSFRAME DETAILS		
I-395 BRIDGE OVER PENOBSCOT RIVER		
I-395 BRIDGE STA. 164+60.00		
PENOBSCOT COUNTY		
STATE OF MAINE		
DEPARTMENT OF TRANSPORTATION		
STATE CONTRACT OR REF. NO.	6	CONTRACTOR CIAMBRO CORP.
IN CHARGE: HINKLE	MADE BY: JLC	CHK'D BY: BJK
CONTRACT NUMBER: ME-84088-1	DRAWING NUMBER: 2 OF 36	DATE: 5-7-84



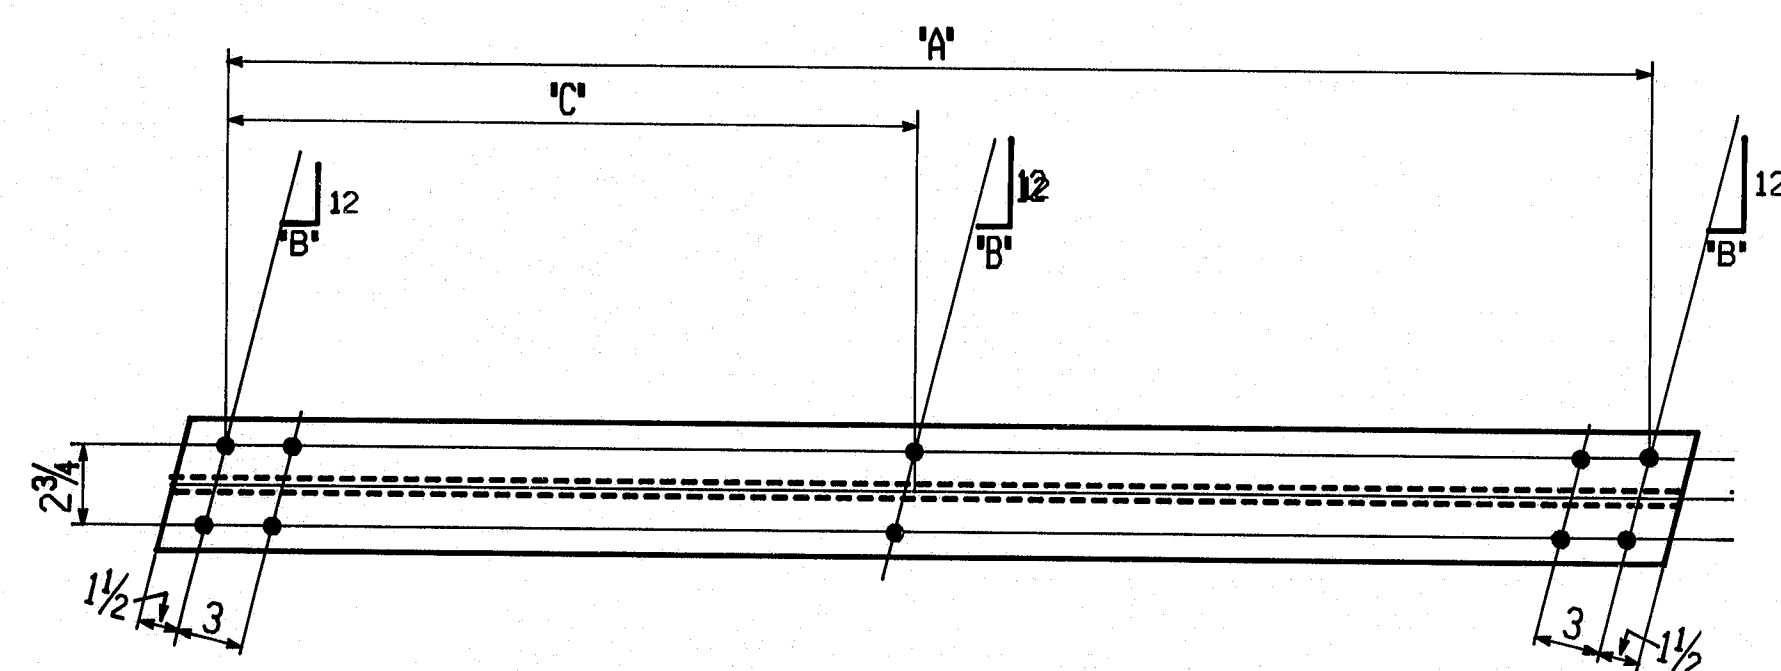

MARK	A	B	C
A1	18'-6 1/8"	2 1/8"	9'-3 1/2"
A2	18'-7 1/8"	2 1/8"	9'-3 3/8"
A3	18'-8 1/8"	2 1/8"	9'-4 1/8"
A4	18'-1 1/8"	2 1/8"	9'-0 1/8"
A5	18'-1 1/8"	2 1/8"	9'-0 1/8"
A6	18'-2 1/8"	2 1/8"	9'-1 1/8"
A7	18'-1 1/8"	2 1/8"	9'-0 1/8"
A8	18'-1 1/8"	2 1/8"	9'-0 1/8"
A9	18'-1 1/8"	2 1/8"	9'-1"
A10	17'-10 1/8"	2 1/8"	8'-11 1/8"
A11	17'-10 1/8"	2 1/8"	8'-11 1/8"
A12	17'-11 1/8"	2 1/8"	8'-11 1/8"
A13	17'-2 1/8"	2 1/8"	8'-7 1/8"
A14	17'-2 1/8"	2 1/8"	8'-7 1/8"
A15	17'-2 1/8"	2 1/8"	8'-7 1/4"
A16	16'-10 1/8"	2 1/8"	8'-5 1/8"
A17	16'-10 1/8"	2 1/8"	8'-5 1/8"
A18	16'-10 1/8"	2 1/8"	8'-5 1/8"
A19	16'-10"	2 1/8"	8'-5"
A20	16'-10 1/8"	2 1/8"	8'-5 1/8"
A21	16'-10 1/8"	2 1/8"	8'-5 1/8"
A22	16'-5 1/8"	2 1/8"	8'-2 1/8"
A23	16'-5 1/8"	2 1/8"	8'-2 1/2"
A24	16'-5"	2 1/8"	8'-2 1/2"
A25	16'-4 1/8"	2 1/8"	8'-2 1/2"

MARK	A	B	C
A26	16'-3 1/8"	2 1/8"	8'-1 1/8"
A27	16'-3 1/8"	2 1/8"	8'-1 1/8"
A28	16'-3 1/8"	2 1/8"	8'-1 1/8"
A29	16'-2 1/8"	2 1/8"	8'-1 1/8"
A30	16'-2 1/8"	2 1/8"	8'-1"
A31	16'-1 1/8"	2 1/8"	8'-0 1/8"
A32	16'-1 1/8"	2 1/8"	8'-0 1/8"
A33	15'-11 1/8"	2 1/8"	7'-11 1/8"
A34	15'-10 1/8"	2 1/8"	7'-11 1/2"
A35	15'-10 1/8"	2 1/8"	7'-11 1/8"
A36	15'-10 1/8"	2 1/8"	7'-11 1/8"
A37	15'-6 1/4"	2 1/8"	7'-9 1/8"
A38	15'-6 1/4"	2 1/8"	7'-9 1/8"
A39	15'-5 1/8"	2 1/8"	7'-8 1/8"
A40	15'-5 1/8"	2 1/8"	7'-8 1/2"
A41	15'-3"	3"	7'-7 1/2"
A42	15'-2 1/8"	3"	7'-7 1/8"
A43	15'-2 1/2"	3"	7'-7 1/4"
A44	15'-2 1/8"	3"	7'-7 1/8"
A45	14'-10 1/8"	3 1/8"	7'-5 1/8"
A46	14'-10 1/2"	3 1/8"	7'-5 1/4"
A47	14'-10 1/8"	3 1/8"	7'-5 1/8"
A48	14'-10 1/8"	3 1/8"	7'-5 1/8"
A49	17'-0 1/8"	2"	8'-6 1/8"
A50	17'-0 1/8"	2"	8'-6 1/8"

MARK	A	B	C
A51	17'-0 1/8"	2 1/8"	8'-6 1/8"
A52	16'-9 1/4"	2"	8'-4 1/8"
A53	16'-9 1/8"	2 1/8"	8'-4 1/8"
A54	16'-9 1/8"	2 1/8"	8'-4 1/8"
A55	16'-0 1/8"	2 1/8"	8'-0 1/8"
A56	16'-0 1/8"	2 1/8"	8'-0 1/8"
A57	16'-1"	2 1/8"	8'-0 1/2"
A58	16'-3 1/8"	2 1/8"	8'-1 1/8"
A59	16'-3 1/8"	2 1/8"	8'-1 1/8"
A60	15'-6 1/8"	2 1/8"	7'-9 1/8"
A61	15'-7 1/8"	2 1/8"	7'-9 1/8"
A62	15'-7 1/8"	2 1/8"	7'-9 1/8"
A63	15'-5 1/8"	2 1/8"	7'-8 1/8"
A64	15'-5 1/8"	2 1/8"	7'-8 1/8"
A65	16'-3 1/8"	2 1/8"	8'-1 1/8"
A66	16'-3 1/8"	2 1/8"	8'-1 1/8"
A67	15'-5 1/8"	2 1/8"	7'-8 1/8"
A68	15'-5 1/8"	2 1/8"	7'-8 1/8"

OPP.HAND

OPP.HAND

BILL OF MATERIAL						
NO.	MARK	DESCRIPTION	LENGTH	REMARKS	ITEM	WEIGHT
ONE	A37	WT4 x 9	15	10 1/8"	3	143
ONE	A38		15	10 1/2"		143
ONE	A39		15	10 3/8"		143
ONE	A40		15	10 1/8"		143
ONE	A41		15	7 1/8"		141
ONE	A42		15	7 1/8"		141
ONE	A43		15	6 1/8"		140
ONE	A44		15	6 1/8"		140
ONE	A45		15	3 1/8"		137
ONE	A46		15	2 1/8"		137
ONE	A47		15	2 3/4"		137
ONE	A48	WT4 x 9	15	2 1/8"	3	137
ONE	A49	WT5 x 11	17	4 1/8"	5	191
ONE	A50		17	4 1/8"		191
2	A51		17	4 1/8"		191
2	A52		17	1 1/4"		188
ONE	A53		17	1 1/8"		189
ONE	A54		17	1 1/8"		189
ONE	A55		16	4 1/8"		181
ONE	A56		16	5"		181
2	A57		16	5 1/8"		181
ONE	A58		16	7 1/8"		183
ONE	A59		16	7 1/4"		183
2	A60		15	11"		175
ONE	A61		15	11 1/4"		176
ONE	A62		15	11 1/8"		176
ONE	A63		15	9 1/8"		174
ONE	A64		15	9 1/8"		174
ONE	A65		16	7 1/8"		183
ONE	A66		16	7 1/4"		183
ONE	A67		15	9 1/8"		174
ONE	A68	WT5 x 11	15	10 1/8"	5	174

BILL OF MATERIAL						
NO.	MARK	DESCRIPTION	LENGTH	REMARKS	ITEM	WEIGHT
2	A1	WT4 x 9	18	11 1/4"	3	170
ONE	A2		18	11 1/4"		171
ONE	A3		19	8 1/8"		171
2	A4		18	5 1/8"		168
ONE	A5		18	5 1/8"		167
ONE	A6		18	6 1/8"		167
ONE	A7		18	5 1/2"		166
ONE	A8		18	5 1/2"		167
2	A9		18	6 1/8"		167
ONE	A10		18	2 1/8"		164
ONE	A11		18	3 1/8"		165
2	A12		18	3 1/8"		165
ONE	A13		17	6 1/2"		158
ONE	A14		17	6 1/8"		158
2	A15		17	6 1/8"		158
ONE	A16		17	2 1/8"		155
ONE	A17		17	3"		155
2	A18		17	3 1/8"		158
2	A19		17	2 1/8"		158
ONE	A20		17	2 1/8"		158
ONE	A21		17	2 1/8"		158
ONE	A22		16	9 1/8"		151
ONE	A23		16	9 1/8"		151
ONE	A24		16	9 1/4"		151
ONE	A25		16	9 1/8"		151
2	A26		16	7 1/8"		150
ONE	A27		16	7 1/8"		150
ONE	A28		16	8 1/8"		150
ONE	A29		16	6 1/8"		149
ONE	A30		16	6 1/4"		149
ONE	A31		16	6 1/8"		149
ONE	A32		16	5 1/8"		149
ONE	A33		16	3 1/8"		147
ONE	A34		16	3 1/4"		147
ONE	A35		16	3 1/8"		147
ONE	A36	WT4 x 9	16	3 1/8"	3	147


# SHOP NOTE

HOLES: 1/4" x 1/4"  
 BOLTS: NONE  
 PAINT: NONE  
 FOR GENERAL SHOP NOTES, SEE DWG. N1.

R95-119

CODE:5300

NO.	REVISION	DATE
HIGH STEEL STRUCTURES, INC. 100 Old Philadelphia Pike Lancaster, Pennsylvania 17603 Phone 717/299-0000 A Subsidiary of High Industries, Inc.		
CROSSFRAMES		
I-395 BRIDGE OVER PENOBSCOT RIVER		
I-395 BRIDGE STA. 16+460.00		
PENOBSCOT COUNTY		
STATE OF MAINE		
DEPARTMENT OF TRANSPORTATION		
STATE CONTRACT OR REF. NO.	6	CONTRACTOR CIANBRO CORP.
IN CHARGE HINKLE	MADE BY C.S.	CHK'D. BY G.F.F. DATE 7/6/84
CONTRACT NUMBER ME-84088-1	DRAWING NUMBER	3 OF 36

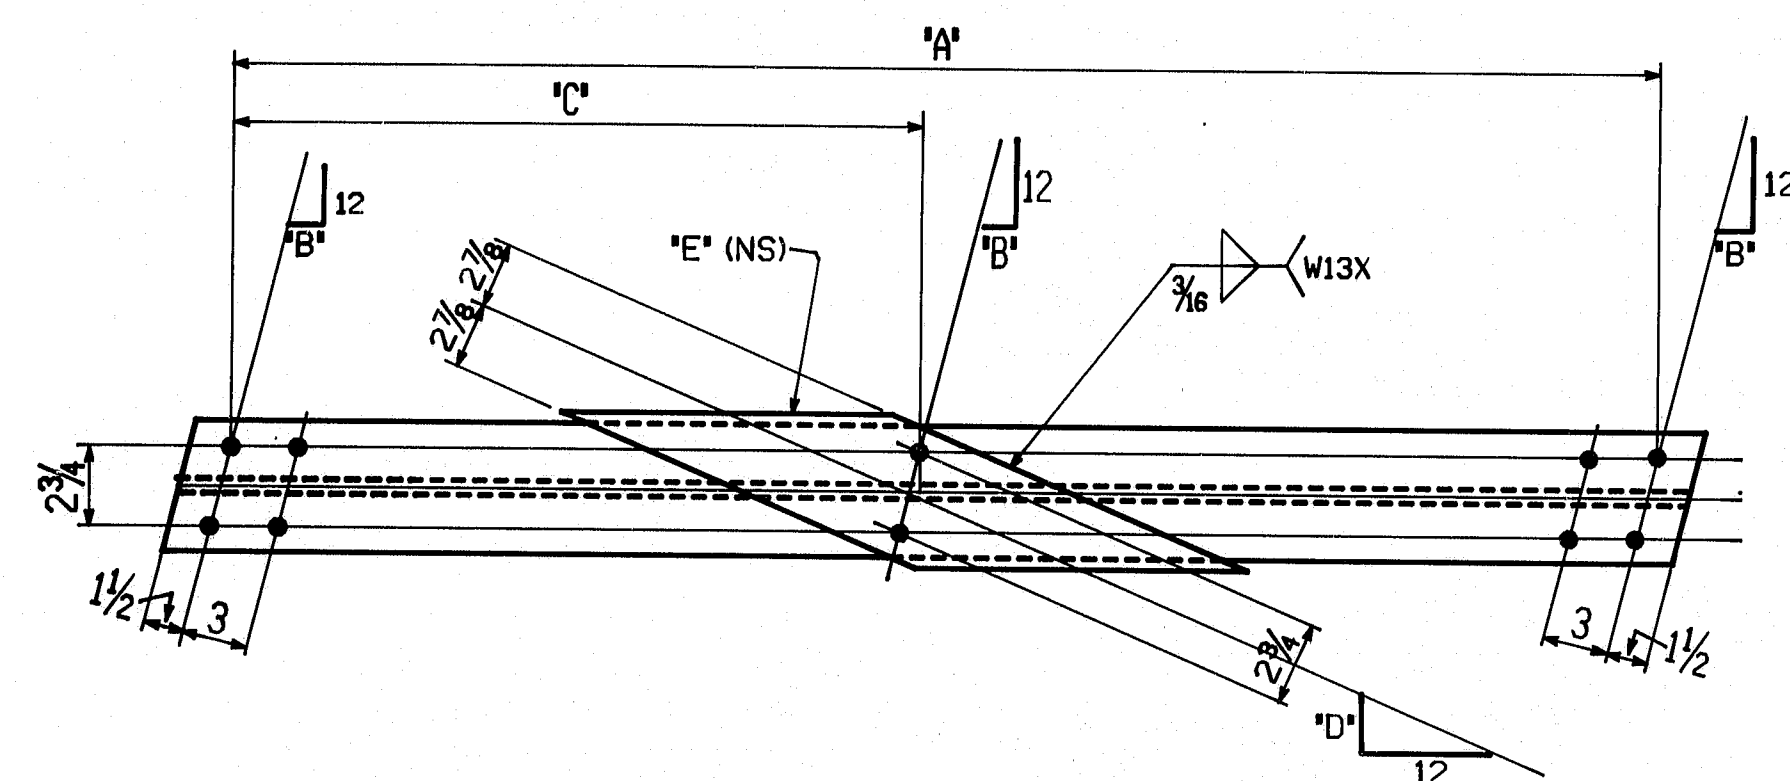

MS1	2'-0"
MS2	2'-1 1/2"
MS3	4'-7"
MS4	4'-11 1/2"

MARK	'A'	'B'	'C'	'D'	'E'
B1	18'-6 1/8"	2 1/8"	9'-3 1/2"	4 3/8"	mc
B2	18'-7 1/8"	2 1/8"	9'-3 3/8"	4 3/8"	md
B3	18'-8 1/8"	2 1/8"	9'-4 1/8"	5 1/8"	mf
B4	18'-1 1/8"	2 1/8"	9'-0 1/8"	4 1/8"	mg
B5	18'-1 1/8"	2 1/8"	9'-0 1/8"	4 1/8"	mh
B6	18'-2 1/8"	2 1/8"	9'-1 1/8"	5 1/8"	mk
B7	18'-1 1/8"	2 1/8"	9'-0 1/8"	4 1/8"	mh
B8	18'-1 1/8"	2 1/8"	9'-0 1/8"	5 1/8"	mm
B9	18'-1 1/8"	2 1/8"	9'-1"	5 1/8"	mf
B10	17'-10 3/4"	2 1/8"	8'-11 3/4"	5	mn
B11	17'-10 3/4"	2 1/8"	8'-11 1/2"	5 1/8"	mp
B12	17'-11 1/8"	2 1/8"	8'-11 1/8"	5 1/8"	mf
B13	17'-2 1/8"	2 1/8"	8'-7 1/8"	5 1/8"	mf
B14	17'-2 1/8"	2 1/8"	8'-7 1/8"	5 1/8"	ms
B15	17'-2 1/8"	2 1/8"	8'-7 1/4"	5 1/8"	mk
B16	16'-10 1/8"	2 1/8"	8'-5 1/8"	5 1/8"	mk
B17	16'-10 1/8"	2 1/8"	8'-5 3/8"	5 1/2"	mt
B18	16'-10 1/8"	2 1/8"	8'-5 1/8"	5 1/8"	mw
B19	16'-10"	2 1/8"	8'-5"	5 1/8"	ms
B20	16'-10 1/8"	2 1/8"	8'-5 1/8"	5 1/2"	mt
B21	16'-10 1/8"	2 1/8"	8'-5 1/8"	5 1/8"	my
B22	16'-5 1/8"	2 1/8"	8'-2 1/8"	5 1/8"	maa
B23	16'-5 1/8"	2 1/8"	8'-2 1/2"	5 1/8"	maa
B24	16'-5"	2 1/8"	8'-2 1/2"	5 1/8"	maa
B25	16'-4 1/8"	2 1/8"	8'-2 1/2"	5 1/8"	maa

MARK	'A'	'B'	'C'	'D'	'E'
B26	16'-3 3/8"	2 1/8"	8'-1 1/8"	5 1/8"	maa
B27	16'-3 3/8"	2 1/8"	8'-1 1/8"	5 1/8"	my
B28	16'-3 3/8"	2 1/8"	8'-1 1/8"	6	mab
B29	16'-2 1/8"	2 1/8"	8'-1 1/8"	5 1/8"	my
B30	16'-2"	2 1/8"	8'-1"	5 1/8"	my
B31	16'-1 1/8"	2 1/8"	8'-0 1/8"	5 1/8"	my
B32	16'-1 1/8"	2 1/8"	8'-0 1/8"	5 1/8"	my
B33	15'-11 1/8"	2 1/8"	7'-11 1/8"	5 1/8"	mac
B34	15'-10 1/8"	2 1/8"	7'-11 1/2"	5 1/8"	mac
B35	15'-10 1/8"	2 1/8"	7'-11 1/8"	5 1/8"	mac
B36	15'-10 1/8"	2 1/8"	7'-11 1/8"	5 1/8"	mac
B37	15'-6 1/4"	2 1/8"	7'-9 1/8"	6 1/4"	mad
B38	15'-6 1/4"	2 1/8"	7'-9 1/8"	6 1/8"	maf
B39	15'-5 1/8"	2 1/8"	7'-8 1/8"	6 1/8"	maf
B40	15'-5 1/8"	2 1/8"	7'-8 1/8"	6 1/8"	maf
B41	15'-3"	3	7'-7 1/2"	6 1/8"	mag
B42	15'-2 1/8"	3	7'-7 3/8"	6 1/8"	mah
B43	15'-2 1/8"	3	7'-7 1/4"	6 1/8"	mah
B44	15'-2 1/8"	3	7'-7 1/8"	6 1/8"	mak
B45	14'-10 1/8"	3 1/8"	7'-5 1/8"	6 1/8"	mam
B46	14'-10 1/8"	3 1/8"	7'-5 1/4"	6 1/8"	mam
B47	14'-10 1/8"	3 1/8"	7'-5 1/8"	6 1/8"	man
B48	14'-10 1/8"	3 1/8"	7'-5 1/8"	6 1/8"	man

BILL OF MATERIAL						
NO.	MARK	DESCRIPTION	LENGTH	REMARKS	ITEM	WEIGHT
ONE	B46	WT4 x 9	15	2 1/8"	3/19	153
ONE	B47	WT4 x 9	15	2 1/8"	3/19	153
ONE	B48	WT4 x 9	15	2 1/8"	3/19	153
1	mc	BAR 5/8 x 7/8	2	7 1/4"	5/6	
1	md		2	6 1/4"		
4	mf		2	3 1/4"	B3,B9,B12,B13	
1	mg		2	5 1/8"	B4	
2	mh		2	5 1/8"	B5,B7	
3	mk		2	2 1/8"	B6,B15,B16	
1	mm		2	4 1/8"	B8	
1	mn		2	4 1/8"	B10	
1	mp		2	4 1/8"	B11	
2	ms		2	3	B14,B19	
2	mt		2	2 1/4"	B17,B20	
1	mw		2	2	B18	
6	my		2	1 1/4"	B21,B27,B29,B30,B31,B32	
5	maa		2	1 1/2"	B22,B23,B24,B25,B26	
1	mab		2	0 1/8"	B28	
4	mac		2	0 1/8"	B33,B34,B35,B36	
1	mad		1	1 1/8"	B37	
3	maf		1	1 1/8"	B38,B39,B40	
1	mag		1	1 1/8"	B41	
2	mah		1	1 1/4"	B42,B43	
1	mak		1	11	B44	
2	mam		1	10 1/4"	B45,B46	
2	man	BAR 5/8 x 7/8	1	10 1/2"	B47,B48	5/6
2	MS1	L3 x 3 x 3/4	2	0	5/14	15
ONE	MS2	L3 x 3 x 3/4	2	1 1/2"	5/14	16
3	MS3	L3 x 3 x 3/4	4	7	5/14	33
3	MS4	L3 x 3 x 3/4	4	11 1/2"	5/14	36

BILL OF MATERIAL						
NO.	MARK	DESCRIPTION	LENGTH	REMARKS	ITEM	WEIGHT
2	B1	WT4 x 9	18	11	3/19	193
ONE	B2		18	11 1/4"		192
ONE	B3		19	0 1/8"		191
2	B4		18	5 1/8"		188
ONE	B5		18	5 1/8"		188
ONE	B6		18	6 1/8"		187
ONE	B7		18	5 1/2"		187
ONE	B8		18	5 1/8"		187
2	B9		18	6 1/8"		186
ONE	B10		18	2 1/8"		185
ONE	B11		18	3 1/8"		185
2	B12		18	3 1/8"		184
ONE	B13		17	6 1/2"		178
ONE	B14		17	6 1/8"		178
2	B15		17	6 1/8"		177
ONE	B16		17	2 1/8"		175
ONE	B17		17	3		174
2	B18		17	3 1/8"		174
2	B19		17	2 1/8"		174
ONE	B20		17	2 1/8"		174
ONE	B21		17	2 1/8"		173
ONE	B22		16	9 1/8"		170
ONE	B23		16	9 1/8"		170
ONE	B24		16	9 1/4"		170
ONE	B25		16	9 1/8"		170
2	B26		16	7 1/8"		168
ONE	B27		16	7 1/8"		168
ONE	B28		16	8 1/8"		168
ONE	B29		16	6 1/8"		167
ONE	B30		16	6 1/4"		167
ONE	B31		16	6 1/8"		167
ONE	B32		16	5 1/8"		167
ONE	B33		16	3 1/8"		164
ONE	B34		16	3 1/4"		164
ONE	B35		16	3 1/8"		164
ONE	B36		16	3 1/8"		164
ONE	B37		15	10 1/8"		160
ONE	B38		15	10 1/2"		160
ONE	B39		15	10 1/8"		160
ONE	B40		15	10 1/8"		160
ONE	B41		15	7 1/8"		157
ONE	B42		15	7 1/8"		157
ONE	B43		15	6 1/8"		157
ONE	B44		15	6 1/8"		157
ONE	B45	WT4 x 9	15	3 1/8"	3/19	153

# SHOP NOTE

HOLES: 5/8" x 1/2"

BOLTS: NONE

PAINT: NONE



FOR GENERAL SHOP NOTES, SEE DWG. N1.

R95-120

CODE:5300


NO.	REVISION	DATE
<p>1005 Old Philadelphia Pike Lancaster, Pennsylvania 17603 Phone 717/299-2800</p> <p><b>HIGH STEEL STRUCTURES, INC.</b></p> <p>A Subsidiary of HSB Industries, Inc.</p>		
CROSSFRAMES & SCUPPER ANGLES		
I-395 BRIDGE OVER PENOBSCOT RIVER		
I-395 BRIDGE STA. 164+60.00		
PENOBSCOT COUNTY		
STATE OF MAINE		
DEPARTMENT OF TRANSPORTATION		
STATE CONTRACT OR REFNO.	6	CONTRACTOR CIANBRO CORP.
IN CHARGE: HINKLE	MADE BY: C.S.	CHECKED BY: G.F.Z. DATE: 7/6/84
CONTRACT NUMBER: ME-84088-1	DRAWING NUMBER:	4 OF 36



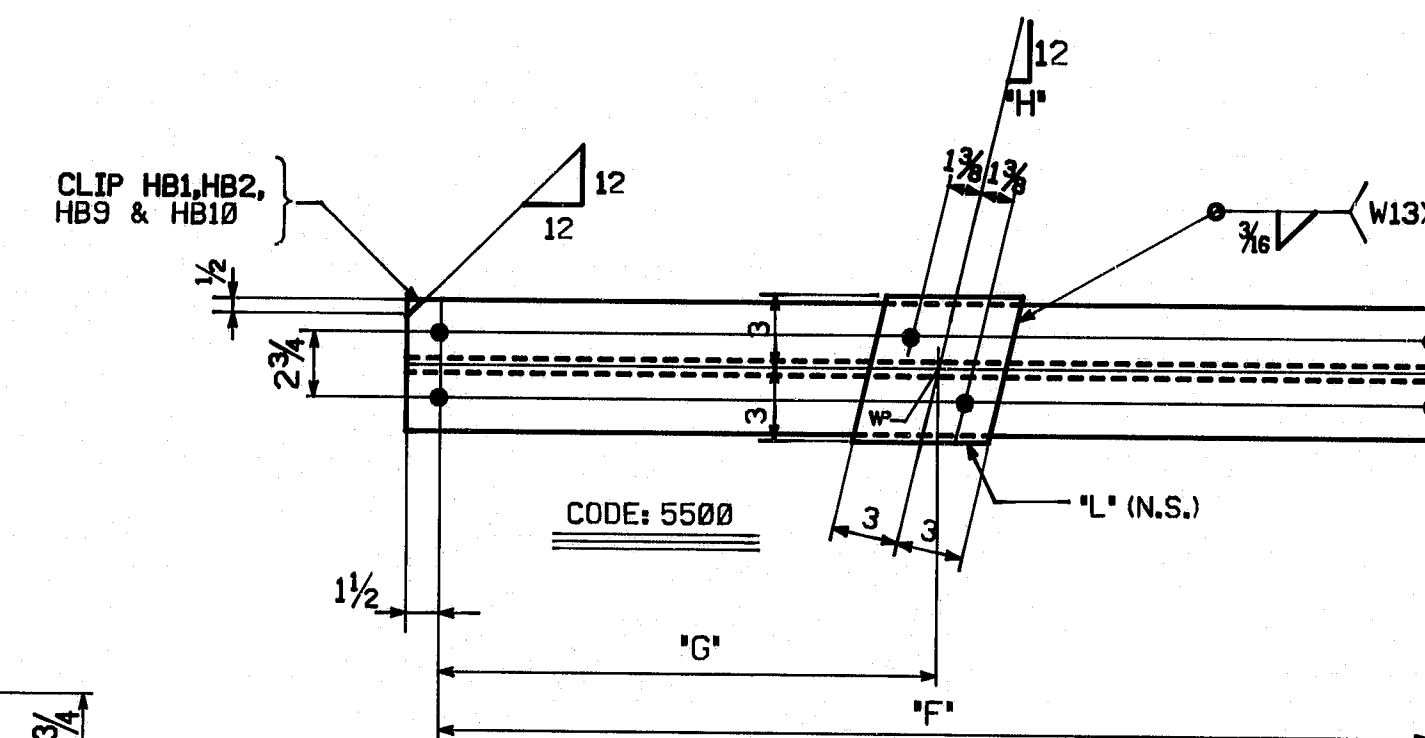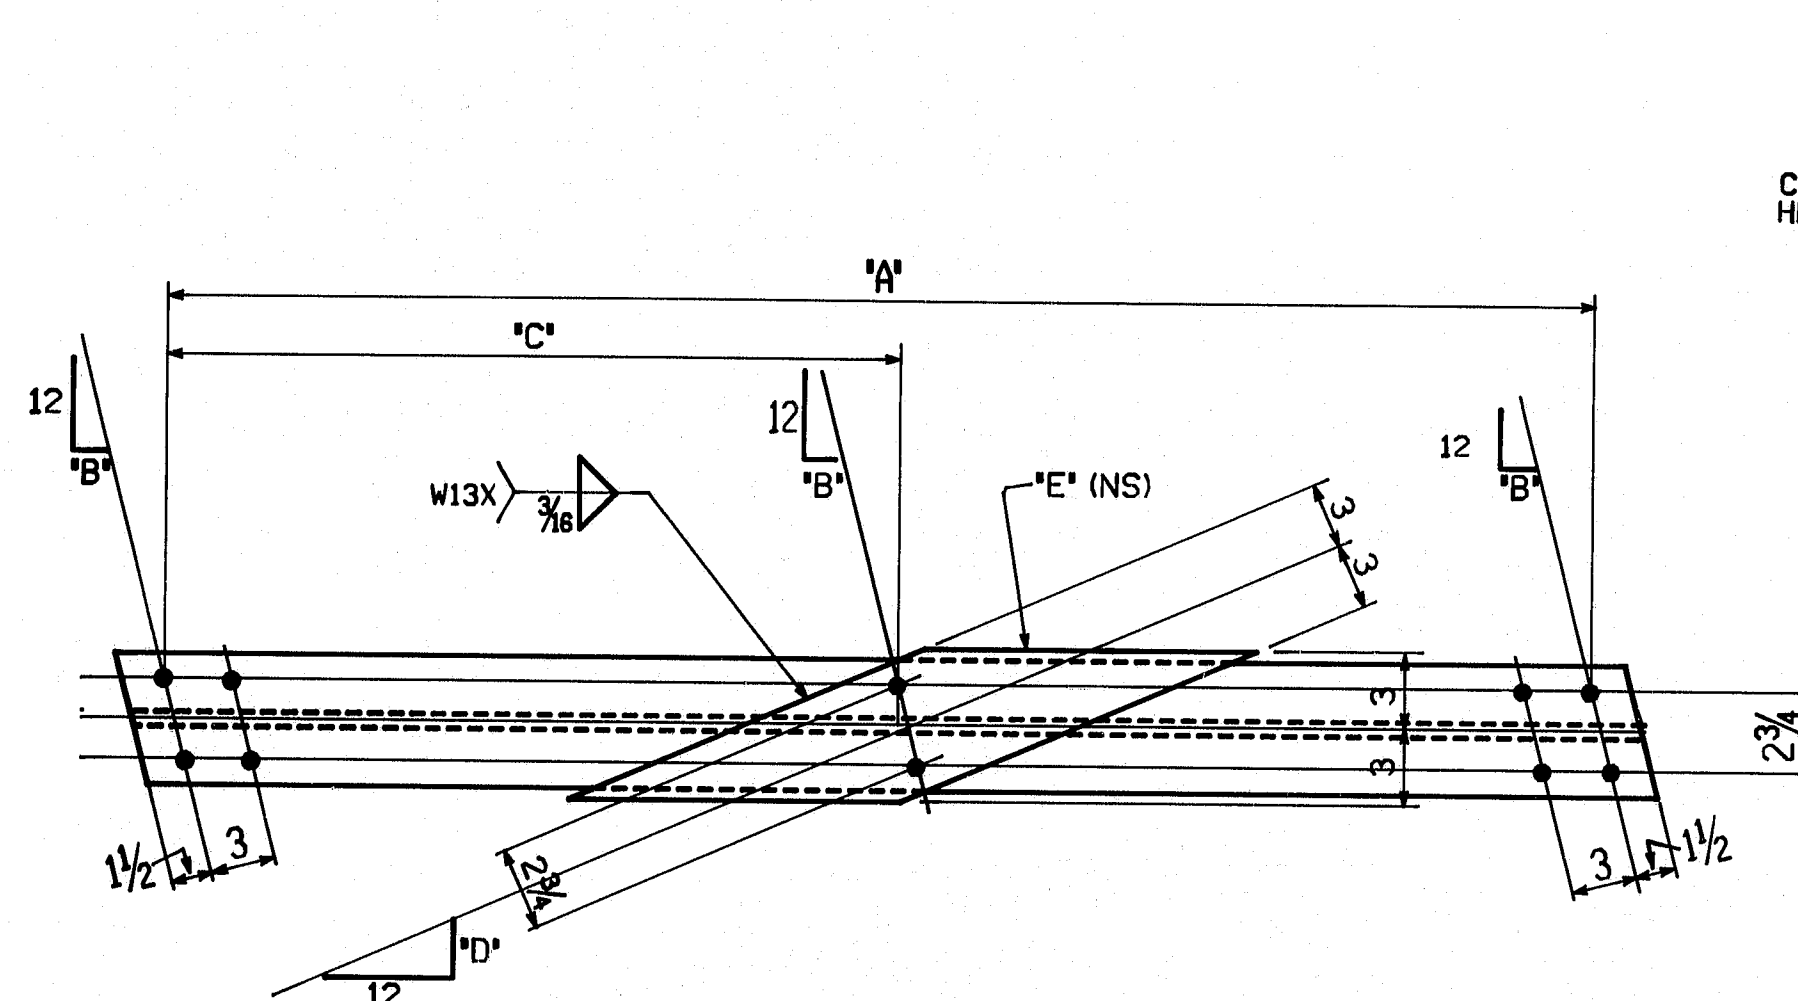

MARK	"F"	"G"	"H"	"L"
HB1	22'-0 1/4"	10'-8 1/8"	1/4"	---
HB2	21'-3 3/8"	10'-4"	1/4"	mbm
HB3	20'-3"	9'-11 1/4"	2 3/8"	---
HB4	19'-4 3/8"	9'-4 1/8"	2 3/8"	mbn
HB5	19'-11 1/4"	9'-0 5/8"	2"	---
HB6	18'-11 1/8"	9'-1 1/8"	2"	mbp
HB9	21'-4 3/8"	10'-4 1/2"	1/4"	---
HB10	21'-11 1/4"	10'-7 7/8"	1/4"	mbm
HB11	19'-7 7/8"	9'-7 7/8"	2 3/8"	---
HB12	19'-11"	9'-8 1/8"	2 3/8"	mbn

MARK	"F"	"G"	"H"	"L"
HB13	19'-3 3/8"	9'-5 1/8"	2"	---
HB14	19'-7 3/8"	9'-8 1/8"	2"	mbp
HB19	19'-5 3/8"	9'-6 1/8"	2 3/8"	---
HB20	20'-1 1/8"	9'-8 3/8"	2 3/8"	mbn
HB21	19'-2 1/8"	9'-4 3/8"	2 3/8"	---
HB22	19'-11"	9'-7 1/8"	2 3/8"	mbt
HB27	19'-1 3/8"	9'-4 1/8"	2 3/8"	---
HB28	20'-6"	9'-10 3/8"	2 3/8"	mbn
HB29	18'-10 1/4"	9'-2"	2 3/8"	---
HB30	20'-3 3/8"	9'-9 3/8"	2 3/8"	mbt

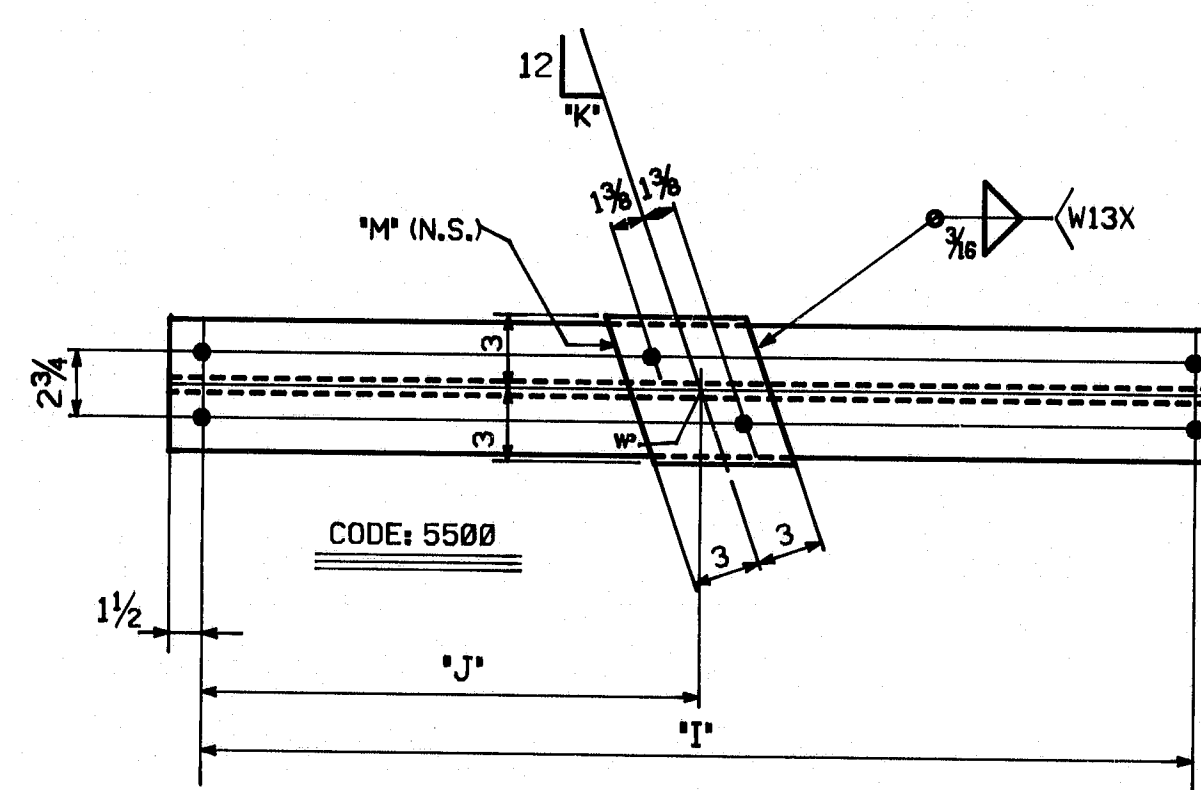

MARK	"I"	"J"	"K"	"M"
HB7	25'-0"	13'-0 1/8"	3 3/8"	---
HB8	24'-0"	12'-6 1/8"	3 3/8"	mbw
HB15	24'-2 3/8"	12'-7 7/8"	3 3/8"	---
HB16	24'-8 1/8"	12'-9 1/8"	3 3/8"	mbw
HB17	25'-5 1/8"	12'-4 1/8"	3 3/8"	---
HB18	26'-6"	12'-10 3/8"	3 3/8"	mbw

MARK	"I"	"J"	"K"	"M"
HB23	24'-10 1/8"	12'-10 3/8"	3 1/2"	---
HB24	25'-8 1/8"	13'-2 1/2"	3 1/2"	mca
HB25	25'-0 3/8"	12'-1 3/8"	3 3/8"	---
HB26	26'-11 1/8"	13'-0 3/8"	3 3/8"	mbw
HB31	24'-4 1/8"	12'-7 1/2"	3 3/8"	---
HB32	26'-1 1/8"	13'-5 3/8"	3 3/8"	mcb

MARK	"A"	"B"	"C"	"D"	"E"
B49	17'-0 3/8"	2"	8'-6 3/8"	4 1/8"	map
B50	17'-0 3/8"	2"	8'-6 3/8"	4 1/8"	mas
B51	17'-0 3/8"	2 1/8"	8'-6 3/8"	4 1/8"	mat
B52	16'-9 1/4"	2"	8'-4 1/8"	4 1/8"	map
B53	16'-9 1/8"	2 1/8"	8'-4 1/8"	4 1/8"	mas
B54	16'-9 1/8"	2 3/8"	8'-4 1/8"	4 1/8"	maw
B55	16'-0 3/8"	2 1/8"	8'-0 7/8"	4 1/8"	mbf
B56	16'-0 3/8"	2 3/8"	8'-0 7/8"	4 1/8"	mbg
B57	16'-1"	2 3/8"	8'-0 1/2"	4 1/8"	mbg
B58	16'-3 1/8"	2 1/8"	8'-1 1/8"	4 1/8"	may
B59	16'-3 1/8"	2 3/8"	8'-1 1/8"	4 1/8"	mba
B60	15'-6 1/8"	2 1/8"	7'-9 1/8"	4 1/8"	mbf
B61	15'-7 1/4"	2 3/8"	7'-9 1/8"	4 1/2"	mbh
B62	15'-7 1/8"	2 3/8"	7'-9 1/8"	4 1/2"	mbk
B63	15'-5 1/8"	2 1/4"	7'-8 3/8"	4 1/2"	mbb
B64	15'-5 1/8"	2 3/8"	7'-8 3/8"	4 1/2"	mbc
B65	16'-3 1/8"	2 1/8"	8'-1 1/8"	4 1/2"	may
B66	16'-3 1/8"	2 3/8"	8'-1 1/8"	4 1/2"	mba
B67	15'-5 1/8"	2 1/4"	7'-8 3/8"	4 1/2"	mbb
B68	15'-5 1/8"	2 3/8"	7'-8 3/8"	4 1/2"	mbd


BILL OF MATERIAL									
NO.	MARK	DESCRIPTION	LENGTH	REMARKS	ITEM	QTY	UNIT	PRICE	TOTAL
4	E1	WT7 x 21.5	17	0 3/8"		4	26	368	
4	E2	WT7 x 21.5	16	9 3/8"		4	25	362	
4	E3	WT7 x 21.5	16	3 1/4"		4	19	350	
4	E4	WT7 x 21.5	16	1"		4	16	346	
4	E5	WT7 x 21.5	15	7 1/2"		4	3	336	
4	E6	WT7 x 21.5	15	5 1/2"		4	2	171	
ONE	HB1	WT5 x 11	22	3 1/4"		1	13	245	
ONE	HB2		21	6 3/8"		1	16	242	
ONE	HB3		20	6"		1	19	226	
ONE	HB4		19	7 1/8"		1	27	222	
ONE	HB5		20	2 1/4"		1	22	223	
ONE	HB6		19	2 3/8"		1	31	213	
ONE	HB9		21	7 1/8"		1	15	238	
ONE	HB10		22	2 1/4"		1	14	250	
ONE	HB11		19	10 3/8"		1	25	219	
ONE	HB12		20	2 3/8"		1	21	229	
ONE	HB13		19	6 3/8"		1	28	215	
ONE	HB14		19	10 3/8"		1	24	225	
ONE	HB19		19	8 3/8"		1	26	218	
ONE	HB20		20	4 3/8"		1	20	231	
ONE	HB21		19	5 3/8"		1	29	215	
ONE	HB22		20	2"		1	23	229	
ONE	HB27		19	4 3/8"		1	30	213	
ONE	HB28		20	9"		1	17	235	
ONE	HB29		19	1 1/4"		1	32	211	
ONE	HB30		20	6 3/8"		1	18	233	
ONE	HB7		25	3"		1	7	278	
ONE	HB8		24	3 3/8"		1	12	275	
ONE	HB15		24	5 3/8"		1	11	270	
ONE	HB16		24	11 3/8"		1	9	282	
ONE	HB17		25	8 3/8"		1	5	284	
ONE	HB18		26	9 3/8"		1	2	302	
ONE	HB23		25	1 1/8"		1	8	276	
ONE	HB24		25	11 3/8"		1	4	293	
ONE	HB25		25	3 3/8"		1	6	278	
ONE	HB26		27	2 3/8"		1	7	307	
ONE	HB31		24	7 3/8"		1	10	271	
ONE	HB32	WT5 x 11	26	4 3/8"		1	3	298	
2	mbm	BAR 6 x 1/2	0	6 1/8"	HB2,HB10	5	7		
2	mbn		0	7 3/8"	HB4,HB12				
2	mbp		0	7 1/8"	HB6,HB14				
2	mbn		0	7 1/8"	HB20,HB28				
2	mbt		0	7 3/8"	HB22,HB30				
2	mbw		0	8 3/8"	HB8,HB16				
2	mbw		0	7 3/8"	HB18,HB26				
1	mca		0	8"	HB24				
1	mcb	BAR 6 x 1/2	0	8 3/8"	HB32	5	7		

BILL OF MATERIAL									
NO.	MARK	DESCRIPTION	LENGTH	REMARKS	ITEM	QTY	UNIT	PRICE	TOTAL
ONE	B49	WT5 x 11	17	4 3/8"		5	4	223	
ONE	B50		17	4 3/8"				222	
2	B51		17	4 3/8"				222	
2	B52		17	1 1/4"				220	
ONE	B53		17	1 1/8"				219	
ONE	B54		17	1 1/8"				217	
ONE	B55		16	4 3/8"				262	
ONE	B56		16	5"				261	
2	B57		16	5 1/8"				261	
ONE	B58		16	7 1/8"				212	
ONE	B59		16	7 1/4"				212	
2	B60		15	11"				256	
ONE	B61		15	11 1/4"				253	
ONE	B62		15	11 3/8"				249	
ONE	B63		15	9 3/8"				202	
ONE	B64		15	9 3/8"				201	
ONE	B65		16	7 3/8"	OPP.HAND			212	
ONE	B66		16	7 1/4"	OPP.HAND			212	
ONE	B67		15	9 3/8"	OPP.HAND			212	
ONE	B68	WT5 x 11	15	10 1/8"	OPP.HAND	5	4	201	
2	map	BAR 6 x 1/2	3	0 1/2"	B49,B52	5	7		
2	mas		2	11 1/2"	B50,B53				
2	mat		2	11"	B51				
1	maw		2	8 3/8"	B54				
2	may		2	10"	B58,B55				
2	mba		2	9 3/8"	B59,B66				
2	mbb		2	8 3/8"	B63,B67				
1	mbc		2	7 3/8"	B64				
1	mbd	BAR 6 x 1/2	2	6 3/8"	B68	5	7		
3	mbf	BAR 6 x 1 1/8"	2	10 1/2"	B55,B60	5	8		
3	mbg	BAR 6 x 1 1/8"	2	10"	B56,B57	5	8		
1	mbh	BAR 6 x 1 1/8"	2	9 3/8"	B61	5	8		
1	mbk	BAR 6 x 1 1/8"	2	7 3/8"	B62	5	8		

SHOP NOTE  
HOLES: 3/8" x 3/8"  
BOLTS: NONE  
PAINT: NONE  
FOR GENERAL SHOP NOTES, SEE DWG. N1.


R95-121

NO.	REVISION	DATE
CROSSFRAMES & HORIZ. BRACING		
I-395 BRIDGE OVER PENOBSCOT RIVER		
I-395 BRIDGE STA. 164+68.00		
PENOBSCOT COUNTY		
STATE OF MAINE		
DEPARTMENT OF TRANSPORTATION		
STATE CONTRACT OR REF. NO.	6	CONTRACTOR CIAMBO CORP.
IN CHARGE HINKLE	MADE BY C.S.	CHECKED BY G.E. DATE 7/4/94
CONTRACT NUMBER ME-84088-1	DRAWING NUMBER 5 OF 36	

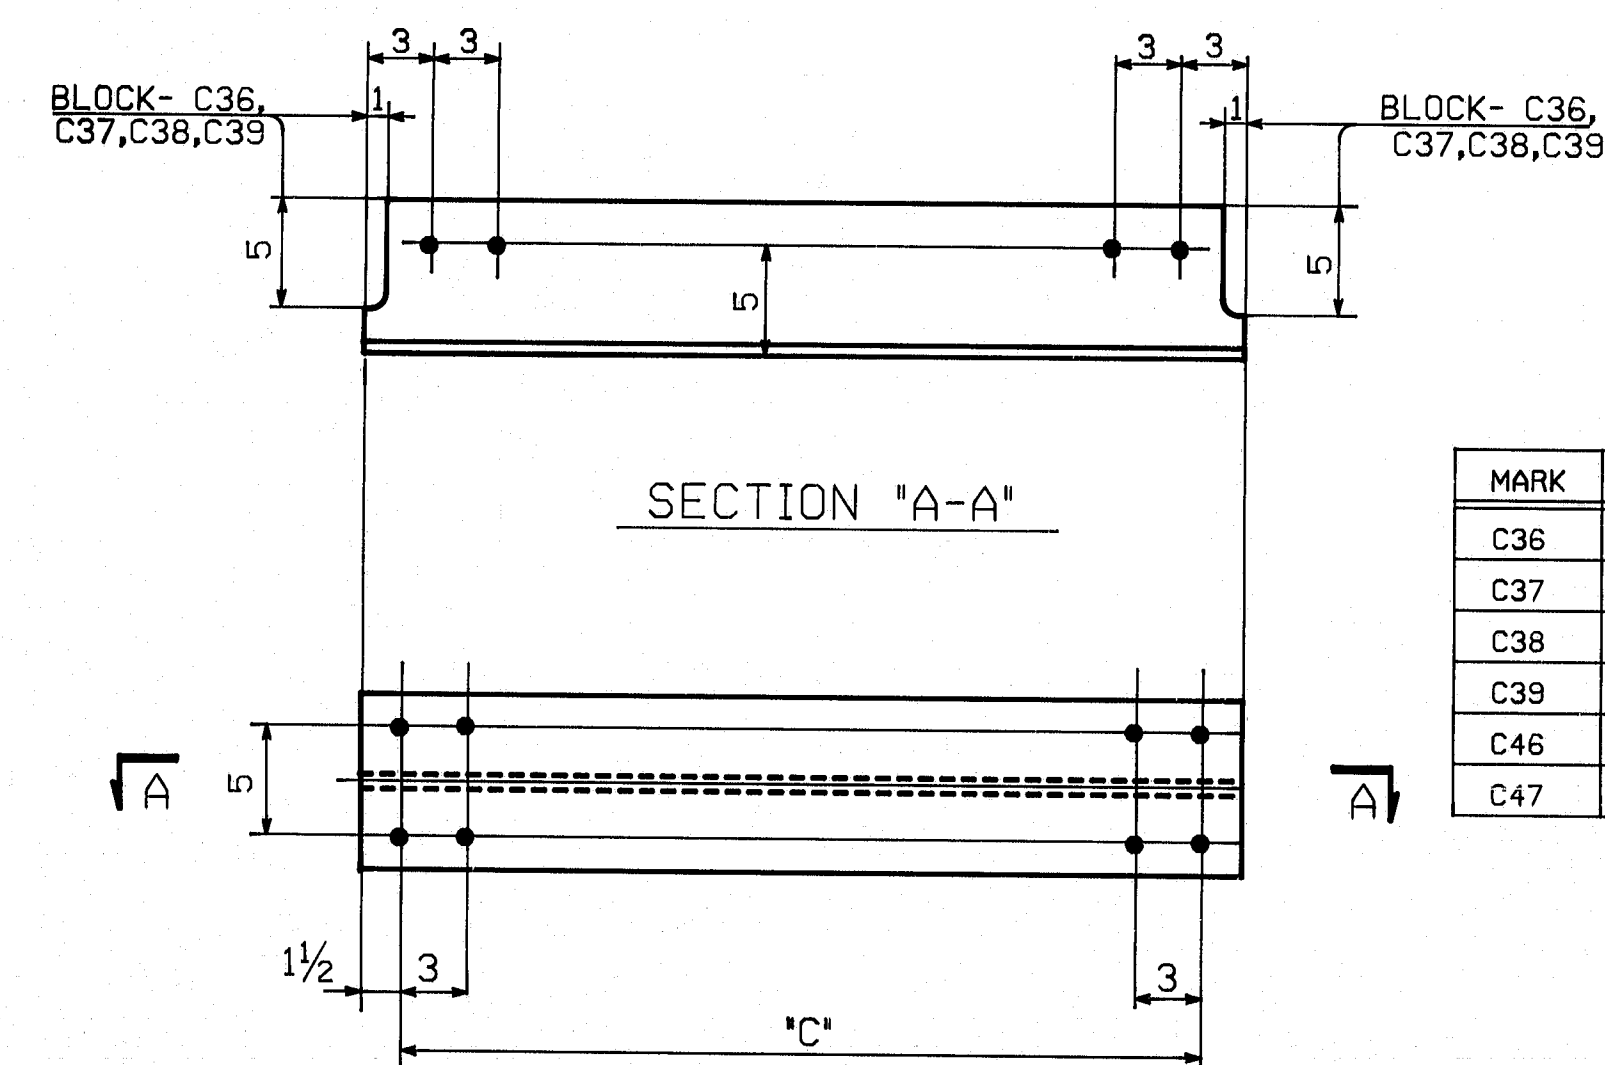

MARK	"A"
C1	18°-3/4"
C2	17°-9/16"
C3	17°-9/16"
C4	17°-6/16"
C5	16°-9/16"
C6	16°-6/16"
C7	16°-6/16"
C8	16°-5/16"
C9	16°-2/16"
C10	16°-2/16"
C11	16°-2/16"
C12	16°-2/16"
C13	15°-10/16"
C14	15°-10"
C15	15°-9/16"
C16	15°-9/16"
C17	15°-8/16"
C18	15°-8/16"
C19	15°-6/16"
C20	15°-5/16"
C21	15°-5/16"
C22	15°-5/16"
C23	15°-4/16"
C24	15°-2/16"
C25	15°-2/16"
C26	15°-2/16"
C27	15°-1/16"
C28	14°-9/16"
C29	14°-9/16"
C30	14°-9/16"
C31	14°-8/16"
C32	14°-5"
C33	14°-4/16"
C34	14°-4/16"
C35	14°-4/16"

MARK	'C'
C36	16'-9 $\frac{7}{8}$ "
C37	16'-6 $\frac{1}{8}$ "
C38	16'-5 $\frac{3}{16}$ "
C39	15'-10 $\frac{11}{16}$ "
C46	15'-10"
C47	15'-4 $\frac{1}{8}$ "

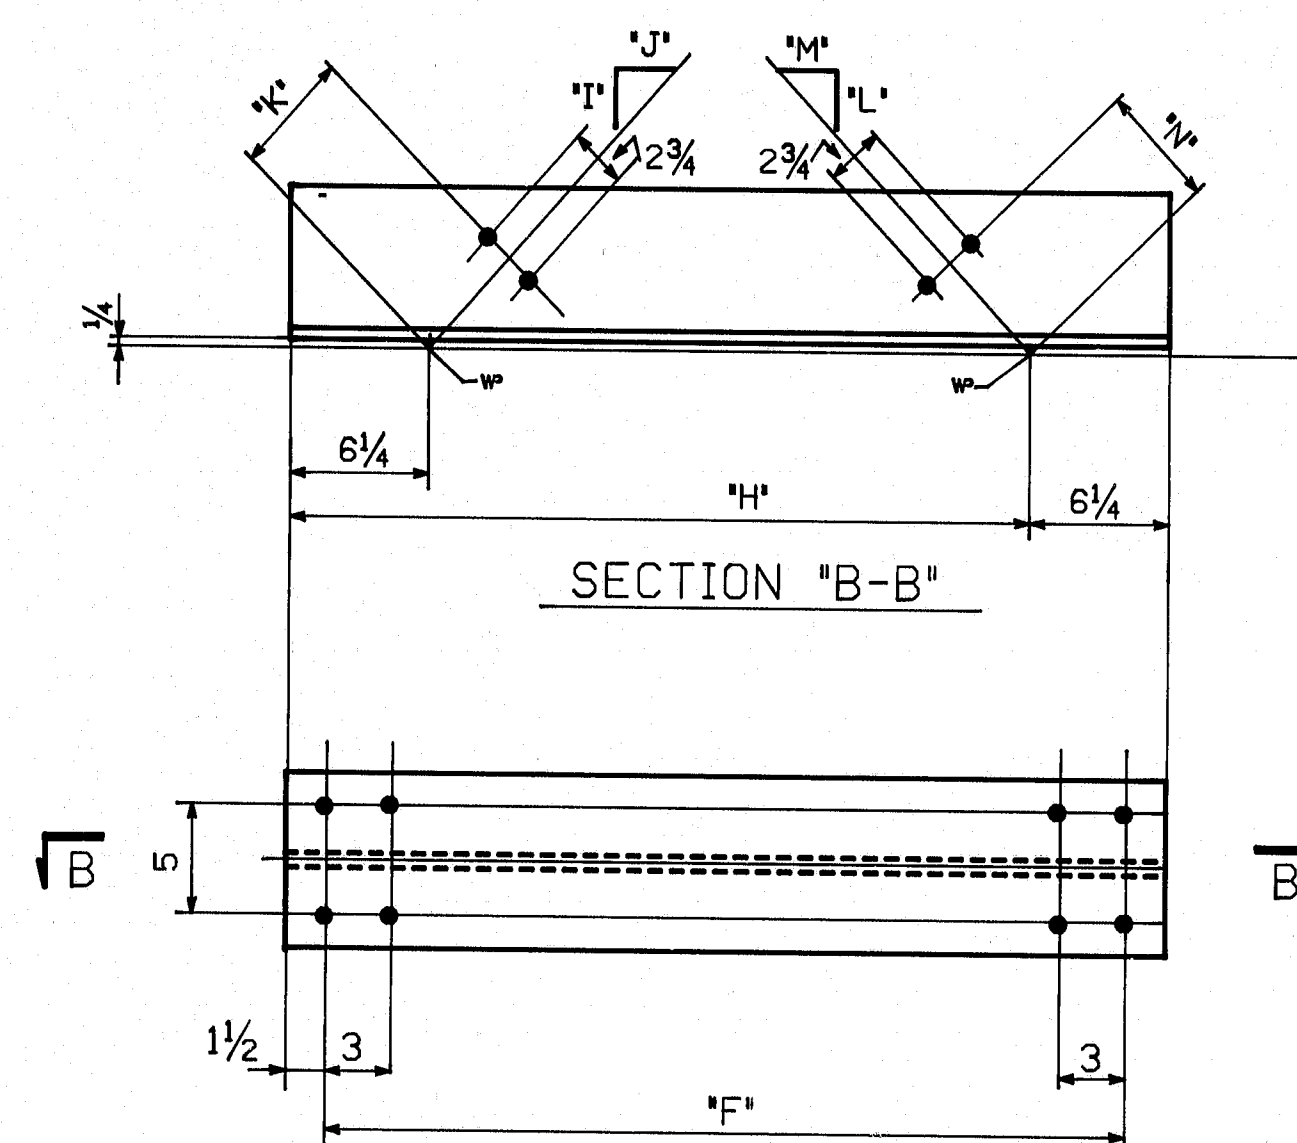

MARK	"F"	"H"	"I"	"J"	"K"	"L"	"M"	"N"
C40	16'-9%	16'-6%	12	8%	5½	12	9%	5% <sub>16</sub>
C41	16'-9%	16'-6%	12	8%	5½	12	10½	5%
C42	16'-6%	16'-3%	12	11%	6%	11½	12	6%
C43	16'-6%	16'-3%	11½	12	6%	12	11½	6½
C44	16'-0%	15'-0%	12	8½	5½	12	9%	5%
C45	16'-0%	15'-0%	12	8½	5½	12	9%	5%
C48	15'-2½	14'-11¼	12	8½	5½	12	9%	5%
C49	15'-2½	14'-11¼	12	9½	5%	12	8%	5½

BILL OF MATERIAL						
NO.	NAME	DESCRIPTION	LENGTH	REMARKS	ITEM	WE
2	C36	WT7 x 21.5	17	0%	$4 \frac{1}{2}$	36
2	C37		16	9%	$4 \frac{1}{2}$	37
2	C38		16	8%	$4 \frac{1}{2}$	38
2	C39		16	1%	$4 \frac{1}{2}$	39
2	C46	↓	16	1	$4 \frac{1}{2}$	36
2	C47	WT7 x 21.5	15	7%	$4 \frac{1}{2}$	37
ONE	C40	WT7 x 21.5	17	0%	$4 \frac{1}{2}$	36
ONE	C41		17	0%	$4 \frac{1}{2}$	36
ONE	C42		16	9%	$4 \frac{1}{2}$	35
ONE	C43		16	9%	$4 \frac{1}{2}$	35
ONE	C44		16	3%	$4 \frac{1}{2}$	35
ONE	C45		16	3%	$4 \frac{1}{2}$	35
ONE	C48	↓	15	5%	$4 \frac{1}{2}$	33
ONE	C49	WT7 x 21.5	15	5%	$4 \frac{1}{2}$	33

BILL OF MATERIAL							
QTY	NO.	MARK	DESCRIPTION	LENGTH	REMARKS	ITEM	UNIT PRICE
1	4	C1	WT7 x 21.5	18	6¼	51	399
2	4	C2		18	0⅞	32	389
3	4	C3		18	0¼	31	388
4	4	C4		17	9⅞	30	383
5	4	C5		17	0⅞	26	361
6	2	C6		16	9⅞	25	362
7	2	C7		16	9⅞	24	361
8	2	C8		16	8⅞	23	360
9	ONE	C9		16	3⅞	20	351
10	ONE	C10		16	3¼	19	350
11	ONE	C11		16	3⅞	19	350
12	3	C12		16	3⅞	18	350
13	2	C13		16	1⅞	17	347
14	2	C14		16	1	16	346
15	ONE	C15		16	0¼	11	345
16	ONE	C16		16	0⅞	10	345
17	ONE	C17		15	11⅞	9	344
18	ONE	C18		15	11⅞	8	344
19	ONE	C19		15	9⅞	7	339
20	ONE	C20		15	8⅞	6	339
21	ONE	C21		15	8⅞	5	339
22	ONE	C22		15	8⅞	4	339
23	2	C23		15	7⅞	4	336
24	2	C24		15	5½	2	333
25	2	C25		15	3⅞	1	330
26	ONE	C26		15	3⅞	32	329
27	ONE	C27		15	3½	31	329
28	ONE	C28		15	0⅞	30	324
29	ONE	C29		15	0⅞	29	323
30	ONE	C30		15	0⅞	28	323
31	ONE	C31		14	11¾	27	322
32	ONE	C32		14	8	26	316
33	ONE	C33		14	7⅞	25	316
34	ONE	C34		14	7⅞	24	315
35	ONE	C35	WT7 x 21.5	14	7⅞	23	315

## SHOP NOTE

**HOLES:** 5/8" Ø


**BOLTS:** NONE

**PAINT:** NONE

FOR GENERAL SHOP NOTES, SEE DWG. N1.



R95-122

CODE: 5300




NO.	REVISION	DATE	
HIGH STEEL STRUCTURES, INC.		 1908 Old Philadelphia Pike Limerick, Pennsylvania 17043 Phone 717/229-3381 A Subsidiary of High Industries, Inc.	
CROSSFRAMES			
I-395 BRIDGE OVER PENOBSCOT RIVER			
I-395 BRIDGE STA. 16+460.00			
PENOBSCOT COUNTY			
STATE OF MAINE			
DEPARTMENT OF TRANSPORTATION			
STATE CONTRACT OR REF. NO.		CONTRACTOR	
6		CIANBRO CORP.	
IN CHARGE		MADE BY	CHKD. BY
HINKLE		CS	G.F.F.
CONTRACT NUMBER		DRAWING NUMBER	DATE
ME-84088-1		8 OF 36	7/6/84



AF 22087A

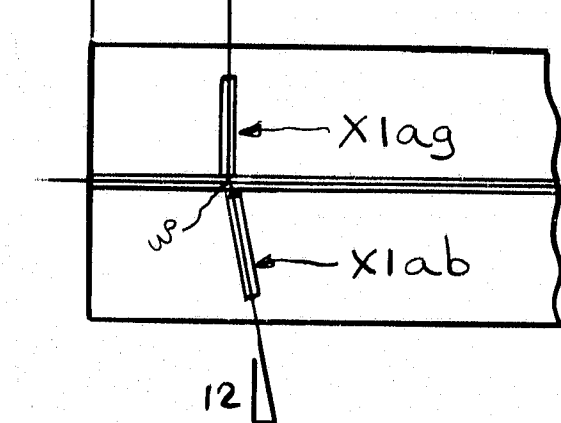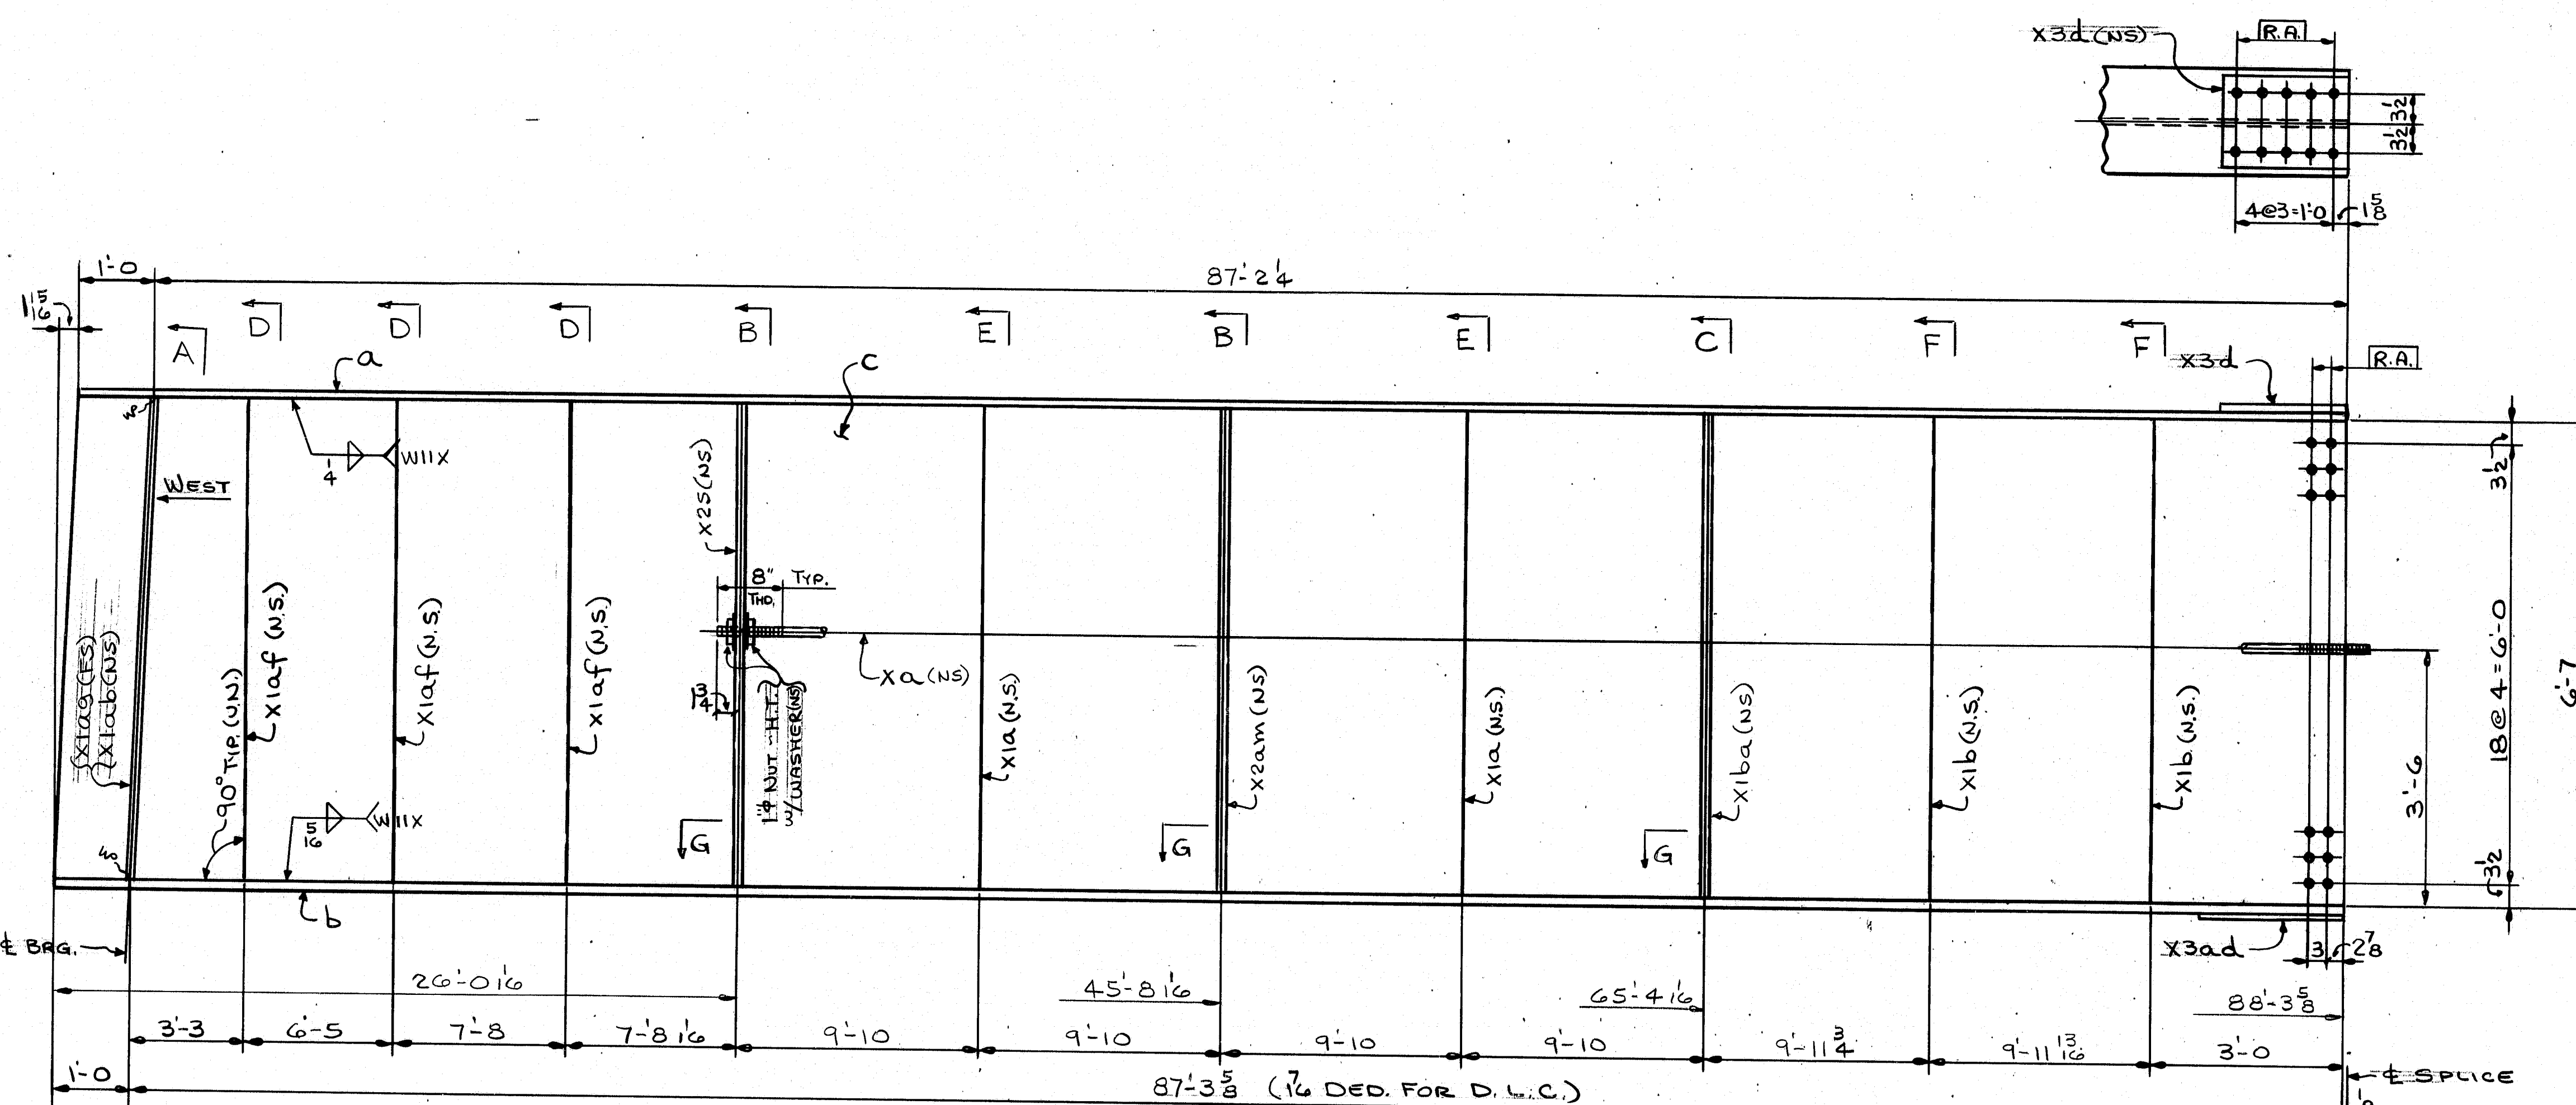

ONE GIRDER - MK. G1A

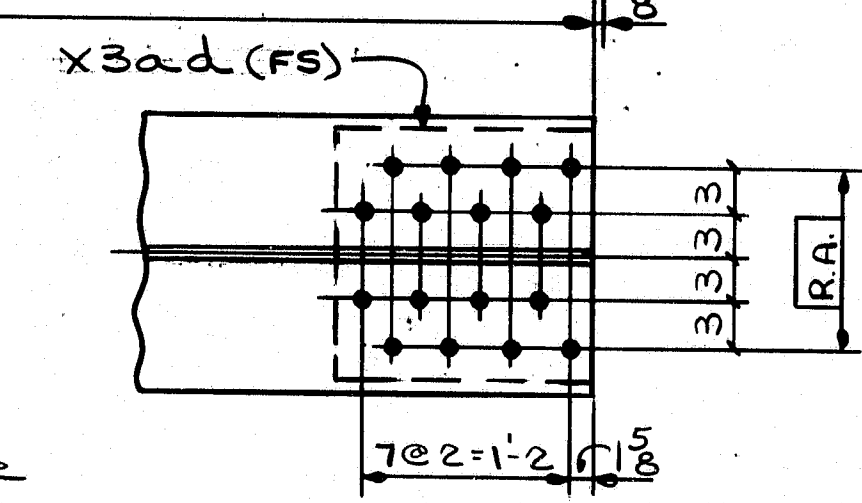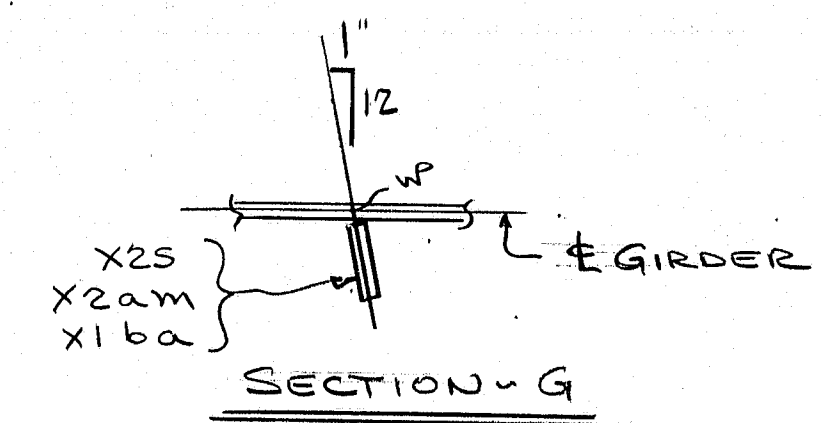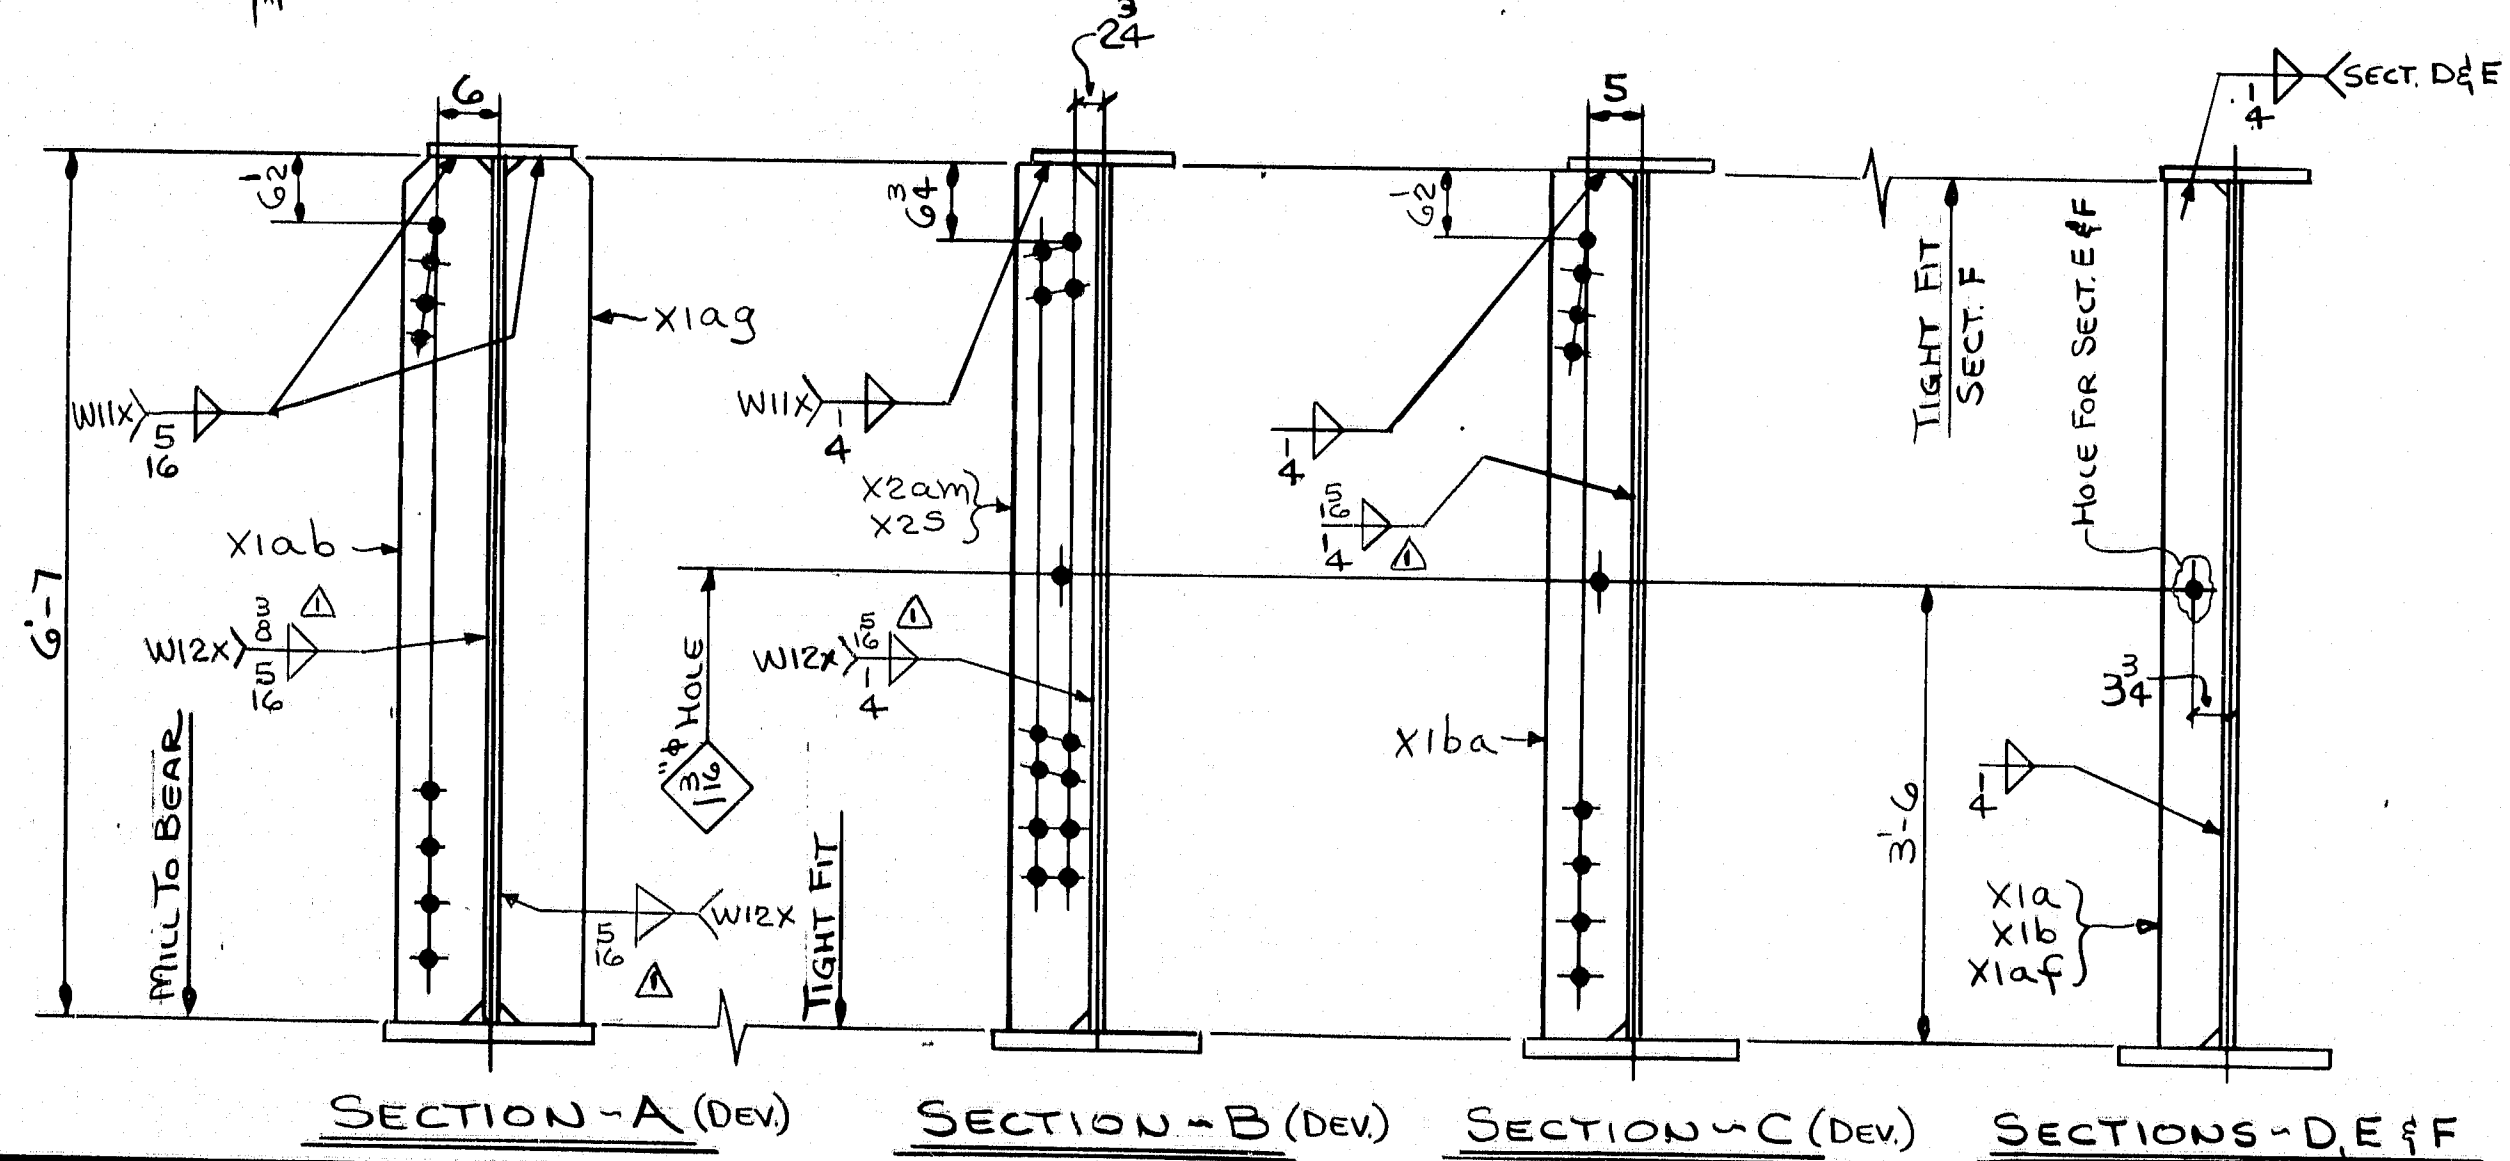

SHOP NOTE

HOLES: 1/2" (U.N.)  
 BOLTS: NONE  
 PAINT: NONE

FOR GENERAL NOTES, SEE DWG. N1.  
 FOR CAMBER DIAGRAM SEE DWG. WCI.


R95-123

FED. ROAD DIST. NO.	STATE	FED. AID PROJ. NO.
ME	ME	14-395-8(R2)04

BILL OF MATERIAL						
NO.	MARK	DESCRIPTION	LENGTH	REMARKS	ITEM	QUANTITY
ONE	G1A	GIRDER				24500
ONE	a	R-13 x 3/4	88 2/4			
ONE	b	R-19 x 1 1/2	88 3/8			
ONE	c	R-79 x 2	88 4 3/8			
ONE	Xa	1 1/4" ROD	62 8/8	THD. BOTH ENDS		
ONE	X3d	FW R-11 x 8	1 3/8			
ONE	X3ad	FW R-17 x 8	1 5/8			
2	X1a	BAR 5 x 1 1/2	6 7			
2	X1b	BAR 5 x 1 1/2				
3	X1af	BAR 5 x 1 1/2				
ONE	X1a3	BAR 8 x 1"				
1	X1ab	BAR 8 x 1"				
	X2s	BAR 7 x 1 1/2				
	X2am	BAR 7 x 1 1/2				
ONE	X1ba	BAR 7 x 1 1/2	6 7			
2		1" STD. HEX. NUTS				8 1/2
2		WASH. FOR 1" ROD				8 1/2

NO. 1	REVISION CHANGED WELD SIZES	DATE 1-3-85
HIGH STEEL STRUCTURES, INC.		
1905 Old Philadelphia Pike Lancaster, Pennsylvania 17603 Phone 717/299-5211		
A Subsidiary of High Industries, Inc.		
GIRDER G1A		
I-395 BRIDGE OVER PENOBSCOT RIVER		
I-395 BRIDGE STA. 164+60.00		
PENOBSCOT COUNTY		
STATE OF MAINE		
DEPARTMENT OF TRANSPORTATION		
STATE CONTRACT OR REF. NO.	6	CONTRACTOR CIABERO CORP.
IN CHARGE:	HINKLE	MADE BY: G.F.Z. CHK'D BY: CS DATE: 6-27-84
CONTRACT NUMBER:	ME-84088-1	DRAWING NUMBER: 7 OF 36

AP 22683A

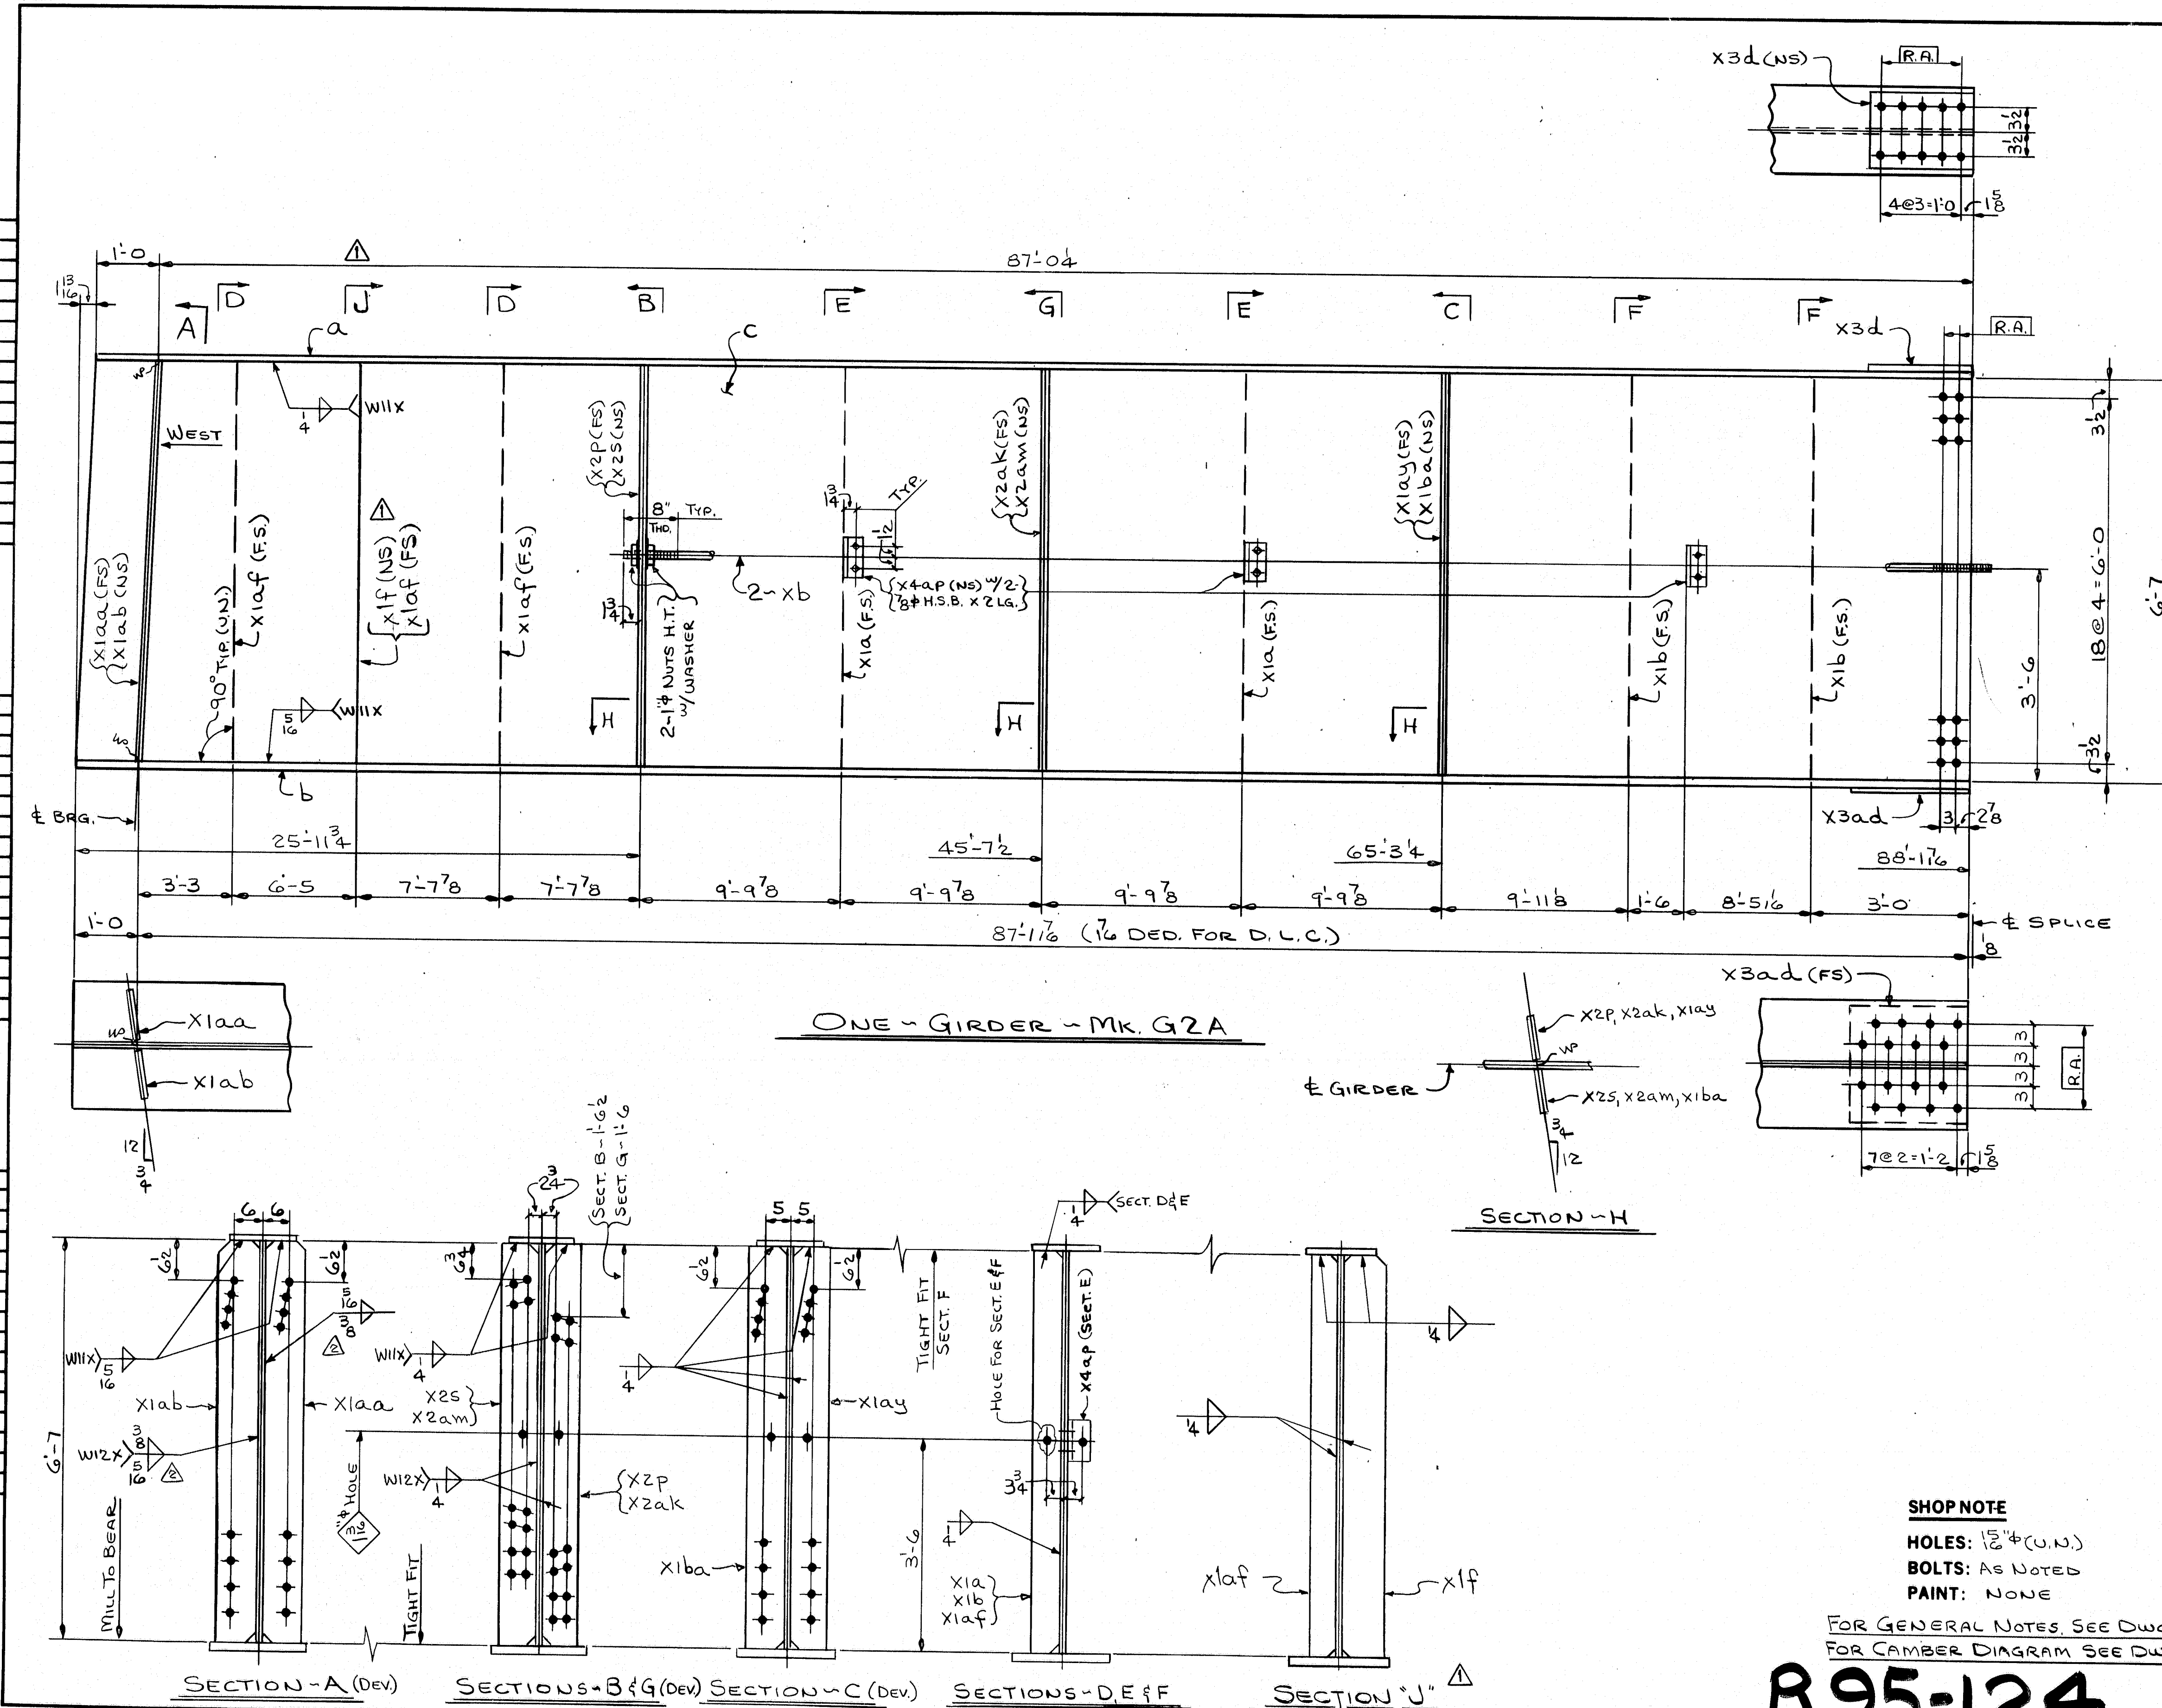

BILL OF MATERIAL					
NO.	MARK	DESCRIPTION	LENGTH	REMARKS	ITEM
ONE	G2A	GIRDER			24924
ONE	a	PL 13 x 3/4	88' 0 1/2"		
ONE	b	PL 19 x 1 1/2	88' 1 1/2"		
ONE	c	PL 79 x 1/2	88' 2 1/2"		
2	x1a	1" ROD	62' 6 1/2"	THD. BOTH ENDS	
ONE	x1f	PL 10 x 3/8	6' 7"		
ONE	x3d	FL PL 11 x 3/8	1' 3 1/2"		
ONE	x3ad	FL PL 17 x 3/8	1' 5 1/2"		
2	x1a	BAR 5 x 1 1/2	6' 7"		
2	x1b	BAR 5 x 1 1/2			
3	x1af	BAR 5 x 1 1/2			
ONE	x1aa	BAR 8 x 1			
	x1ab	BAR 8 x 1			
	x2p	BAR 7 x 1 1/2			
	x2s				
	x2ak				
	x2am				
	x1ay				
ONE	x1ba	BAR 7 x 1 1/2	6' 7"		
3	x4ap	5 x 3 x 1/4	0' 6"		
4		1" STD. HEX. NUTS			81/2
4		WASH. FOR 1" ROD			81/2
6		3/8" H.S. BOLTS	0' 2"		81/2
6		WASH. FOR 3/8" H.S. BOLT			81/2

NO. 2	REVISION CHANGED WELD SIZES	DATE 1-3-85
NO. 1	REVISION CONTRACT REVISION	DATE 9-10-84
<b>HIGH STEEL STRUCTURES, INC.</b> 1905 Old Philadelphia Pike Lancaster, Pennsylvania 17603 Phone 717/299-5211 A Subsidiary of High Industries, Inc.		
<b>GIRDER G2A</b> I-395 BRIDGE OVER PENOBSCOT RIVER I-395 BRIDGE STA. 164 + 60.00 PENOBSCOT COUNTY STATE OF MAINE DEPARTMENT OF TRANSPORTATION		
STATE CONTRACT OR REF. NO.	CONTRACTOR	DATE
6	CIAMBRO CORP.	
IN CHARGE: HINKLE	MADE BY: G.F.Z.	CHK. BY: CS
CONTRACT NO. ME-84088-1	DRAWING NO.	DATE: 6-27-84
		8 OF 36

**SHOP NOTE**  
 BOLTS: AS NOTED  
 PAINT: NONE  
 FOR GENERAL NOTES, SEE DWG. N1.  
 FOR CAMBER DIAGRAM SEE DWG. WCI.  
**R95-124**  
 CODE: 4000




AP 22083A

a  
b  
c  
d  
e  
f  
g  
h  
k  
m  
n  
p  
s  
t  
w  
y

a  
b  
c  
d  
e  
f  
g  
h  
k  
m  
n  
p  
s  
t  
w  
y

a  
b  
c  
d  
e  
f  
g  
h  
k  
m  
n  
p  
s  
t  
w  
y

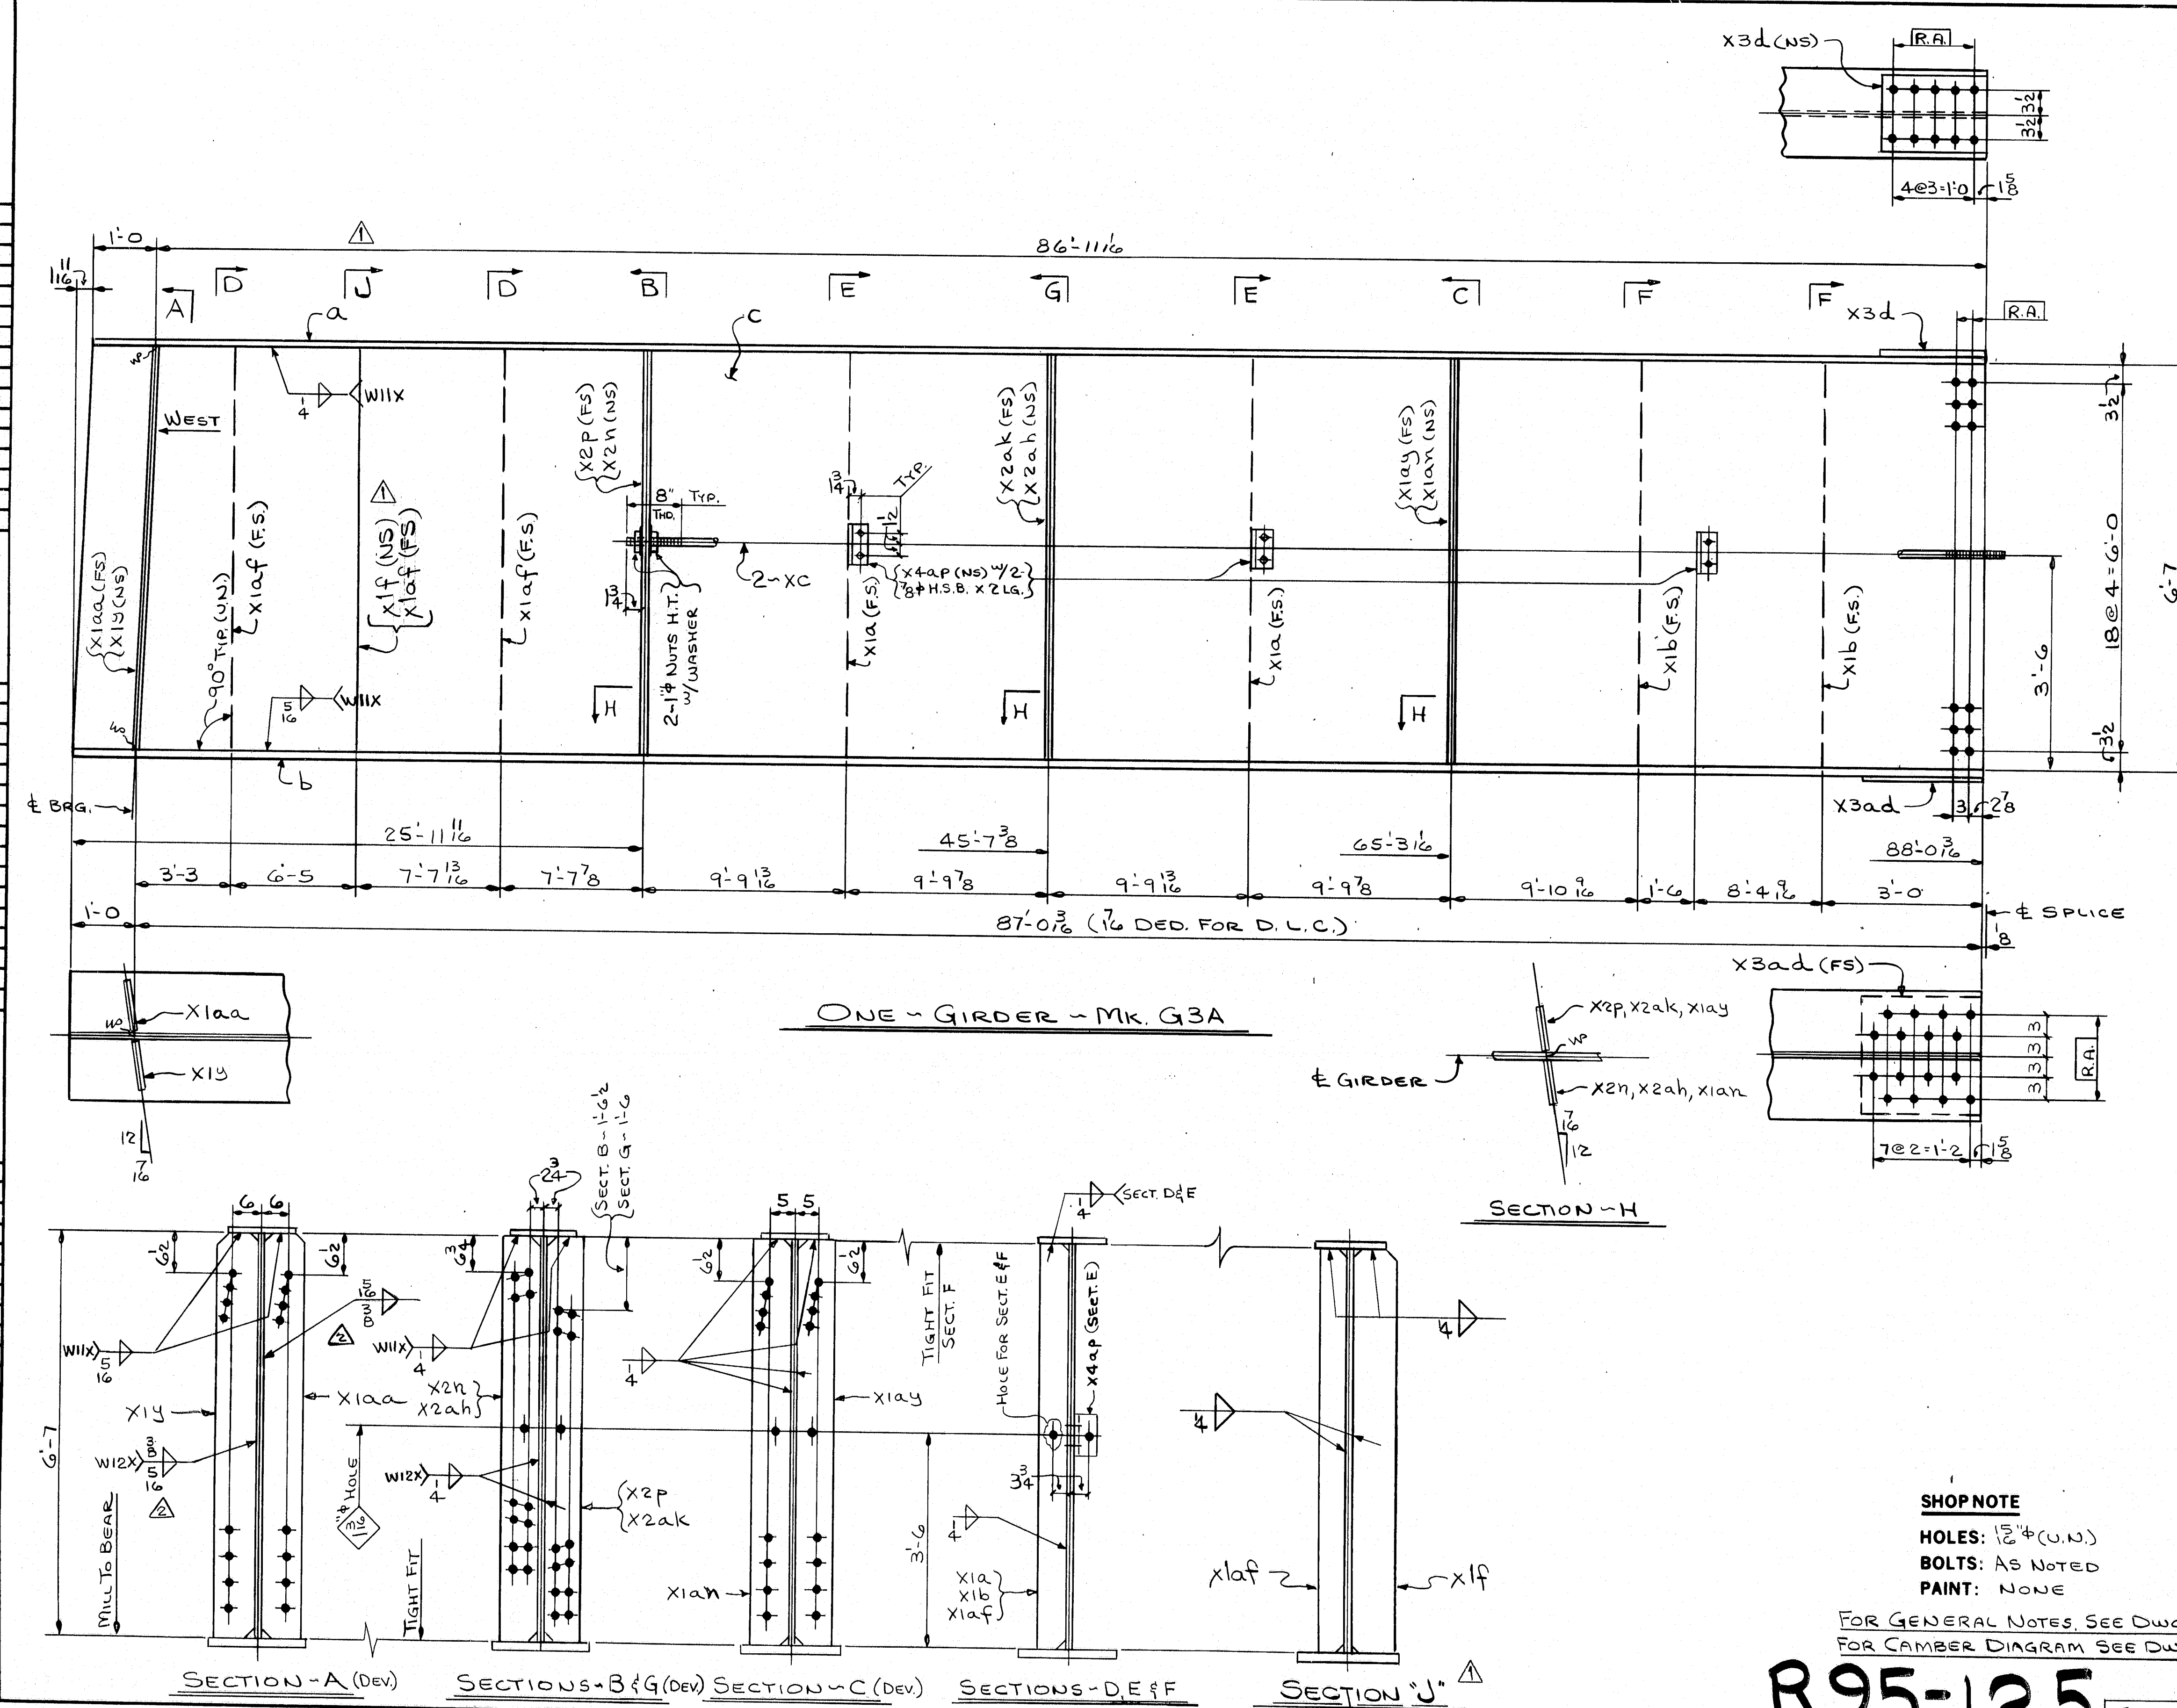

SHOP NOTE

BOLTS: AS NOTED  
PAINT: NONE

FOR GENERAL NOTES, SEE DWG. N1.  
FOR CAMBER DIAGRAM, SEE DWG. WCI.

R95-125

CODE: 4000

FED. ROAD DIV. NO.	STATE	FED. AID PROJ. NO.
1	ME	I-14-315-8(82)174

BILL OF MATERIAL

NO.	MARK	DESCRIPTION	LENGTH	REMARKS	ITEM	SHIP WEIGHT
ONE	G3A	GIRDER				24,894
ONE	a	PL 13 x 3/4	87	11 1/2		
ONE	b	PL 19 x 1 1/2	88	0 1/2		
ONE	c	PL 79 x 1/2	88	0 1/2		
2	xc	1" ROD	62	5 3/8	THD. BOTH ENDS	20
ONE	x1p	PL 10 x 3/8	6	7		
ONE	x3d	PL 11 x 3/8	1	3 3/8		
ONE	x3ad	PL 17 x 3/8	1	5 3/8		
2	x1a	BAR 5 x 1/2	6	7		
2	x1b	BAR 5 x 1/2	6	7		
3	x1af	BAR 5 x 1/2	6	7		
ONE	x1aa	BAR 8 x 1				
ONE	x1b	BAR 8 x 1				
ONE	x2p	BAR 7 x 1/2				
ONE	x2n	BAR 7 x 1/2				
ONE	x2ak	BAR 7 x 1/2				
ONE	x2ah	BAR 7 x 1/2				
ONE	x1ay	BAR 7 x 1/2				
ONE	x1an	BAR 7 x 1/2				
3	x4ap	LS 3 x 1/4	0	6		
4		1" STD. HEX. NUTS				12
4		WASH. FOR 1" ROD				12
6		3/8" H.S. BOLTS	0	2		12
6		WASH. FOR 3/8" H.S. BOLT				12

NO.	REVISION	CHANGED WELD SIZES	DATE
2			1-3-85
NO.	REVISION	CONTRACT REVISION	DATE
1		control # 14	9-10-84

HIGH STEEL STRUCTURES, INC.

1905 Old Philadelphia Pike  
Lancaster, Pennsylvania 17603  
Phone 717/299-5211

A Subsidiary of High Industries, Inc.

GIRDER G3A

I-395 BRIDGE OVER PENOBSCOT RIVER

I-395 BRIDGE STA. 164+60.00

PENOBSCOT COUNTY

STATE OF MAINE

DEPARTMENT OF TRANSPORTATION

STATE CONTRACT OR REF. NO. 6 CONTRACTOR CIAMERO CORP.

IN CHARGE: HINKLE MADE BY: G.F.F. CHK. BY: CS DATE: 6-27-84


CONTRACT NUMBER: ME-84088-1 DRAWING NUMBER: 9 OF 36

AP 22083A

a  
b  
c  
d  
e  
f  
g  
h  
i  
j  
k  
l  
m  
n  
o  
p  
q  
r  
s  
t  
u  
v  
w  
x  
y



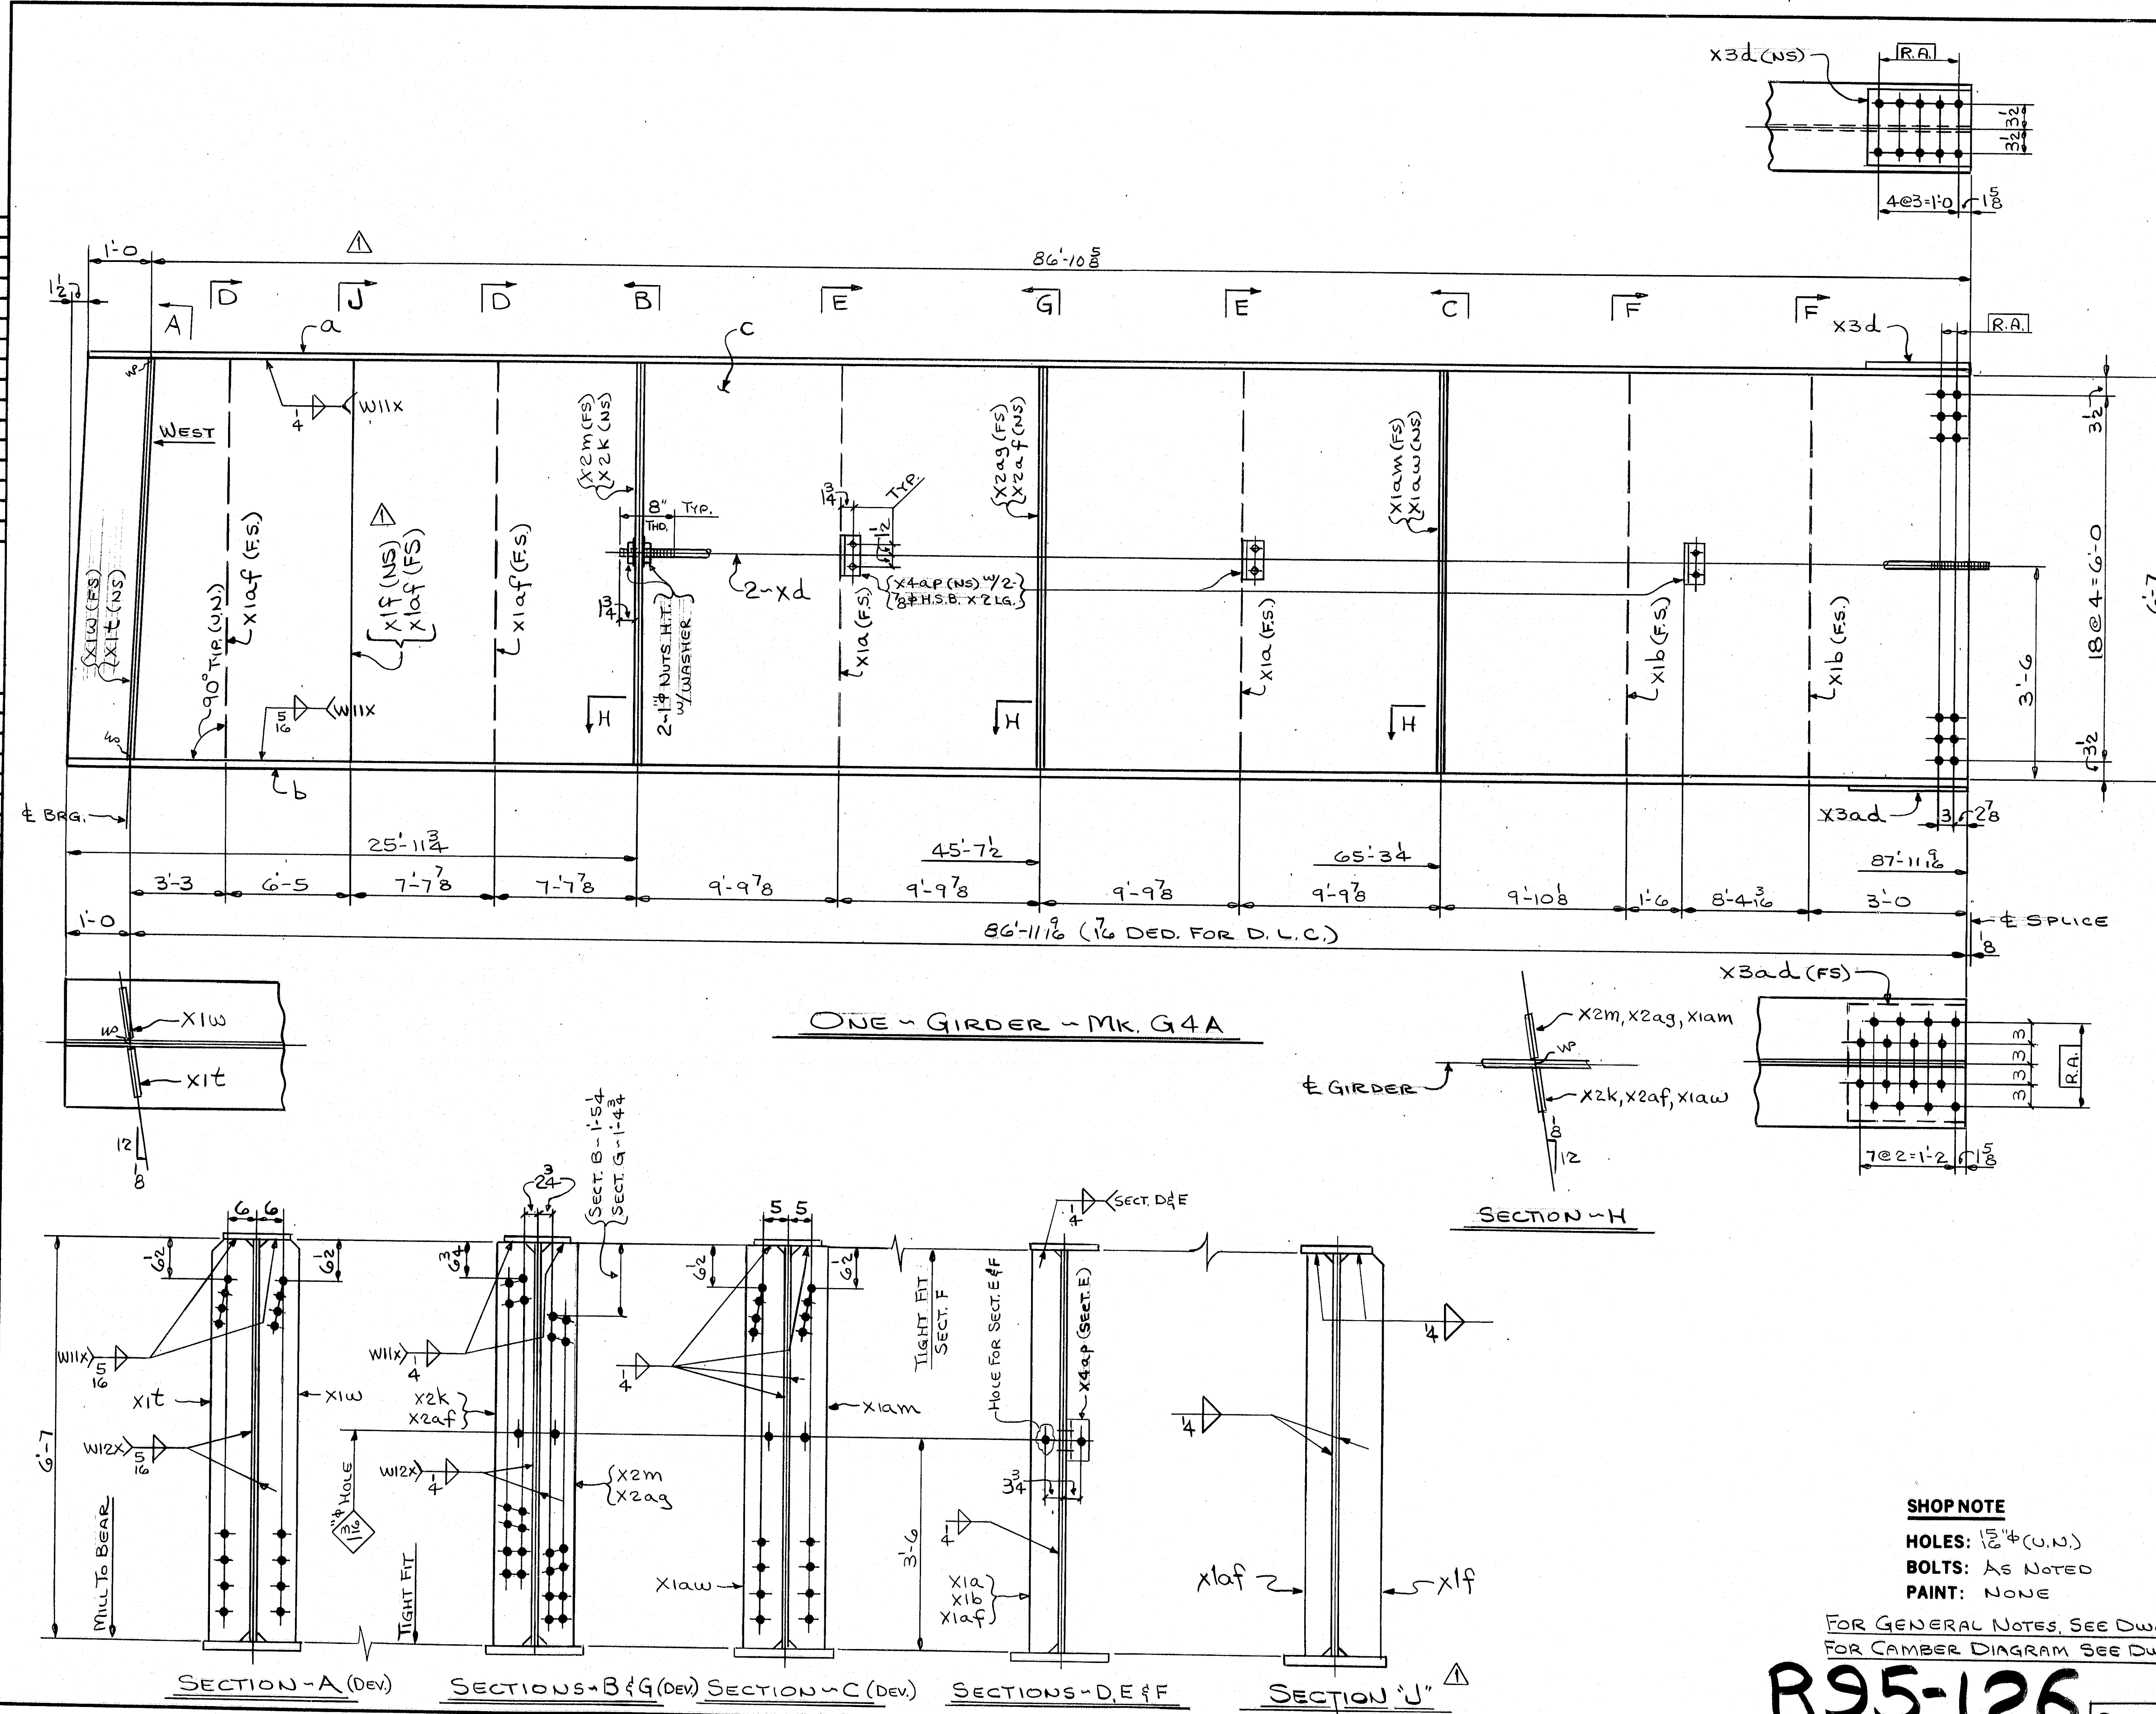

ONE GIRDER - MK. G4A

SECTION - H

SECTION - A (Dev)


SECTION - C (Dev)

SECTIONS - D, E, F

SECTION - J

SHOP NOTE

BOLTS: AS NOTED  
PAINT: NONE

FOR GENERAL NOTES, SEE DWG. N1.  
FOR CAMBER DIAGRAM SEE DWG. WCI.

R95-126

CODE: 4000

FED. ROAD DIV. NO.		STATE	FED. AID PROJ. NO.
1		ME	1-14-315-8(82)04

BILL OF MATERIAL						
NO.	MARK	DESCRIPTION	LENGTH	REMARKS	ITEM	SHIP- WEIGHT
ONE	G4A	GIRDER				14.884
ONE	a	PL 13 x 3/4	87	10 5/8		
ONE	b	PL 19 x 1 1/2	87	11 1/2		
ONE	c	PL 79 x 1/2	88	0 3/4		
2	Xd	1" ROD	62	4 5/8	THD. BOTH ENDS	9/4
ONE	Xlf	PL 10 x 3/8	6	7		
ONE	X3d	FILL PL 11 x 3/8	1	3 3/8		
ONE	X3ad	FILL PL 17 x 1/8	1	5 5/8		
2	X1a	BAR 5 x 1/2	6	7		
2	X1b	BAR 5 x 1/2				
3	X1af	BAR 5 x 1/2				
ONE	X1w	BAR 8 x 1				
	X1t	BAR 8 x 1				
	X2m	BAR 7 x 1/2				
	X2k					
	X2as					
	X2af					
	X1am					
ONE	X1aw	BAR 7 x 1/2	6	7		
3	X4ap	5 x 3 x 1/4	0	6		
4		1" STD. HEX. NUTS			B1	12
4		WASH. FOR 1" ROD			B1	8
6		3/8" H.S. BOLTS	0	2	B1	2
6		WASH. FOR 3/8" H.S. BOLT			B1	9

NO.	REVISION	CONTRACT REVISION	DATE
		control #14	9-10-84
HIGH STEEL STRUCTURES, INC.			
1905 Old Philadelphia Pike Lancaster, Pennsylvania 17603 Phone 717/299-5211			
A Subsidiary of High Industries, Inc.			
GIRDER G4A			
I-395 BRIDGE OVER PENOBSCOT RIVER			
I-395 BRIDGE STA. 164+60.00			
PENOBSCOT COUNTY			
STATE OF MAINE			
DEPARTMENT OF TRANSPORTATION			
STATE CONTRACT OR REF. NO.	CONTRACTOR	DATE	
6	CIANERO CORP.	9-27-84	
IN CHARGE: HINKLE	MADE BY: G.F.Z.	CHK'D BY: CS	DATE: 9-27-84
CONTRACT NUMBER: ME-84088-1	DRAWING NUMBER:	10 OF 36	




AF 22803A

a  
b  
c  
d  
e  
f  
g  
h  
i  
j  
k  
l  
m  
n  
o  
p  
q  
r  
s  
t  
u  
v  
w  
x  
y



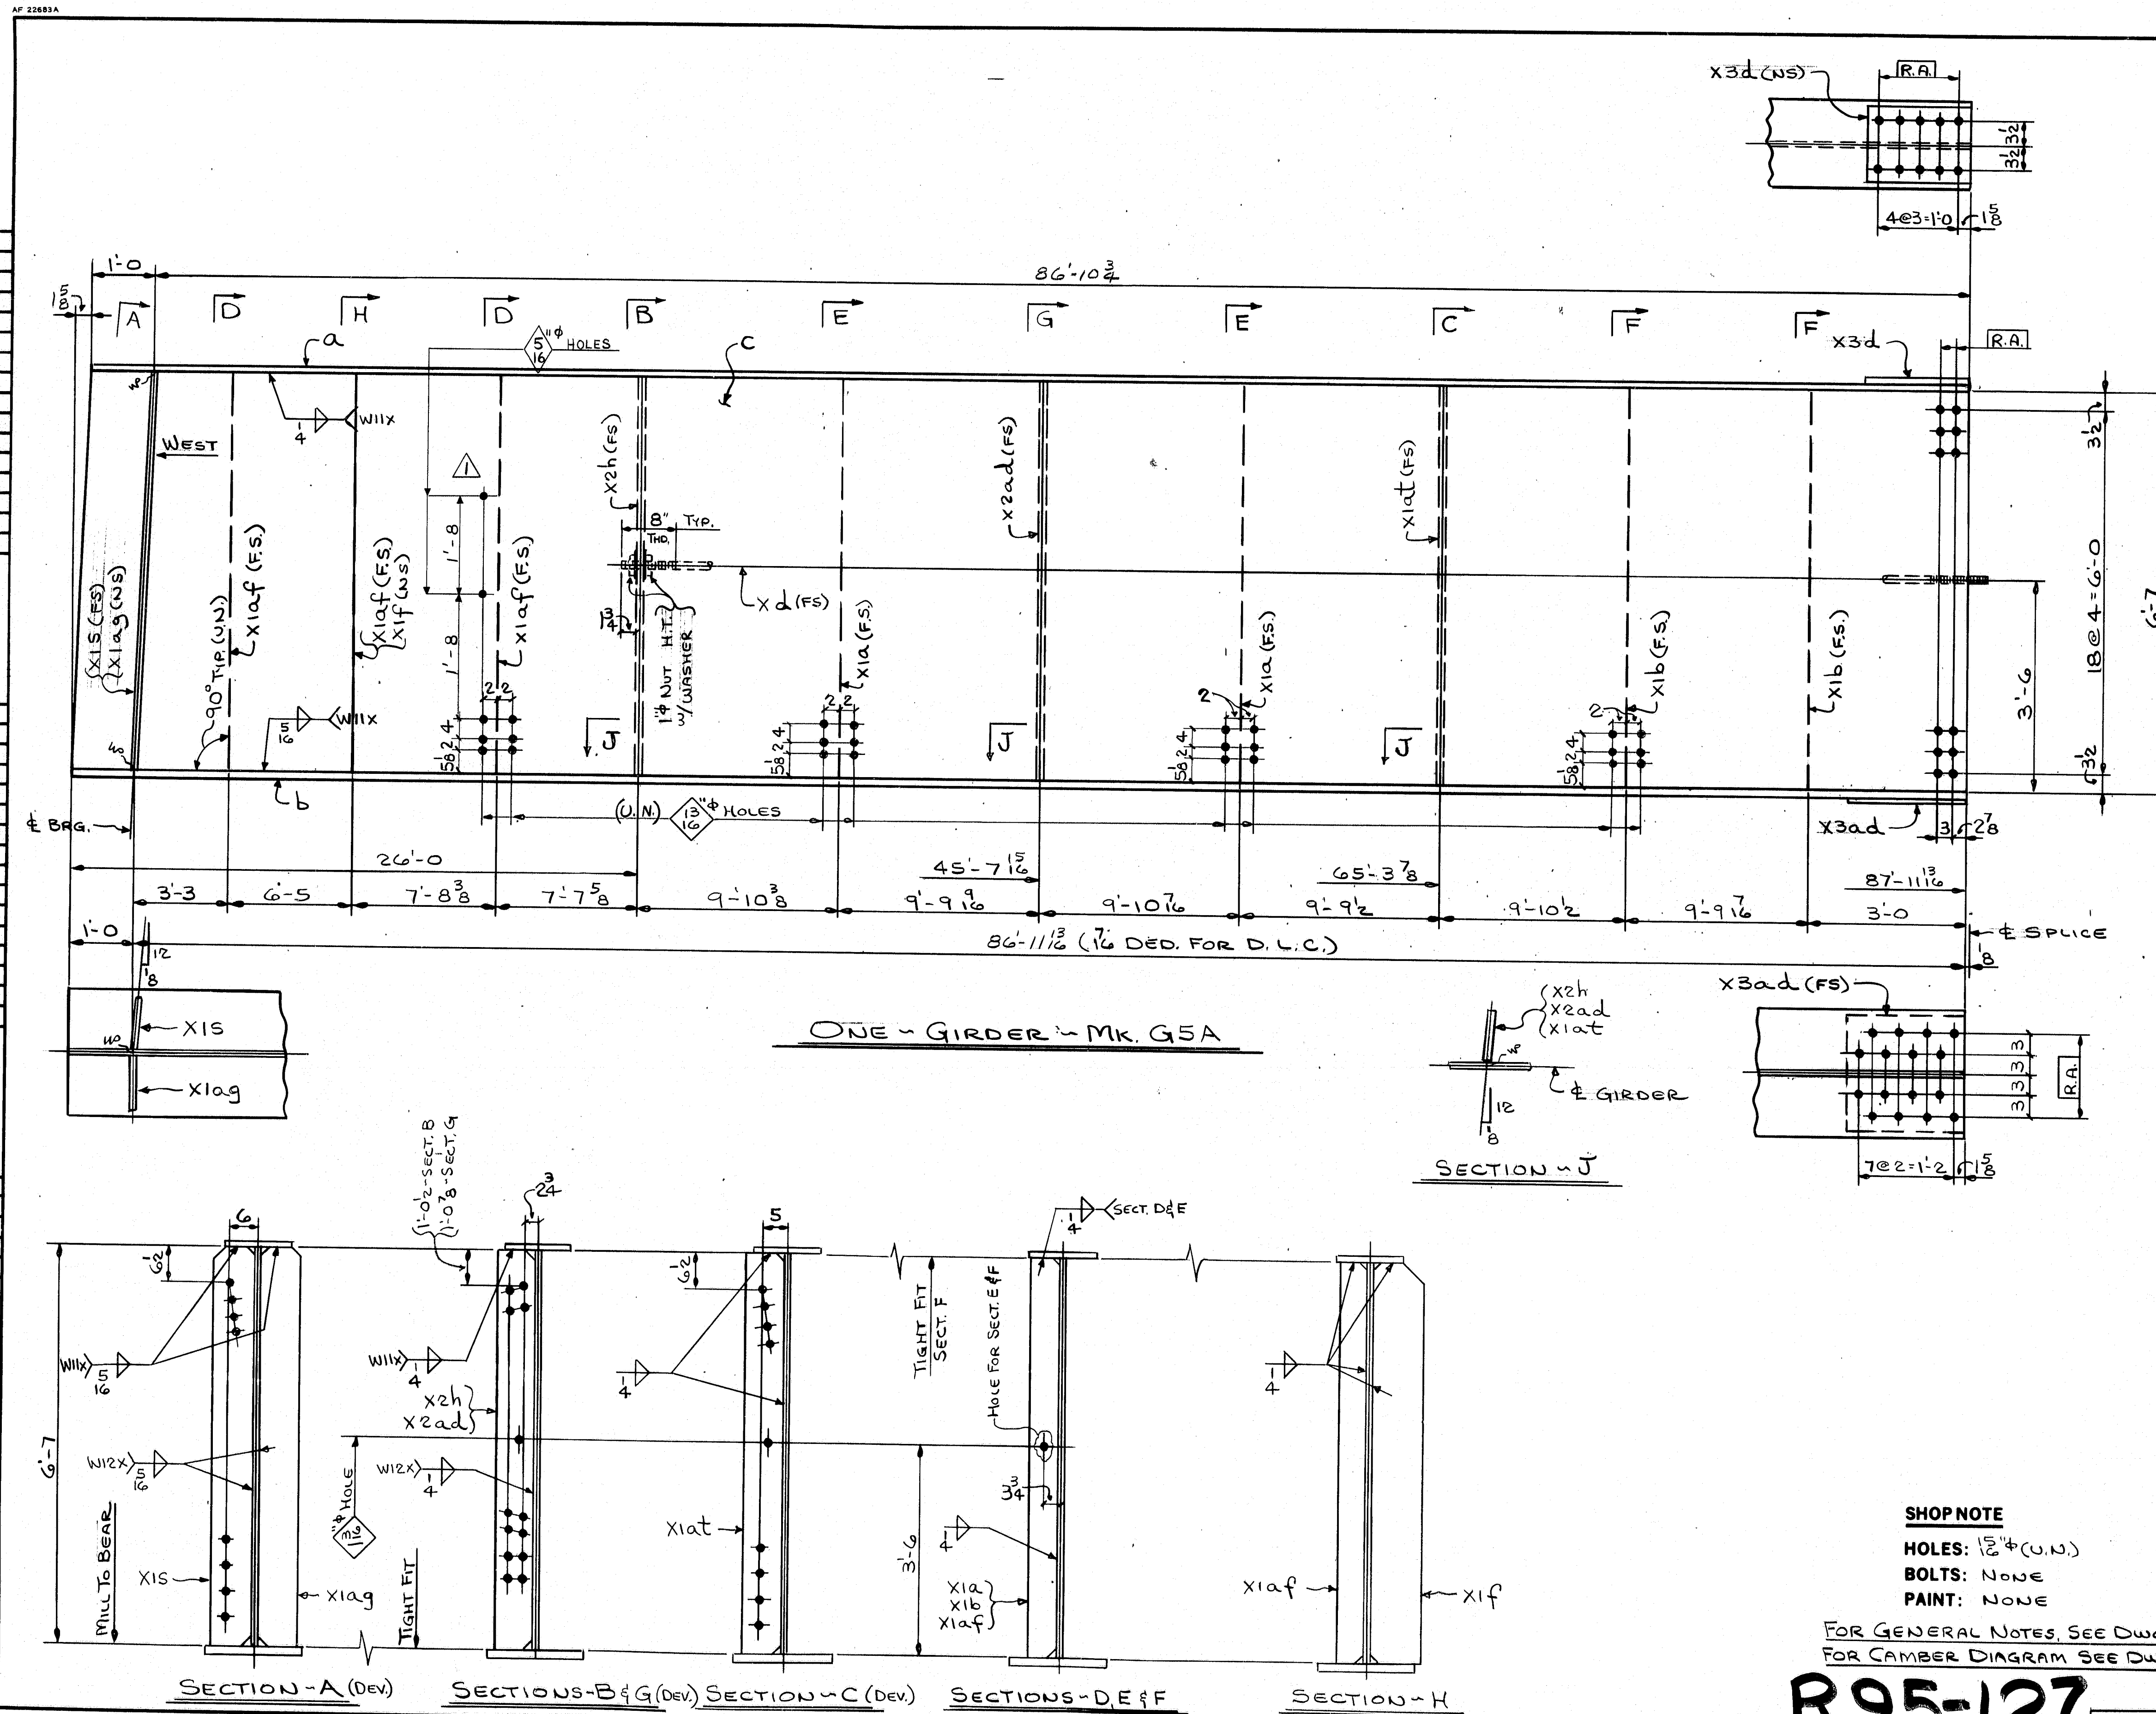

SHOP NOTE

HOLES: 1/2" (U.N.)  
BOLTS: NONE  
PAINT: NONE

FOR GENERAL NOTES, SEE DWG. N1.  
FOR CAMBER DIAGRAM SEE DWG. WCI.

R95-127

Code: 4000


FED. ROAD DIV. NO.	STATE	FED. AID PROJ. NO.
1	ME	1-14-395-8(82)04

BILL OF MATERIAL

NO.	MARK	DESCRIPTION	LENGTH	REMARKS	ITEM	QUANTITY
ONE	G5A	GIRDER				24500
ONE	a	PL 13 x 3/4	87 10 3/4			
ONE	b	PL 19 x 1 1/2	87 11 1/2			
ONE	c	PL 79 x 1/2	88 0 3/8			
ONE	x3d	1" ROD	62 4 3/8	THD. BOTH ENDS		
ONE	x3d	FL. PL. 11 x 7/8	1 3/8			
ONE	x3ad	FL. PL. 17 x 8	1 5/8			
2	x1a	BAR 5 x 1/2	6 7			
2	x1b	BAR 5 x 1/2	1			
3	x1af	BAR 5 x 1/2	1			
ONE	x1s	BAR 8 x 1				
1	x1ag	BAR 8 x 1				
1	x1f	PL 10 x 3/8				
1	x2h	BAR 7 x 1/2				
1	x2ad	BAR 7 x 1/2				
ONE	x1at	BAR 7 x 1/2	6 7			
2		1" STD. HEX. NUTS				8 1/2
2		WASH. FOR 1" ROD				8 1/2

NO.	REVISION	ADD. HOLES FOR CATWALK CHAIN	DATE 2-12-85
HIGH STEEL STRUCTURES, INC.			
1905 Old Philadelphia Pike Lancaster, Pennsylvania 17603 Phone 717/299-5211			
A Subsidiary of High Industries, Inc.			
GIRDER G5A			
I-395 BRIDGE OVER PENOBSCOT RIVER			
I-395 BRIDGE STA. 164+60.00			
PENOBSCOT COUNTY			
STATE OF MAINE			
DEPARTMENT OF TRANSPORTATION			
STATE CONTRACT OR REF. NO.	6	CONTRACTOR	CIANBRO CORP.
IN CHARGE	HINKLE	MADE BY	G.F.Z. CHK'D BY CS
CONTRACT NUMBER	ME-84088-1	DRAWING NUMBER	11 OF 36

AF 22603A

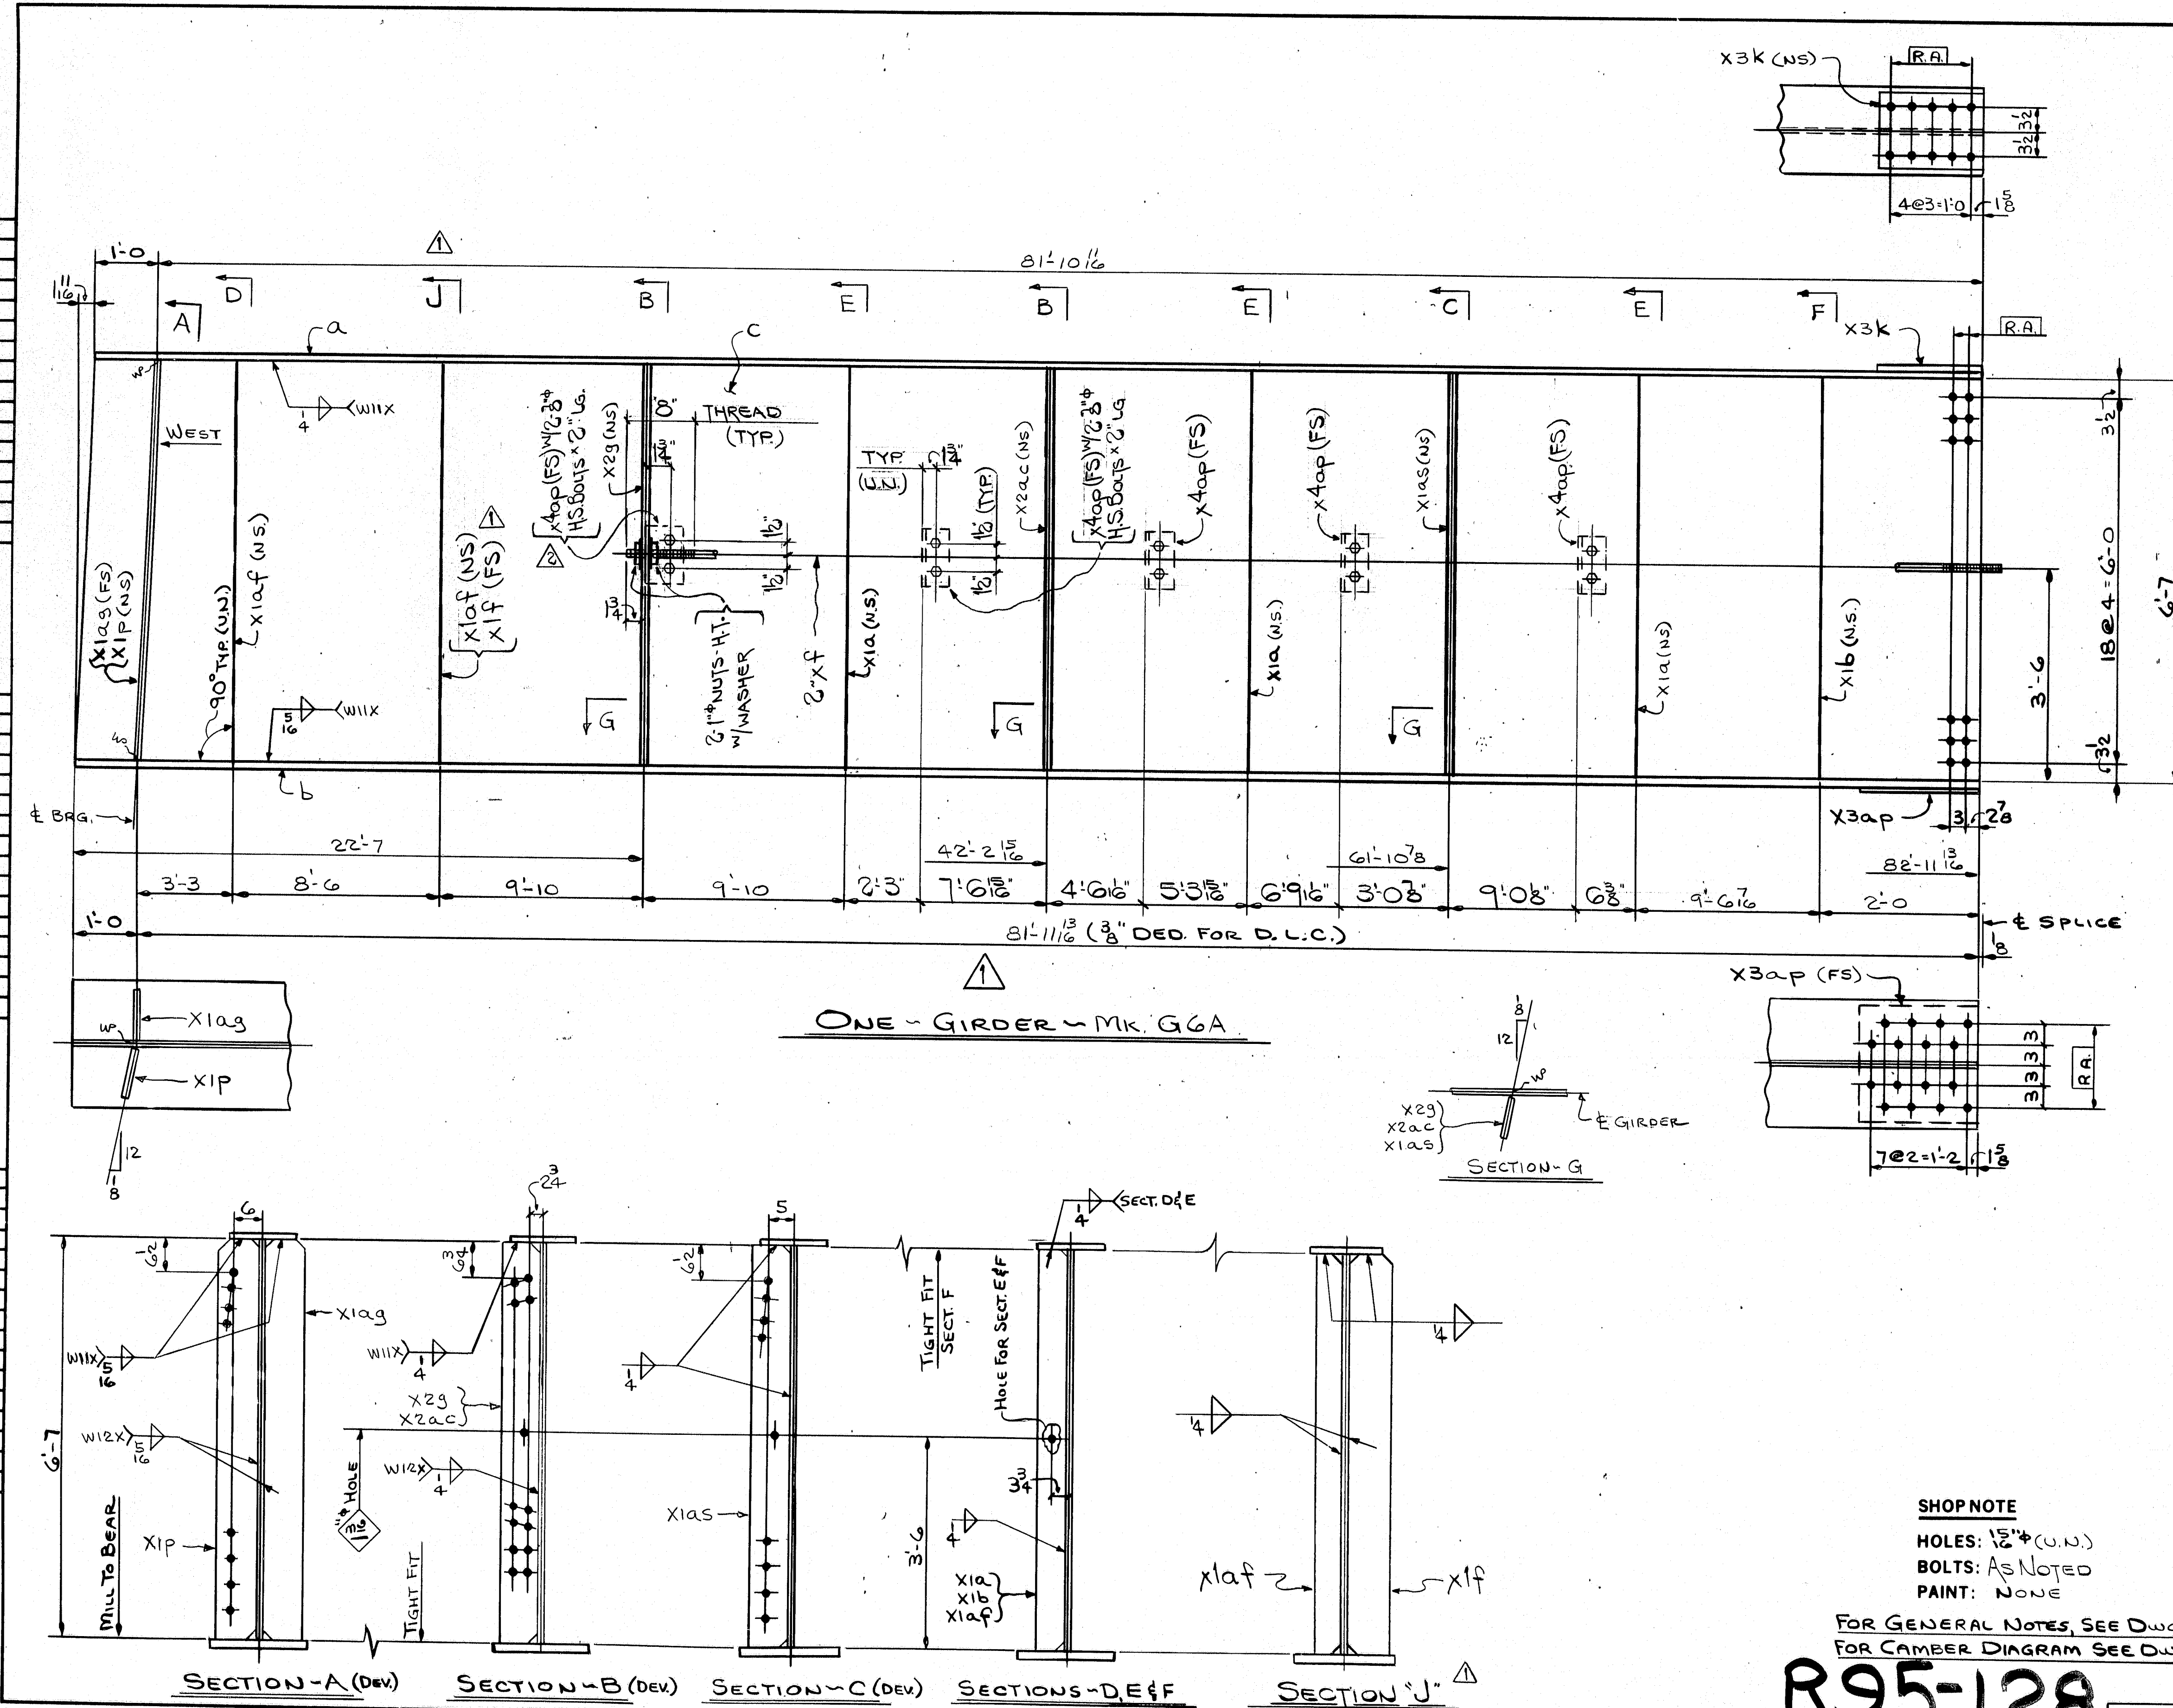

FED. ROAD DIV. NO.		STATE	FED. AID PROJ. NO.
1		ME	I-14-315-8(82)14

BILL OF MATERIAL					
NO.	MARK	DESCRIPTION	LENGTH	REMARKS	ITEM
ONE	G6A	GIRDER			23302
ONE	a	PL 13 x 3/4	82 10 1/2		
ONE	b	PL 19 x 1/2	82 11 1/2		
ONE	c	PL 79 x 1/2	83 0 3/8		
2	x f	1" ROD	60 9 3/8	THD. BOTH ENDS	
ONE	x1 f	PL 10 x 3/8	6 7		
ONE	x3 k	FILL PL. 11 x 1"	1 3/8		
ONE	x3 ap	FILL PL. 17 x 4"	1 5/8		
3	x1 a	BAR 5 x 1/2	6 7		
ONE	x1 b	BAR 5 x 1/2			
2	x1 a p	BAR 5 x 1/2			
ONE	x1 a s	BAR 8 x 1			
1	x1 p	BAR 8 x 1			
1	x2 g	BAR 7 x 1/2			
ONE	x1 a s	BAR 7 x 1/2	6 7		
5	x4 op	5 x 3 x 4	0 6		
4		1" STD. HEX. NUTS			B/ 12
4		WASH. FOR 1" ROD			B/ 8
10		3" H.S. BOLT	0 2		B/ 2
10		WASHERS FOR 3" H.S. BOLTS			B/ 4

**SHOP NOTE**

HOLES: 1/2" (U.N.)

BOLTS: AS NOTED

PAINT: NONE

FOR GENERAL NOTES, SEE DWG. N1.

FOR CAMBER DIAGRAM SEE DWG. WCI.

**R95-128**

CODE: 4000

NO.	1	changed to x4an to x4ap	12-14-84
REVISION	CONTROL # 14	DATE	9-10-84

**HIGH STEEL STRUCTURES, INC.**

1905 Old Philadelphia Pike  
Lancaster, Pennsylvania 17603  
Phone 717/299-5211

A Subsidiary of High Industries, Inc.

**GIRDER G6A**

I-395 BRIDGE OVER PENOBSCOT RIVER

I-395 BRIDGE STA. 164+60.00

PENOBSCOT COUNTY

STATE OF MAINE

DEPARTMENT OF TRANSPORTATION


STATE CONTRACT OR REF. NO. 6 CONTRACTOR CIAMERO CORP.

IN CHARGE: HINKLE MADE BY: G.F.F. CHK. BY: CS DATE: 12-27-84

CHARGE: ME-84088-1 DRAWING NUMBER: 12 OF 36



AP 22852A

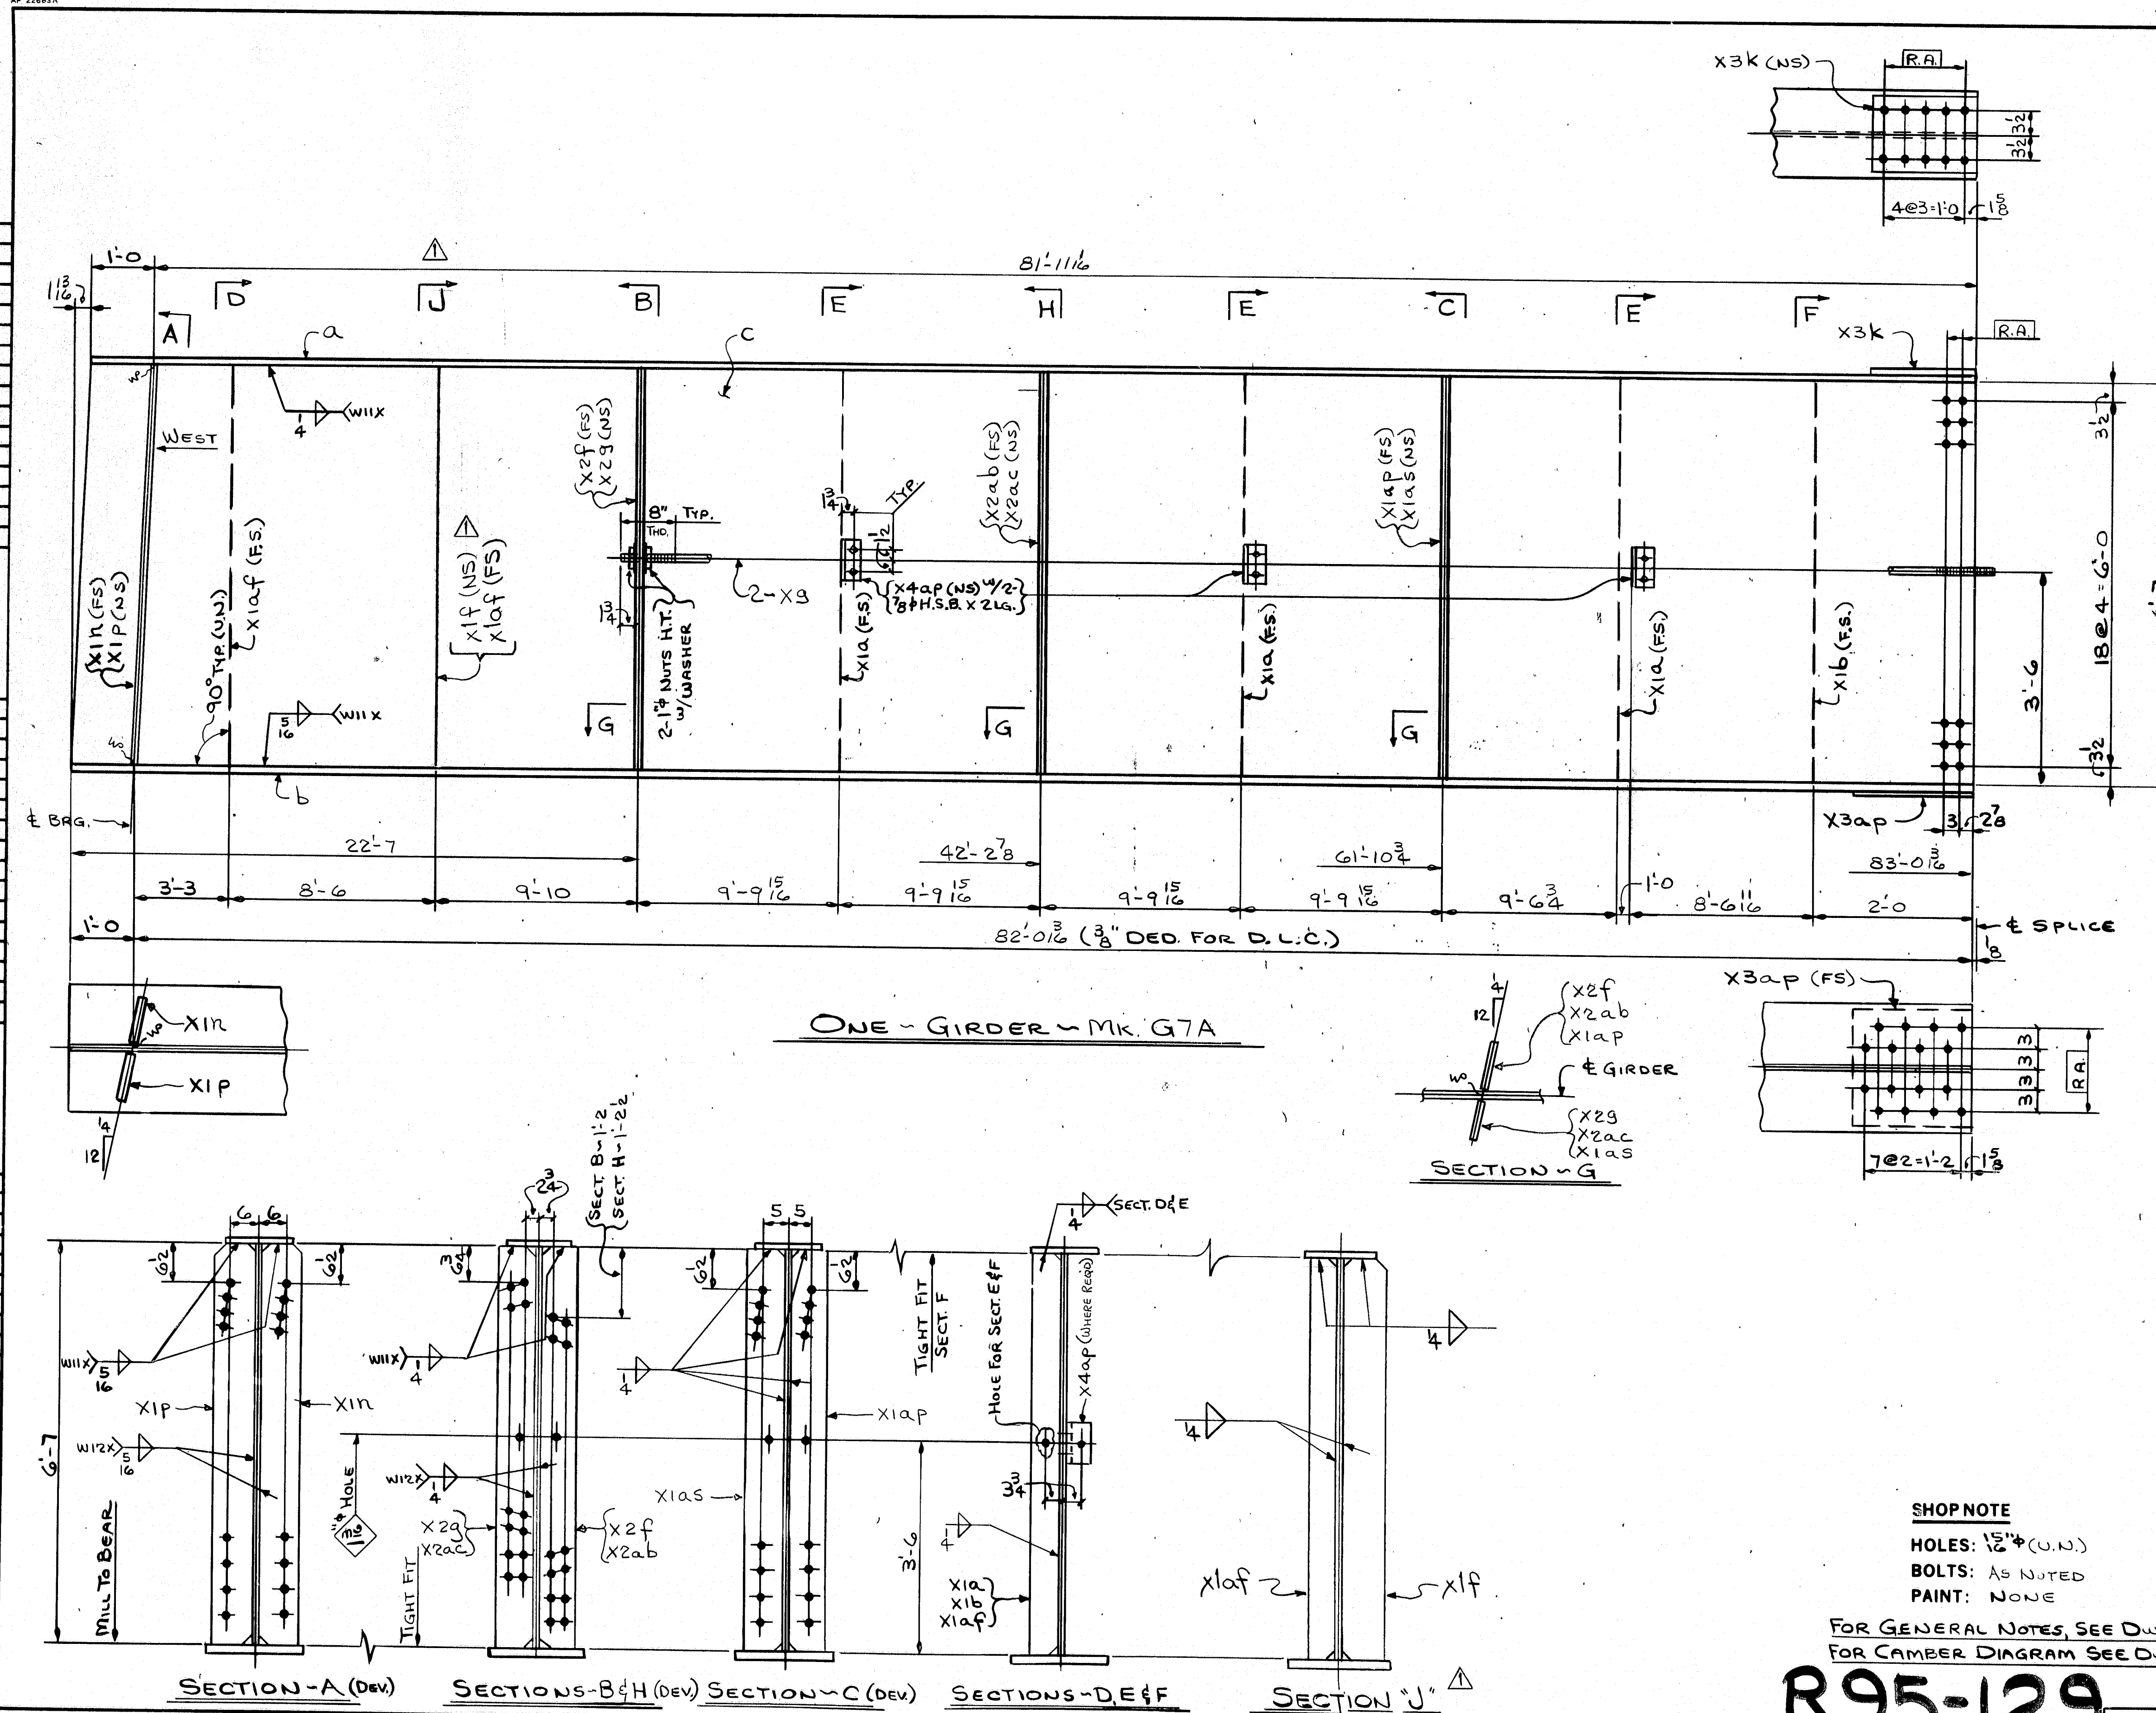

# SHOP NOTE

HOLES: 1/2" (U.N.)  
 BOLTS: AS NOTED  
 PAINT: NONE

FOR GENERAL NOTES, SEE DWG. N1.  
 FOR CAMBER DIAGRAM SEE DWG. WCI.

R95-129


CODE: 4000

FED. ROAD DIV. NO.		STATE	FED. AID PROJ. NO.	
1		ME	114-395-8(82)	

BILL OF MATERIAL						
NO.	MARK	DESCRIPTION	LENGTH	REMARKS	ITEM	SH WELD
ONE	G7A	GIRDER				25 60
ONE	a	PL 13 x 3/4	82 11 1/2			
ONE	b	PL 19 x 1 1/2	83 0 3/8			
ONE	c	PL 79 x 1/2	83 0 3/8			
2	X9	1" ROD	60 10 3/8	THD. BOTH ENDS	15	
ONE	X1P	PL 10 x 3/8	6 7			
ONE	X3K	FILL PL 11 x 1"	1 3/8			
ONE	X3ap	FILL PL 17 x 1/4	1 5/8			
3	X1a	BAR 5 x 1/2	6 7			
ONE	X1b	BAR 5 x 1/2				
2	X1ap	BAR 5 x 1/2				
ONE	X1N	BAR 8 x 1"				
	X1P	BAR 8 x 1"				
	X2f	BAR 7 x 1/2				
	X2g					
	X2ab					
	X2ac					
	X1ap					
ONE	X1as	BAR 7 x 1/2	6 7			
3	X4ap	LS 5 x 3 x 1/4	0 6			
4		1" STD. HEX. NUTS			B1	12
4		WASH. FOR 1" ROD			B1	8
6		7/8" H.S. BOLTS	0 2		B1	2
6		WASH. FOR 7/8" H.S. BOLT			B1	4

NO.	REVISION	CONTRACT REVISION	DATE 9-10-84
HIGH STEEL STRUCTURES, INC.			
1395 BRIDGE OVER PENOBSCOT RIVER			
1395 BRIDGE STA. 164+60.00			
PENOBSCOT COUNTY			
STATE OF MAINE			
DEPARTMENT OF TRANSPORTATION			
STATE CONTRACT OR REF. NO.	6	CONTRACTOR	CIANBRO CORP.
IN CHARGE	HINKLE	MADE BY	G.F.Z.
CHIEF D.	CS	DATE	8-2-84
CONTRACT ME-84088-1	DRAWING NUMBER	13	OF 36

AF 2263A

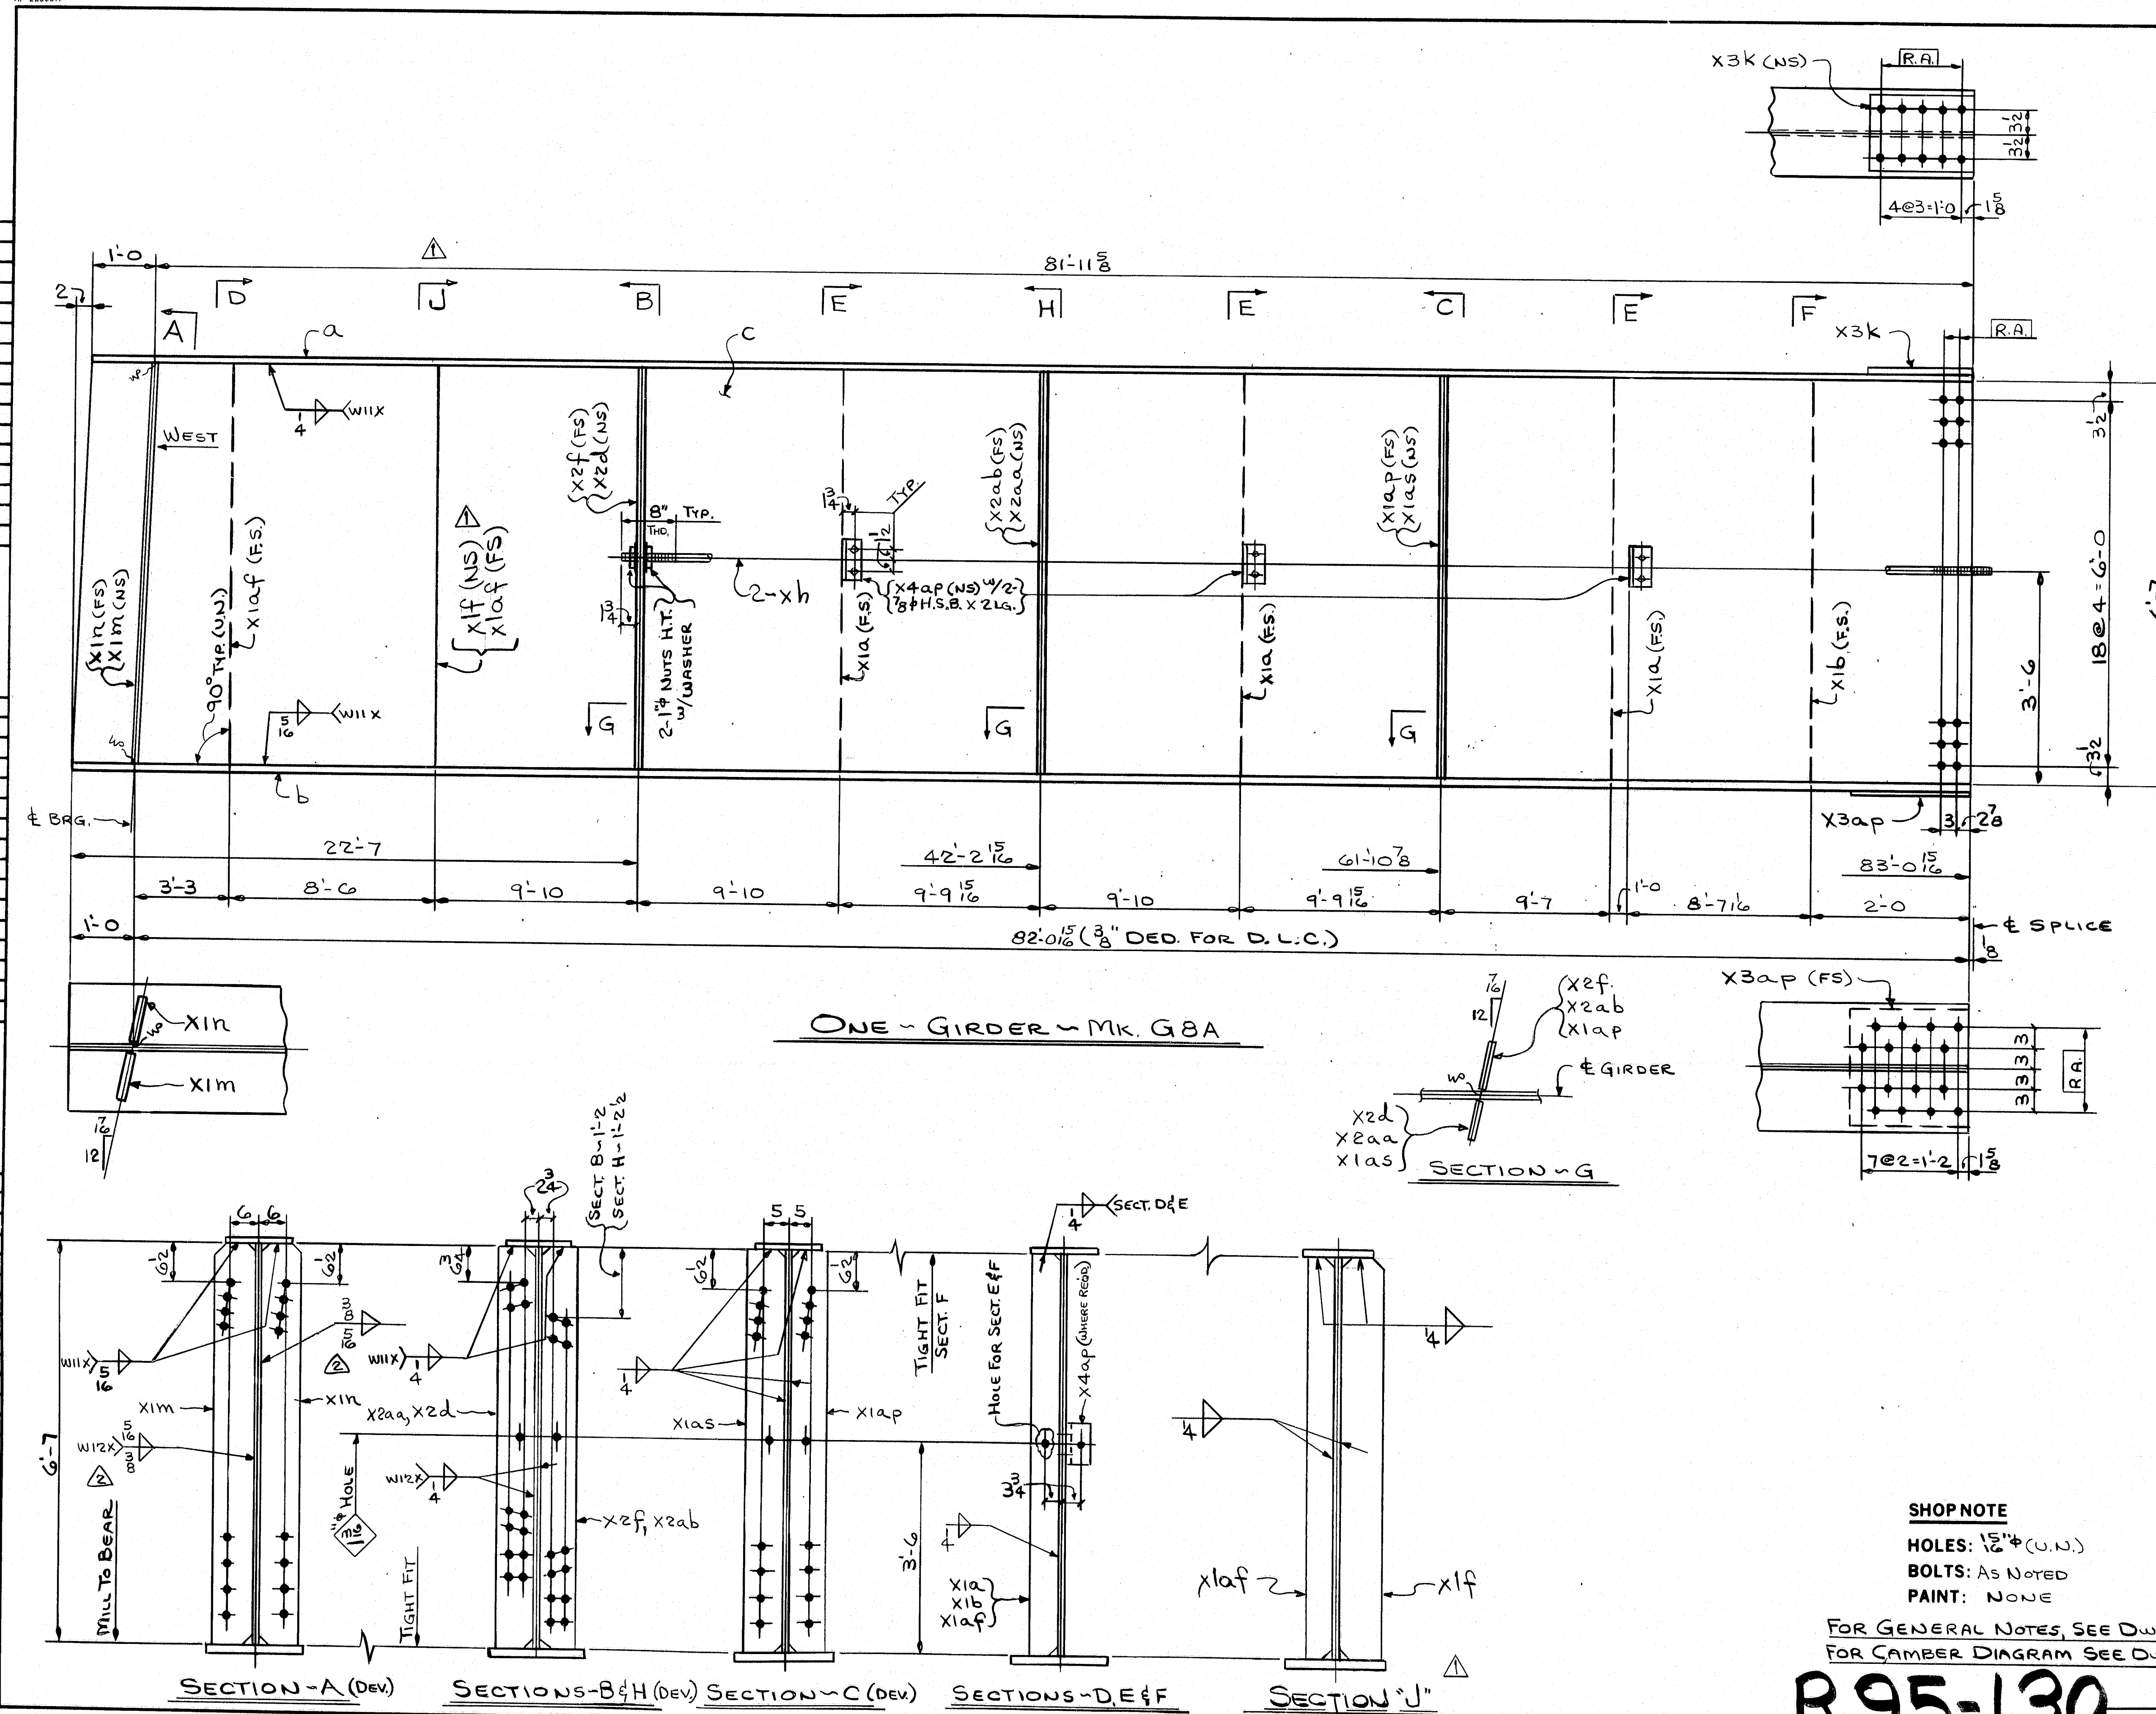

ONE GIRDER - MK. G8A

SHOP NOTE

HOLES: 1 1/2" (U.N.)  
 BOLTS: AS NOTED  
 PAINT: NONE

FOR GENERAL NOTES, SEE DWG. N1.  
 FOR CAMBER DIAGRAM SEE DWG. W1.

R95-130


CODE: 4000

BILL OF MATERIAL					
NO.	MARK	DESCRIPTION	LENGTH	REMARKS	ITEM
ONE	G8A	GIRDER			73549
ONE	a	PL 13 X 3/4	82	11 1/2	
ONE	b	PL 19 X 1 1/2	83	0 1/2	
ONE	c	PL 79 X 1 1/2	83	1 1/2	
2	Xh	1" ROD	60	10 1/2	THD. BOTH ENDS
ONE	X1f	PL 10 X 3/8	6	7	
ONE	X3k	FILL PL. 11 X 1"	1	3 1/2	
ONE	X3ap	FILL PL. 17 X 1/4	1	5 1/2	
3	X1a	BAR 5 X 1/2	6	7	
ONE	X1b	BAR 5 X 1/2			
2	X1c	BAR 5 X 1/2			
ONE	X1d	BAR 8 X 1"			
	X1e	BAR 8 X 1"			
	X2f	BAR 7 X 1/2			
	X2d				
	X2aa				
	X2ab				
	X1ap				
ONE	X1as	BAR 7 X 1/2	6	7	
3	X4ap	LS 3 X 1/4	0	6	
4		1" STD. HEX. NUTS			B/12
4		WASH. FOR 1" ROD			B/8
6		7/8" H.S. BOLTS	0	2	B/2
6		WASH. FOR 7/8" H.S. BOLT			B/4

NO. 2	REVISION CHANGED WELD SIZES	DATE 1-3-85
NO. 1	REVISION CONTRACT REVISION CONTROL #14	DATE 9-10-84
HIGH STEEL STRUCTURES, INC.		
1905 Old Philadelphia Pike Lancaster, Pennsylvania 17603 Phone 717/299-5211		
A Subsidiary of High Industries, Inc.		
GIRDER G8A		
I-395 BRIDGE OVER PENOBSCOT RIVER		
I-395 BRIDGE STA. 164+60.00		
PENOBSCOT COUNTY		
STATE OF MAINE		
DEPARTMENT OF TRANSPORTATION		
STATE CONTRACT OR REF. NO. 6	CONTRACTOR CIANERO CORP.	
IN CHARGE: HINKLE	MADE BY: G.F.Z.	CHK. BY: CS
CONTRACT ME-84088-1	DRAWING NUMBER: 14 OF 36	DATE: 6-28-84



AF 22083A

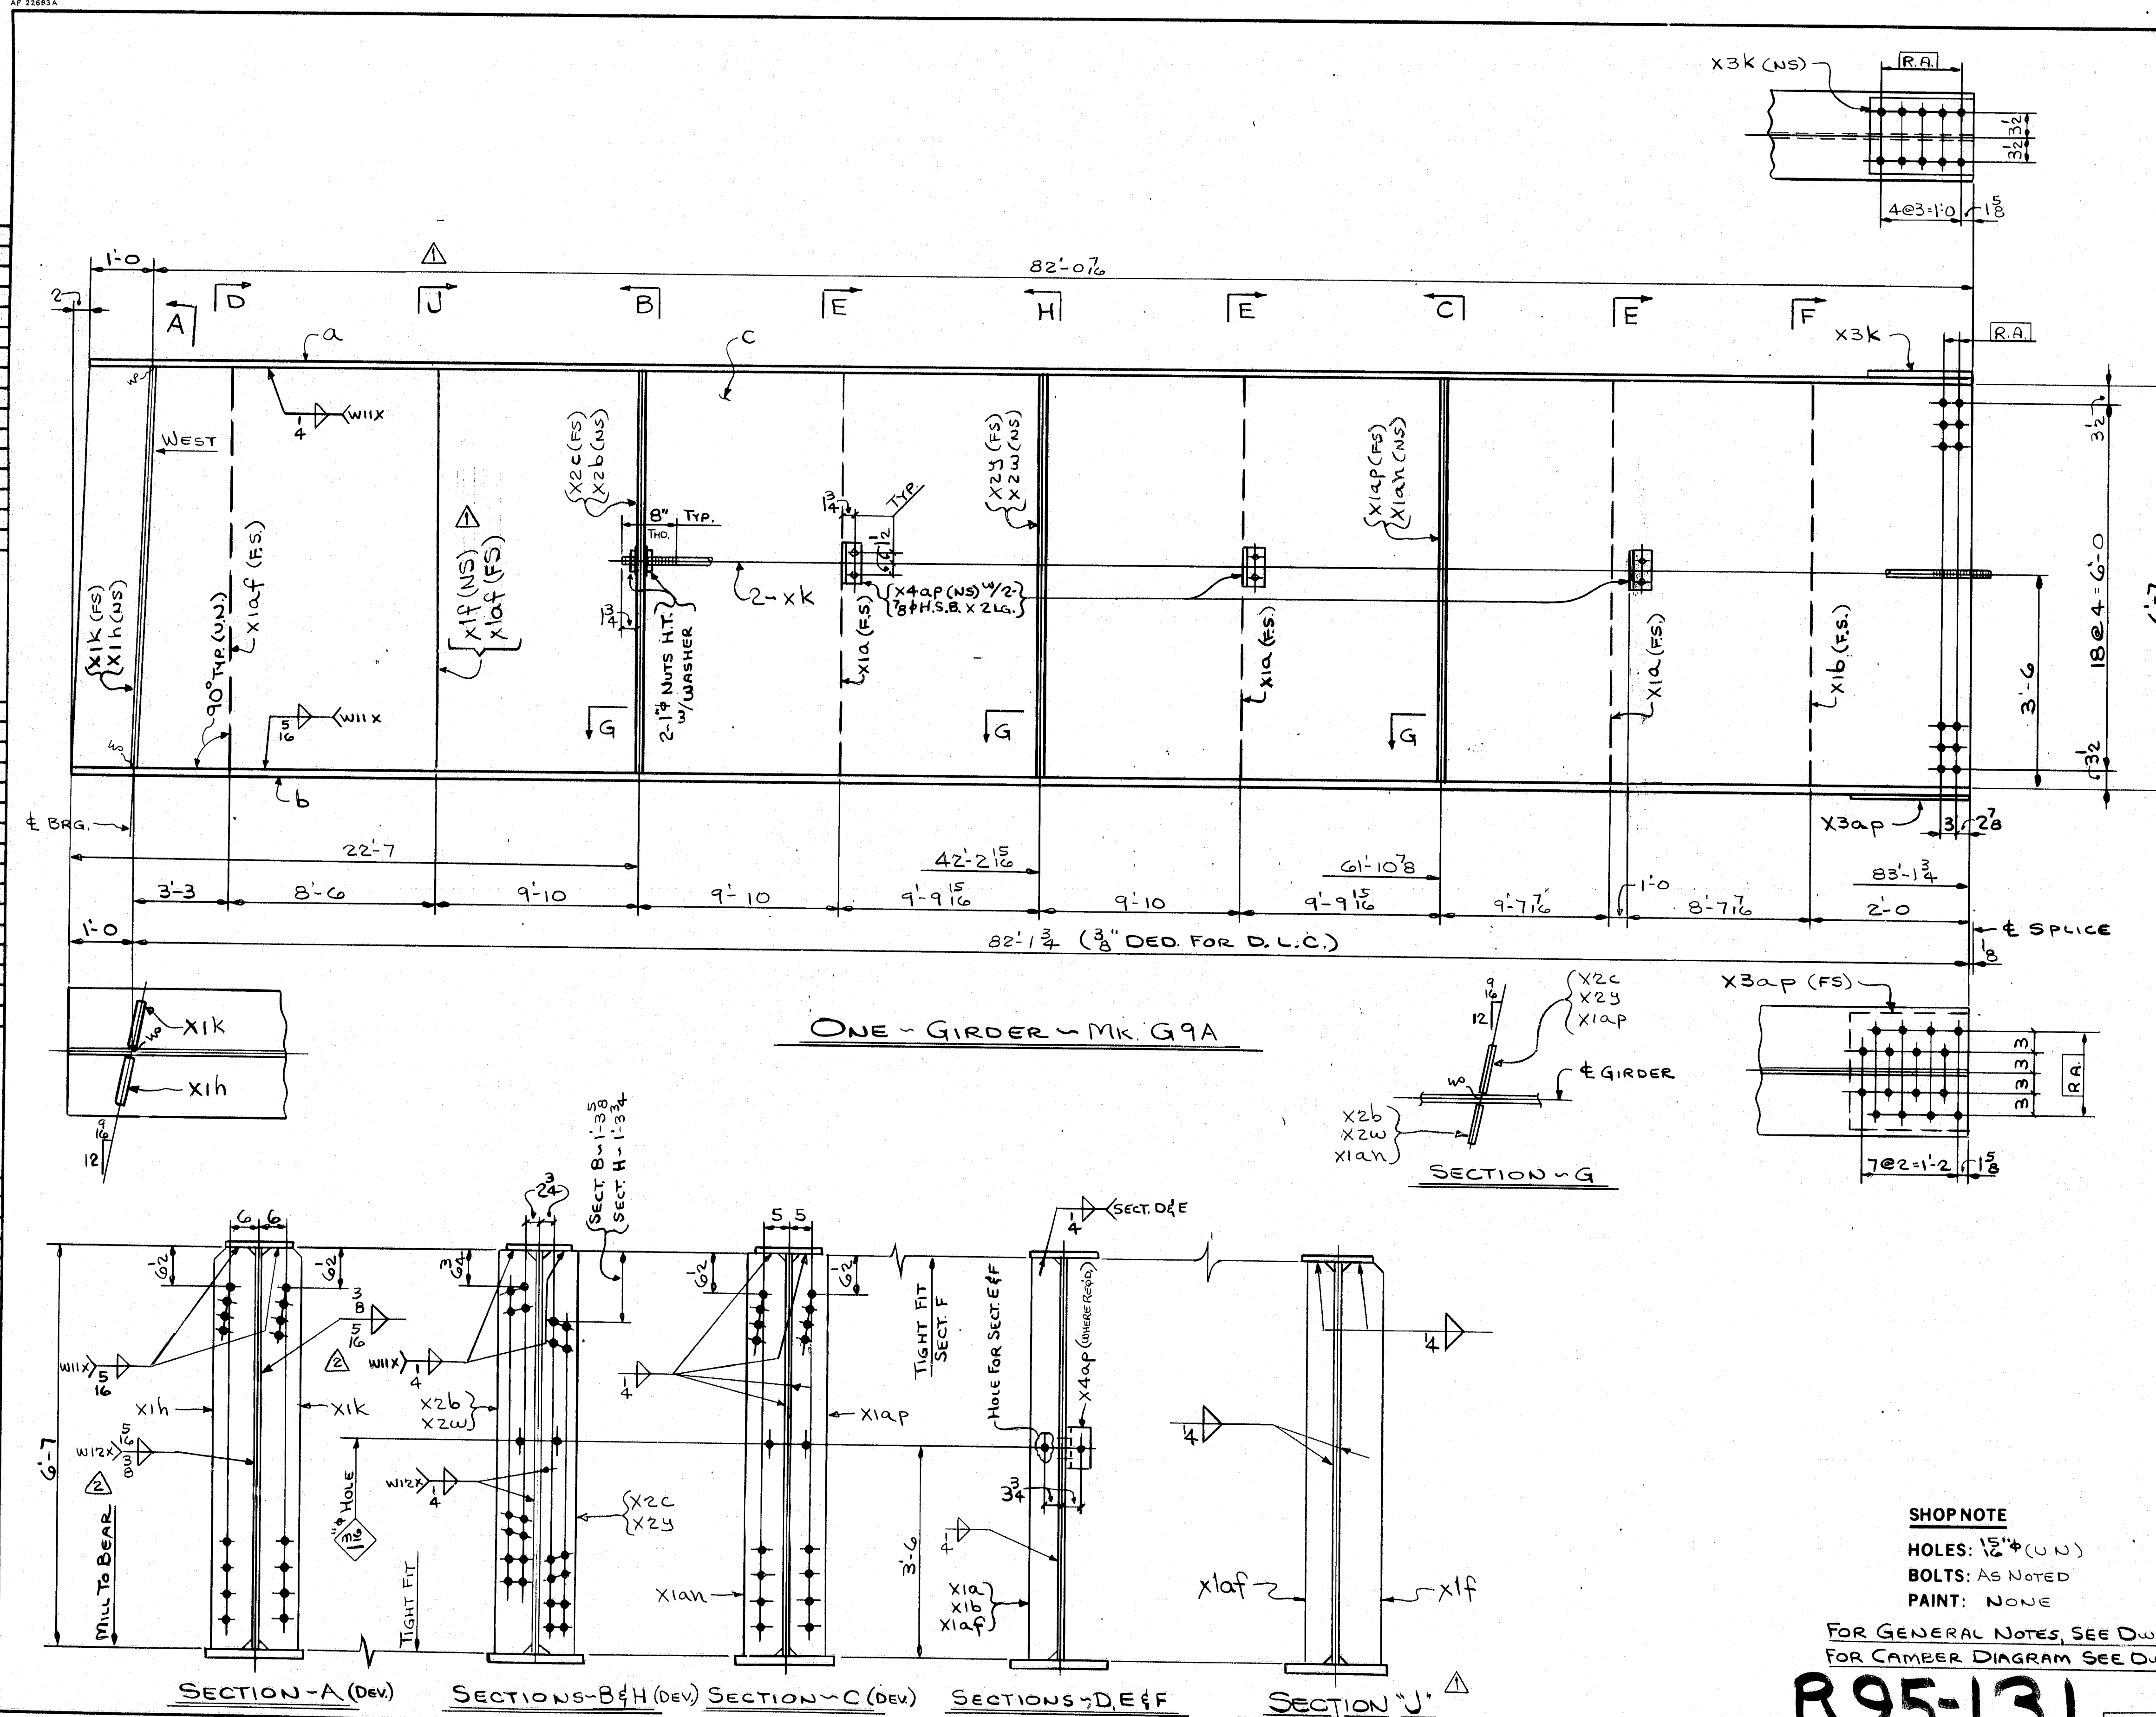

FED. ROAD DIV. NO.		STATE	FED. AID PROJ. NO.
1		ME	I-19-395-8(82)

BILL OF MATERIAL						
NO.	MARK	DESCRIPTION	LENGTH	REMARKS	ITEM	QTY
ONE	G9A	GIRDER				23
ONE	a	R. 13 x 3/4	83	0.7		
ONE	b	R. 19 x 1 1/2	83	1 3/4		
ONE	c	R. 79 x 1/2	83	2 1/2		
2	XK	1" ROD	60	11 3/4	THD. BOTH ENDS	6 17
ONE	X1F	R. 10 x 3/8	6	7		
ONE	X3K	FILL R. 11 x 1"	1	3.8		
ONE	X3ap	FILL R. 17 x 4	1	5.6		
3	X1a	BAR 5 x 1/2	6	7		
ONE	X1b	BAR 5 x 1/2				
2	X1ap	BAR 5 x 1/2				
ONE	X1K	BAR 8 x 1"				
	X1h	BAR 8 x 1"				
	X2c	BAR 7 x 1/2				
	X2b					
	X2w					
	X2y					
	X1ap					
ONE	X1ay	BAR 7 x 1/2	6	7		
3	X4ap	5 x 3 x 1/4	0	6		
4		1" STD. HEX NUTS			BI	12
4		WASH. FOR 1" ROD			BI	8
6		7/8" H.S. BOLTS	0	2	BI	2
6		WASH. FOR 7/8" H.S. BOLT			BI	9

# SHOP NOTE

HOLES: 1/2" (U.N.)  
BOLTS: AS NOTED  
PAINT: NONE

FOR GENERAL NOTES, SEE DWG. N1.  
FOR CAMBER DIAGRAM SEE DWG. WCI.

R95-131


CODE: 4000

NO.	REVISION	CHANGED WELD SIZES	DATE	1-3-85
NO.	REVISION	CONTRACT REVISION	DATE	10-84
HIGH STEEL STRUCTURES, INC.				
1805 Old Philadelphia Pk. Lancaster, Pennsylvania 17603 Phone 717 299-5211				
A Subsidiary of High Industries, Inc.				
GIRDER G9A				
I-395 BRIDGE OVER PENOBSCOT RIVER				
I-395 BRIDGE STA. 164 + 60.00				
PENOBSCOT COUNTY				
STATE OF MAINE				
DEPARTMENT OF TRANSPORTATION				
STATE CONTRACT OR REF. NO.	6	CONTRACTOR	CIANERO CORP.	
IN CHARGE	HINKLE	MADE BY	G.F.Z.	CHK D
CONTRACT NUMBER	ME-84088-1	DRAWING NUMBER	15 OF 36	DATE





AF 22857A

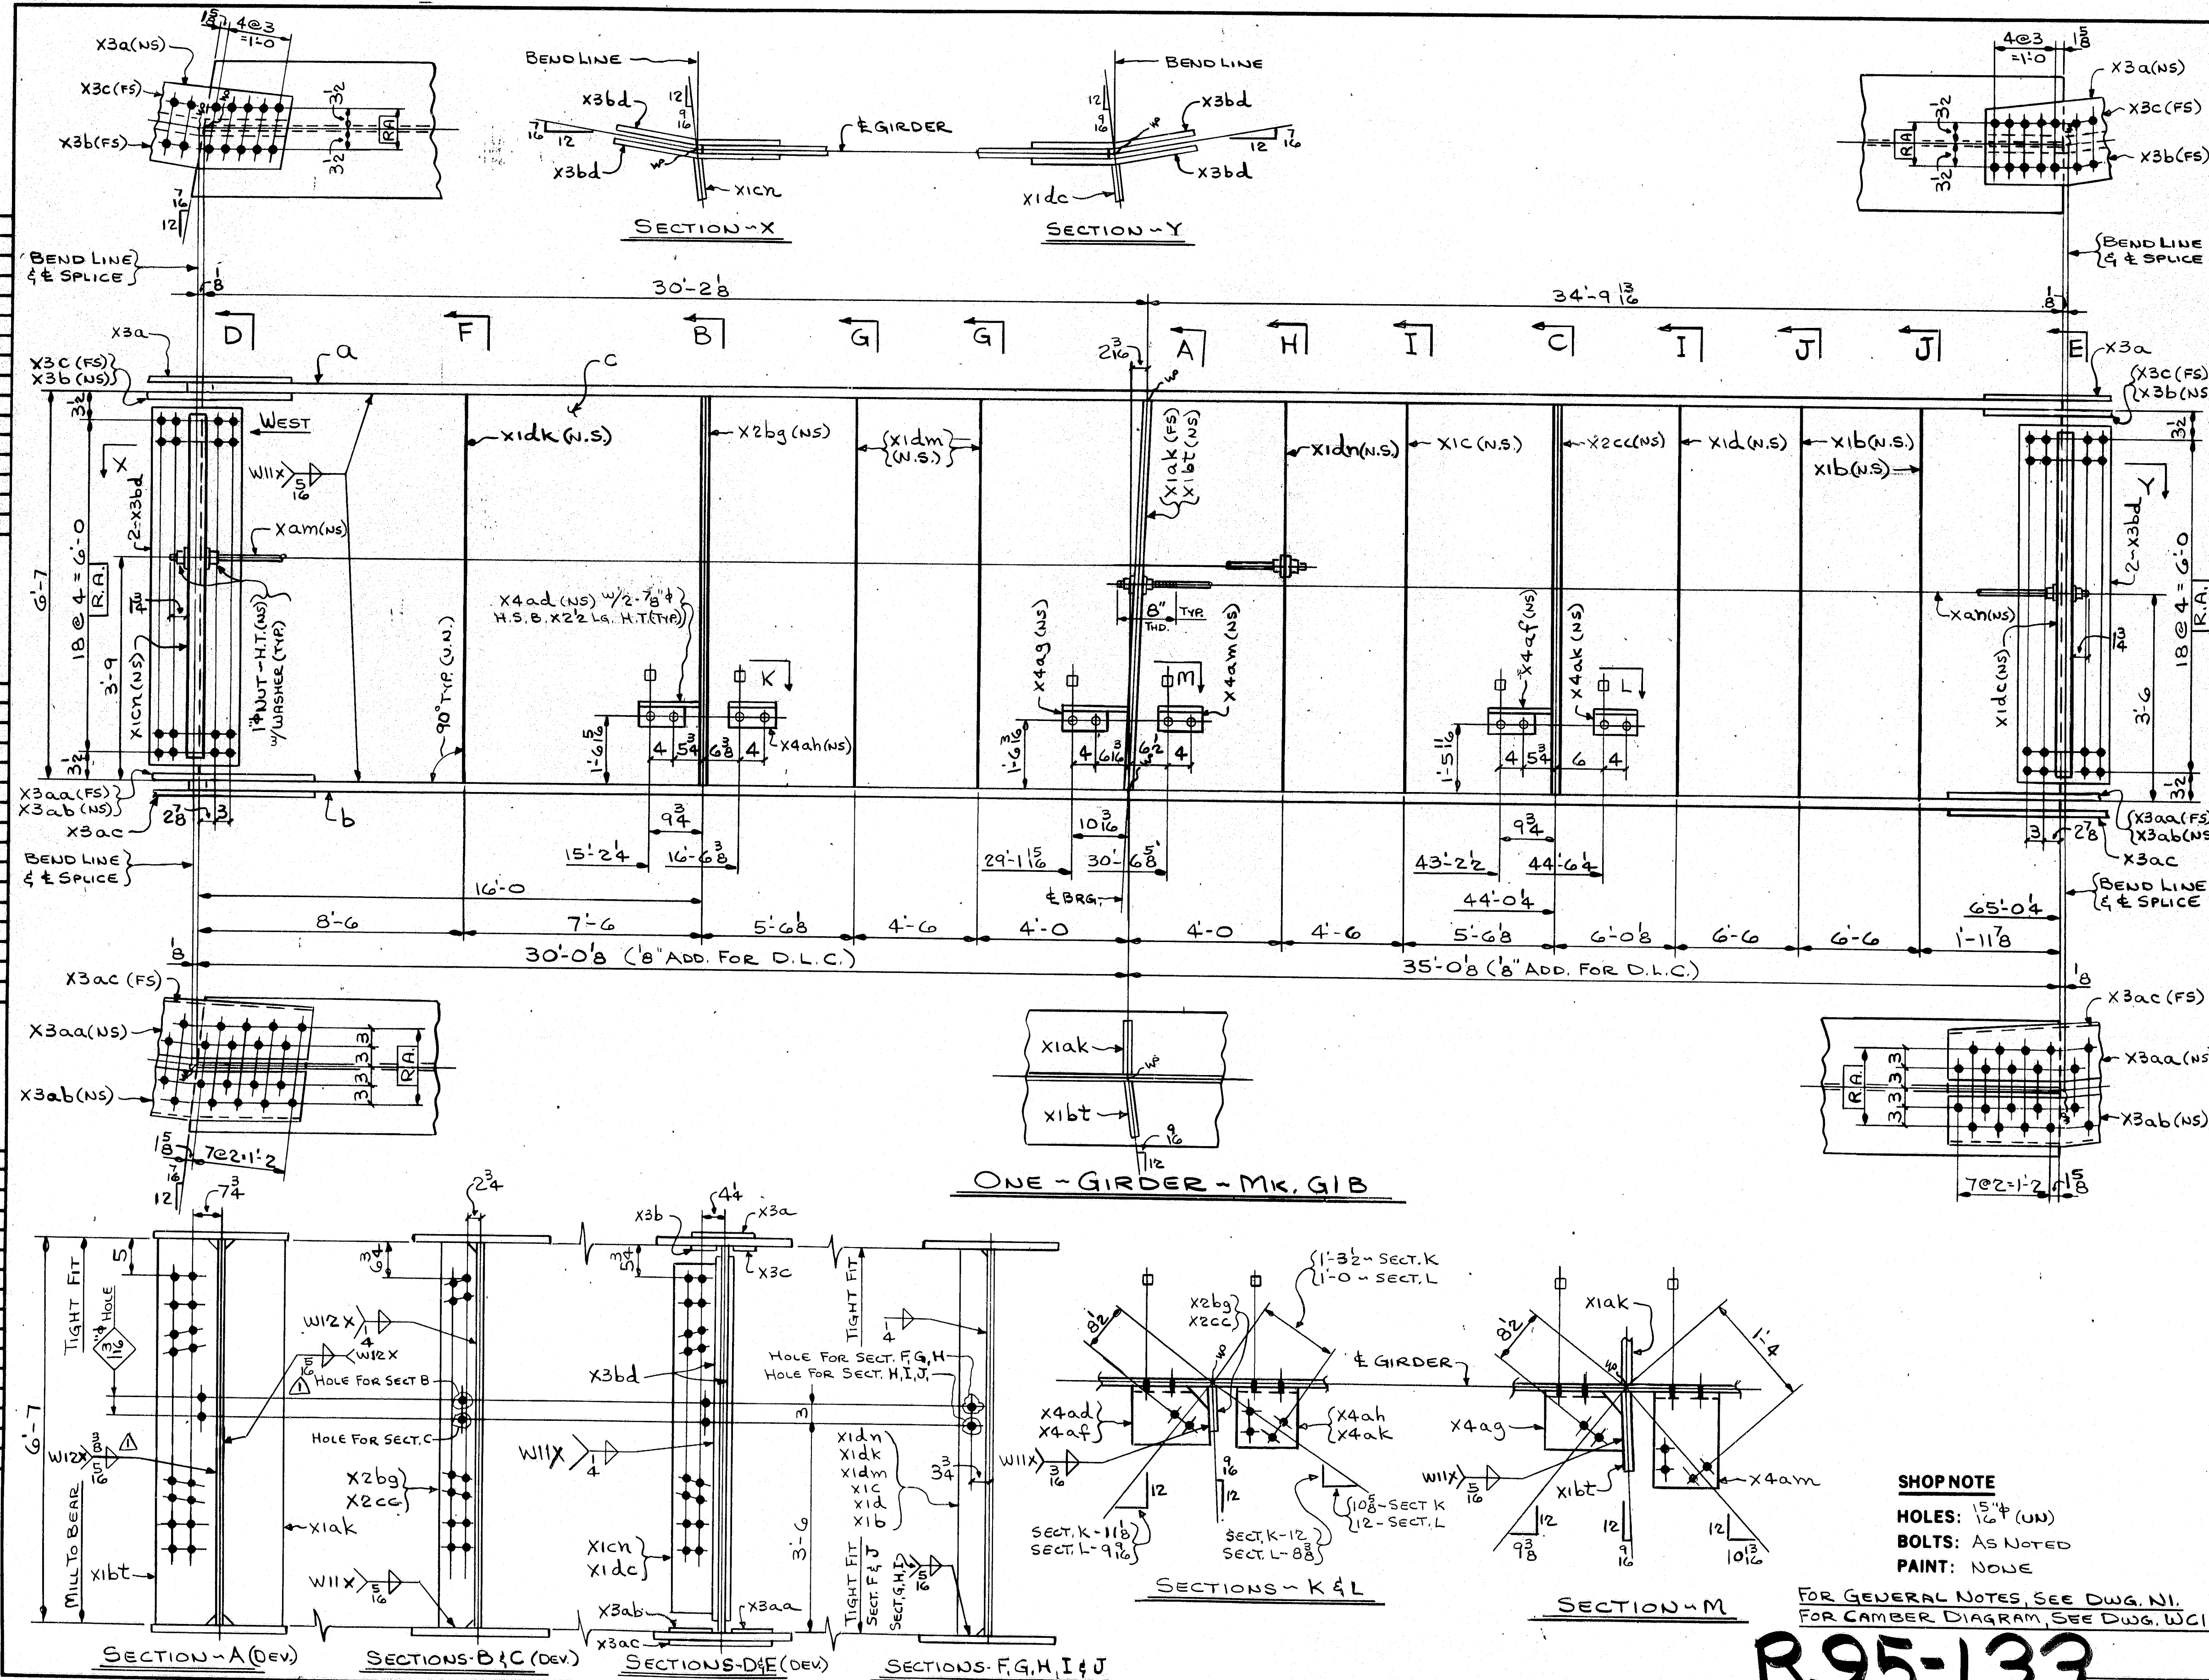

FED. ROAD DIV. NO.		STATE	FED. AID PROJ. NO.
1		ME	I-395-8(82)174

BILL OF MATERIAL					
NO.	MARK	DESCRIPTION	LENGTH	REMARKS	SHIP WEIGHT
ONE	GIB	GIRDER			32,740
ONE	a	PL. 27 X 1 1/2	65 0 1/2		773.66
ONE	b	PL. 27 X 1 1/2	65 0 3/4		773.75
ONE	c	PL. 79 X 1 1/2	65 0 4		1,134.34
ONE	Xam	1" ROD	34.44	THD. BOTH ENDS	6.3
ONE	Xan	1" ROD	35.33	THD. BOTH ENDS	6.3
2	X1b	BAR 5 X 1 1/2	6 7		14.8
ONE	X1c	BAR 6 X 1 1/2			25.1
ONE	X1d	BAR 5 X 1 1/2			41.88
ONE	X1dk	BAR 5 X 1 1/2			41.82
2	X1dm	BAR 6 X 1 1/2			107.8
ONE	X1dn	BAR 6 X 1 1/2			157.1
ONE	X1ak	PL. 12 X 1 1/2			1.77
ONE	X1bt	PL. 12 X 1 1/2			1.77
ONE	X2b9	BAR 7 X 1 1/2			44.65
ONE	X2cc	BAR 7 X 1 1/2	6 7		21.62
ONE	X1cn	BAR 8 X 1 1/2	6 1		22.5
ONE	X1dc	BAR 8 X 1 1/2	6 1		21.35
2	X3a	PL. 11 1/2 X 1/2	2 6 1/2		12.14
2	X3b	BAR 4 1/2 X 3/4	2 6 1/2		5.31
2	X3c	BAR 4 1/2 X 3/4	2 6 1/2		5.31
2	X3aa	PL. 8 5/8 X 1"	2 10 1/2		11.8
2	X3ab	PL. 8 5/8 X 1"	2 10 1/2		11.8
2	X3ac	PL. 17 5/8 X 7/8	2 10 1/2		24.74
4	X3bd	BENT PL. 75 X 1/2	1 3		4.81
ONE	X4ad	PL. MC 18 X 45.8	0 11 1/2		75.5
2	X4af		0 11 1/2		75.5
2	X4ag		0 11 1/2		75.5
2	X4ah		0 9 1/4		57.3
2	X4ak		0 8 1/2		27.04
ONE	X4am	PL. MC 18 X 45.8	0 9 1/2		57.3
12		7/8" H.S. BOLTS	0 2 1/2		1.6
12		WASH. FOR 7/8" H.S. BOLT			4
8		1" STD. HEX. NUTS			12
8		WASH. FOR 1" ROD			8

**SHOP NOTE**

HOLES: 1 1/2" (UN)  
BOLTS: AS NOTED  
PAINT: NONE

FOR GENERAL NOTES, SEE DWG. N1.  
FOR CAMBER DIAGRAM, SEE DWG. W1.


**R95-133**

CODE: 4000

NO. 1	REVISION CHANGED WELD SIZES	DATE 1-3-85
<b>HIGH STEEL STRUCTURES, INC.</b> 1905 Old Philadelphia Pike Lancaster, Pennsylvania 17603 Phone 717/298-5211 A Subsidiary of High Industries, Inc.		
<b>GIRDER GIB</b> I-395 BRIDGE OVER PENOBSCOT RIVER I-395 BRIDGE STA. 164+60.00 PENOBSCOT COUNTY STATE OF MAINE DEPARTMENT OF TRANSPORTATION		
STATE CONTRACT OR REF. NO. 6	CONTRACTOR GAMBRO CORP.	
IN CHARGE: HINKLE	MADE BY: G.F.Z.	CHK'D BY: CS
DATE: 6-28-84	DRAWING NUMBER: 17 OF 36	



AF 22883A

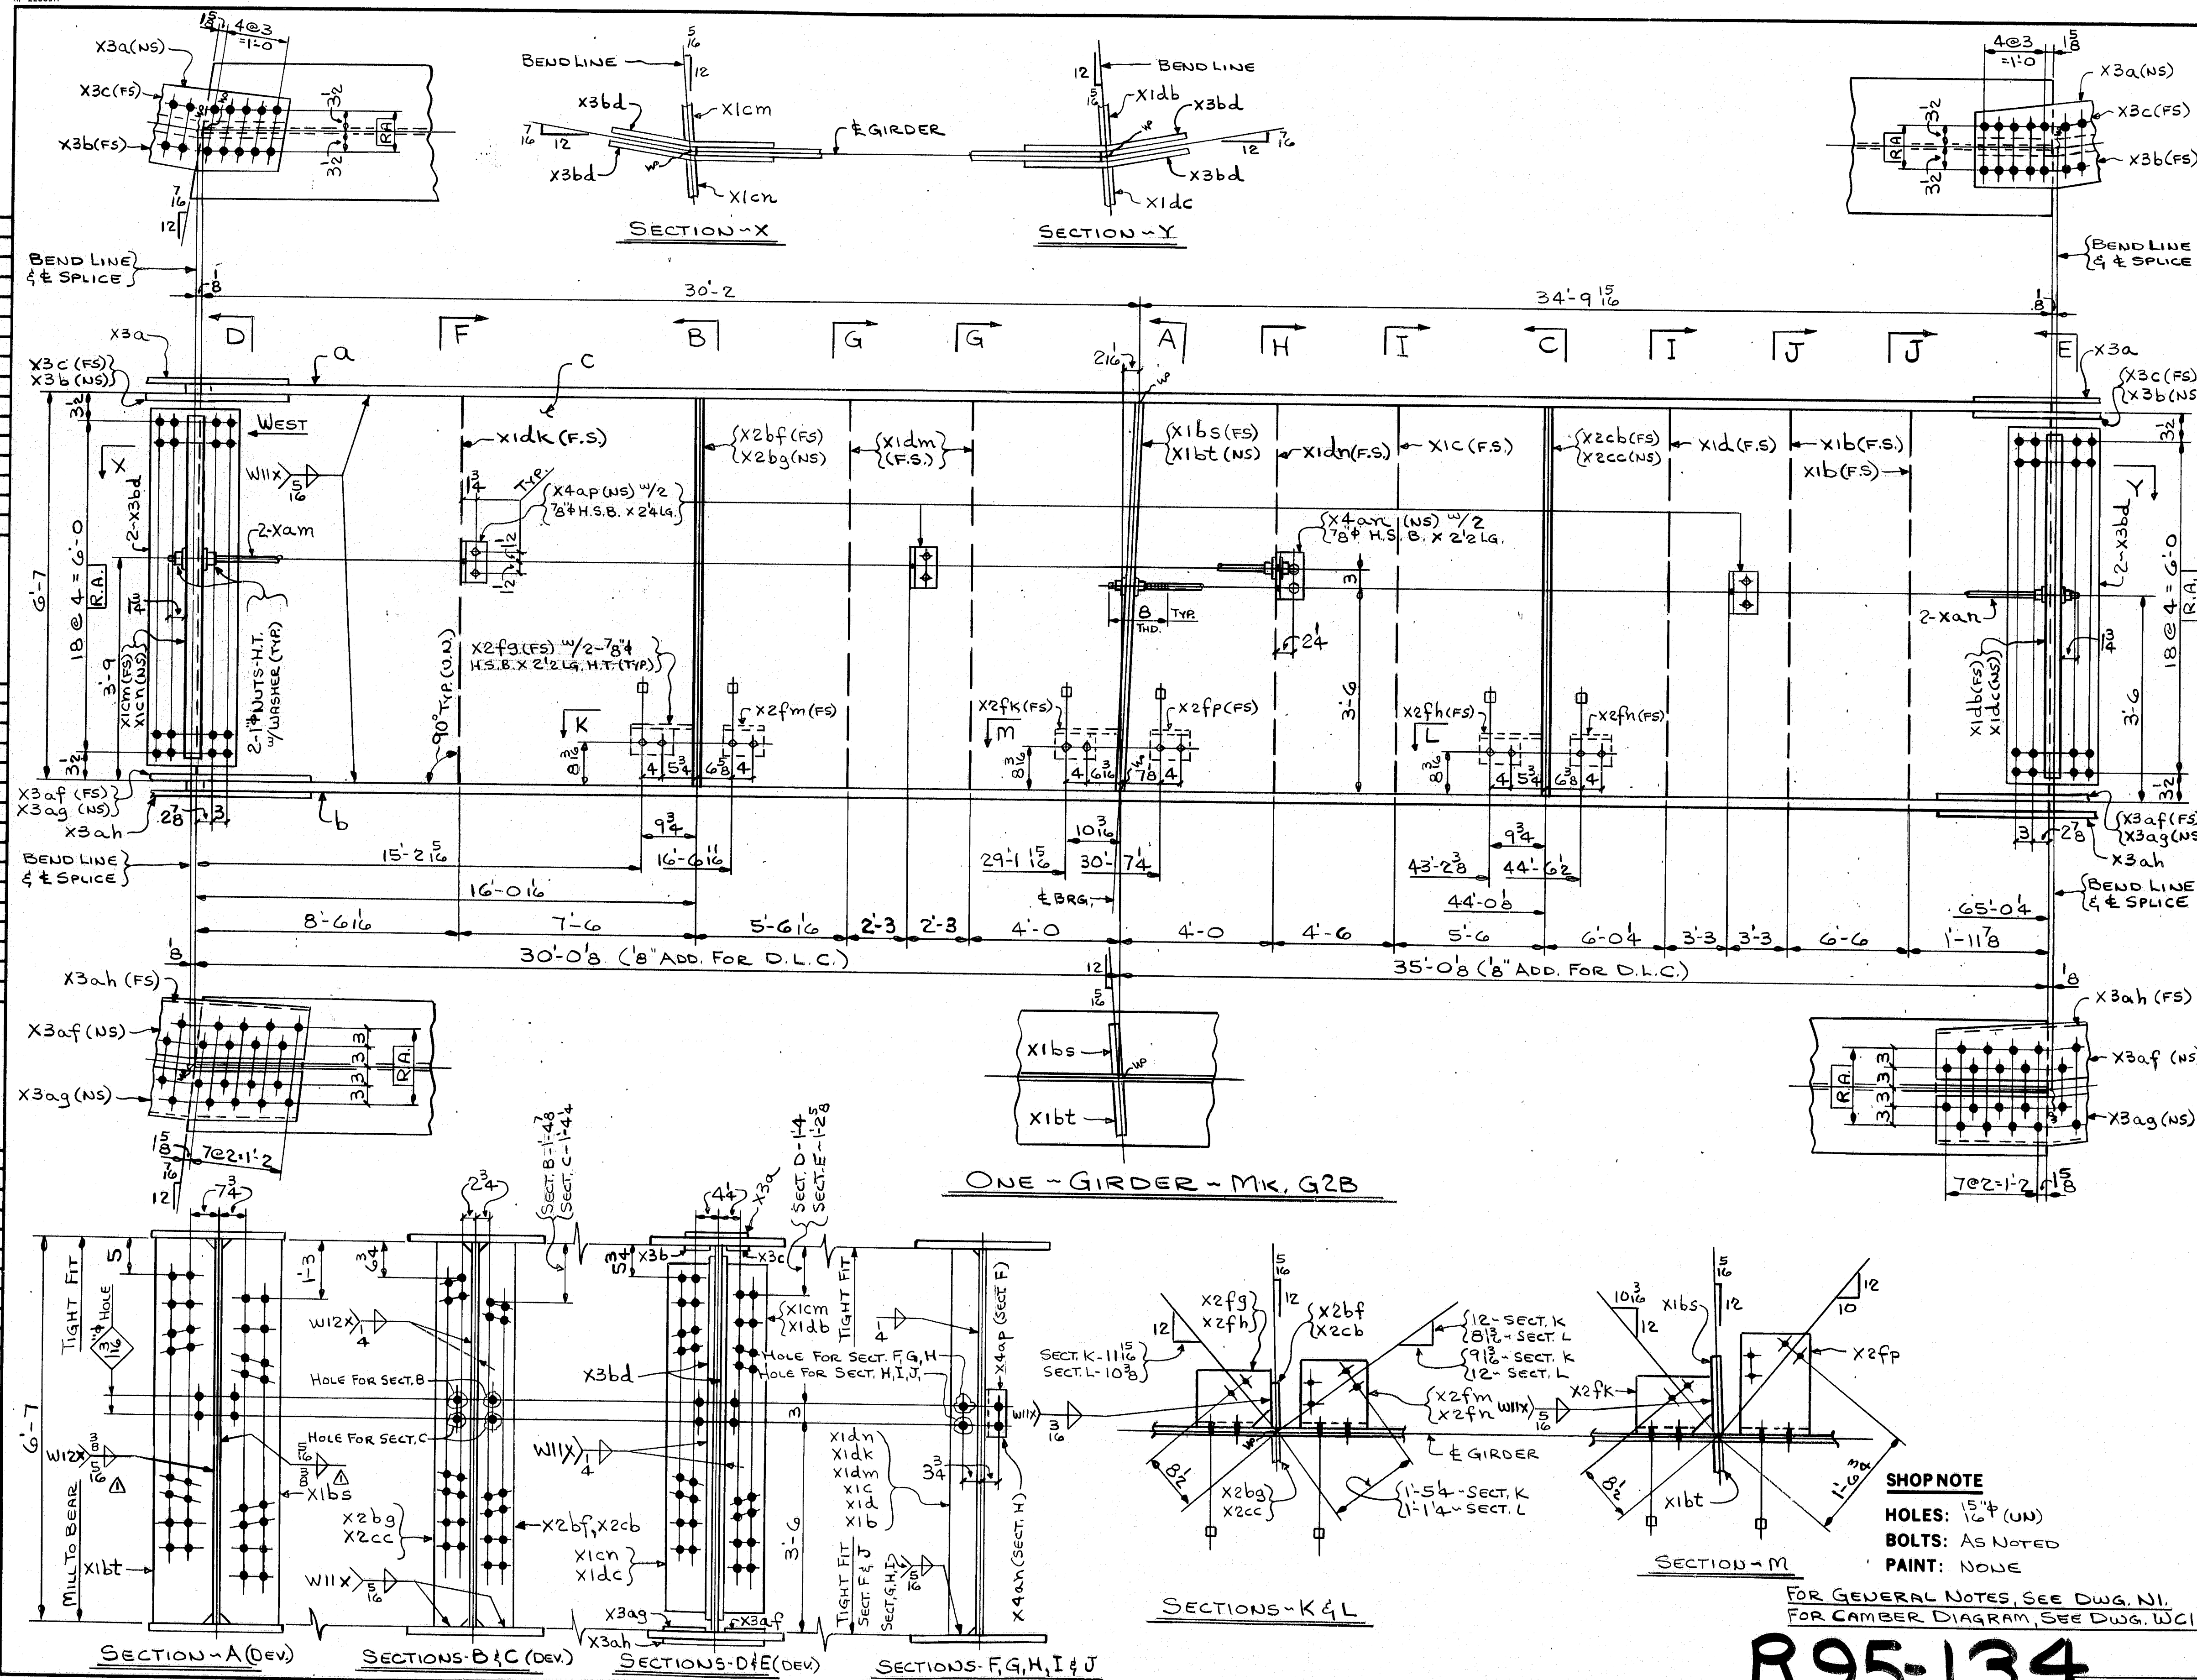

FED. ROAD DIST. NO.	STATE	FED. AID PROJ. NO.
1	ME	116-395-8(80)176

BILL OF MATERIAL					
NO.	MARK	DESCRIPTION	LENGTH	REMARKS	ITEM WEIGHT
ONE	G2B	GIRDER			33,255
ONE	A	PL 27 X 1 1/2	65 0 1/2		
ONE	B	PL 27 X 1 1/2	65 0 1/2		
ONE	C	PL 79 X 1 1/2	65 0 1/2		
2	Xam	1" ROD	34 4 1/4	THD. BOTH ENDS	6 3/4
2	Xan	1" ROD	35 3 3/8	THD. BOTH ENDS	6 3/4
2	X1b	BAR 5 X 1 1/2	6 7		
ONE	X1c	BAR 6 X 1 1/2			
ONE	X1d	BAR 5 X 1 1/2			
ONE	X1dk	BAR 5 X 1 1/2			
2	X1dm	BAR 6 X 1 1/2			
ONE	X1dn	BAR 6 X 1 1/2			
	X1bs	PL 12 X 1 1/2			
	X1bt	PL 12 X 1 1/2			
	X2bf	BAR 7 X 1 1/2			
	X2bg				
	X2cb				
	X2cc	BAR 7 X 1 1/2	6 7		
	X1cm	BAR 8 X 2	6 1		
	X1cn				
	X1db				
ONE	X1dc	BAR 8 X 1/2	6 1		
3	X4ap	5 X 3 X 1/4	0 6		
ONE	X4am	5 X 3 1/2 X 1/2	0 6		
2	X3a	PL 11 1/2 X 1/2	2 6 1/2		
	X3b	BAR 4 1/2 X 3/4	2 6 1/2		
	X3c	BAR 4 1/2 X 3/4	2 6 1/2		
	X3af	PL 8 1/2 X 1"	2 10 1/2		
	X3ag	PL 8 1/2 X 1"	2 10 1/2		
2	X3ah	PL 17 1/2 X 3/8	2 10 1/2		
4	X3bd	BENT PL 75 X 1/2	1 3		
16		1" STD. HEX NUTS			B1 1/2
16		WASH. FOR 1" ROD			B1 1/8
6		7/8" H.S. BOLTS	0 2 1/4		B1 3/8
14		7/8" H.S. BOLTS	0 2 1/2		B1 4
20		WASH. FOR 7/8" H.S. BOLTS			B1 9
ONE	X2fg	PL MC18 X 45.8	0 11 1/2		
	X2fh		0 11 1/2		
	X2fk		0 11 1/2		
	X2fm		0 10 1/4		
	X2fn		0 9 3/4		
ONE	X2fp	PL MC18 X 45.8	0 11 1/2		

NO.	REVISION	CHANGED WELD SIZES	DATE
1			1-3-85

HIGH STEEL STRUCTURES, INC.	
1905 Old Philadelphia Pike Lancaster, Pennsylvania 17603 Phone 717/296-5211	
A Subsidiary of High Industries, Inc.	
GIRDER G2B	
I-395 BRIDGE OVER PENOBSCOT RIVER	
I-395 BRIDGE STA. 164+60.00	
PENOBSCOT COUNTY	
STATE OF MAINE	
DEPARTMENT OF TRANSPORTATION	
STATE CONTRACT OR REF. NO.	CONTRACTOR
6	GAUBRO CORP.
IN CHARGE: HINKLE	MADE BY: G.F.Z. CHK. D. BY: CS DATE: 6-28-84
CONTRACT NUMBER: ME-84088-1	DRAWING NUMBER: 18 OF 36

SHOP NOTE  
HOLES: 1 1/2" (W)  
BOLTS: AS NOTED  
PAINT: NONE


FOR GENERAL NOTES, SEE DWG. N1.  
FOR CAMBER DIAGRAM, SEE DWG. W1.

R95-134

CODE: 4000



AF 22683A

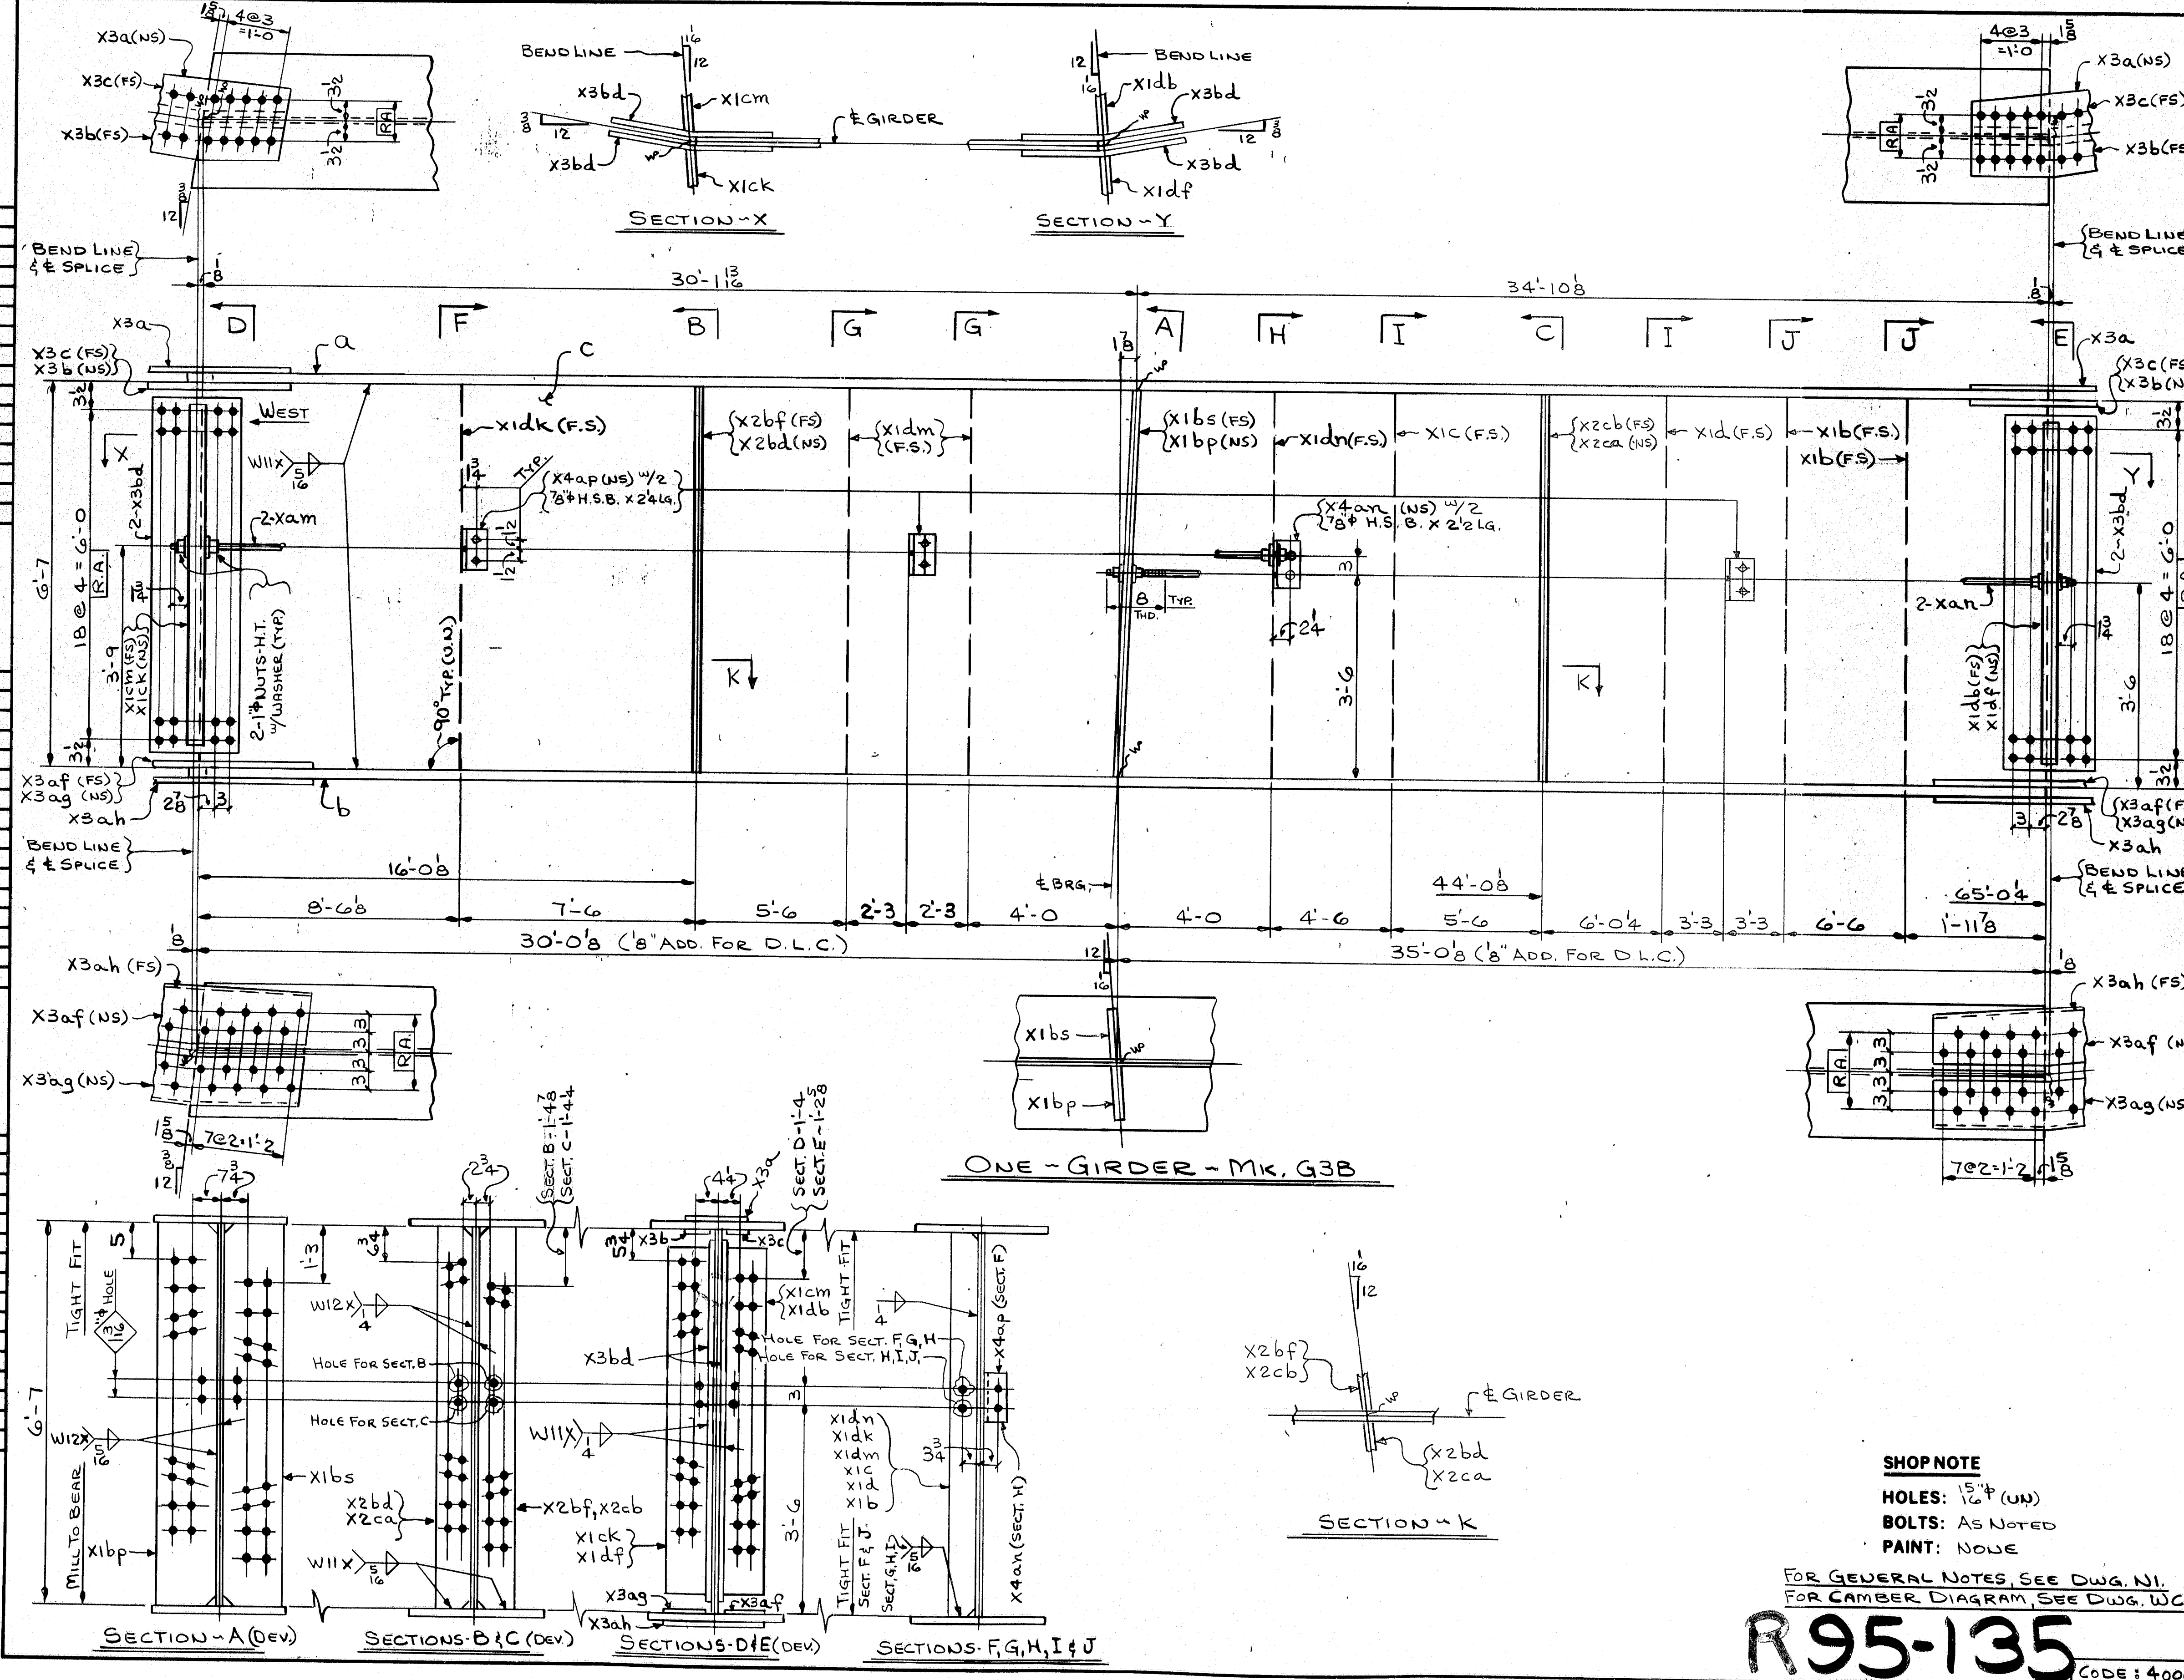

BILL OF MATERIAL					
NO.	NAME	DESCRIPTION	LENGTH	REMARKS	ITEM
ONE	G3B	GIRDER			32,995
ONE	a	PL. 27 x 1 1/2	65' 0 3/8		1711
ONE	b	PL. 27 x 1 1/2	65' 0 1/16		1715
ONE	c	PL. 79 x 9 1/2	65' 0 4		1715
2	Xam	1" Rod	34' 4 1/2	THD. BOTH ENDS	1830
2	Xan	1" Rod	35' 3 3/8	THD. BOTH ENDS	1830
16	1" STD. HEX NUTS				81
16	WASH. FOR 1" ROD				81
6	3/8" H.S. BOLTS	0' 2 1/4			81
2	3/8" H.S. BOLTS	0' 2 1/2			81
8	WASH. FOR 3/8" H.S. BOLTS				81

**SHOP NOTE**  
 HOLES: 1/2" (UN)  
 BOLTS: AS NOTED  
 PAINT: NONE


FOR GENERAL NOTES, SEE DWG. N1.  
 FOR CAMBER DIAGRAM, SEE DWG. W1.

**R95-135**

NO.	REVISION	DATE
HIGH STEEL STRUCTURES, INC.		
1395 BRIDGE OVER PENOBSCOT RIVER		
1395 BRIDGE STA. 164+60.00		
PENOBSCOT COUNTY		
STATE OF MAINE		
DEPARTMENT OF TRANSPORTATION		
STATE CONTRACT OR REF. NO.	CONTRACTOR	DATE
6	GABERO CORP.	6/28/84
IN CHARGE: HINKLE	MADE BY: GFK	CHK'D BY: CS
CONTRACT NO. ME-84088-1	DRAWING NUMBER	19 OF 36



AP 22683A

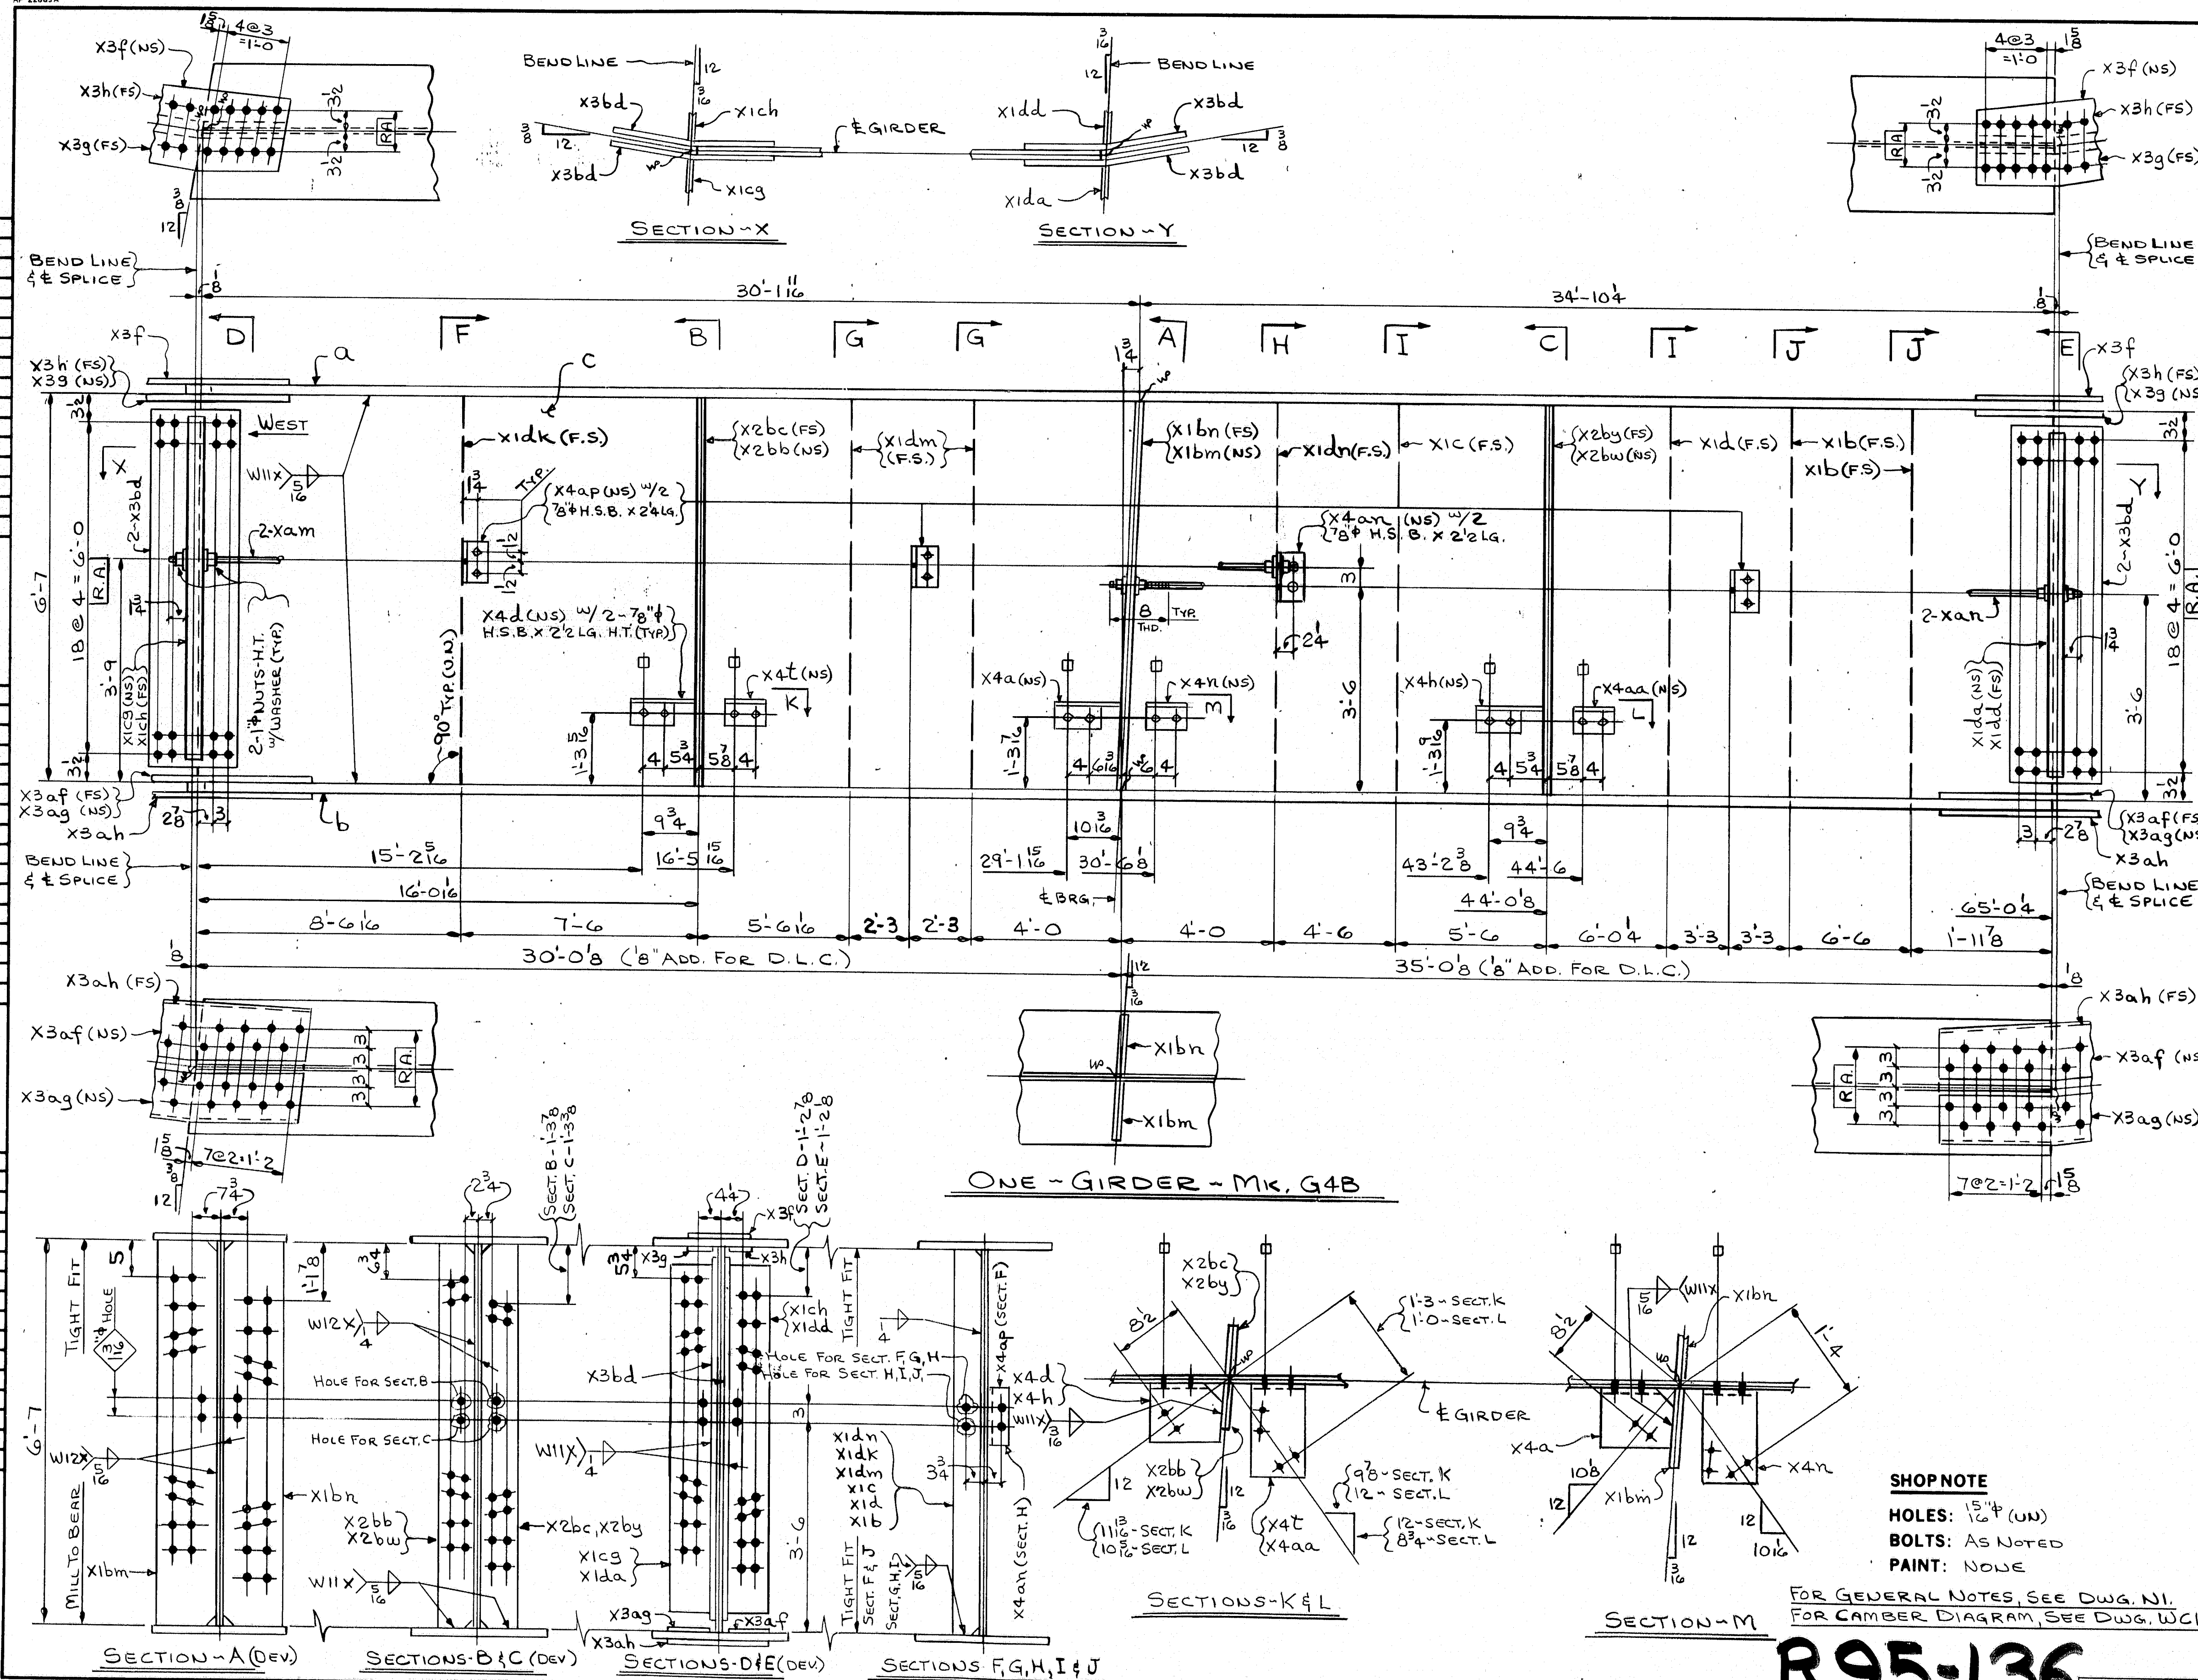

FED. ROAD DIV. NO.	STATE	FED. AID PROJ. NO.
1	ME	114-395-8(82)176

BILL OF MATERIAL					
NO.	MARK	DESCRIPTION	LENGTH	REMARKS	ITEM
ONE	G4B	GIRDER			33,175
ONE	a	PL. 27 X 1 1/2	65' 0 3/8		17,111
ONE	b	PL. 27 X 1 1/2	65' 0 11/16		17,111
ONE	c	PL. 79 X 1 1/2	65' 0 4		17,111
2	Xam	1" ROD	34' 4 1/2	THD. BOTH ENDS	6
2	Xan	1" ROD	35' 3 1/8	THD. BOTH ENDS	6

# SHOPNOTE

HOLES: 1/2" (UN)  
 BOLTS: AS NOTED  
 PAINT: NONE

FOR GENERAL NOTES, SEE DWG. N1.  
 FOR CAMBER DIAGRAM, SEE DWG. W1.

**R95-136**

NO.	REVISION	DATE
1		


HIGH STEEL STRUCTURES, INC.  
 1905 Old Philadelphia Pike  
 Lancaster, Pennsylvania 17603  
 Phone 717/299-5211  
 A Subsidiary of High Industries, Inc.

GIRDER G4B  
 I-395 BRIDGE OVER PENOBSCOT RIVER  
 I-395 BRIDGE STA. 164+60.00  
 PENOBSCOT COUNTY  
 STATE OF MAINE  
 DEPARTMENT OF TRANSPORTATION

STATE CONTRACT NO. 6 CONTRACTOR GAMBRO CORP.  
 IN CHARGE HINKLE MADE BY G.F.Z. CHK'D BY CS DATE 6/28/84  
 CONTRACT ME-84088-1 DRAWING NUMBER 20 OF 36



AF 22683A

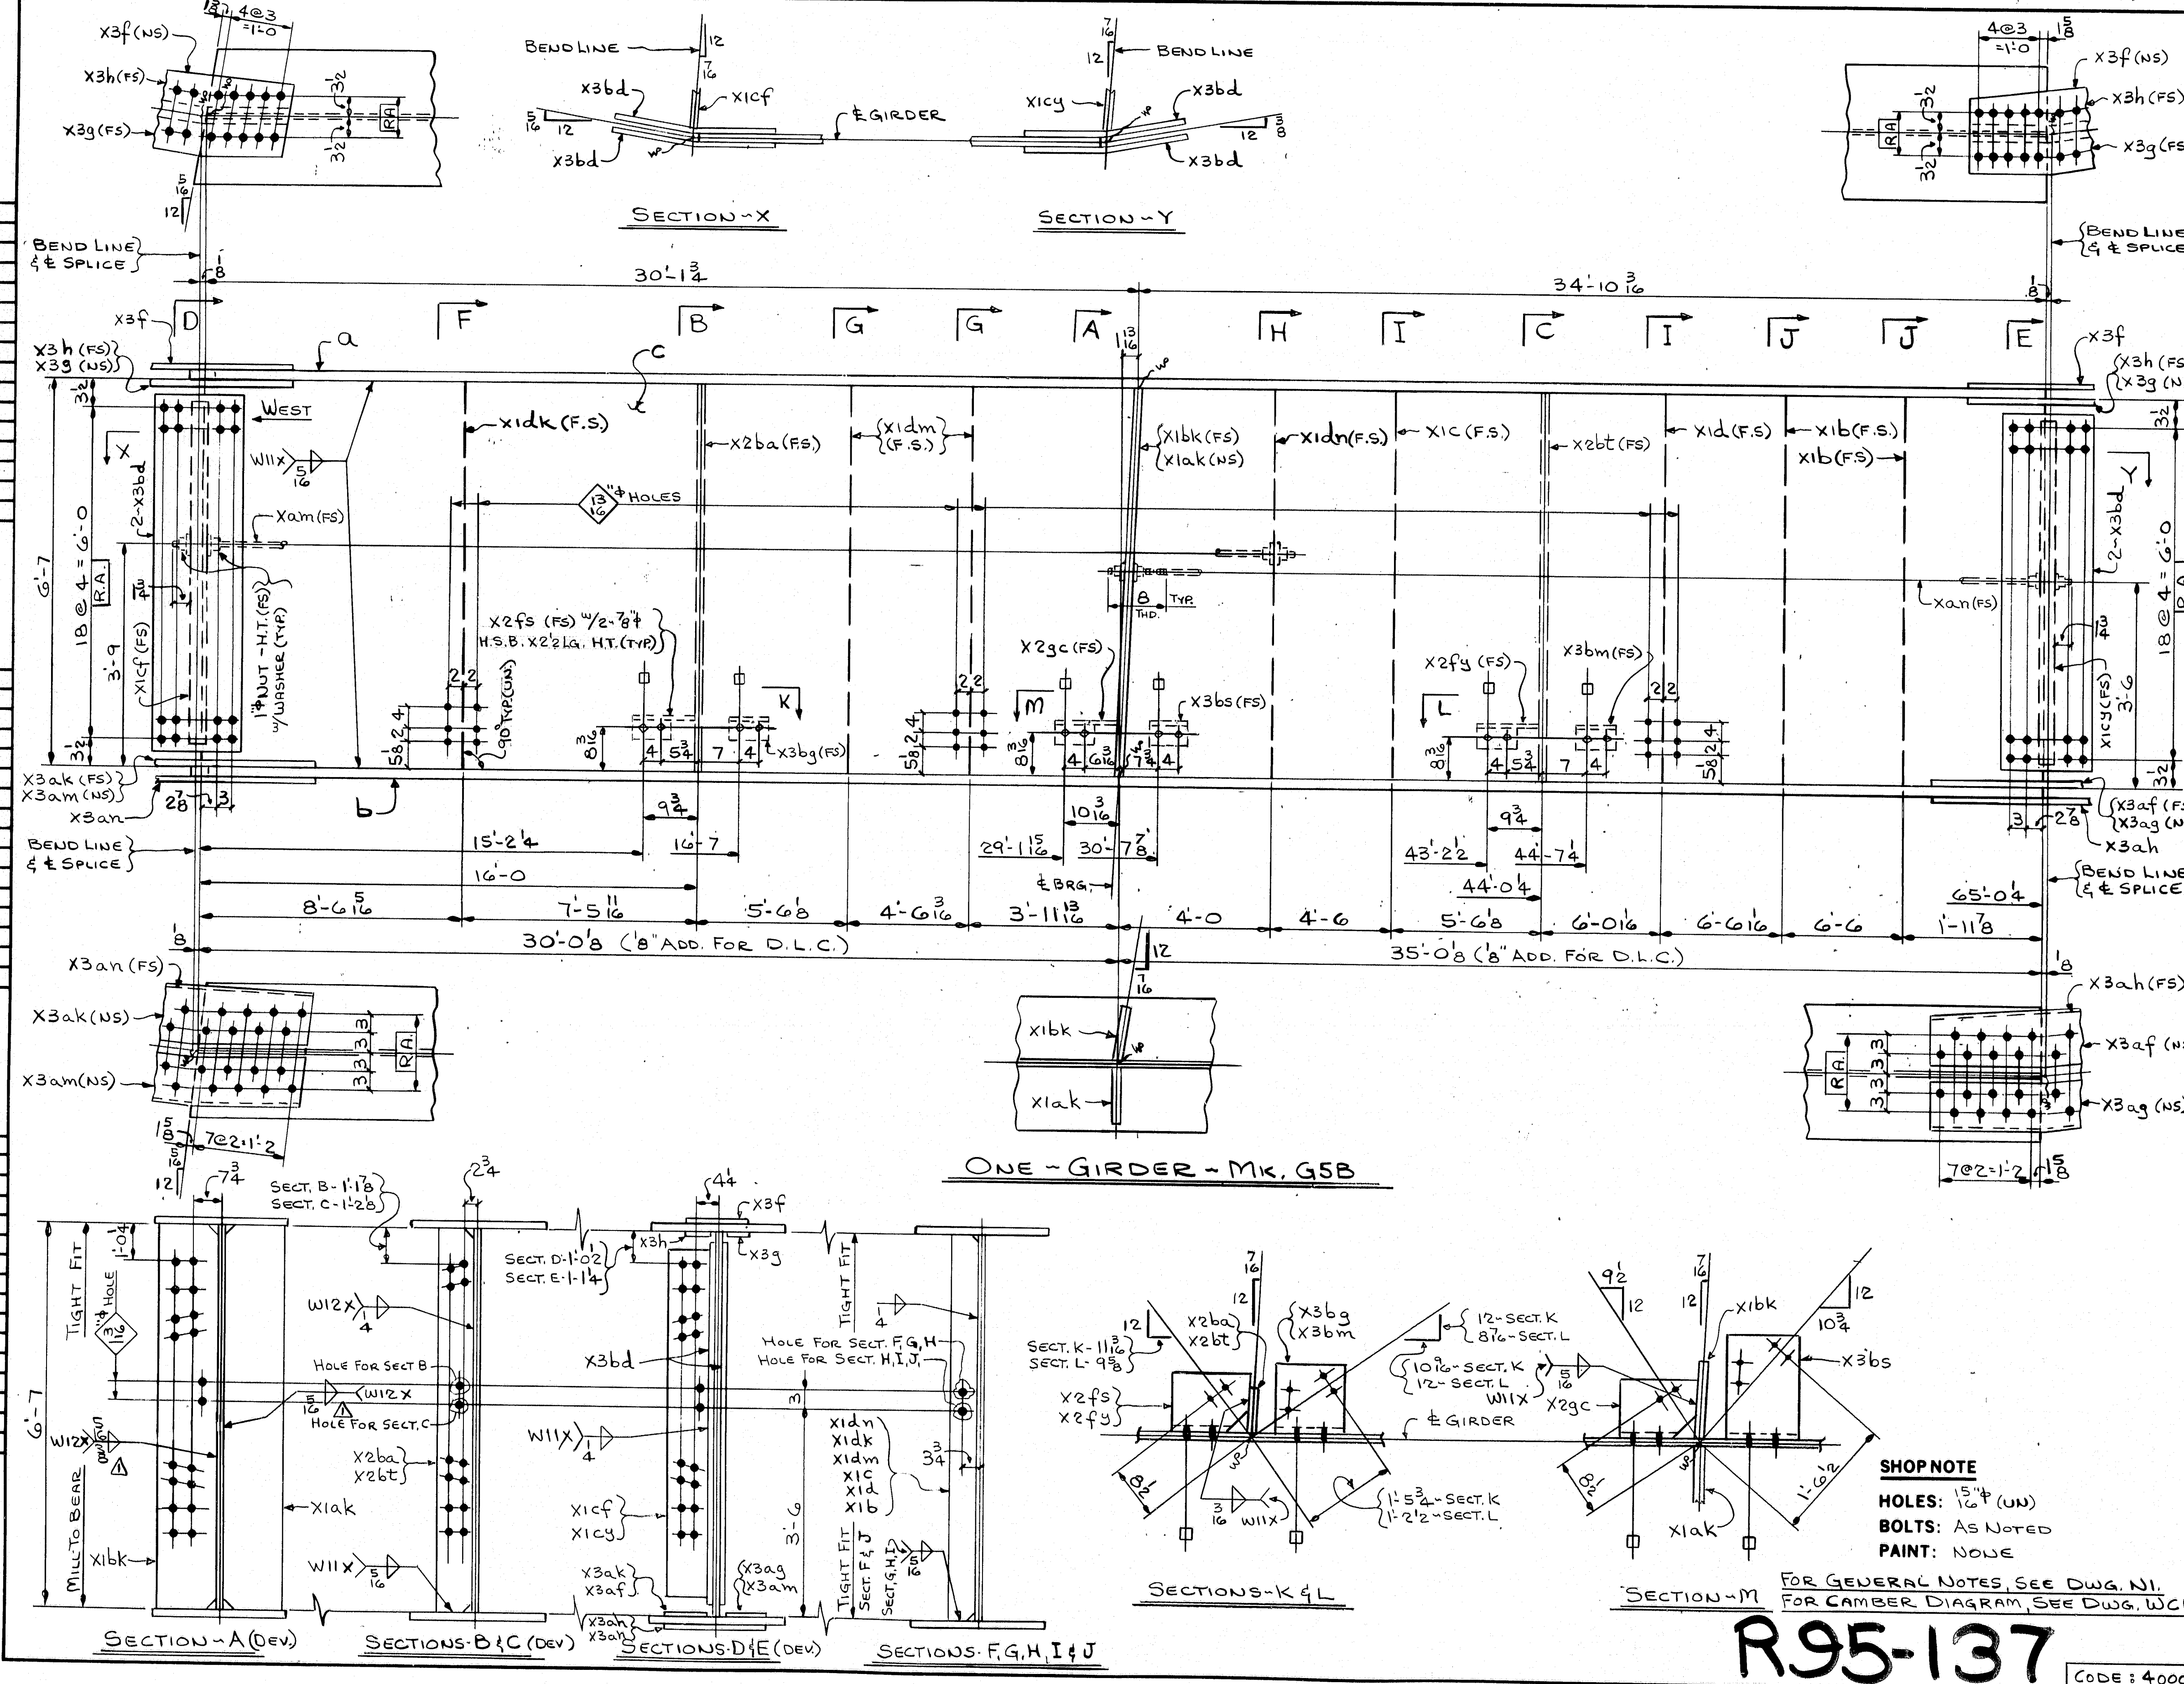

BILL OF MATERIAL					
NO.	MARK	DESCRIPTION	LENGTH	REMARKS	ITEM
ONE	G5B	GIRDER			32735
ONE	a	PL. 27 X 1 1/2	65 0 1/2		
ONE	b	PL. 27 X 1 1/2	65 0 3/8		
ONE	c	PL. 79 X 1 1/2	65 0 4		
ONE	Xam	1" ROD	34 4 4	THD. BOTH ENDS	6 3
ONE	Xan	1" ROD	35 3 8	THD. BOTH ENDS	6 3
2	X1b	BAR 5 X 1 1/2	6 7		
ONE	X1c	BAR 6 X 1 1/2			
ONE	X1d	BAR 5 X 1 1/2			
ONE	X1dk	BAR 5 X 1 1/2			
2	X1dm	BAR 6 X 1 1/2			
ONE	X1dn	BAR 6 X 1 1/2			
ONE	X1bk	PL. 12 X 1 1/2			
ONE	X1ak	PL. 12 X 1 1/2			
ONE	X2ba	BAR 7 X 1 1/2			
ONE	X2bt	BAR 7 X 1 1/2	6 7		
ONE	X1cf	BAR 8 X 1 1/2	6 1		
ONE	X1cy	BAR 8 X 1 1/2	6 1		
2	X3f	PL. 11 3/4 X 1 1/2	2 6 1/2		
2	X3g	BAR 4 3/8 X 3/4	2 6 1/2		
2	X3h	BAR 4 3/8 X 3/4	2 6 1/2		
ONE	X3af	PL. 8 1/2 X 1"	2 10 1/2		
ONE	X3ag	PL. 8 1/2 X 1"	2 10 1/2		
ONE	X3ah	PL. 17 1/2 X 3/8	2 10 1/2		
ONE	X3ak	PL. 8 3/8 X 1"	2 10 1/2		
ONE	X3am	PL. 8 3/8 X 1"	2 10 1/2		
ONE	X3an	PL. 17 3/8 X 3/8	2 10 1/2		
4	X3bd	BENT PL. 75 X 1/2	1 3		
ONE	X2fy	PL. MC 18 X 45.8	0 11 1/2		
ONE	X2fc		0 11 1/2		
ONE	X2fs		0 11 1/2		
ONE	X3bs		0 10 1/2		
ONE	X3bs		0 10 1/2		
ONE	X3bm	PL. MC 18 X 45.8	0 10 1/2		
12		3/4" H.S. BOLTS	0 2 1/2		
12		WASH. FOR 3/4" H.S. BOLTS			
8		1" STD. HEX. NUTS			
8		WASH. FOR 1" ROD			

NO. 1	REVISION	CHANGED WELD SIZES	DATE 1-3-85
HIGH STEEL STRUCTURES, INC.			
1905 Old Philadelphia Pike Lancaster, Pennsylvania 17603 Phone 717/299-5211			
A Subsidiary of High Industries, Inc.			
GIRDER G5B			
I-395 BRIDGE OVER PENOBSCOT RIVER			
I-395 BRIDGE STA. 164+60.00			
PENOBSCOT COUNTY			
STATE OF MAINE			
DEPARTMENT OF TRANSPORTATION			
STATE CONTRACT OR REF. NO.	6	CONTRACTOR	GANBRO CORP.
IN CHARGE	HINKLE	MADE BY	G.F.Z. CHK.D. BY CS
DATE	6-28-84		
CONTRACT NUMBER	ME-84088-1	DRAWING NUMBER	21 OF 36

R95-137


CODE: 4000







AF 22682A

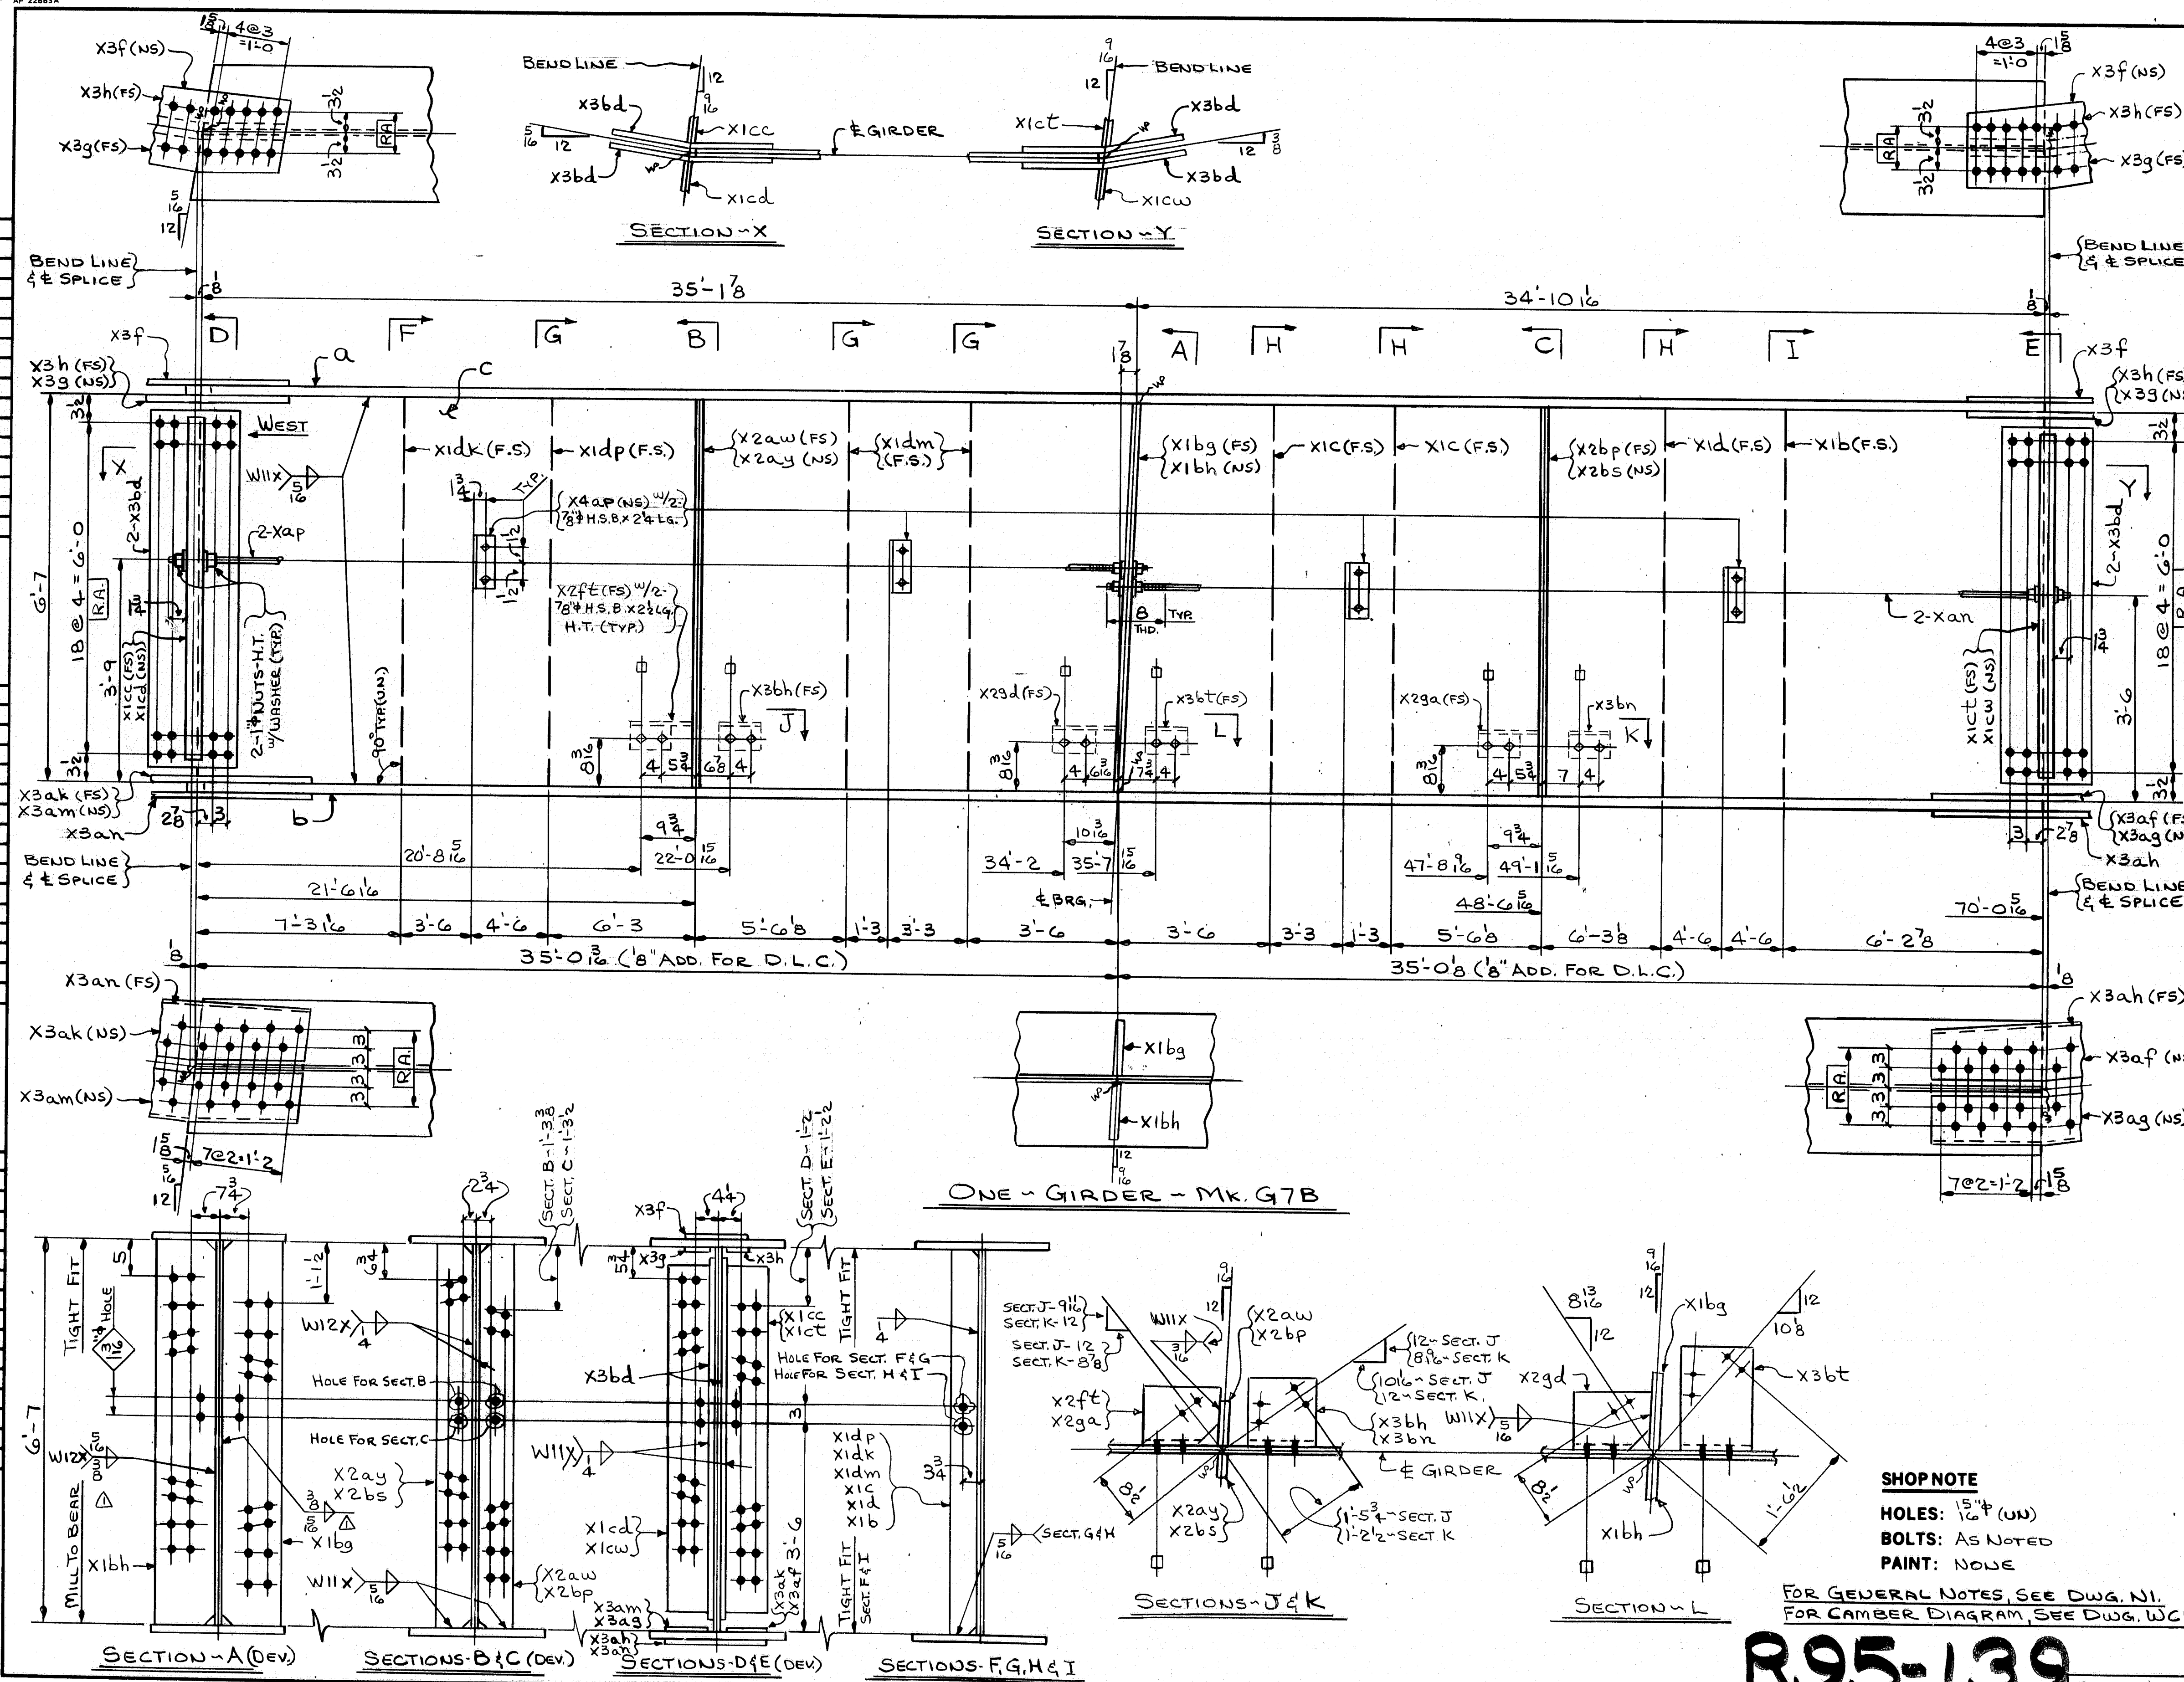


FED. ROAD DIV. NO.		STATE	FED. AID PROJ. NO.
1		ME	116-395-8(82)176

BILL OF MATERIAL					
NO.	MARK	DESCRIPTION	LENGTH	REMARKS	ITEM
ONE	G7B	GIRDER			37,110
ONE	a	PL. 27 X 1 1/2	70	0 5/16	
ONE	b	PL. 27 X 1 1/2	70	0 1/16	
ONE	C	PL. 79 X 9 1/2	70	0 5/16	
2	Xap	1 1/2" ROD	35	5 1/8	THD. BOTH ENDS
2	Xan	1 1/2" ROD	35	5 1/8	THD. BOTH ENDS
4	XAop	1/2 X 3/4	0	6	
ONE	X1b	BAR 5 X 1 1/2	6	7	
2	X1c	BAR 6 X 1 1/2			
ONE	X1d	BAR 5 X 1 1/2			
ONE	X1dk	BAR 5 X 1 1/2			
2	X1dm	BAR 6 X 1 1/2			
ONE	X1dp	BAR 5 X 1 1/2	6	7	
2	X3f	PL. 11 3/8 X 1/2	2	6 1/2	
2	X33	BAR 4 3/8 X 3/4	2	6 1/2	
2	X3h	BAR 4 3/8 X 3/4	2	6 1/2	
4	X3bd	BENT PL. 75 X 1/2	1	3	
ONE	X3ak	PL. 8 3/8 X 1"	2	10 1/2	
	X3am	PL. 8 3/8 X 1"	2	10 1/2	
	X3an	PL. 17 3/8 X 3/8	2	10 1/2	
	X3af	PL. 8 1/2 X 1"	2	10 1/2	
	X3ag	PL. 8 1/2 X 1"	2	10 1/2	
	X3ah	PL. 17 1/2 X 3/8	2	10 1/2	
	X1b3	PL. 12 X 1 3/8	6	7	
	X1bh	PL. 12 X 1 3/8			
	X2ay	BAR 7 X 1 1/2			
	X2aw				
	X2bp				
	X2bs	BAR 7 X 1 1/2	6	7	
	X1cc	BAR 8 X 1/2	6	1	
	X1cd				
	X1ct				
ONE	X1cw	BAR 8 X 1/2	6	1	
16		1 1/2 STD. HEX. NUTS			B/ 12
16		WASH. FOR 1 1/2" ROD			B/ 8
20		WASH. FOR 3/4" H.S. BOLTS			B/ 9
8		3/4" H.S. BOLTS	0	2 1/4	B/ 3
12		3/4" H.S. BOLTS	0	2 1/2	B/ 4
ONE	X2ft	PL. MC18 X 45.8	0	11 1/2	
	X2ga		0	11 1/2	
	X2gd		0	11 1/2	
	X3bh		0	10 1/4	
	X3bn		0	10 1/2	
ONE	X3bt	PL. MC18 X 45.8	0	10 1/2	



AF 2283A

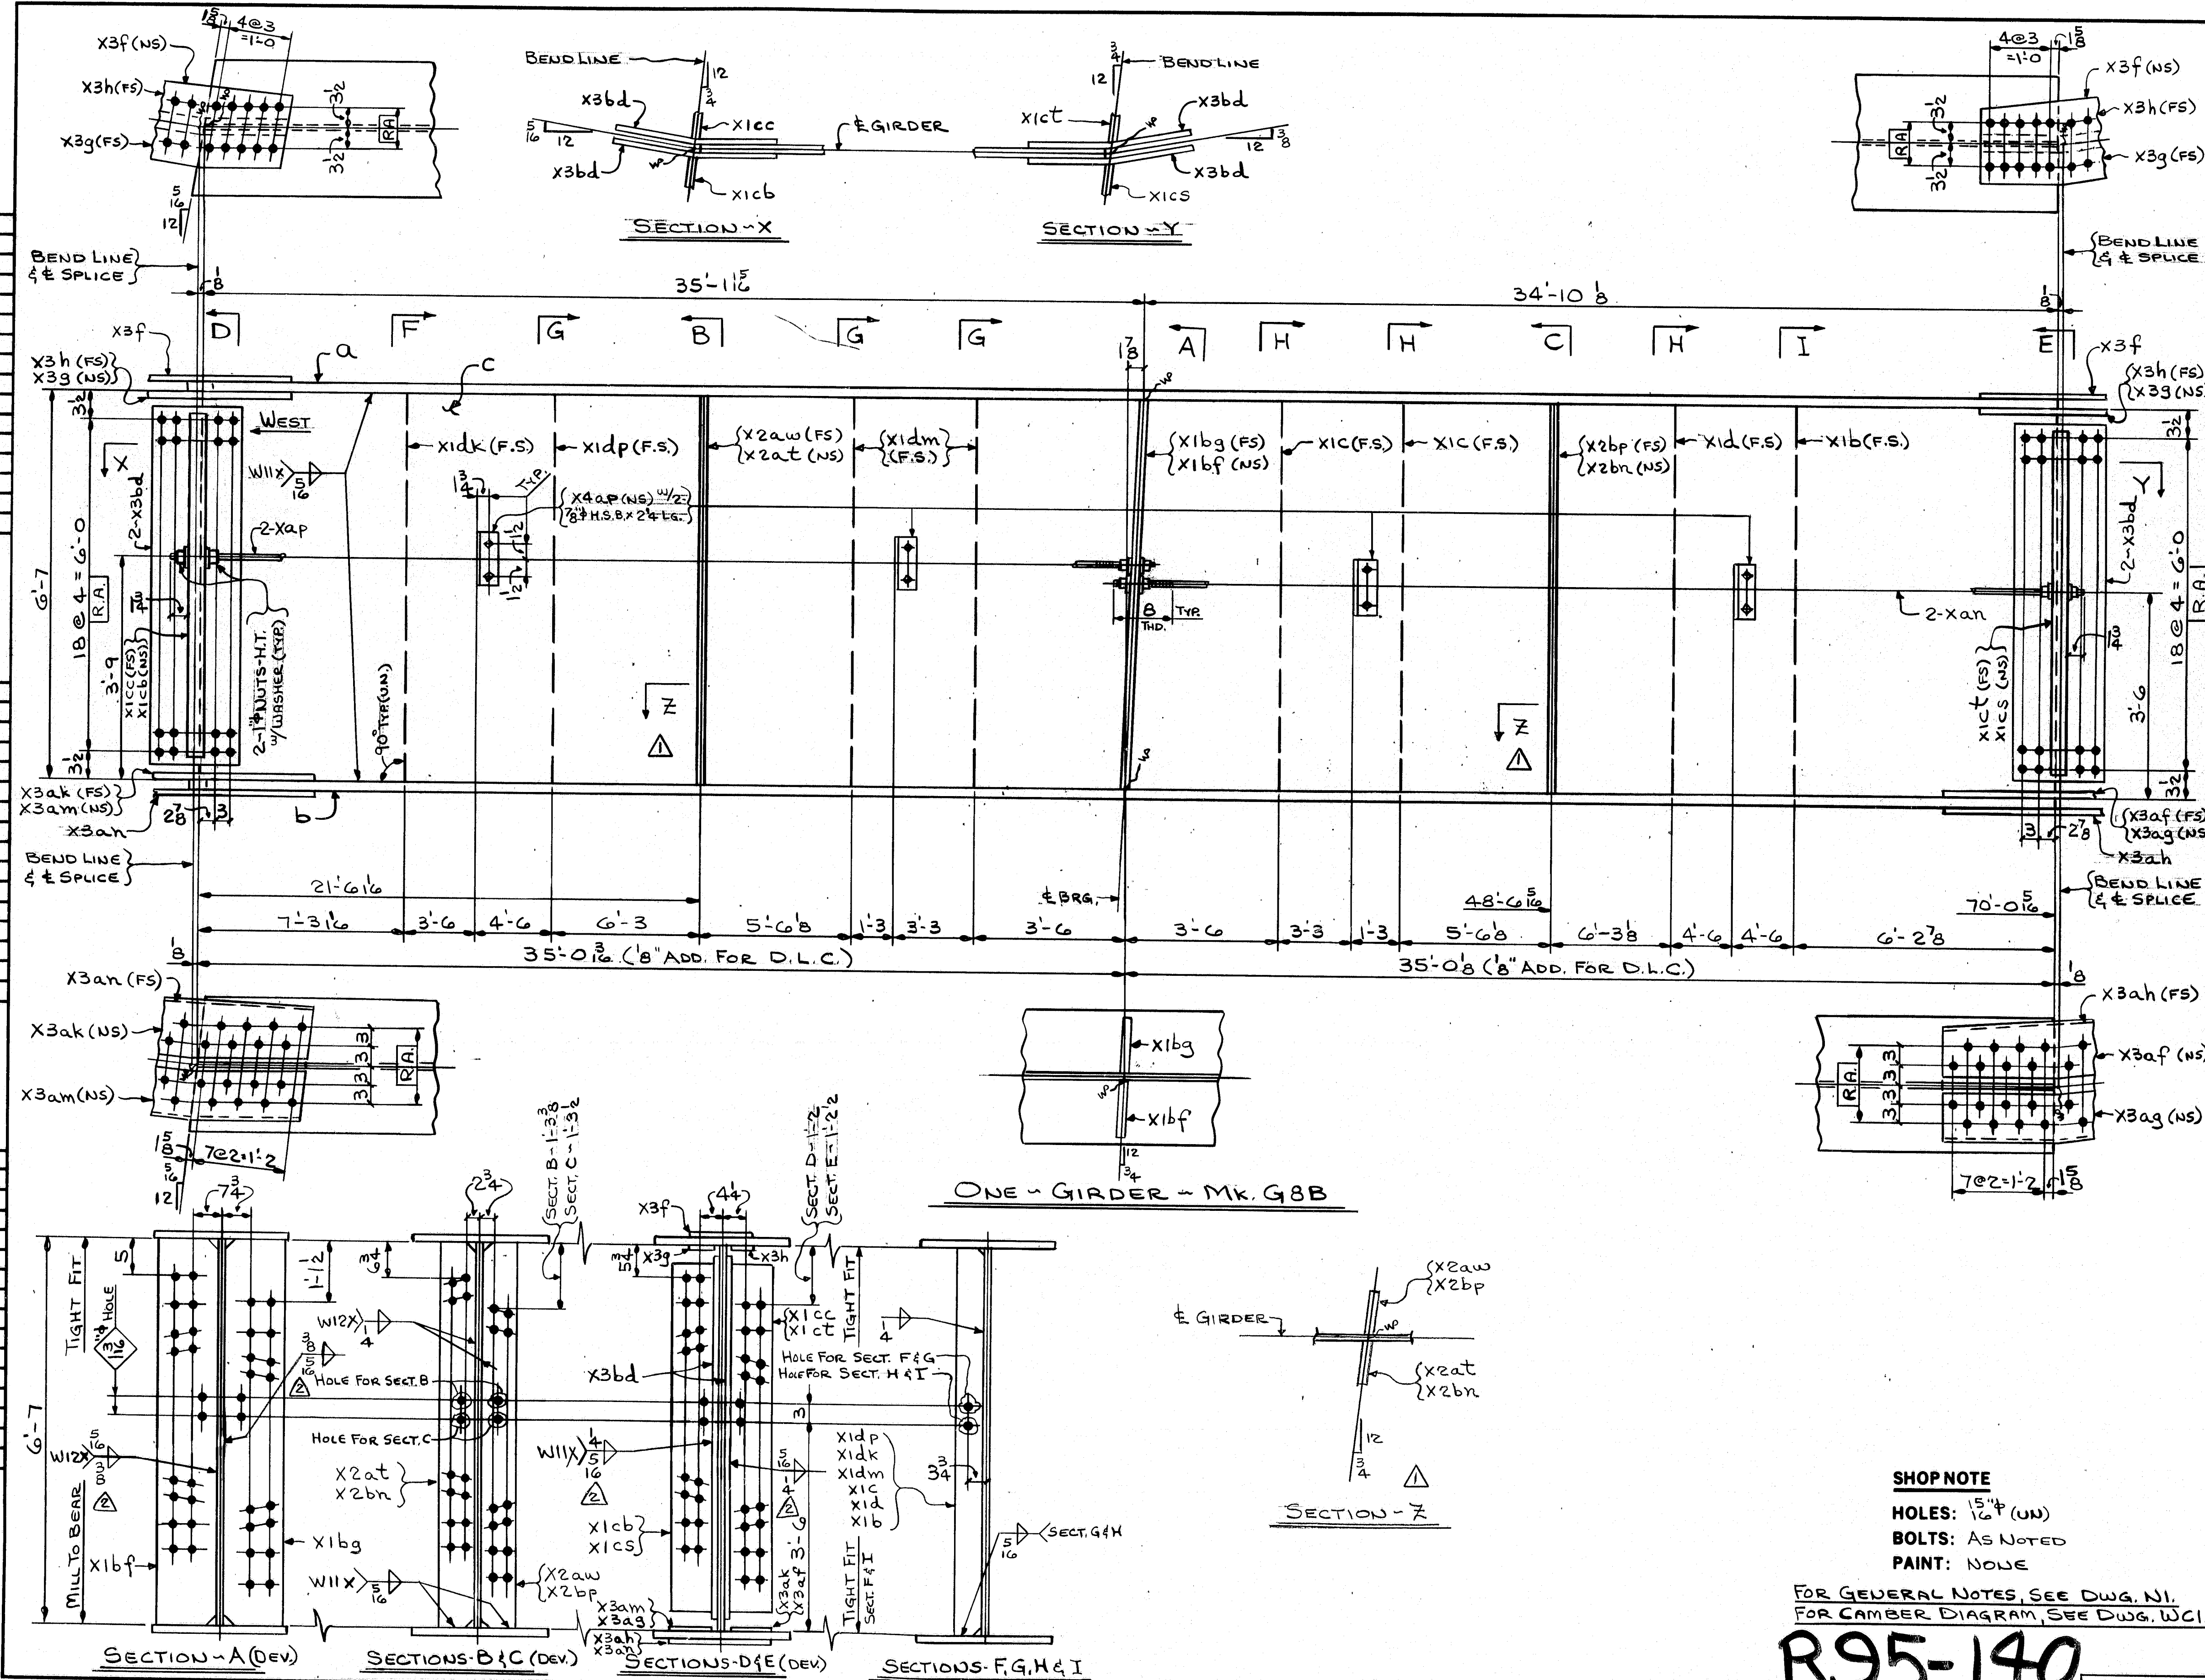

		FED. ROAD DIV. NO.		STATE		FED. AID PROJ. NO.	
		1		ME		116-395-8(82)176	
BILL OF MATERIAL							
NO.	MARK	DESCRIPTION	LENGTH	REMARKS	ITEM	SHIP WEIGHT	
ONE	G8B	GIRDER				36,845	
ONE	A	R. 27 X 1 3/4	70	0 1/2			
ONE	B	R. 27 X 1 3/4	70	0 1/2			
ONE	C	R. 79 X 1 1/2	70	0 1/2			
2	Xap	1 1/2 Rod	35	5 1/2	THD. BOTH ENDS	2 3/8	
2	Xan	1 1/2 Rod	35	3 1/2	THD. BOTH ENDS	2 3/8	
4	Xap	1 1/2 X 3/4	0	6			
ONE	X1b	BAR 5 X 1 1/2	6	7			
2	X1c	BAR 6 X 1 1/2	↑	↑			
ONE	X1d	BAR 5 X 1 1/2	6	7			
ONE	X1dk	BAR 5 X 1 1/2	6	7			
2	X1dm	BAR 6 X 1 1/2	↓	↓			
ONE	X1dp	BAR 5 X 1 1/2	6	7			
2	X3f	R. 1 1/2 X 1 1/2	2	6 1/2			
2	X3g	BAR 4 3/8 X 3/4	2	6 1/2			
2	X3h	BAR 4 3/8 X 3/4	2	6 1/2			
4	X3bd	BENT R. 75 X 2	1	3			
ONE	X3ak	R. 8 3/8 X 1"	2	10 1/2			
↑	X3am	R. 8 3/8 X 1"	2	10 1/2			
	X3an	R. 17 3/8 X 7/8	2	10 1/2			
	X3af	R. 8 1/2 X 1"	2	10 1/2			
	X3ag	R. 8 1/2 X 1"	2	10 1/2			
	X3ah	R. 17 1/2 X 7/8	2	10 1/2			
	X1bf	R. 12 X 1 3/8	6	7			
	X1bf	R. 12 X 1 3/8	↑	↑			
	X2aw	BAR 7 X 1 1/2	6	7			
	X2at	↑	↓	↓			
	X2bp	↓	↓	↓			
	X2bn	BAR 7 X 1 1/2	6	7			
	X1cb	BAR 8 X 1 1/2	6	1			
	X1cc	↑	↑	↑			
↓	X1cs	↑	↑	↑			
ONE	X1ct	BAR 8 X 1 1/2	6	1			
16		1 1/2 STD. HEX. NUTS				B1	12
16		WASH. FOR 1 1/2 Rod				B1	8
8		WASH. FOR 3/4 H.S. BOLT				B1	4
8		3/4 H.S. BOLTS	0	24		B1	3

# SHOP NOTE

HOLES: 1 1/2" (UN)  
BOLTS: AS NOTED  
PAINT: NONE

FOR GENERAL NOTES, SEE DWG. N1.  
FOR CAMBER DIAGRAM, SEE DWG. WCI.


R95-140

CODE: 4000

NO. 2	REVISION CHANGED WELD SIZES	DATE 1-3-85
NO. 1	REVISION ADDED SECT. Z	DATE 12-21-84
HIGH STEEL STRUCTURES, INC.		
GIRDER G8B		
I-395 BRIDGE OVER PENOBSCOT RIVER		
I-395 BRIDGE STA. 164+60.00		
PENOBSCOT COUNTY		
STATE OF MAINE		
DEPARTMENT OF TRANSPORTATION		
STATE CONTRACT OR REF. NO. 6	CONTRACTOR GAUBRO CORP.	
IN CHARGE: HINKLE	MADE BY: G.F.Z.	CHK'D BY: CS
CONTRACT NUMBER: ME-84088-1	DRAWING NUMBER: 24 OF 36	DATE: 6-29-84



AP 22083A

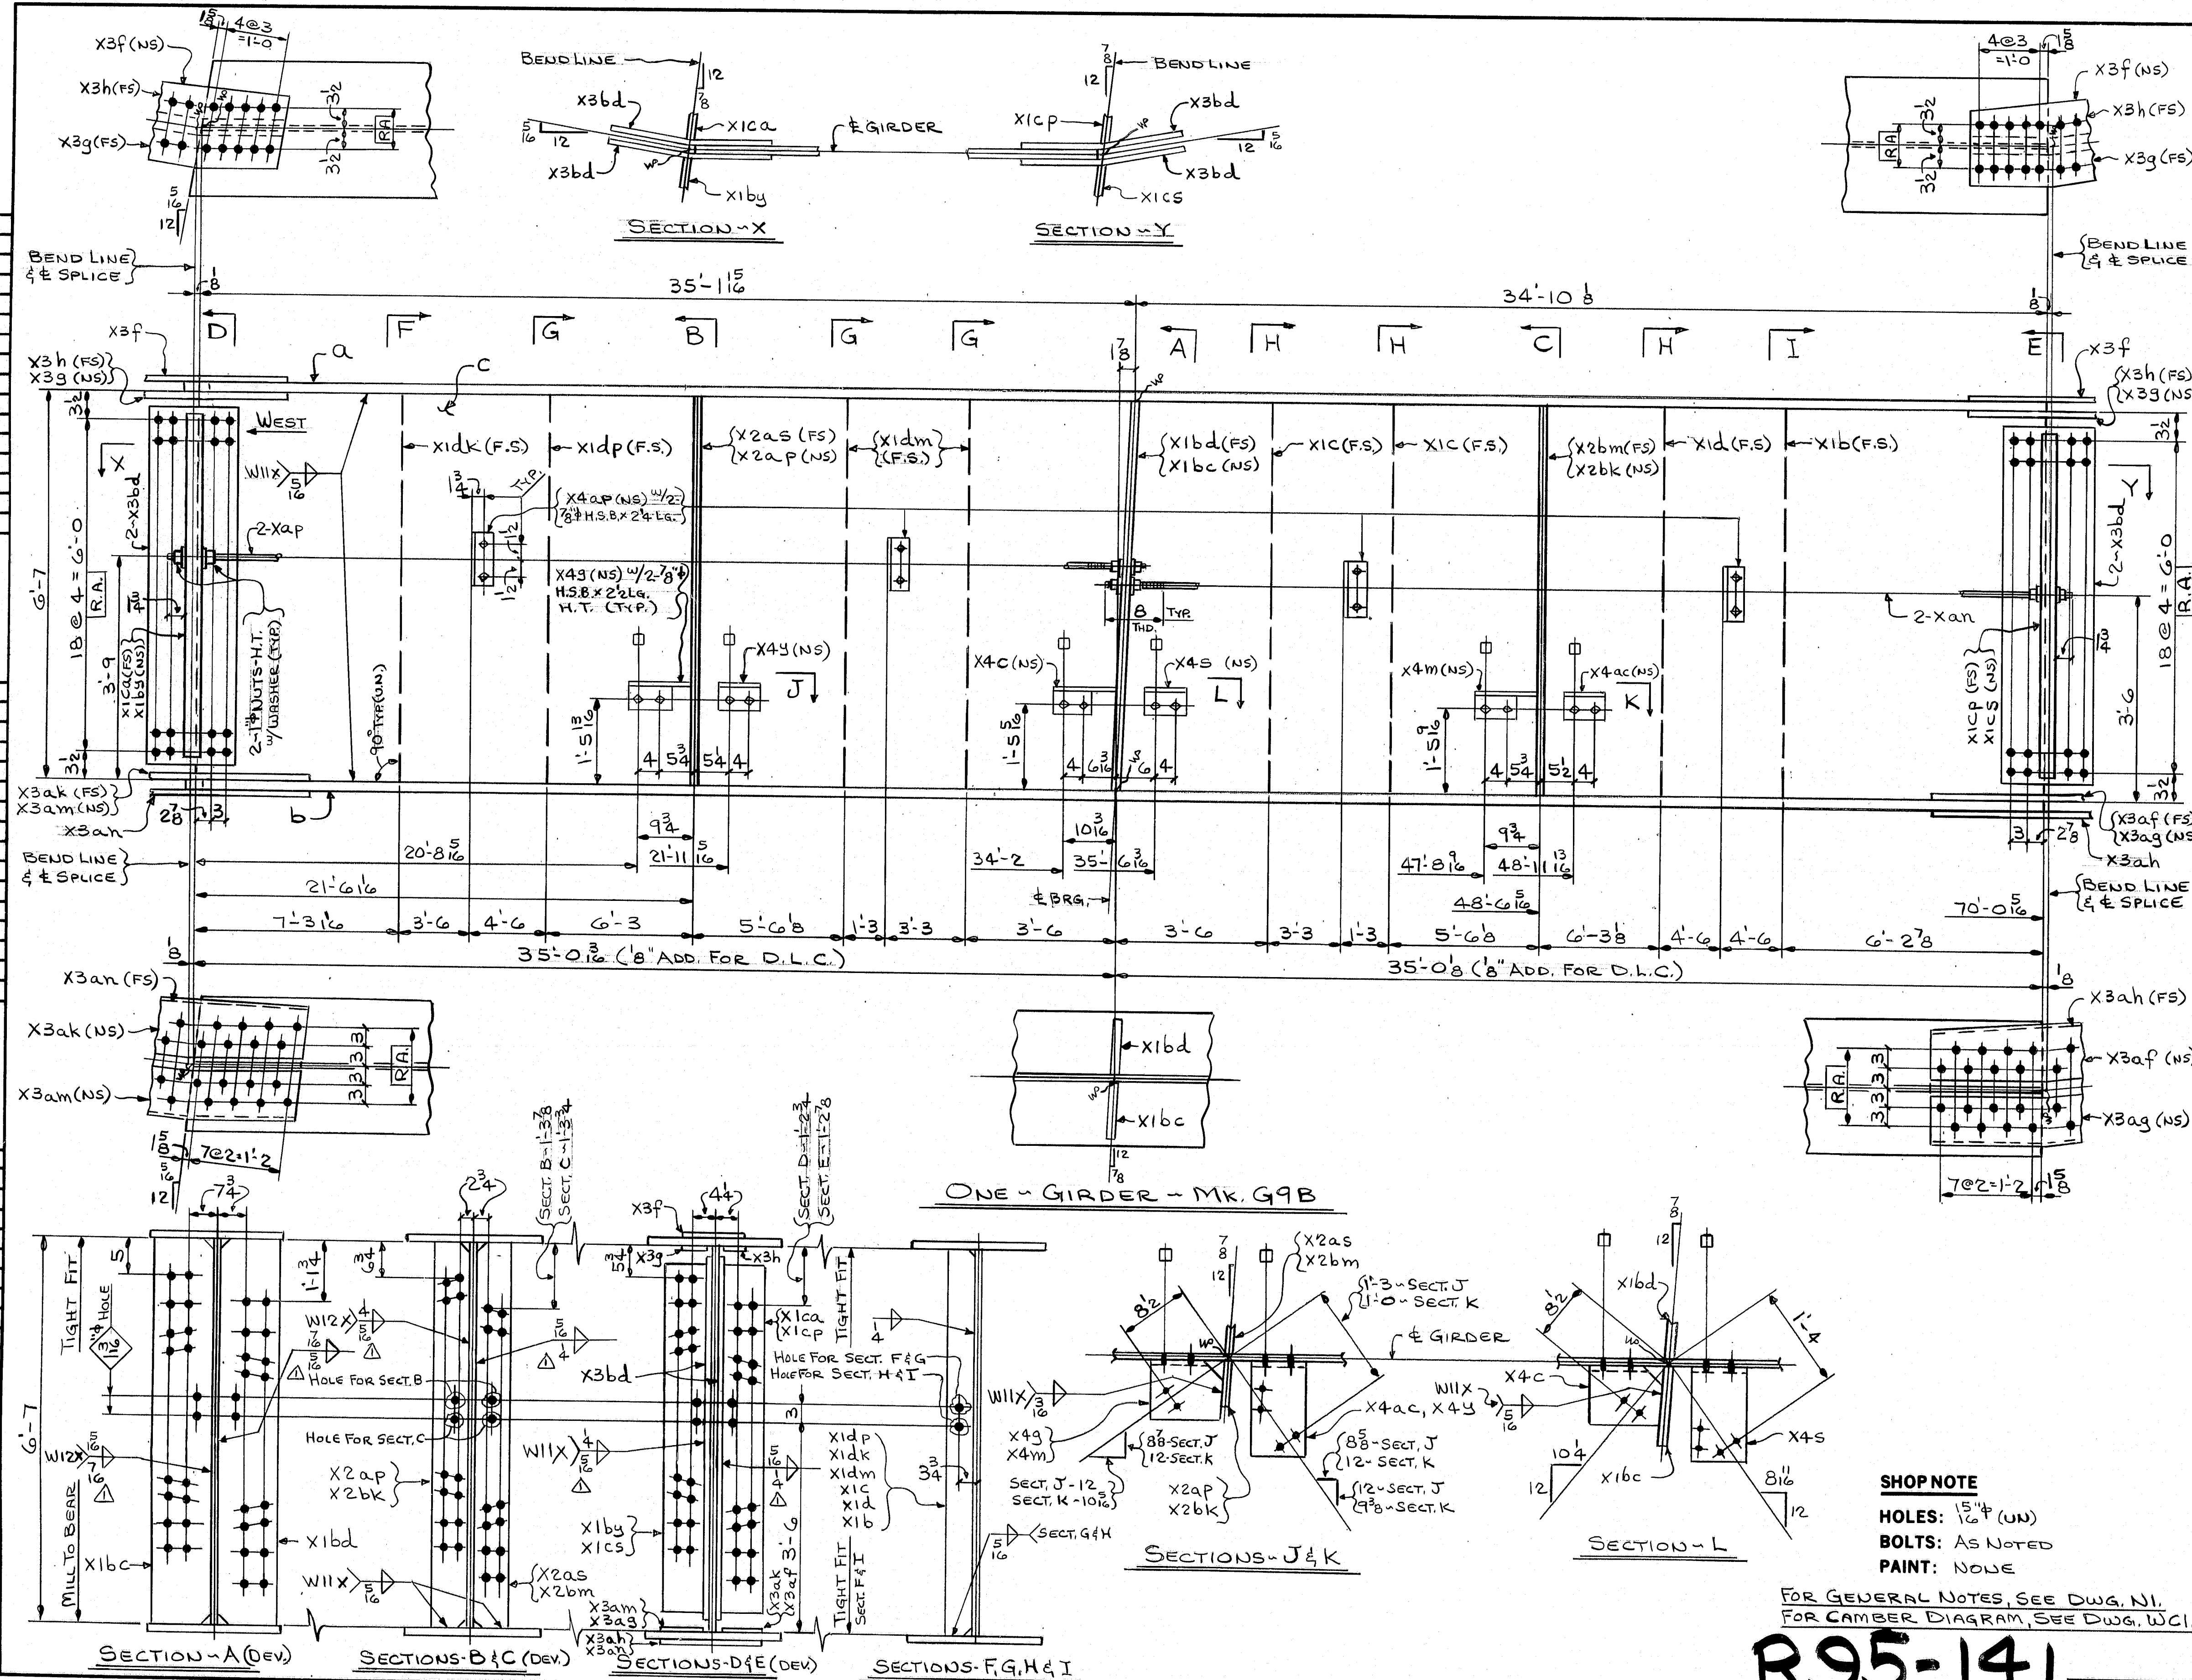

BILL OF MATERIAL					
NO.	MARK	DESCRIPTION	LENGTH	REMARKS	ITEM
ONE	G9B	GIRDER			37,085
ONE	A	PL. 27 X 1 1/4	70	0 1/2	
ONE	B	PL. 27 X 1 1/4	70	0 1/2	
ONE	C	PL. 79 X 1 1/4	70	0 1/2	
2	Xap	1" Rod	35	5 1/2	THD. BOTH ENDS
2	Xan	1" Rod	35	3 1/2	THD. BOTH ENDS
4	Xap	1/2 X 3/4	0	6	
ONE	X1b	BAR 5 X 7/8	6	7	
2	X1c	BAR 6 X 7/8			
ONE	X1d	BAR 5 X 7/8			
ONE	X1dk	BAR 5 X 7/8			
2	X1dm	BAR 6 X 7/8			
ONE	X1dp	BAR 5 X 7/8	6	7	
2	X3f	PL. 1 1/2 X 1/2	2	6 1/2	
2	X3g	BAR 4 3/8 X 3/4	2	6 1/2	
2	X3h	BAR 4 3/8 X 3/4	2	6 1/2	
4	X3bd	BENT PL. 75 X 1/2	1	3	
ONE	X3ak	PL. 8 3/8 X 1"	2	10 1/2	
	X3am	PL. 8 3/8 X 1"	2	10 1/2	
	X3an	PL. 17 3/8 X 7/8	2	10 1/2	
	X3af	PL. 8 1/2 X 1"	2	10 1/2	
	X3ag	PL. 8 1/2 X 1"	2	10 1/2	
	X3ah	PL. 17 1/2 X 7/8	2	10 1/2	
	X1bc	PL. 12 X 1 3/8	6	7	
	X1bd	PL. 12 X 1 3/8			
	X2af	BAR 7 X 7/8			
	X2as				
	X2bk				
	X2bm	BAR 7 X 7/8	6	7	
	X1bw	BAR 8 X 1/2			
	X1ca				
	X1cp				
ONE	X1cs	BAR 8 X 1/2	6	1	
16		1" STD. HEX. NUTS			B1 1/2
16		WASH. FOR 1" ROD			B1 1/2
20		WASH. FOR 7/8" H.S. BOLT			B1 1/4
8		7/8" H.S. BOLTS	0	2 1/4	B1 3/4
12		7/8" H.S. BOLTS	0	2 1/2	B1 4
ONE	X4c	PL. MC18 X 45.8	0	11 1/2	
	X4g		0	11 1/2	
	X4m		0	11 1/2	
	X4s		0	10	
	X4y		0	8 1/4	
ONE	X4ac	PL. MC18 X 45.8	0	8 1/2	

**SHOP NOTE**  
 HOLES: 1/8" (UN)  
 BOLTS: AS NOTED  
 PAINT: NONE


FOR GENERAL NOTES, SEE DWG. N1.  
 FOR CAMBER DIAGRAM, SEE DWG. W1.

**R95-141**

NO. 1	REVISION	CHANGED WELD SIZES	DATE 1-3-85
<b>HIGH STEEL STRUCTURES, INC.</b> 1905 Old Philadelphia Pike Leicestershire, Pennsylvania 17603 Phone 717/299-5111 A Subsidiary of High Industries, Inc.			
<b>GIRDER G9B</b> I-395 BRIDGE OVER PENOBSCOT RIVER I-395 BRIDGE STA. 164+60.00 PENOBSCOT COUNTY STATE OF MAINE DEPARTMENT OF TRANSPORTATION			
STATE CONTRACT OR REF. NO.	6	CONTRACTOR	GAMBRO CORP.
IN CHARGE:	HINKLE	MADE BY:	G.F.Z. CHK. BY: CS DATE: 6/29/84
CONTRACT NUMBER:	ME-84088-1	DRAWING NUMBER:	25 OF 36



AP 2285A

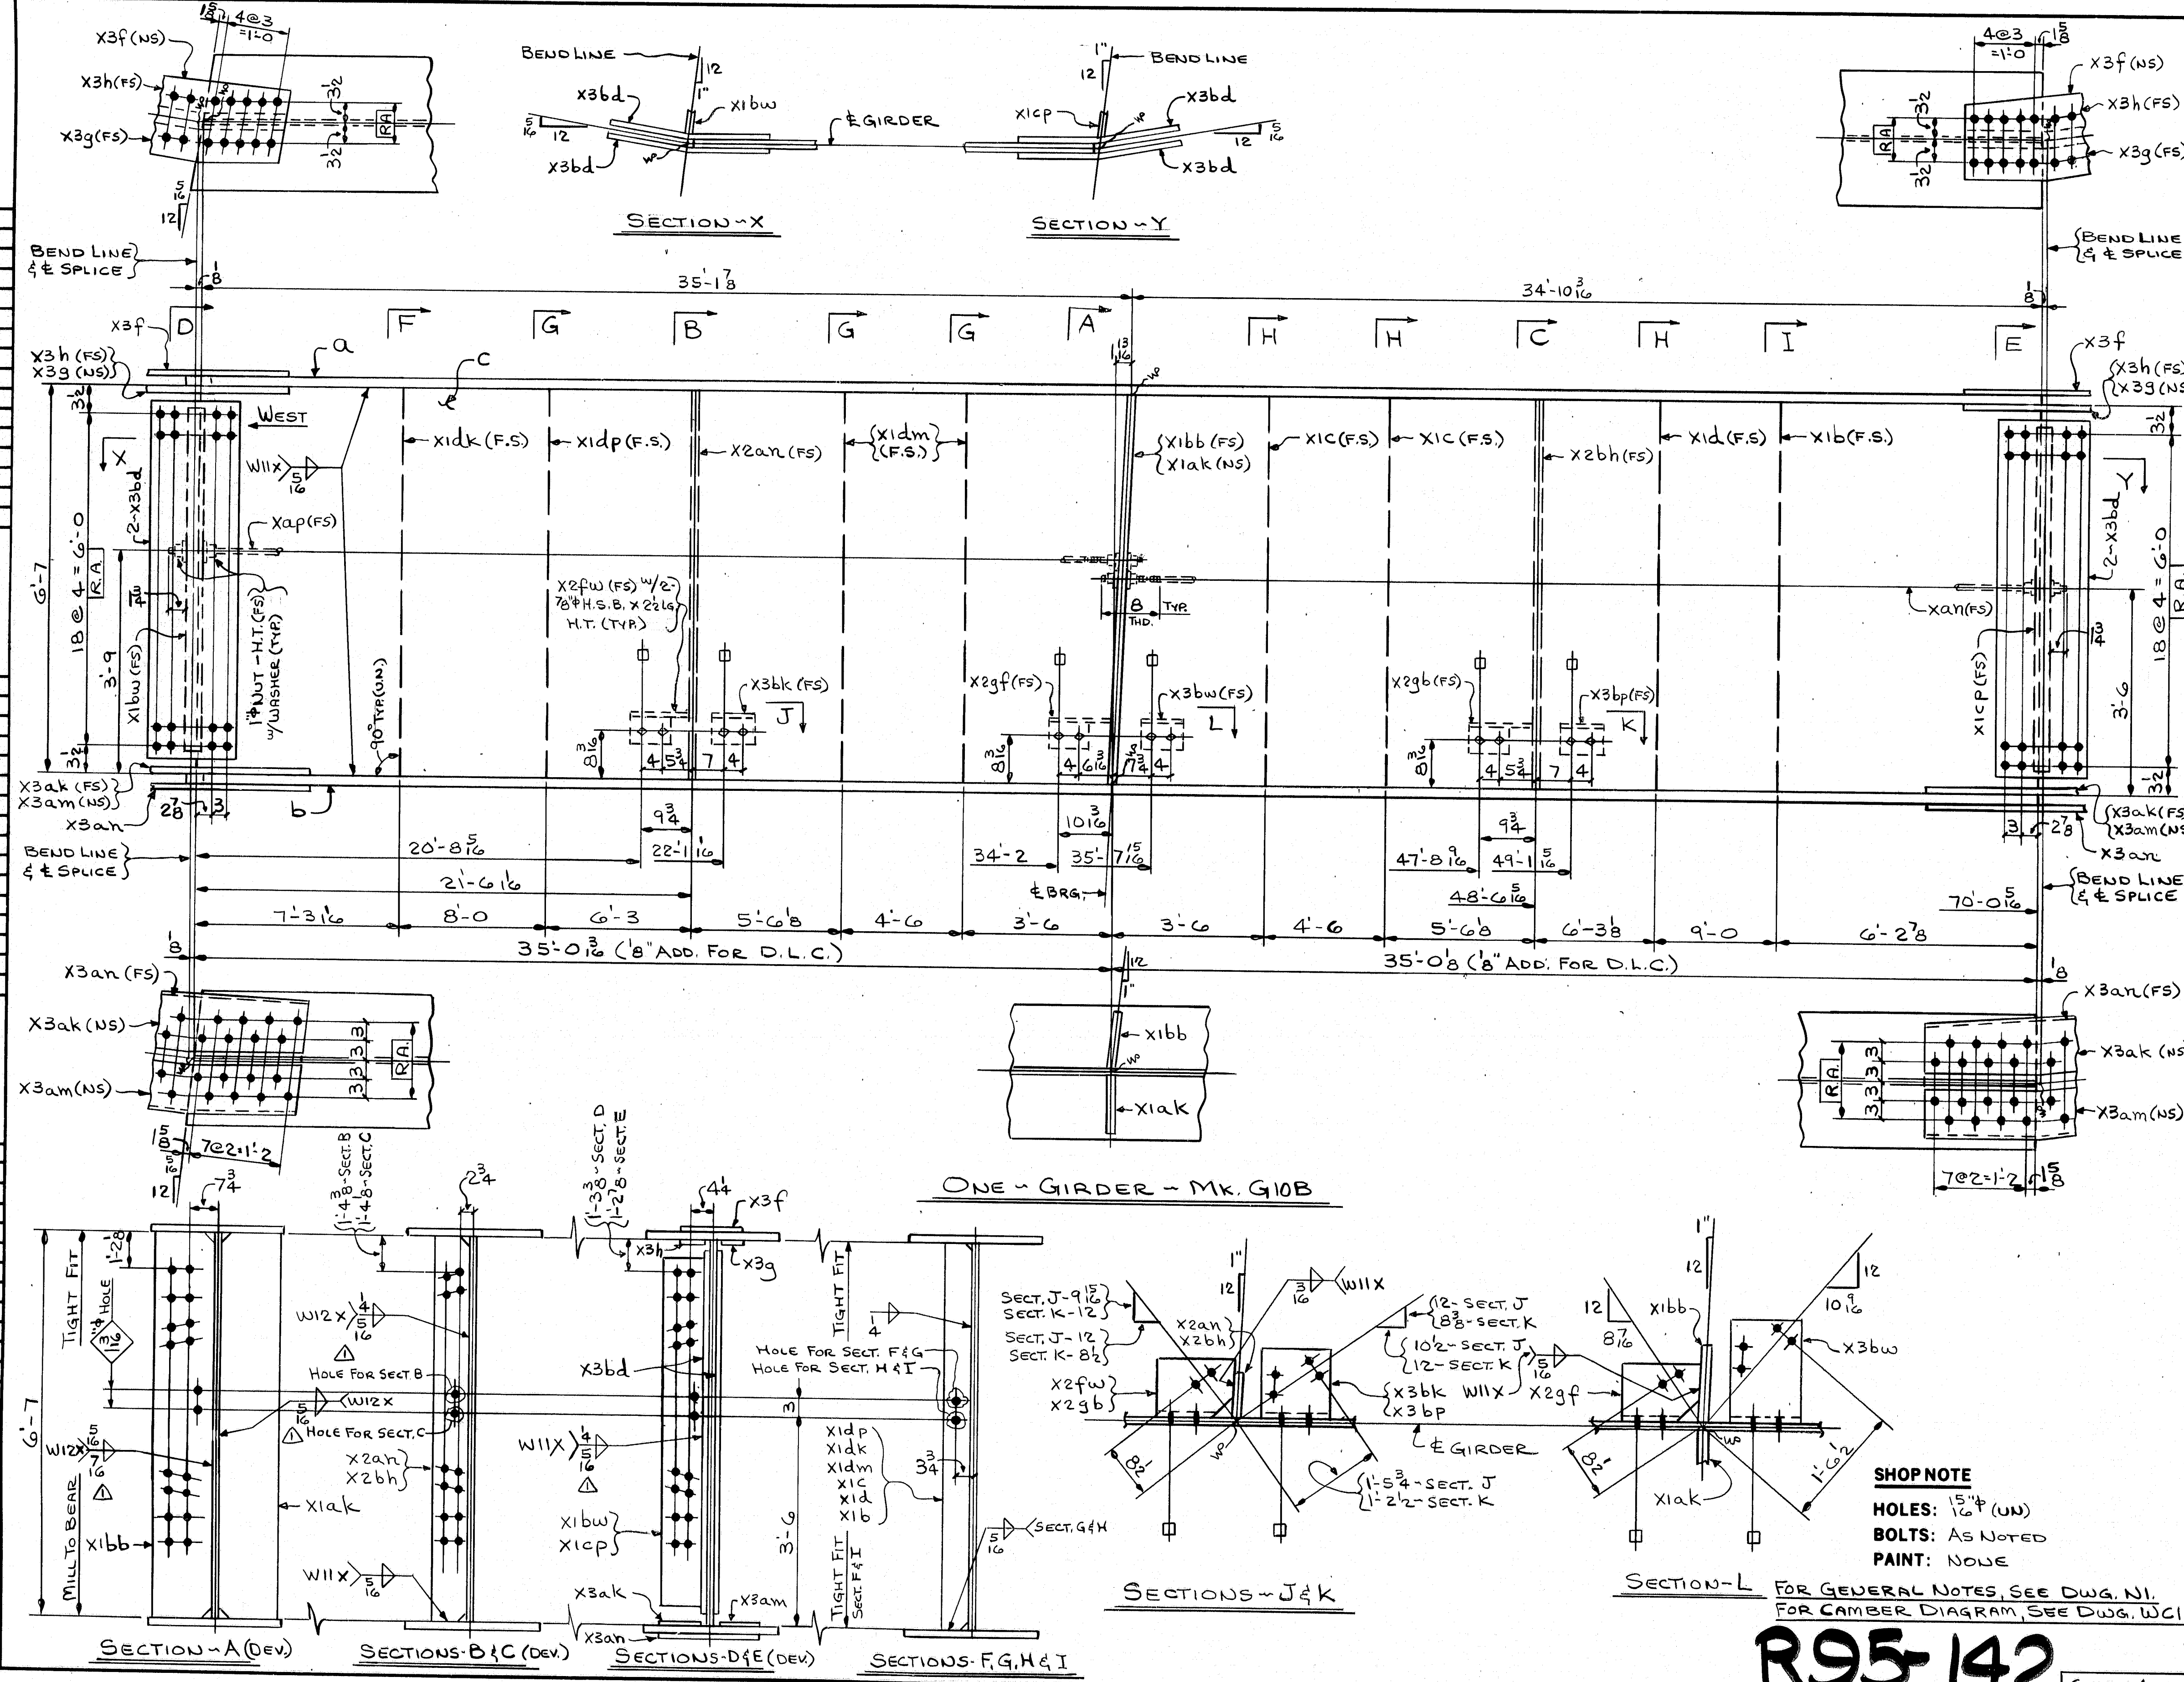

FED. ROAD DIV. NO.	STATE	FED. AID PROJ. NO.
1	ME	114-395-8(82)176

BILL OF MATERIAL					
NO.	MARK	DESCRIPTION	LENGTH	REMARKS	ITEM
ONE	G10B	GIRDER			34,600
ONE	A	R. 27 X 1 1/4	70	0/7	
ONE	B	R. 27 X 1 1/4	70	0/7	
ONE	C	R. 79 X 1 1/4	70	0/7	
ONE	XAP	1" ROD	35	5/8 THD. BOTH ENDS	3
ONE	XAN	1" ROD	35	5/8 THD. BOTH ENDS	3
ONE	X1B	BAR 5 X 1 1/2	6		7
2	X1C	BAR 6 X 1 1/2			
ONE	X1D	BAR 5 X 1 1/2			
ONE	X1K	BAR 5 X 1 1/2			
2	X1M	BAR 6 X 1 1/2			
ONE	X1P	BAR 5 X 1 1/2			
2	X3F	R. 1 1/2 X 1/2	2	6/2	
2	X3G	BAR 4 3/8 X 3/4	2	6/2	
2	X3H	BAR 4 3/8 X 3/4	2	6/2	
4	X3B	BENT R. 75 X 2	1	3	
2	X3AK	R. 8 3/8 X 1"	2	10 1/2	
2	X3AM	R. 8 3/8 X 1"	2	10 1/2	
2	X3AN	R. 17 3/8 X 3/8	2	10 1/2	
ONE	X1B	R. 12 X 1 3/8	6		7
	X1AK	R. 12 X 1 3/8			
	X2AN	BAR 7 X 1 1/2			
	X2BH	BAR 7 X 1 1/2			
	X1BW	BAR 8 X 1"			
	X1CP	BAR 8 X 1"			
	X2FW	R. MC 18 X 45.8	1	0 1/4	
	X23B				
	X23F				
	X3BK				
	X3BP				
ONE	X3BW	R. MC 18 X 45.8	1	0 1/2	
B		1" STD. HEX. NUTS			12
B		WASH. FOR 1" ROD			12
12		3" H.S. BOLTS			12
12		WASH. FOR 3" H.S. BOLTS			12


NO. 1	REVISION CHANGED WELD SIZES	DATE 1-3-85
HIGH STEEL STRUCTURES, INC.		
1395 BRIDGE OVER PENOBSCOT RIVER		
1-395 BRIDGE STA. 164+60.00		
PENOBSCOT COUNTY		
STATE OF MAINE		
DEPARTMENT OF TRANSPORTATION		
STATE CONTRACT OR REF. NO. 6	CONTRACTOR GAMBRO CORP.	
IN CHARGE HINKLE	MADE BY G.F.Z.	CHKD. BY CS
CONTRACT ME-84088-1	DRAWING NUMBER 26 OF 36	DATE 6-29-84

R95-142

CODE: 4000





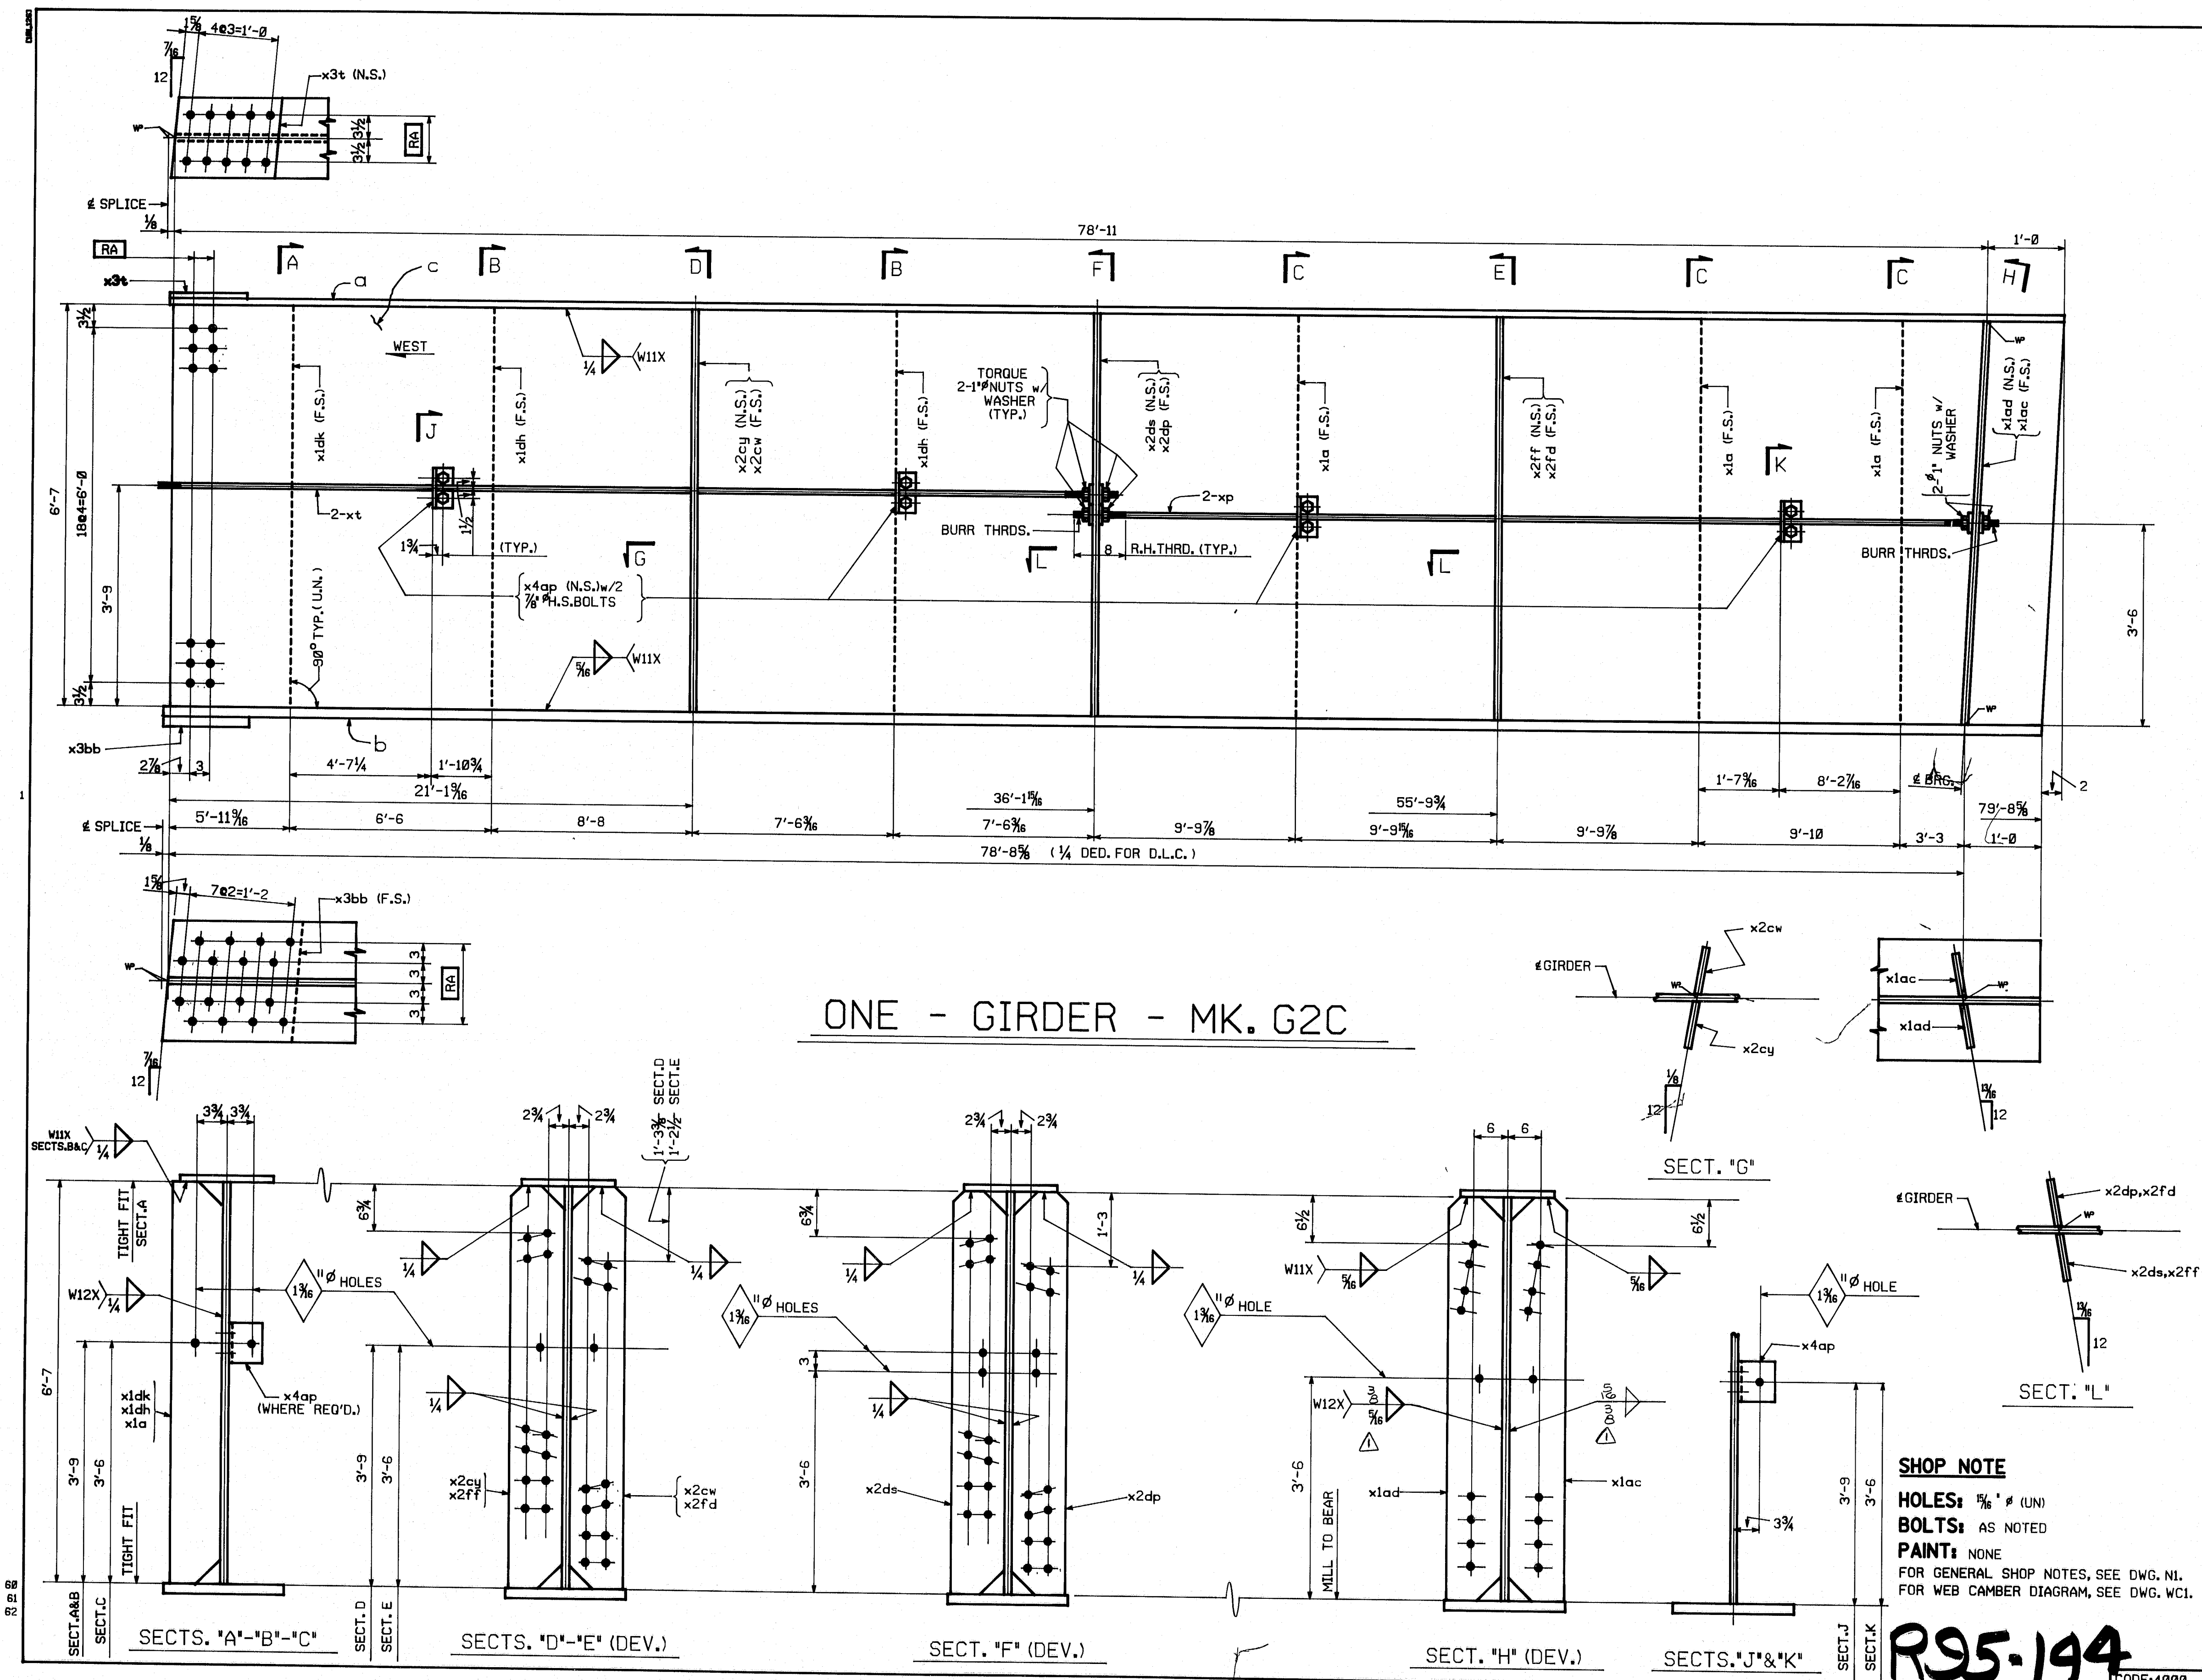


			FED. ROAD DIV. NO.		STATE		FED. AID PROJ. NO.	
			1		ME.		I-IG-395-81821176	
BILL OF MATERIAL								
NO.	MARK	DESCRIPTION	LENGTH		REMARKS		ITEM	SUP. WORTH E.L.
ONE-GIRDER			MK. G2C					21490
ONE	a	PL.12 x ¾	79	11¼				
ONE	b	PL.18 x 1⅝	79	8⅝				
ONE	c	PL.79 x ½	79	11				
2	xp	1" ROD	42	11½	THRD. BOTH ENDS		6	12
2	xt	1" ROD	36	5¾	THRD. BOTH ENDS		6	4
ONE	x3t	PL.11½x ⅞	1	3½				
ONE	x3bb	PL.17½x ¼	1	5½				
3	x1a	BAR 5 x ⅞	6	7				
ONE	x1ac	BAR 8 x 1	6	7				
ONE	x1ad	BAR 8 x 1	6	7				
2	x1dh	BAR 5 x ⅞	6	7				
ONE	x1dk	BAR 5 x ⅞	6	7				
ONE	x2cw	BAR 7 x ⅞	6	7				
ONE	x2cy	BAR 7 x ⅞	6	7				
ONE	x2dp	BAR 7 x ⅞	6	7				
ONE	x2ds	BAR 7 x ⅞	6	7				
ONE	x2fd	BAR 7 x ⅞	6	7				
ONE	x2ff	BAR 7 x ⅞	6	7				
4	x4ap	L 5 x 3 x ¼	8	6				
12		1" STD. HEX. NUTS					B1	12
12		WASHERS FOR 1" RODS					B1	8
8		⅞" H.S. BOLTS	8	2			B1	2
8		WASHERS FOR ⅞" H.S. BOLTS					B1	8

NO.	REVISION	CHANGED WELD SIZES	DATE
1			1-3-85
HIGH STEEL STRUCTURES, INC.			
805 Old Philadelphia Pike Lancaster, Pennsylvania 17603 Phone 717/299-025			
A Subsidiary of High Industries, Inc.			
GIRDER G2C			
I-395 BRIDGE OVER PENOBSCOT RIVER			
I-395 BRIDGE STA. 164+60.00			
PENOBSCOT COUNTY			
STATE OF MAINE			
DEPARTMENT OF TRANSPORTATION			
STATE CONTRACT OR REF. NO.	6	CONTRACTOR	CIANBRO CORP.
IN CHARGE	HINKLE	MADE BY	C.S.
CHCKD. BY	G.F.F.	DATE	7/6/84
CONTRACT NUMBER	ME-84088-1	DRAWING NUMBER	28 OF 36

**R95-144**




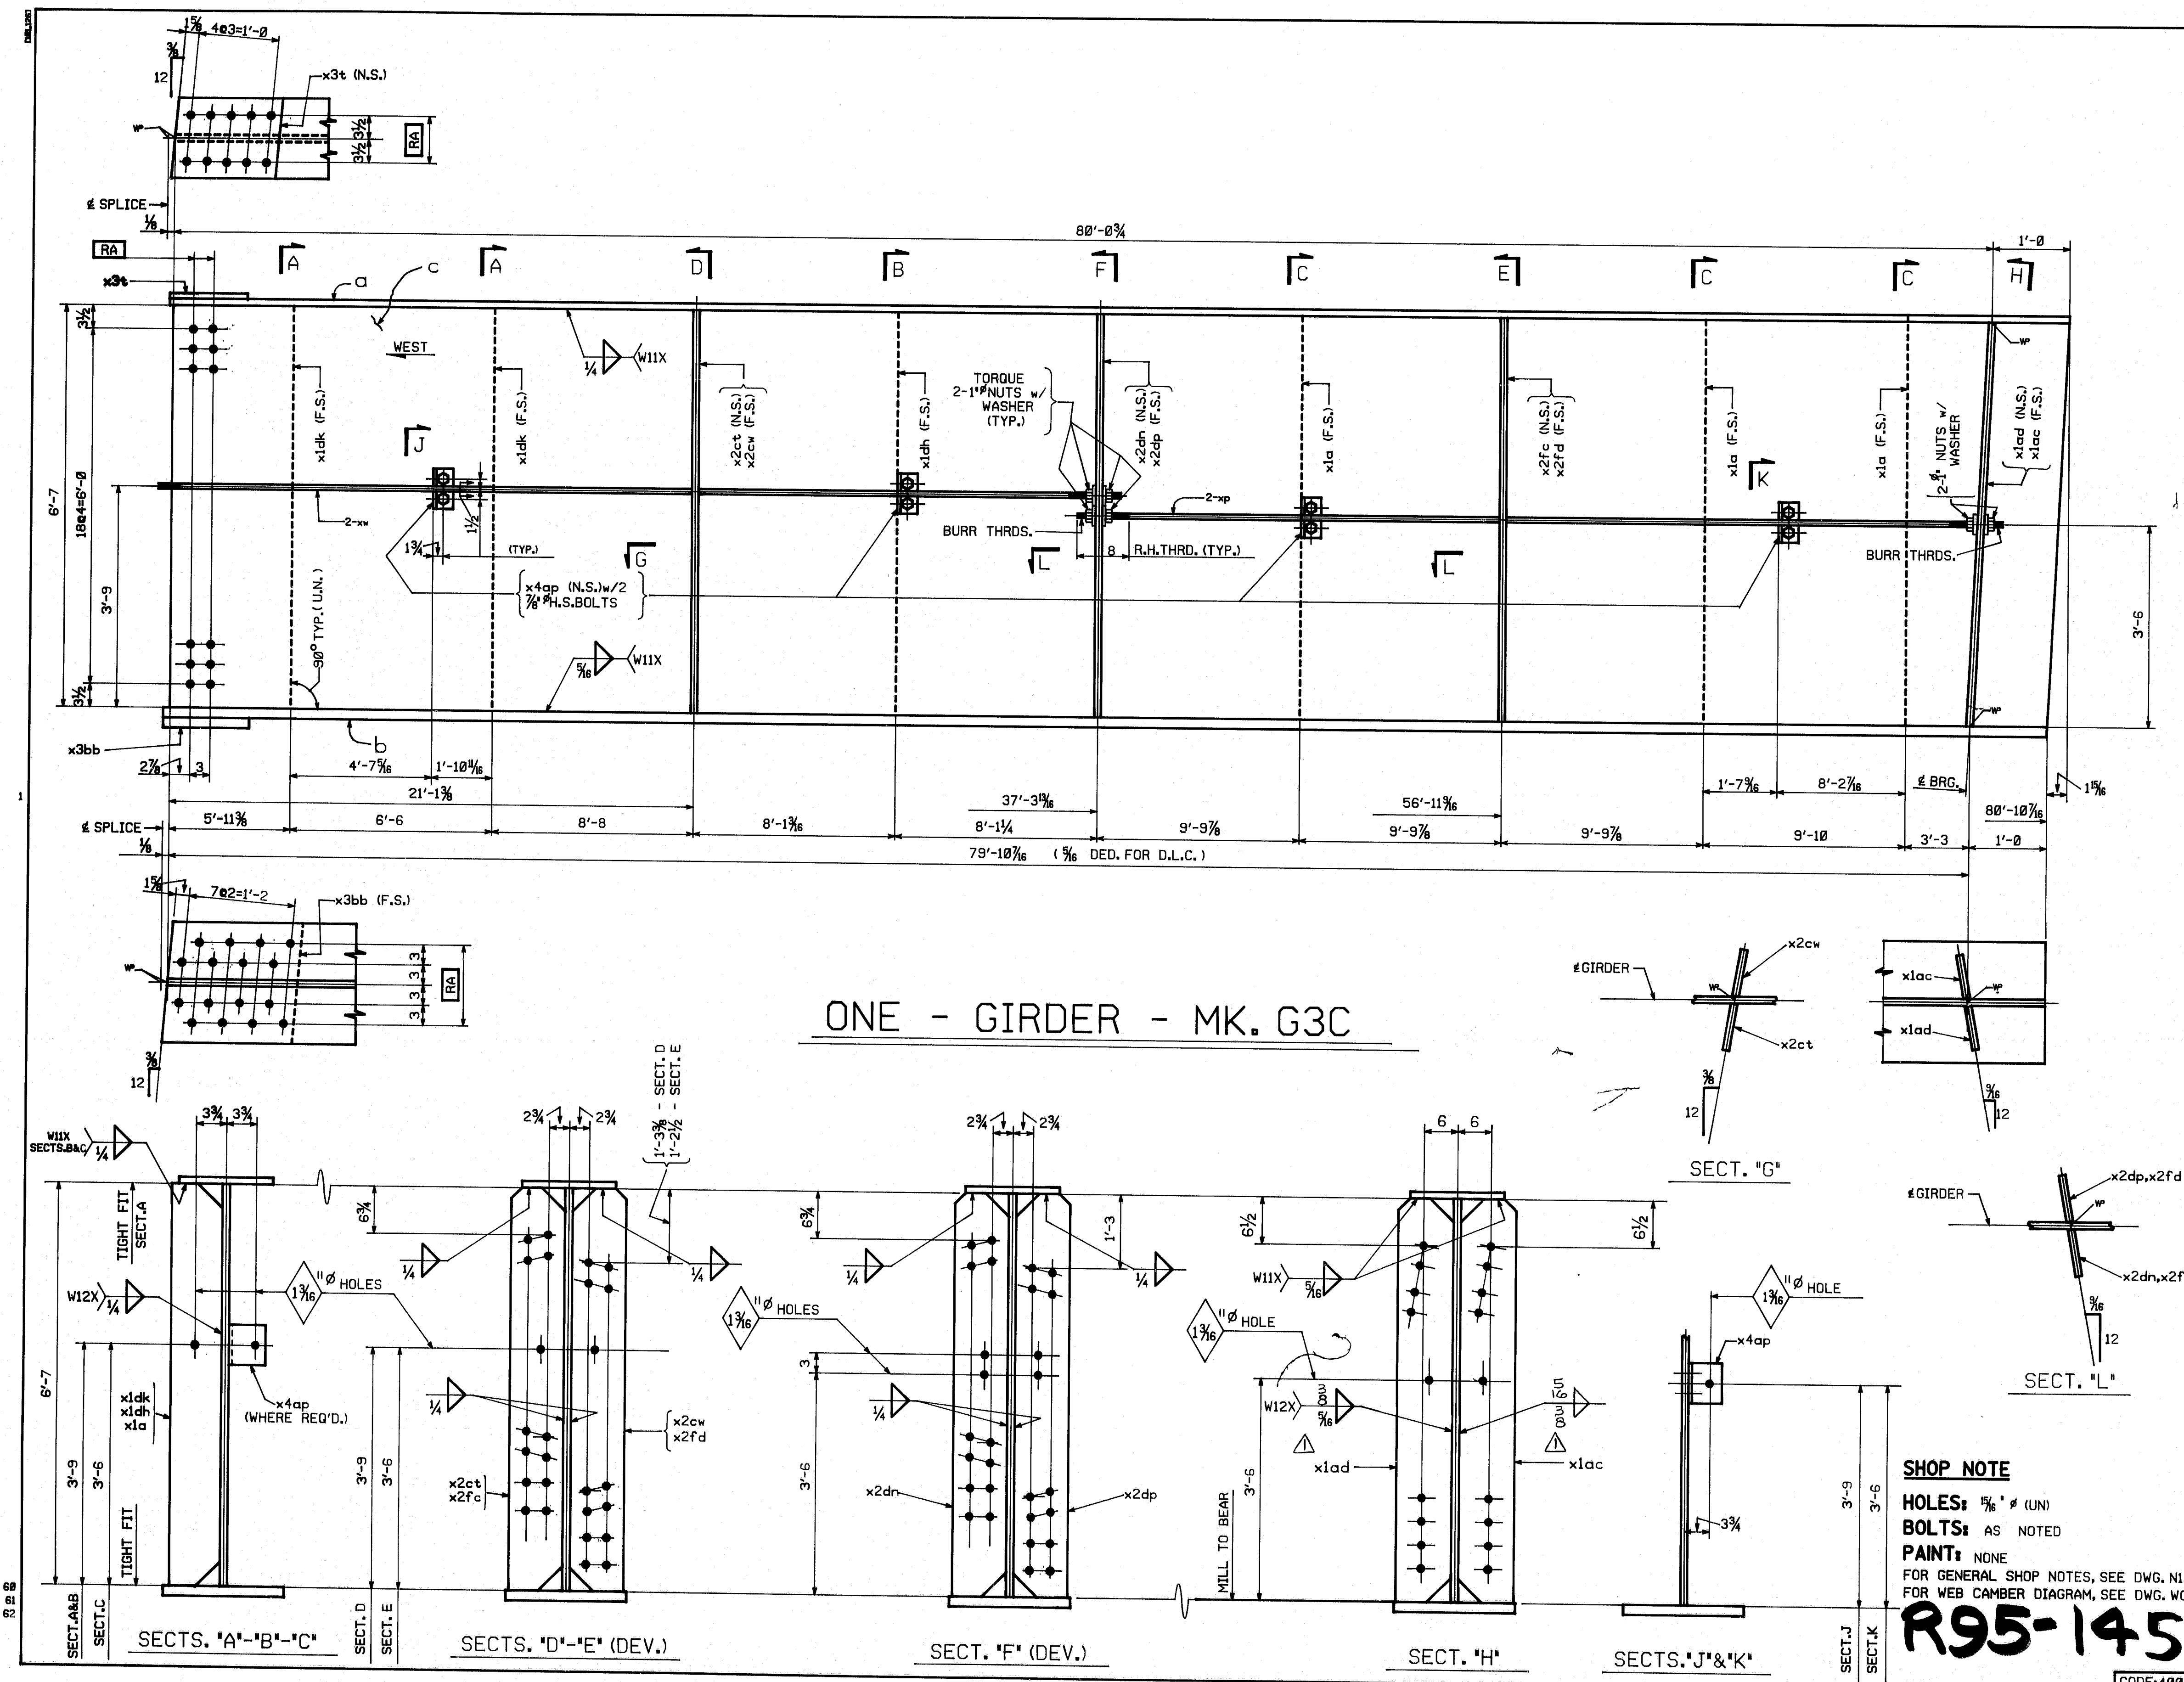


		FED. ROAD DIV. NO.		STATE		FED. AID PROJ. NO.	
		1		ME.		I-10-395-81821176	
BILL OF MATERIAL							
NO.	MARK	DESCRIPTION	LENGTH	REMARKS		ITEM	SW- WEIGHT EA.
		ONE-GIRDER	MK, G3C				21'80
ONE	a	PL.12 x ¾	81	0%			
ONE	b	PL.18 x 1½	80	10%			
ONE	c	PL.79 x ½	81	0%			
2	xp	1" ROD	42	11%	THRD. BOTH ENDS	6 1/2	
2	xw	1" ROD	37	7½	THRD. BOTH ENDS	6 5/8	
ONE	x3t	PL.11½x ¾	1	3½			
ONE	x3bb	PL.17½x ¼	1	5½			
3	x1a	BAR 5 x ¾	6	7			
ONE	x1ac	BAR 8 x 1	6	7			
ONE	x1ad	BAR 8 x 1	6	7			
ONE	x1dh	BAR 5 x ¾	6	7			
2	x1dk	BAR 5 x ¾	6	7			
ONE	x2ct	BAR 7 x ¾	6	7			
ONE	x2cw	BAR 7 x ¾	6	7			
ONE	x2dn	BAR 7 x ¾	6	7			
ONE	x2dp	BAR 7 x ¾	6	7			
ONE	x2fc	BAR 7 x ¾	6	7			
ONE	x2fd	BAR 7 x ¾	6	7			
4	x4ap	L5 x 3 x ¼	0	6			
12		1" STD. HEX. NUTS				BI 12	
12		WASHERS FOR 1" RODS				BI 8	
8		¾" H.S. BOLT	0	2		BI 2	
8		WASHERS FOR ¾" BOLTS				BI 9	

NO. 1	REVISION CHANGED WELD SIZES	DATE 1-3-85
<b>HIGH STEEL STRUCTURES, INC.</b> <small>1005 Old Philadelphia Pike Lancaster, Pennsylvania 17603 Phone 717/299-528</small> <small>A Subsidiary of High Industries, Inc.</small>		
GIRDER G3C		
I-395 BRIDGE OVER PENOBSCOT RIVER		
I-395 BRIDGE STA. 164+60.00		
PENOBSCOT COUNTY		
STATE OF MAINE		
DEPARTMENT OF TRANSPORTATION		
STATE CONTRACT OR REF. NO.	6	CONTRACTOR CIANBRO CORP.
IN CHARGE HINKLE	MADE BY C.S.	CHKD. BY G.F.Z. DATE 7/4/84
CONTRACT ME-84088-1	DRAWING NUMBER	29 OF 36

**SHOP NOTE**  
**HOLES:** 5/8" # (UN)  
**BOLTS:** AS NOTED  
**PAINT:** NONE  
 FOR GENERAL SHOP NOTES, SEE DWG. N1.  
 FOR WEB CAMBER DIAGRAM, SEE DWG. W1.  
**R95-145**  
 CODE: 4000

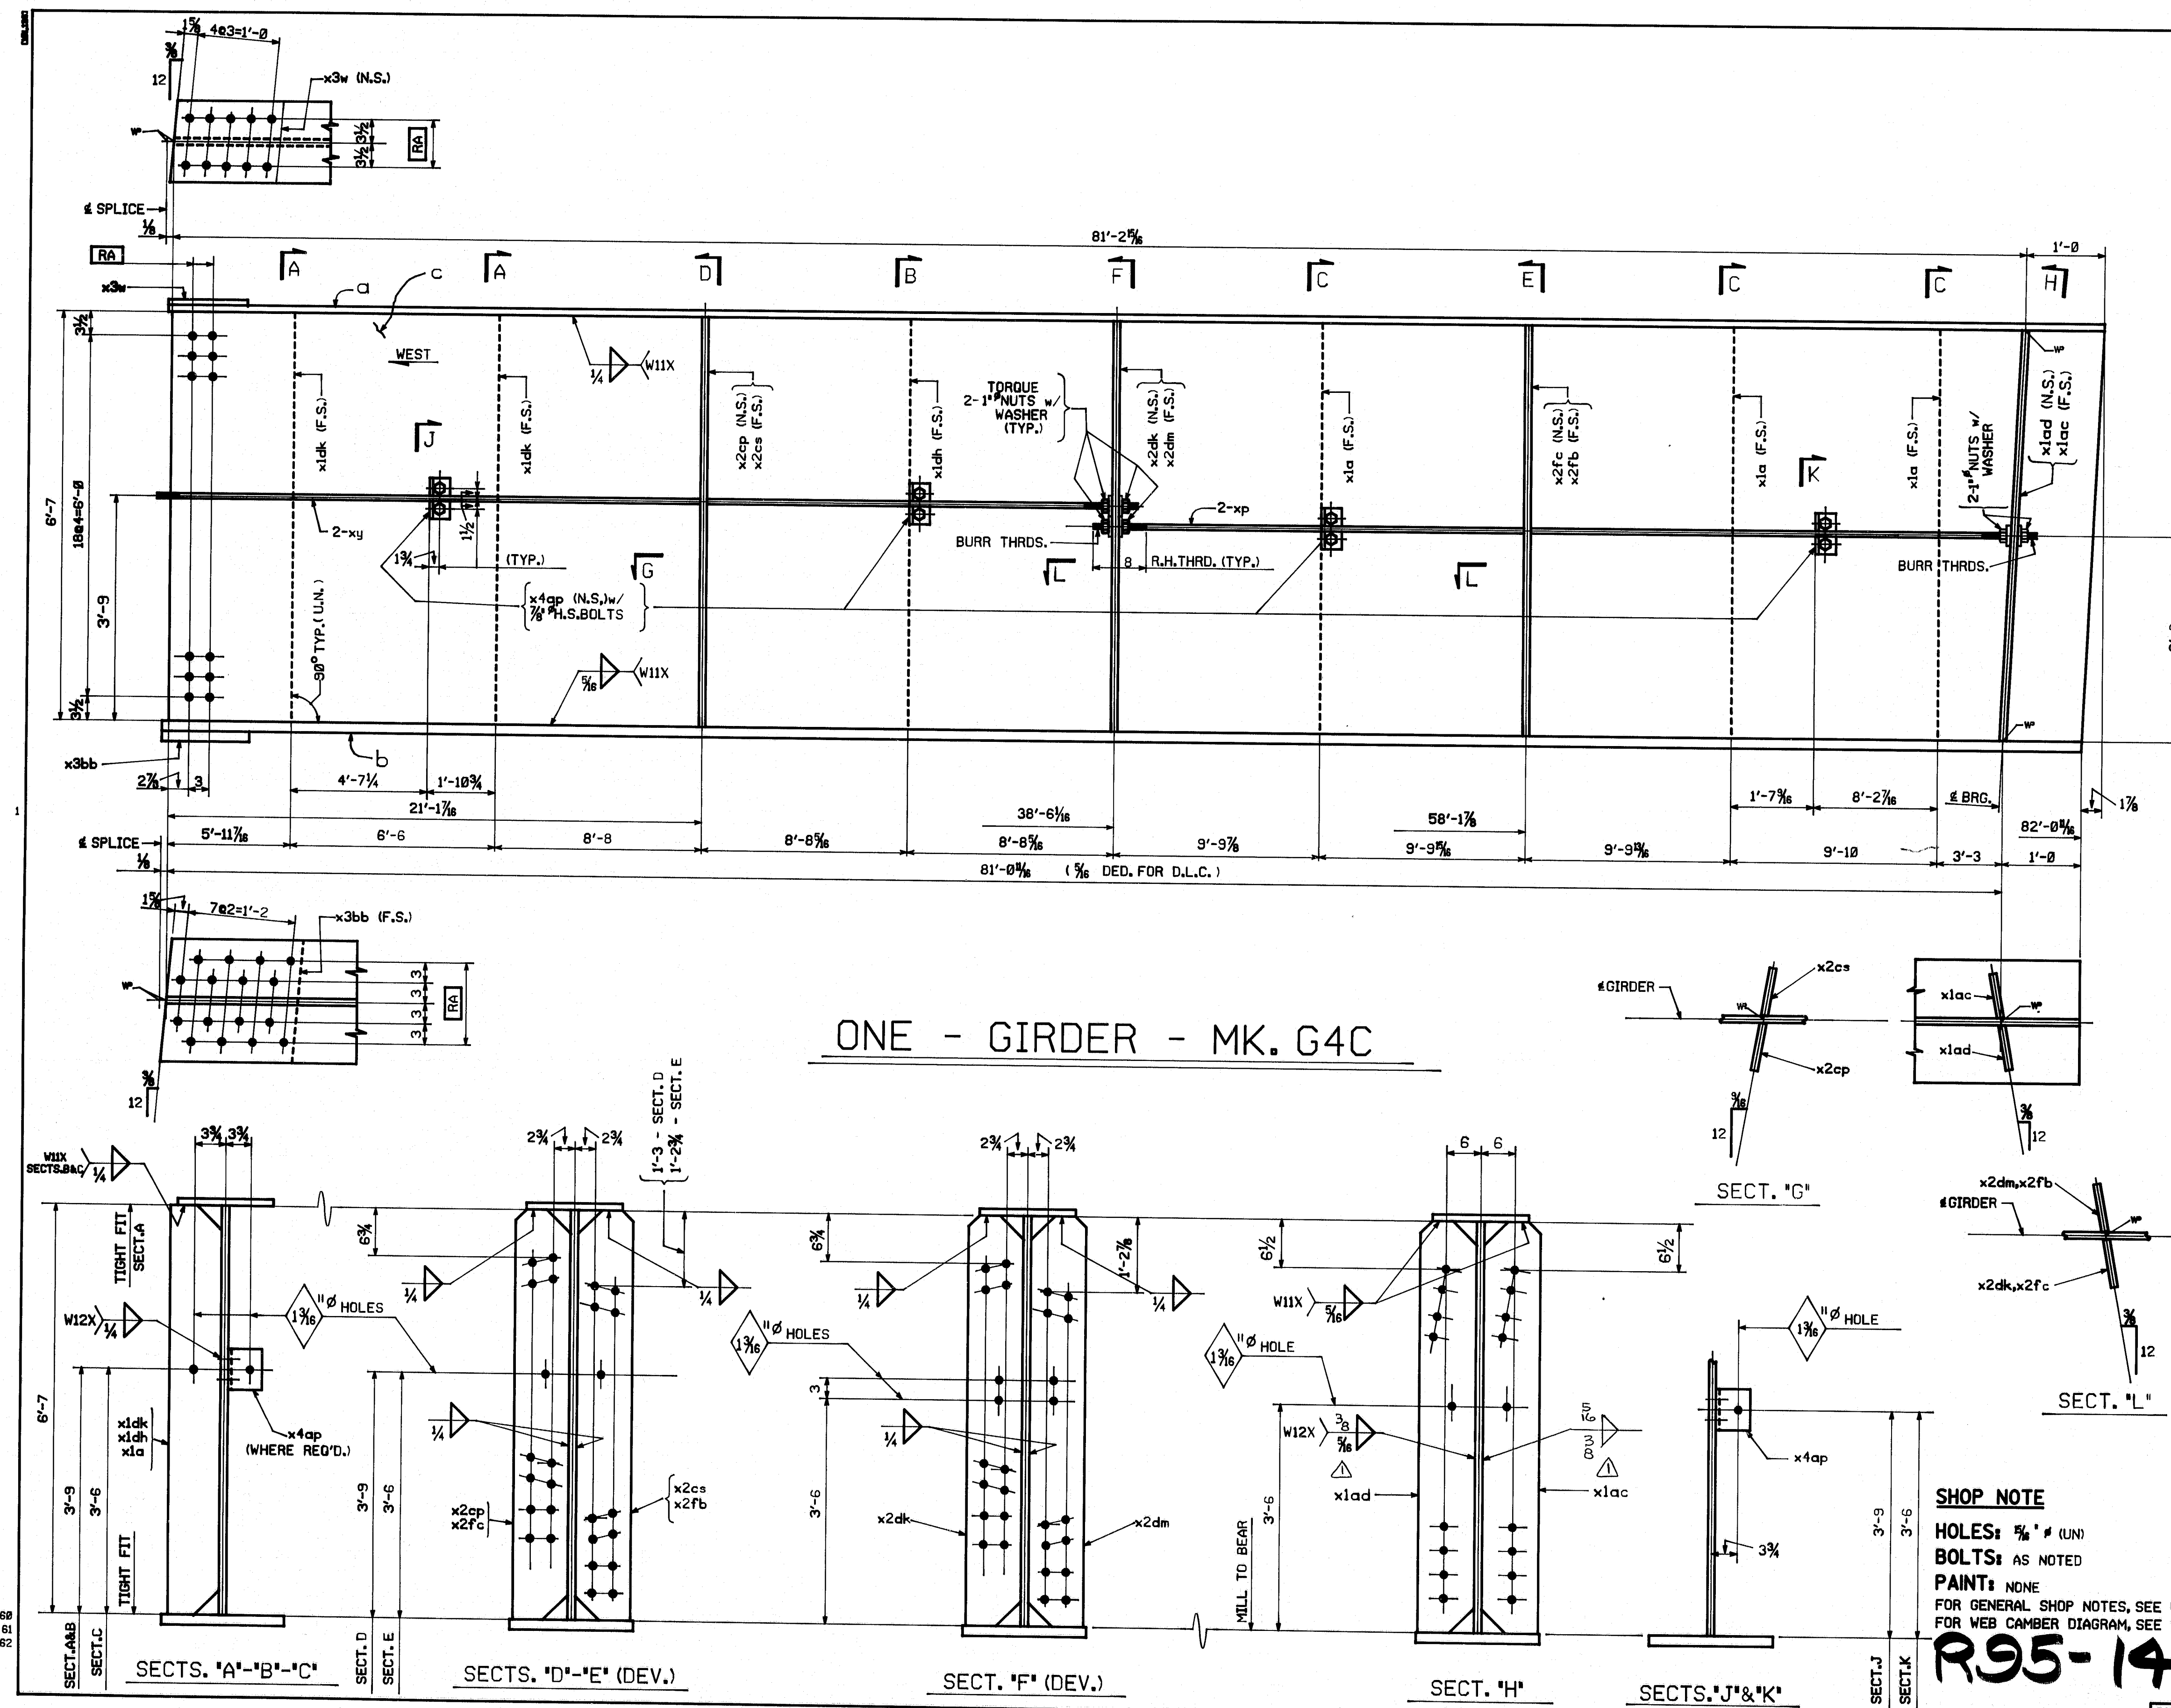

# ONE - GIRDER - MK. G4C

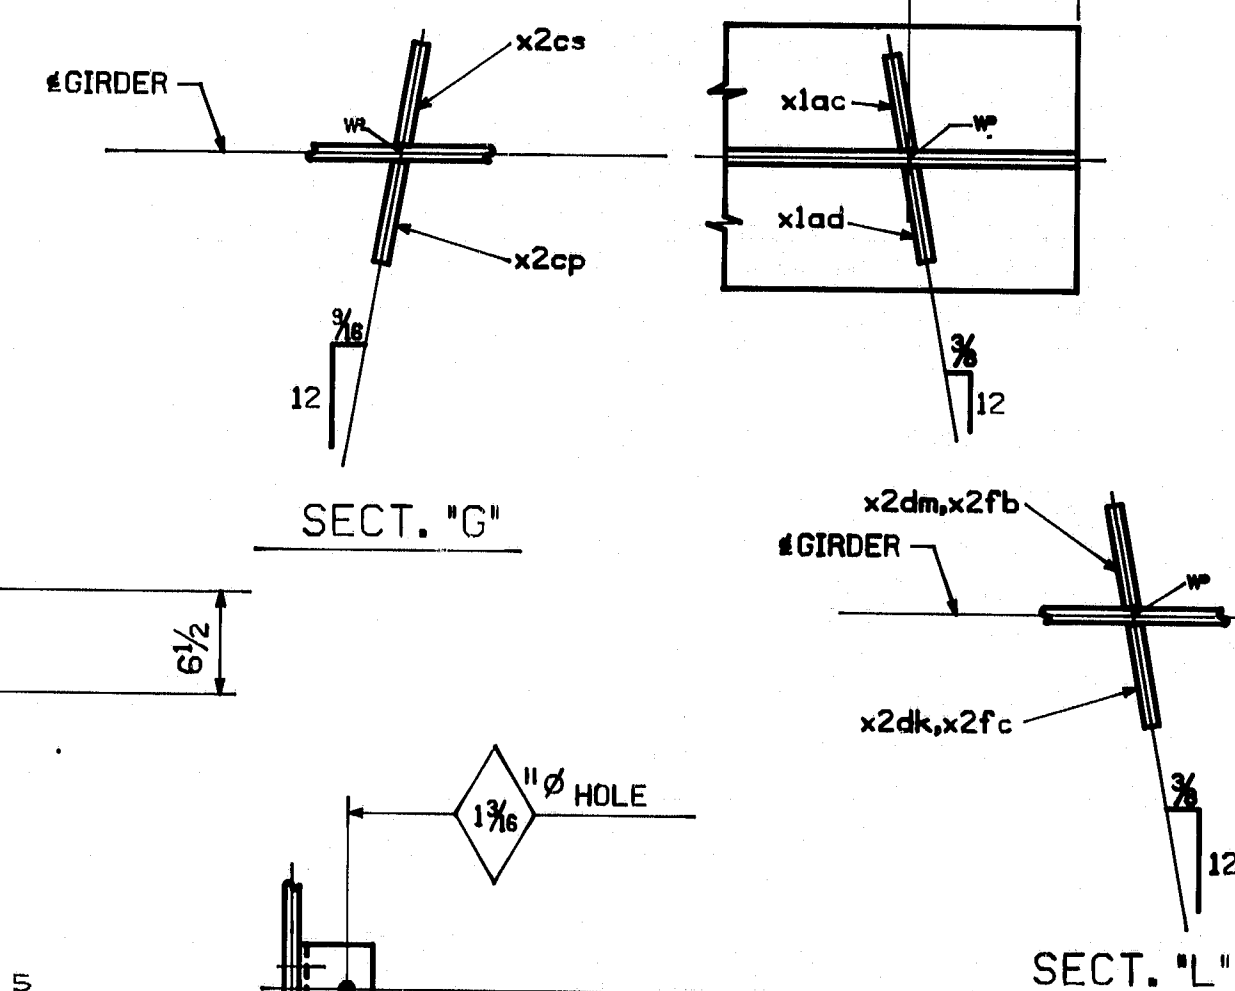


**SHOP NOTE**  
 HOLES: 3/4\" (UN)  
 BOLTS: AS NOTED  
 PAINT: NONE  
 FOR GENERAL SHOP NOTES, SEE DWG. N1.  
 FOR WEB CAMBER DIAGRAM, SEE DWG. W1.

**R95-146**

FED. ROAD DIST. NO.		STATE		FED. AID PROJ. NO.	
1		ME.		I-10-395-8(02)17	
BILL OF MATERIAL					
NO.	MARK	DESCRIPTION	LENGTH	REMARKS	ITEM
ONE-GIRDER MK. G4C					
ONE	a	PL.12 x ¾	82	¾	
ONE	b	PL.18 x 1½	82	1	
ONE	c	PL.79 x ½	82	2½	
2	xp	1" ROD	42	11½	THRD. BOTH ENDS
2	xy	1" ROD	38	9¾	THRD. BOTH ENDS
ONE	x3w	PL.11¾ x ⅞	1	3¾	
ONE	x3bb	PL.17½ x ¼	1	5¾	
3	x1a	BAR 5 x ⅞	6	7	
ONE	x1ac	BAR 8 x 1	6	7	
ONE	x1ad	BAR 8 x 1	6	7	
ONE	x1dh	BAR 5 x ⅞	6	7	
2	x1dk	BAR 5 x ⅞	6	7	
ONE	x2cp	BAR 7 x ⅞	6	7	
ONE	x2cs	BAR 7 x ⅞	6	7	
ONE	x2dk	BAR 7 x ⅞	6	7	
ONE	x2dm	BAR 7 x ⅞	6	7	
ONE	x2fb	BAR 7 x ⅞	6	7	
ONE	x2fc	BAR 7 x ⅞	6	7	
4	x4ap	L 5 x 3 x ¼	0	6	
12		1" STD. HEX. NUTS			B1 12
12		WASHERS FOR 1" RODS			B1 8
8		¾" H.S. BOLT	0	2	B1 2
8		WASHERS FOR ¾" BOLTS			B1 9

NO.	REVISION	CHANGED WELD SIZES	DATE
1			1-3-85
HIGH STEEL STRUCTURES, INC.			
1008 Old Philadelphia Pike Lancaster, Pennsylvania 17603 Phone: 717/299-022			
A Subsidiary of High Industries, Inc.			
GIRDER G4C			
I-395 BRIDGE OVER PENOBSCOT RIVER			
I-395 BRIDGE STA. 164+60.00			
PENOBSCOT COUNTY			
STATE OF MAINE			
DEPARTMENT OF TRANSPORTATION			
STATE CONTRACT OR REF. NO.	6	CONTRACTOR	CIANBRO CORP.
IN CHARGE	HINKLE	MADE BY	C.S. G.F. DATE 7/6/84
CONTRACT NUMBER	ME-84088-1	DRAWING NUMBER	30 OF 36



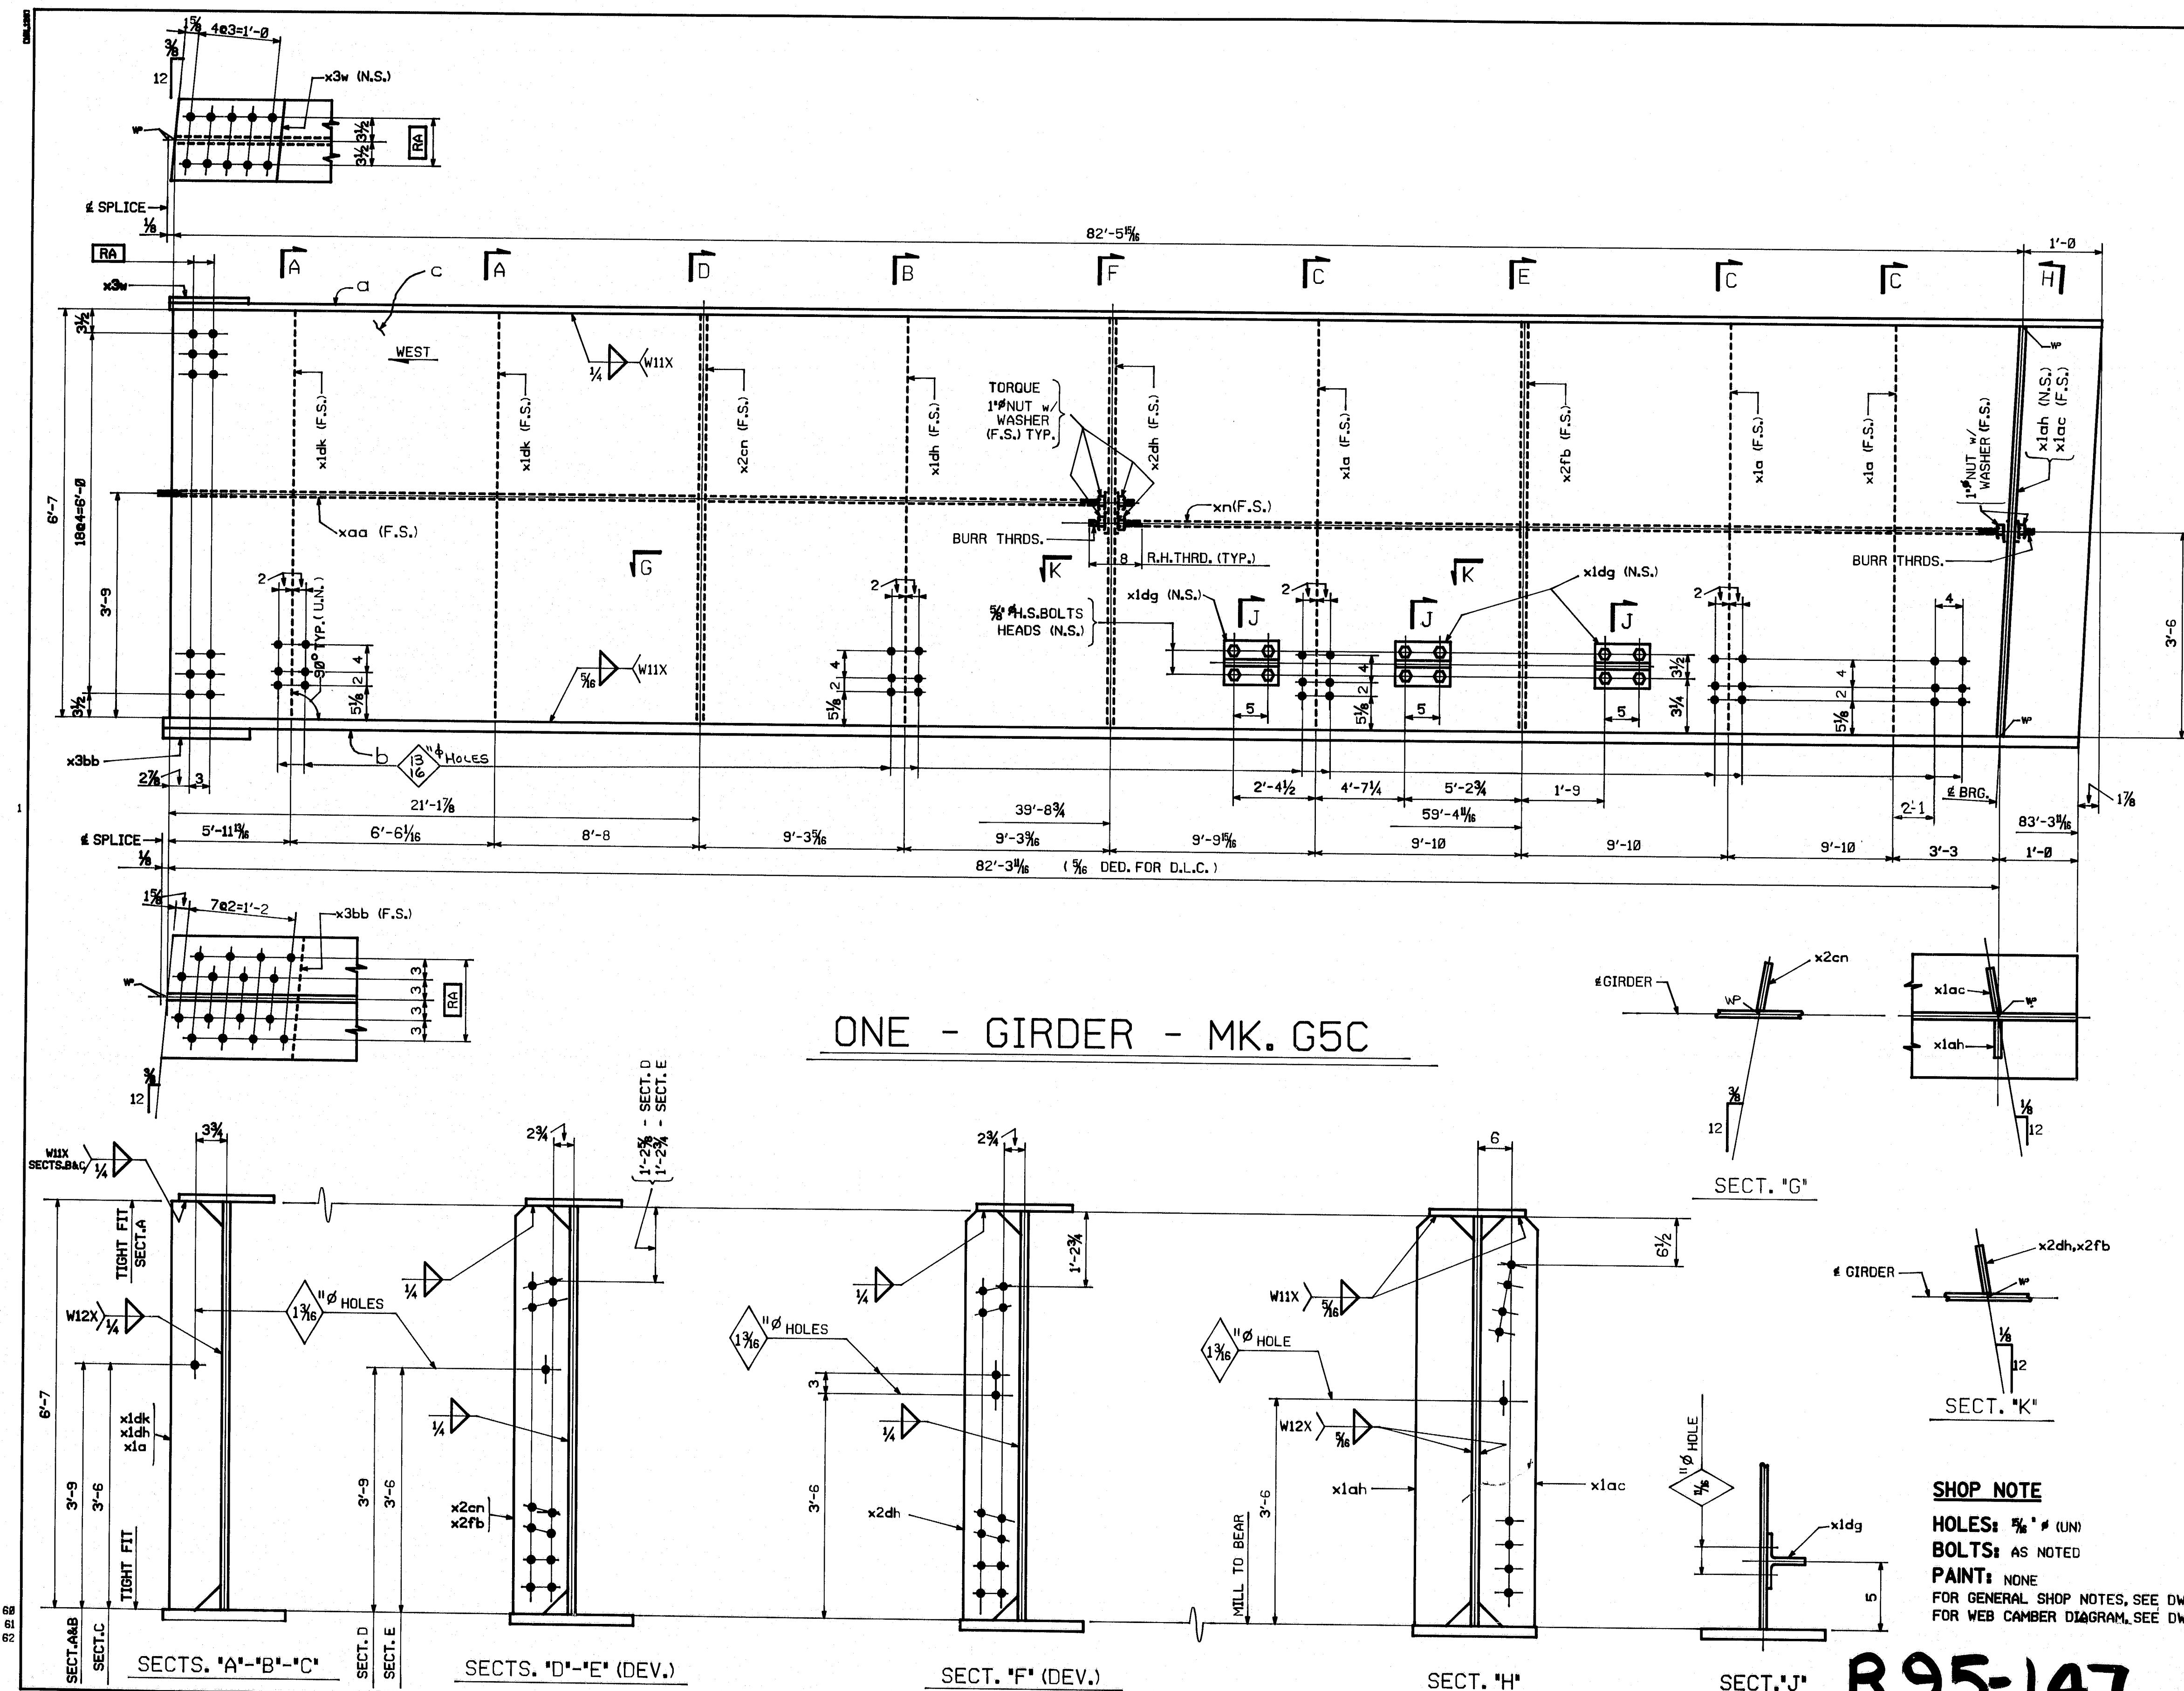

FED. ROAD DIST. NO.	STATE	FED. ROAD PROJ. NO.
1	ME.	I-10-395-8(82)176


BILL OF MATERIAL						
NO.	MARK	DESCRIPTION	LENGTH	REMARKS	ITEM	QTY.
ONE - GIRDER MK. G5C						
ONE	a	PL.12 x 3/4	83	6 1/2		
ONE	b	PL.18 x 1 1/2	83	4		
ONE	c	PL.79 x 1/2	83	5 1/2		
ONE	xn	1" ROD	42	11 1/2	THRD. BOTH ENDS	6 1/2
ONE	xaa	1" ROD	40	10 1/2	THRD. BOTH ENDS	6 9
ONE	x3w	PL.11 3/4 x 7/8	1	3 1/4		
ONE	x3bb	PL.17 1/2 x 1/4	1	5 1/4		
3	x1a	BAR 5 x 7/8	6	7		
ONE	x1ac	BAR 8 x 1	6	7		
ONE	x1ah	BAR 8 x 1	6	7		
ONE	x1dh	BAR 5 x 7/8	6	7		
2	x1dk	BAR 5 x 7/8	6	7		
ONE	x2cn	BAR 7 x 7/8	6	7		
ONE	x2dh	BAR 7 x 7/8	6	7		
ONE	x2fb	BAR 7 x 7/8	6	7		
3	x1dg	WT 6 x 13	0	8		
6		1" STD. HEX. NUTS				B1 12
6		WASHERS FOR 1" RODS				B1 8
12		3/8" H.S. BOLT	0	2		B1 6
12		WASHERS FOR 3/8" H.S. BOLTS				B1 10

NO.	REVISION	DATE
HIGH STEEL STRUCTURES, INC. 100 Old Philadelphia Pike Lancaster, Pennsylvania 17603 Phone: 717/299-0200 A Subsidiary of High Industries, Inc.		
GIRDER G5C		
I-395 BRIDGE OVER PENOBSCOT RIVER		
I-395 BRIDGE STA. 164+60.00		
PENOBSCOT COUNTY		
STATE OF MAINE		
DEPARTMENT OF TRANSPORTATION		
STATE CONTRACT OR REF. NO.	6	CONTRACTOR CIANBRO CORP.
IN CHARGE HINKLE	MADE BY C.S.	CHKD. BY G.F.F. DATE 7/6/84
CONTRACT NUMBER ME-84088-1	DRAWING NUMBER 31 OF 36	

**SHOP NOTE**  
HOLES: 3/8" (UN)  
BOLTS: AS NOTED  
PAINT: NONE  
FOR GENERAL SHOP NOTES, SEE DWG. N1.  
FOR WEB CAMBER DIAGRAM, SEE DWG. W1.

**R95-147**

CODE 4000

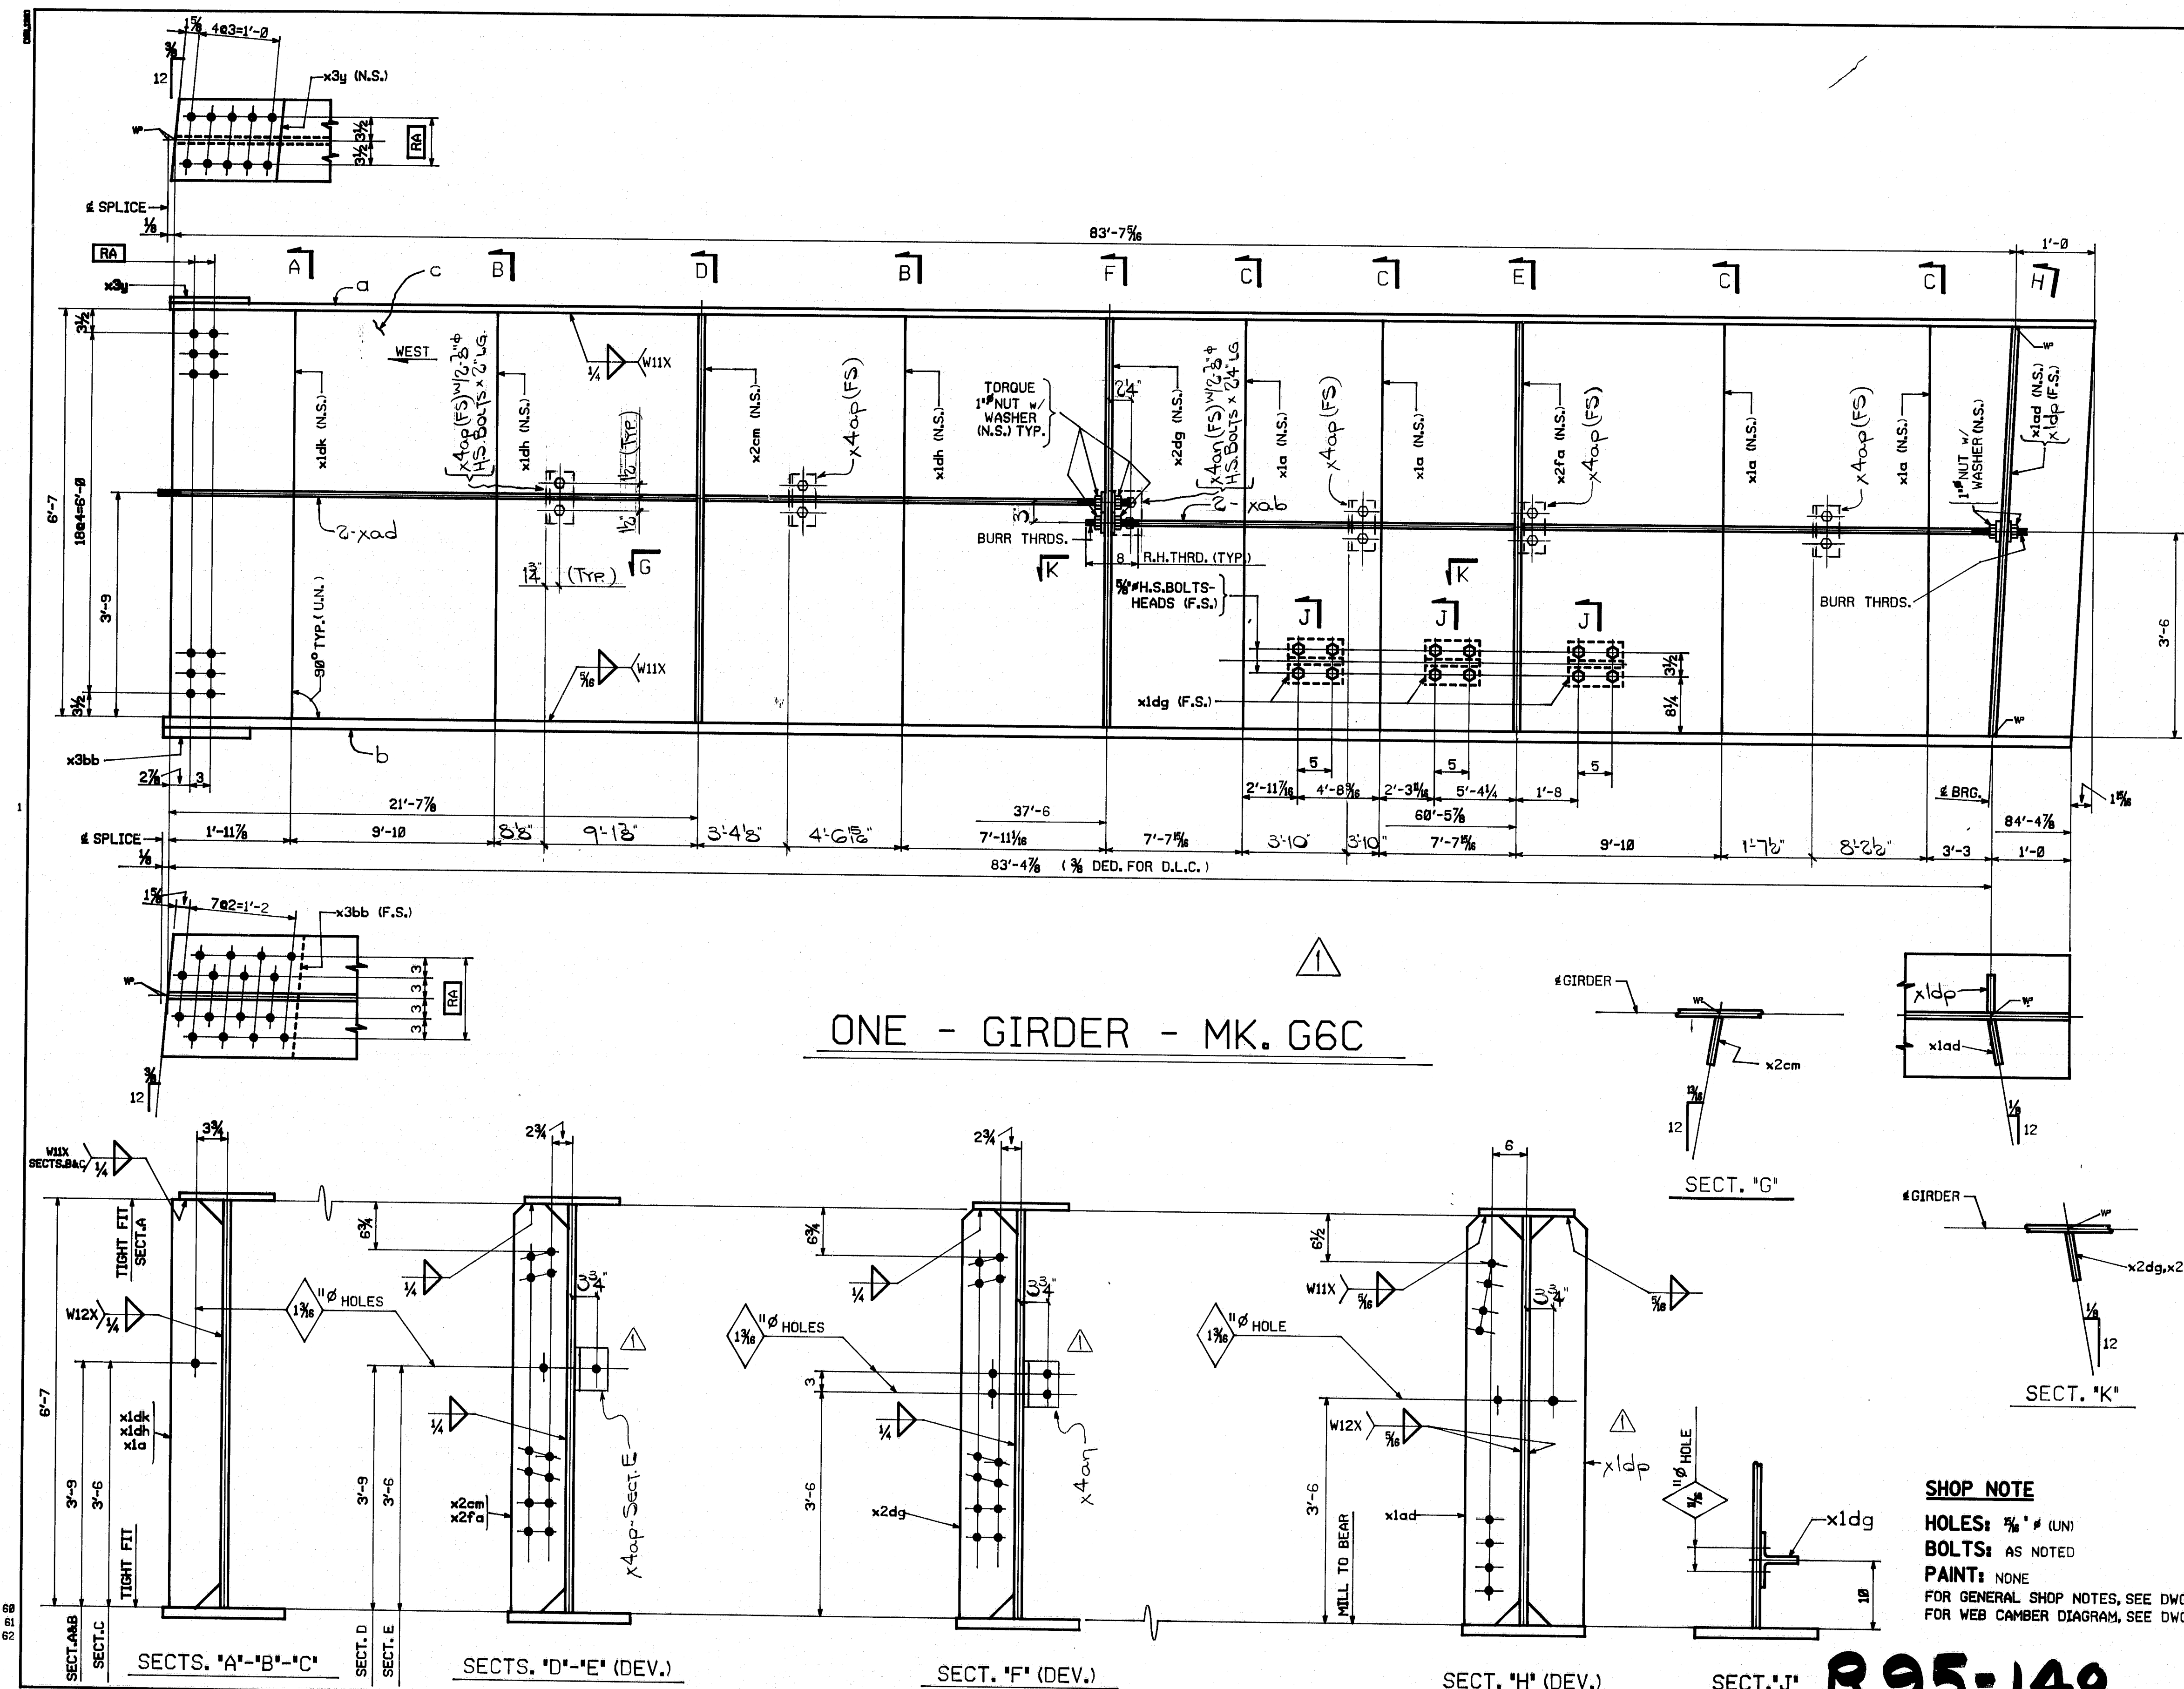

FED. ROAD DIV. NO.			STATE		FED. ROAD PROJ. NO.	
1			ME.		I-IG-395-8(82)176	
BILL OF MATERIAL						
NO.	MARK	DESCRIPTION	LENGTH	REMARKS	ITEM	SHIPMENT NO.
ONE-GIRDER MK. G6C						23210
ONE	a	PL.12 x 3/4	84	7 1/2		
ONE	b	PL.18 x 1 1/2	84	5 1/2		
ONE	c	PL.79 x 1/2	84	7 1/2		
2	xab	1" ROD	46	3 1/2	THRD. BOTH ENDS	6 14
2	xad	1" ROD	37	9 1/2	THRD. BOTH ENDS	6 6
ONE	x3y	PL.11 1/2 x 1	1	3 1/2		
ONE	x3bb	PL.17 1/2 x 1/2	1	5 1/2		
ONE	x4an	5 x 3 1/2 x 1/2	0	6		
5	x4ap	5 x 3 x 1/2	0	6		
4	x1a	BAR 5 x 7/8	6	7		
ONE	x1ad	BAR 8 x 1	6	7		
ONE	x1dp	BAR 8 x 1	6	7		
2	x1dh	BAR 5 x 7/8	6	7		
ONE	x1dk	BAR 5 x 7/8	6	7		
ONE	x2cm	BAR 7 x 7/8	6	7		
ONE	x2dg	BAR 7 x 7/8	6	7		
ONE	x2fa	BAR 7 x 7/8	6	7		
3	x1dg	WT6 x 13	0	8		
12		1" STD. HEX. NUTS				B1 12
12		WASHERS FOR 1" RODS				B1 8
12		5/8" H.S. BOLTS	0	2		B1 6
12		WASHERS FOR 5/8" H.S. BOLTS				B1 10
2		3" H.S. BOLT	0	24		B1 3
10		3" H.S. BOLT	0	2		B1 2
12		WASHERS FOR 3" H.S. BOLTS				B1 9

NO.	REVISION	contract revision	DATE 9-10-84
		control 14	
HIGH STEEL STRUCTURES, INC. 100 Old Philadelphia Pike Lancaster, Pennsylvania 17603 Phone 717/299-5211 A Subsidiary of High Industries, Inc.			
GIRDER G6C			
I-395 BRIDGE OVER PENOBSCOT RIVER			
I-395 BRIDGE STA. 164+60.00			
PENOBSCOT COUNTY			
STATE OF MAINE			
DEPARTMENT OF TRANSPORTATION			
STATE CONTRACT OR REF. NO.	6	CONTRACTOR	CIANBRO CORP.
IN CHARGE	HINKLE	MADE BY	C.S. BY G.F.Z. DATE 7/6/84
CONTRACT NUMBER	ME-84088-1	DRAWING NUMBER	32 OF 36

**SHOP NOTE**

HOLES: 1/2" (UN)

BOLTS: AS NOTED


PAINT: NONE

FOR GENERAL SHOP NOTES, SEE DWG. N1.

FOR WEB CAMBER DIAGRAM, SEE DWG. WCI.

**R95-148**




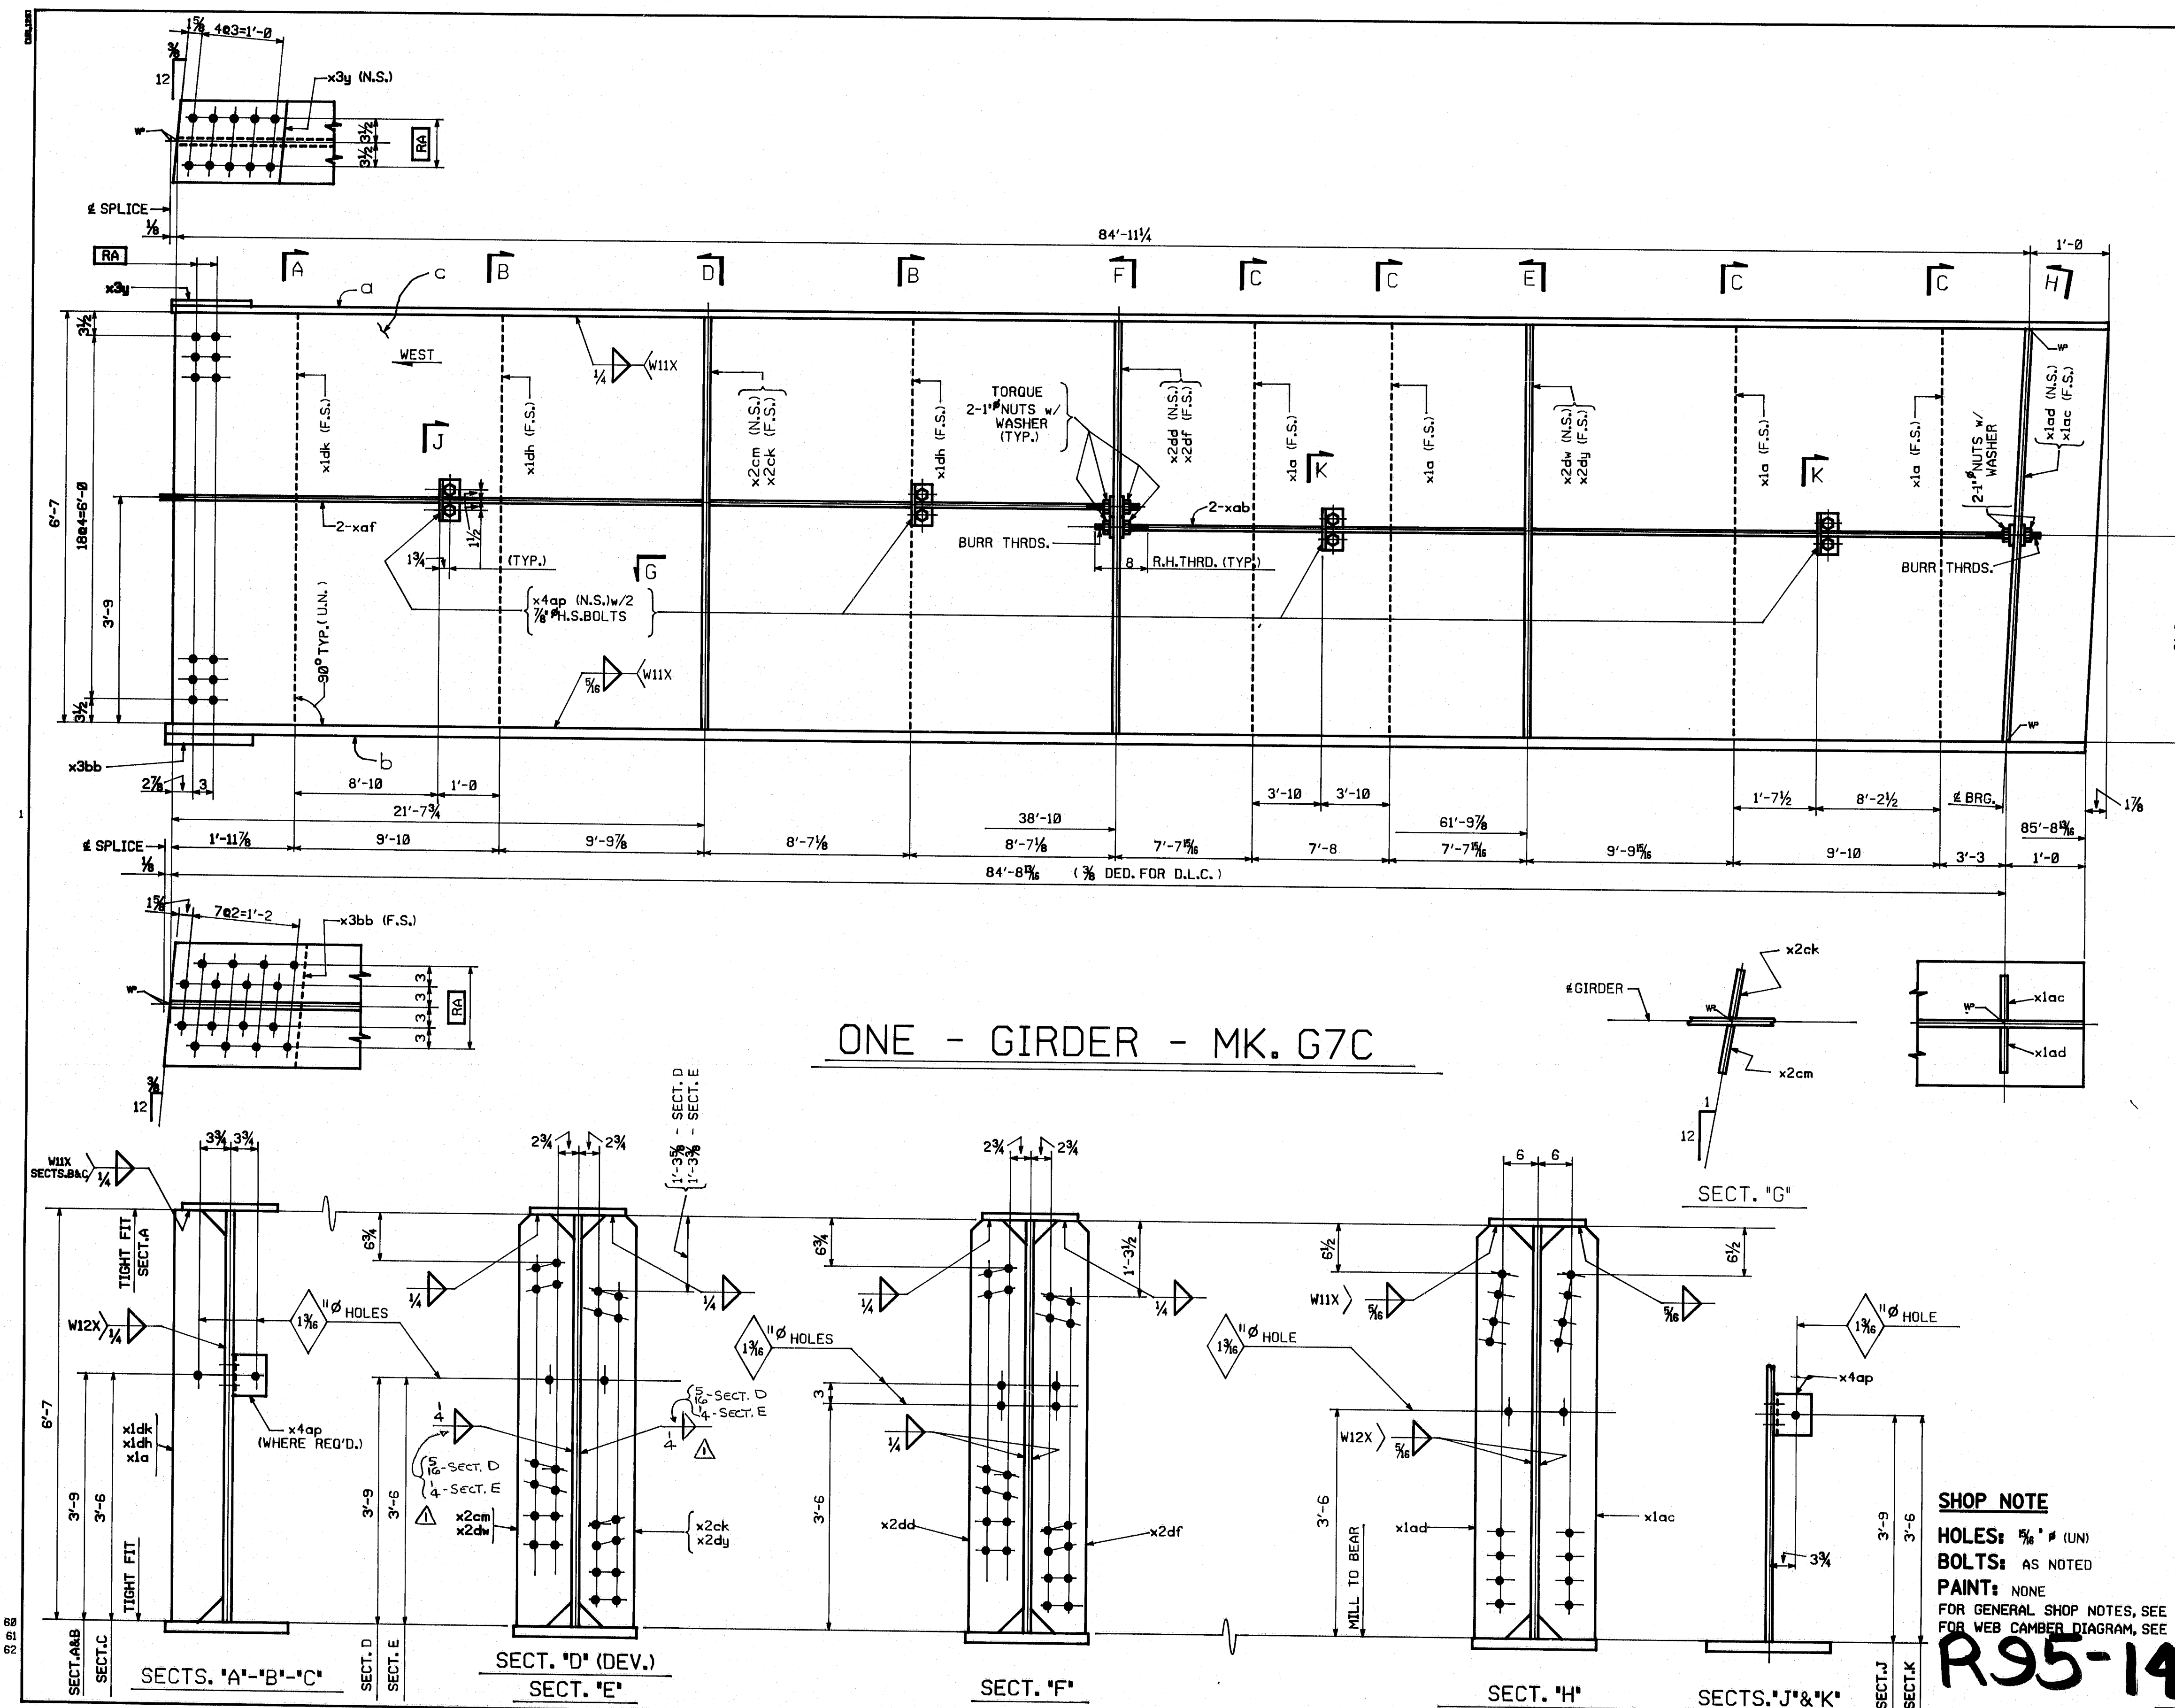

FED. ROAD DIV. NO.			STATE		FED. AID PROJ. NO.	
1			ME.		I-IG-395-8(2)176	
BILL OF MATERIAL						
NO.	MARK	DESCRIPTION	LENGTH	REMARKS	ITEM	SUB-NUMBER
ONE-GIRDER			MK. G7C			23135
ONE	a	PL.12 x ¾	85	11 1/8		
ONE	b	PL.18 x 1½	85	9 1/8		
ONE	c	PL.79 x ½	85	11 1/4		
2	xab	1"Ø ROD	46	3 3/4	THRD. BOTH ENDS	6/4
2	xaf	1"Ø ROD	39	1 3/4	THRD. BOTH ENDS	6/8
ONE	x3y	PL.11 1/2x 1	1	3 1/8		
ONE	x3bb	PL.17 1/2x ¼	1	5 1/8		
4	x1a	BAR 5 x 7/16	6	7		
ONE	x1ac	BAR 8 x 1	6	7		
ONE	x1ad	BAR 8 x 1	6	7		
2	x1dh	BAR 5 x 7/16	6	7		
ONE	x1dk	BAR 5 x 7/16	6	7		
ONE	x2ck	BAR 7 x 7/16	6	7		
ONE	x2cm	BAR 7 x 7/16	6	7		
ONE	x2dd	BAR 7 x 7/16	6	7		
ONE	x2df	BAR 7 x 7/16	6	7		
ONE	x2dw	BAR 7 x 7/16	6	7		
ONE	x2dy	BAR 7 x 7/16	6	7		
4	x4ap	L 5 x 3 x ¼	Ø	6		
12		1"STD.HEX.NUTS				B1/12
12		WASHERS FOR 1"Ø RODS				B1/8
8		¾" A.S.BOLTS	Ø	2		B1/2
8		WASHERS FOR ¾" A.S.BOLTS				B1/9

NO. 1	REVISION	CHANGED WELD SIZES	DATE 1-3-85
<b>HIGH STEEL STRUCTURES, INC.</b> 805 Old Philadelphia Pike Lancaster, Pennsylvania 17603 Phone 717/299-3333 A Subsidiary of H.S. Industries, Inc.			
GIRDER G7C			
I-395 BRIDGE OVER PENOBSCOT RIVER			
I-395 BRIDGE STA. 164+60.00			
PENOBSCOT COUNTY			
STATE OF MAINE			
DEPARTMENT OF TRANSPORTATION			
STATE CONTRACT OR REF. NO.	6	CONTRACTOR	CIANBRO CORP.
IN CHARGE	HINKLE	MADE BY	C.S.
CHD. BY	G.F. Z.	DATE	7/6/84
CONTRACT NUMBER	ME-84088-1	DRAWING NUMBER	33 OF 36

**SHOP NOTE**  
 HOLES: 3/8\" (UN)  
 BOLTS: AS NOTED  
 PAINT: NONE  
 FOR GENERAL SHOP NOTES, SEE DWG. N1.  
 FOR WEB CAMBER DIAGRAM, SEE DWG. WC1.  
**R95-149**  
 CODE: 4000

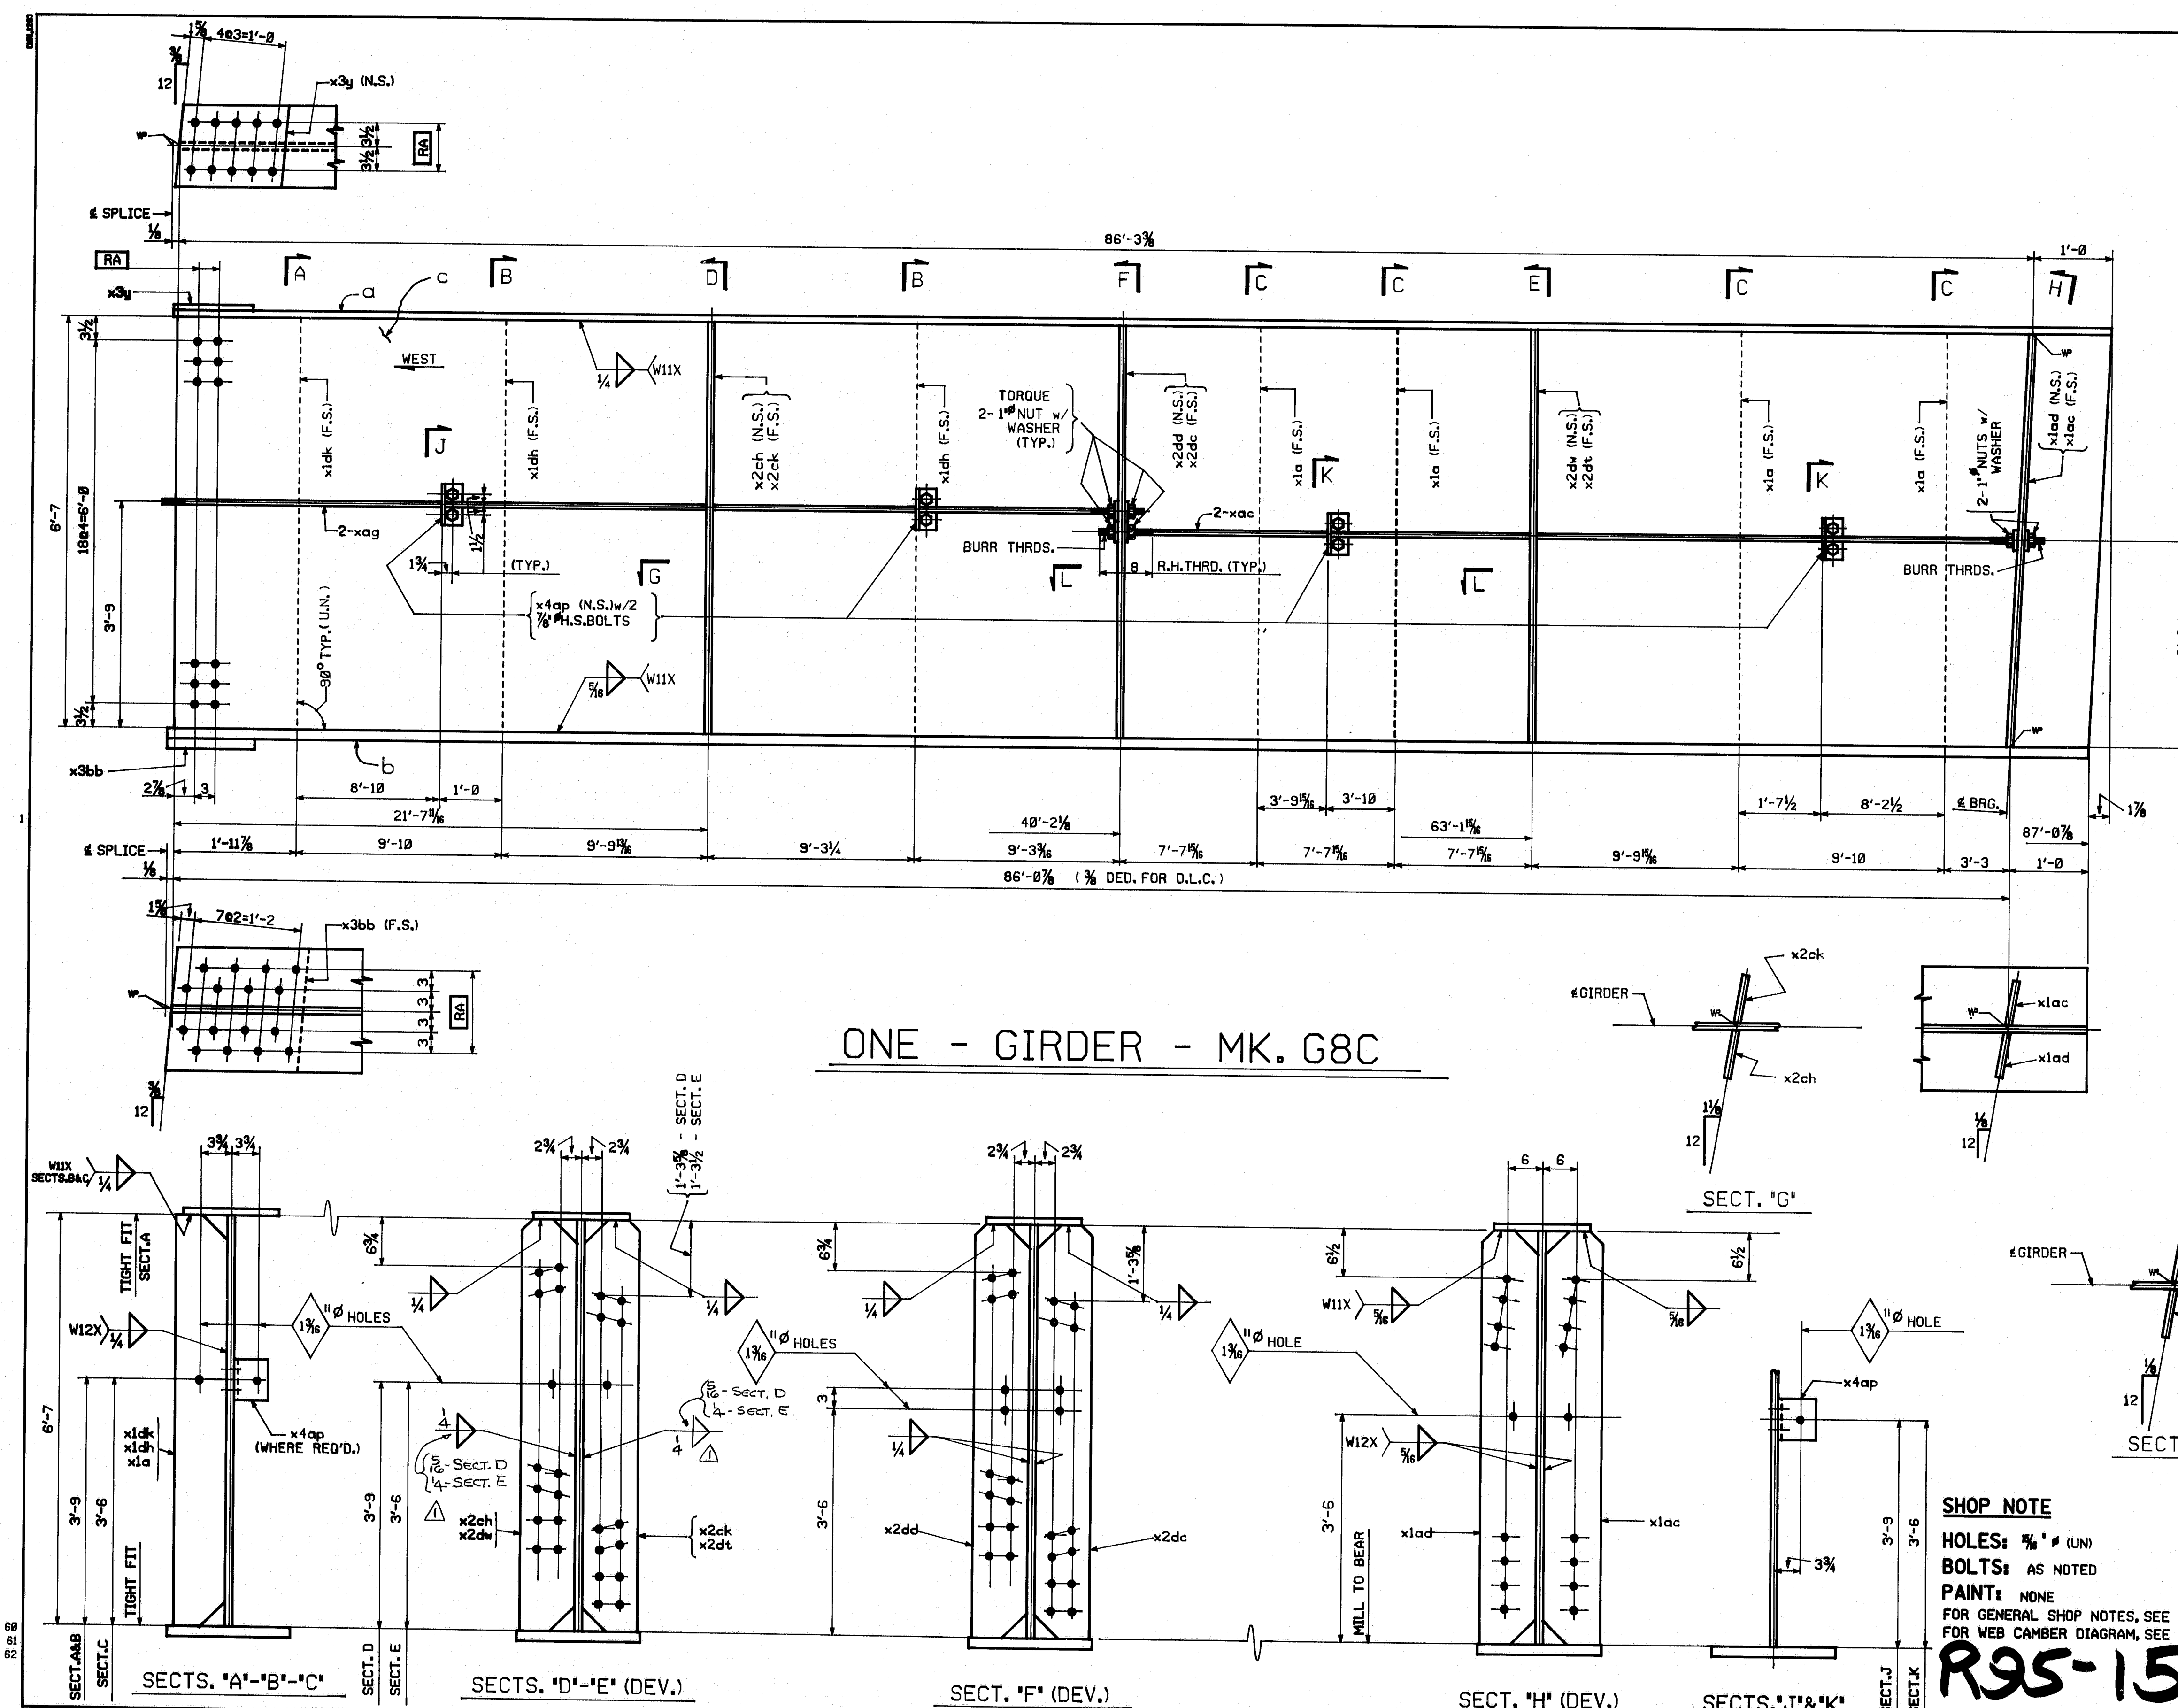

ONE - GIRDER - MK. G8C

FED. ROAD DIV. NO.			STATE		FED. AID PROJ. NO.	
1			ME.		I-10-395-81821176	
BILL OF MATERIAL						
NO.	MARK	DESCRIPTION	LENGTH	REMARKS	ITEM	SUB. WEIGHT LBS.
		ONE-GIRDER MK. G8C				24.085
ONE	a	PL.12 x 3/4	87	3 1/8		
ONE	b	PL.18 x 1 1/2	87	1 1/8		
ONE	c	PL.79 x 1/2	87	3 1/8		
2	xac	1" ROD	46	3 1/8	THRD. BOTH ENDS	6 1/4
2	xag	1" ROD	40	6 1/4	THRD. BOTH ENDS	6 1/4
ONE	x3y	PL.11 3/4 x 1	1	3 1/8		
ONE	x3bb	PL.17 1/2 x 1/4	1	5 1/8		
4	x1a	BAR 5 x 7/8	6	7		
ONE	x1ac	BAR 8 x 1	6	7		
ONE	x1ad	BAR 8 x 1	6	7		
2	x1dh	BAR 5 x 7/8	6	7		
ONE	x1dk	BAR 5 x 7/8	6	7		
ONE	x2ch	BAR 7 x 7/8	6	7		
ONE	x2ck	BAR 7 x 7/8	6	7		
ONE	x2dc	BAR 7 x 7/8	6	7		
ONE	x2dd	BAR 7 x 7/8	6	7		
ONE	x2dt	BAR 7 x 7/8	6	7		
ONE	x2dw	BAR 7 x 7/8	6	7		
4	x4ap	5 x 3 x 1/4	0	6		
12		1" STD. HEX. NUTS				BI 12
12		WASHERS FOR 1" RODS				BI 8
8		7/8" L.S. BOLTS	0	2		BI 2
8		WASHERS FOR 7/8" L.S. BOLTS				BI 9

NO. 1 REVISION CHANGED WELD SIZES DATE 1-3-85

**HIGH STEEL STRUCTURES, INC.**

1005 Old Philadelphia Pike  
Lancaster, Pennsylvania 17603  
Phone 717/299-528

A Subsidiary of High Industries, Inc.

GIRDER G8C  
I-395 BRIDGE OVER PENOBSCOT RIVER  
I-395 BRIDGE STA. 164+60.00  
PENOBSCOT COUNTY  
STATE OF MAINE  
DEPARTMENT OF TRANSPORTATION

STATE CONTRACT OR REF. NO. 6 CONTRACTOR CIANBRO CORP.

IN CHARGE HINKLE MADE BY C.S. CHK'D BY G.F.Z. DATE 7/6/84


CONTRACT ME-64088-1 DRAWING NUMBER 34 OF 36

**SHOP NOTE**  
HOLES: 5/8" (UN)  
BOLTS: AS NOTED  
PAINT: NONE  
FOR GENERAL SHOP NOTES, SEE DWG. N1.  
FOR WEB CAMBER DIAGRAM, SEE DWG. WCI.

**R95-150**

CODE: 4000



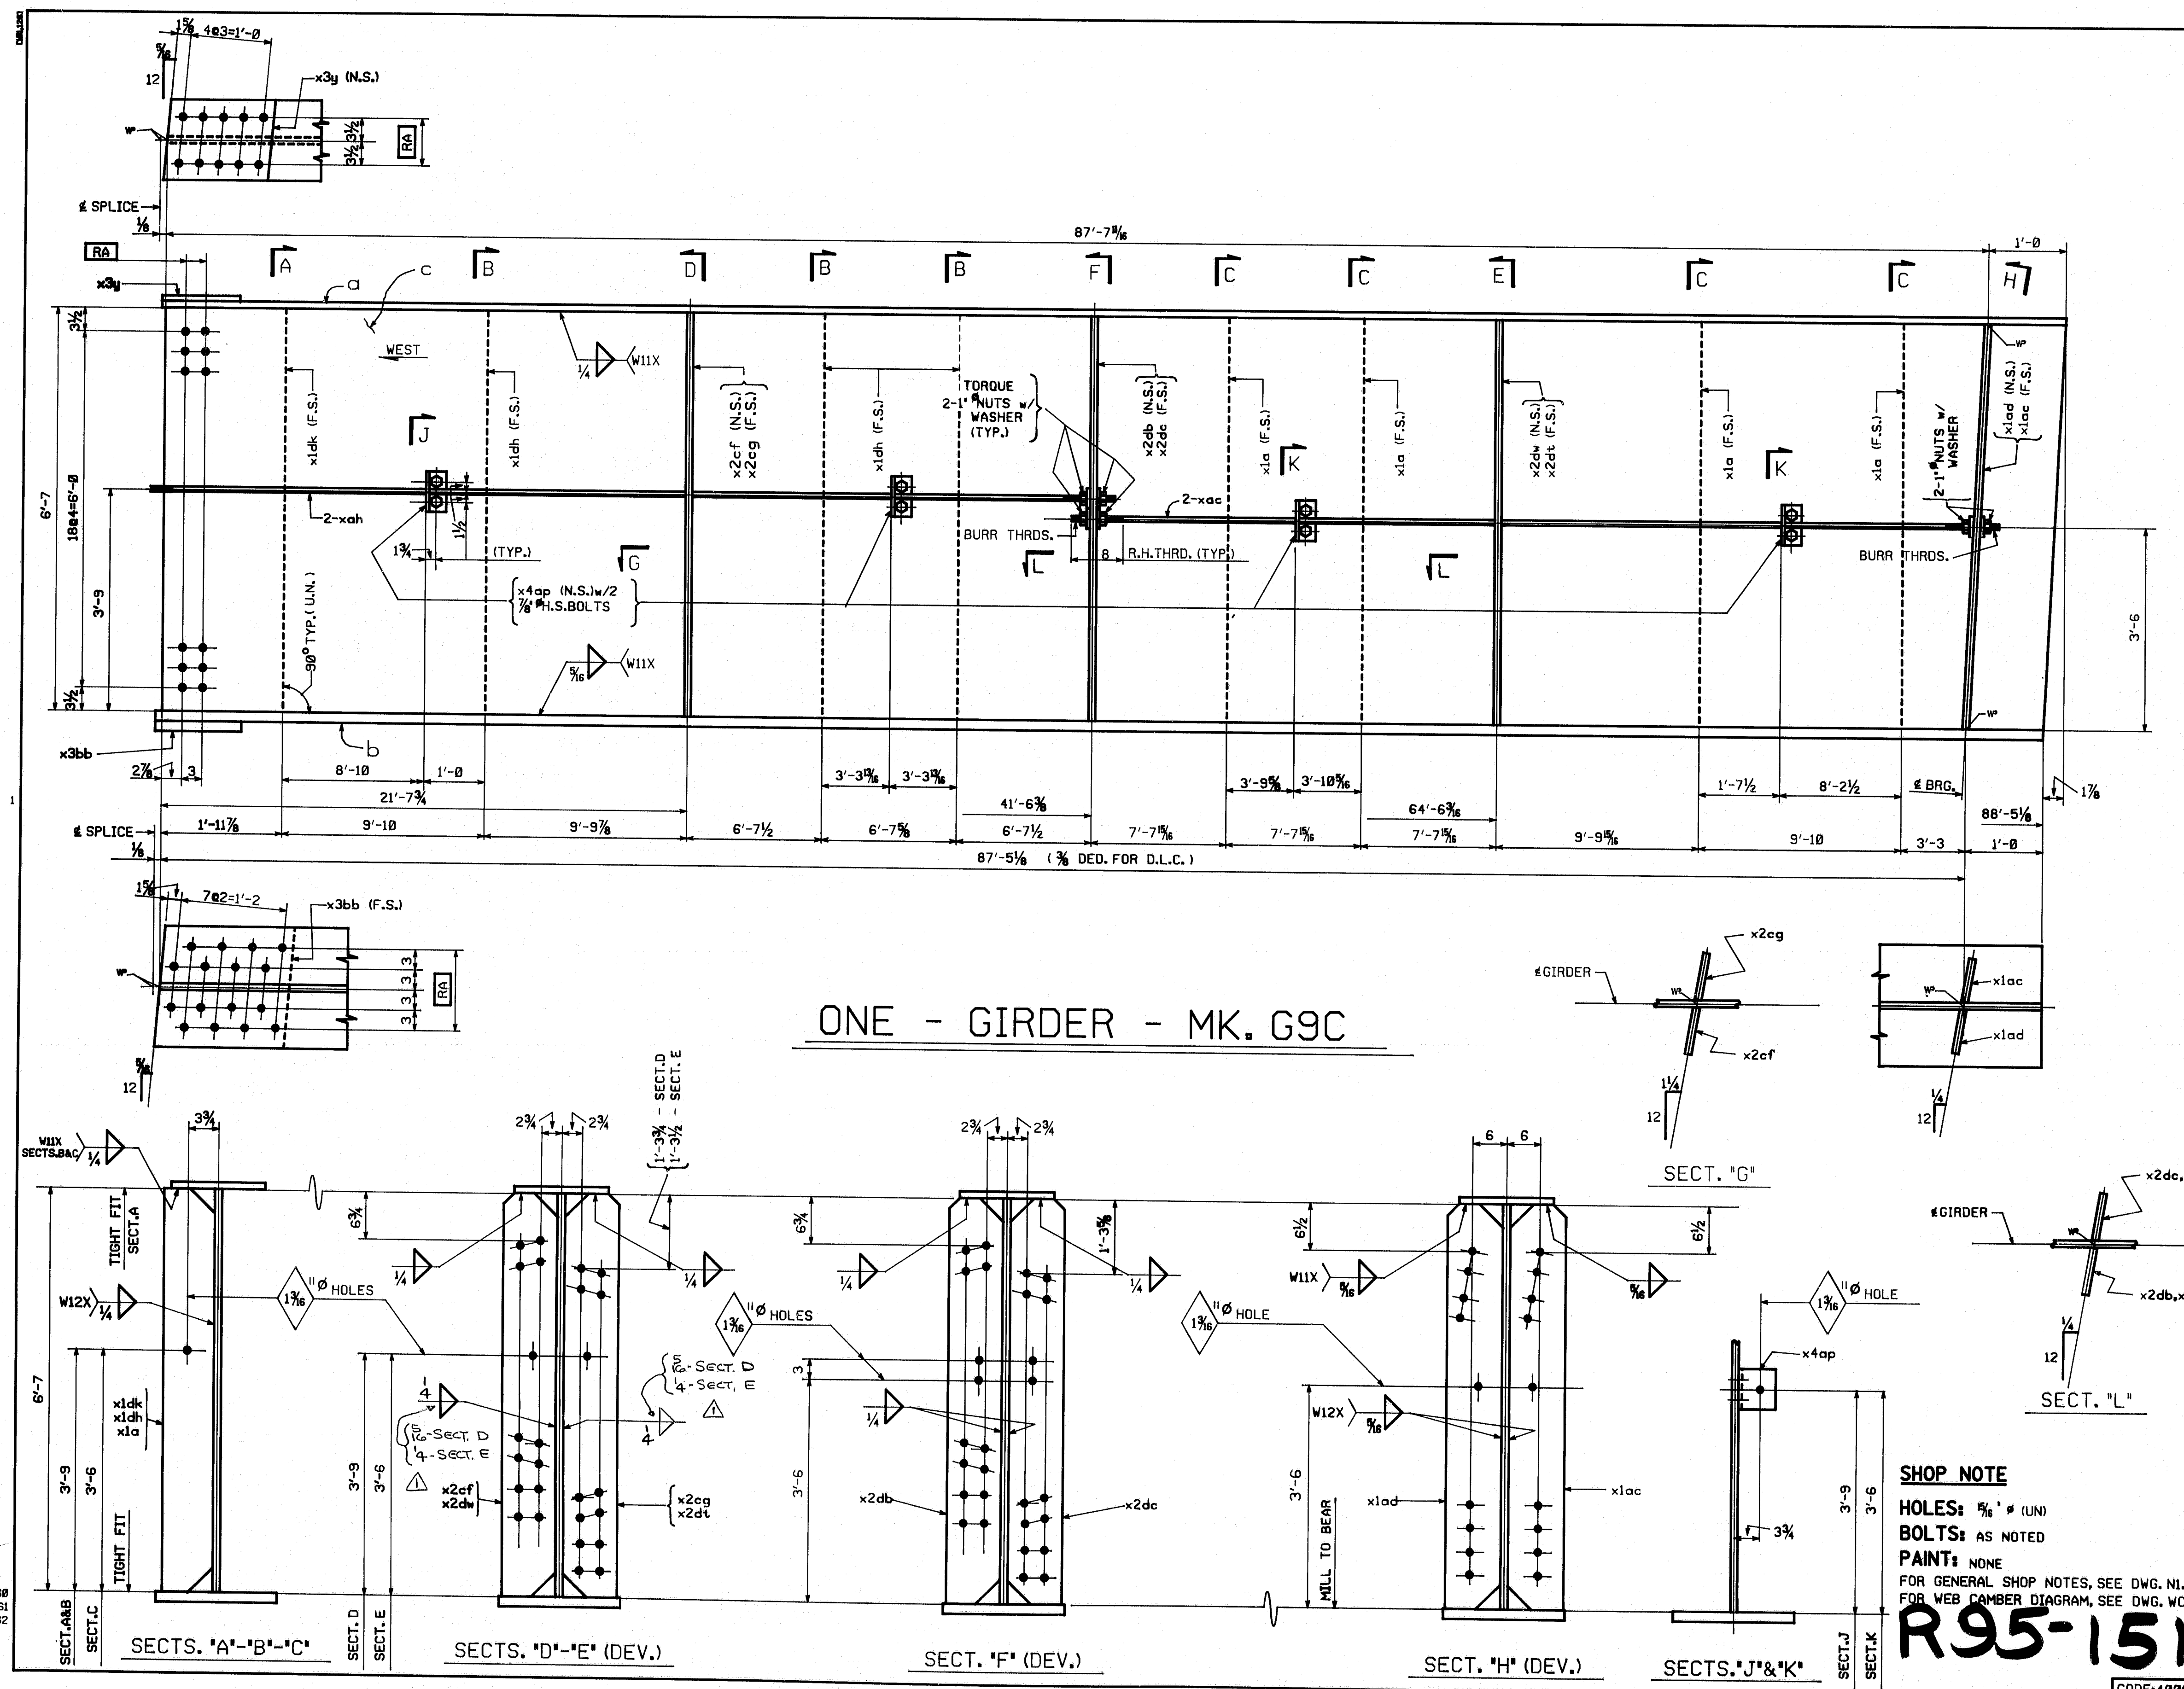

FED. ROAD DIV. NO.		STATE	FED. AID PROJ. NO.
1		ME.	1-10-395-8(82)176

BILL OF MATERIAL						
NO.	MARK	DESCRIPTION	LENGTH	REMARKS	ITEM	QTY.
ONE-GIRDER MK. G9C						
ONE	a	PL.12 x 3/4	88	7%		
ONE	b	PL.18 x 1 1/2	88	5%		
ONE	c	PL.79 x 1/2	88	7%		
2	xac	1" ROD	46	3%	THRD. BOTH ENDS	6 1/4
2	xah	1" ROD	41	10	THRD. BOTH ENDS	6 1/4
ONE	x3y	PL.11 3/4 x 1	1	3%		
ONE	x3bb	PL.17 1/2 x 1/4	1	5%		
4	xla	BAR 5 x 7/8	6	7		
ONE	xlac	BAR 8 x 1	6	7		
ONE	xlad	BAR 8 x 1	6	7		
3	xldh	BAR 5 x 7/8	6	7		
ONE	xldk	BAR 5 x 7/8	6	7		
ONE	x2cf	BAR 7 x 7/8	6	7		
ONE	x2cg	BAR 7 x 7/8	6	7		
ONE	x2db	BAR 7 x 7/8	6	7		
ONE	x2dc	BAR 7 x 7/8	6	7		
ONE	x2dt	BAR 7 x 7/8	6	7		
ONE	x2dw	BAR 7 x 7/8	6	7		
4	x4ap	L 5 x 3 x 1/4	0	6		
12		1" STD. HEX. NUTS				8 1/2
12		WASHERS FOR 1" RODS				8 1/2
8		3/4" S.BOLTS	0	2		8 1/2
8		WASHERS FOR 3/4" S.BOLTS				8 1/2

NO. 1	REVISION	CHANGED WELD SIZES	DATE 1-3-85
-------	----------	--------------------	-------------

**HIGH STEEL STRUCTURES, INC.**

1908 Old Philadelphia Pike  
Lancaster, Pennsylvania 17603  
Phone 717/299-5221  
A Subsidiary of High Industries, Inc.

GIRDER G9C

1-395 BRIDGE OVER PENOBSCOT RIVER

1-395 BRIDGE STA. 164+60.00

PENOBSCOT COUNTY

STATE OF MAINE

DEPARTMENT OF TRANSPORTATION

STATE CONTRACT OR REF. NO. 6 CONTRACTOR CIAMBRO CORP.

IN CHARGE HINKLE MADE BY C.S. 8/1 G.F.F. DATE 7/9/84

CONTRACT NUMBER ME-84088-1 DRAWING NUMBER 35 OF 36

**SHOP NOTE**

HOLES: 5/8" # (UN)

BOLTS: AS NOTED

PAINT: NONE

FOR GENERAL SHOP NOTES, SEE DWG. N1.





FOR WEB CAMBER DIAGRAM, SEE DWG. WCI.

**R95-151**

CODE:4000





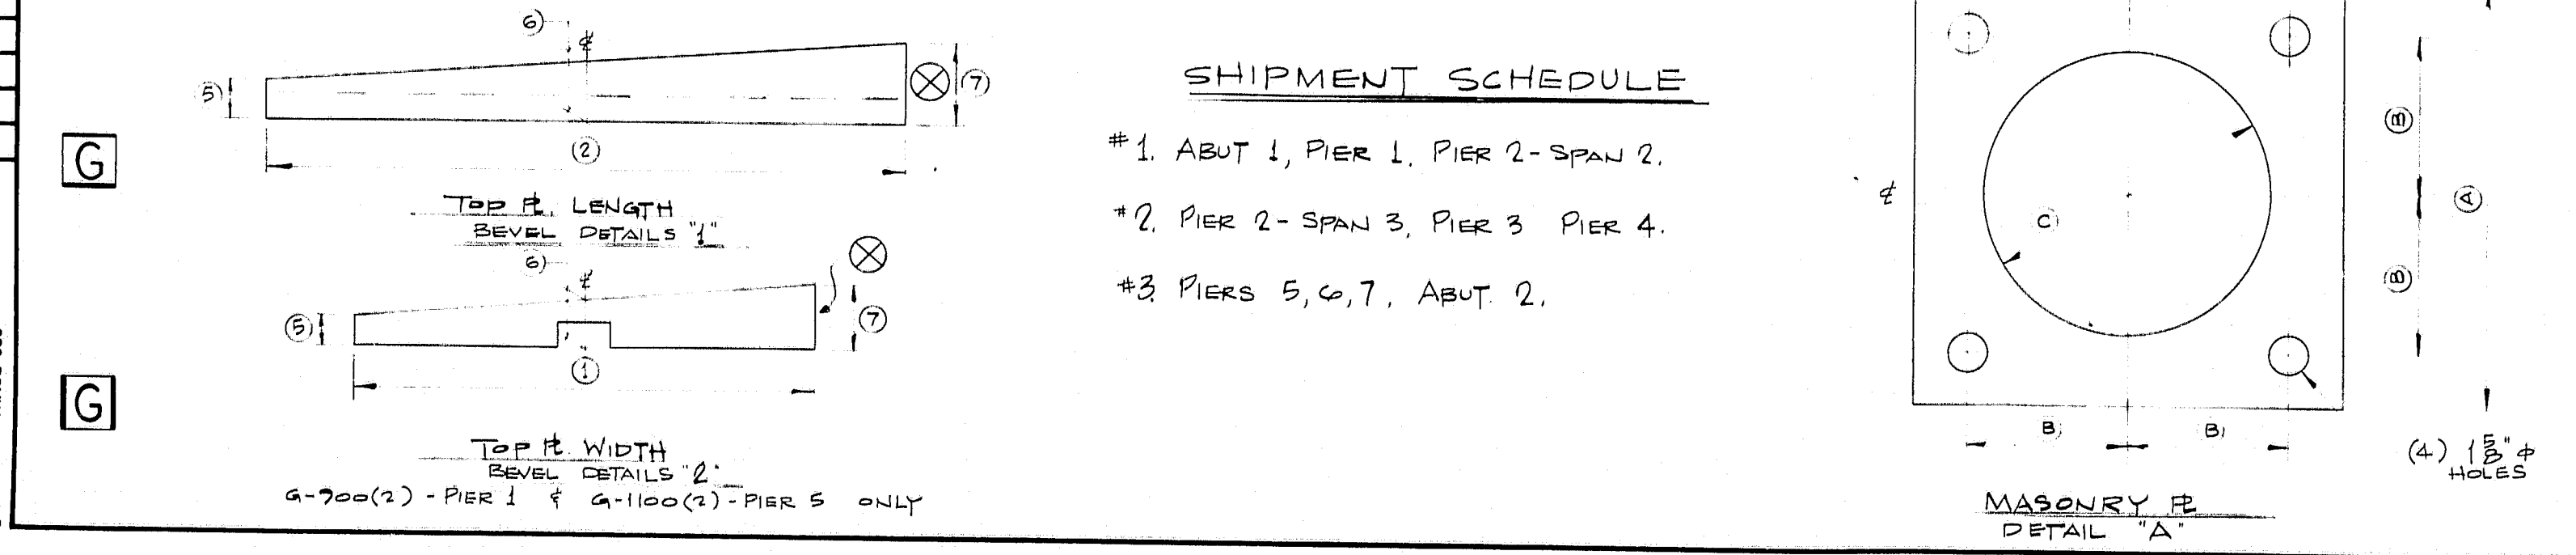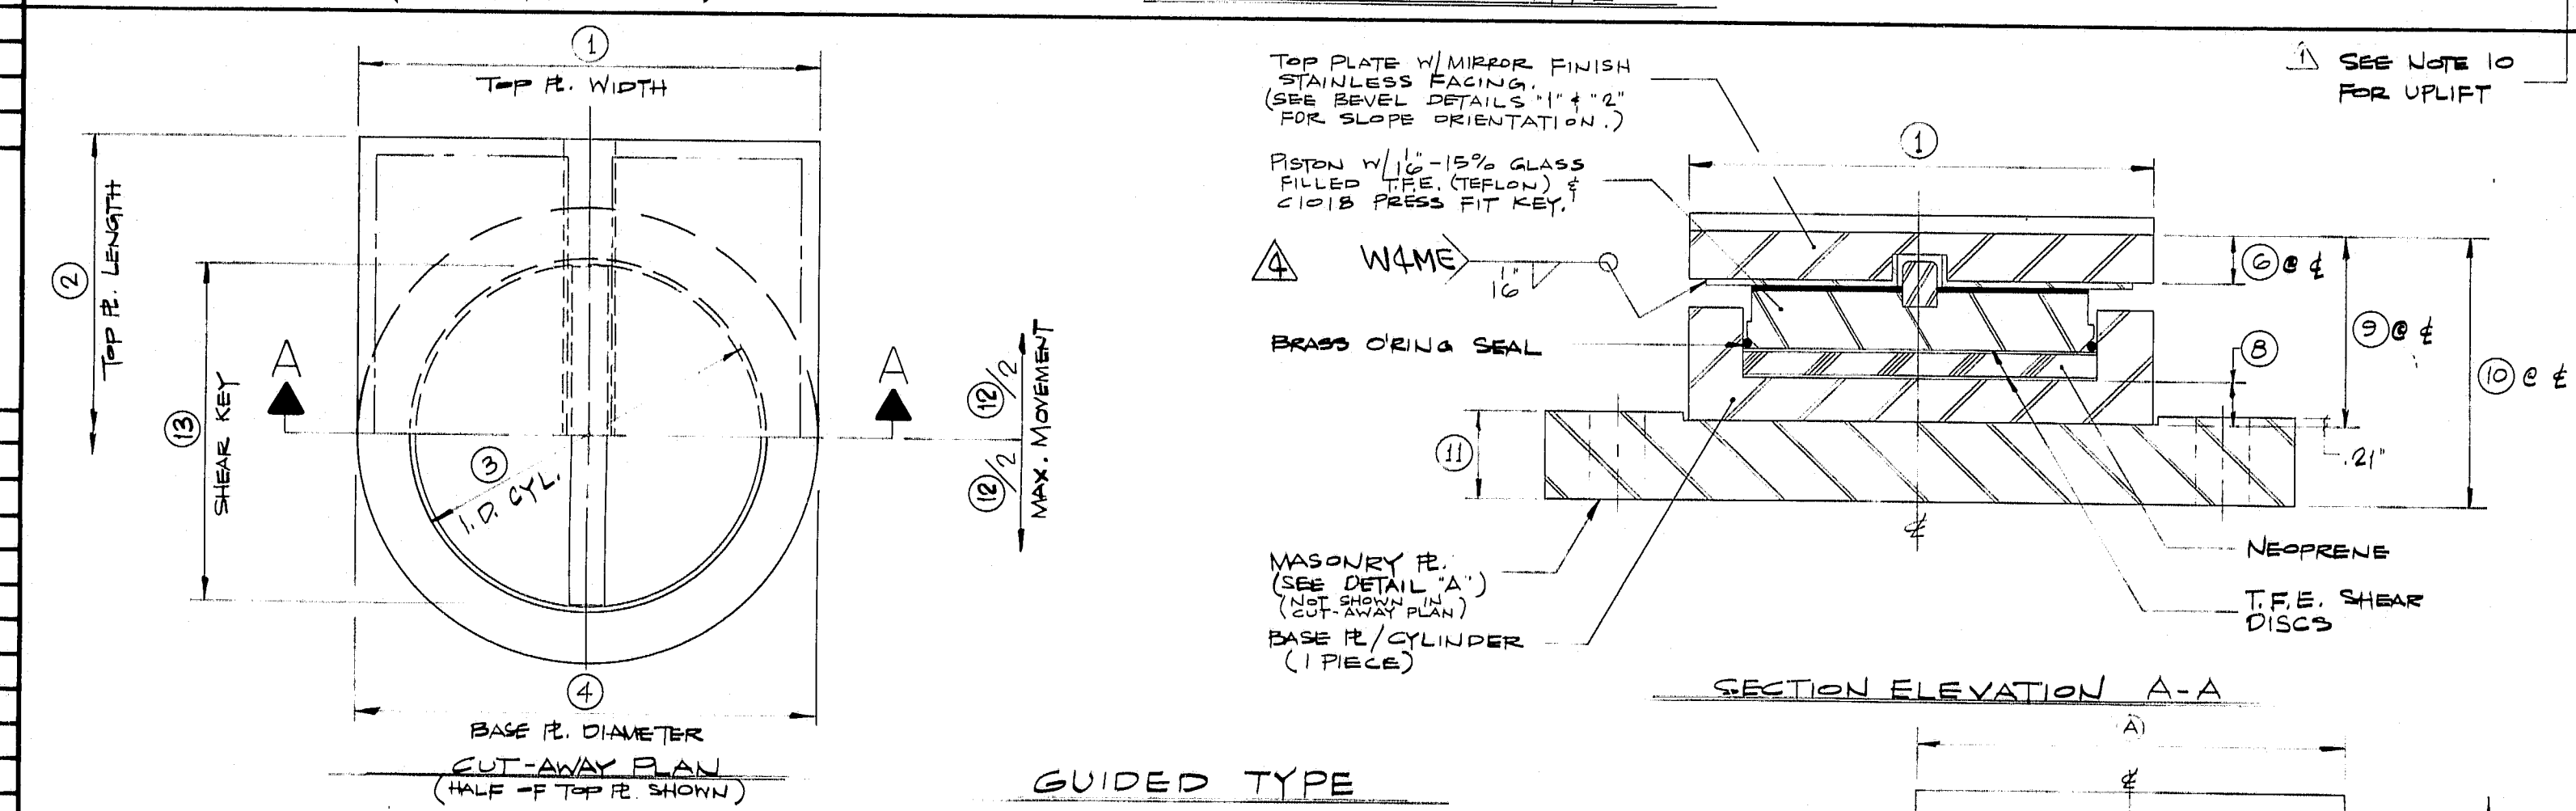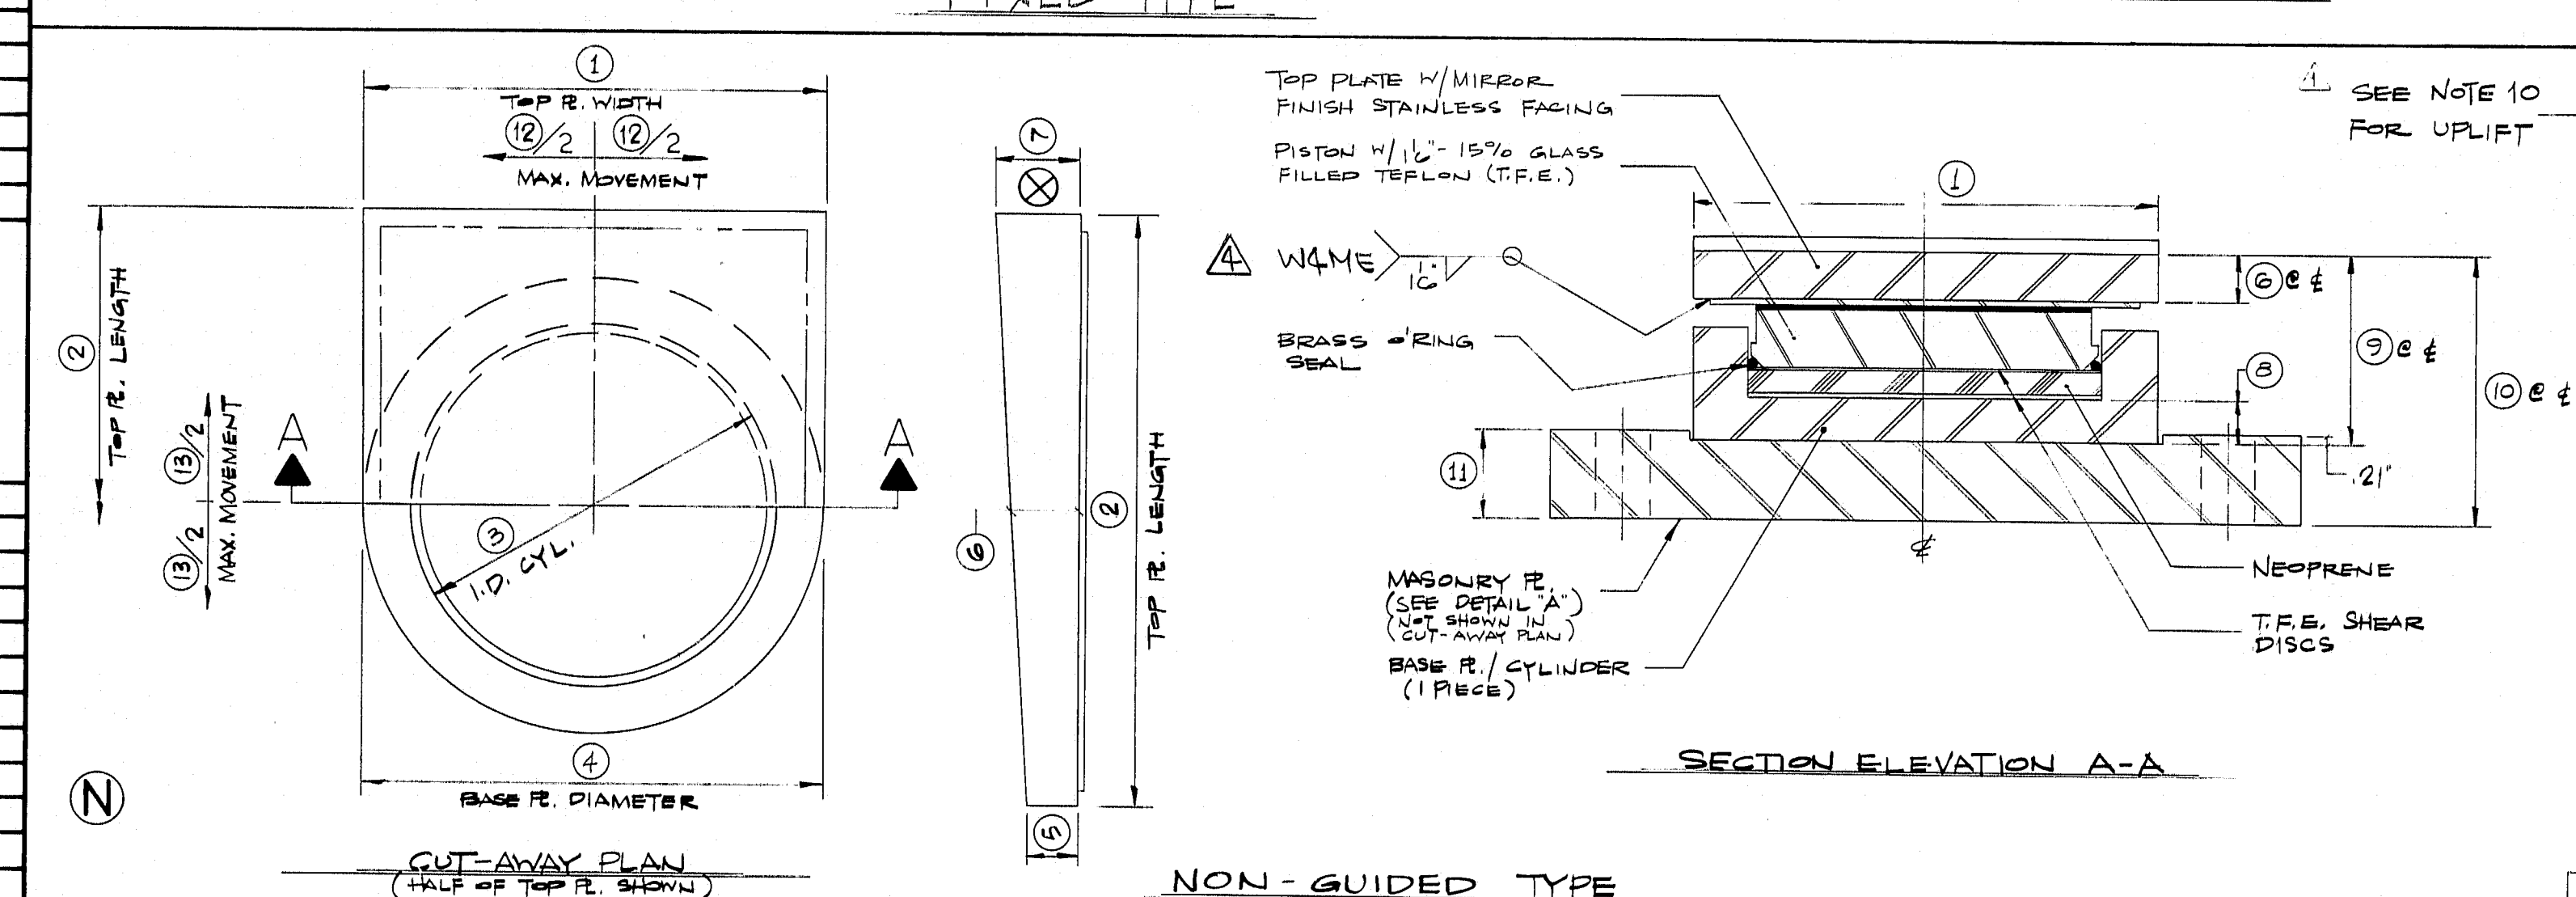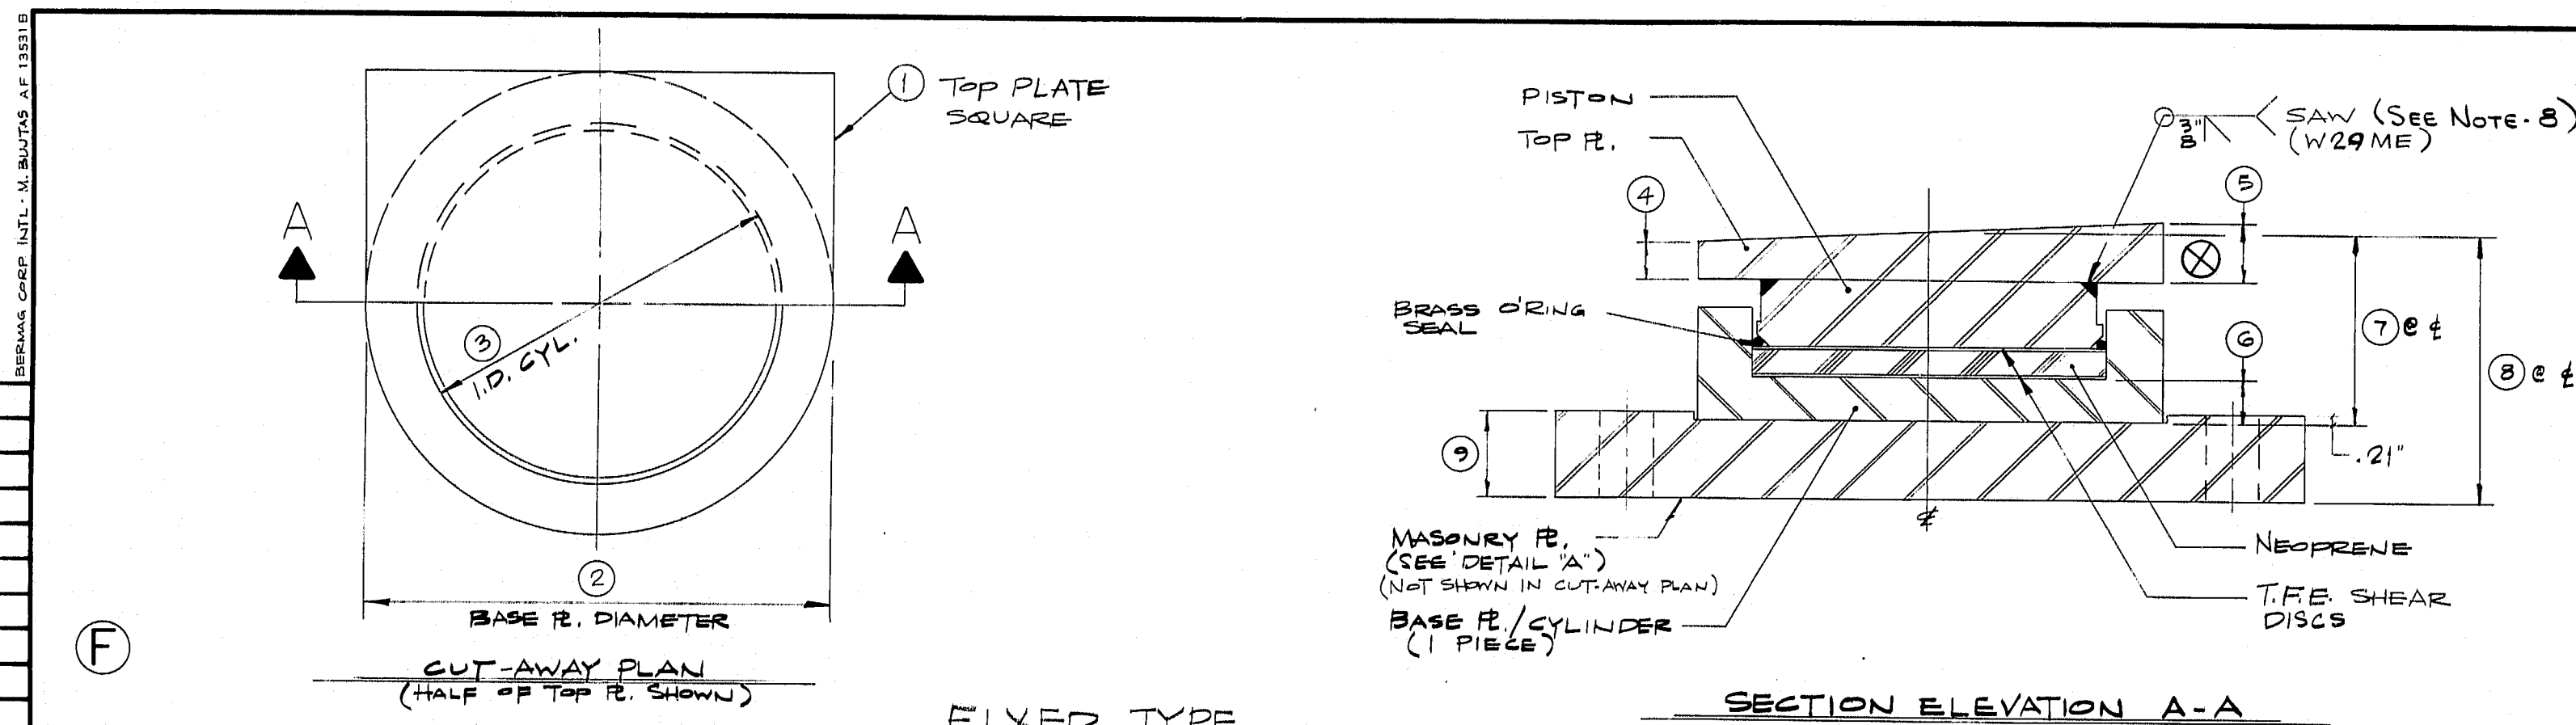

POT BEARING DATA & DETAILS																											FED. ROAD DIV. NO.	STATE	FED. AID PROJ. NO.	
LOCATION	GIRDER	QUAN.	BEARING TYPE	SLOPE	MAX. VERT. LIFT (IN.)	MAX. HOR. LIFT (IN.)	MIN. VERT. LIFT (IN.)	MIN. HOR. LIFT (IN.)	1	2	3	4	5	6	7	8	9	10	11	12	13	A	B	C	MIN. VERT. LIFT (IN.)	

**GENERAL NOTES:**

- ALL STEEL: A588 U.N.O.
- NEOPRENE: A.A.S.H.T.O. 50 DUROMETER.
- STAINLESS FACING: 14 GA. A140 TYPE 304 MIRROR FINISH.
- RETENTION: .06" (.015 RADIANS)
- MOVEMENT: SEE PLAN.
- COATING: ZINC METALIZED PER AWS C2.2 WITH 8ML EXTERNAL DRY COAT THICKNESS & 2ML INTERNAL THICKNESS.
- ⊗ INDICATES THICK EDGE OF TOP PLATE.
- MAGNETIC PARTICLE TESTING REQUIRED FOR 10% OF WELD LENGTH.
- BEARINGS TO BE SHIP ASSEMBLED, MATCH MARKED, AND SHIPPED AS A UNIT.
- 10 UPLIFT RESTRAINTS REQUIRED FOR PIER 2-SPAN 3 BEARINGS ONLY. REFER TO DWG. D-1003-1A FOR DETAILS.
- FOR PARTS DETAILS REFER TO DWGS. D-1001-1B THRU D-1001-1F.
- ZINC METALIZE ALL SURFACES AS PER NOTE 6 (UNLESS NOTED ON PARTS DWGS. D-1001-1D, E, F) AFTER COMPLETING ALL SHOP WELDING. MASK STAINLESS STEEL & TEFLOON TO PREVENT OVER SPRAY. A588 STEEL NOT METALIZED TO RECEIVE ONE COAT BOILED UNUSSED OIL OR APPROVED EQUAL.

**REVISIONS:**

NO.	REVISION	DATE
1	REMOVED SNAW FROM X-REF	12-13-84
2	REV. DIM. ① ON G-1100 Brg	11-14-84
3	Altered as per 10-11-84 approval	9-28-84
4	Dimension Changes & Uplift Details	10-11-84

**STATE OF MAINE - DEPT. OF TRANSPORTATION**  
I-395 BRIDGE OVER PENOBSCOT RIVER  
BANGOR-BREWER PENOBSCOT COUNTY


STATE CONTRACT OR REF. NO. **6** CONTRACTOR **CIAMBRO CORP.**

IN CHARGE: **M. BUTAS** CHKD. BY: **5-25-84** DATE: **6-28-84**

CONTRACT ME-84088-123 DRAWING NUMBER: **D-1001-1A**


**R95-153**








DETAIL 1

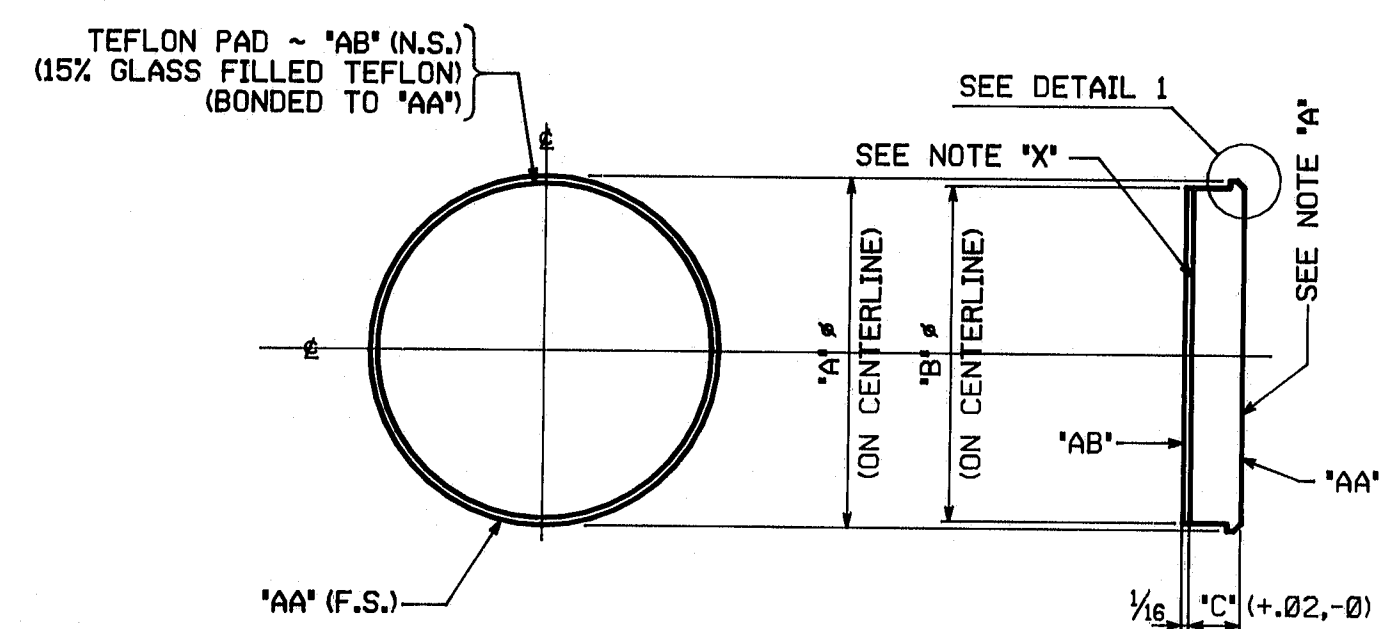


# PISTONS - NON GUIDED

LOCATION	GIRDER	BRG. TYPE	*A*	*B*	*C*	*D*	*E*	*F*	*AA*	*AB*
PIER 2	SPAN 2	N-350(2)	10.72 (+0,-.008)	10.58	1.33	.07	.13	.37	ba	bk
ABUT. 1	12.35	N-400(2)	11.87 (+0,-.009)	11.71	1.36	.08	.13	.37	bb	bm
ABUT. 2	12.35	N-400(7)	11.87 (+0,-.009)	11.71	1.36	.08	.13	.37	bb	bm
PIER 6	12.35	N-600(9)	14.07 (+0,-.010)	13.91	1.46	.08	.14	.37	bc	bn
PIER 7	12.35	N-1000(3)	19.04 (+0,-.012)	18.84	1.77	.10	.18	.50	bd	bp
PIER 4	12.35	N-1500(3)	23.27 (+0,-.012)	23.05	2.04	.11	.24	.56	bg	bt
PIER 3	12.35	N-1800(7)	25.58 (+0,-.012)	25.36	2.14	.11	.27	.56	bh	bw

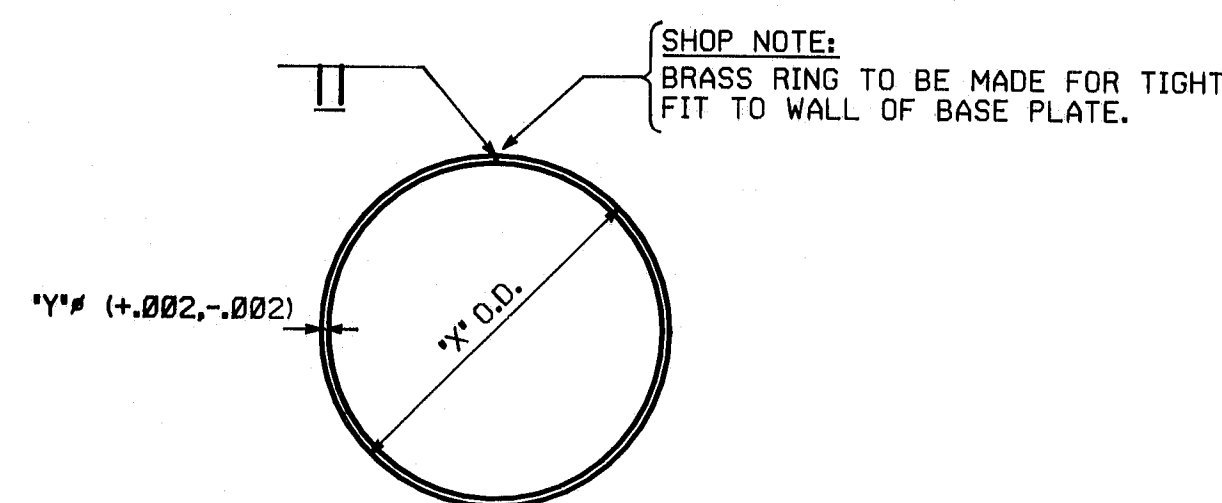


# BRASS SEALING RINGS

LOCATION	GIRDER	BRG. TYPE	*X*	*Y*
PIER 2	SPAN 2	N-350(2)	10.74	5/16
ABUT. 1	12.35	N-400(2)	11.89	5/16
ABUT. 2	12.35	N-400(7)	11.89	5/16
PIER 6	12.35	N-600(9)	14.11	5/16
PIER 7	12.35	N-1000(3)	19.09	5/16
PIER 4	12.35	N-1500(3)	23.32	1/2
PIER 3	12.35	N-1800(7)	25.63	1/2

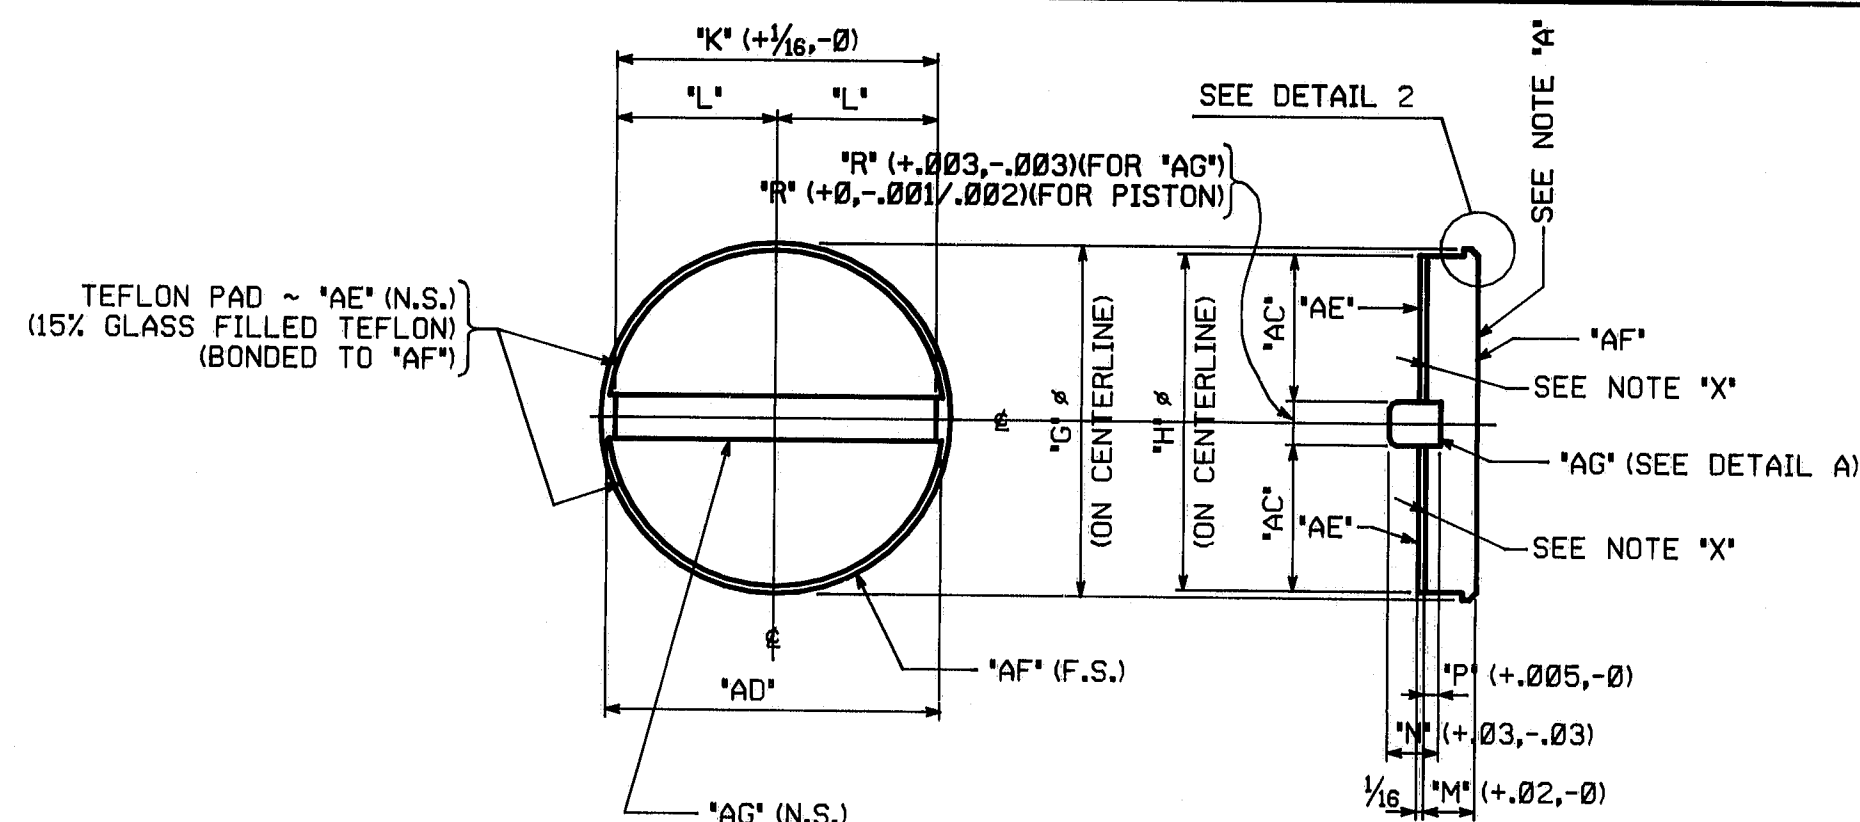

# PISTONS - GUIDED


LOCATION	GIRDER	BRG. TYPE	*G*	*H*	*I*	*J*	*K*	*L*	*M*	*N*	*O*	*P*	*Q*	*R*	*S*	*T*	*U*	*V*	*W*	*X*	*Y*	*Z*
PIER 2	SPAN 2	G-350(2)	10.72 (+0,-.008)	10.58	10 1/16	5 1/2	1.33	1'	.37	.500	.07	.13	.37	5.04	10.5682	by	bak	bbk				
ABUT. 1	4.7	G-400(2)	11.87 (+0,-.009)	11.71	11 1/16	5 1/2	1.36	1'	.37	.500	.08	.13	.37	5.605	11.6993	baa	bam	bbb				
ABUT. 2	4.5	G-400(7)	11.87 (+0,-.009)	11.71	11 1/16	5 1/2	1.36	1'	.37	.500	.08	.13	.37	5.605	11.6993	baa	bam	bbb				
PIER 6	12.35	G-600(9)	14.07 (+0,-.010)	13.91	1'-1 1/16	6 3/32	1.46	1 1/4	.45	.750	.08	.14	.37	6.58	13.8898	bab	ban	bbc				
PIER 7	12.35	G-1000(3)	19.04 (+0,-.012)	18.84	1'-6 1/4	9 1/8	1.77	1 1/2	.55	1.000	.10	.21	.50	9.455	19.8849	baf	bat	bbg				
PIER 4	12.35	G-1500(3)	23.27 (+0,-.012)	23.05	1'-10 1/16	11 7/32	2.04	1 1/2	.55	1.000	.11	.24	.56	11.025	23.0283	bag	baw	bbh				
PIER 3	12.35	G-1800(7)	25.58 (+0,-.012)	25.36	2'-0 3/4	1'-0 3/8	2.14	1 3/4	.68	1.000	.11	.27	.56	12.18	25.3403	bah	bay	bbk				

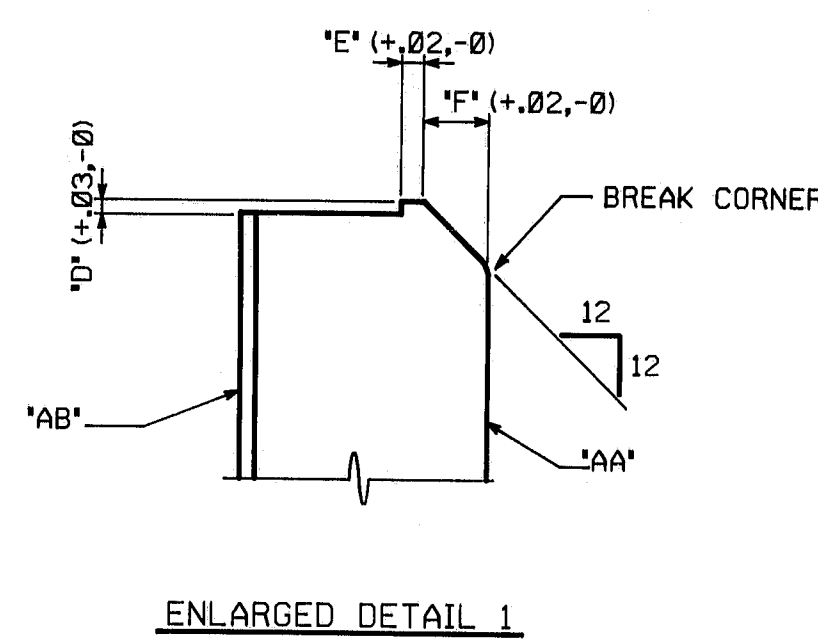



# NOTES:

NOTE \*A\*: SURFACES INDICATED ARE TO BE STRAIGHT AND TRUE; FINISH IF NECESSARY

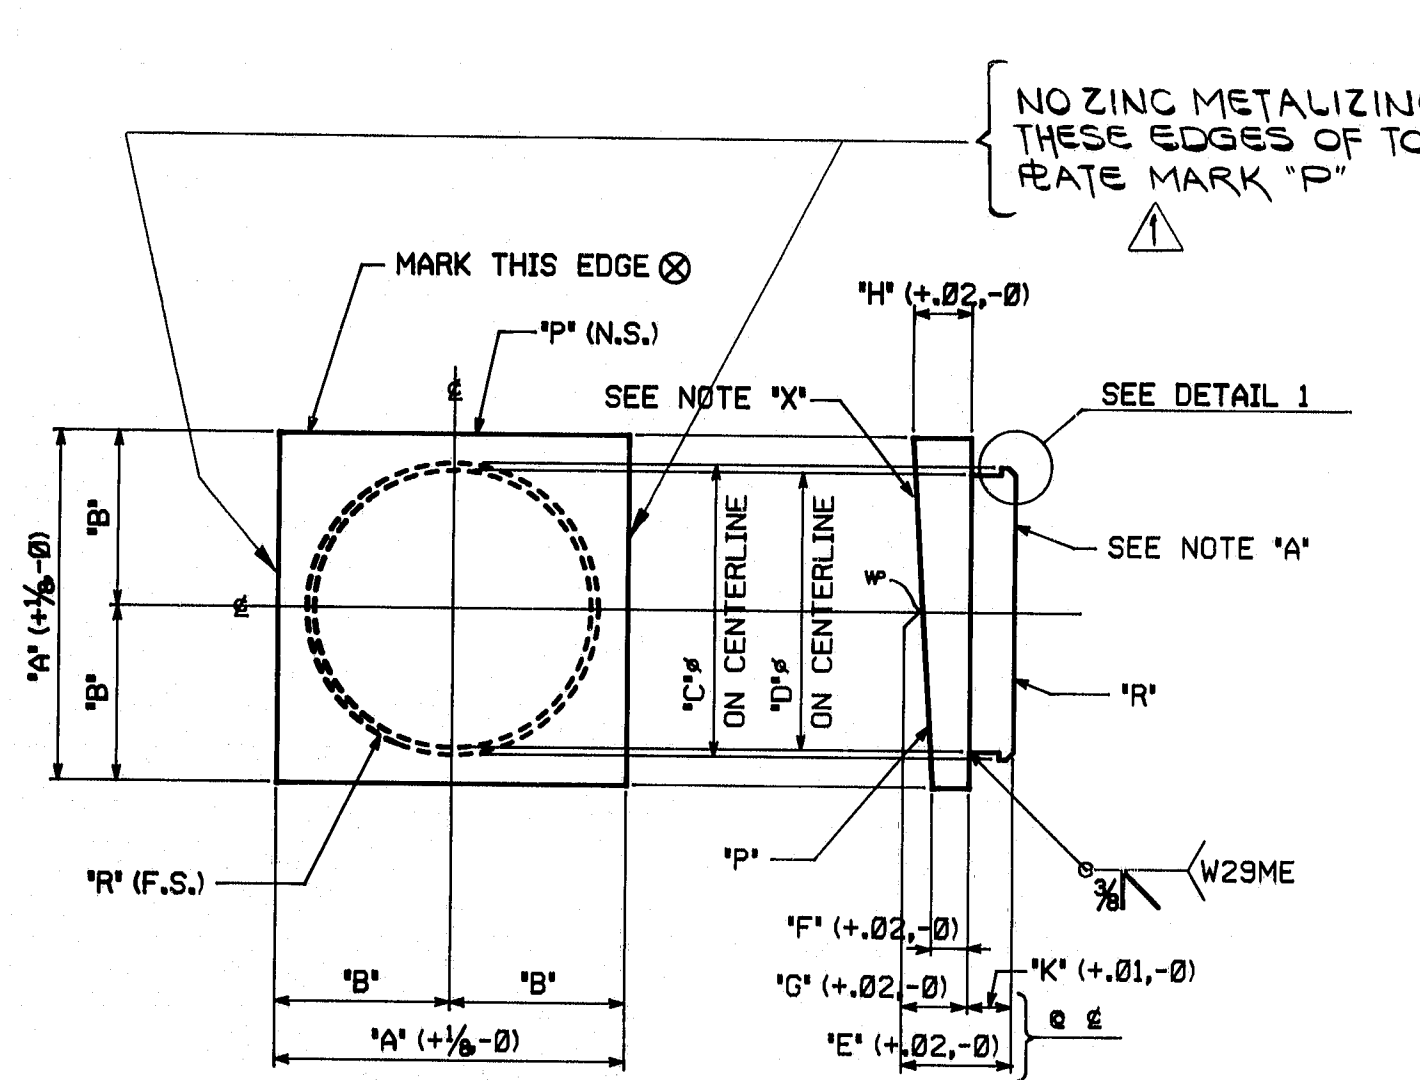

SOLE PLATE/PISTON PLATE - FIXED


LOCATION	GIRDER	BRG. TYPE	'A'	'B'	'C'	'D'	'E'	'F'	'G'	'H'	'I'	'J'	'K'	'L'	'M'	'N'	'O'	'P'	'Q'	'R'
PIER 1	4	F-900	1'-10 1/2"	11 1/8"	18.43 (+0, -.010)	18.23	2.95	.97	1.22	1.47	1.73	.17	bbm	bbm						
	7	F-900	1'-10 1/2"	11 1/8"	18.43 (+0, -.010)	18.23	2.95	.95	1.22	1.49	1.73	.17	bbm	bbm						
PIER 5	4,5	F1100	2'-1 1/2"	1'-0 1/2"	20.11 (+0, -.012)	19.91	3.05	1.04	1.22	1.40	1.83	.21	bbp	bbt						

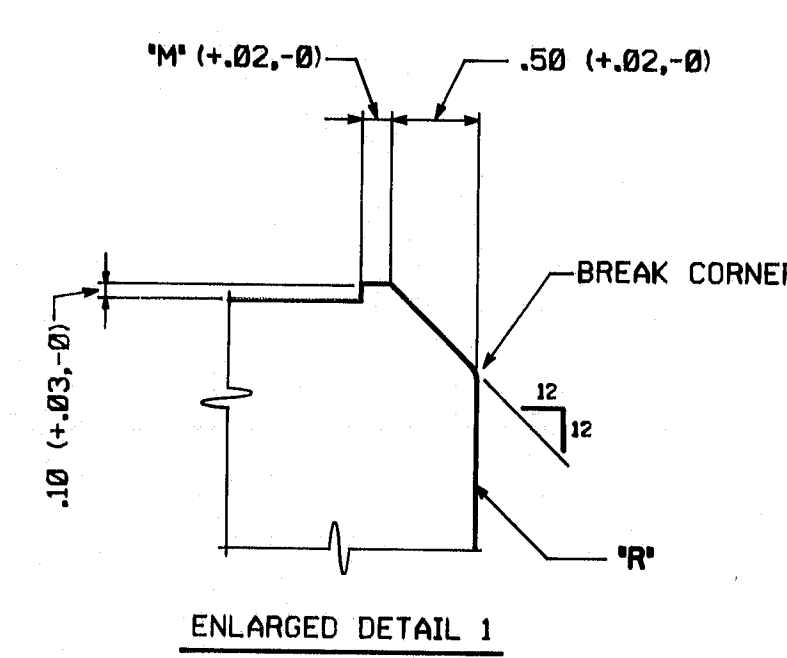

ENLARGED DETAIL 1

NO ZINC METALIZING THESE EDGES OF TOP PLATE MARK 'AN' FOR ALL BRGS. TYPE 350(2) & 400(2)

NO ZINC METALIZING THESE EDGES OF TOP PLATE MARK 'AN' FOR 1" AS SHOWN IN SIDE VIEW FOR ALL BRGS. TYPE 1500(5); 1800(7) & 400(7)

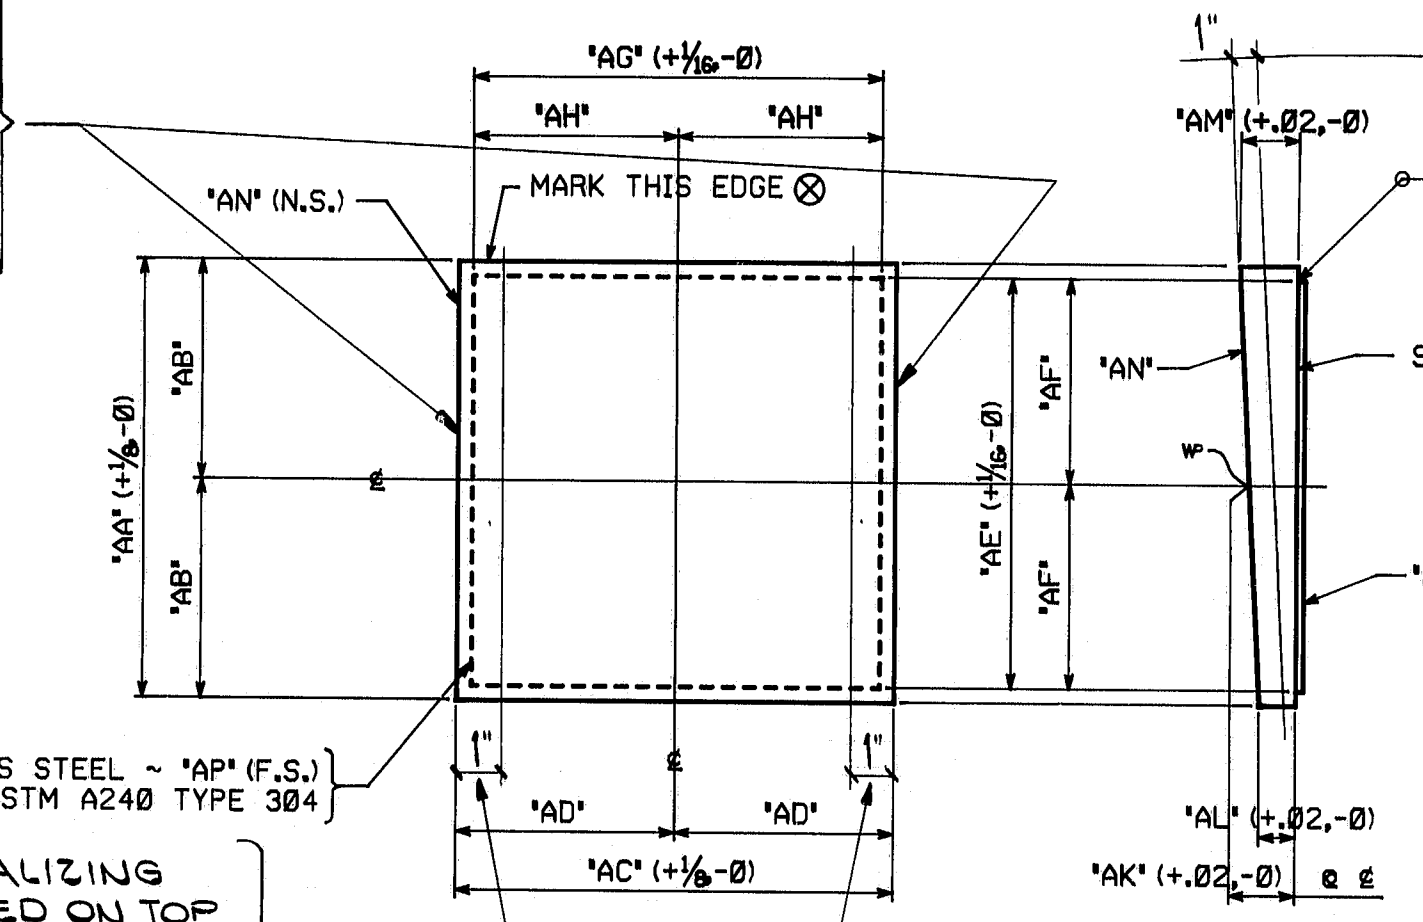

SOLE PLATES - NON GUIDED

STAINLESS STEEL - 'AP' (F.S.)  
MIRROR FINISH - ASTM A240 TYPE 304

NO ZINC METALIZING FOR 1" AS NOTED ON TOP PLATE MARK 'AN' FOR ALL BRGS. TYPE 1000(5) & 1100(5)

LOCATION	GIRDER	BRG. TYPE	'AA'	'AB'	'AC'	'AD'	'AE'	'AF'	'AG'	'AH'	'AI'	'AJ'	'AK'	'AL'	'AM'	'AN'	'AP'

NOTES:

NOTE 'A' SURFACES INDICATED ARE TO BE STRAIGHT AND TRUE; FINISH IF NECESSARY.

NOTE 'X' SURFACES INDICATED ARE TO BE MACHINED FLAT TO .01"/FT. (0.04" MAXIMUM)

ALL DIMENSIONS GIVEN THUS: 2.95 ARE DECIMALS OF AN INCH. FOR NOTES AND REFERENCE, SEE DRAWING D-1001-1A.

MATERIAL TO BE ASTM A588 (U.N.)


SHOP NOTE

HOLES: NONE

BOLTS: NONE


REQUIRED PER SHIPMENT										BILL OF MATERIAL										FED. ROAD DIV. NO.		STATE		FED. ROAD PROJ. NO.	
																				1		ME.		I-10-395-(8)2176	
#1	#2	#3	NO.	MARK	DESCRIPTION	LENGTH	REMARKS	ITEM	QTY	UNIT	WEIGHT	QTY	UNIT	WEIGHT	QTY	UNIT	WEIGHT	QTY	UNIT	WEIGHT					
SOLE PLATE/PISTON PLATE - FIXED																									
1	--	--	1	bbm	22 1/2" x 1.47 x .37	1	10%	FOR BRG. TYPE 900	10	LB	24														
1	--	--	1	bbn	22 1/2" x 1.49 x .35	1	10%	FOR BRG. TYPE 900	10	LB	24														
--	2	--	2	bbp	25 1/2" x 1.48 x .34	2	1%	FOR BRG. TYPE 1100	10	LB	27														
2	--	--	2	bbs	2 1/2" x 1.73 THK.			FOR BRG. TYPE 900	10	LB	27														
--	2	--	2	bbt	2 1/2" x 1.83 THK.			FOR BRG. TYPE 1100	10	LB	25														
SOLE PLATES - NON GUIDED																									
1	--	--	1	bbw	21 1/2" x 1.46 x .34	1	3%	FOR BRG. TYPE 350	10	LB	26														
1	--	--	1	bbx	21 1/2" x 1.45 x .35	1	3%	FOR BRG. TYPE 350	10	LB	26														
2	--	--	2	bca	21 1/2" x 1.43 x .37	1	3%	FOR BRG. TYPE 350	10	LB	26														
4	--	--	4	ccb	21 1/2" x 1.42 x .38	1	3%	FOR BRG. TYPE 350	10	LB	26														
1	--	--	1	bcc	21 1/2" x 1.45 x .38	1	4%	FOR BRG. TYPE 400	10	LB	25														
2	--	--	2	bcd	21 1/2" x 1.43 x .39	1	4%	FOR BRG. TYPE 400	10	LB	25														
1	--	--	1	bce	21 1/2" x 1.42 x .40	1	4%	FOR BRG. TYPE 400	10	LB	25														
4	--	--	4	bcd	21 1/2" x 1.45 x .40	1	4%	FOR BRG. TYPE 400	10	LB	25														
--	1	--	1	bch	21 1/2" x 1.36 x .36	1	9%	FOR BRG. TYPE 400	10	LB	23														
--	5	--	5	bck	21 1/2" x 1.37 x .35	1	9%	FOR BRG. TYPE 400	10	LB	23														
--	6	--	6	bcy	25 1/2" x 2.21 x 1.61	2	1	FOR BRG. TYPE 1000	10	LB	18														
--	4	--	4	bda	25 1/2" x 2.45 x 1.65	2	4%	FOR BRG. TYPE 1100	10	LB	14														
--	2	--	2	bdb	25 1/2" x 2.46 x 1.64	2	4%	FOR BRG. TYPE 1100	10	LB	14														
--	1	--	1	bdc	25 1/2" x 2.11 x 2.07	2	6 1/2%	FOR BRG. TYPE 1500	10	LB	21														
--	2	--	2	bdd	25 1/2" x 2.09 x 2.09	2	6 1/2%	FOR BRG. TYPE 1500	10	LB	21														
--	1	--	1	bdf	25 1/2" x 2.15 x 2.03	2	6%	FOR BRG. TYPE 1500	10	LB	21														
--	1	--	1	bdg	25 1/2" x 2.18 x 2.00	2	6%	FOR BRG. TYPE 1500	10	LB	16														
--	1	--	1	bdb	25 1/2" x 2.21 x 1.97	2	6%	FOR BRG. TYPE 1500	10	LB	16														
--	1	--	1	bdk	25 1/2" x 2.45 x 2.11	3	1	FOR BRG. TYPE 1800	10	LB	13														
--	1	--	1	bdm	25 1/2" x 2.43 x 2.13	3	1	FOR BRG. TYPE 1800	10	LB	13														
--	1	--	1	bdr	25 1/2" x 2.41 x 2.15	3	1	FOR BRG. TYPE 1800	10	LB	13														
--	1	--	1	bdp	25 1/2" x 2.37 x 2.19	3	1	FOR BRG. TYPE 1800	10	LB	15														
--	1	--	1	bds	25 1/2" x 2.35 x 2.21	3	1	FOR BRG. TYPE 1800	10	LB	15														
--	1	--	1	bdt	25 1/2" x 2.34 x 2.22	3	1	FOR BRG. TYPE 1800	10	LB	15														
8	--	--	8	bdu	21 1/4" x 14GA.	1	3 1/4%	A240 TYPE 384 FOR BRG. TYPE 350	10	IC	12														
8	--	--	8	bdu	21 1/4" x 14GA.	1	4 1/4%	A240 TYPE 384 FOR BRG. TYPE 400	10	IC	10														
--	6	--	6	bfa	21 1/4" x 14GA.	1	9%	A240 TYPE 384 FOR BRG. TYPE 400	10	IC	9														
--	6	--	6	bfb	22 3/8" x 14GA.	2	0 1/2%	A240 TYPE 384 FOR BRG. TYPE 1800	10	IC	6														
--	6	--	6	bfd	22 3/4" x 14GA.	2	3 3/4%	A240 TYPE 384 FOR BRG. TYPE 1100	10	IC	5														
--	6	--	6	bff	22 3/8" x 14GA.	2	5%	A240 TYPE 384 FOR BRG. TYPE 1500	10	IC	4														
--	6	--	6	bfg	23 1/2" x 14GA.	3	0 1/2%	A240 TYPE 384 FOR BRG. TYPE 1800	10	IC	3														



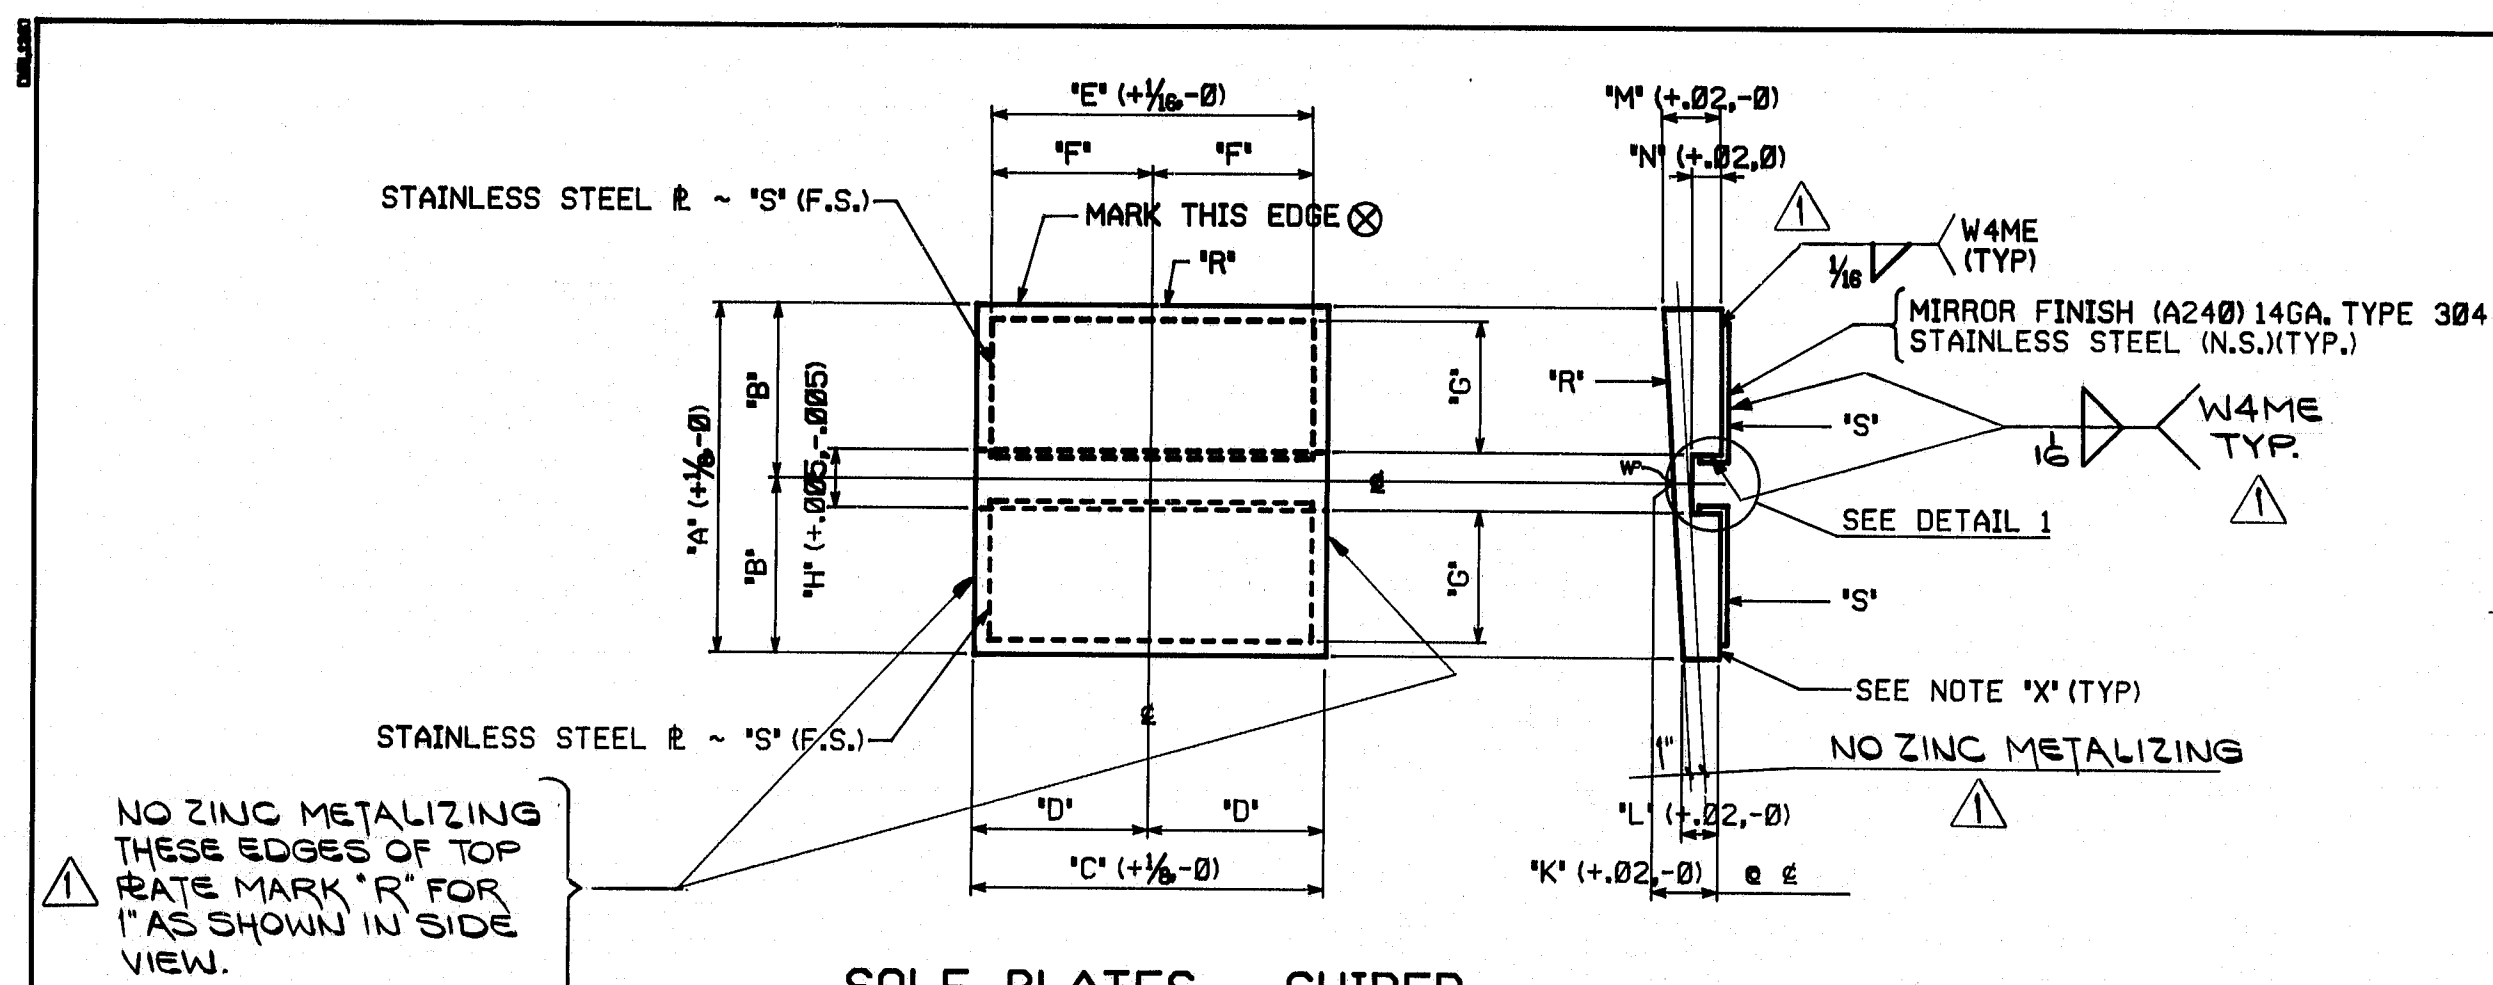



SOLE PLATES - GUIDED

LOCATION	GIRDER	BRG. TYPE	'A'	'B'	'C'	'D'	'E'	'F'	'G'	'H'	'I'	'J'	'K'	'L'	'M'	'N'	'P'	'Q'	'R'	'S'
PIER 1	1	G-900(2)	1'-10 7/8"	11 7/8"	1'-11"	11 1/2"	1'-10 1/2"	11 1/4"	10 3/4"	1.06	1.30	1.59	2.21	.75	%	bgb	bhc			
	2	G-900(2)													1.60	2.20			bgc	
	3,8,9,10	G-900(2)													1.63	2.17			bgd	
	5,6	G-900(2)	1'-10 7/8"	11 7/8"	1'-11"	11 1/2"	1'-10 1/2"	11 1/4"	10 3/4"	1.06	1.30	1.61	2.19	.75	%	bgi	bhc			
PIER 5	1,2,3	G-1100(2)	2'-1 3/8"	1'-0 1/8"	2'-1 3/8"	1'-0 1/8"	2'-0 7/8"	1'-0 7/8"	11 1/8"	1.31	2.01	1.86	2.16	.93	%	bgi	bhd			
	6	G-1100(2)													1.83	2.19			bgh	
	7	G-1100(2)													1.82	2.20			bgk	
	8	G-1100(2)	2'-1 3/8"	1'-0 1/8"	2'-1 3/8"	1'-0 1/8"	2'-0 7/8"	1'-0 7/8"	11 1/8"	1.31	2.01	1.81	2.21	.93	%	bgm	bhd			

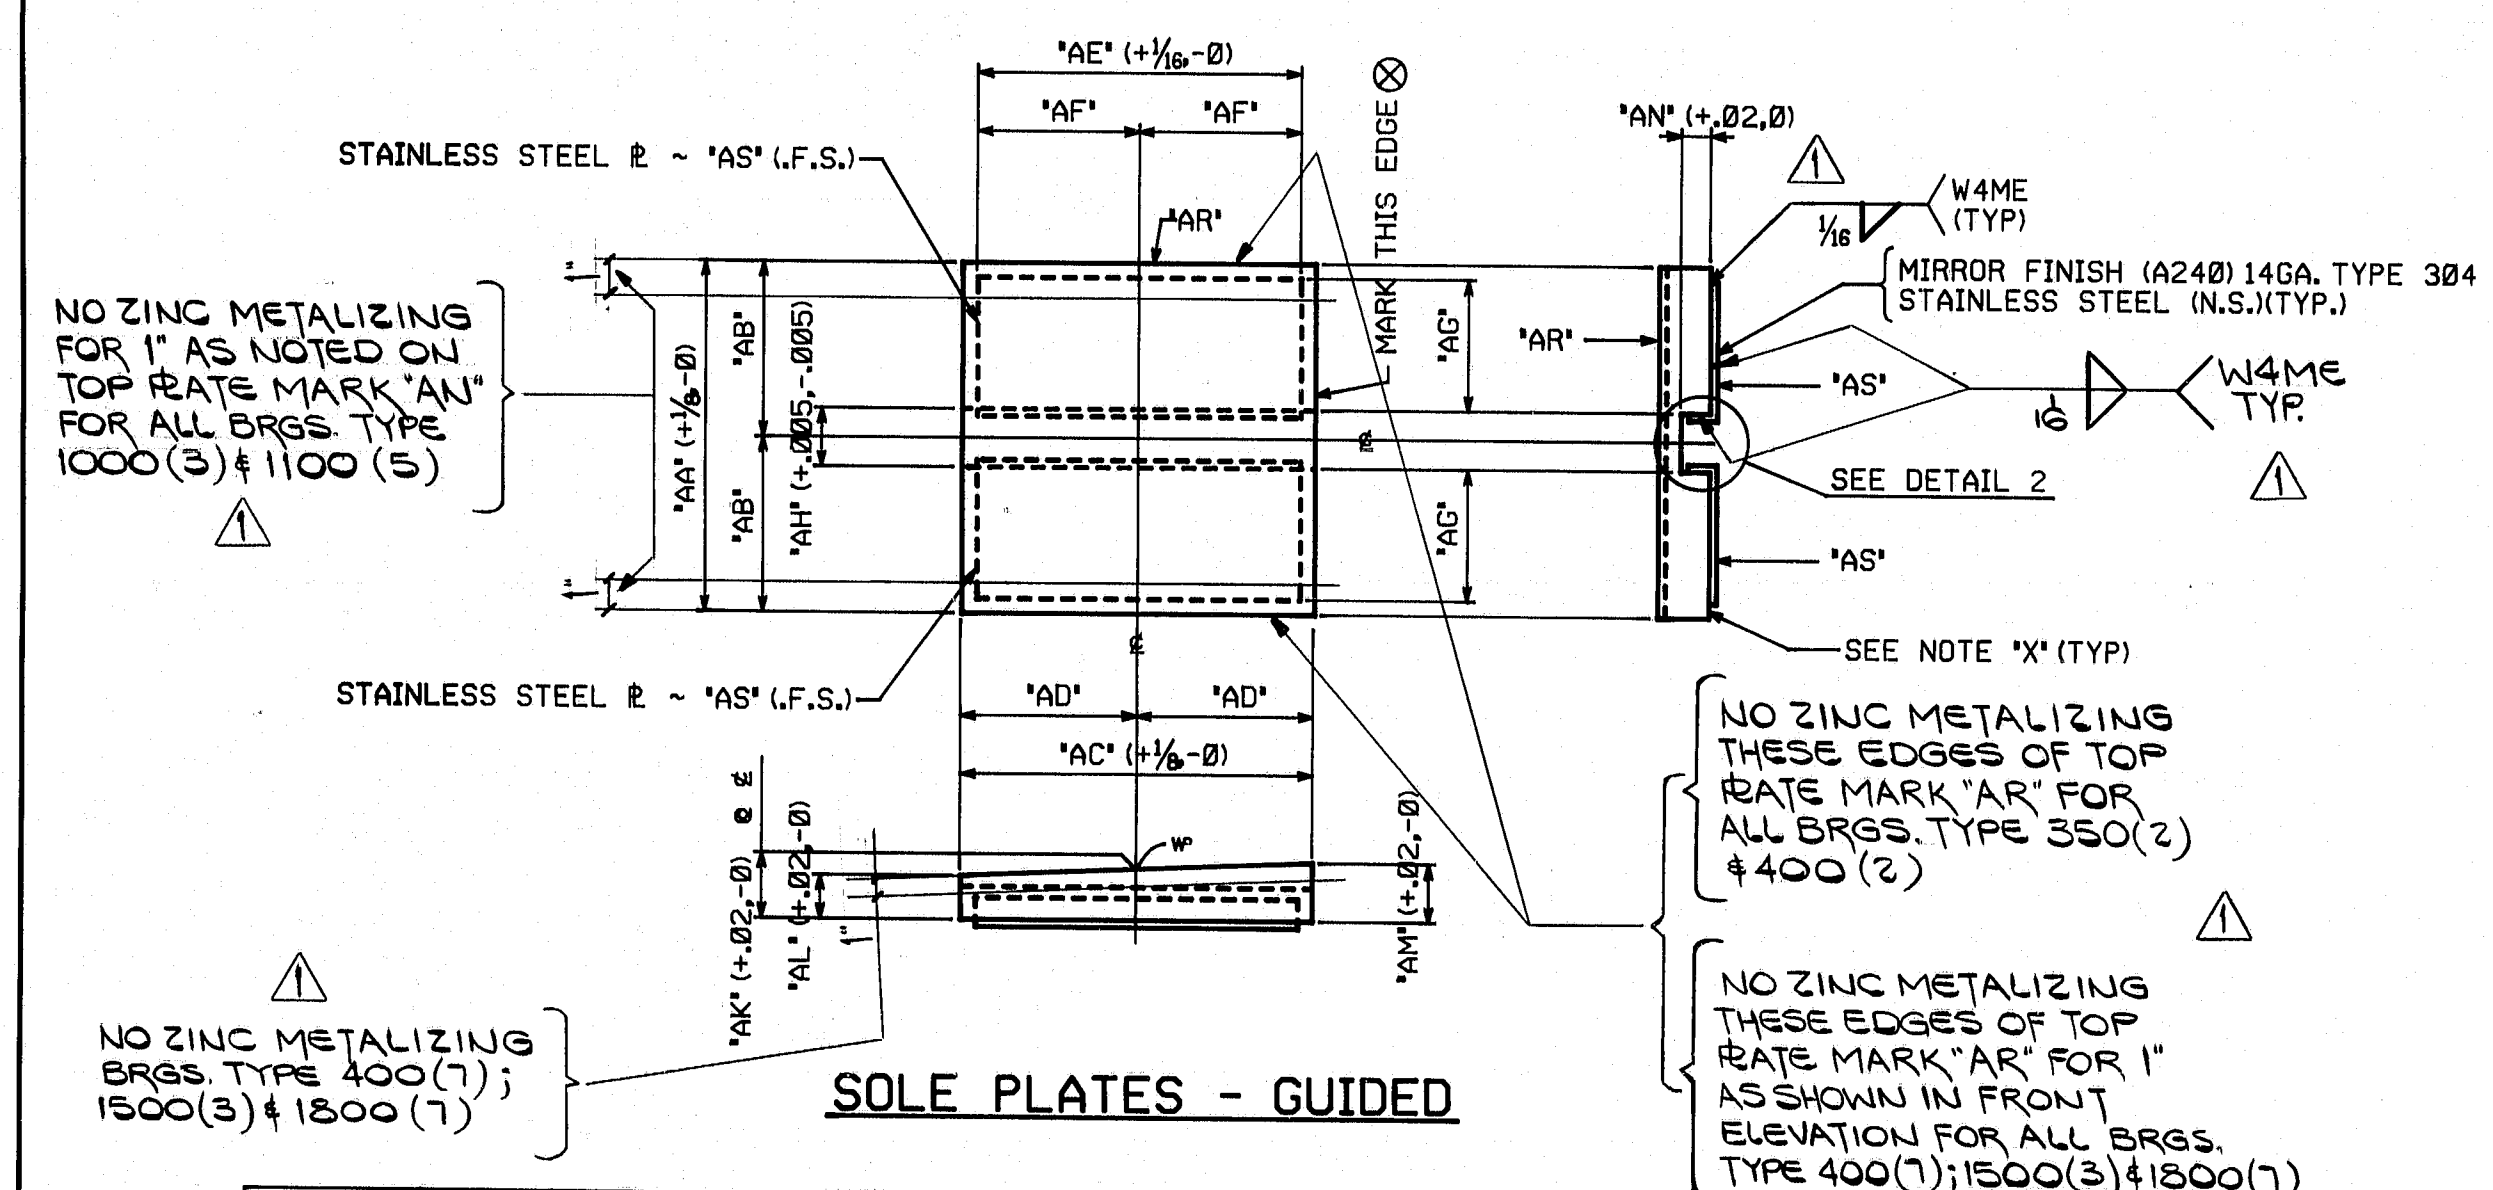

SOLE PLATES - GUIDED

LOCATION	GIRDER	BRG. TYPE	'AA'	'AB'	'AC'	'AD'	'AE'	'AF'	'AG'	'AH'	'AI'	'AJ'	'AK'	'AL'	'AM'	'AN'	'AO'	'AP'	'AQ'	'AR'	'AS'
PIER 2	4,7	G-350(2)	1'-2 3/4"	7 3/4"	1'-3 3/4"	7 3/4"	1'-3 3/4"	7 3/4"	8 3/4"	.81	1.25	1.07	1.43	.56	%	bfn	bgm				
ABUT. 1	4	G-400(2)	1'-3 3/4"	7 3/4"	1'-4 3/4"	8 3/4"	1'-4 3/4"	8 3/4"	7 3/4"	.81	1.23	1.05	1.41	.56	%	bfn	bgp				
	7	G-400(2)	1'-3 3/4"	7 3/4"	1'-4 3/4"	8 3/4"	1'-4 3/4"	8 3/4"	7 3/4"	.81	1.23	1.02	1.44	.56	%	bfn	bgp				
ABUT. 2	4,5	G-400(7)	1'-4 1/4"	8 3/4"	1'-9 3/4"	10 3/4"	1'-9 3/4"	10 3/4"	7 3/4"	.81	1.66	1.35	1.97	.56	%	bfn	bgg				
PIER 6	4,5	G-1000(3)	2'-1 1/2"	1'-0 1/4"	2'-1 1/2"	1'-0 1/4"	2'-0 1/2"	1'-0 1/4"	11 1/8"	1.06	1.91	1.61	2.21	.75	%	bfs	bgw				
PIER 7	4,5	G-1100(5)	2'-1 3/8"	1'-0 1/8"	2'-1 3/8"	1'-0 1/8"	2'-0 7/8"	1'-0 7/8"	11 1/8"	1.31	2.05	1.65	2.45	.93	%	bfs	bgw				
PIER 4	4,5	G-1500(3)	2'-5 1/4"	1'-2 3/8"	2'-6 1/4"	1'-3 3/8"	2'-5 3/4"	1'-2 3/8"	1'-1 1/8"	1.31	2.09	2.04	2.14	.93	%	bfs	bha				
PIER 3	4	G-1800(7)	2'-9"	1'-4 1/2"	3'-1"	1'-6 1/2"	3'-0 1/2"	1'-6 1/4"	1'-3 3/8"	1.31	2.28	2.15	2.41	.93	%	bfs	bhb				
	5	G-1800(7)	2'-9"	1'-4 1/2"	3'-1"	1'-6 1/2"	3'-0 1/2"	1'-6 1/4"	1'-3 3/8"	1.31	2.28	2.17	2.39	.93	%	bfs	bhb				

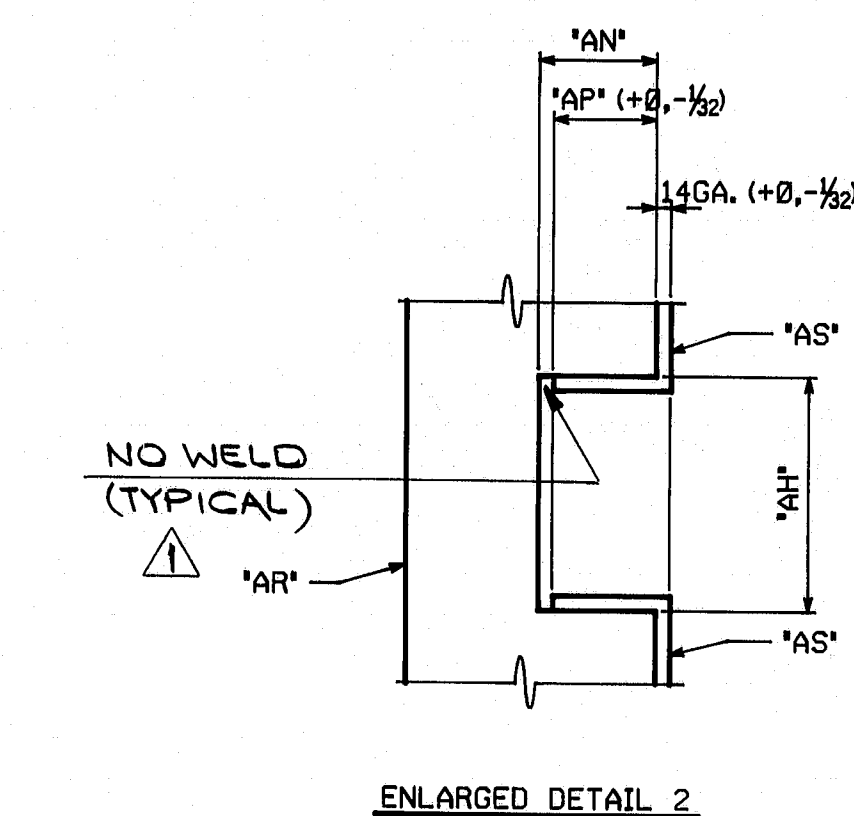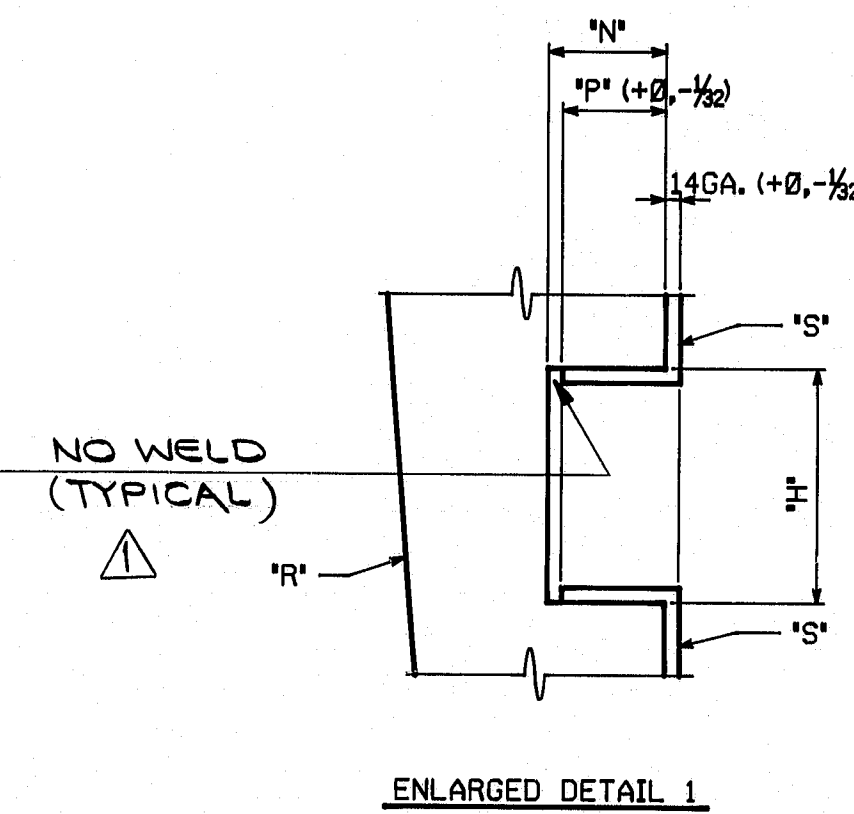

NOTES:

NOTE 'A': SURFACES INDICATED ARE TO BE STRAIGHT AND TRUE; FINISH IF NECESSARY.

NOTE 'X': SURFACES INDICATED ARE TO BE MACHINED FLAT TO .01"/FT. (0.4" MAXIMUM)

ALL DIMENSIONS GIVEN THUS: 2.21 ARE DECIMALS OF AN INCH. FOR NOTES AND REFERENCE, SEE DRAWING D-1001-1A. MATERIAL TO BE ASTM A588 (U.N.)

SHOP NOTE

HOLES: NONE  
BOLTS: NONE

REQUIRED PER SHIPMENT			BILL OF MATERIAL									
#1	#2	#3	NO.	MARK	DESCRIPTION	LENGTH	REMARKS	ITEM	QTY.	WEIGHT	EA.	
SOLE PLATES - GUIDED												
2	--	--	2	bfn	14 3/4" x (1.43 x 1.07)	1	3%	FOR BRG. TYPE 350	1B	26		
1	--	--	1	bfn	15 1/2" x (1.41 x 1.05)	1	4%	FOR BRG. TYPE 400	1B	25		
1	--	--	1	bfn	15 1/2" x (1.44 x 1.02)	1	4%	FOR BRG. TYPE 400	1B	25		
--	--	2	2	bfn	16 1/4" x (1.97 x 1.35)	1	9%	FOR BRG. TYPE 400	1B	23		
--	--	2	2	bfs	25 1/2" x (2.21 x 1.61)	2	1	FOR BRG. TYPE 1000	1B	18		
--	--	2	2	bft	25 1/2" x (2.45 x 1.65)	2	4%	FOR BRG. TYPE 1100	1B	14		
--	--	2	2	bft	29 1/4" x (2.14 x 2.04)	2	6%	FOR BRG. TYPE 1500	1B	21		
--	--	1	1	bft	33 x (2.41 x 2.15)	3	1	FOR BRG. TYPE 1800	1B	13		
--	--	1	1	bgt	33 x (2.39 x 2.17)	3	1	FOR BRG. TYPE 1800	1B	13		
1	--	--	1	bgb	22 1/2" x (2.21 x 1.59)	1	11	FOR BRG. TYPE 900	1B	19		
1	--	--	1	bgt	22 1/2" x (2.20 x 1.60)	1	11	FOR BRG. TYPE 900	1B	19		
4	--	--	4	bgt	22 1/2" x (2.17 x 1.63)	1	11	FOR BRG. TYPE 900	1B	19		
2	--	--	2	bgt	22 1/2" x (2.19 x 1.61)	1	11	FOR BRG. TYPE 900	1B	19		
--	--	3	3	bgt	25 1/2" x (2.16 x 1.86)	2	1%	FOR BRG. TYPE 1100	1B	17		
--	--	1	1	bgh	25 1/2" x (2.19 x 1.83)	2	1%	FOR BRG. TYPE 1100	1B	17		
--	--	1	1	bgt	25 1/2" x (2.20 x 1.82)	2	1%	FOR BRG. TYPE 1100	1B	17		
--	--	1	1	bgt	25 1/2" x (2.21 x 1.81)	2	1%	FOR BRG. TYPE 1100	1B	17		
4	--	--	4	bgn	7 1/2" x 14GA.	1	3 1/4"	A240 TYPE 304 FOR BRG. TYPE 350	1C	20		
4	--	--	4	bgn	7 1/2" x 14GA.	1	4 1/4"	A240 TYPE 304 FOR BRG. TYPE 400	1C	19		
--	--	4	4	bgs	7 1/2" x 14GA.	1	9 1/4"	A240 TYPE 304 FOR BRG. TYPE 400	1C	18		
--	--	4	4	bgw	11 1/8" x 14GA.	2	0 1/2"	A240 TYPE 304 FOR BRG. TYPE 1000	1C	15		
--	--	4	4	bgw	12 1/8" x 14GA.	2	3 3/4"	A240 TYPE 304 FOR BRG. TYPE 1100	1C	13		
--	--	4	4	bha	14 1/8" x 14GA.	2	5 3/4"	A240 TYPE 304 FOR BRG. TYPE 1500	1C	11		
--	--	4	4	bhb	16 1/8" x 14GA.	3	0 1/2"	A240 TYPE 304 FOR BRG. TYPE 1800	1C	8		
16	--	--	16	bhc	11 1/8" x 14GA.	1	10 1/2"	A240 TYPE 304 FOR BRG. TYPE 900	1C	16		
--	--	12	12	bhd	12 1/8" x 14GA.	2	0 1/2"	A240 TYPE 304 FOR BRG. TYPE 1100	1C	14		

NO. 1 REVISION altered as per 10-11-84 app'1 DATE 10-17-84


POT BEARING DETAILS

I-395 BRIDGE OVER PENOBSCOT RIVER

I-395 BRIDGE STA. 164+60.00

PENOBSCOT COUNTY

STATE OF MAINE



DEPARTMENT OF TRANSPORTATION

STATE CONTRACT OR REF. NO. 6 CONTRACTOR CIANBRO CORP.

IN CHARGE: HINKLE MADE BY: B.J.K. CHK'D BY: JCH DATE: 2-16-84


CONTRACT NUMBER: ME-84088-1,2,3 DRAWING NUMBER: D-1001-1E DATE: 7-2-84

R95-157


NO. 	REVISION	altered as per 10-11-84 app'1	DATE	9-28-84 10-17-84
HIGH STEEL STRUCTURES, INC.			1805 E. 6th Philadelphia Pike Gloucester, Pennsylvania 17033 Phone 717/239-628	
			A Subsidiary of High Industries, Inc.	
POT BEARING DETAILS				
I-395 BRIDGE OVER PENOBSCOT RIVER				
I-395 BRIDGE STA. 164+60.00				
PENOBSCOT COUNTY				
STATE OF MAINE				
DEPARTMENT OF TRANSPORTATION				
STATE CONTRACT OR REF. NO.		6	CONTRACTOR CIAMBRIO CORP.	
IN CHARGE	HINKLE	MADE BY	B.J.K.	CHK'D BY
CONTRACT NUMBER	ME-84088-2	DRAWING NUMBER	D-1001-1F	DATE
				8-17-84



AF 22682A

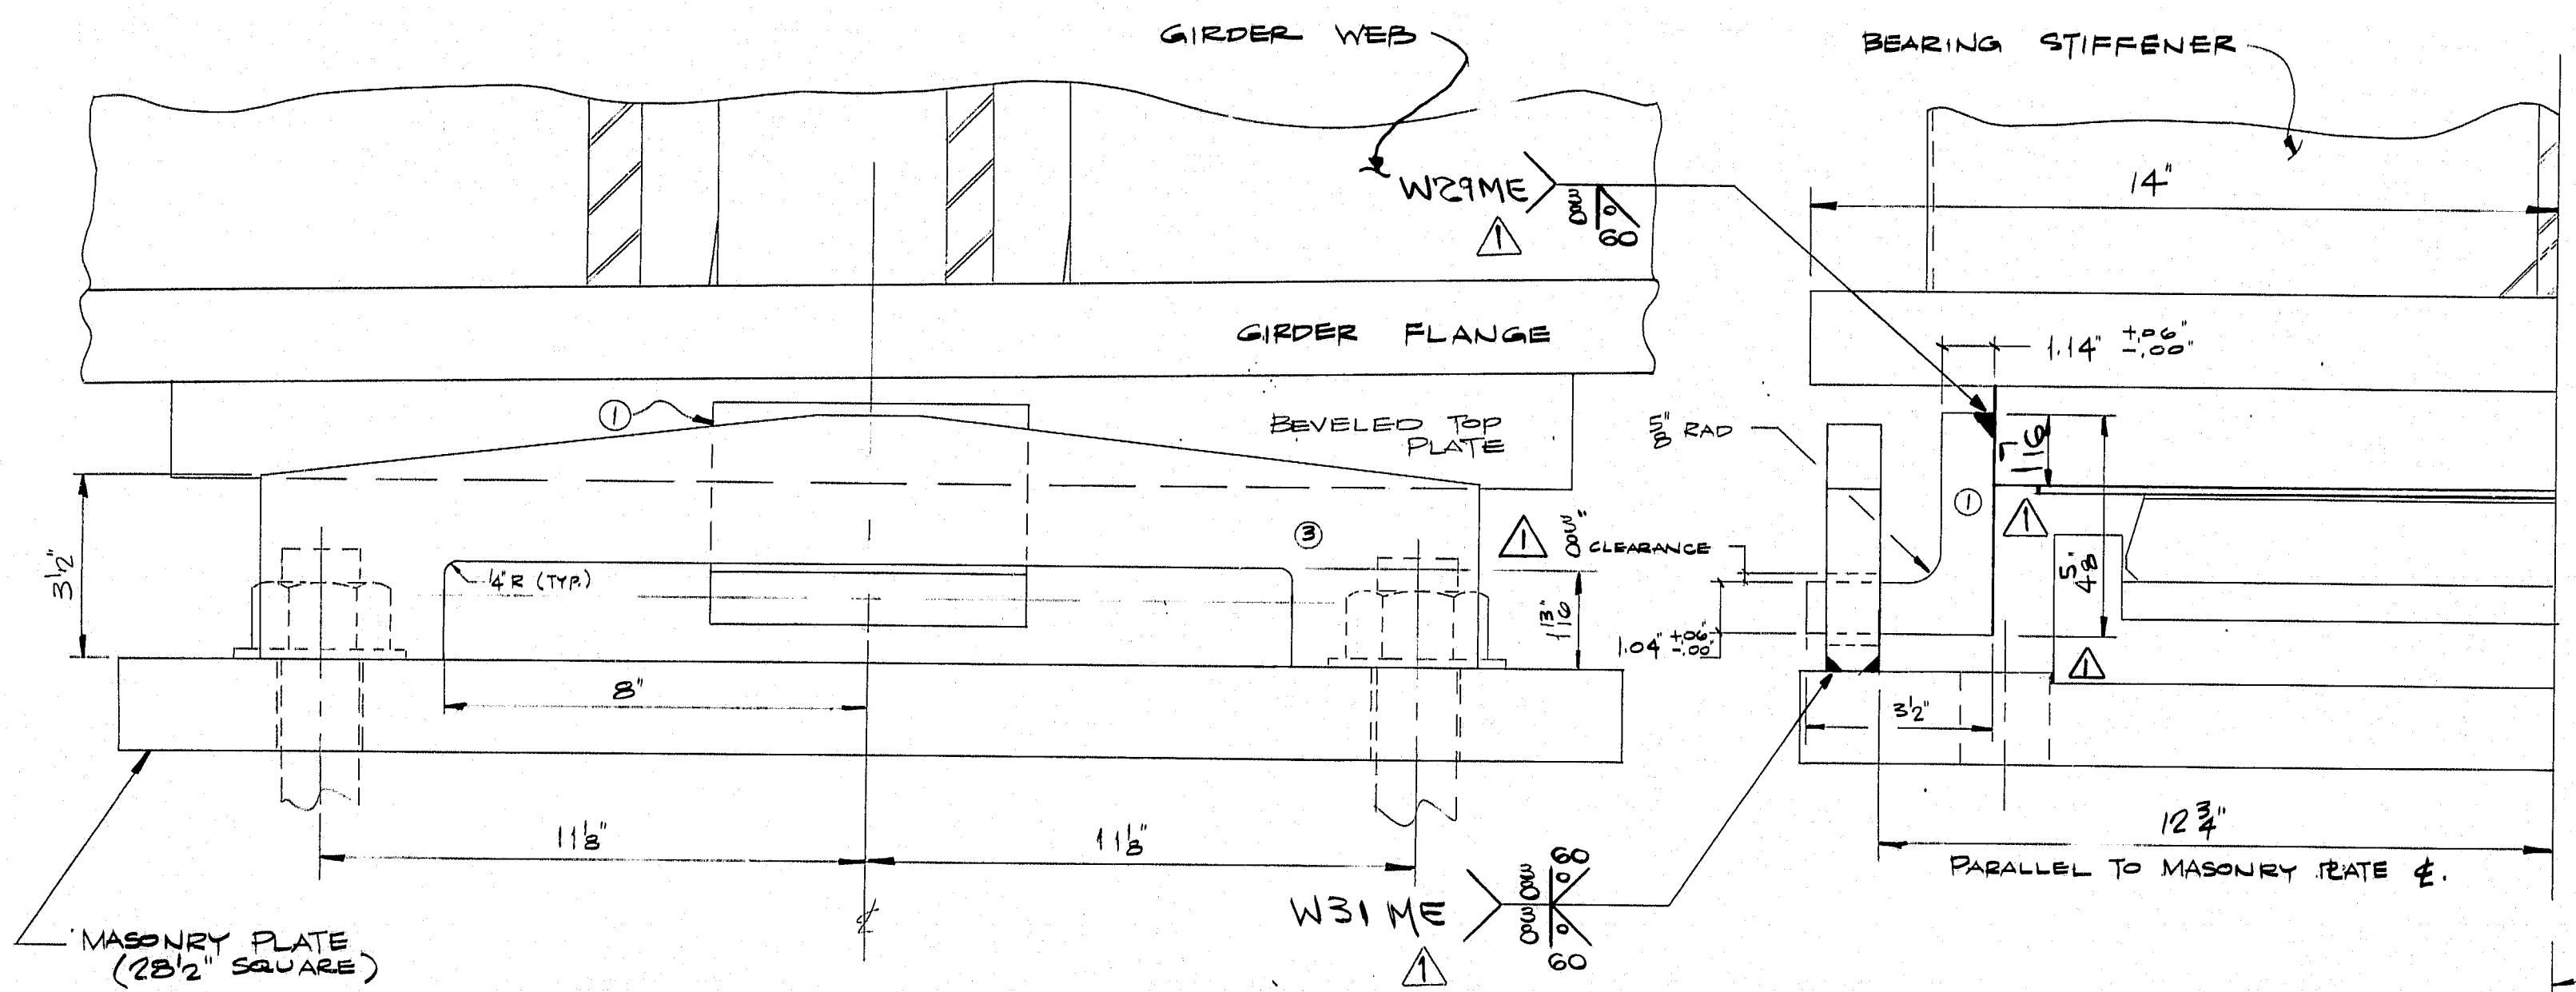

SIDE ELEVATION

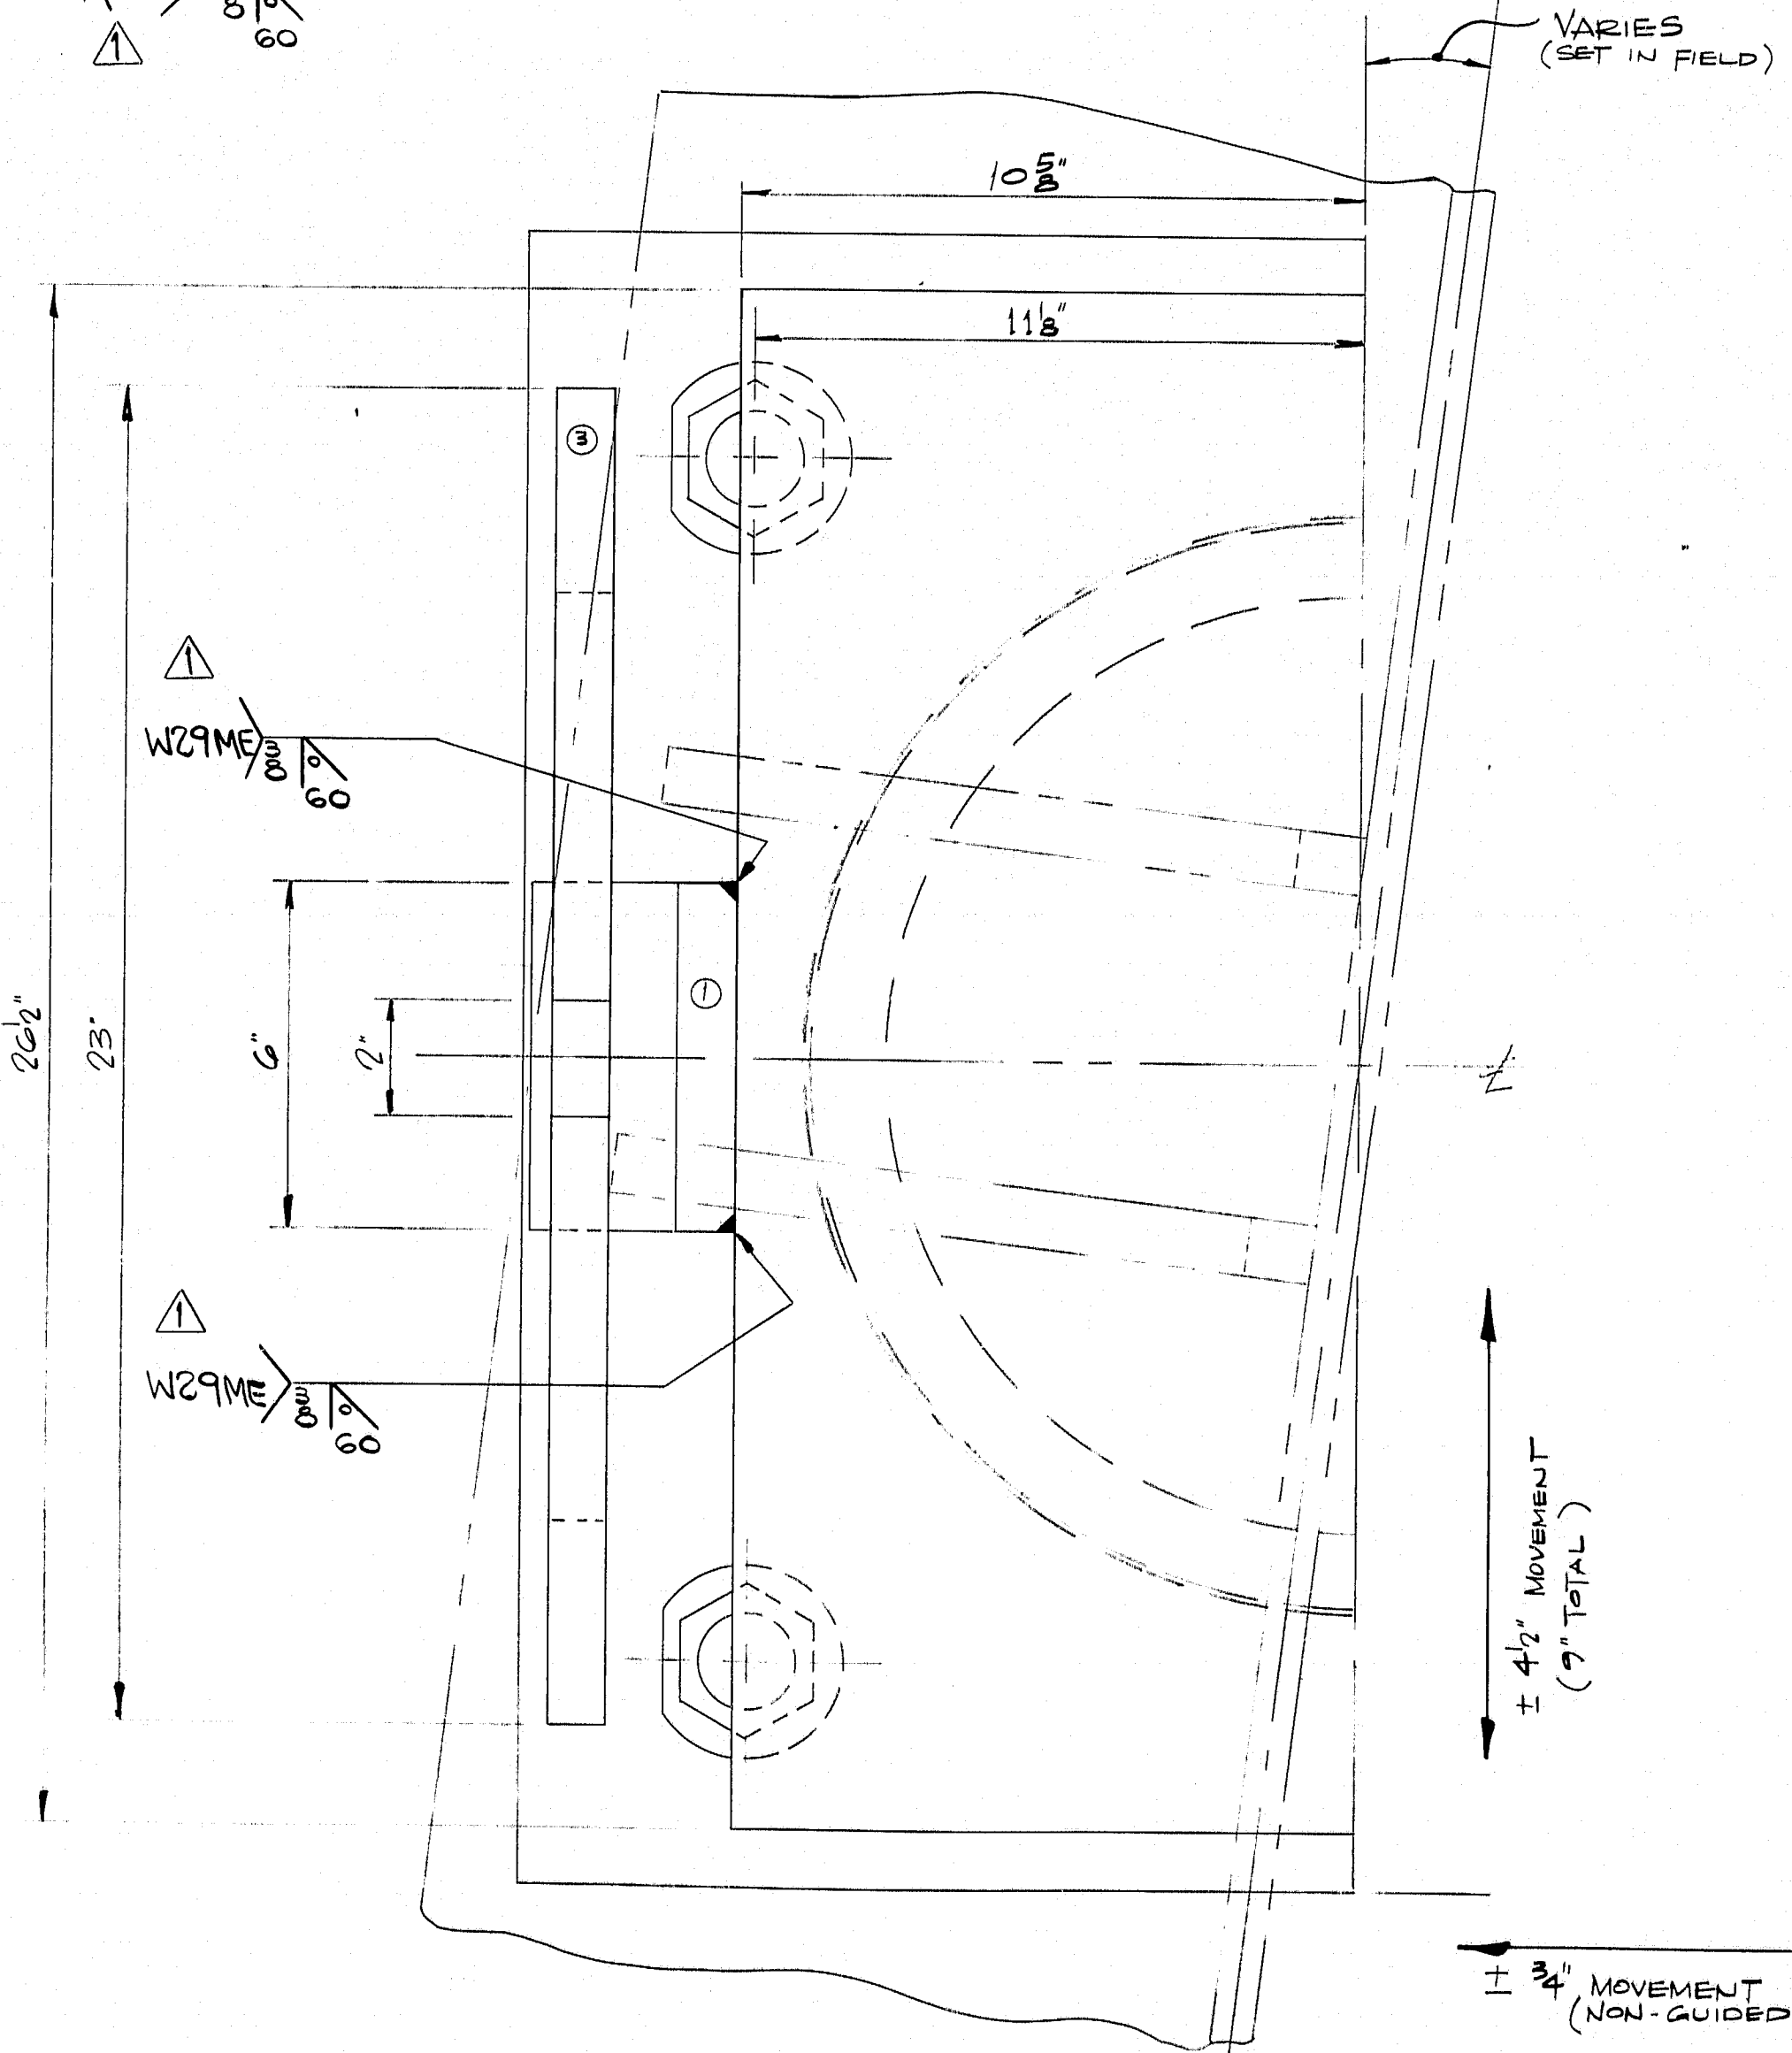

PLAN VIEW  
(HALF OF DETAIL SHOWN)

- NOTES:
1. WORK THIS DRAWING WITH D-1001-1A.
  2. UPLIFT PER BEARING: 45K MIN.
  3. DIMENSIONS & CLEARANCES GIVEN ALLOW FOR REMOVAL OF BASE/CYLINDER. ALSO, ALLOWS FOR MOVEMENT TO EXTREME LIMIT AS REQUIRED ON CONTRACT DRAWINGS.

FED. ROAD DIV. NO.		STATE		FED. AID PROJ. NO.	
BILL OF MATERIAL					
NO.	MARK	DESCRIPTION	LENGTH	REMARKS	ITEM WEIGHT
	①	$4\frac{5}{8} \times 2\frac{1}{2} \times (11\frac{1}{4} \pm .04)$	—	6" ASTM A514	
	②	$4\frac{3}{4} \times 1"$	1' 11"	MACHINE ANGLE FRONT SHOLD PISE ASTM A514	


SHOP NOTE

HOLES: REFER TO  
BOLTS: DWG. D-1001-1A  
PAINT:

R95-159

CODE: 6000

NO. 1	REVISION altered as per 10-11-84 appv	DATE 9-28-84 10-17-84
HIGH STEEL STRUCTURES, INC.		
1905 Old Philadelphia Pike Lancaster, Pennsylvania 17603 Phone 717/299-6211		
A Subsidiary of High Industries, Inc.		
STATE OF MAINE - DEPT. OF TRANSPORTATION		
I-395 BRIDGE OVER PENOBSCOT RIVER		
BANGOR - BEEFER PENOBSCOT COUNTY		
UPLIFT DETAILS FOR PIER 2 - SPAN 3		
BEARING DETAILS BY BERMAZ CORP. INT'L, FAIRFIELD, N.J. 07004-4		
STATE CONTRACT OR REF. NO. 6	CONTRACTOR CIANBRO CORP.	
IN CHARGE:	MADE IN U.S.A. CHK. D. BY: B.S.B. BY: DATE: 8-6-84	
CONTRACT ME-84088-1,2,3 DRAWING NUMBER: D-1003-1A		

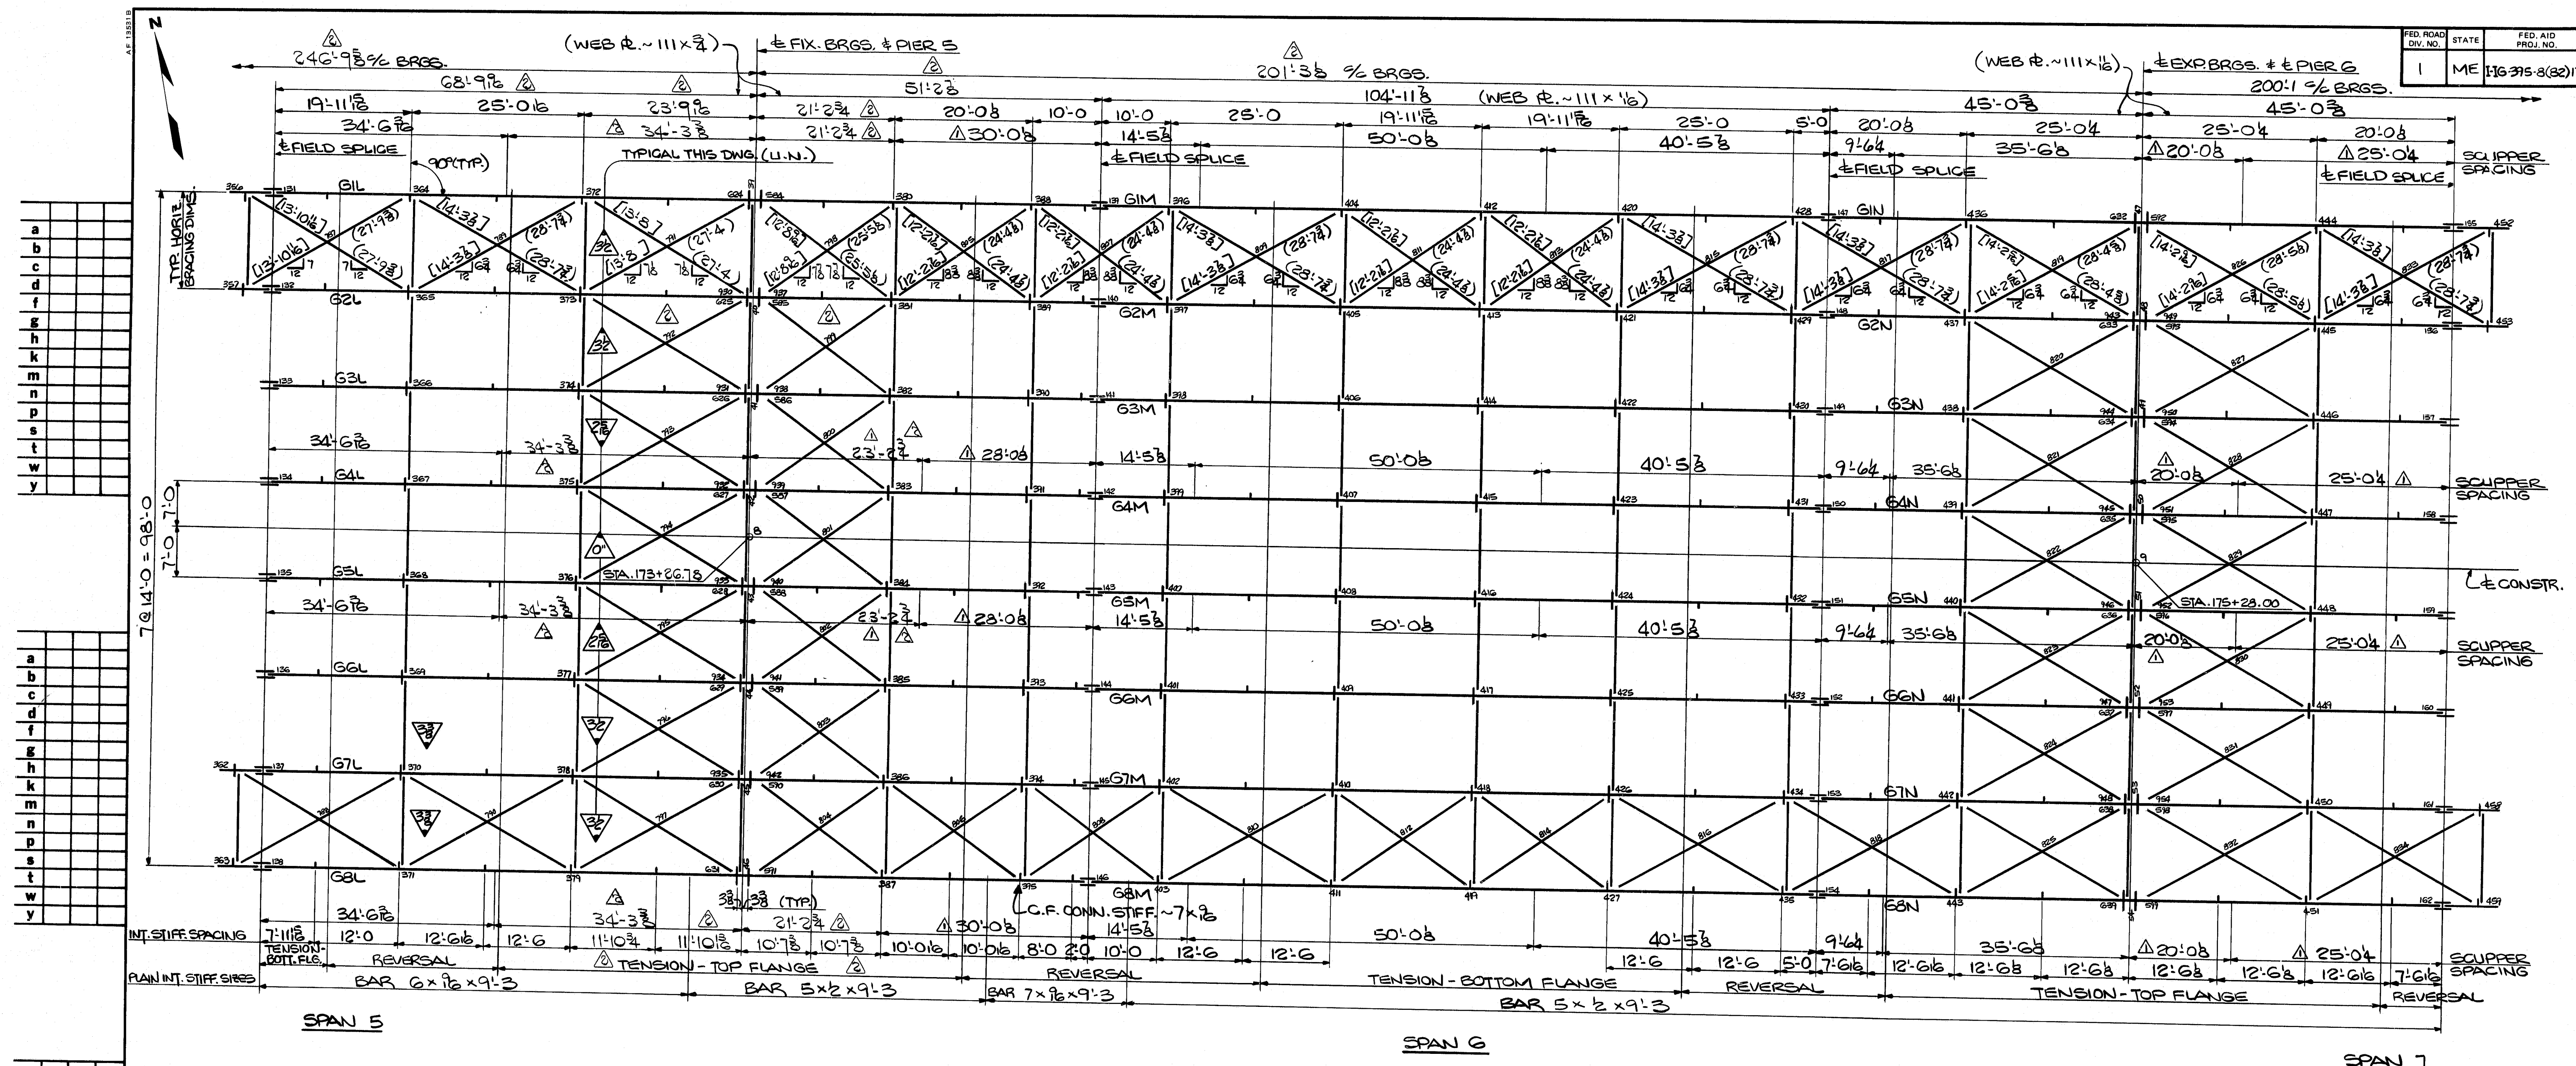

a  
b  
c  
d  
e  
f  
g  
h  
k  
m  
n  
p  
s  
t  
w  
y

a  
b  
c  
d  
e  
f  
g  
h  
k  
m  
n  
p  
s  
t  
w  
y

a  
b  
c  
d  
e  
f  
g  
h  
k  
m  
n  
p  
s  
t  
w  
y

FOR FIGURING PLAN NOTES, SEE DWS. WEI ON CONTRACT # ME-84088-1.  
 FOR WELDING OF INT. STIFFS. & G.F. CONN. STIFFS., SEE DWS. WEI ON CONTRACT # ME-84088-1.  
 WORK THIS DWS. WITH DWS. WEI THRU WE

NO.	REVISION	DATE
1	Revised span length & bracing G.F. CONN. STIFFS. & INT. STIFFS. CONTRACT REVISION CONTROL #14	1-12-85 DATE 9-11-84

**HIGH STEEL STRUCTURES, INC.**  
 1905 Old Philadelphia Pike  
 Lancaster, Pennsylvania 17603  
 Phone 717/299-8211  
 A Subsidiary of High Industries, Inc.

**FIGURING PLAN - SPANS 5, 6, & 7**  
**I-395 BRIDGE OVER PENOBSCOT RIVER**  
**I-395 BRIDGE STA. 164+60.00**  
**PENOBSCOT COUNTY**  
**STATE OF MAINE**  
**DEPARTMENT OF TRANSPORTATION**


STATE CONTRACT OR REF. NO. **G** CONTRACTOR **CIANBRO CORP.**

IN CHARGE **HINKLE** MADE BY **EJK** CHK. D. **JLC** DATE **7-10-84**

CONTRACT NUMBER **ME-84088-3** DRAWING NUMBER **WSI**

R95-160



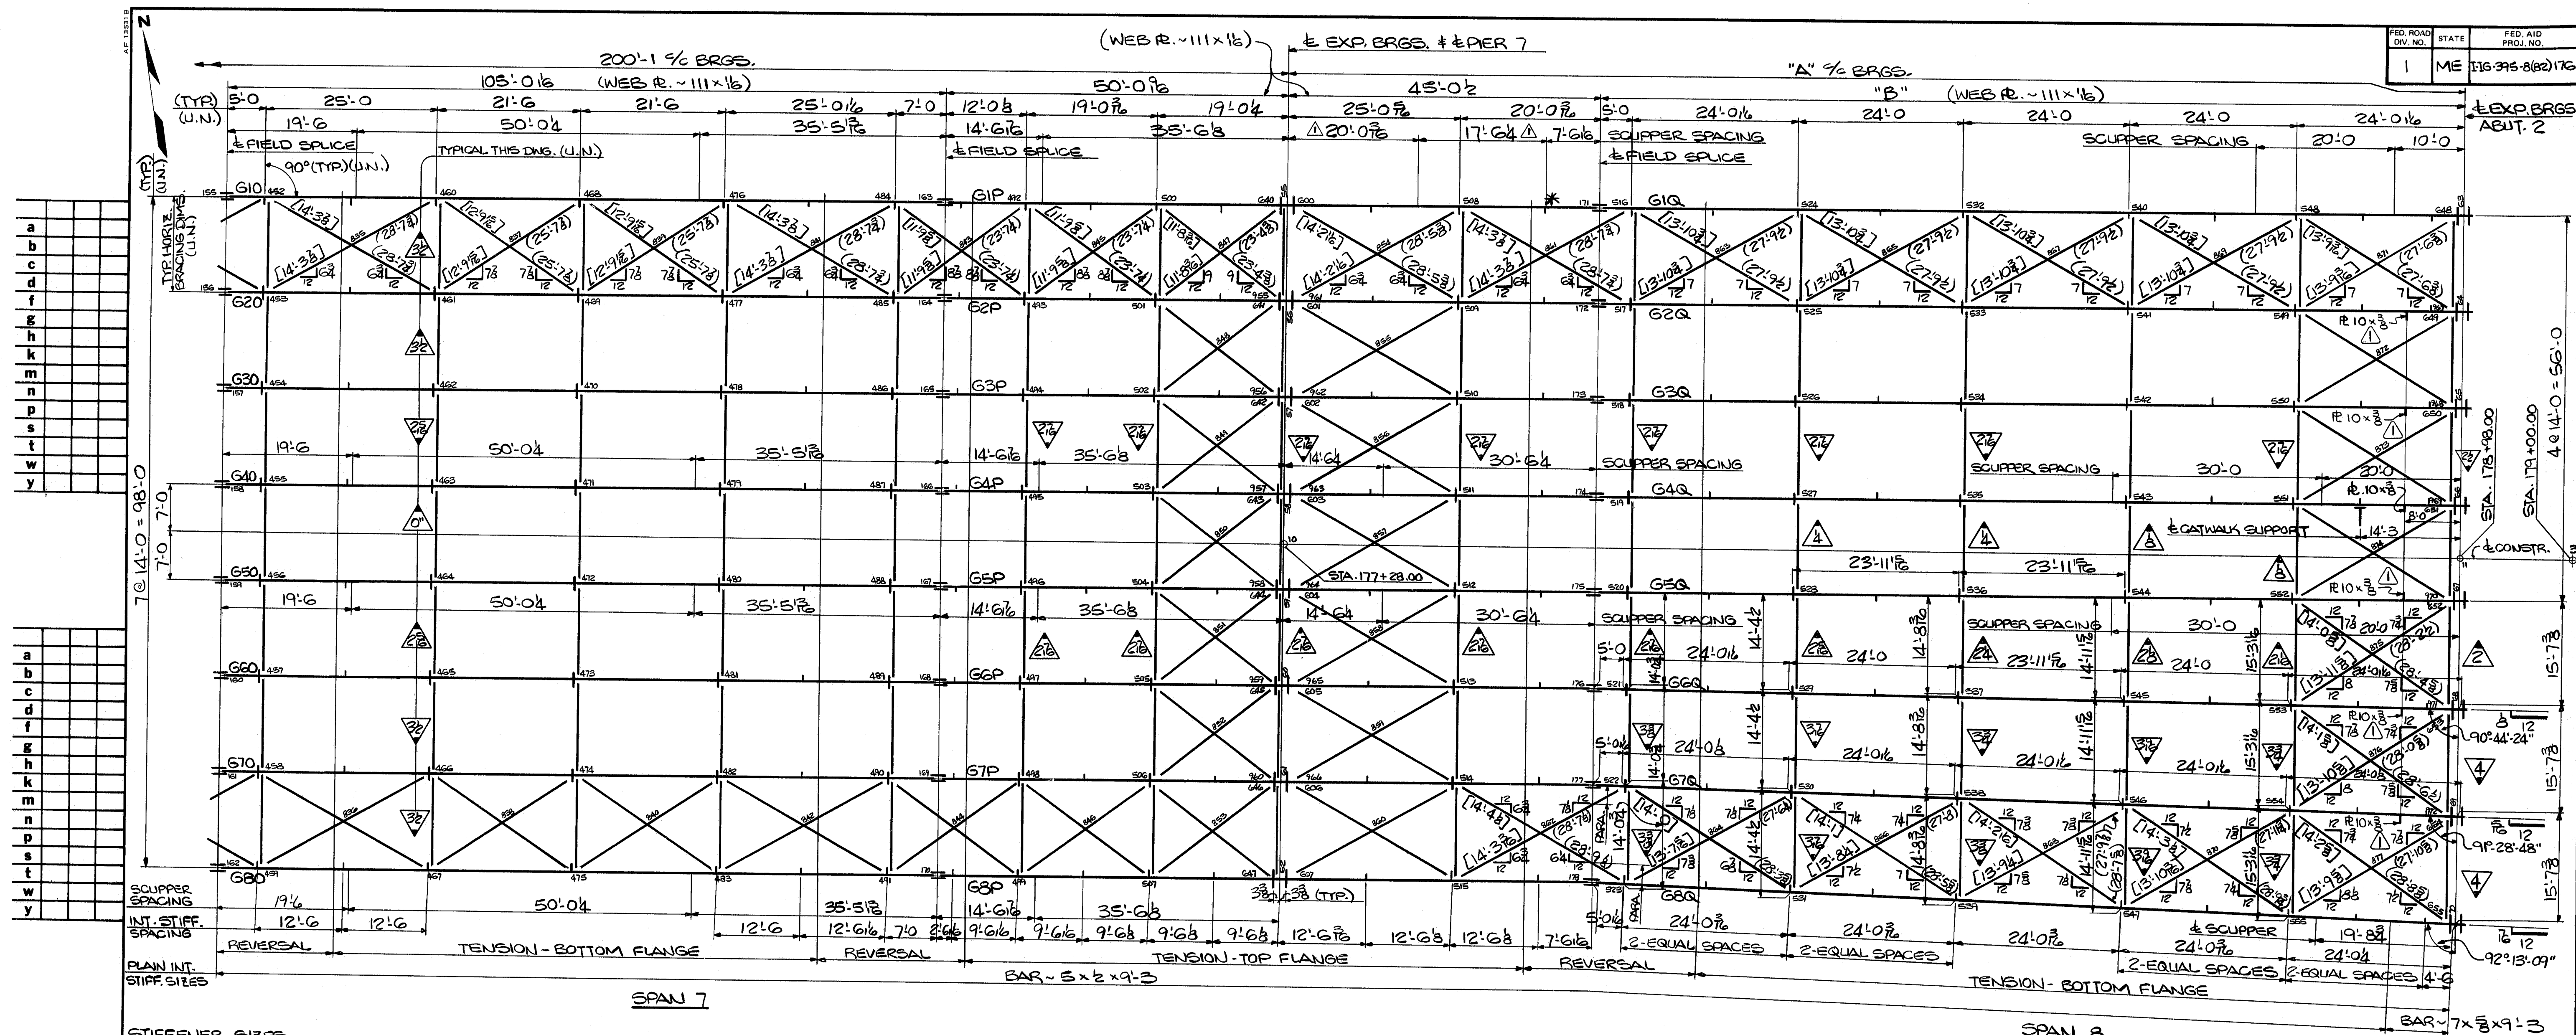

STIFFENER SIZES  
 BEARING STIFFS. ~ PIER 7 ~ 10 x 1  
 ABUT. 2 ~ 9 x 1  
 C.F. CONN. STIFFS. ~ 7 x 2  
 PLAIN INT. STIFFS. ~ AS NOTED  
 STIFFENER CORNER CLIPS  
 BRG. STIFFS. ~ 12 x 32  
 OTHERS ~ 32 x 32

LINE	"A"	"B"
G1	170'-0 3/8	125'-0 3/8
G2	170'-0 3/8	125'-0 3/8
G3	170'-0 3/8	125'-0 3/8
G4	170'-0 3/8	125'-0 3/8
G5	170'-0 3/8	125'-0
G6	170'-0 3/8	125'-0 1/2
G7	170'-1	125'-0 1/2
G8	170'-1 1/2	125'-1 1/2

WORK THIS DWG. WITH DWGS. WE1 & WE3

NO. 1 REVISION CONTRACT REVISION CONTROL #14 DATE 9-11-84

HIGH STEEL STRUCTURES, INC. 1805 Old Philadelphia Pkwy  
 Lancaster, Pennsylvania 17603  
 Phone 717/299-5211  
 A Subsidiary of High Industries, Inc.

FIGURING PLAN ~ SPANS 7 & 8  
 I-395 BRIDGE OVER PENOBSCOT RIVER  
 I-395 BRIDGE STA. 164+60.00  
 PENOBSCOT COUNTY  
 STATE OF MAINE  
 DEPARTMENT OF TRANSPORTATION



STATE CONTRACT OR REF. NO. 6 CONTRACTOR CIANERO CORP.

IN CHARGE HINKLE MADE BY BLK CHK'D BY JLC DATE 7-10-84

CONTRACT NUMBER ME-84088-3 DRAWING NUMBER WS2

R95-161

FED. ROAD DIST. NO.	STATE	FED. AID PROJ. NO.
1	ME.	IG-395-8(82)176

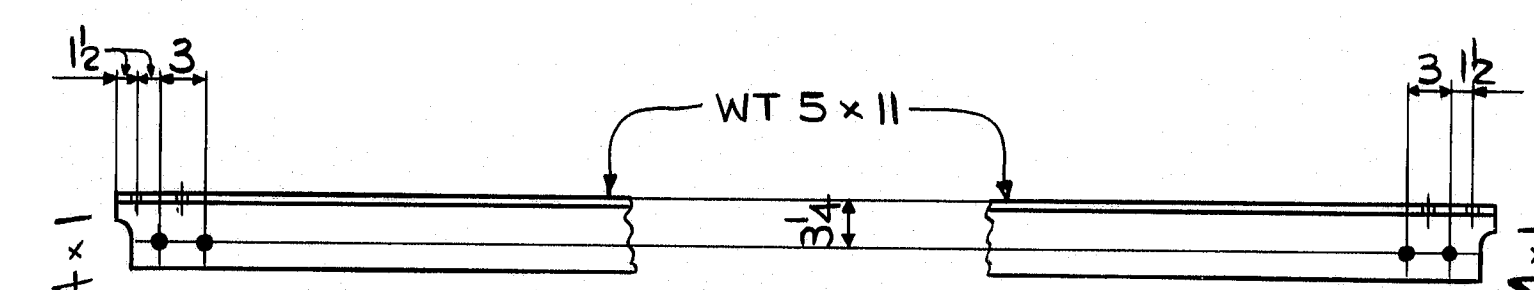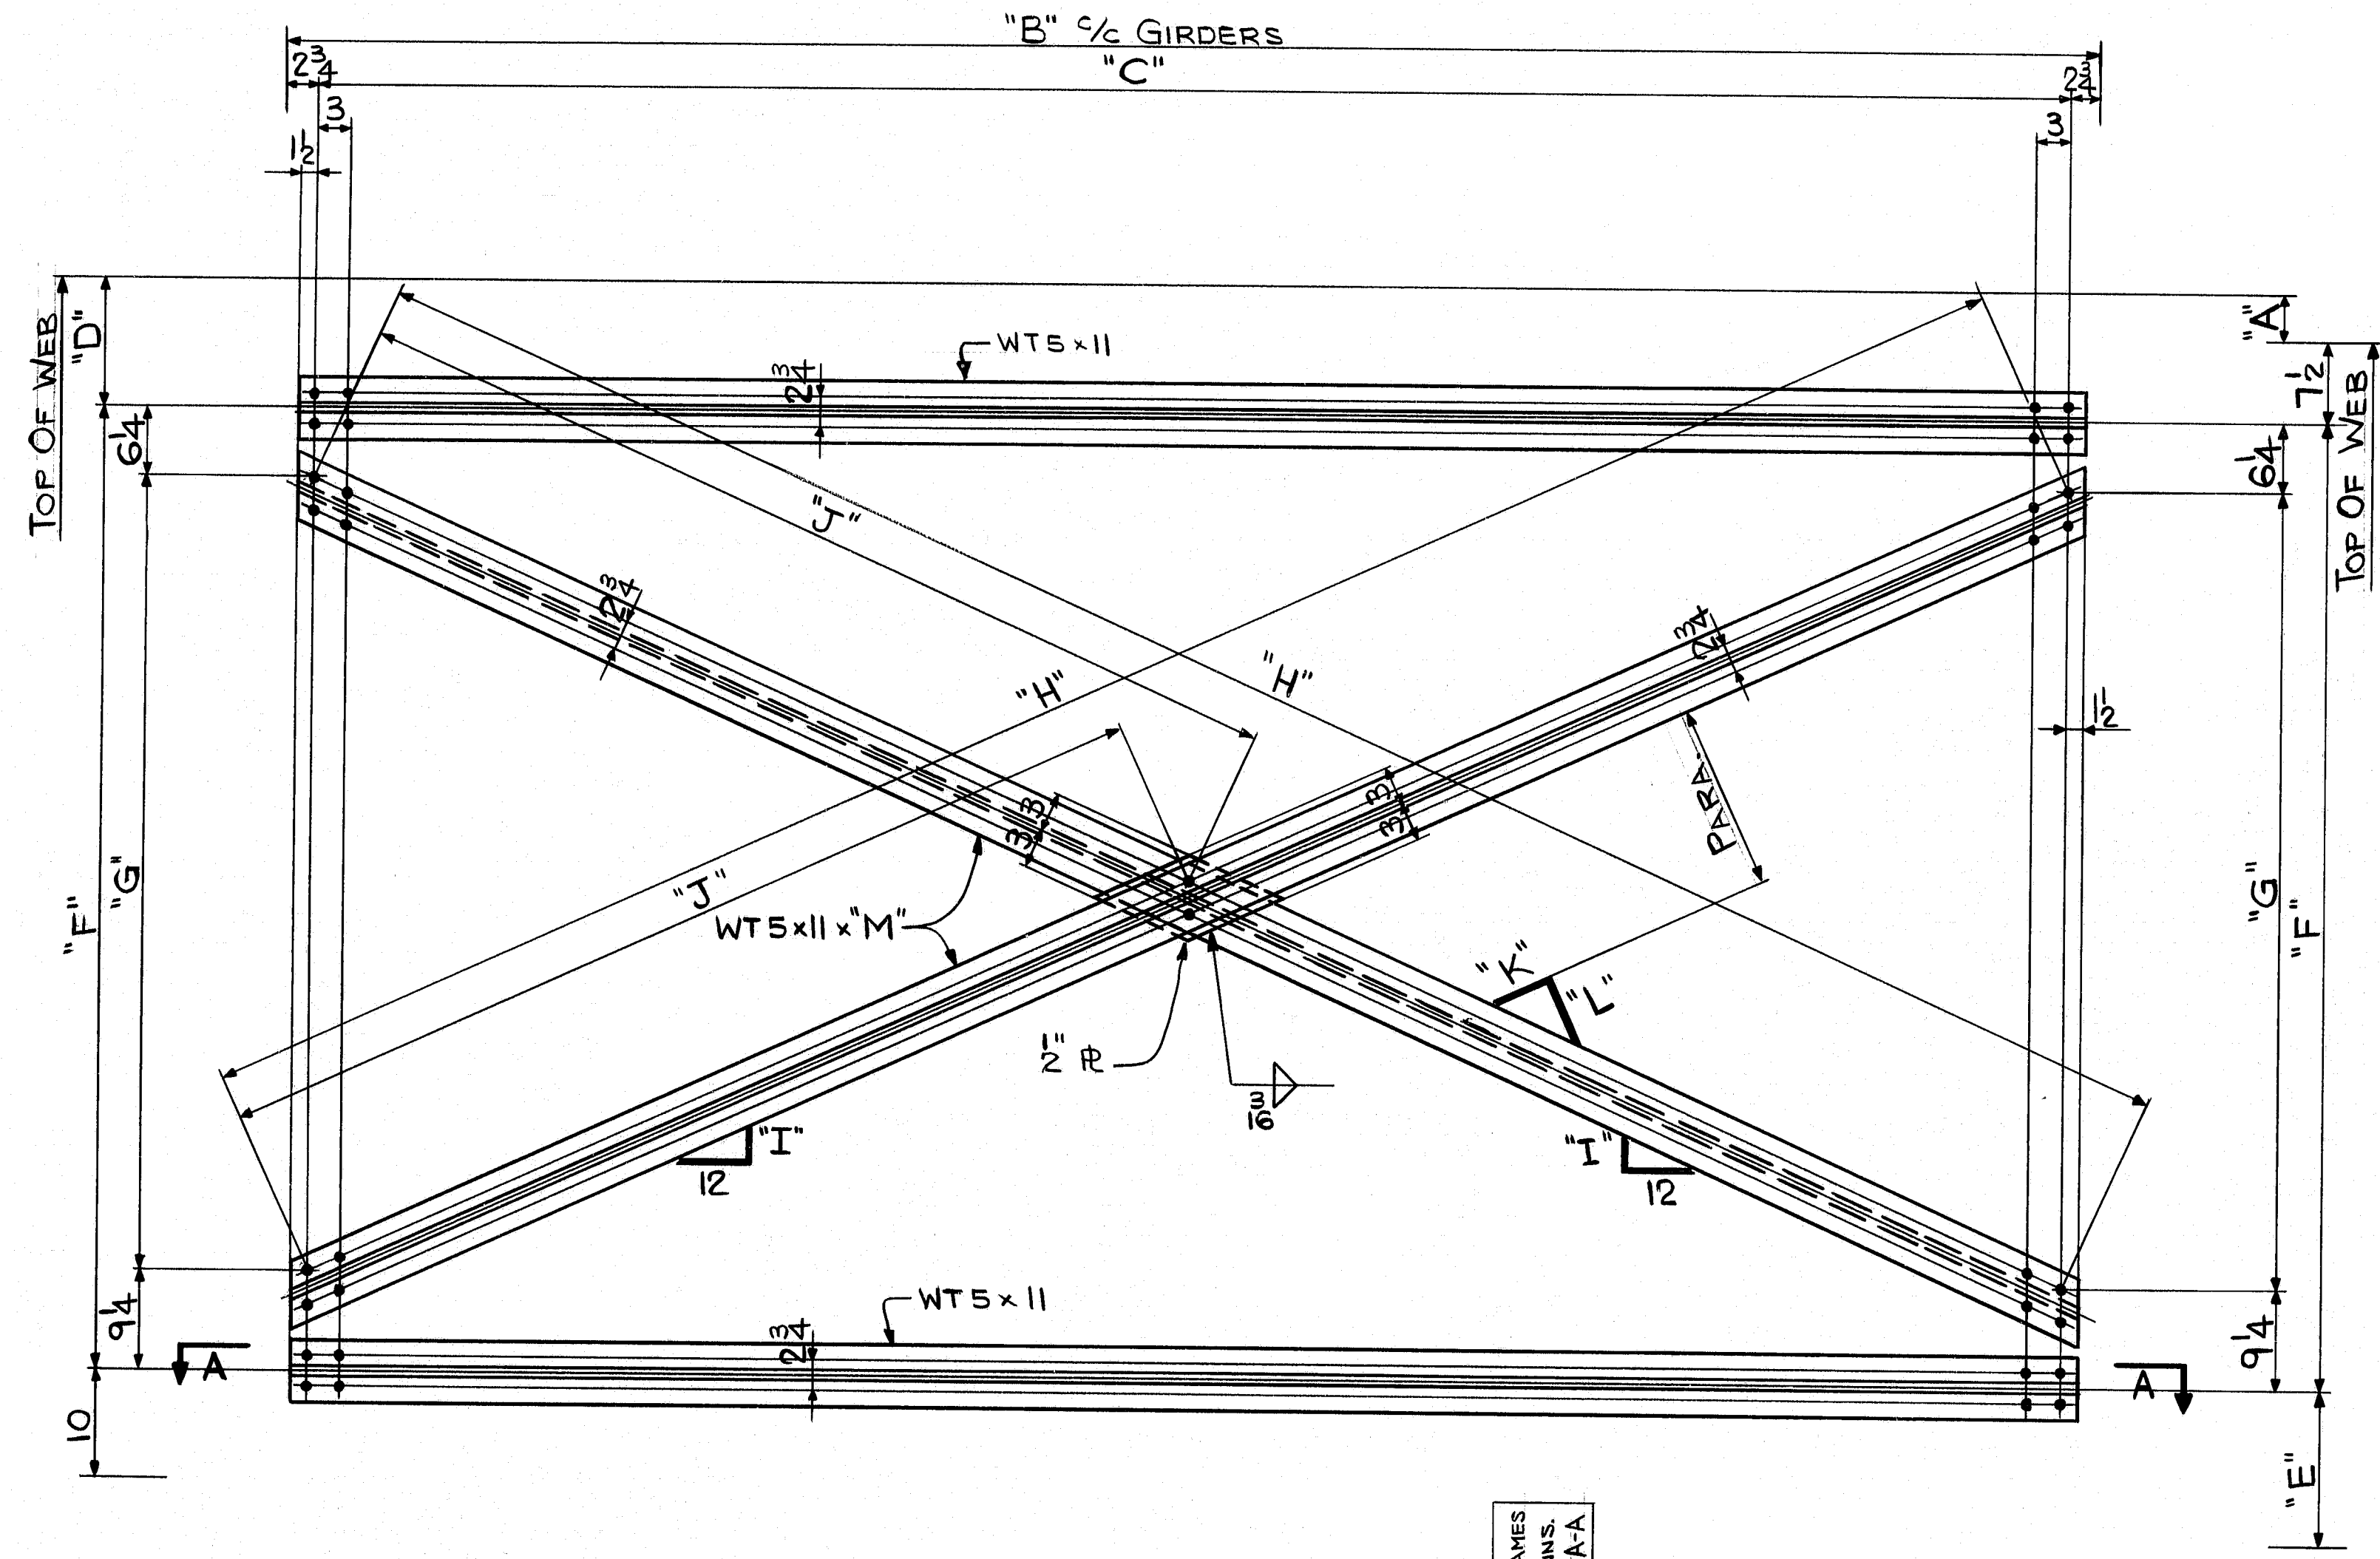

SECTION A-A  
FOR FRAMES WITH H.B. CONNS. SEE CHART

"A"	"B"	"C"	"D"	"E"	"F"	"G"	"H"	"I"	"J"	"K"	"L"	"M"	NO. OF FRAMES WITH H.B. CONNS. SEE SPEC. A-A
2 1/8	14'-0"	13'-6 1/2"	9 1/8	11'-0 1/8"	7'-7 3/8"	6'-3 1/8"	14'-11 1/4"	5 1/8	7'-5 3/8"	10 1/8	12	15'-5 1/4"	4
2 1/8			9 1/8	11'-0 1/8"	7'-7 3/8"	6'-3 1/8"	14'-11 1/4"	5 1/8	7'-5 3/8"	10 1/8	12	15'-5 1/4"	3
3 3/8			10 3/8	11'-1 3/8"	7'-6 3/8"	6'-2 3/8"	14'-10 1/8"	5 1/8	7'-5 1/8"	10 1/8	12	15'-4 3/4"	1
3 1/2	14'-0"	13'-6 1/2"	11	11'-1 1/2"	7'-6"	6'-2 1/2"	14'-10 3/4"	5 1/2	7'-5 3/8"	10 1/8	12	15'-4 1/8"	44
2 1/8	14'-4 1/2"	13'-11"	9 1/8	11'-0 1/8"	7'-7 3/8"	6'-3 1/8"	15'-3 3/8"	5 1/8	7'-7 1/8"	10 1/2	12	15'-9 1/4"	0
3 1/8	14'-4 1/2"	13'-11"	10 1/8	11'-1 1/8"	7'-6 1/8"	6'-2 1/8"	15'-2 3/8"	5 3/8	7'-7 1/8"	10 3/4	12	15'-8 3/4"	1
2 1/4	14'-8 1/8"	14'-2 1/8"	9 3/4	11'-0 1/4"	7'-7 1/4"	6'-3 3/4"	15'-6 3/4"	5 1/8	7'-9 3/8"	10 3/8	12	16'-0 1/8"	0
3 3/8	14'-8 1/8"	14'-2 1/8"	10 3/8	11'-1 3/8"	7'-6 3/8"	6'-2 3/8"	15'-6 1/8"	5 1/4	7'-9 3/8"	11 3/8	12	16'-0 1/8"	1
3 3/4	14'-8 1/8"	14'-2 1/8"	11 1/4	11'-1 3/4"	7'-5 3/4"	6'-2 1/4"	15'-6 1/4"	5 1/4	7'-9 1/8"	11 3/8	12	15'-11 1/8"	0
2 3/8	14'-11 1/8"	14'-6 1/8"	9 3/8	11'-0 3/8"	7'-7 3/8"	6'-3 3/8"	15'-10 1/4"	5 1/4	7'-11 3/8"	11 3/8	12	16'-4"	0
3 3/8	14'-11 1/8"	14'-6 1/8"	11 1/8	11'-1 1/8"	7'-5 1/8"	6'-2 1/8"	15'-9 3/8"	5 3/8	7'-10 1/8"	11 3/8	12	16'-3 3/8"	1
2 1/8	15'-3 1/8"	14'-10 1/8"	9 1/8	11'-0 1/8"	7'-7 1/8"	6'-3 1/8"	16'-1 1/8"	5 3/8	8'-0 3/8"	11 1/2	12	16'-7 3/8"	1
3 3/4	15'-3 1/8"	14'-10 1/8"	11 1/4	11'-1 3/4"	7'-5 3/4"	6'-2 1/4"	16'-1 1/8"	5	8'-0 1/2"	11 3/8	12	16'-6 1/8"	2

R95-162

WORK THIS DWG. WITH DWGS. WS1, WS2, & WS5


NO.	REVISION	DATE
HIGH STEEL STRUCTURES, INC.		
1905 Old Philadelphia Pike Lancaster, Pennsylvania 17603 Phone 717/299-5211		
A Subsidiary of High Industries, Inc.		
INT. CROSSFRAME LAYOUTS (M)		
I-395 BRIDGE OVER PENOBSCOT RIVER		
I-395 BRIDGE STA. 164+60.00		
PENOBSCOT COUNTY		
STATE OF MAINE		
DEPARTMENT OF TRANSPORTATION		
STATE CONTRACT OR REF. NO.	6	CONTRACTOR CIAMBRO CORP.
IN CHARGE:	HINKLE	MADE BY: JLC CHK'D BY: BJK DATE: 7-25-84
CONTRACT NUMBER:	ME-84088-3	DRAWING NUMBER: WS3



a  
b  
c  
d  
e  
f  
g  
h  
k  
m  
n  
p  
s  
t  
w  
y


a  
b  
c  
d  
e  
f  
g  
h  
k  
m  
n  
p  
s  
t  
w  
y

a  
b  
c  
d  
e  
f  
g  
h  
k  
m  
n  
p  
s  
t  
w  
y

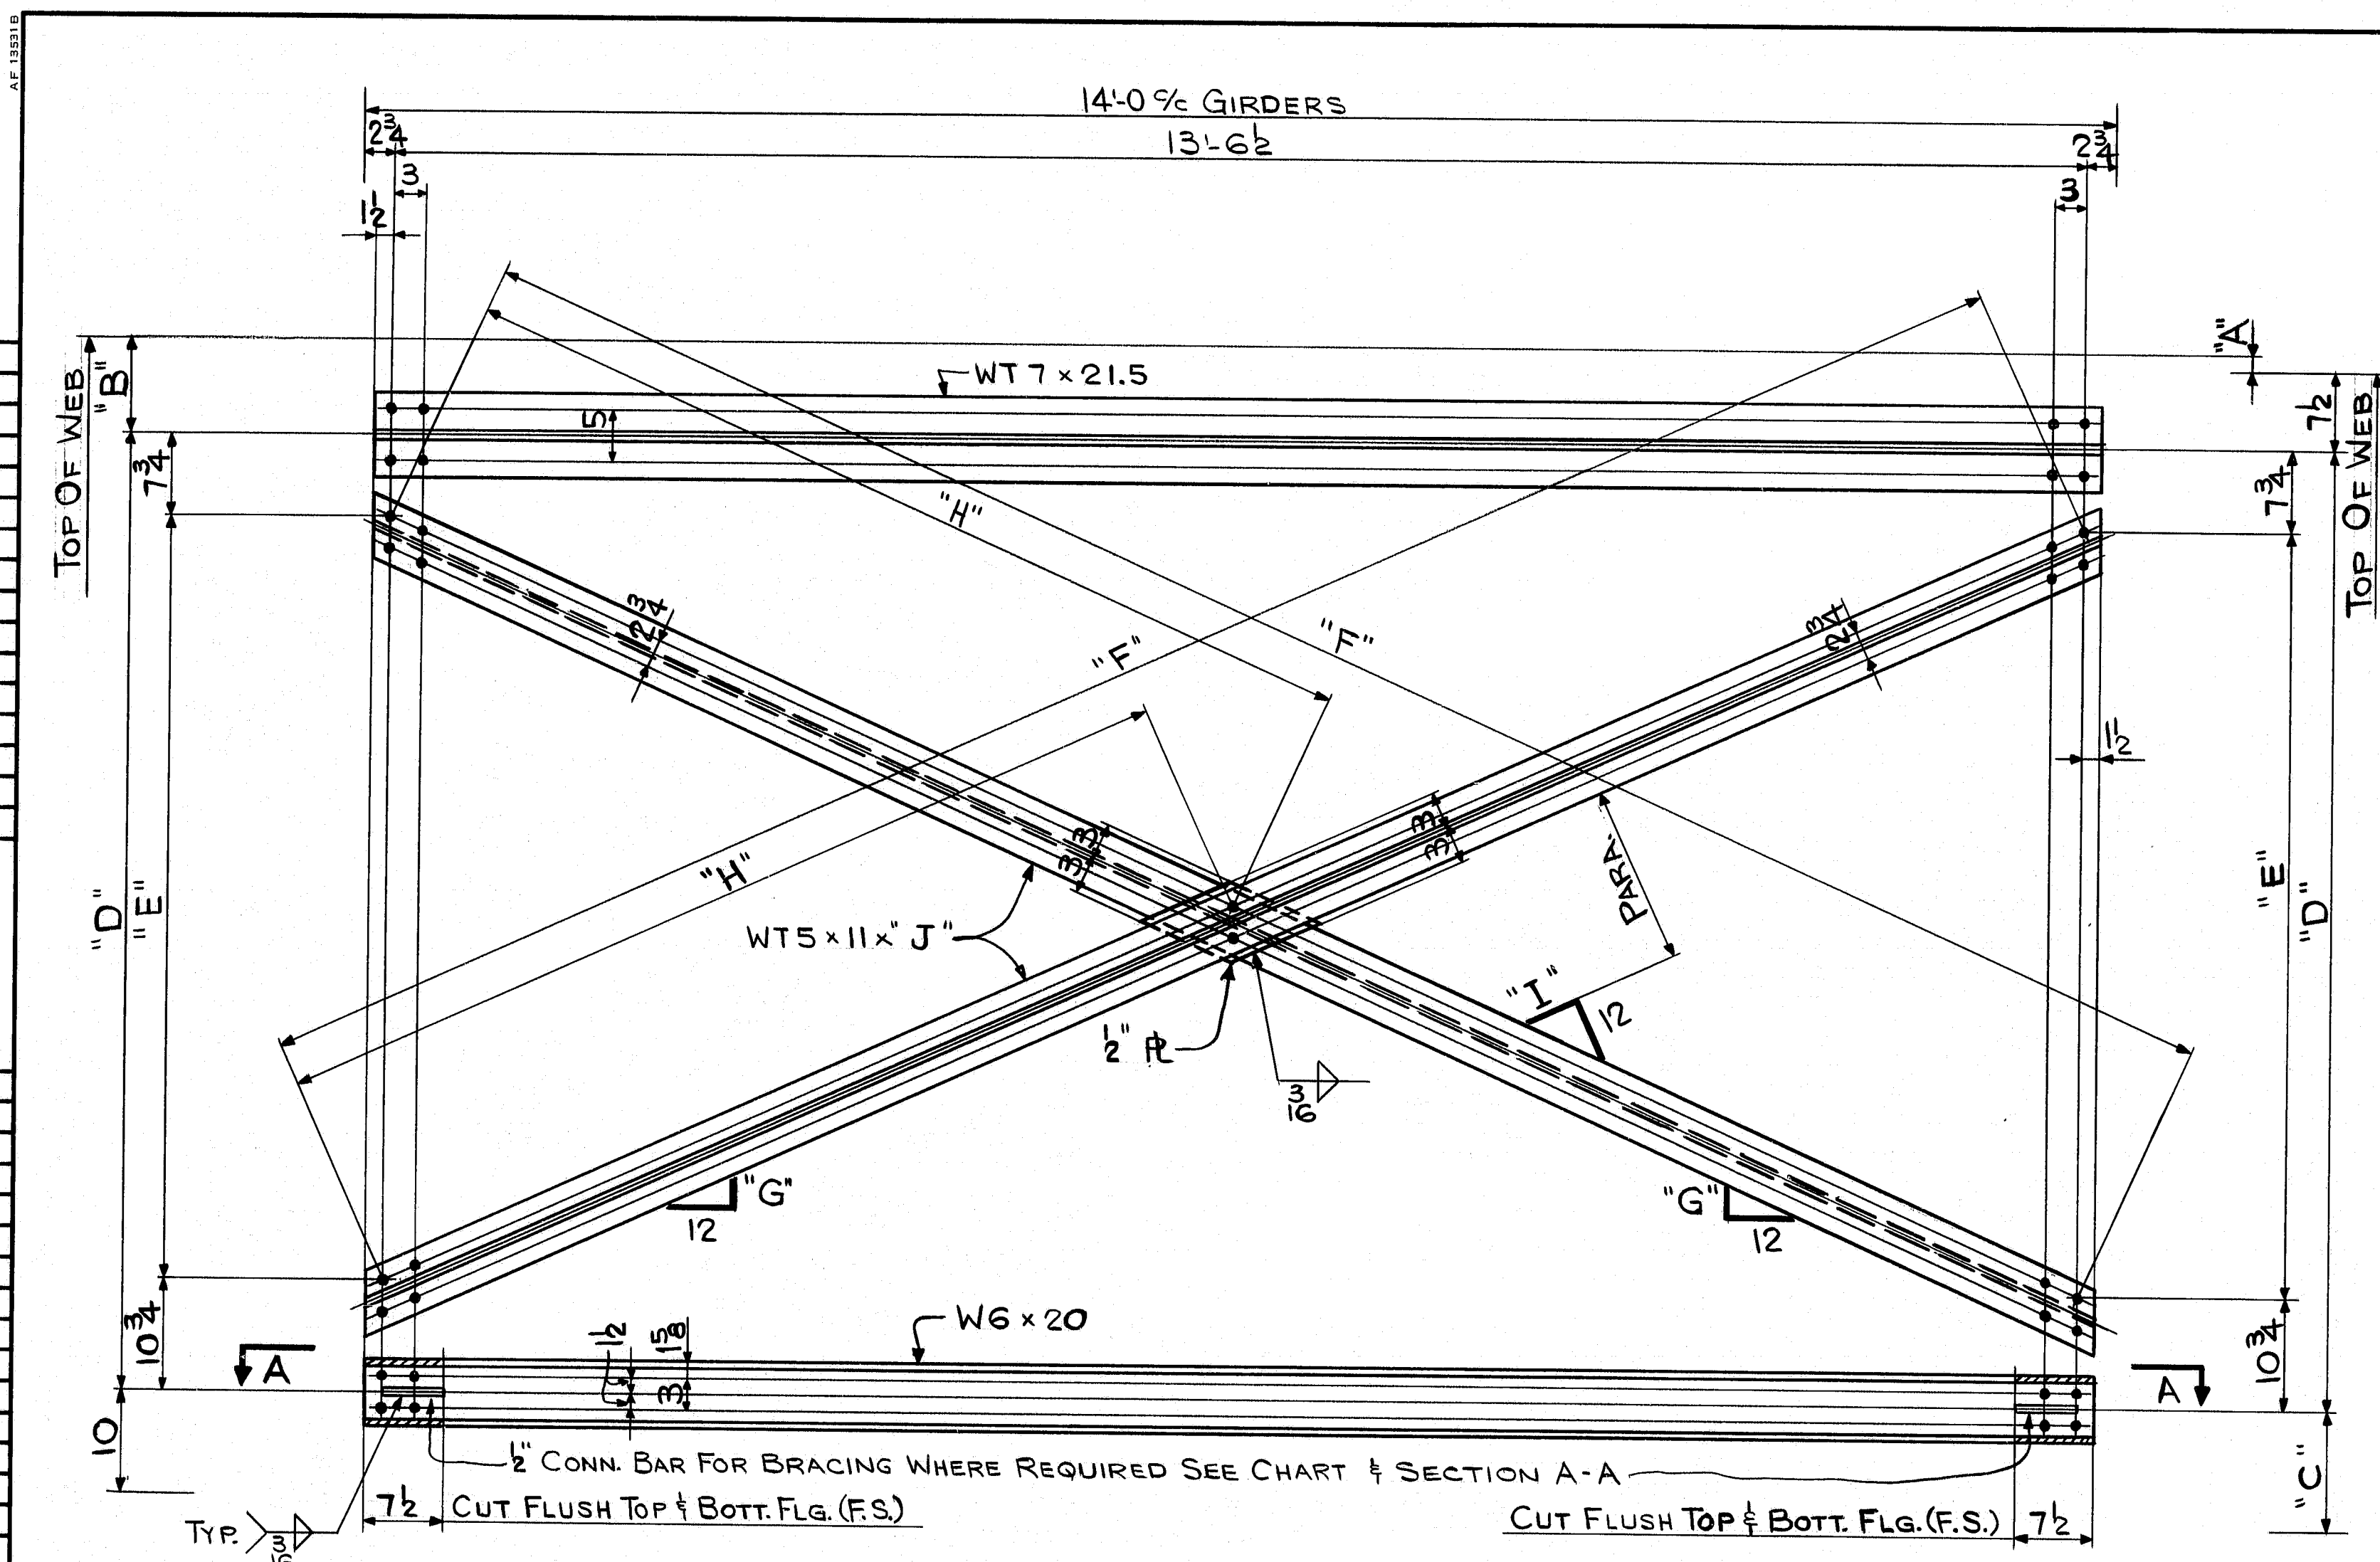


"A"	"B"	"C"	"D"	"E"	"F"	"G"	"H"	"I"	"J"	NO. OF BRACES W/ B. CONNS. SEE SECT. A-A.
0	7 1/2	10	7-9 1/2	6-3	14-11	5 9/16	7-5 1/2	10 4/5	15-4 1/8	0
1	7 3/8	10 1/8	7-9 3/8	6-2 3/8	14-10 1/2	5 1/2	7-5 1/16	10 4/5	15-4 1/8	1
4	7 3/4	10 1/4	7-9 1/4	6-2 3/4	14-10 3/4	5 1/2	7-5 1/16	10 1/16	15-4 1/16	0

FED. ROAD DIV. NO.	STATE	FED. AID PROJ. NO.
1	ME	11G-395-8(82)176

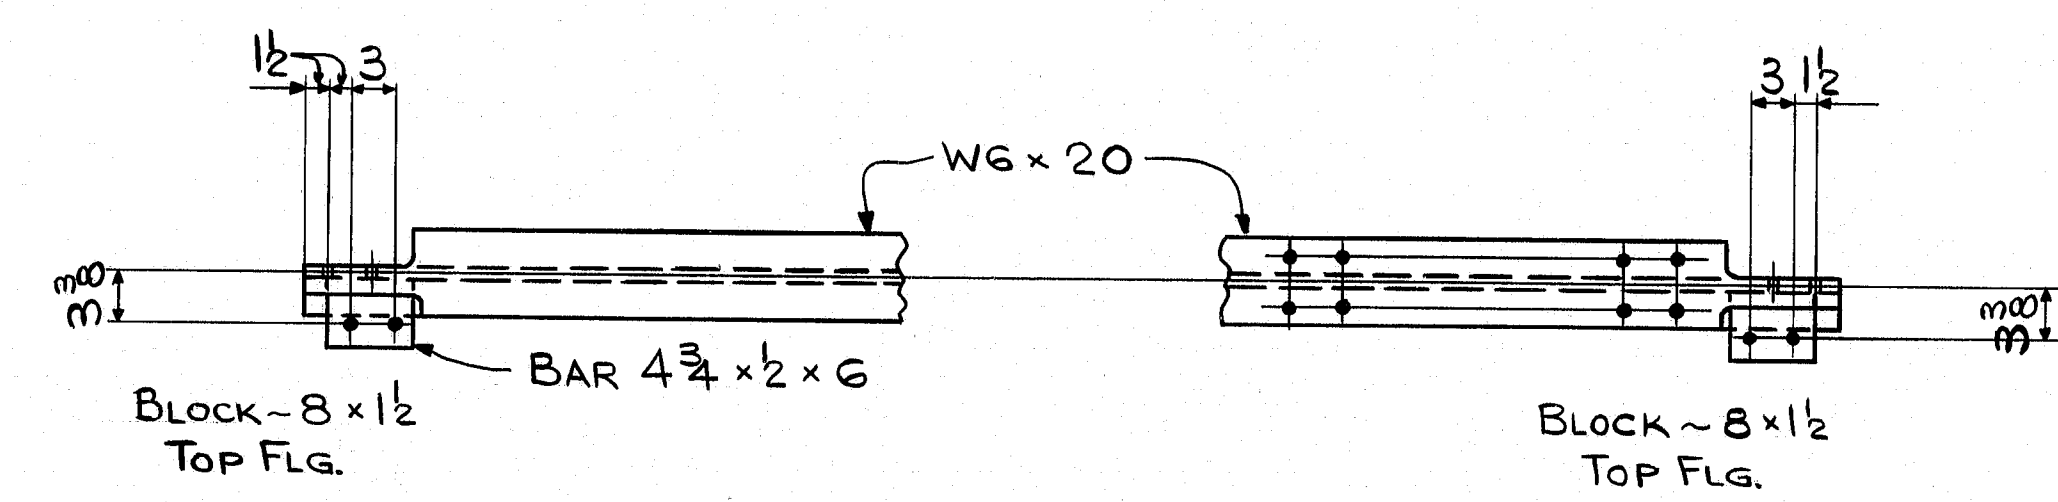

SECTION A-A  
FOR FRAMES WITH H.B. CONNS. SEE CHART


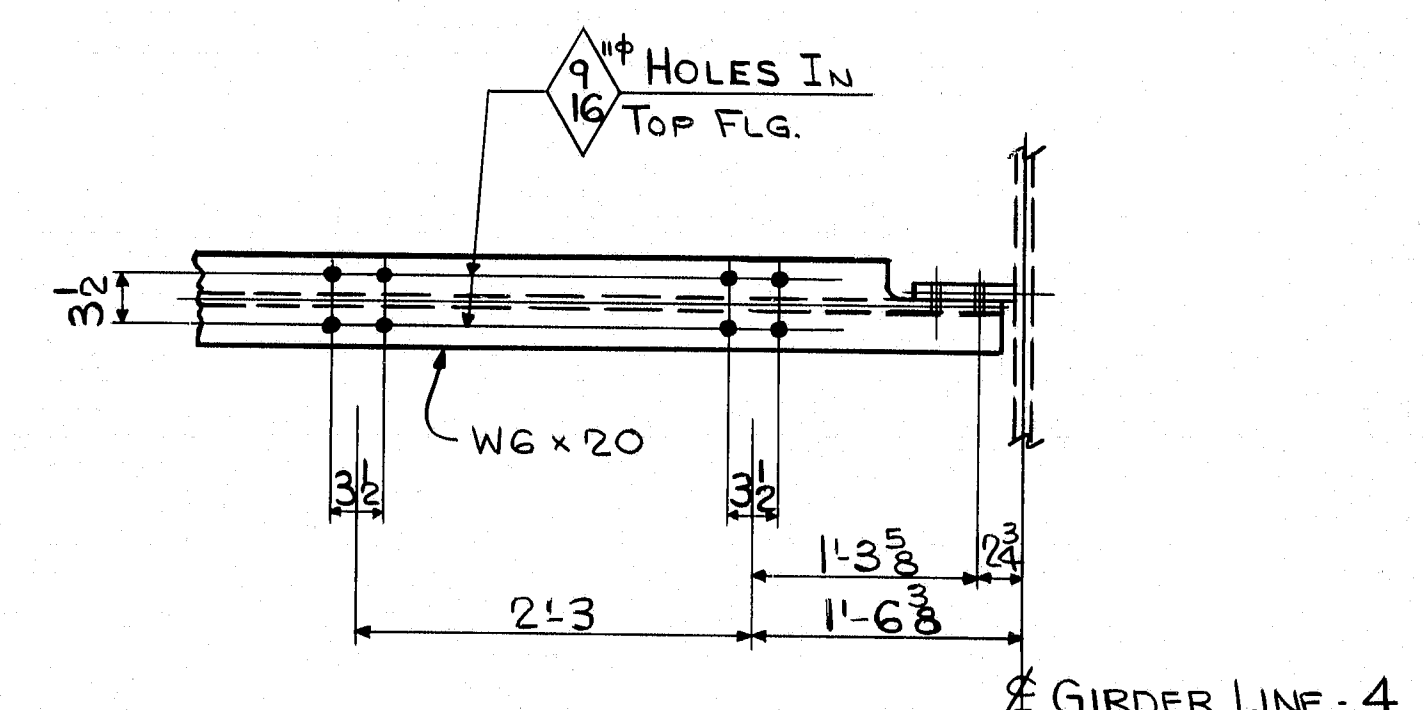


SECTION -A  
TYP. HOLE SPACING FOR CATWALK CONN.



R95-163

WORK THIS DWG. WITH DWGS. WS1, WS2, & WS5


NO.	REVISION	DATE
<p><b>HIGH STEEL STRUCTURES, INC.</b></p> <p>1905 Old Philadelphia Pike Lancaster, Pennsylvania 17603 Phone 717/299-5211</p> <p>A Subsidiary of High Industries, Inc.</p>		
<p>INT. CROSSFRAME LAYOUTS ("M2" Mod.)</p> <p>I-395 BRIDGE OVER PENOBSCOT RIVER</p> <p>I-395 BRIDGE STA. 164+60.00</p> <p>PENOBSCOT COUNTY</p> <p>STATE OF MAINE</p> <p>DEPARTMENT OF TRANSPORTATION</p>		
STATE CONTRACT OR REF. NO.	CONTRACTOR	
6	CIAMBRO CORP.	
IN CHARGE:	MADE BY:	CHK'D BY:
HINKLE	JLC	EJK
		DATE: 7-26-84
CONTRACT NUMBER:	DRAWING NUMBER:	
ME-84088-3	WS4	

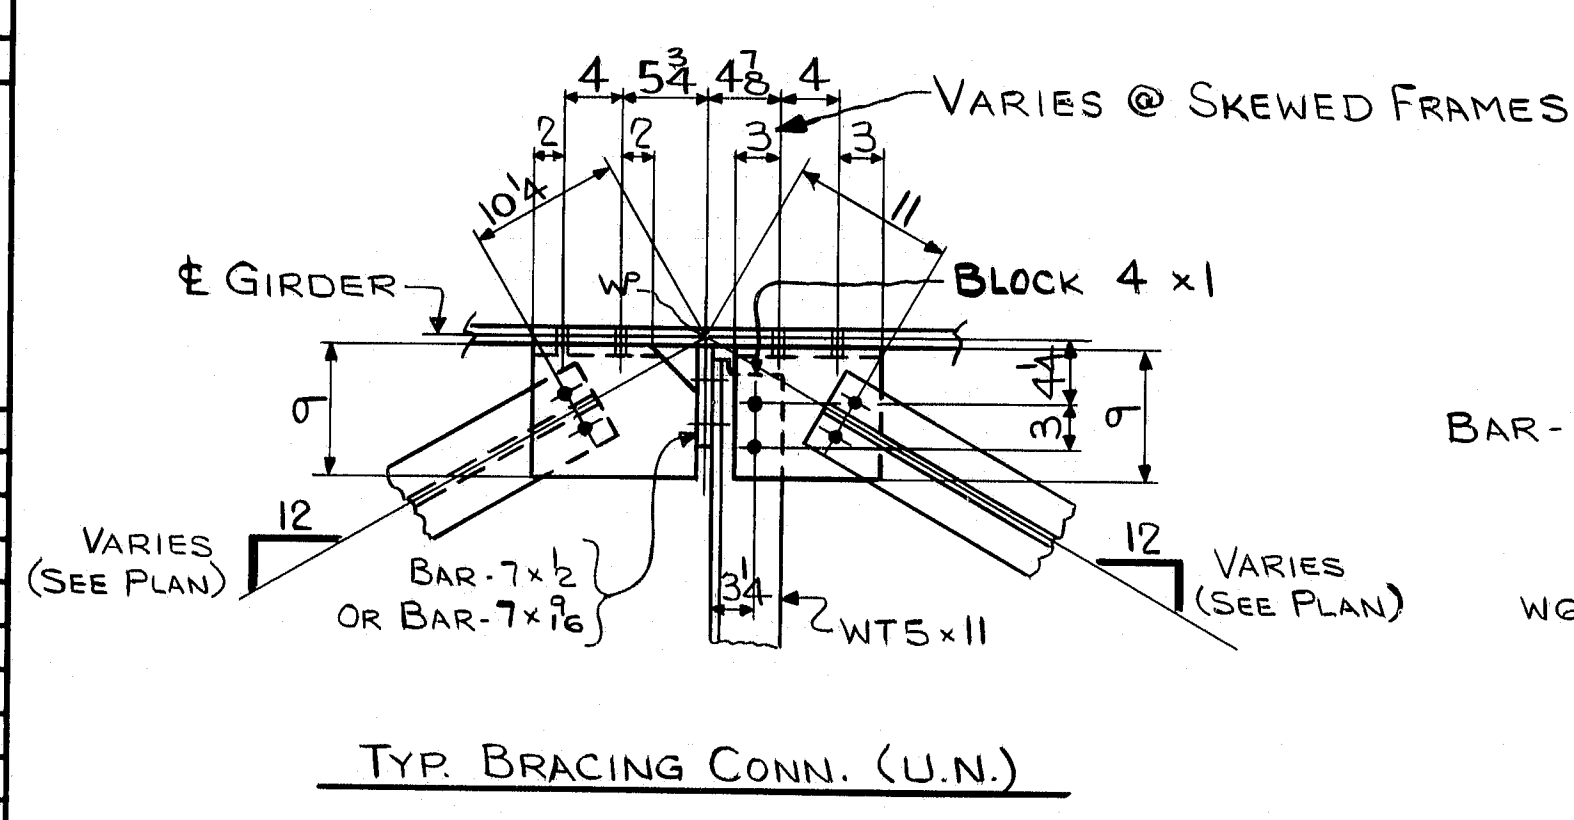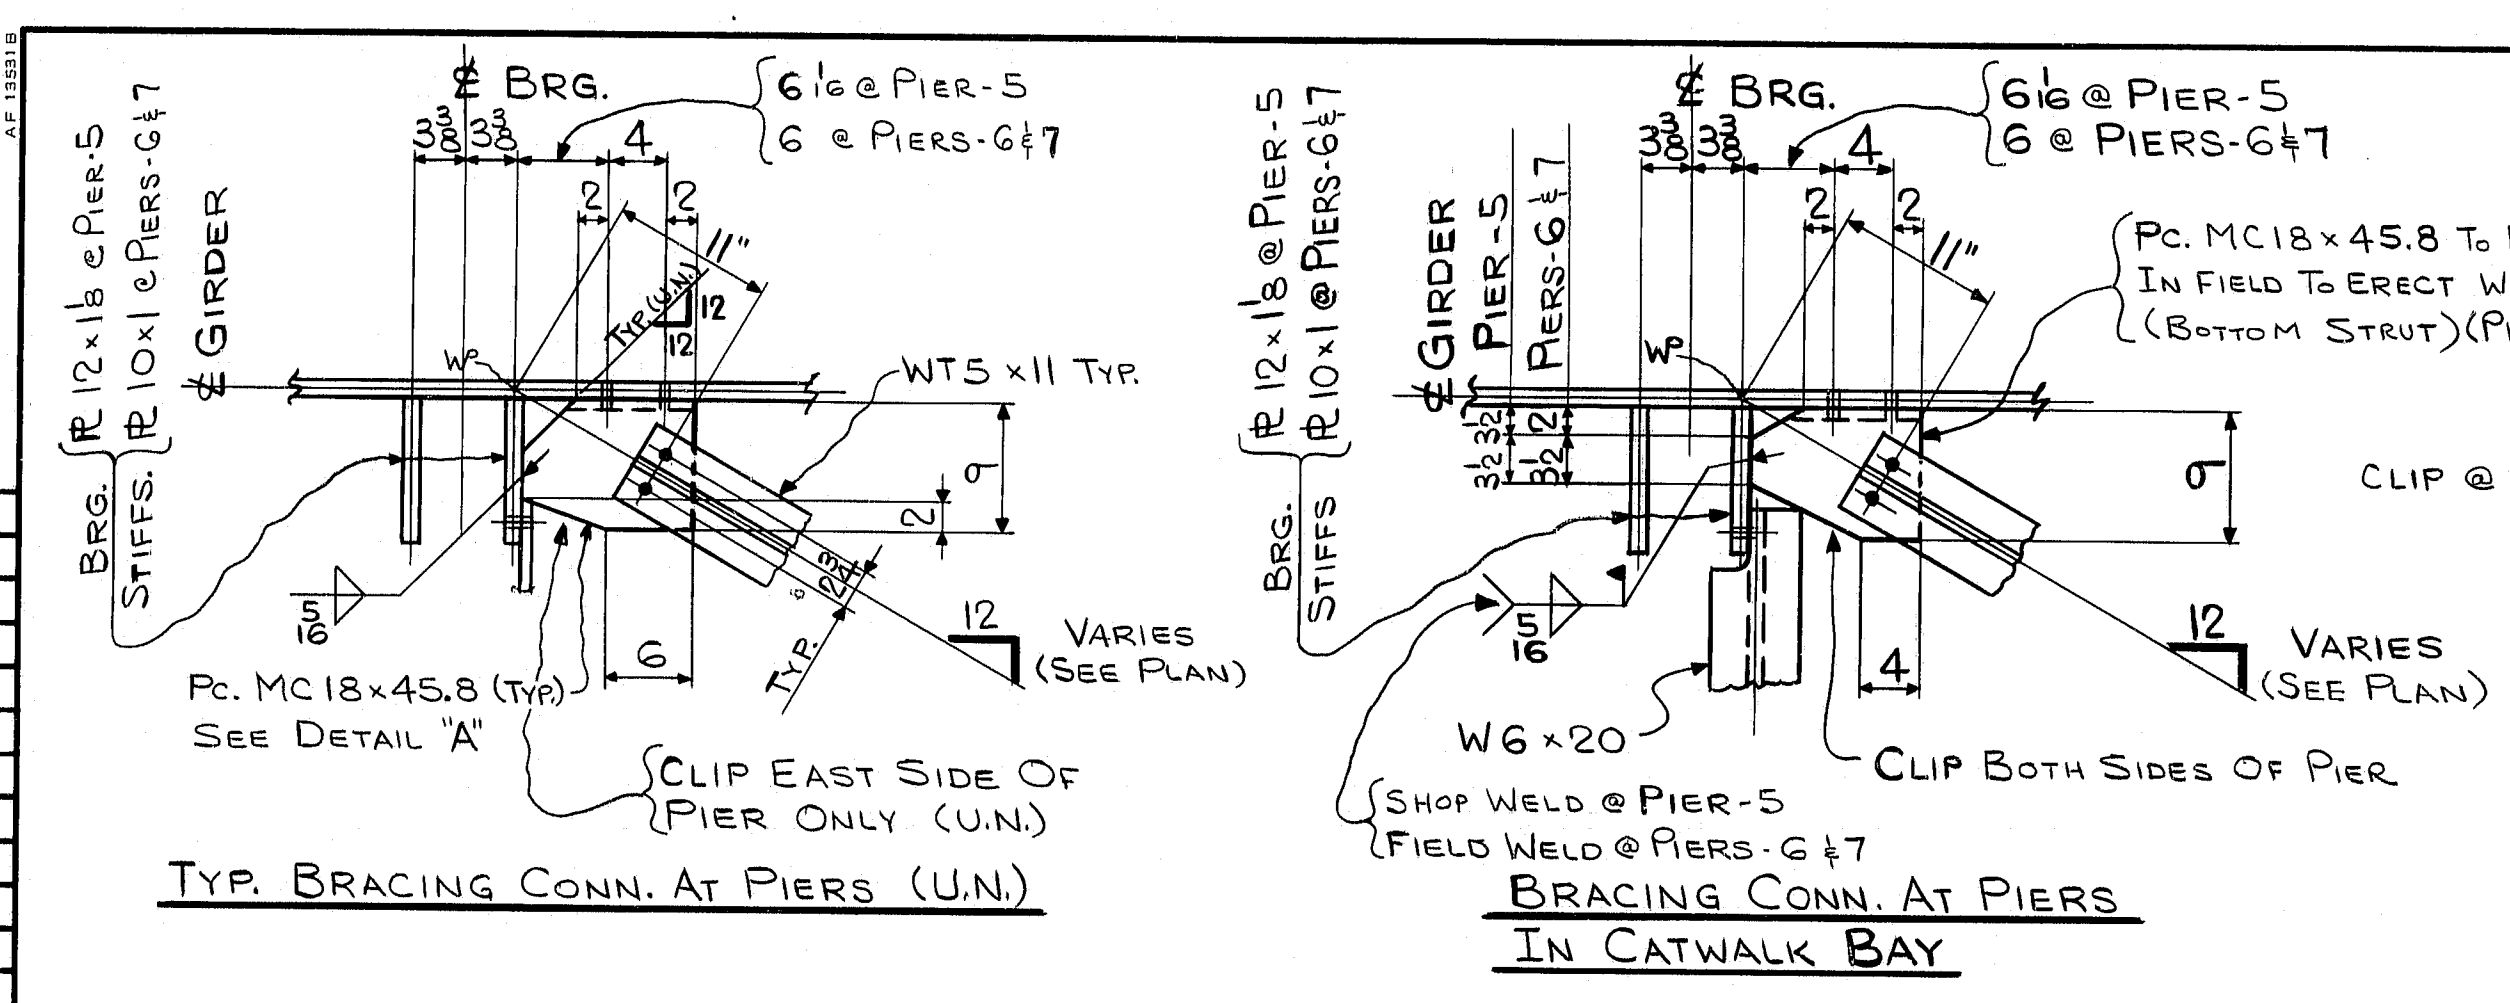


NOTE:  
CROSSFRAMES BETWEEN GIRDERS G7Q & G8Q IN  
SPAN-8 ARE SKEWED (SEE PLAN)

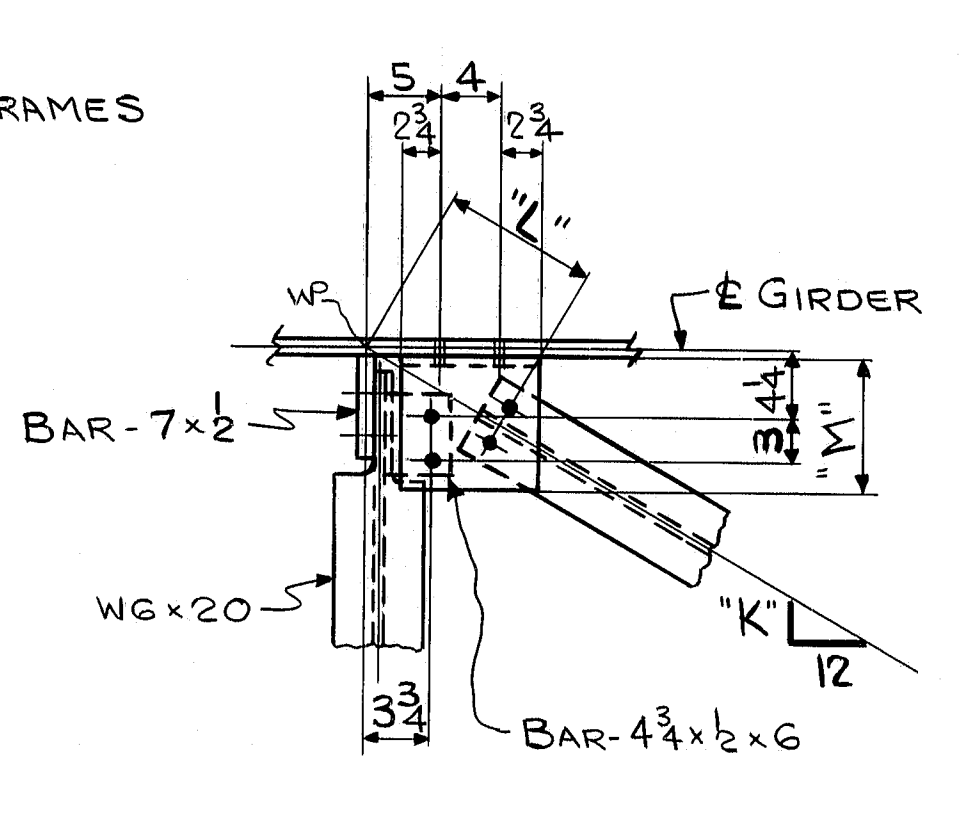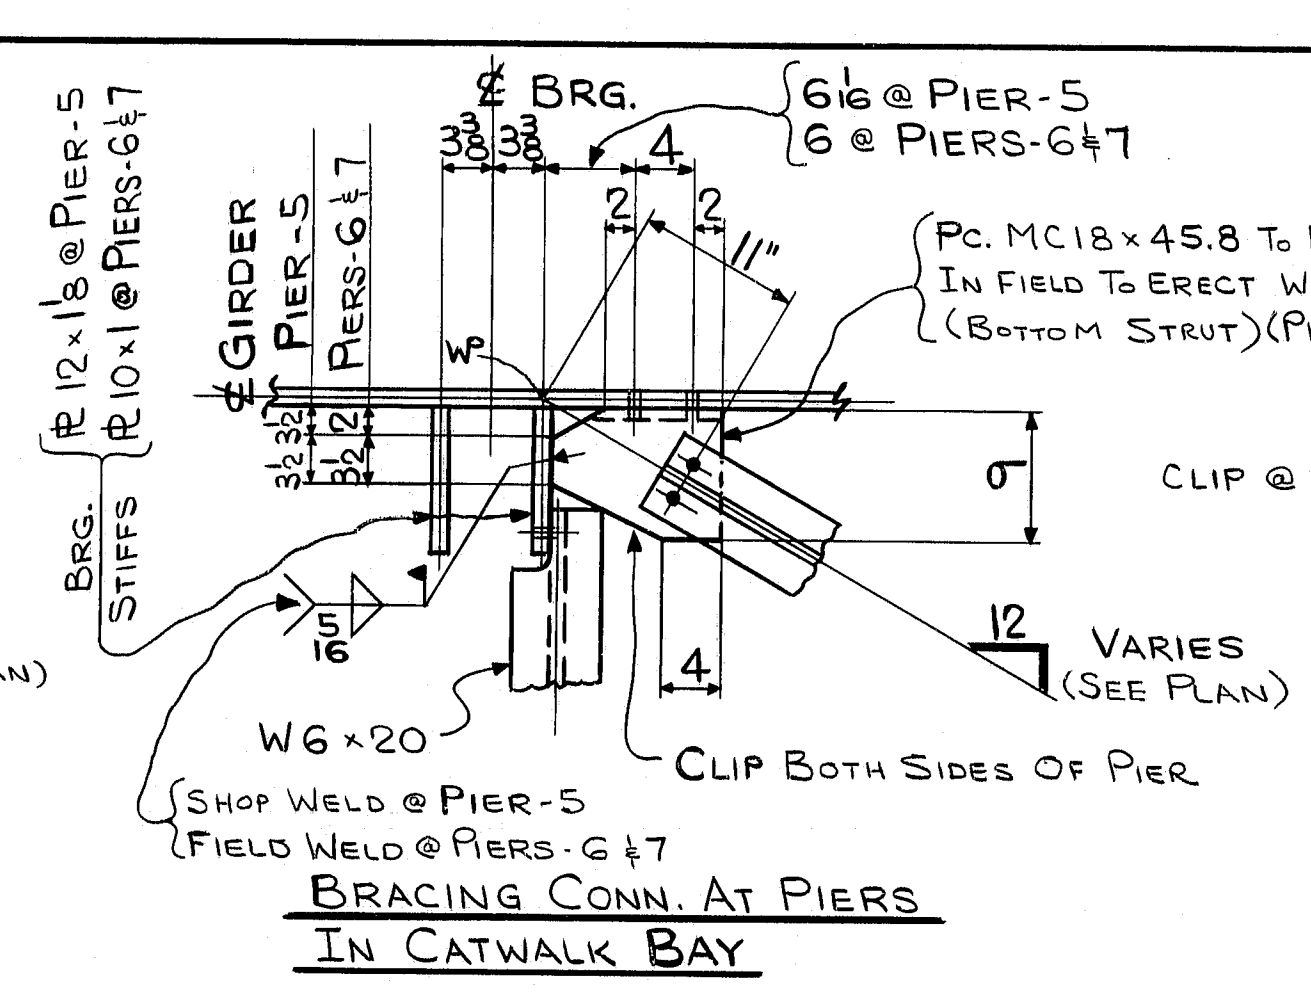

POINT	"K"	"L"	"M"
375, 376, 439, & 440	6 3/4	10 1/4	9
503 & 504	9	11 1/2	9 1/2
551 & 552	7	10 1/2	9


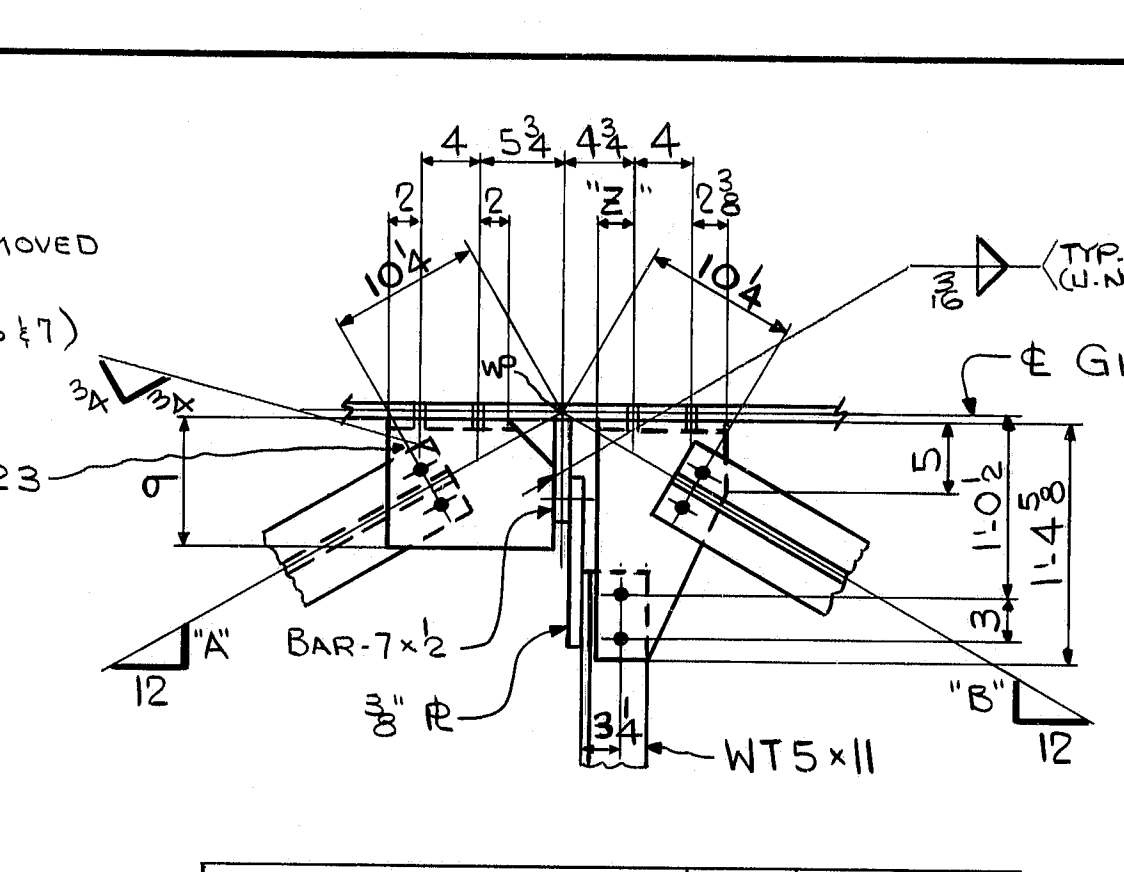


POINT	"A"	"B"	"Z"
396, 397, 402, & 403	8 3/8	6 3/4	2 3/8
452, 453, 458 & 459	6 3/4	7 1/8	2 3/8
516 & 517	6 3/4	7	2 3/8
* 522	7 1/8	7 1/8	2 3/8
* 523	6 1/4	7 1/8	3

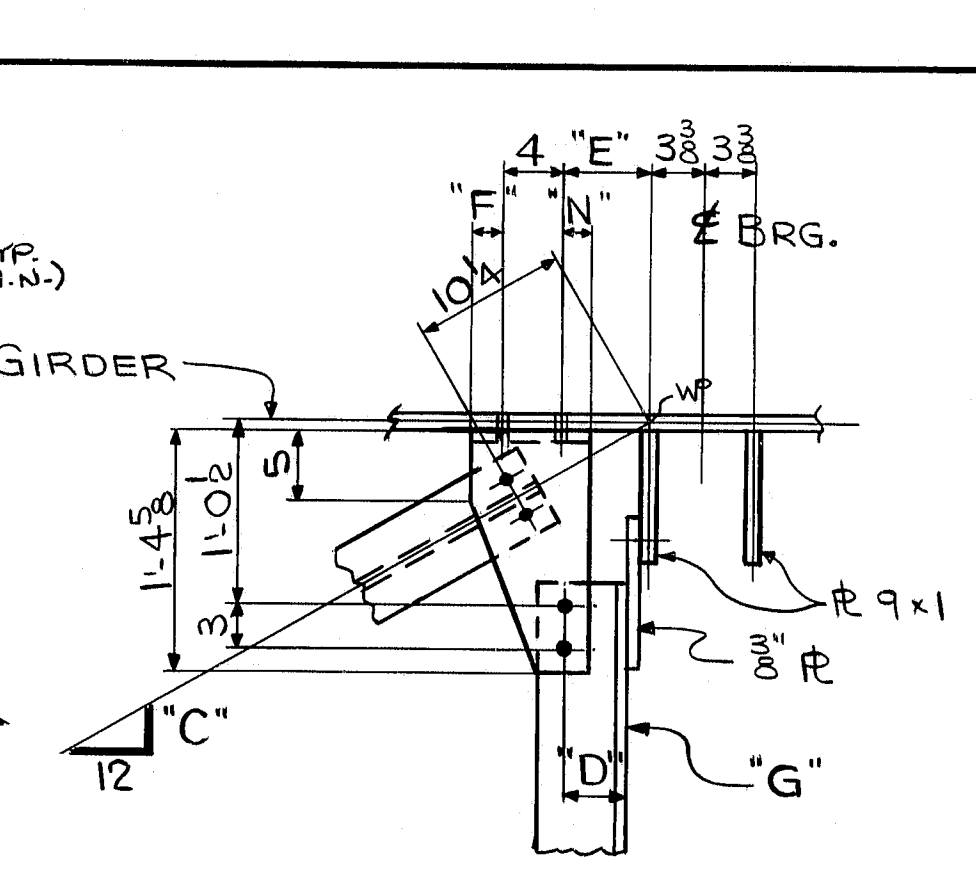

POINT	"C"	"D"	"E"	"F"	"G"	"N"
648, 649, 650, 651, 967, 968, 969, 970	7	3 1/4	4 1/8	2 1/4	WTS x 11	2 1/4
652	7 3/8	5	6 3/8	2	WT 1 x 21.5	2
* 971 & 972 *	7 1/8					2
G54 *	7 1/8					2 3/8
G55 *	7 1/2					2
G53 *	7 3/4	5	6 3/8	2	WT 1 x 21.5	2 1/4

\* INDICATES CROSSFRAME SKEWED (SEE PLAN)

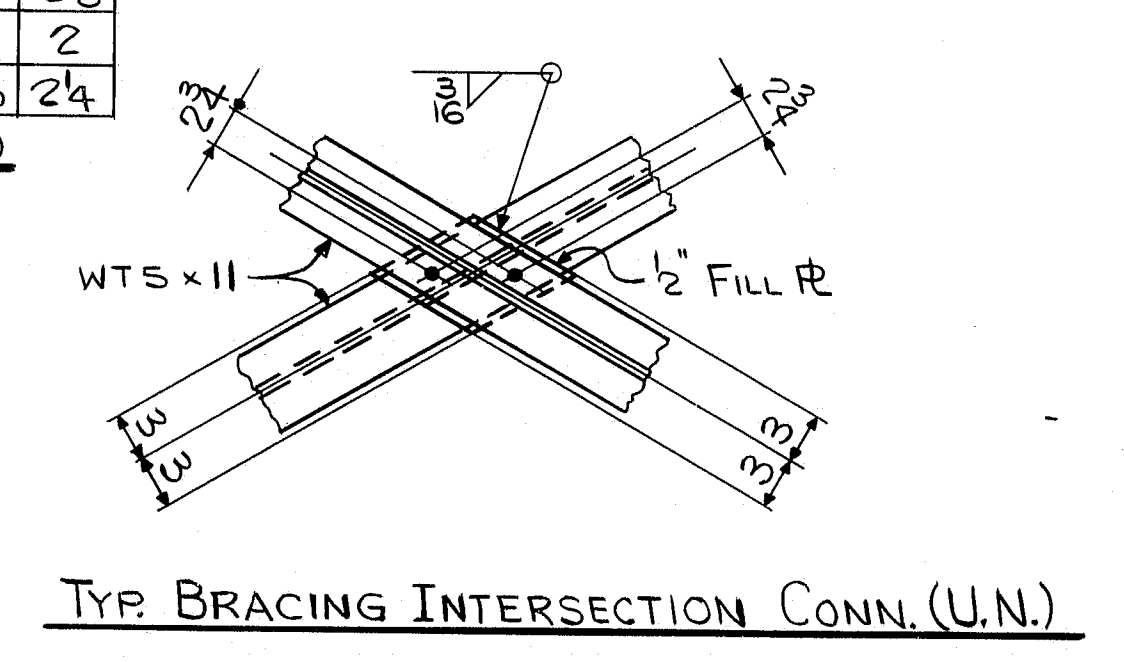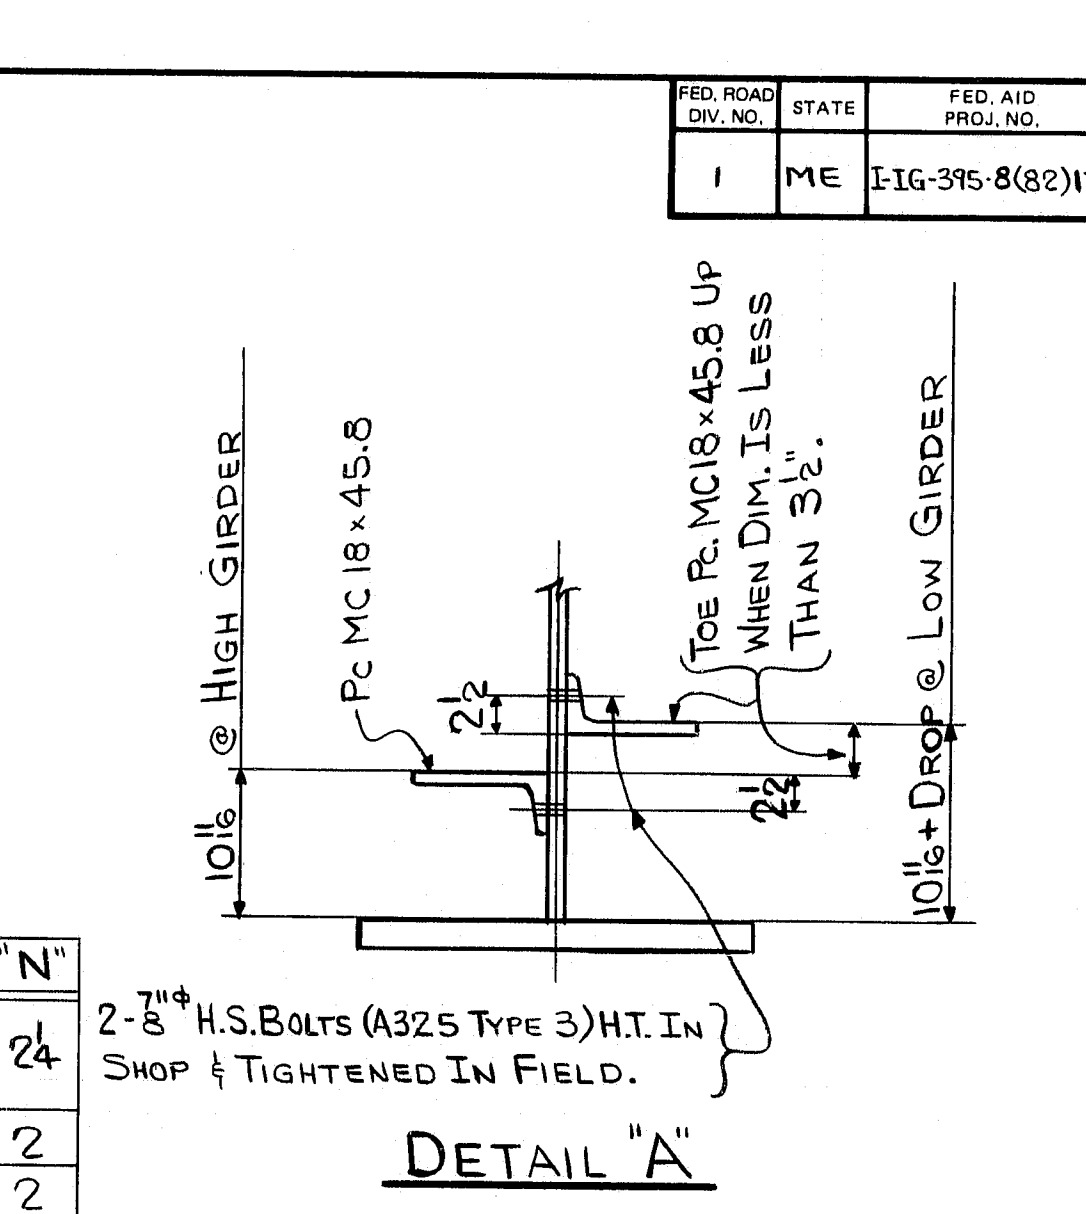

POINT	"H"	"I"	"J"
794	6 1/2	5 1/2	1' 6"
822, 829, 857	7 1/8	6	1' 7"
801	5 1/2	5 1/4	1' 5"
850	3 1/2	4 3/4	1' 4"
874	6 5/8	5 3/4	1' 6"

NO. 1	REVISION	Revised span length Control # 16	DATE 1-12-83
NO. 2	REVISION	construction joint moved	DATE 1-19-84

**HIGH STEEL STRUCTURES, INC.**

1905 Old Philadelphia Pike  
LANCASTER, Pennsylvania 17603  
Phone 717/299-5211

A Subsidiary of High Industries, Inc.

**BRACING LAYOUTS**

I-395 BRIDGE OVER PENOBSCOT RIVER

I-395 BRIDGE STA. 164+60.00

PENOBSCOT COUNTY

STATE OF MAINE

DEPARTMENT OF TRANSPORTATION

STATE CONTRACT OR REF. NO. 6 CONTRACTOR CIANBRO CORP.

IN CHARGE: HINKLE MADE BY: JLC CHK'D: BJK DATE: 7-26-84


CONTRACT ME-84088-3 DRAWING NUMBER: WSS

**R95-164**


WORK THIS DWG. WITH DWGS. WSI THRU WS4



FED. ROAD DIST. NO.	STATE	FED. AID PROJ. NO.
1	ME	FIG-395-8(82)176

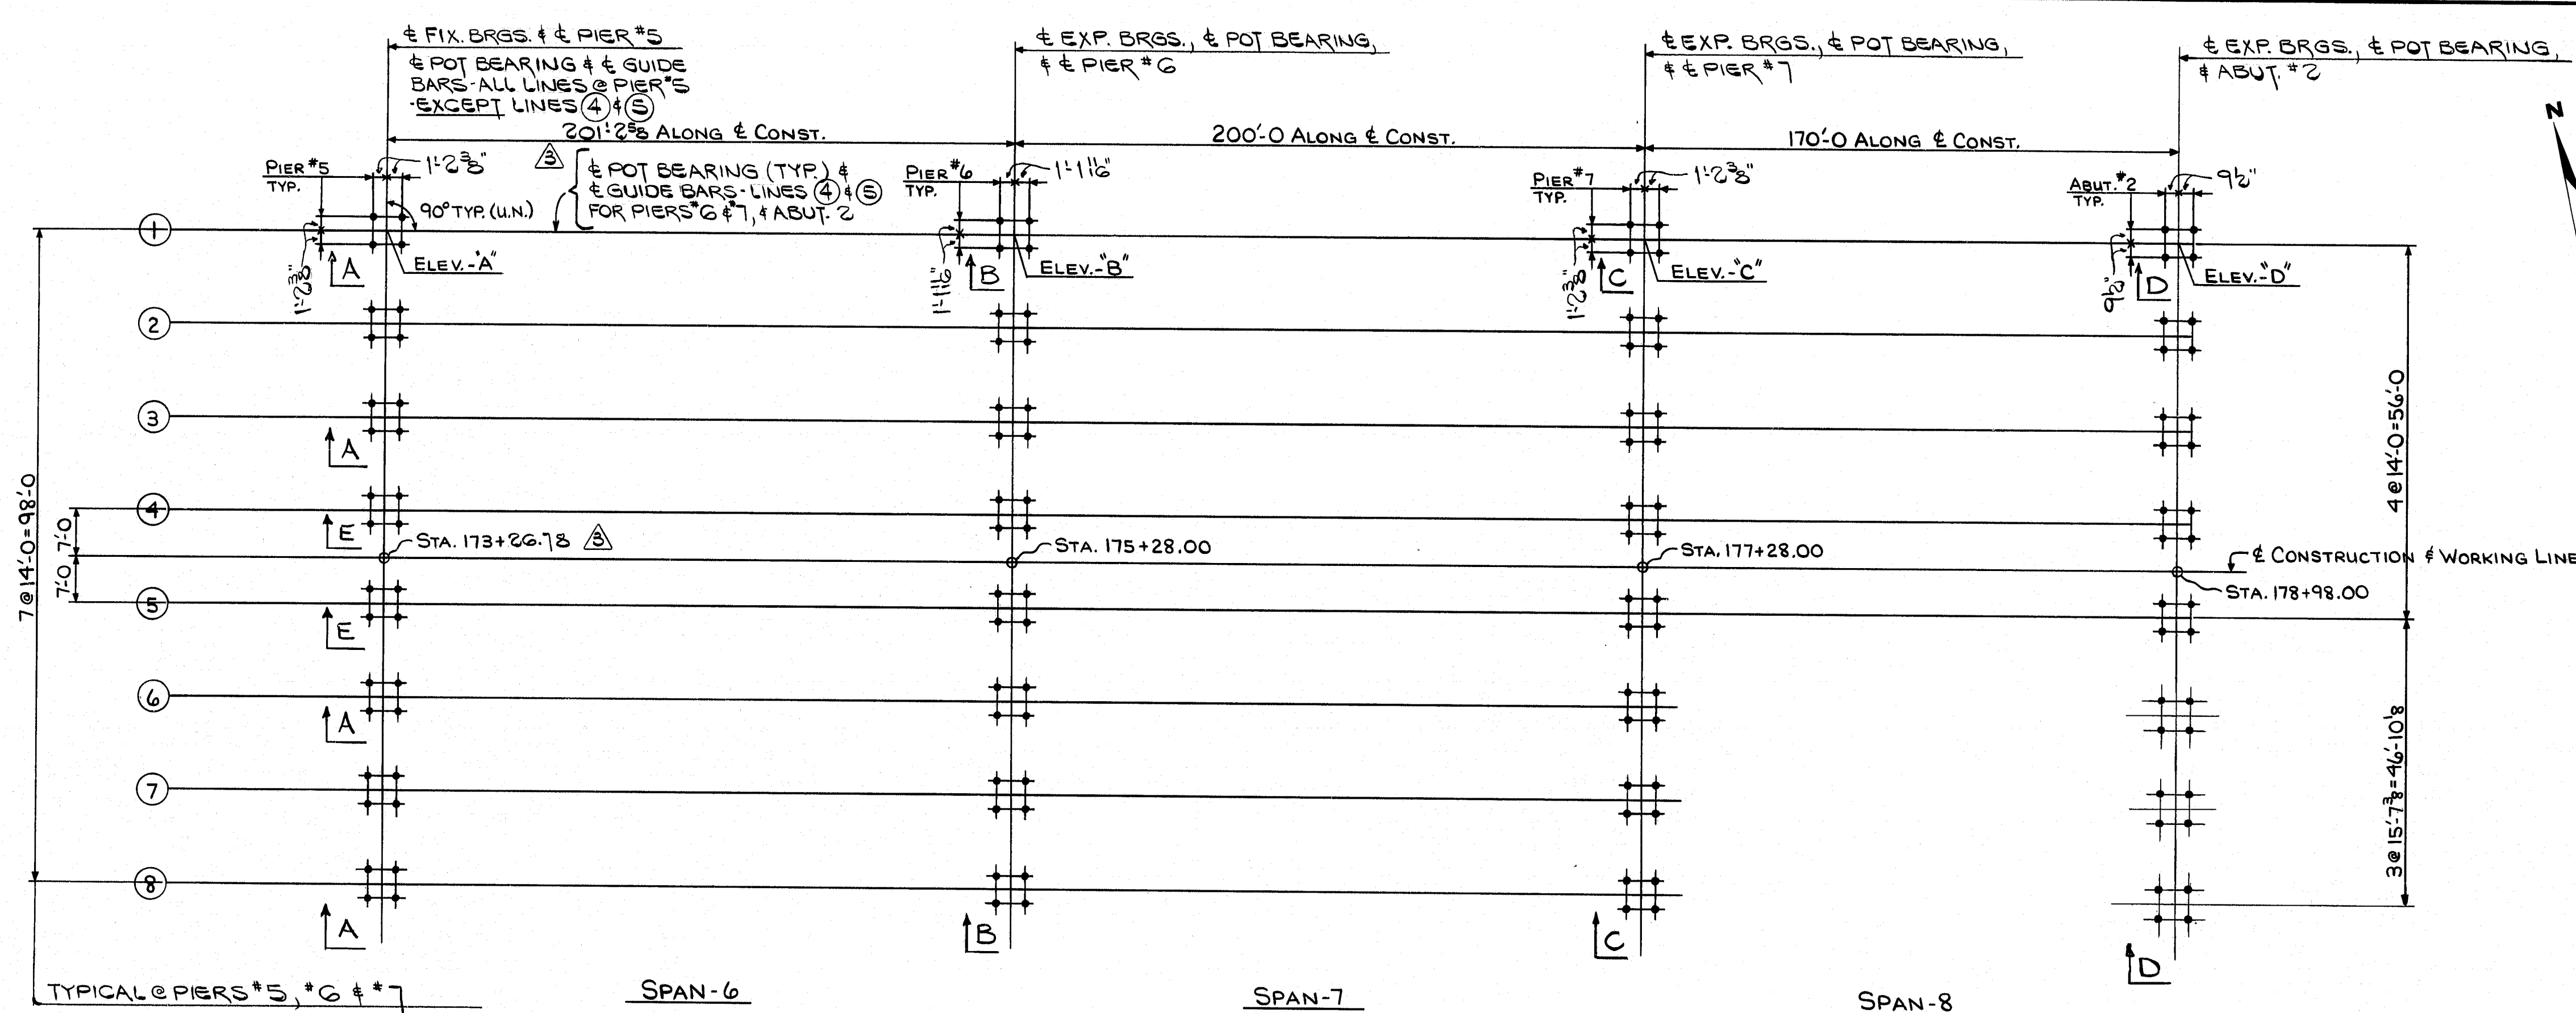

LINE	"A"	"B"	"C"	"D"
1	81.57	77.75	72.10	67.25
2	81.86	78.04	72.39	67.54
3	82.15	78.33	72.68	67.83
4	82.03	78.14	72.48	67.63
5	82.03	78.14	72.48	67.63
6	82.15	78.33	72.68	67.80
7	81.86	78.04	72.39	67.47
8	81.57	77.75	72.10	67.15

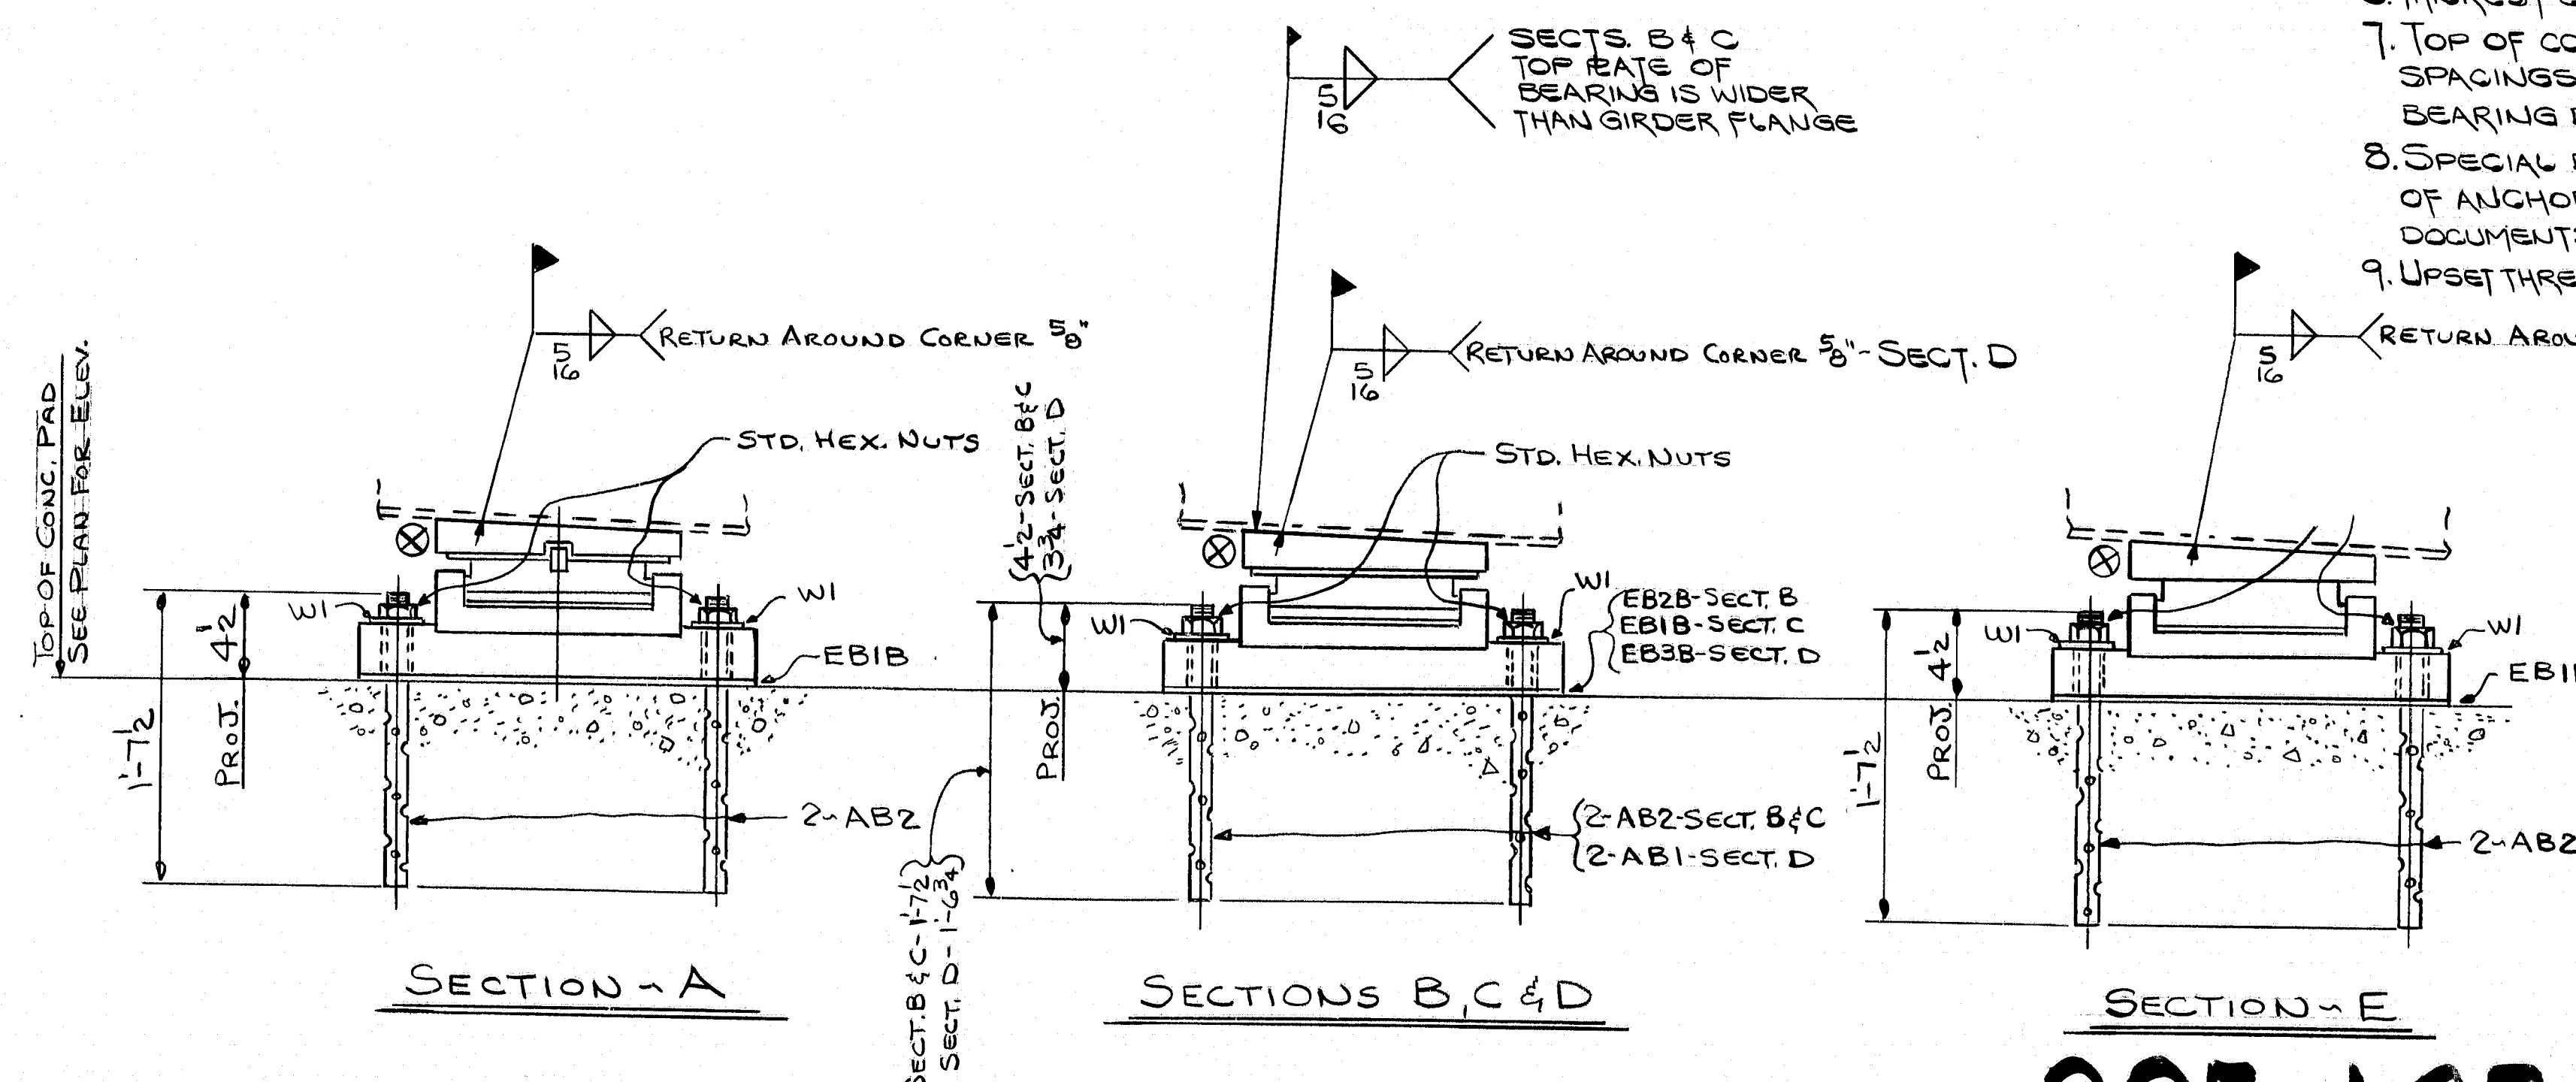

- NOTES:
- All dimensions are given horizontally.
  - Elevations are given to top of concrete pad.
  - Anchor bolt settings must be exact in every detail in accordance with this drawing.
  - Anchor bolts are furnished by High Steel Structures, Inc., and set by others.
  - FOR POT BEARINGS SEE DRAWINGS D-1001-1A THRU D-1001-1F & D-1003-1A.
  - THICKEST EDGE OF SOLE PLATE MARKED THUS ⊗
  - TOP OF CONCRETE ELEVATIONS & ANCHOR BOLT SPACINGS HAVE BEEN MADE TO CONFORM TO BEARING DETAILS ON DWG. D-1001-1A.
  - SPECIAL BRIDGE SEAT PREPARATION & GROUTING OF ANCHOR BOLT HOLES, REQUIRED BY CONTRACT DOCUMENTS, BY OTHERS THAN HIGH STEEL STRUCTURES, INC.
  - UPSET THREADS ABOVE NUT FOR ALL ANCHOR BOLTS. (AB MARKS)

NO.	REVISION	DATE
1	REVISION Revised span length Control # 16	DATE 1-12-85
2	REVISION Revised ELEVATIONS AS PER POT DES. REV.	DATE 9-28-84
3	REVISION General revision to agree with pot bearings	DATE 8-15-84

**HIGH STEEL STRUCTURES, INC.**  
1905 Old Philadelphia Pike  
Lancaster, Pennsylvania 17603  
Phone 717/298-5211  
A Subsidiary of High Industries, Inc.


**ANCHOR BOLT PLAN**  
I-395 BRIDGE OVER PENOBSCOT RIVER  
I-395 BRIDGE STA. 164+60.00  
PENOBSCOT COUNTY  
STATE OF MAINE  
DEPARTMENT OF TRANSPORTATION

STATE CONTRACT OR REF. NO. 6 CONTRACTOR CIANBRO CORP.  
IN CHARGE HINKLE MADE BY FDS CHK. D. CS DATE 6-26-84  
CONTRACT NUMBER ME-84088-3 DRAWING NUMBER EIC

R95-165





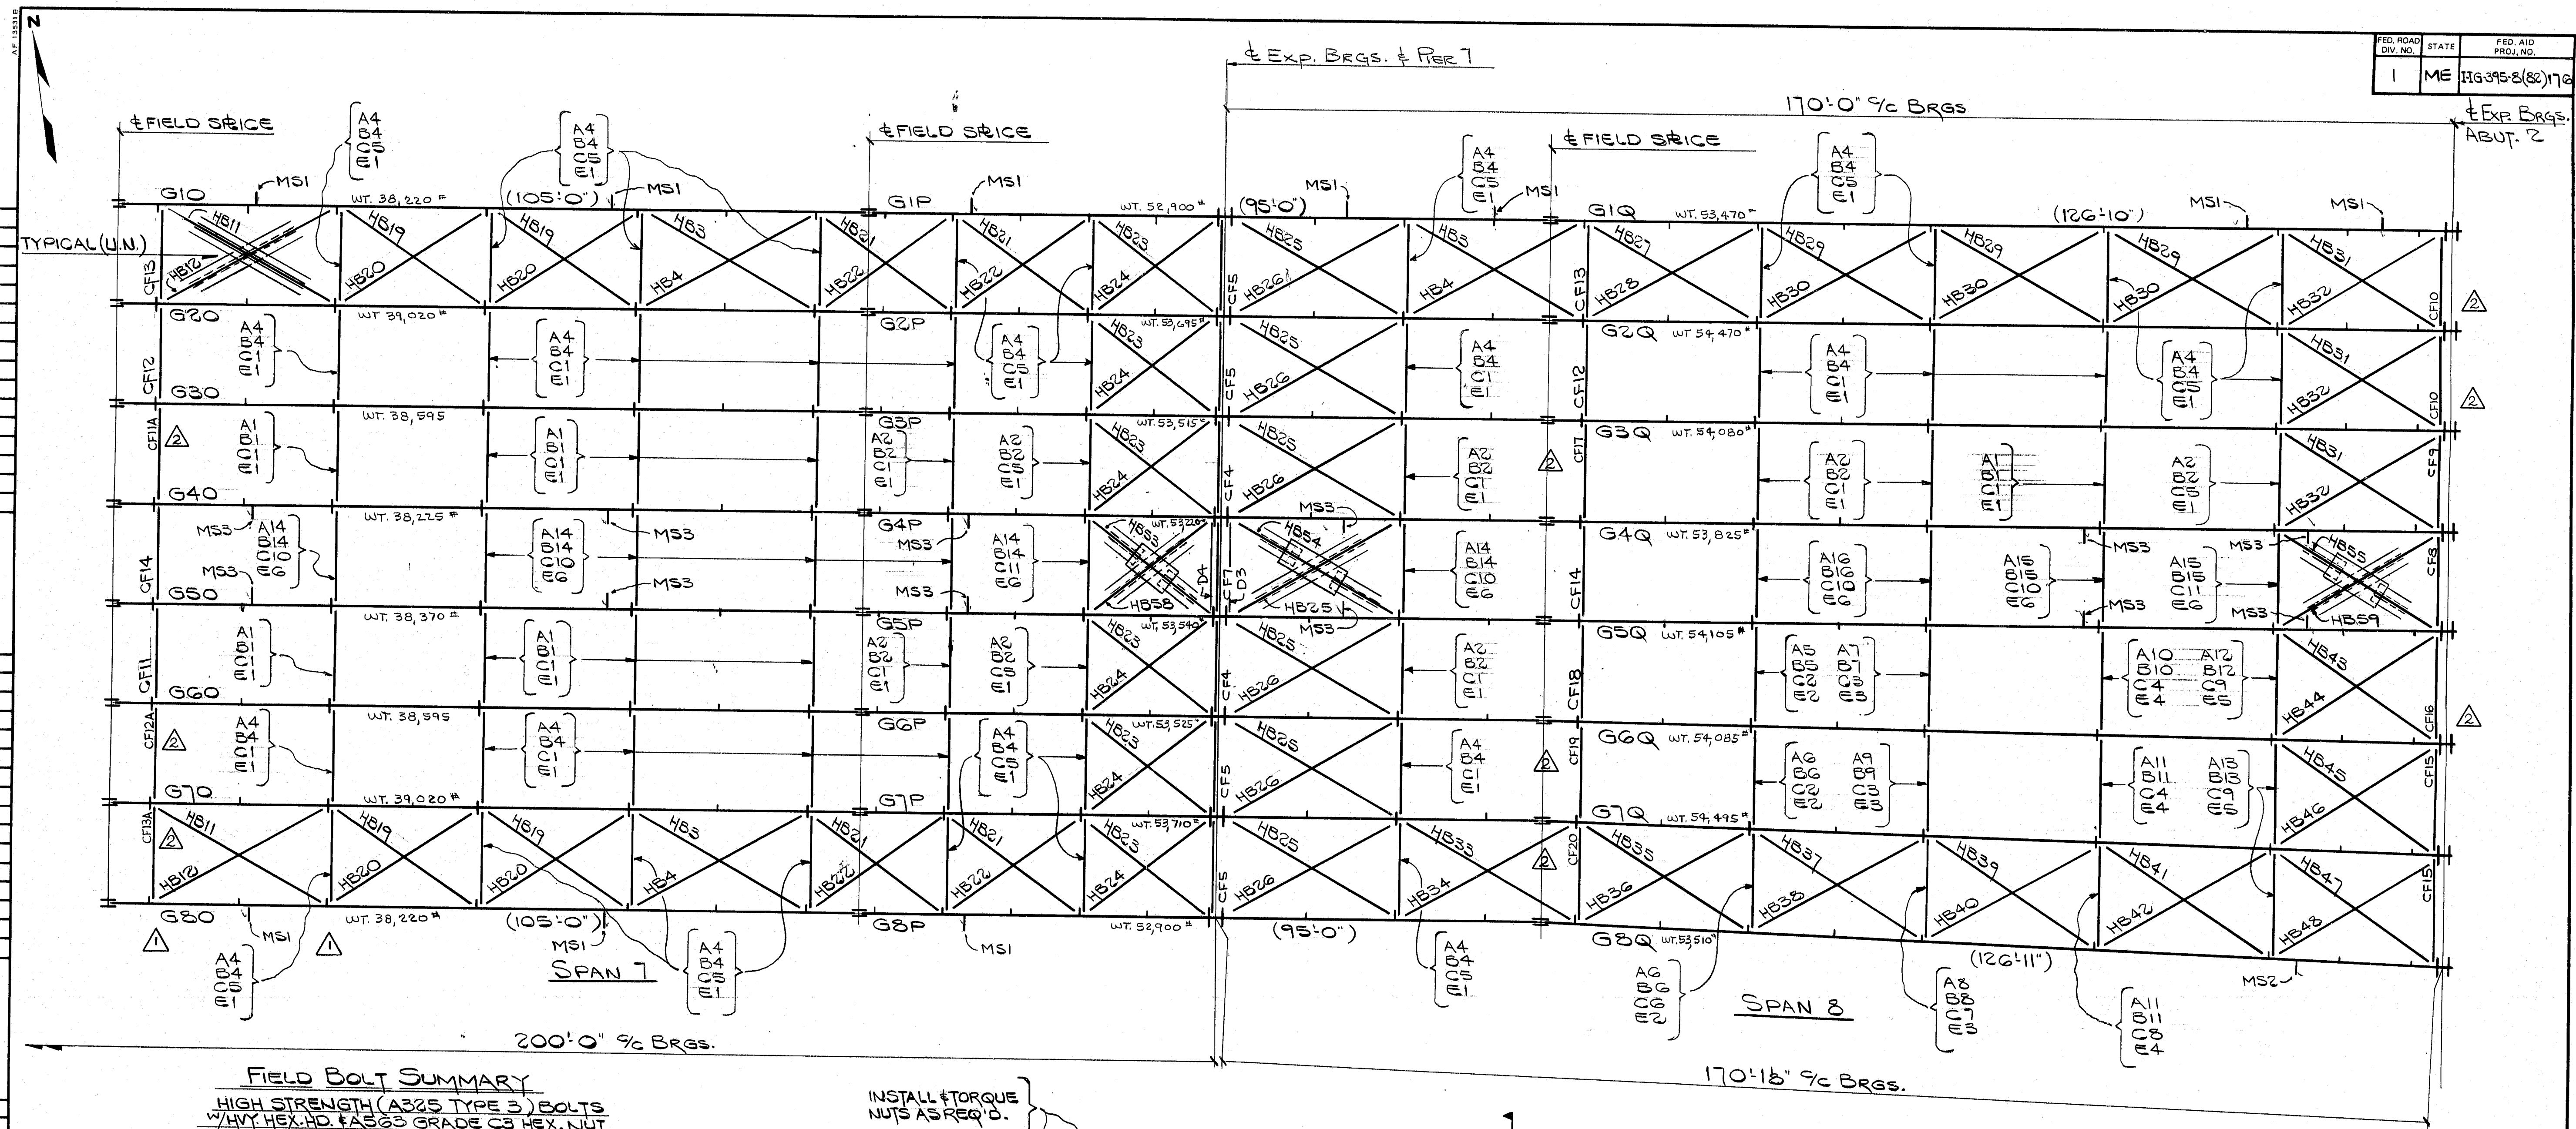


# **FIELD BOLT SUMMARY** HIGH STRENGTH (A325 TYPE 3) BOLTS W/HTY HEX HD. F436 GRADE C3 HEX NUT

640-3/4" H.S. BOLTS	x 0'12" LG.
5750-	x 0'24" LG.
570-	x 0'28" LG.
520-	x 0'28" LG.
5635-	x 0'3" LG.
135-	x 0'30" LG.
400-	x 0'33" LG.
640-	x 0'4" LG.
470-	x 0'44" LG.
235-	x 0'48" LG.
400-3/4" H.S. BOLTS	x 0'44" LG.

15,395-HARD FLAT WASH FOR 3/4" H.S. BOLTS (F436 WEATHERING)


165-HEX NUTS FOR 1" H.S. BOLTS (A563 GR C3) FOR HANDRAIL  
165-HARD FLAT WASH FOR 1" H.S. BOLTS (WEATHERING) AT FIELD SPICES

INSTALL & TORQUE  
NUTS AS REQ'D.

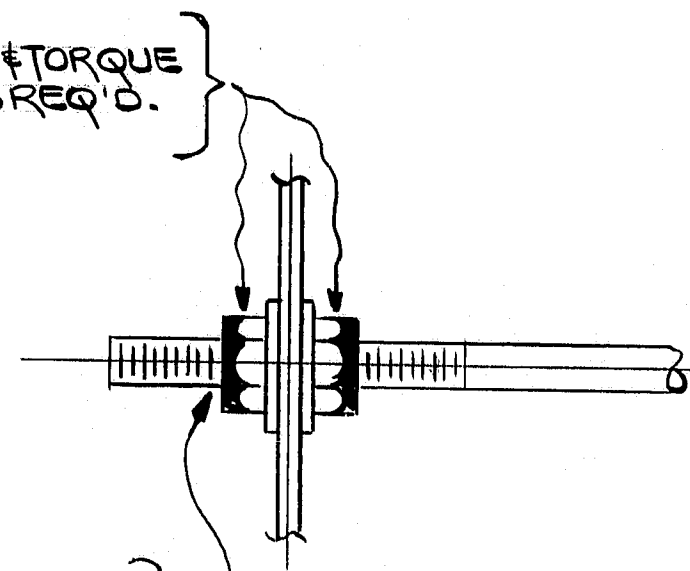

BURR THREADS AT  
EXTERNAL NUT.

## **HANDRAIL TERMINATION**

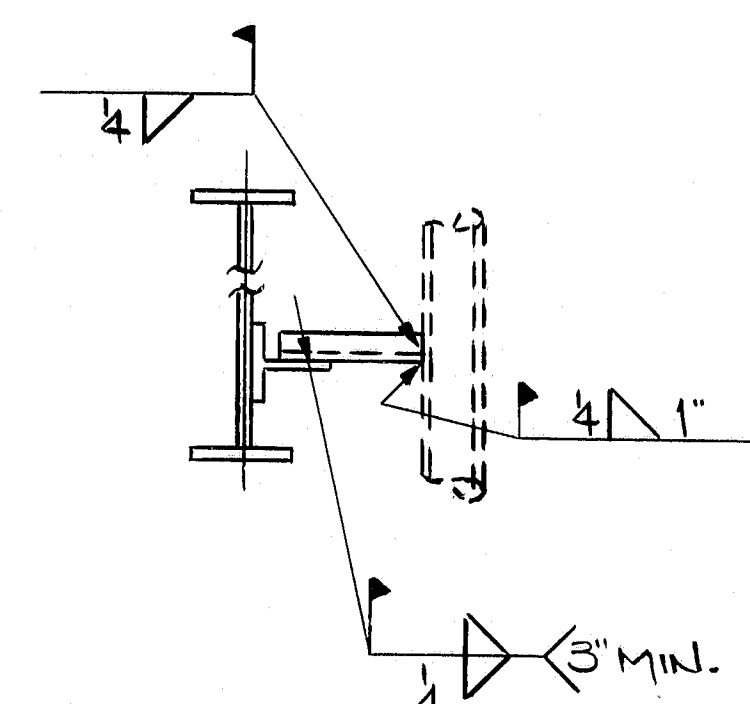

FIELD WELD FOR  
SCUPPER ANGLES

WORK THIS DWG. WITH DWGS. E2 & E4.



NO. 1	REVISION	CHANGED MARK LOCATION	DATE 6-12-85
NO. 2	REVISION	MOVED CENTER JOINT CONTROL #15	DATE 11-19-84

<b>HIGH STEEL STRUCTURES, INC.</b>		1905 Old Philadelphia Pike Lansdale, Pennsylvania 17033 Phone 717/296-5511	
A Subsidiary of High Industries, Inc.			
<b>ERECTION PLAN</b>			
<b>I-395 BRIDGE OVER PENOBSCOT RIVER</b>			
<b>I-395 BRIDGE STA. 164+60.00</b>			
<b>PENOBSCOT COUNTY</b>			
<b>STATE OF MAINE</b>			
<b>DEPARTMENT OF TRANSPORTATION</b>			
STATE CONTRACT OR REF. NO.	G	CONTRACTOR	CIANERO CORP.
IN CHARGE	HINKLE	MADE BY	CS
CHK'D BY	JLC	DATE	9-26-84
CONTRACT NUMBER	ME-84088-3	DRAWING NUMBER	E3

**R95-167**

FED. ROAD DIV. NO.	STATE	FED. AID PROJ. NO.
1	ME	I-IG-395-8(82)


0"~G1 To G5  
1'-7<sup>3</sup>8"~G6  
3'-2<sup>3</sup>4"~G7  
4'-10<sup>8</sup>"~G8

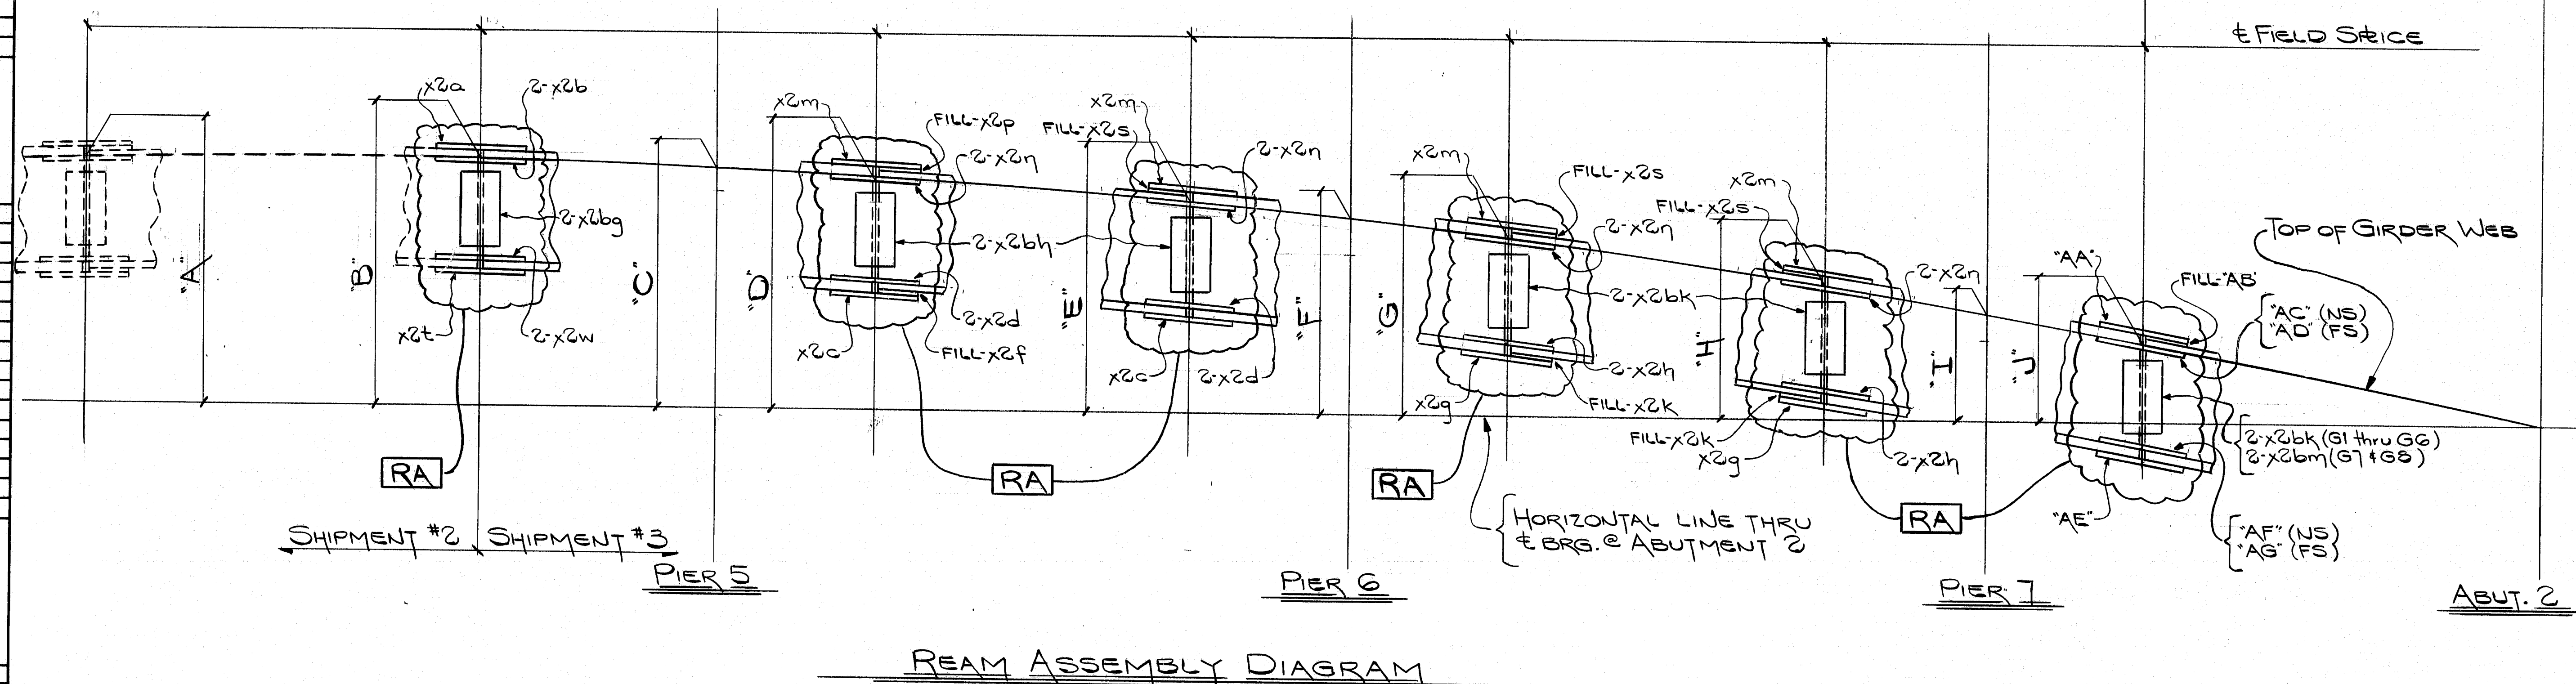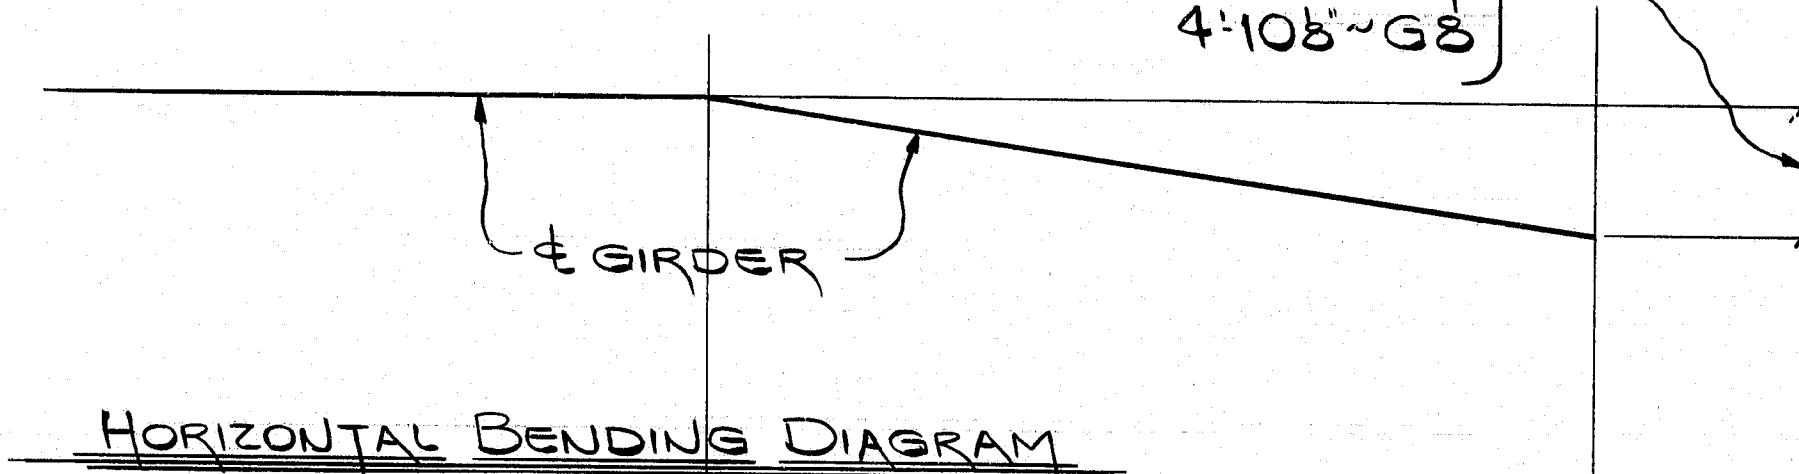








GIRDER	"A"	"B"	"C"	"D"	"E"	"F"	"G"	"H"	"I"	"J"
G1	16'0 $\frac{5}{8}$	15'9 $\frac{5}{8}$	14'7 $\frac{1}{2}$	13'10 $\frac{1}{2}$	11'10 $\frac{1}{2}$	10'9 $\frac{1}{2}$	9'9 $\frac{1}{2}$	6'10 $\frac{1}{2}$	5'2 $\frac{1}{2}$	3'10 $\frac{1}{2}$
G2	16'1 $\frac{3}{8}$	15'9 $\frac{5}{8}$	14'7 $\frac{1}{2}$	13'10 $\frac{1}{2}$	11'10 $\frac{1}{2}$	10'9 $\frac{1}{2}$	9'9 $\frac{1}{2}$	6'10 $\frac{1}{2}$	5'2 $\frac{1}{2}$	3'10 $\frac{1}{2}$
G3	16'2 $\frac{1}{2}$	15'9 $\frac{5}{8}$	14'7 $\frac{1}{2}$	13'10 $\frac{1}{2}$	11'10 $\frac{1}{2}$	10'9 $\frac{1}{2}$	9'9 $\frac{1}{2}$	6'10 $\frac{1}{2}$	5'2 $\frac{1}{2}$	3'11"
G4	16'8 $\frac{1}{2}$	15'9 $\frac{5}{8}$	14'7 $\frac{1}{2}$	13'11 $\frac{1}{2}$	11'10 $\frac{1}{2}$	10'9 $\frac{1}{2}$	9'9 $\frac{1}{2}$	6'10 $\frac{1}{2}$	5'2 $\frac{1}{2}$	3'11"
G5	16'8 $\frac{1}{2}$	15'9 $\frac{5}{8}$	14'7 $\frac{1}{2}$	13'11 $\frac{1}{2}$	11'10 $\frac{1}{2}$	10'9 $\frac{1}{2}$	9'9 $\frac{1}{2}$	6'9 $\frac{1}{2}$	5'2 $\frac{1}{2}$	3'11 $\frac{1}{2}$
G6	16'9 $\frac{1}{2}$	15'9 $\frac{1}{2}$	14'7 $\frac{1}{2}$	13'11 $\frac{1}{2}$	11'11"	10'9 $\frac{1}{2}$	9'9 $\frac{1}{2}$	6'10 $\frac{1}{2}$	5'2 $\frac{1}{2}$	3'11 $\frac{1}{2}$
G7	17'3 $\frac{1}{2}$	15'10 $\frac{1}{2}$	14'8 $\frac{1}{2}$	13'11 $\frac{1}{2}$	11'11 $\frac{1}{2}$	10'10"	9'10"	6'10 $\frac{1}{2}$	5'3"	4'0 $\frac{1}{2}$
G8	17'8 $\frac{1}{2}$	15'11 $\frac{1}{2}$	14'8 $\frac{1}{2}$	14'0 $\frac{1}{2}$	11'11 $\frac{1}{2}$	10'10 $\frac{1}{2}$	9'10 $\frac{1}{2}$	6'11 $\frac{1}{2}$	5'3 $\frac{1}{2}$	4'0 $\frac{1}{2}$

FIELD SPRUCE MARKS							
GIRDER	'AA'	'AB'	'AC'	'AD'	'AE'	'AF'	'AG'
G1	x2g	x2k	x2h	x2h	x2c	x2d	x2c
G2	↑		↑	↑		↑	↑
G3							
G4	↓	↓	↓	↓		↓	↓
G5	x2g	x2k	x2h	x2h	x2c	x2d	x2c
G6	x2y	x2ac	x2ab	x2aa	x2as	x2aw	x2a
G7	x2ad	x2ah	x2ag	x2af	x2ay	x2bb	x2b
G8	x2ak	x2ap	x2an	x2am	x2ba	x2bf	x2b

WORK THIS DWG. WITH DWGS. E2 & E3

NO.	REVISEN	DATE
		1905 Old Philadelphia Pike Lancaster, Pennsylvania 17603 Phone 717/298-6211
HIGH STEEL STRUCTURES, INC.		A Subsidiary of High Industries, Inc.
REAM ASSEMBLY DIAGRAM I-395 BRIDGE OVER PENOBSCOT RIVER I-395 BRIDGE STA. 164+60.00 PENOBSCOT COUNTY STATE OF MAINE DEPARTMENT OF TRANSPORTATION		
STATE CONTRACT OR REF. NO.		CONTRACTOR
G		CIAM BRO CORP
IN CHARGE:	HINKLE	MADE BY: CS
CHK'D BY:	JLC	DATE: 9-25-84
CONTRACT NUMBER:	Me-84088-3 DRAWING	F 4



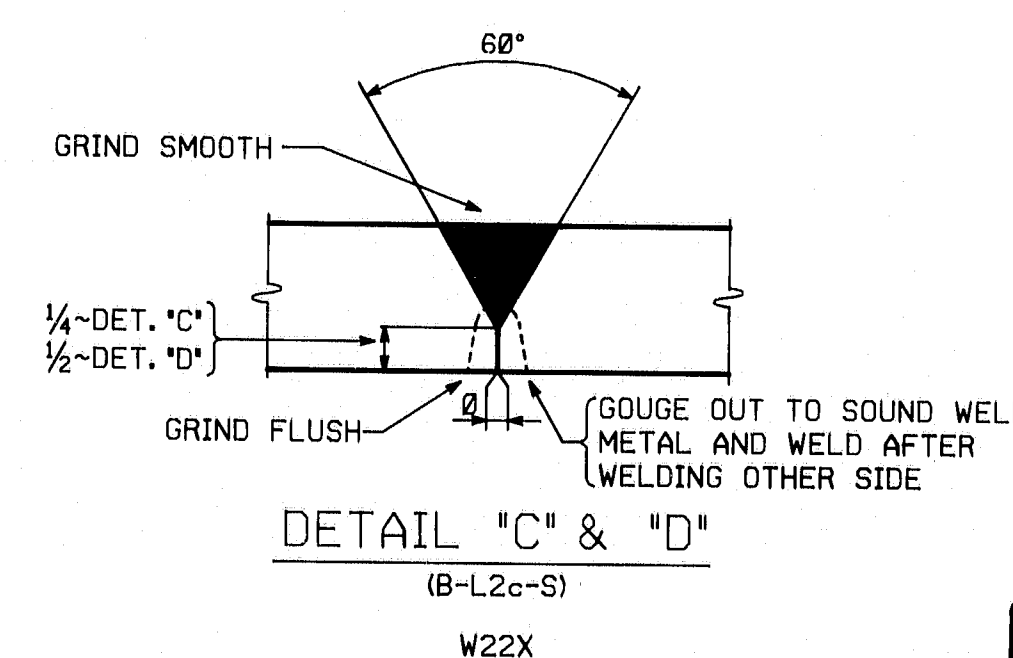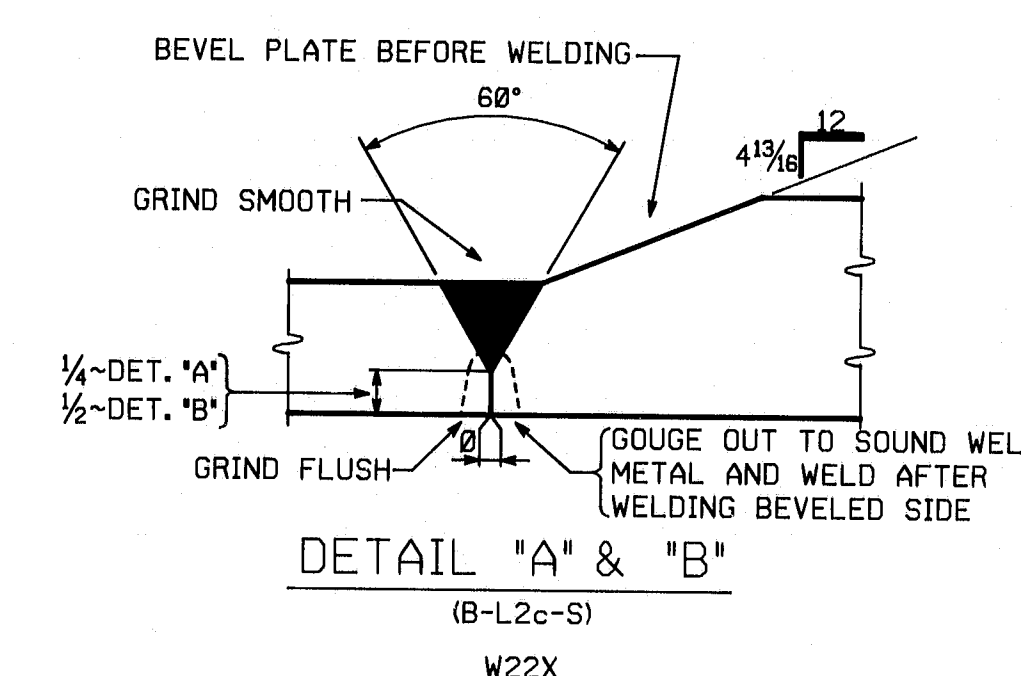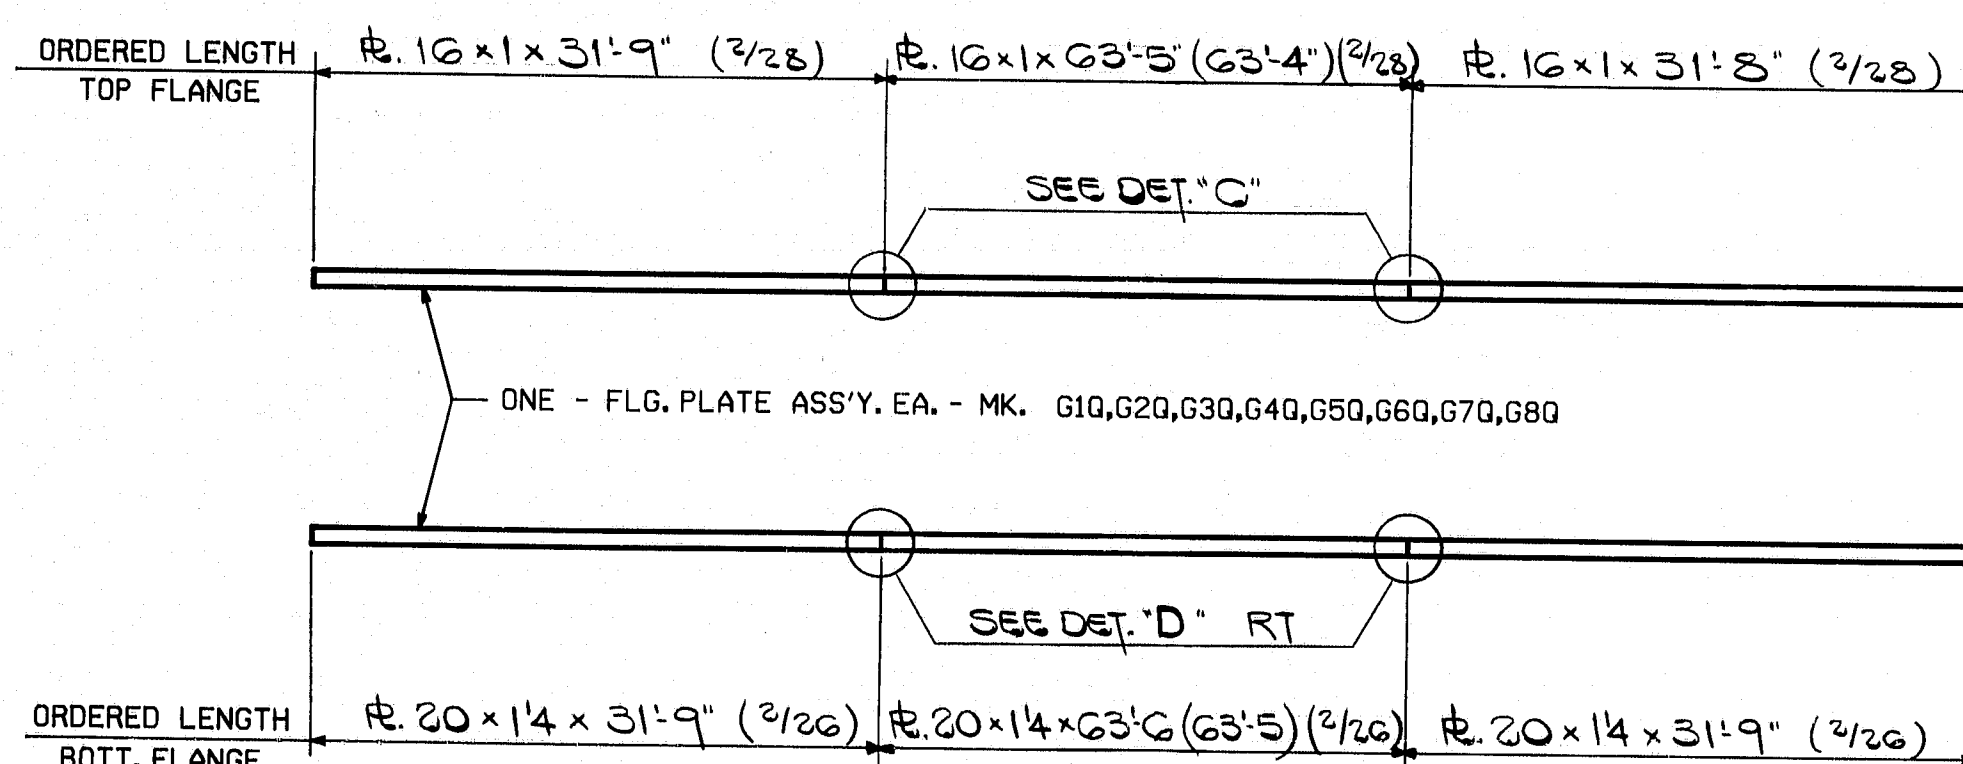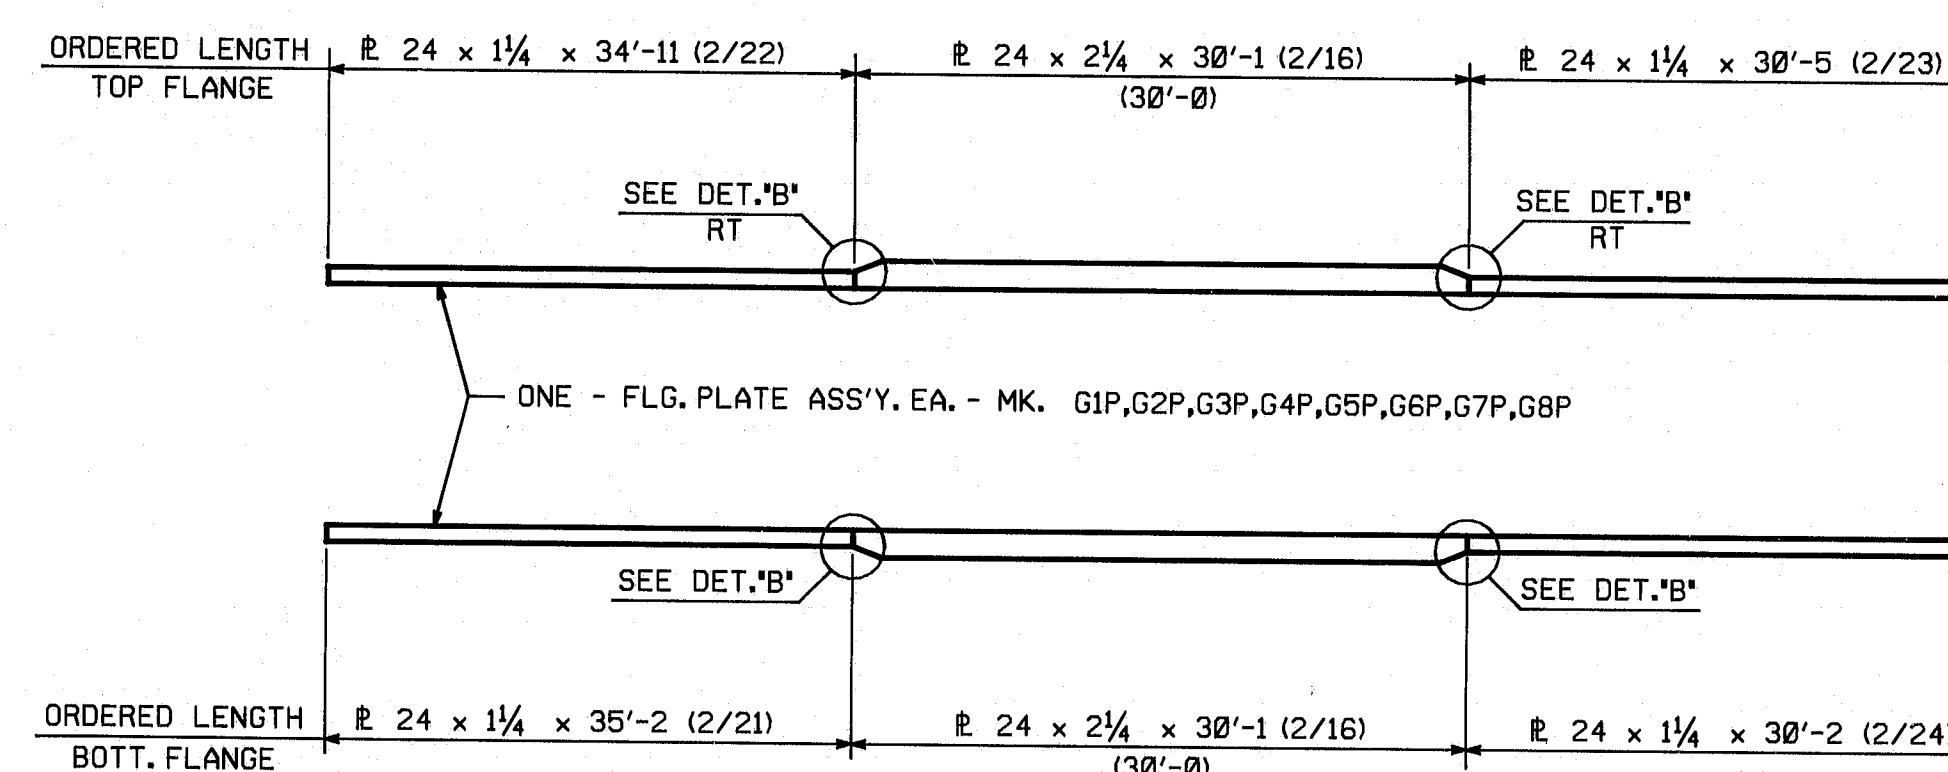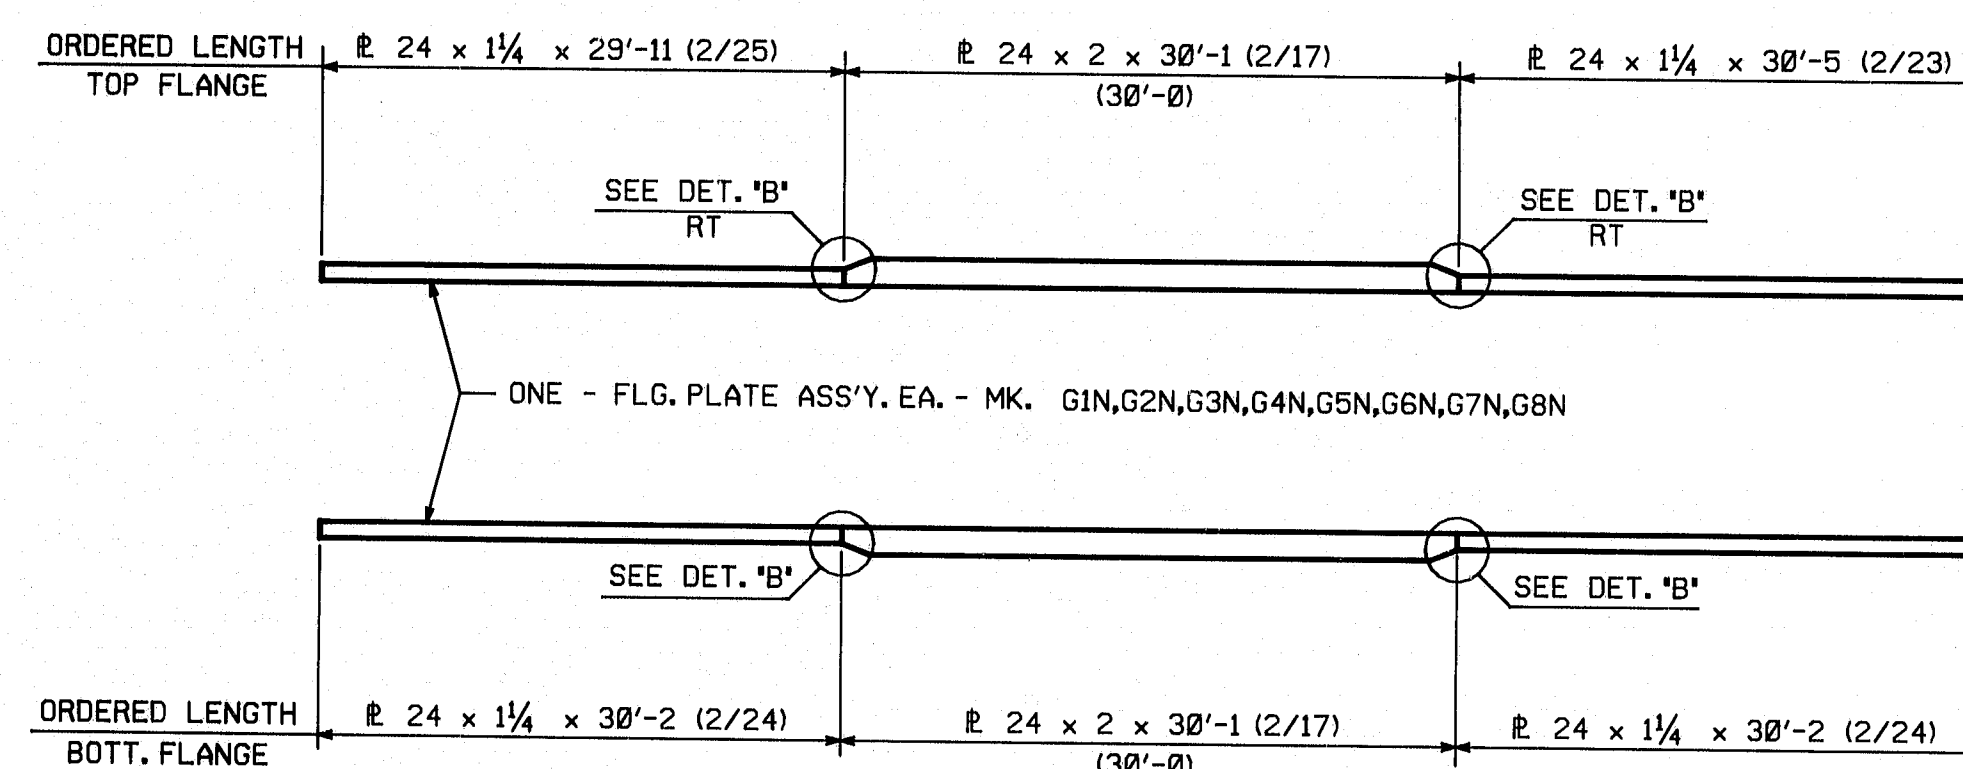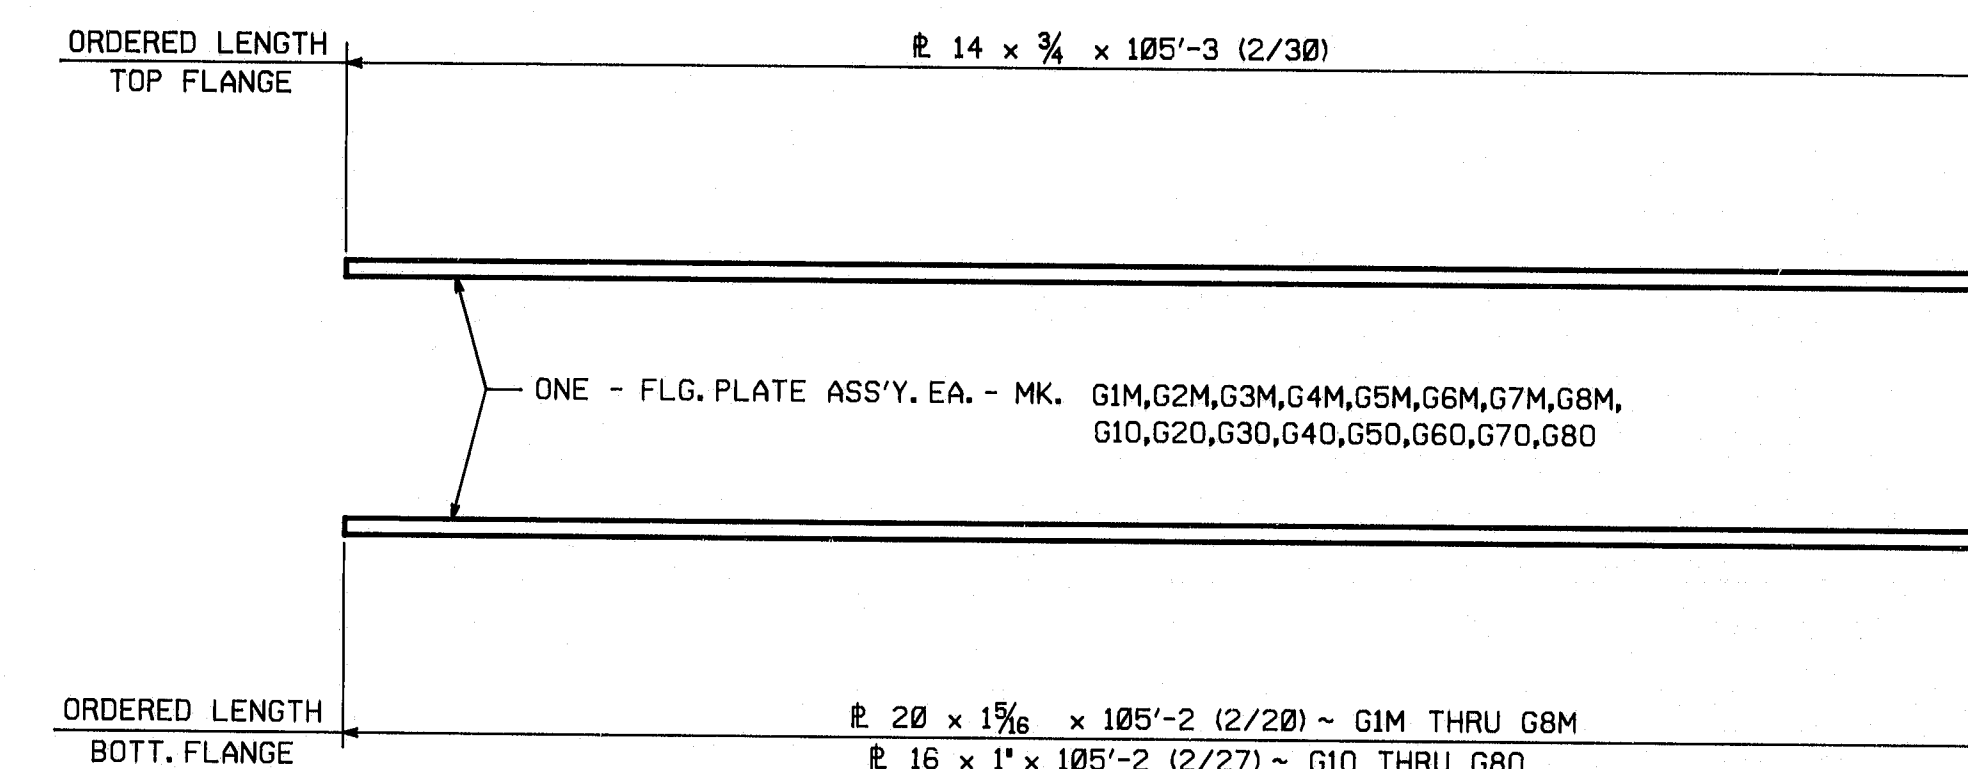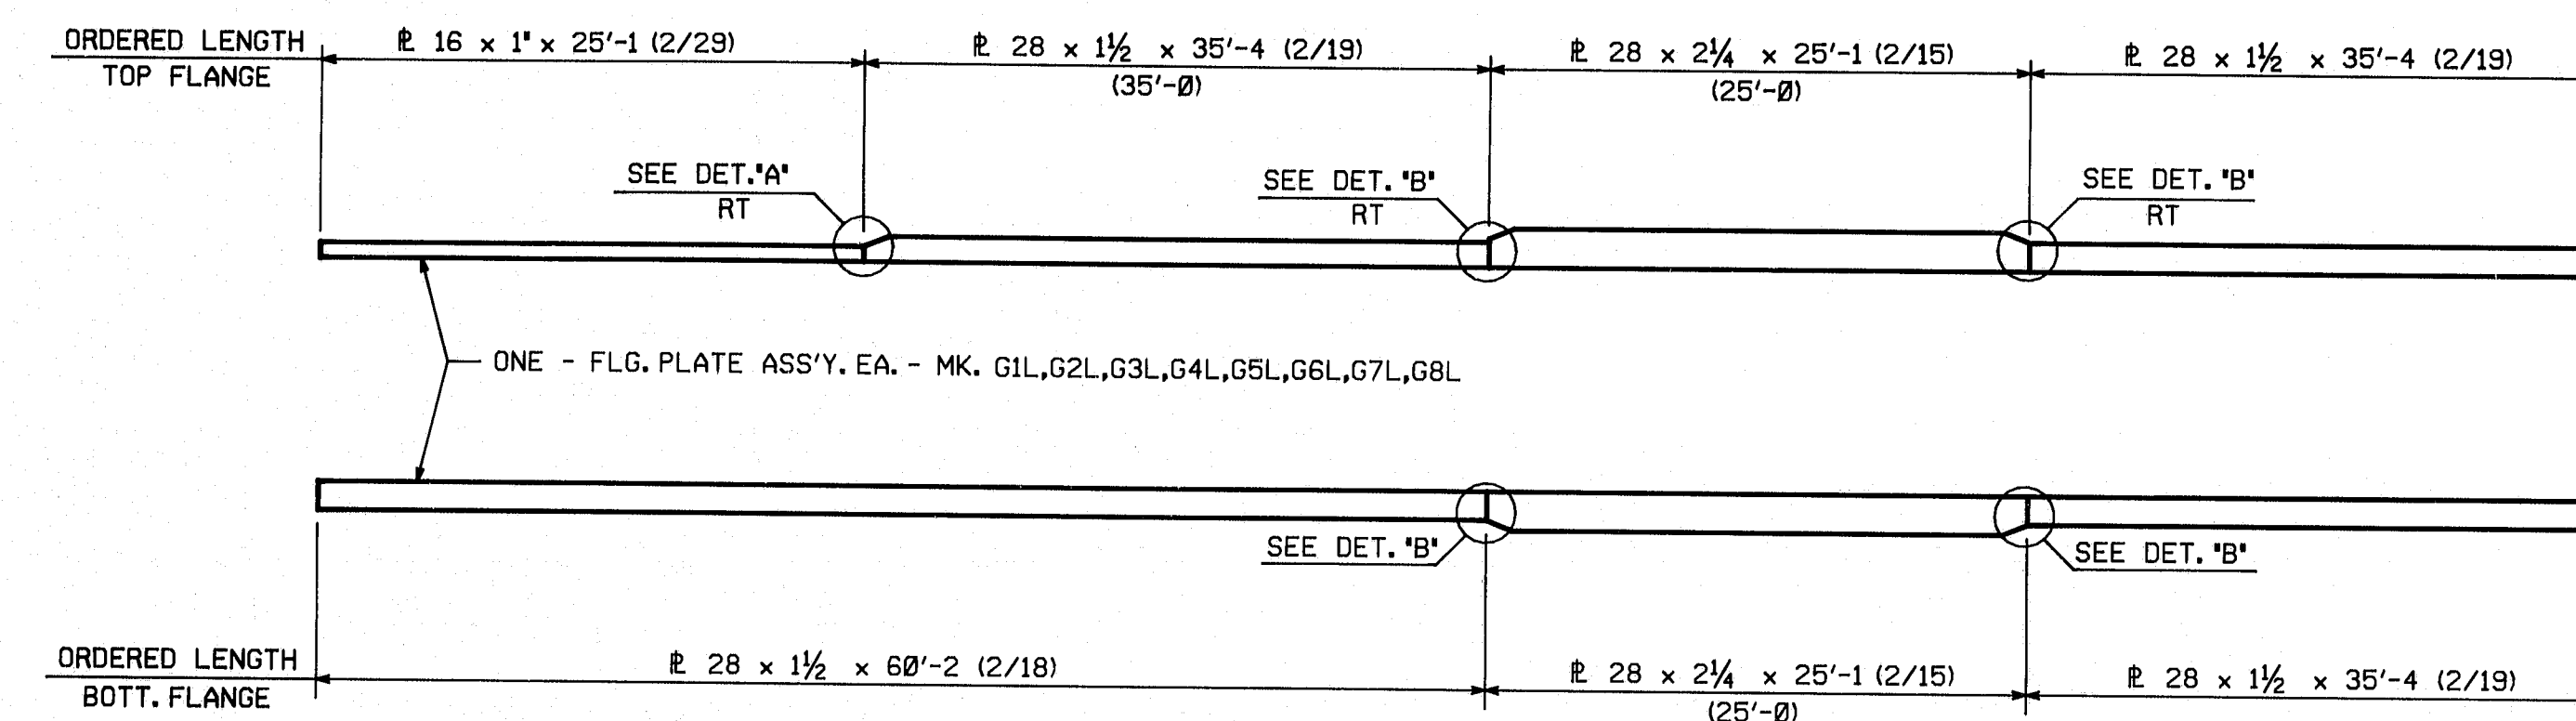

PLAN VIEW AT FLG. TRANSITION

# NOTES:


FOR GENERAL NOTES, SEE DRAWING N1.  
ALL STEEL TO BE ASTM A588,  
WITH CHARPY V-NOTCH TEST REQUIRED.  
RT INDICATES SPICES TO BE 100% RADIOGRAPHICALLY TESTED.  
TEST RANDOM 25% OF REMAINDER.  
TESTING TO BE DONE BY A QUALIFIED TECHNICIAN IN  
THE PRESENCE OF AN INSPECTOR.  
DIMENSIONS SHOWN THUS (25'-0) ARE THE ACTUAL DIMENSIONS  
THAT WILL APPEAR ON THE GIRDER DETAIL DRAWINGS.

NO.	REVISION	DATE
<b>HIGH STEEL STRUCTURES, INC.</b> 1905 Old Philadelphia Pike Lancaster, Pennsylvania 17603 Phone 717/295-521 A Subsidiary of High Industries, Inc.		
FLANGE SPICE DETAILS		
I-395 BRIDGE OVER PENOBSCOT RIVER		
I-395 BRIDGE STA. 164+60.00		
PENOBSCOT COUNTY		
STATE OF MAINE		
DEPARTMENT OF TRANSPORTATION		
STATE CONTRACT OR REFNO.	6	CONTRACTOR CIANBRO CORP.
IN CHARGE	HINKLE	MADE BY S.J.A. CHK'D BY JLC DATE 9-17-84
CONTRACT NUMBER	ME-84088-3	DRAWING NUMBER FS1

R95-169


CODE:4000

FED. ROAD DIV. NO.	STATE	FED. AID PROJ. NO.
1	ME.	I-19-395-B(82)176

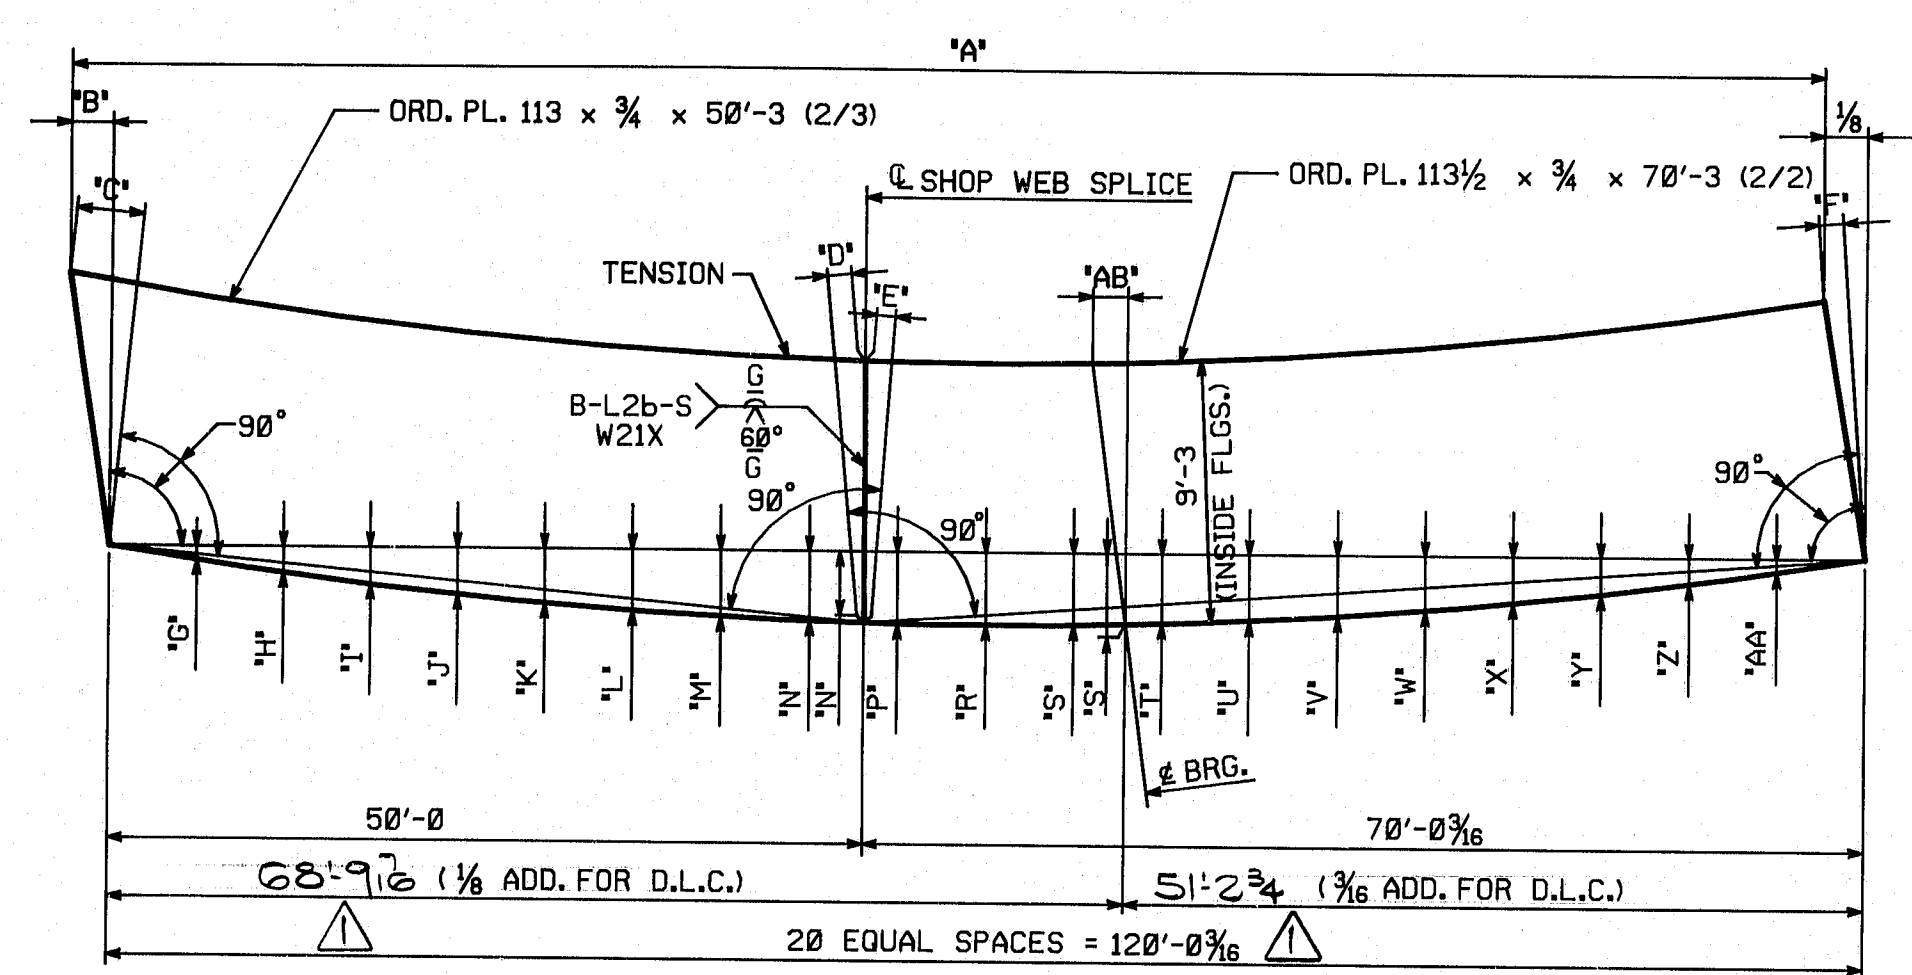


CAMBER DIAGRAM-G1L,G2L,G3L,G4L,G5L,G6L&G7L


MARK	'A'	'B'	'C'	'D'	'E'	'F'	'G'	'H'	'I'	'J'	'K'	'L'	'M'	'N'	'P'	'R'	'S'	'T'	'U'	'V'	'W'	'X'	'Y'	'Z'	'AA'	'AB'
G1L	120'-0 1/4	3/8	7/8	1/8	1/8	0	1/8	1/8	3/8	1/4	3/8	1/8	1/2	3/8	3/8	3/8	3/8	3/8	3/8	1/2	7/8	3/8	1/8	1 1/8		
G2L	120'-0 3/8	1/8	1/4	1/8	1/8	0	1/8	1/8	3/8	1/4	3/8	1/8	1/2	3/8	3/8	3/8	3/8	3/8	3/8	1/2	7/8	3/8	1/8	1 1/8		
G3L	120'-0 3/8	1/8	1/4	1/8	1/8	0	1/8	1/8	3/8	1/4	3/8	1/8	1/2	3/8	3/8	3/8	3/8	3/8	3/8	1/2	7/8	3/8	1/8	1 1/8		
G4L	120'-0 3/8	1/8	1/4	1/8	1/8	0	1/8	1/8	3/8	1/4	3/8	1/8	1/2	3/8	3/8	3/8	3/8	3/8	3/8	1/2	7/8	3/8	1/8	1 1/8		
G5L	120'-0 3/8	1/8	1/4	1/8	1/8	0	1/8	1/8	3/8	1/4	3/8	1/8	1/2	3/8	3/8	3/8	3/8	3/8	3/8	1/2	7/8	3/8	1/8	1 1/8		
G6L	120'-0 3/8	1/8	1/4	1/8	1/8	0	1/8	1/8	3/8	1/4	3/8	1/8	1/2	3/8	3/8	3/8	3/8	3/8	3/8	1/2	7/8	3/8	1/8	1 1/8		
G7L	120'-0 3/8	0	1/8	1/8	1/8	0	1/8	1/8	3/8	1/4	3/8	1/8	1/2	3/8	3/8	3/8	3/8	3/8	3/8	1/2	7/8	3/8	1/8	1 1/8		

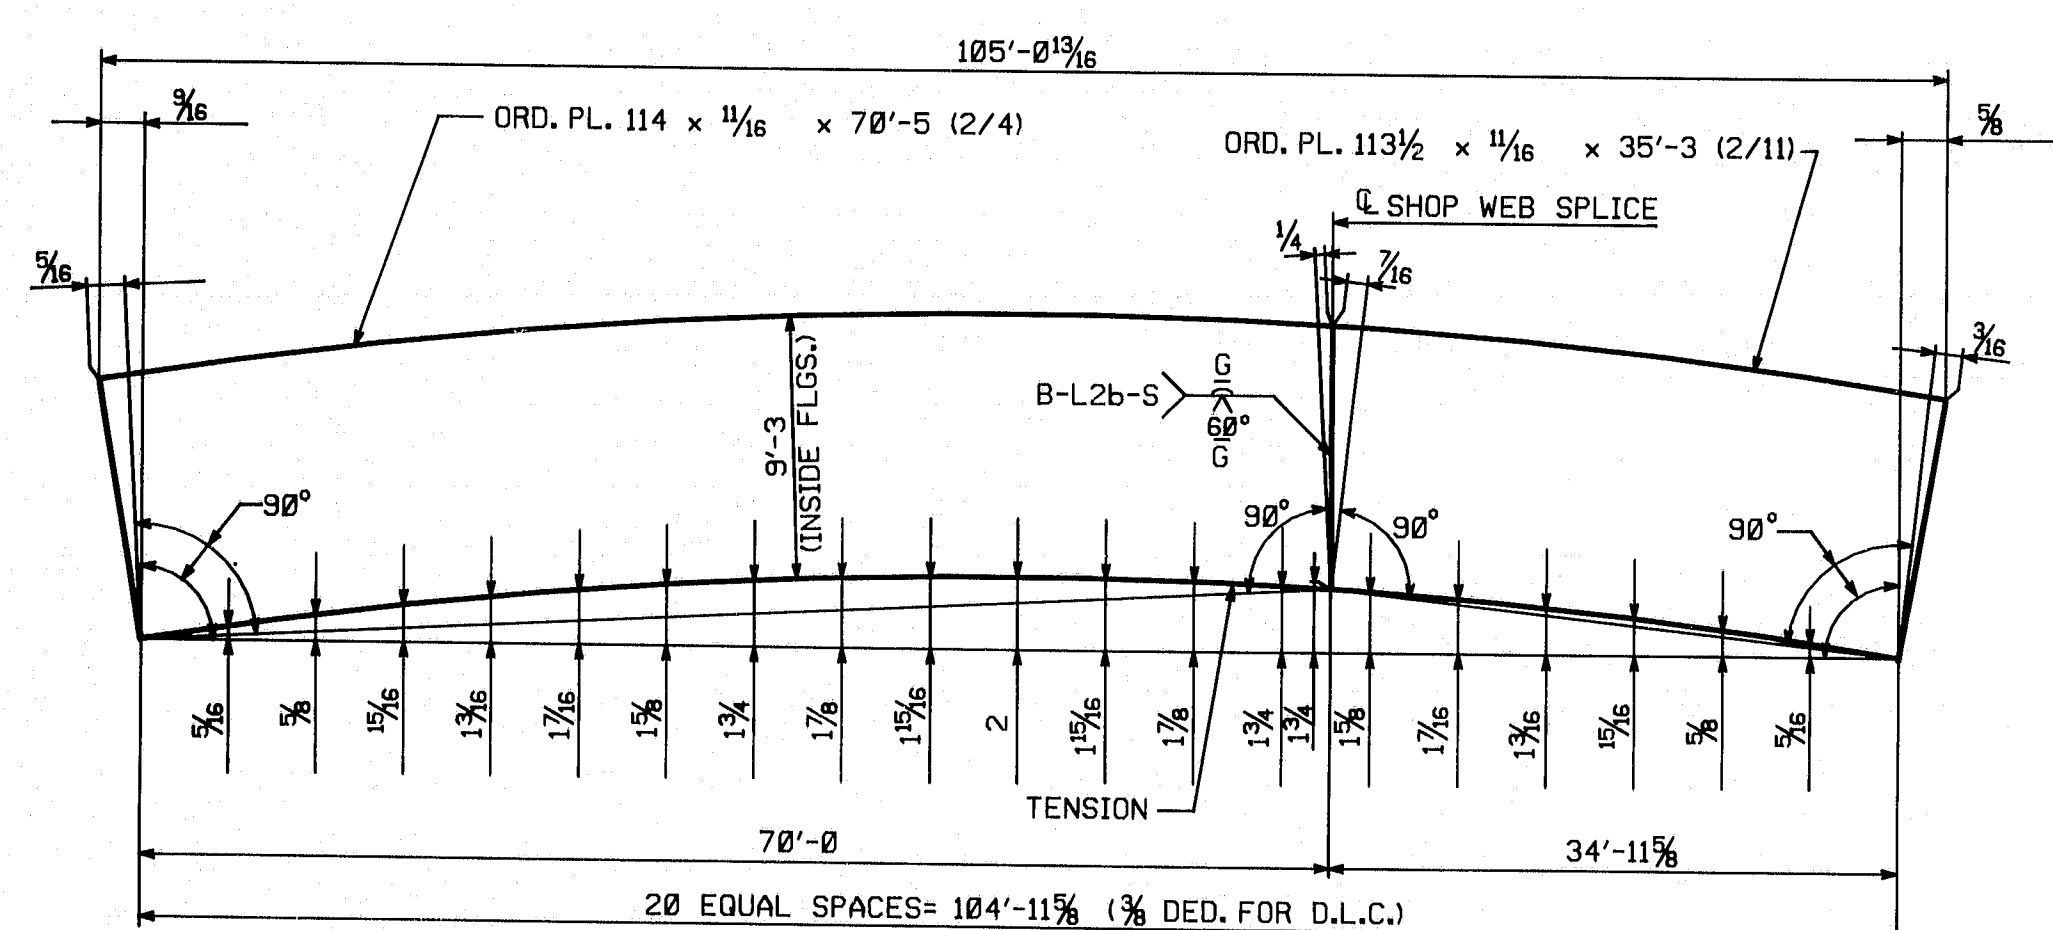


CAMBER DIAGRAM-G1M,G2M,G3M,G4M,G5M,G6M,G7M,G8M

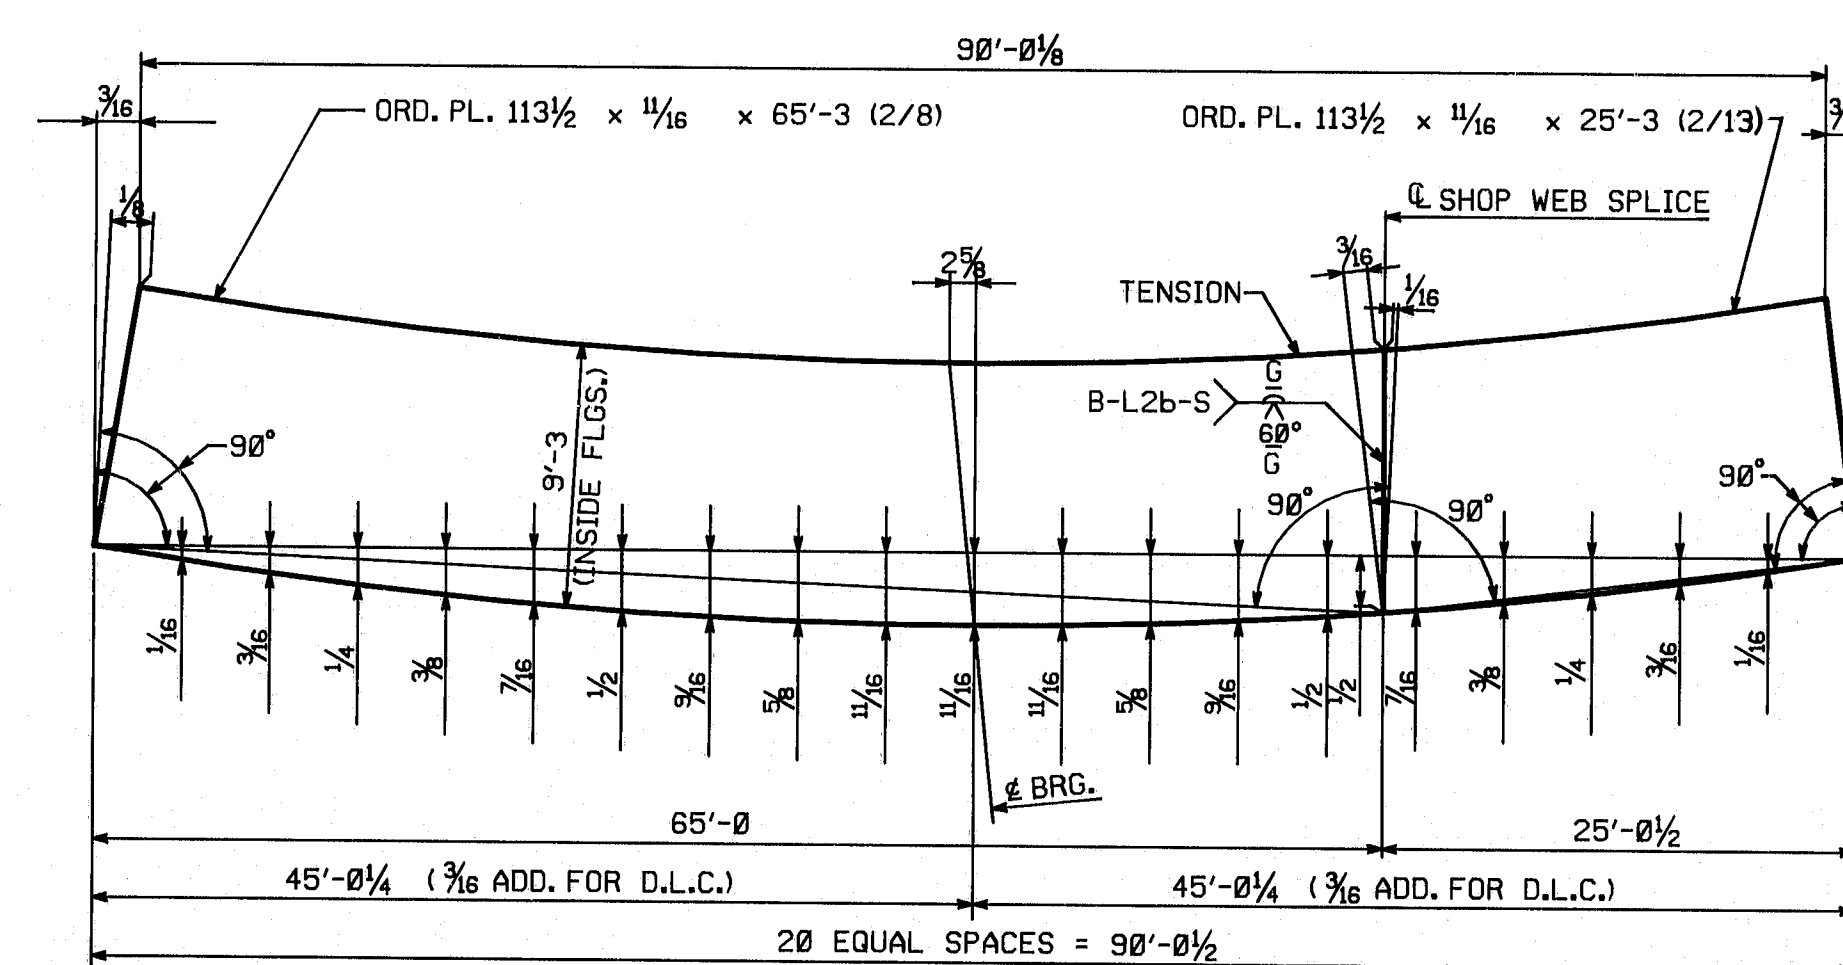

CAMBER DIAGRAM-G1N,G2N,G3N,G4N,G5N,G6N,G7N,G8N

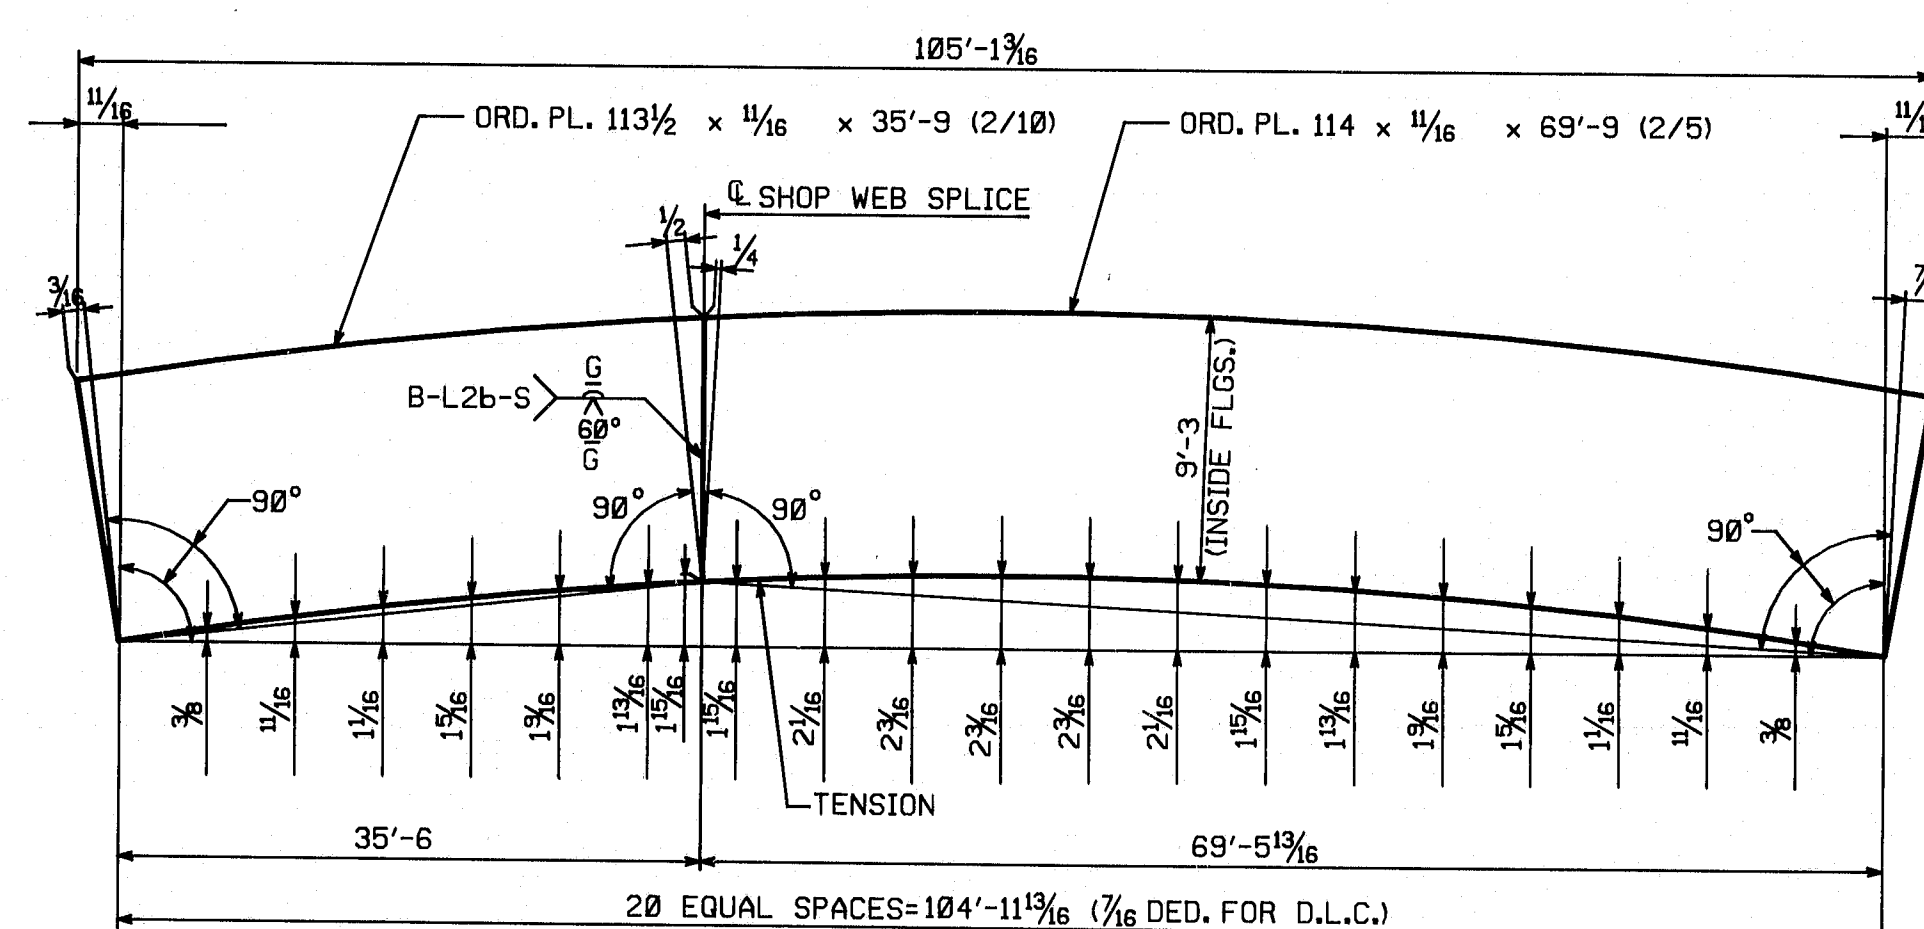

CAMBER DIAGRAM-G1O,G2O,G3O,G4O,G5O,G6O,G7O,G8O

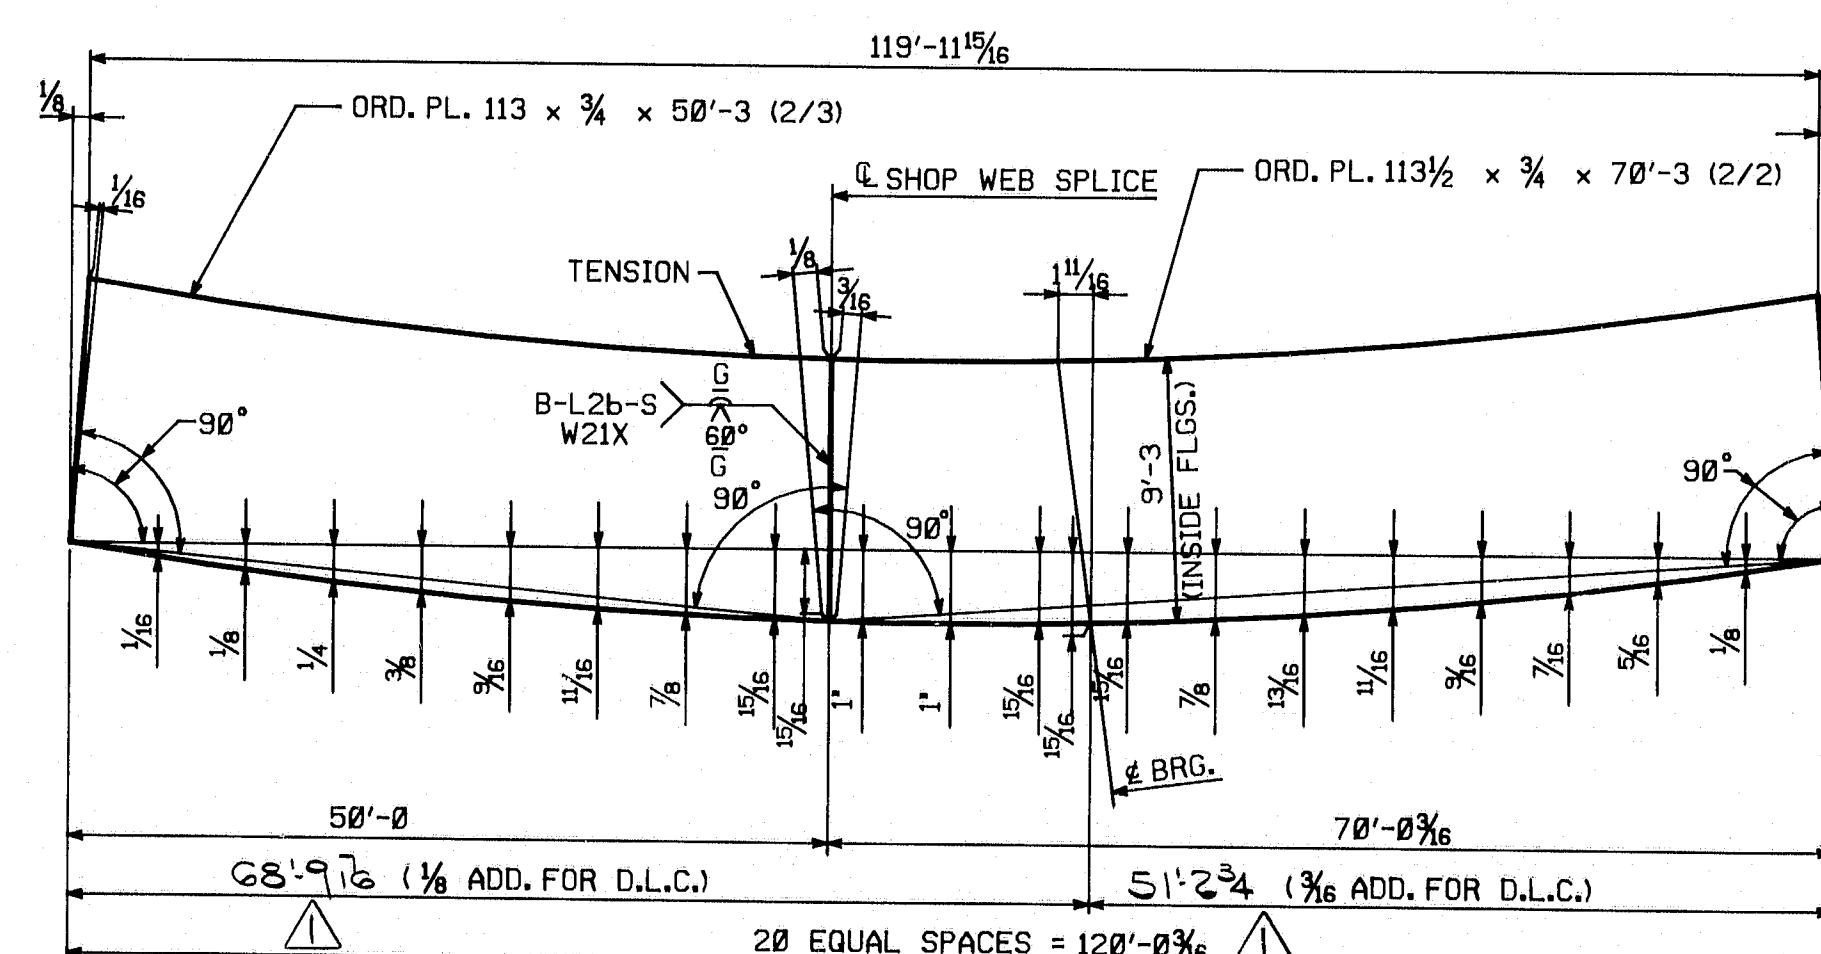

CAMBER DIAGRAM-G8L

# NOTES:

FOR GENERAL NOTES, SEE DRAWING N1.  
ALL STEEL TO BE ASTM A588 WITH CHARTY V-NOTCH TEST.  
RADIOGRAPHICALLY TEST 1/6 THE DEPTH OF THE WEB  
AT THE TENSION EDGE + 25%, AT RANDOM, OF THE REMAINDER.  
TESTING TO BE DONE BY A QUALIFIED TECHNICIAN IN  
THE PRESENCE OF THE INSPECTOR.  
SHOP INSPECTION BY MAINE D.O.T., OR THEIR REPRESENTATIVE.


NO. 1	REVISION Revised span length Central 2 LG	DATE 1-12-85
<b>HIGH STEEL STRUCTURES, INC.</b> <small>1905 Old Philadelphia Pike Lancaster, Pennsylvania 17603 Phone 717/295-333</small> <small>A Subsidiary of HSP Industries, Inc.</small>		
WEB CAMBER DIAGRAMS		
I-395 BRIDGE OVER PENOBSCOT RIVER		
I-395 BRIDGE STA. 164+60.00		
PENOBSCOT COUNTY		
STATE OF MAINE		
DEPARTMENT OF TRANSPORTATION		
STATE CONTRACT OR REF. NO. 6	CONTRACTOR CIAMBRO CORP.	
IN CHARGE HINKLE	MADE BY S.J.A.	CHK'D BY JLC DATE 9-17-84
CONTRACT NUMBER ME-84088-3	DRAWING NUMBER WC1	

R95-170


CODE: 4000



FED. ROAD DIV.	STATE	FED. AID PROJ. NO.
1	ME.	I-10-395-6(2)176

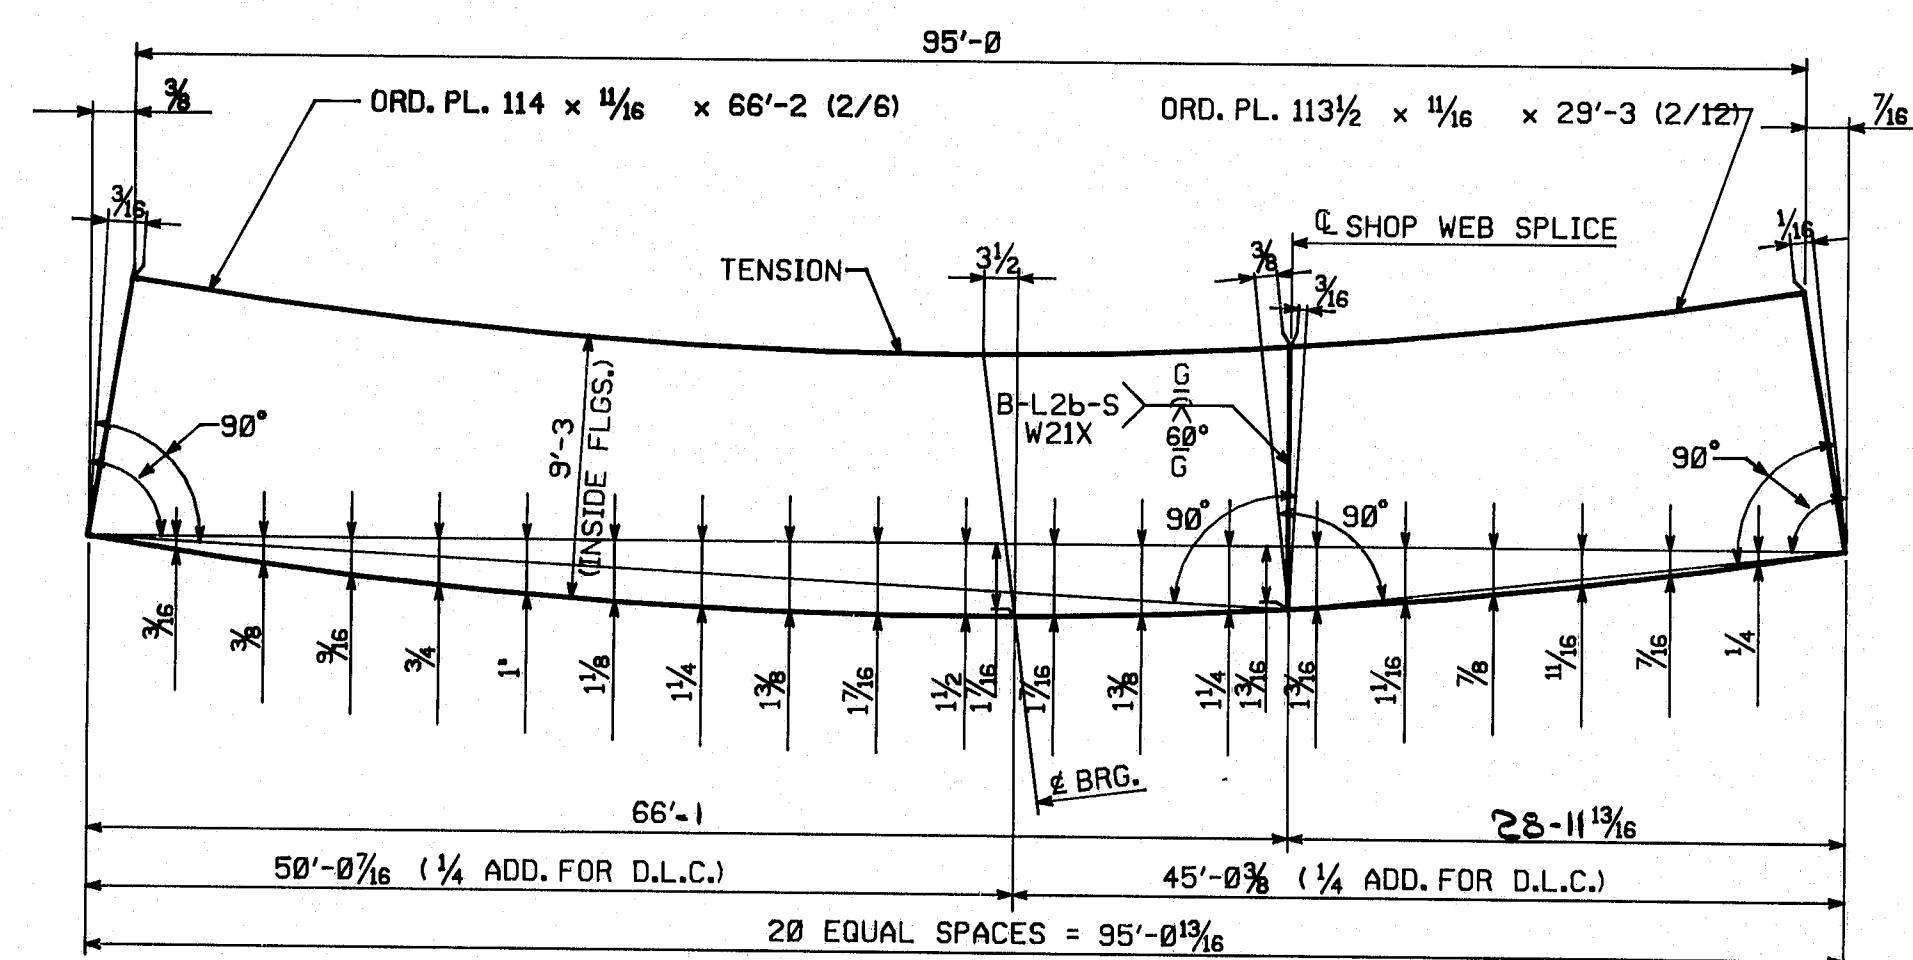

CAMBER DIAGRAM-G1P,G2P,G3P,G4P,G5P,G6P,G7P,G8P

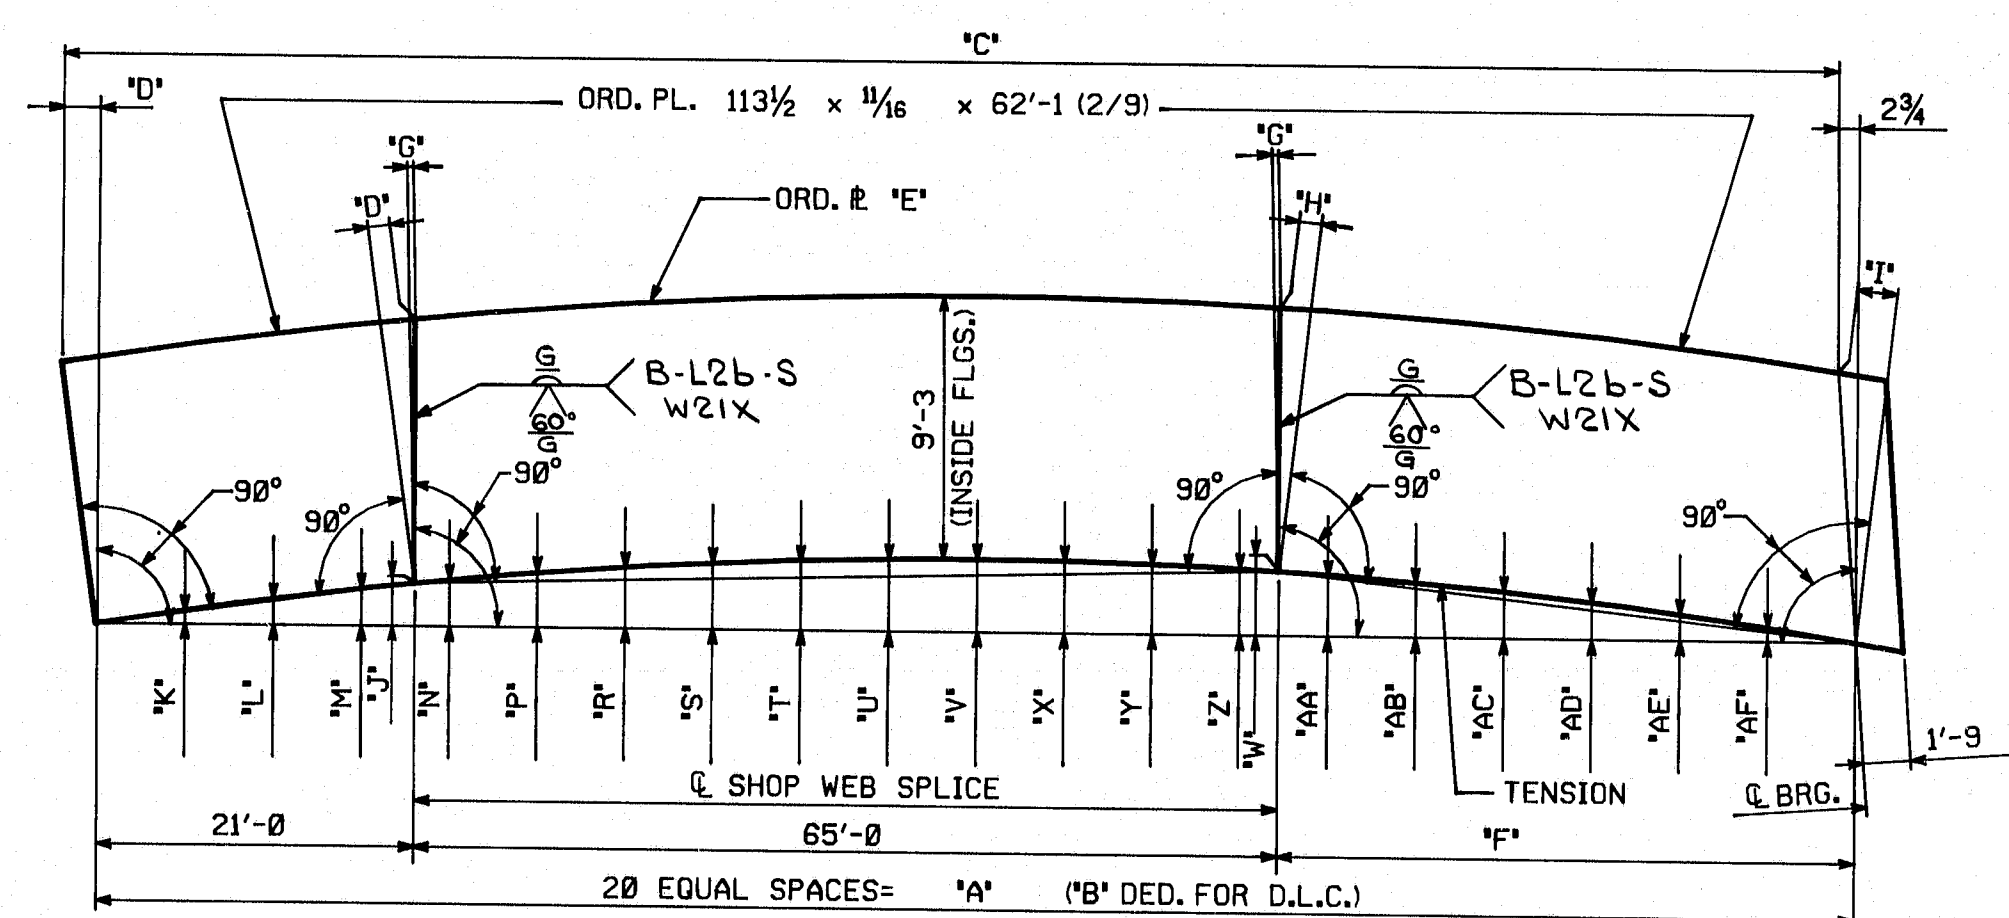

CAMBER DIAGRAM- G1Q,G2Q,G3Q,G4Q,G5Q,G6Q,G7Q,G8Q

MARK	"A"	"B"	"C"	"D"	"E"	"F"	"G"	"H"	"I"	"J"	"K"	"L"	"M"	"N"	"P"	"R"	"S"	"T"	"U"	"V"	"W"	"X"	"Y"	"Z"	"AA"	"AB"	"AC"	"AD"	"AE"	"AF"
G1Q	125'-0	$\frac{7}{16}$	124'-9 $\frac{3}{4}$	$\frac{1}{2}$	113 $\frac{1}{2}$ x $\frac{1}{16}$ x65'-3 (2/8)	39'-0	$\frac{1}{16}$	$\frac{7}{16}$	$\frac{3}{16}$	1 $\frac{1}{16}$	$\frac{5}{16}$	$\frac{5}{16}$	$\frac{15}{16}$	1 $\frac{1}{4}$	1 $\frac{1}{2}$	1 $\frac{1}{16}$	1 $\frac{1}{2}$	2	2 $\frac{1}{2}$	2 $\frac{1}{2}$	1 $\frac{13}{16}$	2 $\frac{1}{2}$	2	1 $\frac{1}{2}$	1 $\frac{1}{16}$	1 $\frac{1}{2}$	1 $\frac{1}{4}$	$\frac{1}{16}$	$\frac{5}{16}$	$\frac{5}{16}$
G2Q	125'-0	$\frac{7}{16}$	124'-9 $\frac{3}{4}$	$\frac{1}{2}$	113 $\frac{1}{2}$ x $\frac{1}{16}$ x65'-3 (2/8)	39'-0	$\frac{1}{16}$	$\frac{7}{16}$	$\frac{3}{16}$	1 $\frac{1}{16}$	$\frac{5}{16}$	$\frac{5}{16}$	1'	1 $\frac{1}{4}$	1 $\frac{1}{2}$	1 $\frac{1}{16}$	1 $\frac{1}{2}$	2 $\frac{1}{2}$	2 $\frac{1}{2}$	2 $\frac{1}{2}$	1 $\frac{1}{2}$	2 $\frac{1}{2}$	2 $\frac{1}{2}$	1 $\frac{15}{16}$	1 $\frac{1}{2}$	1 $\frac{1}{4}$	$\frac{1}{16}$	$\frac{5}{16}$	$\frac{5}{16}$	
G3Q	125'-0	$\frac{7}{16}$	124'-9 $\frac{3}{4}$	$\frac{1}{2}$	113 $\frac{1}{2}$ x $\frac{1}{16}$ x65'-3 (2/8)	39'-0	$\frac{1}{16}$	$\frac{7}{16}$	$\frac{3}{16}$	1 $\frac{1}{16}$	$\frac{5}{16}$	$\frac{5}{16}$	1'	1 $\frac{1}{4}$	1 $\frac{1}{2}$	1 $\frac{1}{16}$	1 $\frac{1}{2}$	2 $\frac{1}{2}$	2 $\frac{1}{2}$	2 $\frac{1}{2}$	1 $\frac{1}{2}$	2 $\frac{1}{2}$	2 $\frac{1}{2}$	1 $\frac{15}{16}$	1 $\frac{1}{2}$	1 $\frac{1}{4}$	$\frac{1}{16}$	$\frac{5}{16}$	$\frac{5}{16}$	
G4Q	125'-0	$\frac{7}{16}$	124'-9 $\frac{3}{4}$	$\frac{1}{2}$	113 $\frac{1}{2}$ x $\frac{1}{16}$ x65'-3 (2/8)	39'-0	$\frac{1}{16}$	$\frac{7}{16}$	$\frac{3}{16}$	1 $\frac{1}{16}$	$\frac{5}{16}$	$\frac{5}{16}$	1'	1 $\frac{1}{2}$	1 $\frac{1}{2}$	1 $\frac{1}{16}$	1 $\frac{1}{2}$	2 $\frac{1}{2}$	2 $\frac{1}{2}$	2 $\frac{1}{2}$	1 $\frac{1}{2}$	2 $\frac{1}{2}$	2 $\frac{1}{2}$	2	1 $\frac{1}{2}$	1 $\frac{1}{4}$	$\frac{1}{16}$	$\frac{5}{16}$	$\frac{5}{16}$	
G5Q	124'-11 $\frac{1}{2}$	$\frac{7}{16}$	124'-9 $\frac{3}{4}$	$\frac{1}{2}$	113 $\frac{1}{2}$ x $\frac{1}{16}$ x65'-3 (2/8)	38'-11 $\frac{7}{8}$	$\frac{1}{16}$	$\frac{7}{16}$	$\frac{3}{16}$	1 $\frac{1}{16}$	$\frac{5}{16}$	$\frac{5}{16}$	$\frac{3}{4}$	1 $\frac{1}{4}$	1 $\frac{1}{2}$	1 $\frac{1}{2}$	2 $\frac{1}{4}$	2 $\frac{1}{2}$	2 $\frac{1}{2}$	2 $\frac{1}{2}$	1 $\frac{1}{2}$	2 $\frac{1}{2}$	2 $\frac{1}{2}$	2	1 $\frac{1}{2}$	1 $\frac{1}{4}$	$\frac{1}{16}$	$\frac{5}{16}$	$\frac{5}{16}$	
G6Q	124'-11 $\frac{1}{2}$	$\frac{7}{16}$	124'-9 $\frac{3}{4}$	$\frac{1}{2}$	114"x $\frac{1}{16}$ x65'-3 (2/7)	38'-11 $\frac{1}{2}$	$\frac{1}{16}$	$\frac{7}{16}$	$\frac{3}{16}$	1 $\frac{1}{16}$	$\frac{5}{16}$	$\frac{1}{2}$	$\frac{15}{16}$	1 $\frac{1}{2}$	1 $\frac{1}{2}$	1 $\frac{1}{2}$	2 $\frac{1}{4}$	2 $\frac{1}{2}$	2 $\frac{1}{2}$	2 $\frac{1}{2}$	2 $\frac{3}{16}$	2 $\frac{1}{2}$	2 $\frac{1}{2}$	2 $\frac{1}{2}$	1 $\frac{1}{2}$	1 $\frac{1}{4}$	$\frac{1}{16}$	$\frac{5}{16}$	$\frac{5}{16}$	
G7Q	125'-0 $\frac{3}{8}$	$\frac{7}{16}$	124'-10 $\frac{1}{4}$	$\frac{1}{2}$	114"x $\frac{1}{16}$ x65'-3 (2/7)	39'-0 $\frac{3}{8}$	$\frac{1}{16}$	$\frac{7}{16}$	$\frac{3}{16}$	1 $\frac{1}{16}$	$\frac{5}{16}$	$\frac{1}{16}$	1 $\frac{1}{2}$	1 $\frac{1}{2}$	1 $\frac{1}{2}$	2	2 $\frac{1}{4}$	2 $\frac{1}{2}$	2 $\frac{1}{2}$	2 $\frac{1}{2}$	2 $\frac{1}{2}$	2 $\frac{1}{2}$	2 $\frac{1}{2}$	2 $\frac{1}{2}$	1 $\frac{1}{2}$	1 $\frac{1}{4}$	$\frac{1}{16}$	$\frac{5}{16}$	$\frac{5}{16}$	
G8Q	125'-0 $\frac{5}{8}$	$\frac{7}{16}$	124'-10 $\frac{7}{8}$	$\frac{1}{2}$	113 $\frac{1}{2}$ x $\frac{1}{16}$ x65'-3 (2/8)	39'-0 $\frac{5}{8}$	$\frac{1}{16}$	$\frac{7}{16}$	$\frac{3}{16}$	1 $\frac{1}{16}$	$\frac{5}{16}$	$\frac{5}{16}$	$\frac{3}{4}$	1 $\frac{1}{4}$	1 $\frac{1}{2}$	1 $\frac{1}{2}$	2 $\frac{1}{4}$	2 $\frac{1}{2}$	2 $\frac{1}{2}$	2 $\frac{1}{2}$	2 $\frac{1}{2}$	2 $\frac{1}{2}$	2 $\frac{1}{2}$	2 $\frac{1}{2}$	2 $\frac{1}{2}$	1 $\frac{1}{2}$	1 $\frac{1}{4}$	$\frac{1}{16}$	$\frac{5}{16}$	$\frac{5}{16}$

NOTES:  
FOR NOTES, SEE DRAWING WC1.

NO.	REVISION	DATE
<p>105 Old Philadelphia Pike Lancaster, Pennsylvania 17603 Phone 717/299-525</p> <p><b>HIGH STEEL STRUCTURES, INC.</b></p> <p>A Subsidiary of High Industries, Inc.</p>		
WEB CAMBER DIAGRAMS		
I-395 BRIDGE OVER PENOBSCOT RIVER		
I-395 BRIDGE STA. 164+60.00		
PENOBSCOT COUNTY		
STATE OF MAINE		
DEPARTMENT OF TRANSPORTATION		
STATE CONTRACT OR REF. NO.	6	CONTRACTOR
IN CHARGE	HINKLE	MADE BY S.J.A. CHK'D BY JLC DATE 9-17-84
CONTRACT NUMBER	ME-84088-3	DRAWING NUMBER
		WC2


R95-171

CODE: 4000




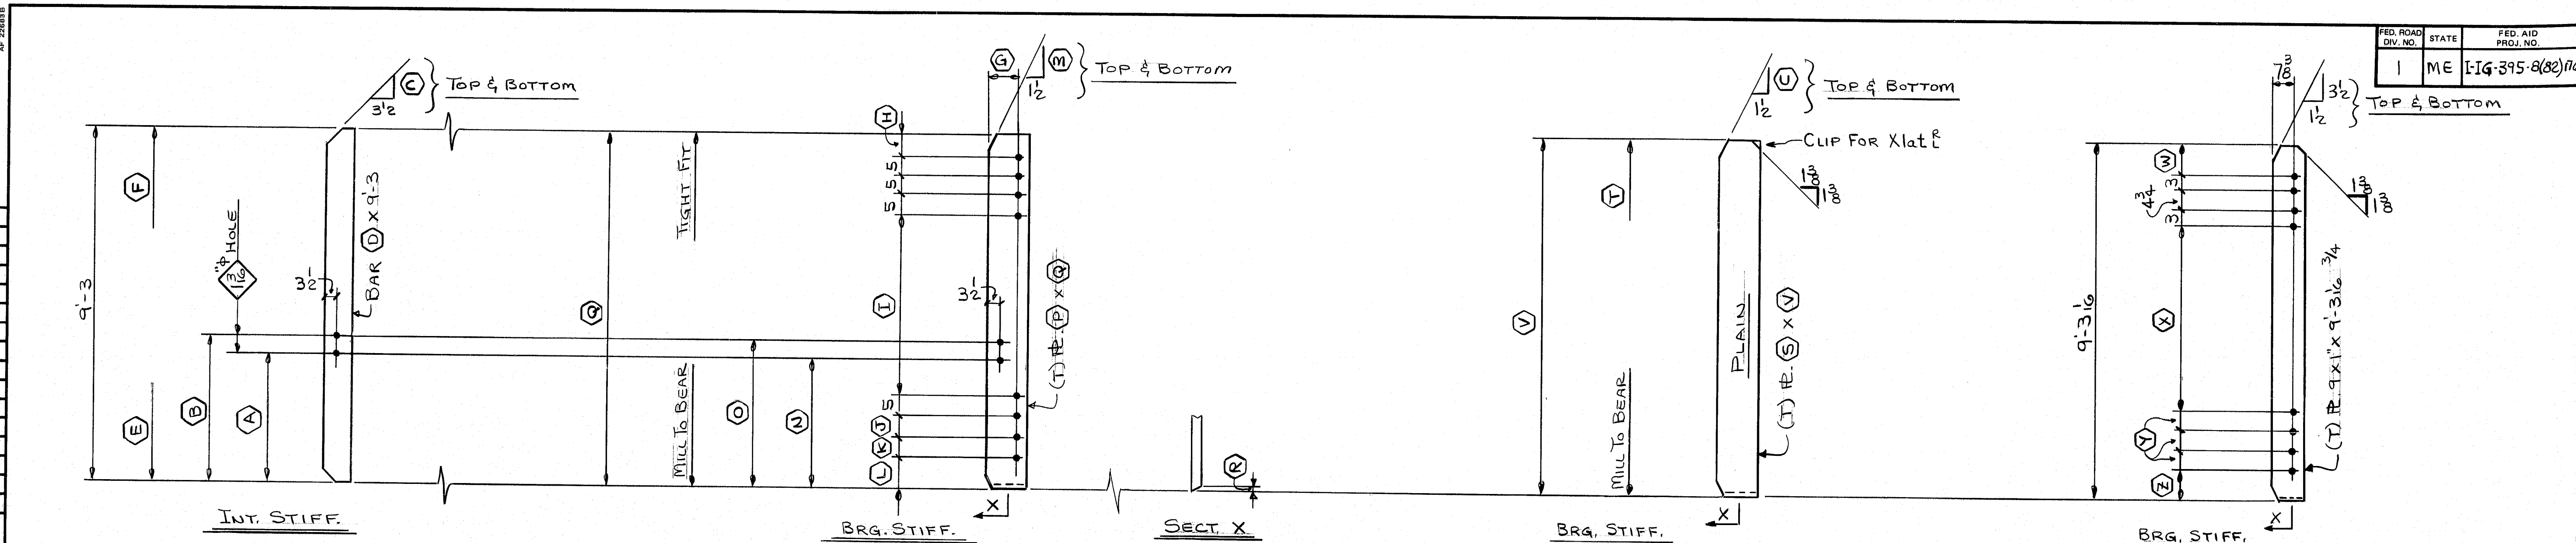


REQ'D	MK.	A	B	C	D	E	F
8	Xia	-	3'-9"	4'-2"	6x16 3/4"	TIGHT FIT	-
8	Xib	-	3'-9"	-	6x16 3/8"	TIGHT FIT	-
8	Xic	3'-6"	-	-	6x16 3/4"	-	-
8	Xid	3'-6"	3'-9"	-	5x12 3/4"	-	-
8	Xie	-	3'-9"	4'-2"	3/4"	-	-
24	Xif	3'-6"	-	3'-2"	3/4"	TIGHT FIT	-
24	Xig	3'-6"	3'-9"	-	3/4"	-	-
8	Xih	3'-6"	-	-	-	-	-
8	Xik	3'-6"	-	-	-	-	-
8	Xil	-	3'-9"	-	-	-	TIGHT FIT
24	Xim	3'-6"	-	-	-	TIGHT FIT	-
16	Xin	-	3'-9"	-	-	TIGHT FIT	-
8	Xio	-	-	-	3/4"	TIGHT FIT	-
24	Xip	-	3'-9"	-	5x12 3/4"	TIGHT FIT	TIGHT FIT
8	Xiq	-	-	3'-2"	7x16 3/8"	TIGHT FIT	-
8	Xir	-	3'-9"	4'-2"	7x16 3/8"	TIGHT FIT	TIGHT FIT
Δ 6	Xis	-	-	3'-2"	10x16 3/8"	TIGHT FIT	-

REQ'D	MK.	G	H	I	J	K	L	M	N	O	P	Q	R
4	xiaa	10 $\frac{1}{2}$	4	5'-6 $\frac{11}{16}$	5	5	10 $\frac{5}{8}$	4 $\frac{1}{2}$	3'-6	-	12x18	9'-3 $\frac{3}{4}$	0"
4	xiab	$\uparrow$	6 $\frac{5}{8}$	5'-6 $\frac{11}{16}$	$\uparrow$	$\uparrow$	8	$\uparrow$	$\uparrow$	-	$\uparrow$	$\uparrow$	$\uparrow$
8	xiac		4	5'-5 $\frac{1}{2}$			11 $\frac{1}{2}$			-			
8	xiad	10 $\frac{1}{2}$	7 $\frac{1}{2}$	5'-5 $\frac{1}{2}$			8	4 $\frac{1}{2}$		-	12x18	9'-3 $\frac{3}{4}$	0"
2	xiaf <sup>R</sup>	8 $\frac{1}{2}$	4	5'-6 $\frac{11}{16}$			10 $\frac{3}{8}$	3 $\frac{1}{2}$		3'-9	10x1"	9'-3 $\frac{1}{16}$ $\frac{3}{8}$	$\frac{1}{32}$
2	xiaf <sup>L</sup>												
2	xia <sup>R</sup>	$\uparrow$	6 $\frac{5}{8}$	5'-6 $\frac{11}{16}$			8 $\frac{1}{16}$	$\uparrow$		$\uparrow$	$\uparrow$	$\uparrow$	$\uparrow$
2	xia <sup>L</sup>												
8	xiah <sup>R</sup>		4	5'-5 $\frac{1}{2}$			11 $\frac{9}{16}$						
8	xiah <sup>L</sup>												
8	xiak <sup>R</sup>		7 $\frac{1}{2}$	5'-5 $\frac{1}{2}$			8 $\frac{1}{16}$						
8	xiak <sup>L</sup>												
2	xiam <sup>R</sup>	$\uparrow$	4	5'-6 $\frac{9}{16}$			10 $\frac{1}{2}$			$\uparrow$	$\uparrow$	$\uparrow$	$\uparrow$
2	xiam <sup>L</sup>												
2	xian <sup>R</sup>	8 $\frac{1}{2}$	6 $\frac{1}{16}$	5'-6 $\frac{9}{16}$	5	5	8 $\frac{1}{16}$	3 $\frac{1}{2}$	3'-6	3'-9	10x1"	9'-3 $\frac{1}{16}$ $\frac{3}{8}$	$\frac{1}{32}$
2	xian <sup>L</sup>												
2	xiap	10 $\frac{1}{2}$	4	5'-10	5 $\frac{1}{2}$	3	8 $\frac{1}{2}$	4 $\frac{1}{2}$	-	-	12x18	9'-3 $\frac{3}{4}$	0"
4	xias	8 $\frac{1}{2}$	4	5'-10	5 $\frac{1}{2}$	3	8 $\frac{1}{16}$	3 $\frac{1}{2}$	-	-	10x1"	9'-3 $\frac{1}{16}$ $\frac{3}{8}$	$\frac{1}{32}$
4	xib <sup>y</sup>	8 $\frac{1}{2}$	4	5'-10	5 $\frac{1}{2}$	3	8 $\frac{9}{16}$	3 $\frac{1}{2}$	3'-6	3'-9	10x1"	9'-3 $\frac{1}{16}$ $\frac{3}{8}$	$\frac{1}{32}$
2	xibw	10 $\frac{1}{2}$	4	5'-10	5 $\frac{1}{2}$	3	8 $\frac{1}{2}$	4 $\frac{1}{2}$	3'-6	-	12x18	9'-3 $\frac{3}{4}$	0"

REQ'D	MK.	R	S	T	U	V
9	Xiat <sup>R</sup>	3/2	9x1"	-	3'-2"	9'-3 1/2"
9	Xiat <sup>L</sup>	3/2	9x1"	-	3'-2"	9'-3 1/2"
4	Xiaw	0"	12x16 3/4"	TIGHT FIT	4'-2"	9'-3 1/2"
4	Xiax <sup>R</sup>	3/2	10x11"	TIGHT FIT	3'-2"	9'-3 1/2"
4	Xiax <sup>L</sup>	3/2	10x11"	TIGHT FIT	3'-2"	9'-3 1/2"

NOTE	REQ'D	MK.	R	S	T	U	V
Δ	4	Xiba <sup>R</sup>	3/2	6'-6"	6'-4 1/2"	3'	8'-2"
Δ	4	Xiba <sup>L</sup>	3/2	6'-6"	6'-4 1/2"	3'	8'-2"
	ONE	Xibc	-	-	6'-1 1/2"	3'	11'-6"
OPP. HAND	2	Xibf	-	-	6'-0 3/4"	3'	1'-0 1/2"
	2	Xibh	-	-	5'-7 3/4"	5'	11'-6"
OPP. HAND	ONE	Xibm	3/2	6'-6"	5'-9 3/4"	5'	9'-6"

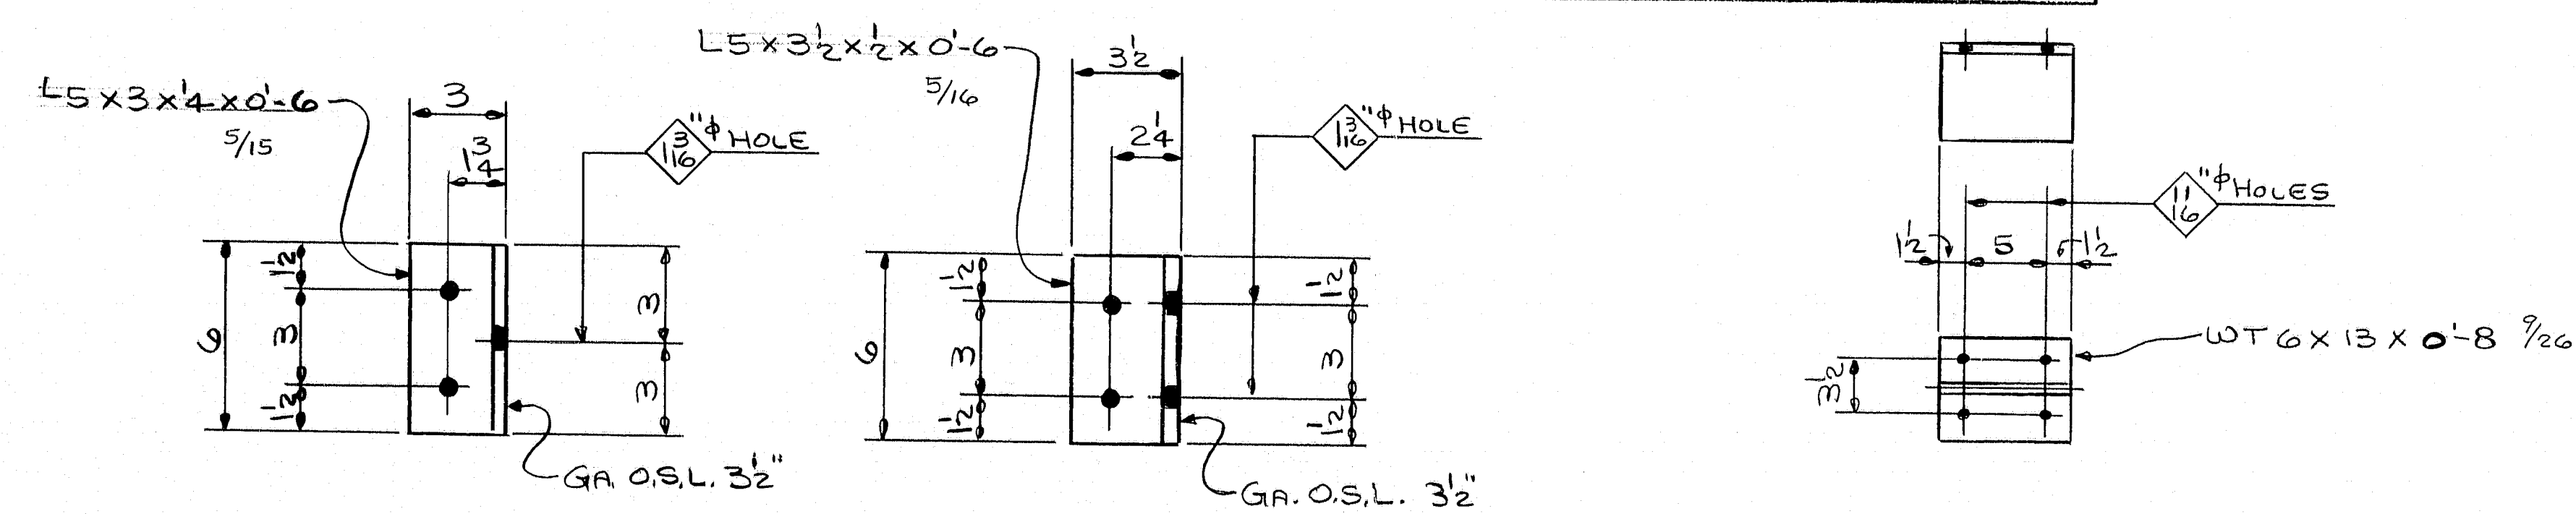

Δ 155-ANGLES-MK Xibp

Δ 20-ANGLES-MK Xibs

47-SCUPPER CONN.-MK Xibt

SHOP NOTE

HOLES: 1/2" (U.N.)  
BOLTS: NONE  
PAINT: NONE

FOR GENERAL NOTES SEE DWG. N1.  
ALL STEEL TO BE A.S.T.M. A588.  
(T) INDICATES CHARPY V-NOTCH TEST REQ'D.

R95-172


CONSTRUCTION JOINT	11-19-84
NO. Δ	REVISION CONTR. REV. CONTROL DATE 9/7/84
HIGH STEEL STRUCTURES, INC.	
1500 Old Philadelphia Pike Lancaster, Pennsylvania 17603 Phone 717/299-5211	
A Subsidiary of High Industries, Inc.	
JOB STANDARDS	
I-395 BRIDGE OVER PENOBSCOT RIVER	
I-395 BRIDGE STA. 164+60.00	
PENOBSCOT COUNTY	
STATE OF MAINE	
DEPARTMENT OF TRANSPORTATION	
STATE CONTRACT OR REF. NO.	CONTRACTOR CIANBRO CORP.
IN CHARGE: HINKLE	MADE BY: G.F.E. CHK'D BY: J.L.C. DATE: 9-19-84
CONTRACT NUMBER: ME-84088-3	DRAWING NUMBER: X1





a  
b  
c  
d  
e  
f  
g  
h  
i  
j  
k  
l  
m  
n  
o  
p  
q  
r  
s  
t  
u  
v  
w  
x  
y




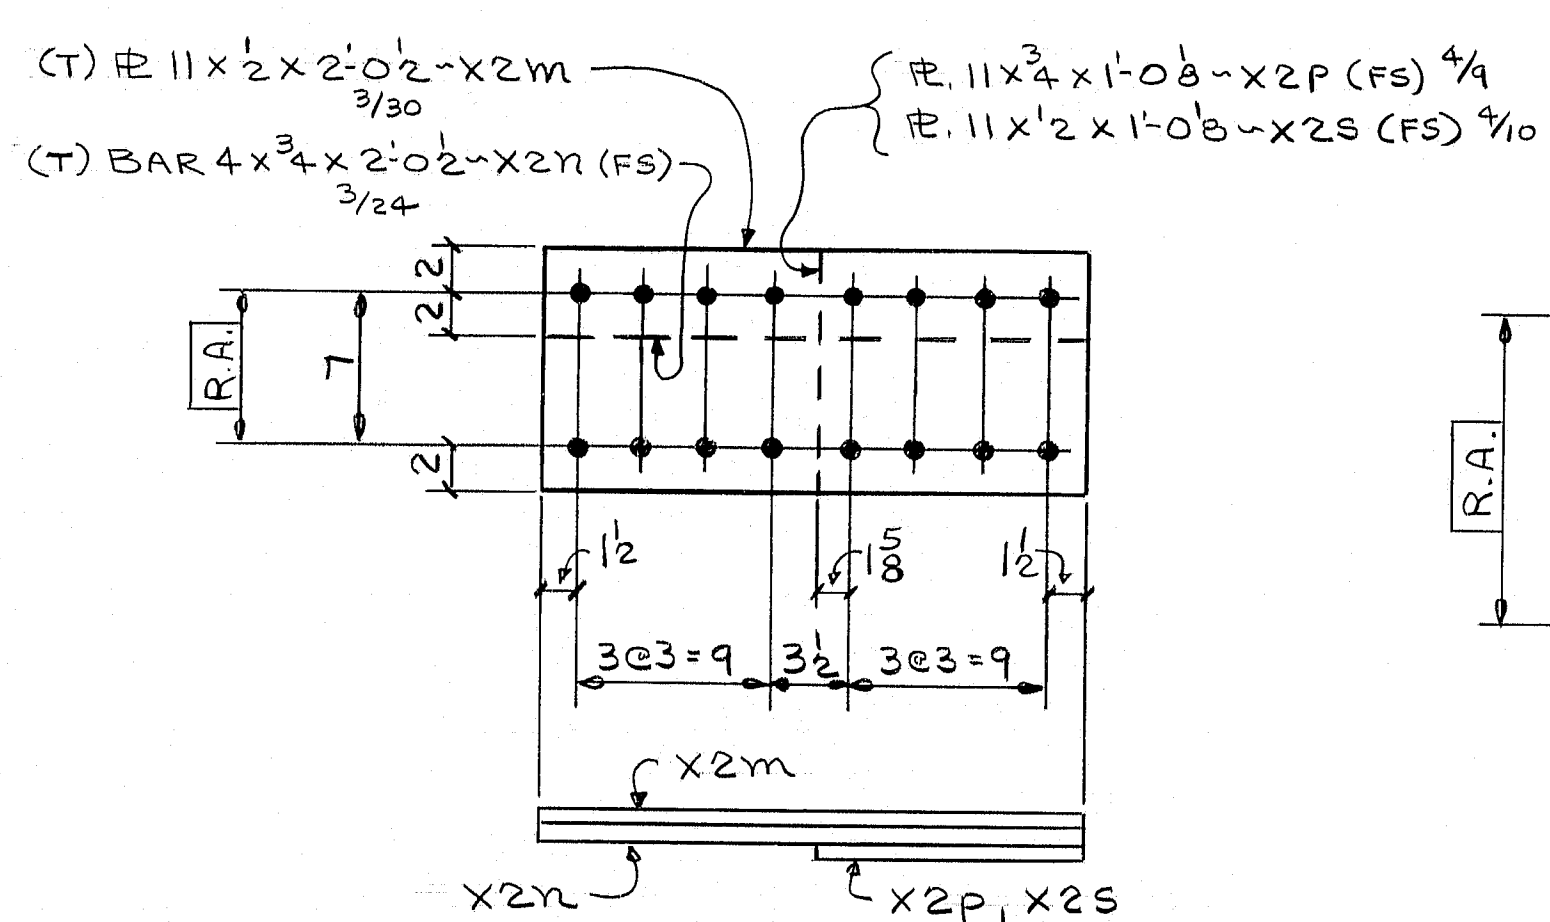


32~SPlice Rs.~Mk. X2M  
 64~SPlice Rs.~Mk. X2N  
 8~Fill Rs.~Mk. X2P  
 24~Fill Rs.~Mk. X2S

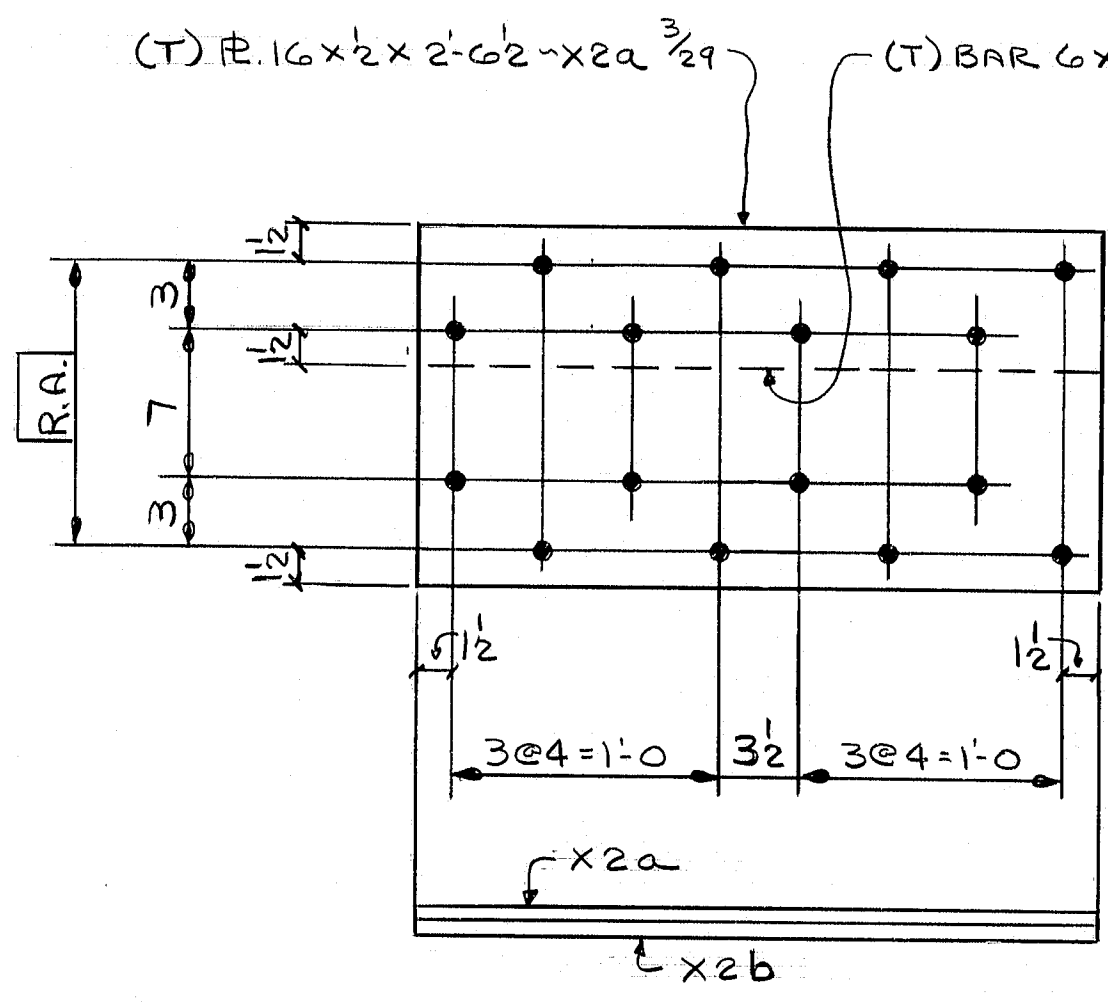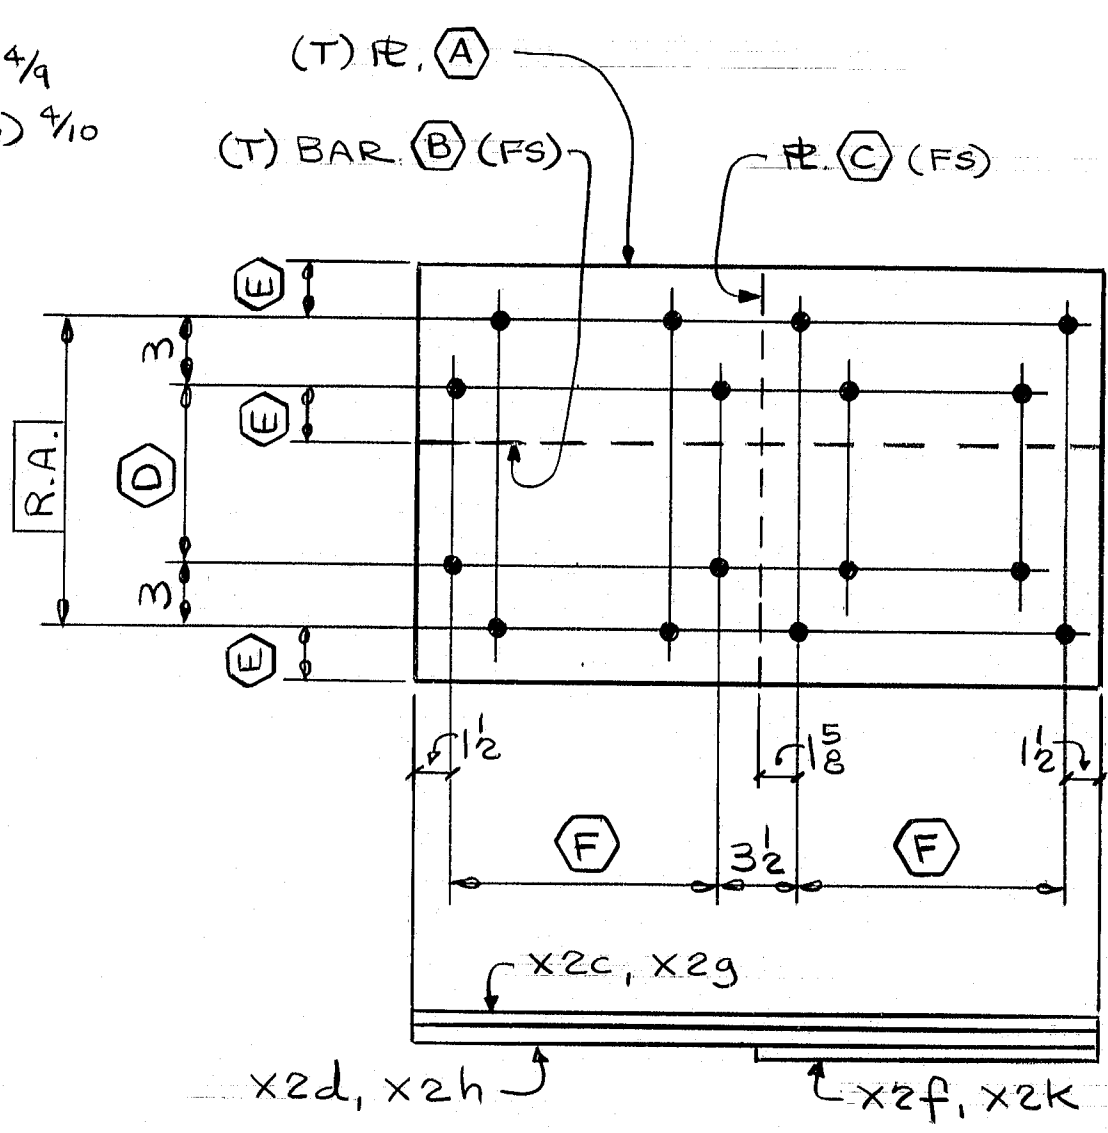

8~SPlice Rs.~Mk. X2a  
 16~SPlice Rs.~Mk. X2b

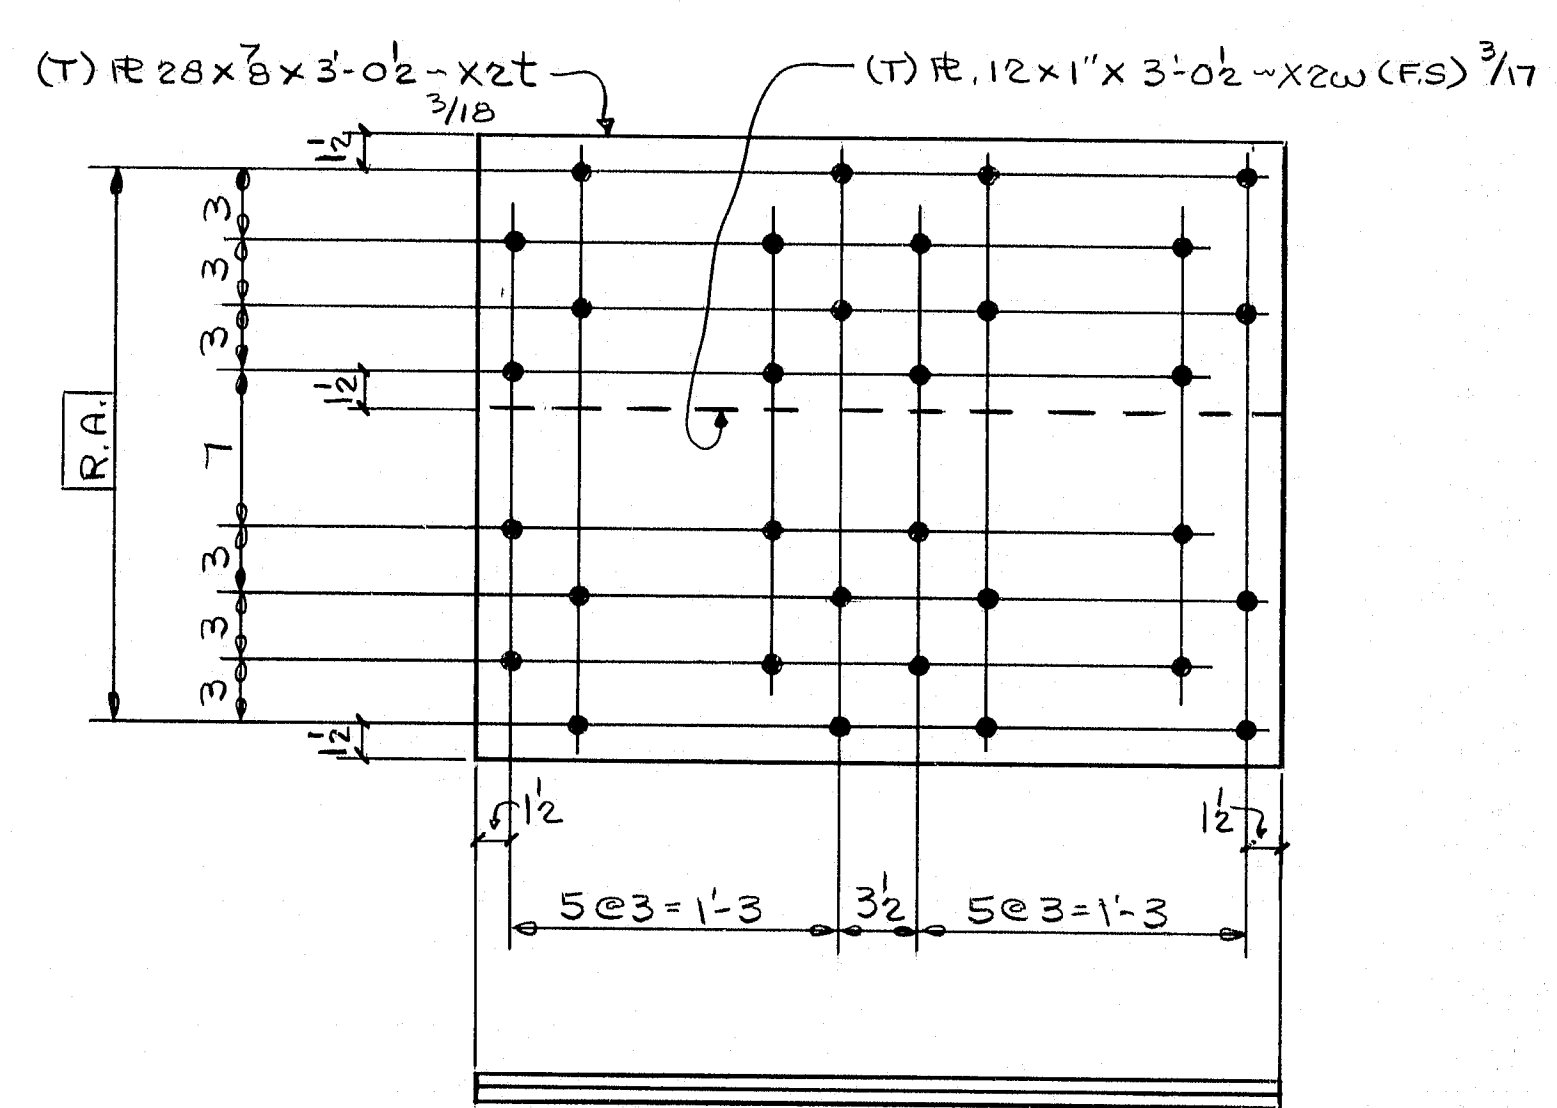

8~SPlice Rs.~Mk. X2t  
 16~SPlice Rs.~Mk. X2w

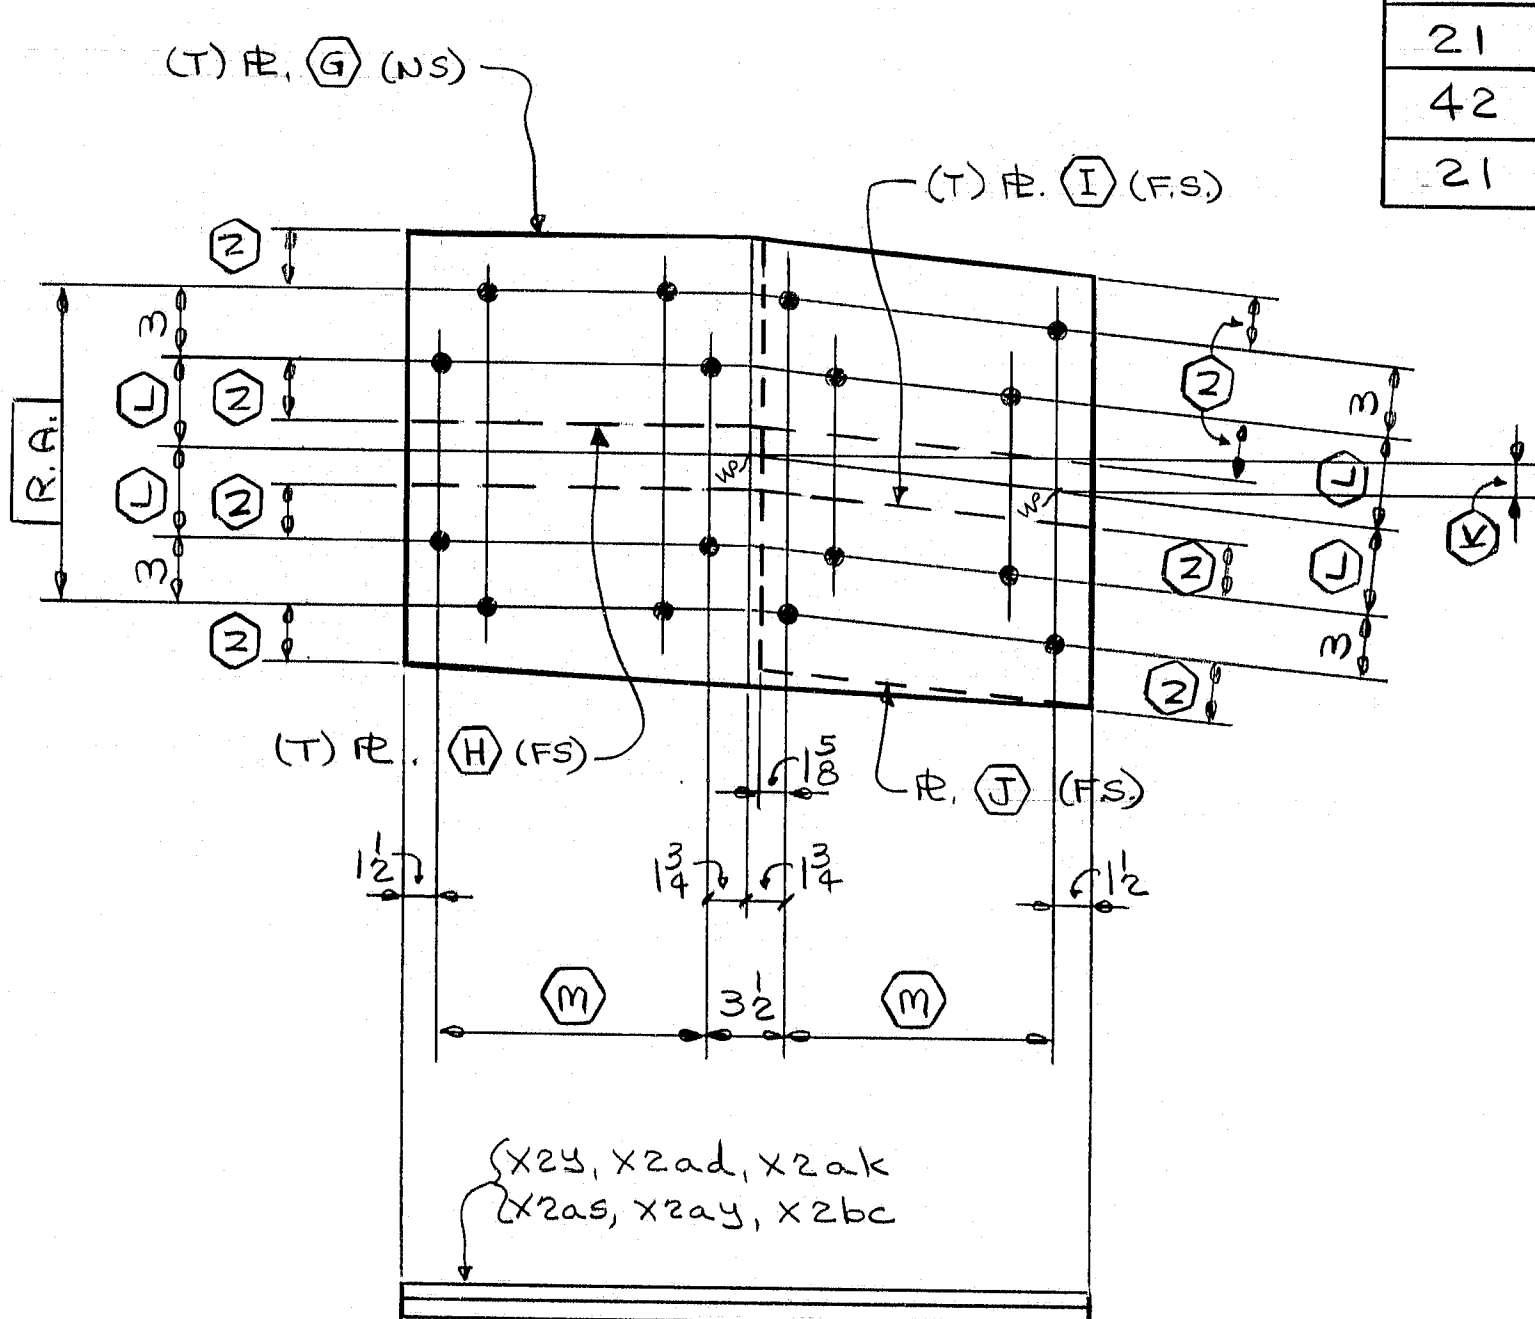


X2aa, X2ab, X2af, X2ag  
 X2am, X2an, X2at, X2aw  
 X2ba, X2bb, X2bd, X2bf

SEE SCHEDULE C RIGHT

REQ'D.	MK.	(A)	(B)	(C)	(D)	(E)	(F)
21	X2c	$19 \times 16 \times 2'-0" \div 2$ $\frac{3}{26}$	—	—	8	2 $\frac{1}{2}$	$6 \phi 2 = 1'-0$
42	X2d	—	$8 \times 8 \times 2'-0" \div 2$ $\frac{3}{20}$	—	—	2 $\frac{1}{2}$	$6 \phi 2 = 1'-0$
8	X2f	—	—	$19 \times 16 \times 1'-3 \div 8$ $\frac{3}{13}$	8	2 $\frac{1}{2}$	$6 \phi 2 = 1'-0$
21	X2g	$15 \times 16 \times 1'-10 \div 2$ $\frac{3}{28}$	—	—	6	1 $\frac{1}{2}$	$4 \phi 2 = 8$
42	X2h	—	$6 \times 8 \times 1'-10 \div 2$ $\frac{3}{23}$	—	—	1 $\frac{1}{2}$	$4 \phi 2 = 8$
21	X2k	—	—	$15 \times 4 \times 0'-11 \div 8$ $\frac{3}{12}$	6	1 $\frac{1}{2}$	$4 \phi 2 = 8$

REQ'D.	MK.	(G)	(H)	(I)	(J)	(K)	(L)	(M)	(N)
ONE	X2y	$15 \times 16 \times 1'-10 \div 2$ $\frac{3}{27}$	—	—	—	1 $\frac{1}{8}$	3	$4 \phi 2 = 8$	1 $\frac{1}{2}$
	X2aa	—	$6 \times 6 \times 4 \times 1'-10 \div 2$ $\frac{3}{21}$	—	—	1 $\frac{1}{8}$	3	—	—
	X2ab	—	—	$6 \times 6 \times 4 \times 1'-10 \div 2$ $\frac{3}{21}$	—	1 $\frac{1}{8}$	3	—	—
	X2ac	—	—	—	$15 \times 4 \times 0'-11 \div 8$ $\frac{3}{11}$	1 $\frac{1}{8}$	3	—	—
	X2ad	$15 \times 16 \times 1'-10 \div 2$ $\frac{3}{27}$	—	—	—	1 $\frac{1}{4}$	3	—	—
	X2af	—	$6 \times 6 \times 4 \times 1'-10 \div 2$ $\frac{3}{21}$	—	—	1 $\frac{1}{4}$	3	—	—
	X2ag	—	—	$6 \times 6 \times 4 \times 1'-10 \div 2$ $\frac{3}{21}$	—	1 $\frac{1}{4}$	3	—	—
	X2ah	—	—	—	$15 \times 4 \times 0'-11 \div 8$ $\frac{3}{11}$	1 $\frac{1}{4}$	3	—	—
	X2ak	$15 \times 16 \times 1'-10 \div 2$ $\frac{3}{27}$	—	—	—	1 $\frac{1}{4}$	3	—	—
	X2am	—	$6 \times 6 \times 4 \times 1'-10 \div 2$ $\frac{3}{21}$	—	—	1 $\frac{1}{4}$	3	—	—
	X2an	—	—	$6 \times 6 \times 4 \times 1'-10 \div 2$ $\frac{3}{21}$	—	1 $\frac{1}{4}$	3	—	—
	X2ap	—	—	—	$15 \times 4 \times 0'-11 \div 8$ $\frac{3}{11}$	1 $\frac{1}{4}$	3	—	—
	X2as	$19 \times 16 \times 2'-0" \div 2$ $\frac{3}{25}$	—	—	—	1 $\frac{1}{4}$	3	$4 \phi 2 = 8$	1 $\frac{1}{2}$
	X2at	—	$8 \times 8 \times 2'-0" \div 2$ $\frac{3}{19}$	—	—	1 $\frac{1}{4}$	3	$6 \phi 2 = 1'-0$	2 $\frac{1}{2}$
	X2aw	—	—	$8 \times 8 \times 2'-0" \div 2$ $\frac{3}{19}$	—	1 $\frac{1}{4}$	3	—	—
	X2ay	$19 \times 16 \times 2'-0" \div 2$ $\frac{3}{25}$	—	—	—	1 $\frac{1}{4}$	3	—	—
	X2ba	—	$8 \times 8 \times 2'-0" \div 2$ $\frac{3}{19}$	—	—	1 $\frac{1}{4}$	3	—	—
	X2bb	—	—	$8 \times 8 \times 2'-0" \div 2$ $\frac{3}{19}$	—	1 $\frac{1}{4}$	3	—	—
	X2bc	$19 \times 16 \times 2'-0" \div 2$ $\frac{3}{25}$	—	—	—	1 $\frac{1}{4}$	3	—	—
	X2bd	—	$8 \times 8 \times 2'-0" \div 2$ $\frac{3}{19}$	—	—	1 $\frac{1}{4}$	3	—	—
ONE	X2bf	—	—	$8 \times 8 \times 2'-0" \div 2$ $\frac{3}{19}$	—	1 $\frac{1}{4}$	3	$6 \phi 2 = 1'-0$	2 $\frac{1}{2}$

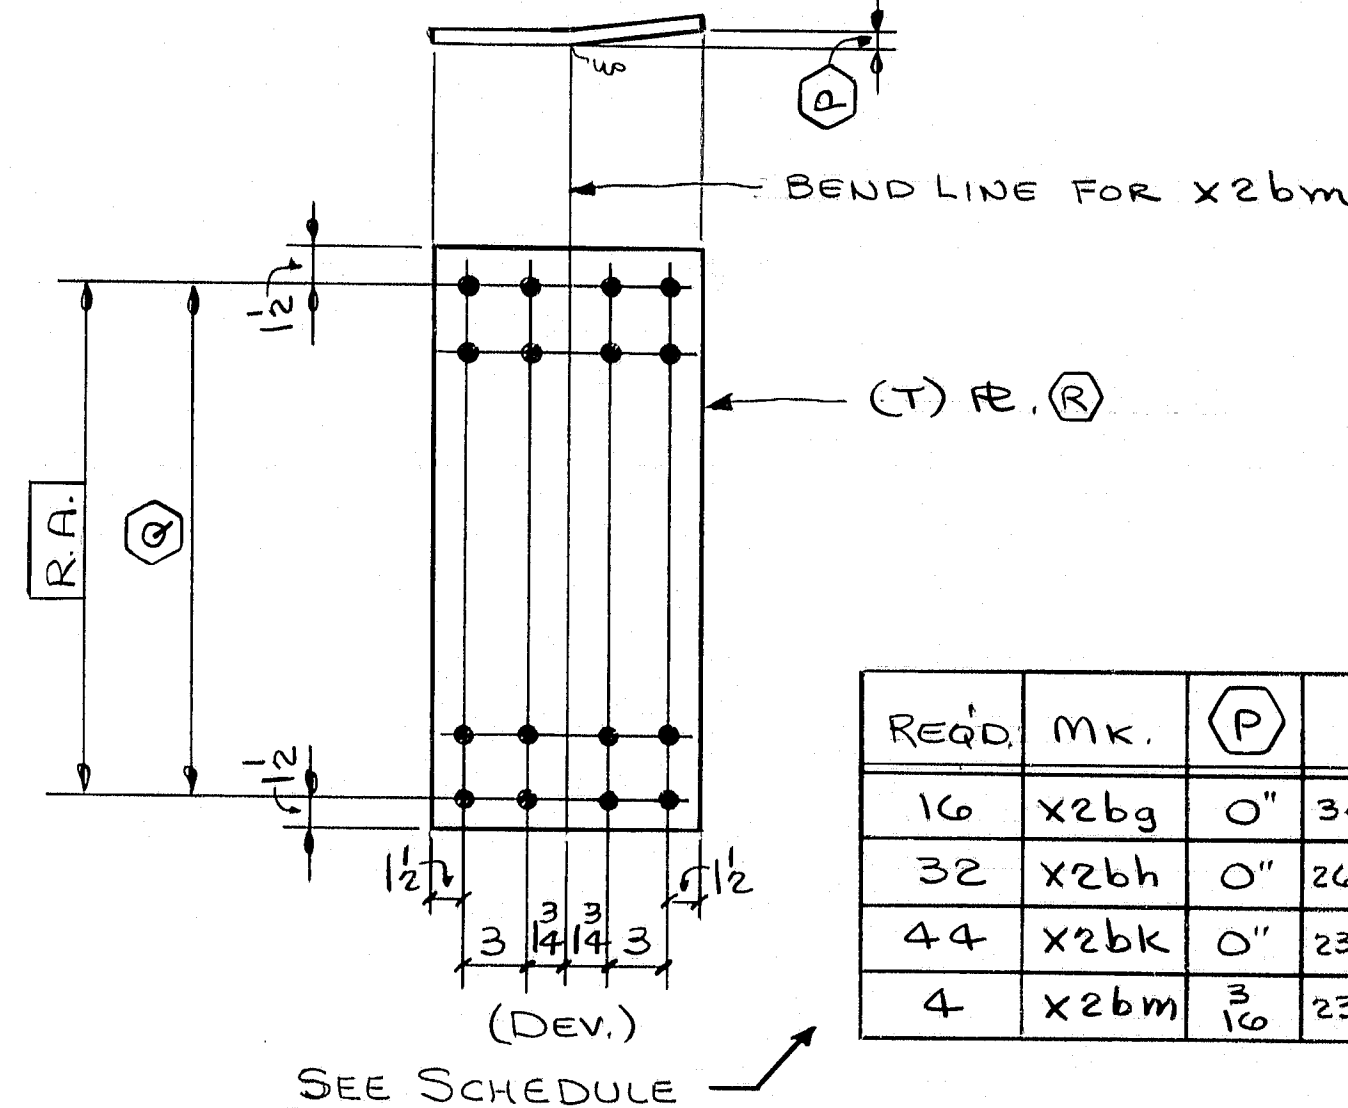

SHOP NOTE  
 HOLES: [R.A.]  
 BOLTS: NONE  
 PAINT: NONE

FOR GENERAL NOTES SEE DWG. N1.  
 ALL STEEL TO BE A.S.T.M. A 588.  
 (T) INDICATES CHARPY V-NOTCH TEST REQ'D

R95-173

REQ'D.	MK.	(P)	(Q)	(R)
16	X2bg	0"	$34 \phi 3 = 8'-6$	$105 \times 2 \times 1'-0 \div 2$ $\frac{3}{5}$
32	X2bh	0"	$26 \phi 4 = 8'-8$	$107 \times 2 \times 1'-0 \div 2$ $\frac{3}{2}$
44	X2bk	0"	$23 \phi 4 \div 2 = 8'-7 \frac{1}{2}$	$106 \times 2 \times 1'-0 \div 2$ $\frac{3}{3}$
4	X2bm	$\frac{3}{10}$	$23 \phi 4 \div 2 = 8'-7 \frac{1}{2}$	$106 \times 2 \times 1'-0 \div 2$ $\frac{3}{4}$



NO.	REVISION	DATE
HIGH STEEL STRUCTURES, INC.		
1905 Old Philadelphia Pike Lancaster, Pennsylvania 17603 Phone 717/299-8211		
A Subsidiary of High Industries, Inc.		
JOB STANDARDS		
I-395 BRIDGE OVER PENOBSCOT RIVER		
I-395 BRIDGE STA. 164+60.00		
PENOBSCOT COUNTY		
STATE OF MAINE		
DEPARTMENT OF TRANSPORTATION		
STATE CONTRACT OR REF. NO.	CONTRACTOR	DATE
6	CIANBRO CORP.	
IN CHARGE:	MADE BY:	CHK'D BY:
HINKLE	G.F.F.	J.L.C.
CONTRACT ME-84088-3	DRAWING NUMBER:	DATE: 9-21-84
		X2






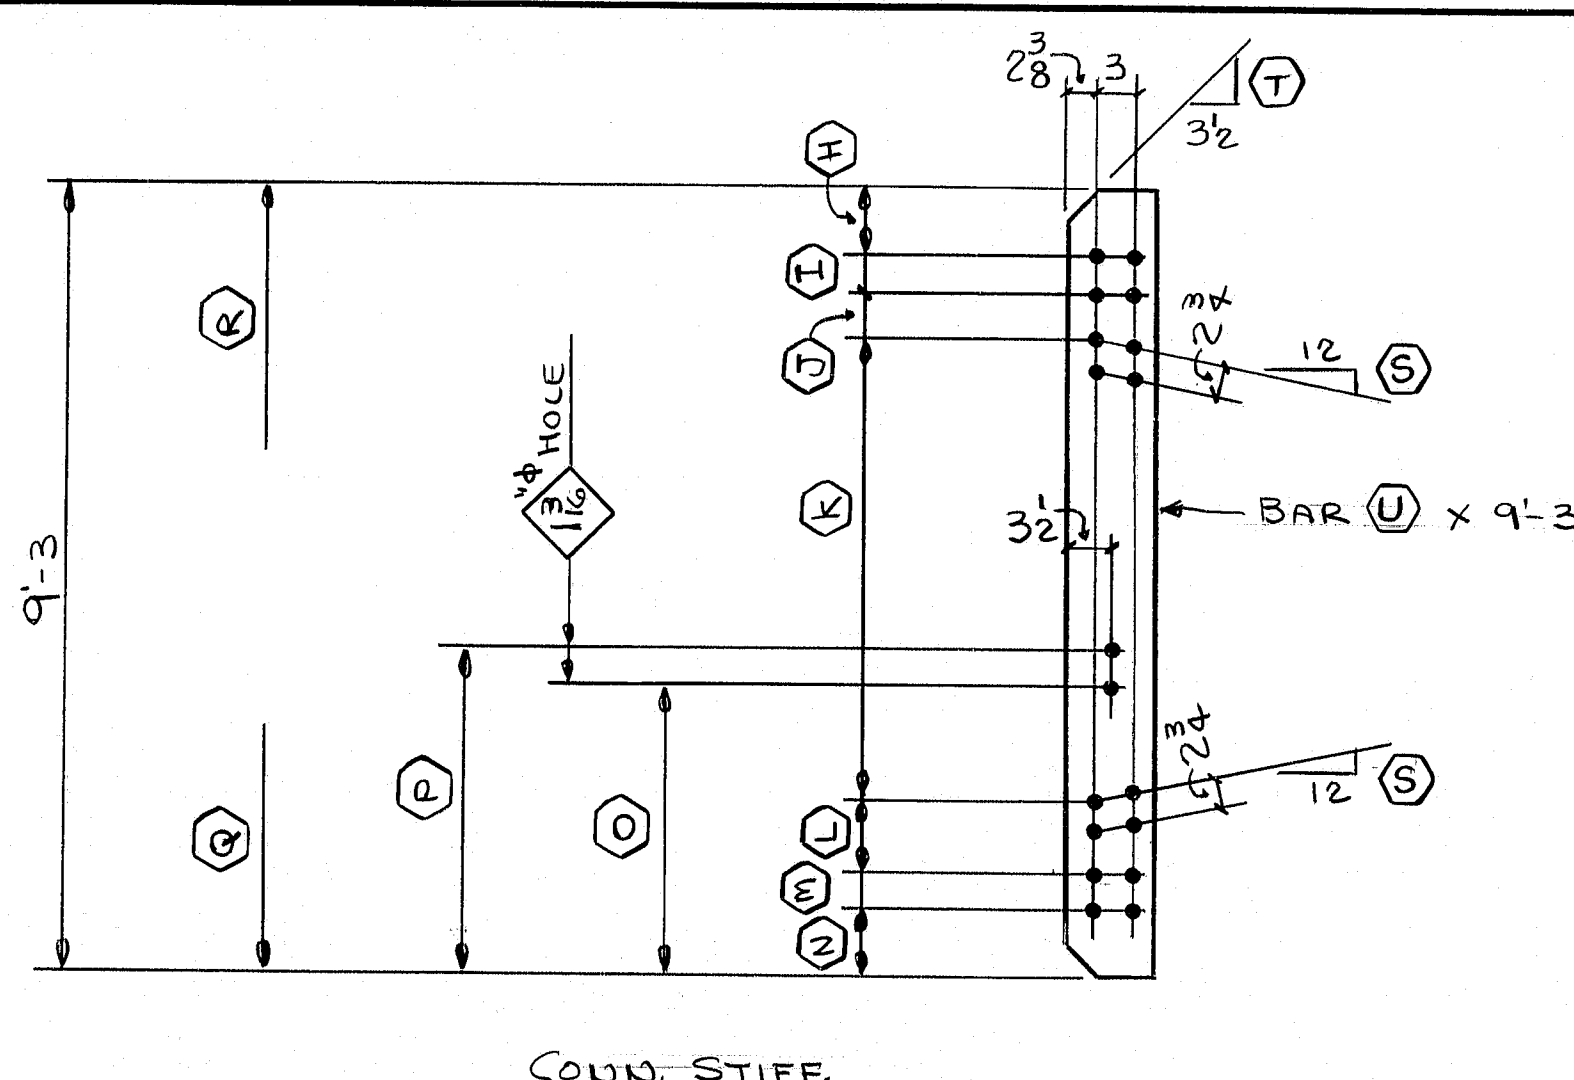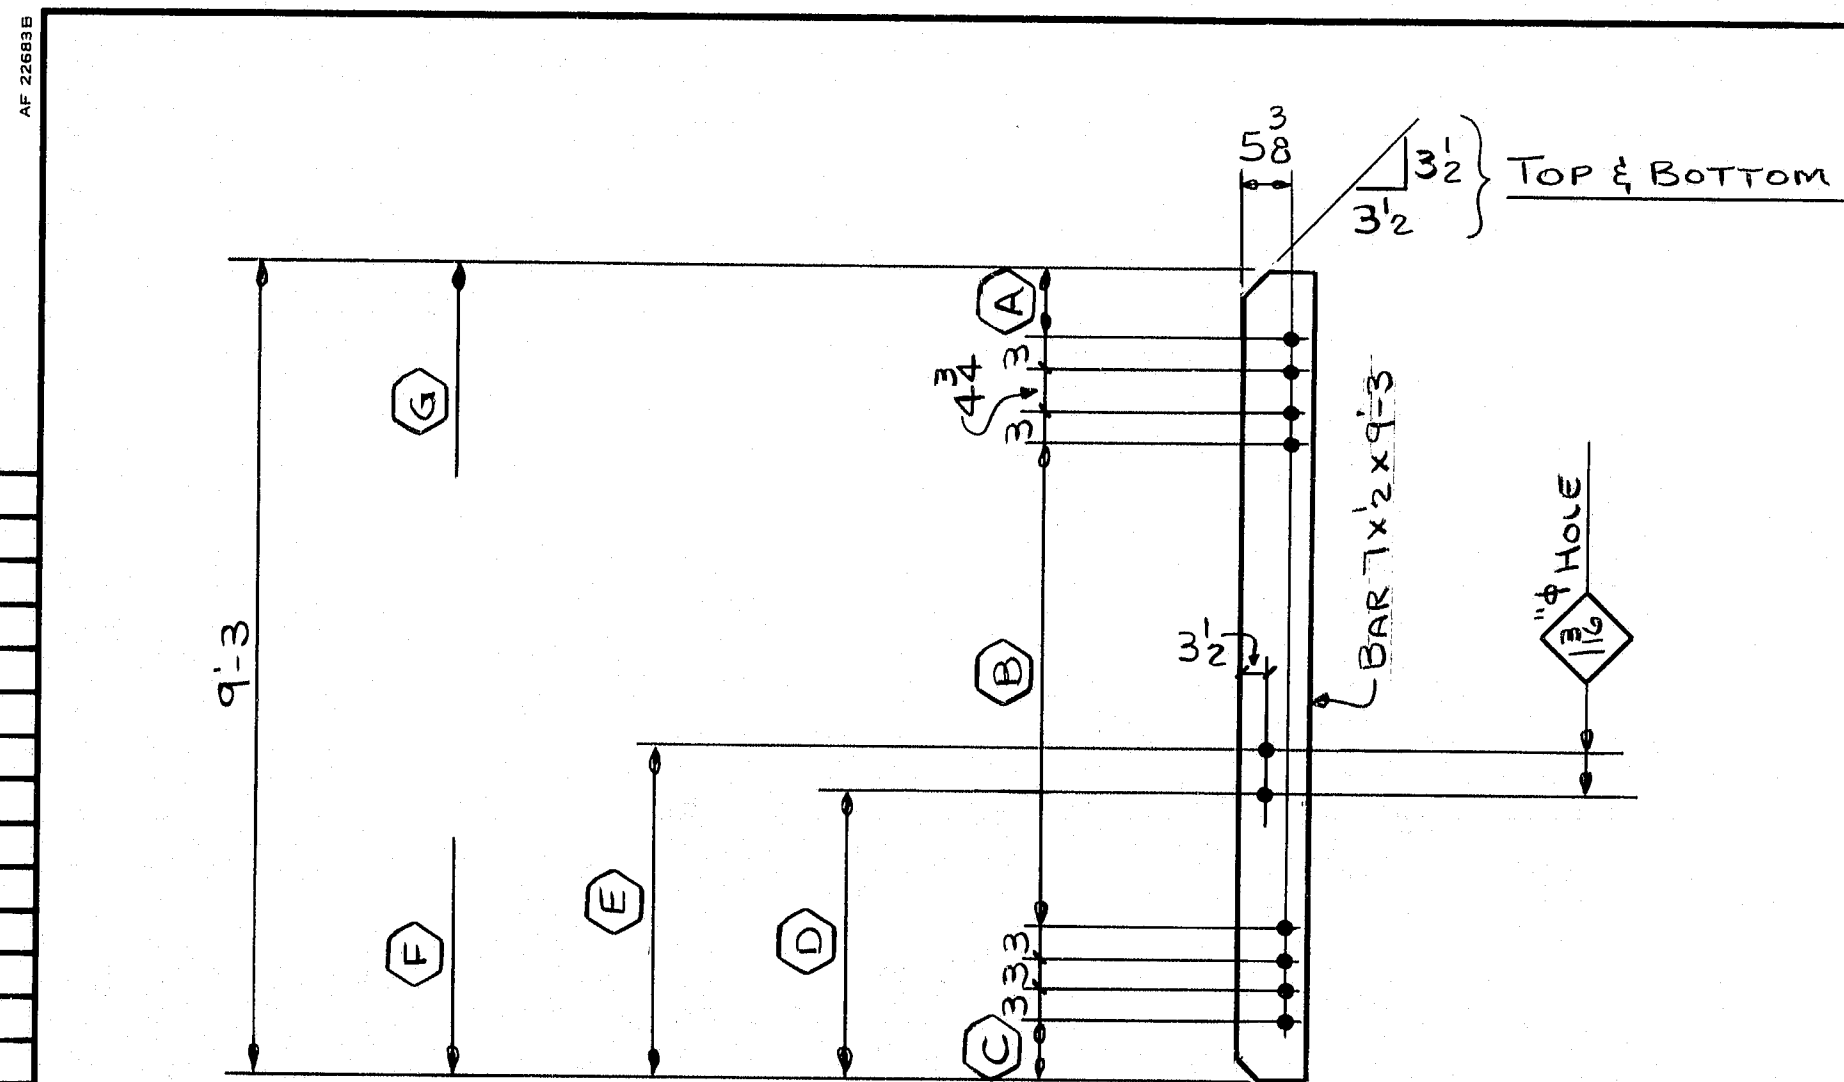

REQD.	MK.	A	B	C	D	E	F	G	Item
2	X3b	6b	6'-11 1/8"	10'-3 1/8"	3'-6"	3'-9"	TIGHT FIT	TIGHT FIT	3
6	X3d		6'-0 3/4"	1'-0"	3'-6"	3'-9"			3
2	X3g		6'-11 1/8"	10'-3 1/8"	3'-6"	3'-9"			3
2	X3k		6'-0 3/4"	1'-0"	3'-6"	3'-9"			3
2	X3m		6'-4 1/4"	8'-2"	-	-	TIGHT FIT		3
2	X3p		6'-11 1/8"	10'-3 1/8"	3'-6"	3'-9"			3
4	X3t		6'-0 3/4"	1'-0"	3'-6"	3'-9"			3
ONE	X3w		6'-4 1/4"	8'-2"	-	-			3
14	X3gd		6'-4 1/4"	8'-2"	3'-6"	3'-9"	TIGHT FIT		3
7	X3gp	6b	6'-4 1/4"	8'-2"	3'-6"	3'-9"	TIGHT FIT		3

REQD.	MK.	H	I	J	K	L	M	N	O	P	Q	R	S	T	U
4	X3y	9 5/8	2 3/4	4 7/8	6'-2 1/2	7'-6"	2 3/4	8 5/8	-	3'-9"	TIGHT FIT	TIGHT FIT	5 1/2	4 1/2	7x1 1/2 3/4
4	X3aa	6b			6'-2 1/2			1'-0 1/2	-				5 1/2		
2	X3ab	8 1/2			6'-3 1/2			8 5/8	-				5 1/2		
2	X3ac	6b	2 3/4	4 7/8	6'-3 1/2	7'-6"	2 3/4	10 1/2	-	3'-9"			5 1/2		
ONE	X3ad	5	5	5 1/4	6'-3	9'-4"	3	8 1/2	-				5 1/2		7x1 1/2 3/4
ONE	X3ae	5	5	5 1/4	6'-3	9'-4"	3	8 1/2	-				5 1/2		7x1 1/2 3/4
2	X3af	9 1/2	2 3/4	4 7/8	6'-2 1/2	7'-6"	2 3/4	8 5/8	-	3'-9"			5 1/2		
	X3ag	6b			6'-2 1/2			1'-0	-				5 1/2		
	X3ah	8 1/2			6'-3 1/2			8 5/8	-				5 1/2		
	X3ai	6b			6'-3 1/2			10 1/2	-				5 1/2		
	X3aj	9 5/8			6'-2 1/2			8 5/8	-				5 1/2		
2	X3an	6b	2 3/4	4 7/8	6'-2 1/2	7'-6"	2 3/4	1'-0 1/2	-	3'-9"			5 1/2		
ONE	X3ao	5	5	5 1/4	6'-3	9'-4"	3	8 1/2	-		TIGHT FIT		5 1/2		3/4
ONE	X3ap	5	5	5 1/4	6'-3	9'-4"	3	8 1/2	-				5 1/2		3/4
8	X3as	9 5/8	2 3/4	4 7/8	6'-2 1/2	7'-6"	2 3/4	8 5/8	3'-6"	3'-9"			5 1/2		
8	X3at	6b			6'-2 1/2			1'-0 1/2	-				5 1/2		
4	X3aw	8 1/2			6'-3 1/2			8 5/8	-				5 1/2		
4	X3ay	6b	2 3/4	4 7/8	6'-3 1/2	7'-6"	2 3/4	10 1/2	3'-6"	3'-9"			5 1/2		
2	X3ba	5	5	5 1/4	6'-3	9'-4"	3	8 1/2	-				5 1/2		3/4
2	X3bb	9 5/8	2 3/4	4 7/8	6'-2 1/2	7'-6"	2 3/4	8 5/8	3'-6"	3'-9"	TIGHT FIT		5 1/2		3/10
12	X3bc	6b			6'-2 1/2			1'-0 1/2	-				5 1/2		
6	X3bd	8 1/2			6'-3 1/2			8 5/8	-				5 1/2		
6	X3bf	6b	2 3/4	4 7/8	6'-3 1/2	7'-6"	2 3/4	10 1/2	3'-6"	3'-9"			5 1/2		
3	X3bg	5	5	5 1/4	6'-3	9'-4"	3	8 1/2	-				5 1/2		3/10
3	X3bh	5	5	5 1/4	6'-3	9'-4"	3	8 1/2	-				5 1/2		3/10
6	X3bi	9 5/8	2 3/4	4 7/8	6'-2 1/2	7'-6"	2 3/4	8 5/8	3'-6"	-			5 1/2		3/4
6	X3bj	6b			6'-2 1/2			1'-0 1/2	-				5 1/2		
2	X3bm	8 1/2			6'-3 1/2			8 5/8	-				5 1/2		
2	X3bn	6b	2 3/4	4 7/8	6'-3 1/2	7'-6"	2 3/4	10 1/2	3'-6"	-			5 1/2		
5	X3bp	5	5	5 1/4	6'-3	9'-4"	3	8 1/2	-				5 1/2		
2	X3bq	5	5	5 1/4	6'-3	9'-4"	3	8 1/2	-				5 1/2		
10	X3bs	9 5/8	2 3/4	4 7/8	6'-2 1/2	7'-6"	2 3/4	8 5/8	3'-6"	3'-9"			5 1/2		
10	X3bt	6b			6'-2 1/2			1'-0 1/2	-				5 1/2		
4	X3bw	8 1/2			6'-3 1/2			8 5/8	-				5 1/2		
4	X3by	6b	2 3/4	4 7/8	6'-3 1/2	7'-6"	2 3/4	10 1/2	3'-6"	3'-9"			5 1/2		
ONE	X3ca	5 1/4	5	5 1/4	6'-2 1/2	9'-4"	3	8 1/2	3'-6"	-			5 1/2		
ONE	X3cb	5 1/4	5	5 1/4	6'-2 1/2	9'-4"	3	8 1/2	3'-6"	-			5 1/2		
12	X3cc	9 5/8	2 3/4	4 7/8	6'-2 1/2	7'-6"	2 3/4	8 5/8	-	3'-9"			5 1/2		
12	X3cd	6b			6'-2 1/2			1'-0 1/2	-				5 1/2		
5	X3ce	8 1/2			6'-3 1/2			8 5/8	-				5 1/2		
5	X3cf	6b	2 3/4	4 7/8	6'-3 1/2	7'-6"	2 3/4	10 1/2	-	3'-9"			5 1/2		
2	X3cg	5	5	5 1/4	6'-2 1/2	9'-4"	3	8 1/2	-		TIGHT FIT		5 1/2	3 1/2	7x2 3/4
2	X3ch	5	5	5 1/4	6'-3	9'-4"	3	8 1/2	-	3'-9"		TIGHT FIT	5 1/2	3 1/2	7x2 3/4

REQD.	MK.	H	I	J	K	L	M	N	O	P	Q	R	S	T	U
12	X3ch	9 5/8	2 3/4	4 7/8	6'-2 1/2	7'-6"	2 3/4	8 5/8	3'-6"	-	-	TIGHT FIT	5 1/2	3 1/2	7x2 3/4
12	X3ck	6b			6'-2 1/2			1'-0 1/2	-	-	-		5 1/2		
2	X3cm	8 1/2			6'-3 1/2			8 5/8	-	-	-		5 1/2		
2	X3cn	6b	2 3/4	4 7/8	6'-3 1/2	7'-6"	2 3/4	10 1/2	3'-6"	-	-				
5	X3cp	5	5	5 1/4	6'-3	9'-4"	3	8 1/2	3'-6"	-	-				
3	X3cq	5	5	5 1/4	6'-3	9'-4"	3	8 1/2	3'-6"	-	-				
4	X3cs	8 1/2	2 3/4	4 7/8	6'-3 1/2	7'-6"	2 3/4	8 5/8	3'-6"	-	-		5 1/2		
4	X3ct	6b			6'-3 1/2			11 1/2	3'-6"	-	-		5 1/2		
8	X3cw	9 5/8			6'-2 1/2			8 5/8	-	3'-9"	-		5 1/2		
8	X3cy	6b			6'-2 1/2			1'-0 1/2	-	-	-		5 1/2		
2	X3da	8 1/2			6'-3 1/2			8 5/8	-	-	-		5 1/2		
	X3db	6b			6'-3 1/2			10 1/2	-	-	-				
	X3dc	8 1/2			6'-3 1/2			8 5/8	-	-	-				
	X3dd	6b	2 3/4	4 7/8	6'-3 1/2	7'-6"	2 3/4	11 1/2	-	3'-9"	-	TIGHT FIT	5 1/2		
	X3de	5b	5	5 1/4	6'-2 1/2	9'-4"	3	8 1/2	-	3'-9"	TIGHT FIT	-	5 1/2		
2	X3dg	5	5	5 1/4	6'-2 1/2	9'-4"	3	8 5/8	-	-	-		5 1/2		
ONE	X3dh	8 1/2	2 3/4	4 7/8	6'-3 1/2	7'-6"	2 3/4	8 5/8	3'-6"	-	-		5 1/2		
	X3dk	6b						11 1/2	-	-	-				
	X3dl	8 1/2						8 5/8	-	3'-9"	-				
	X3dm	8 1/2						11 1/2	3'-6"	-	-				
	X3dn	6b						11 1/2	3'-6"	-	-				
	X3dp	8 1/2						8 5/8	-	-	-				
	X3ds	6b			6'-3 1/2			11 1/2	-	3'-9"	-		5 1/2		
	X3dt	8 1/2			6'-3 1/2			8 5/8	3'-6"	-	-		5 1/2		
ONE	X3dw	6b			6'-3 1/2			10 1/2	-	-	-		5 1/2		
2	X3dy	9 5/8			6'-2 1/2			8 5/8	-	-	-		5 1/2		
2	X3fa	6b			6'-2 1/2			1'-0 1/2	-	-	-		5 1/2		
ONE	X3fb	8 5/8			6'-3 1/2			8 5/8	-	3'-9"	-		5 1/2		
	X3fc	6b			6'-3 1/2			10 1/2	-	-	-		5 1/2		
	X3fd	9 5/8			6'-2 1/2			8 5/8	-	-	-		5 1/2		
	X3fe	6b			6'-2 1/2			1'-0 1/2	-	-	-				
	X3ff	9 5/8			6'-2 1/2			8 5/8	-	-	-				
	X3fg	9 5/8			6'-2 1/2			8 5/8	-	-	-				
	X3fh	6b			6'-2 1/2			1'-0	3'-6"	-	-				
	X3fi	8 1/2			6'-3 1/2			8 5/8	-	-	-				
ONE	X3fm	6b			6'-3 1/2			10 1/2	-	-	-		5 1/2		
2	X3fn	9 1/2			6'-2 1/2			8 5/8	-	-	-		5 1/2		
2	X3fp	6b			6'-2 1/2			1'-0 1/2	-	-	-				
ONE	X3fs	8 1/2			6'-3 1/2			8 5/8	-	-	-				
ONE	X3ft	6b			6'-3 1/2			10 1/2	-	-	-		5 1/2		
2	X3fw	9 5/8			6'-2 1/2			8 5/8	-	-	-		5 1/2		
2	X3fx	6b	2 3/4	4 7/8	6'-2 1/2	7'-6"	2 3/4	1'-0 1/2	-	3'-9"	TIGHT FIT	-	5	3 1/2	7x2 3/4
2	X3gy	6b	2 3/4	4 7/8	6'-2 1/2	7'-6"	2 3/4	1'-0 1/2	-	3'-9"	TIGHT FIT	-	5	3 1/2	7x2 3/4
ONE	X3gz	5	5	5 1/4	6'-3	9'-4"	3	8 1/2	3'-6"	3'-9"	TIGHT FIT	-	5	3 1/2	7x2 3/4
ONE	X3gh	5	5	5 1/4	6'-3	9'-4"	3	8 1/2	3'-6"	3'-9"	TIGHT FIT	-	5	3 1/2	7x2 3/4

NO. 1 REVISION Construction joint moved DATE 11-19-84 NO. 2 REVISION CONTRACT REVISION CONTROL #14 DATE 9-13-84

SHOP NOTE  
HOLES: 1 1/2" (U.N.)  
BOLTS: NONE  
PAINT: NONE  
FOR GENERAL NOTES SEE DWG. N1.  
ALL STEEL TO BE A.S.T.M. A588.

R95-174  
CODE: 4000

HIGH STEEL STRUCTURES, INC.  
1905 Old Philadelphia Pike  
Lancaster, Pennsylvania 17603  
Phone 717/299-5211  
A Subsidiary of High Industries, Inc.

JOB STANDARDS  
I-395 BRIDGE OVER PENOBSCOT RIVER  
I-395 BRIDGE STA. 164+60.00  
PENOBSCOT COUNTY  
STATE OF MAINE  
DEPARTMENT OF TRANSPORTATION

STATE CONTRACT NO. 6 CONTRACTOR: CIANBRO CORP.  
IN CHARGE: HINKLE MADE BY: G.F.Z. CHK'D BY: J.L.C. DATE: 9-24-84  
CONTRACT NO. ME-84088-3 DRAWING NUMBER: X3











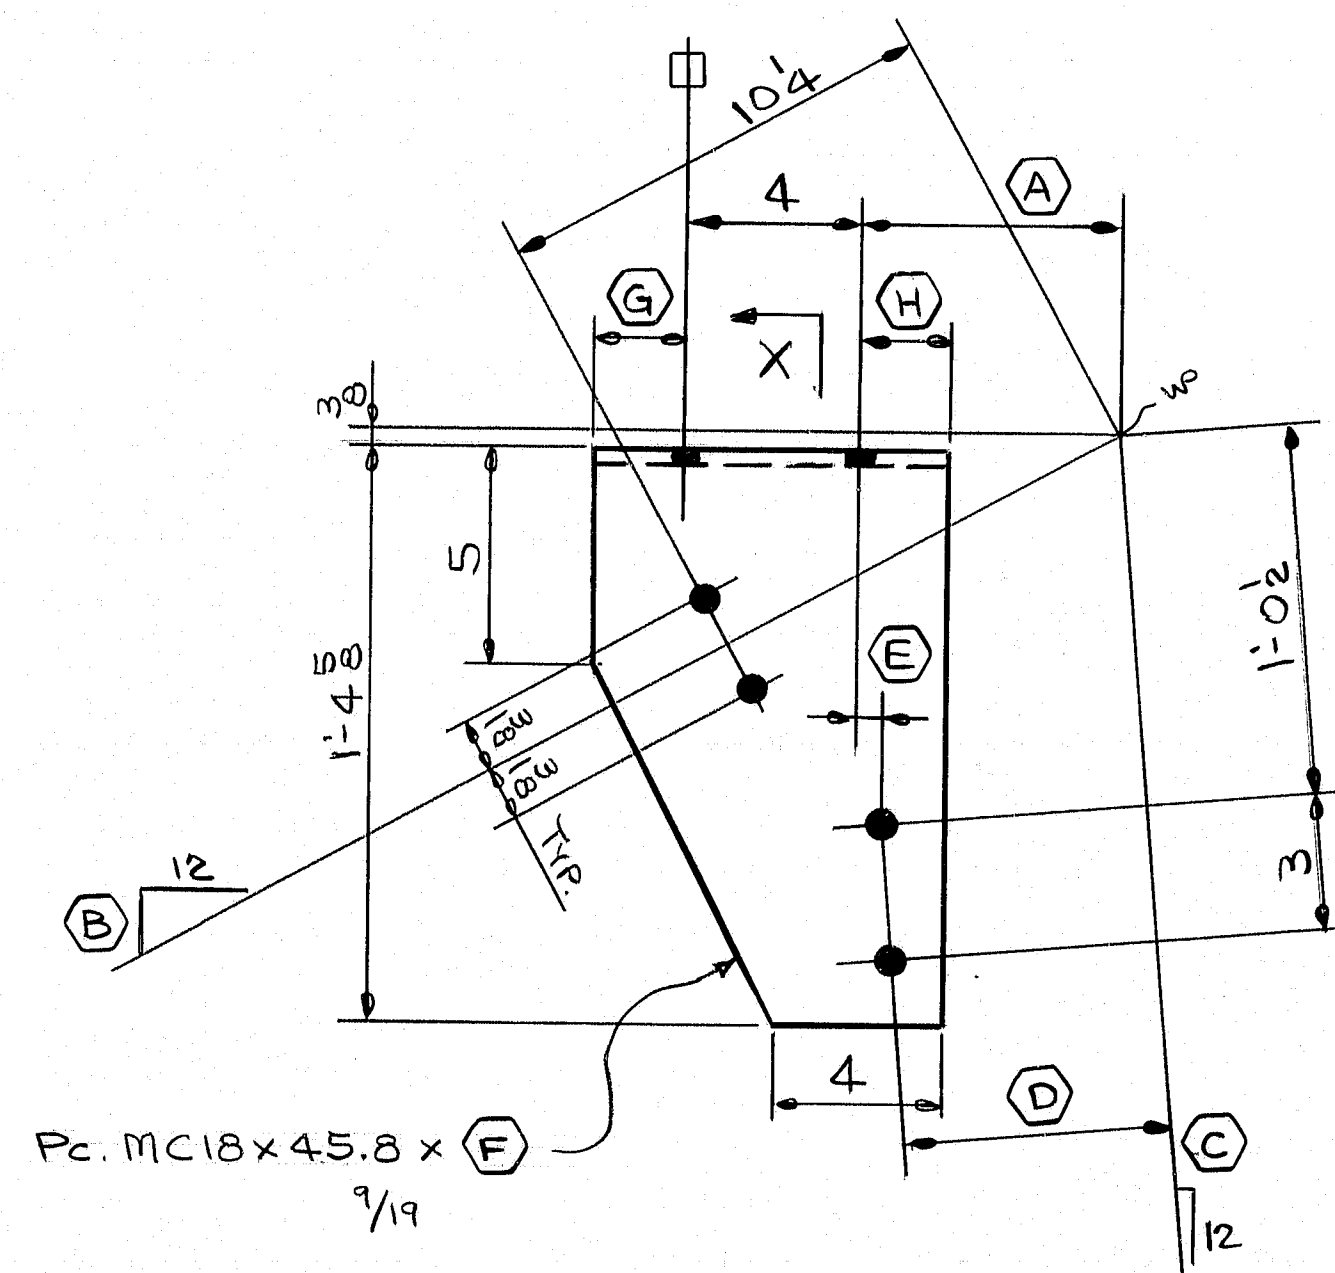


REQD.	MARK	A	B	C	D	E	F	G	H
5	X5a	4/8	7	0"	4/8	3/4	8/2	2/4	2/4
ONE	X5c	6/8	7/8	1/8	5/8	5/8	8/4	2	2/4
ONE	X5d	6/8	7/8	1/8	5/8	1/8	8/8	2	2/8
2	X5m	4/8	6/8	0"	3/8	7/8	8/8	2/8	2/8
2	X5n	7/8	0"	7/8	8/8	2/8	2/8		
ONE	X5p	7	0"	7/8	8/8	2/8			
ONE	X5s	4/8	7/8	1/8	3/8	1/8	9/8	2/8	3

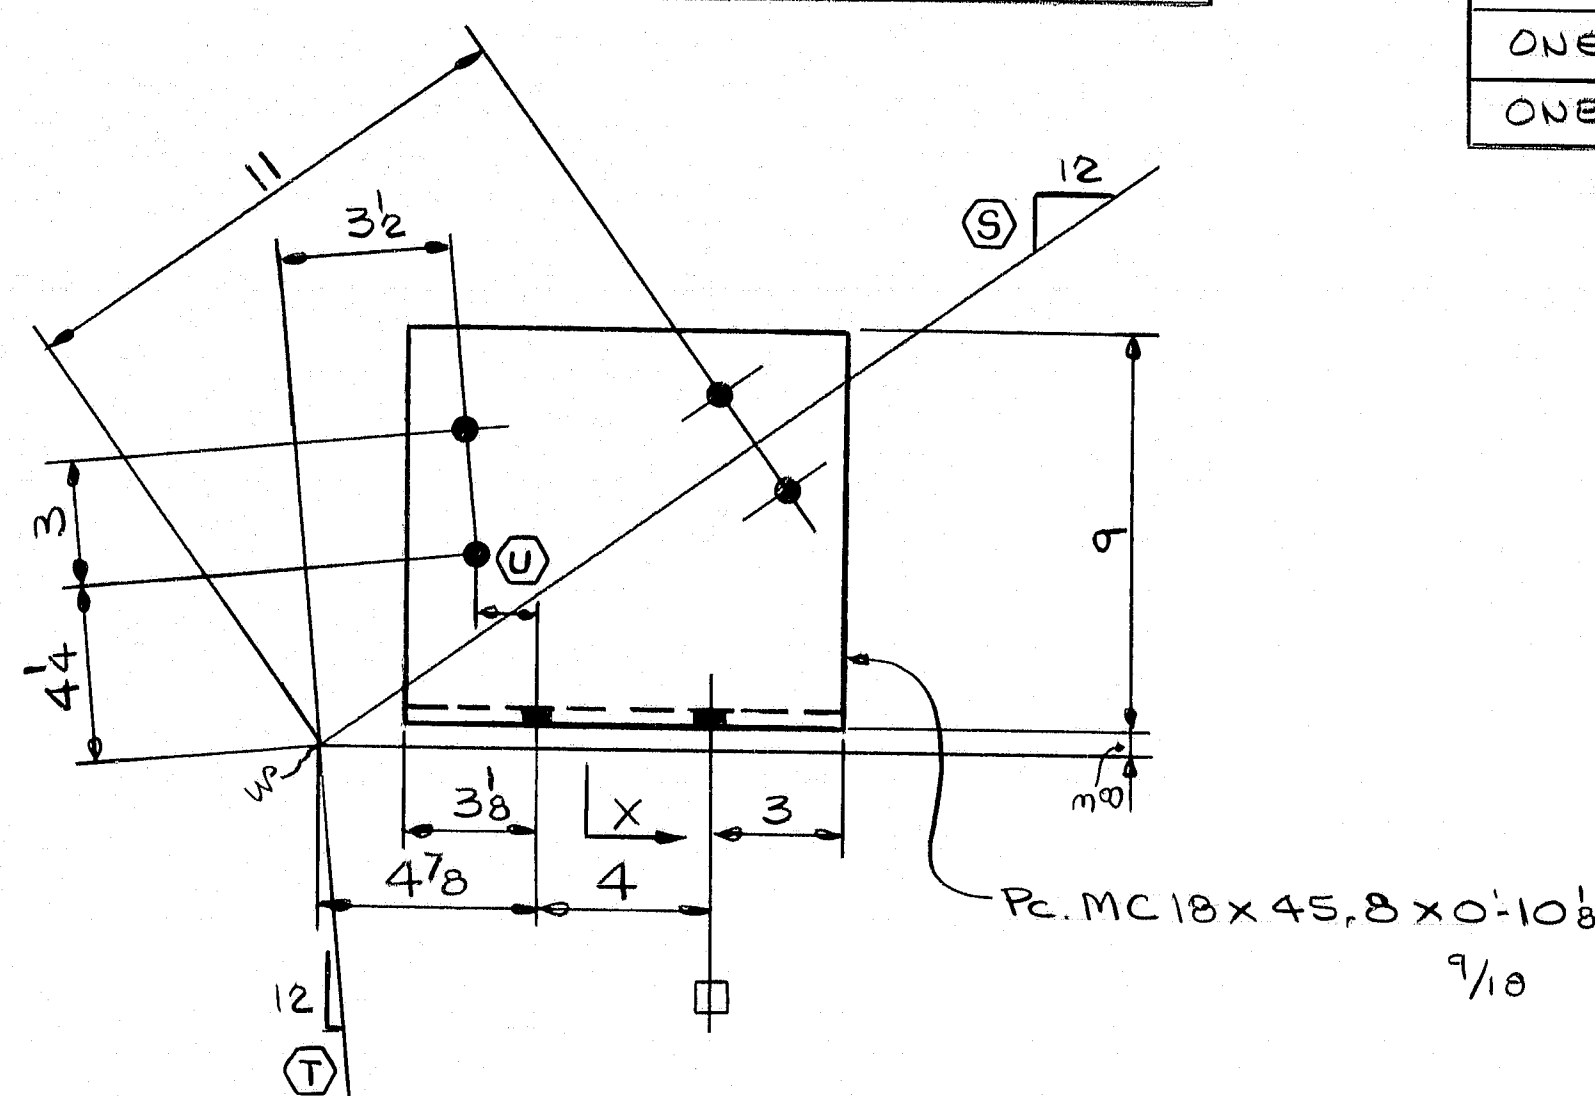


REQD.	MARK	S	T	U
ONE	X5ah	7/2	7/16	1/2
	X5ak	7/8		
	X5am	7/8		
	X5an	8/8	7/16	
	X5ap	8	5/16	1/2
ONE	X5as	8	8	1/16

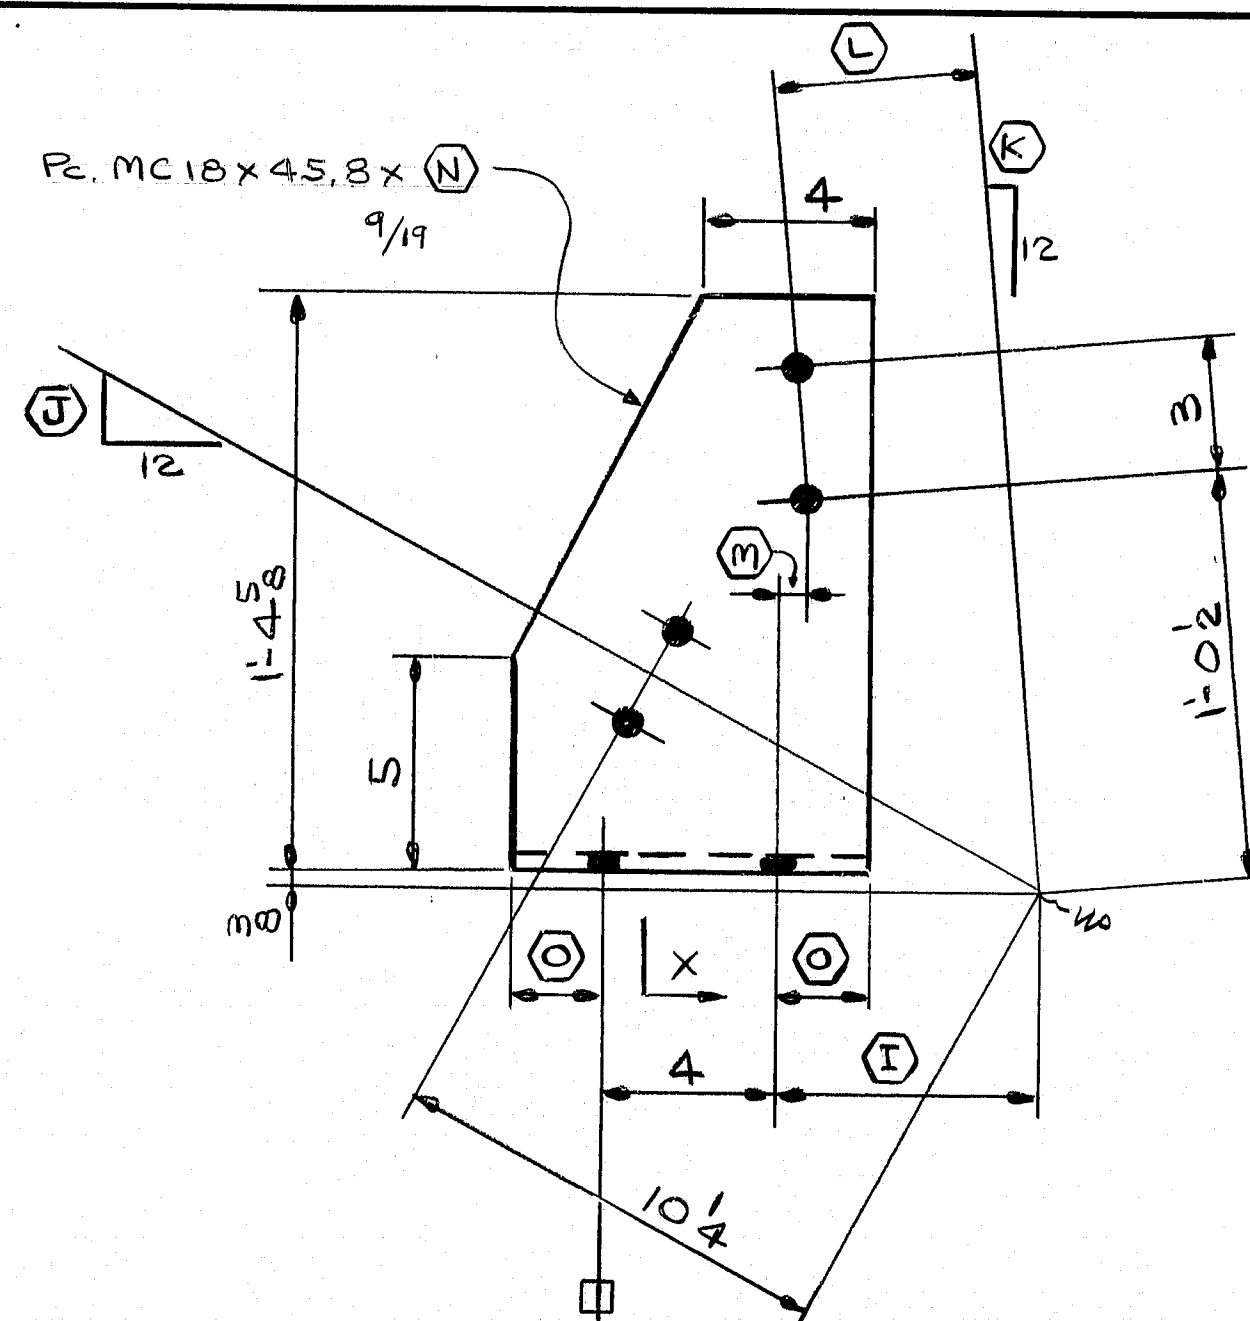

REQD.	MARK	I	J	K	L	M	N	O
3	X5b	4/8	7	0"	4/8	3/4	8/2	2/4
ONE	X5f	6/8	7/8	0"	5/8	1/2	8	2
	X5g	7/8	1/8	3/8				
	X5h	7/8	5/16	3/16				
ONE	X5k	6/8	7/2	1/6	5/8	1/6	8	2
2	X5t	4/8	6/8	0"	3/8	7/8	8/8	2/8
2	X5u	7/8	0"	7/8				
ONE	X5v	7	0"	7/8				
ONE	X5aa	4/8	7/8	5/16	3/8	9/16	8/8	2/8

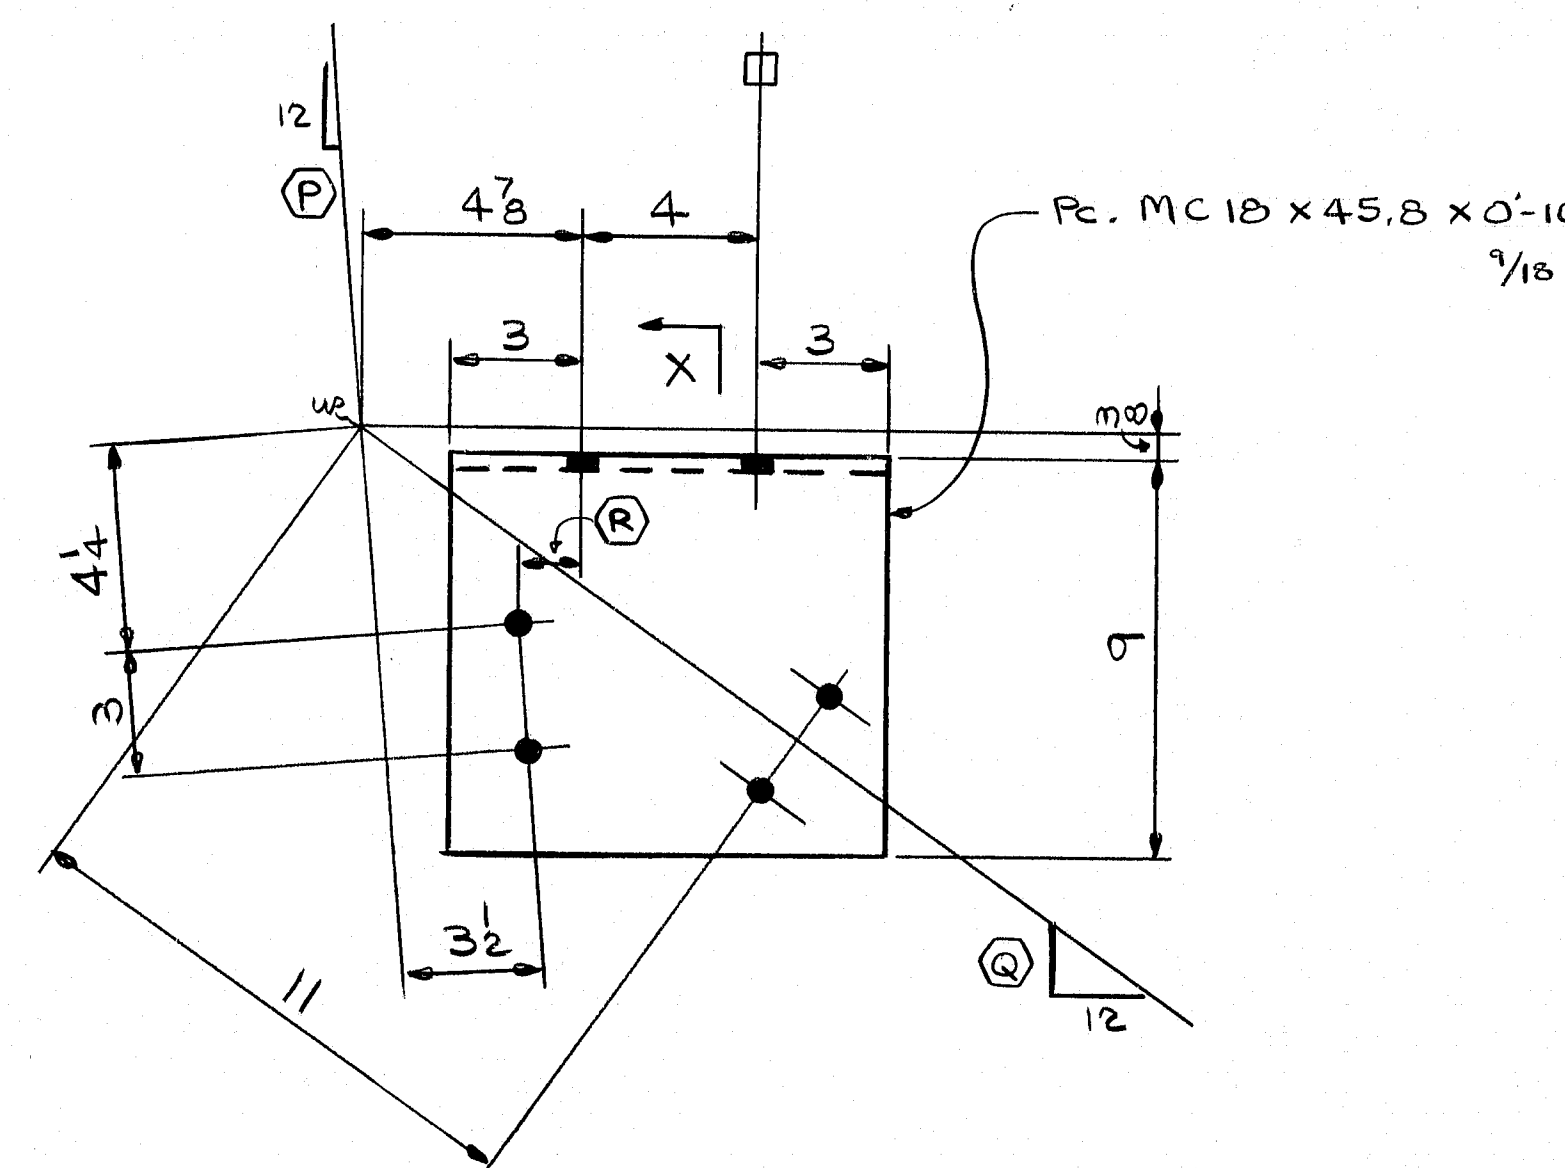

REQD.	MARK	P	Q	R
ONE	X5ab	5/16	7/4	1/4
	X5ac	7/8		
	X5ad	7/2		
	X5af	5/16	7/8	1/4
ONE	X5ag	1/8	7/8	1/16

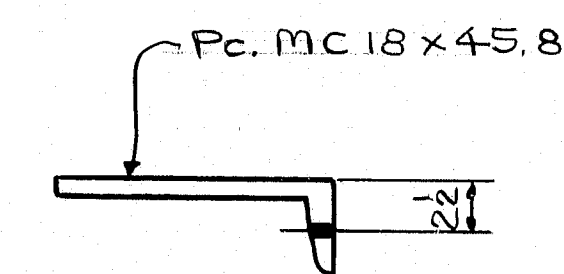

# SHOP NOTE

HOLES: 1 1/2"  $\phi$   
 BOLTS: NONE  
 PAINT: NONE


FOR GENERAL NOTES SEE DWG. N1.  
 ALL STEEL TO BE A.S.T.M. A588

**R95-176** CODE 4000

NO.	REVISION	DATE
HIGH STEEL STRUCTURES, INC. 1905 Old Philadelphia Pike Lancaster, Pennsylvania 17603 Phone 717/299-5211 A Subsidiary of High Industries, Inc.		
JOB STANDARDS		
I-395 BRIDGE OVER PENOBSCOT RIVER		
I-395 BRIDGE STA. 164 +60.00		
PENOBSCOT COUNTY		
STATE OF MAINE		
DEPARTMENT OF TRANSPORTATION		
STATE CONTRACT OR REF. NO.	CONTRACTOR	DATE
6	CIAMBRO CORP.	
IN CHARGE	CHK'D.	BY
HINKLE	G.F.Z.	JLC
CONTRACT NUMBER	DRAWING NUMBER	DATE
ME-84088-3	X5	9-24-84



FED. ROAD DIV. NO.	STATE	FED. AID PROJ. NO.
1	ME.	1-10-395-8(82)176

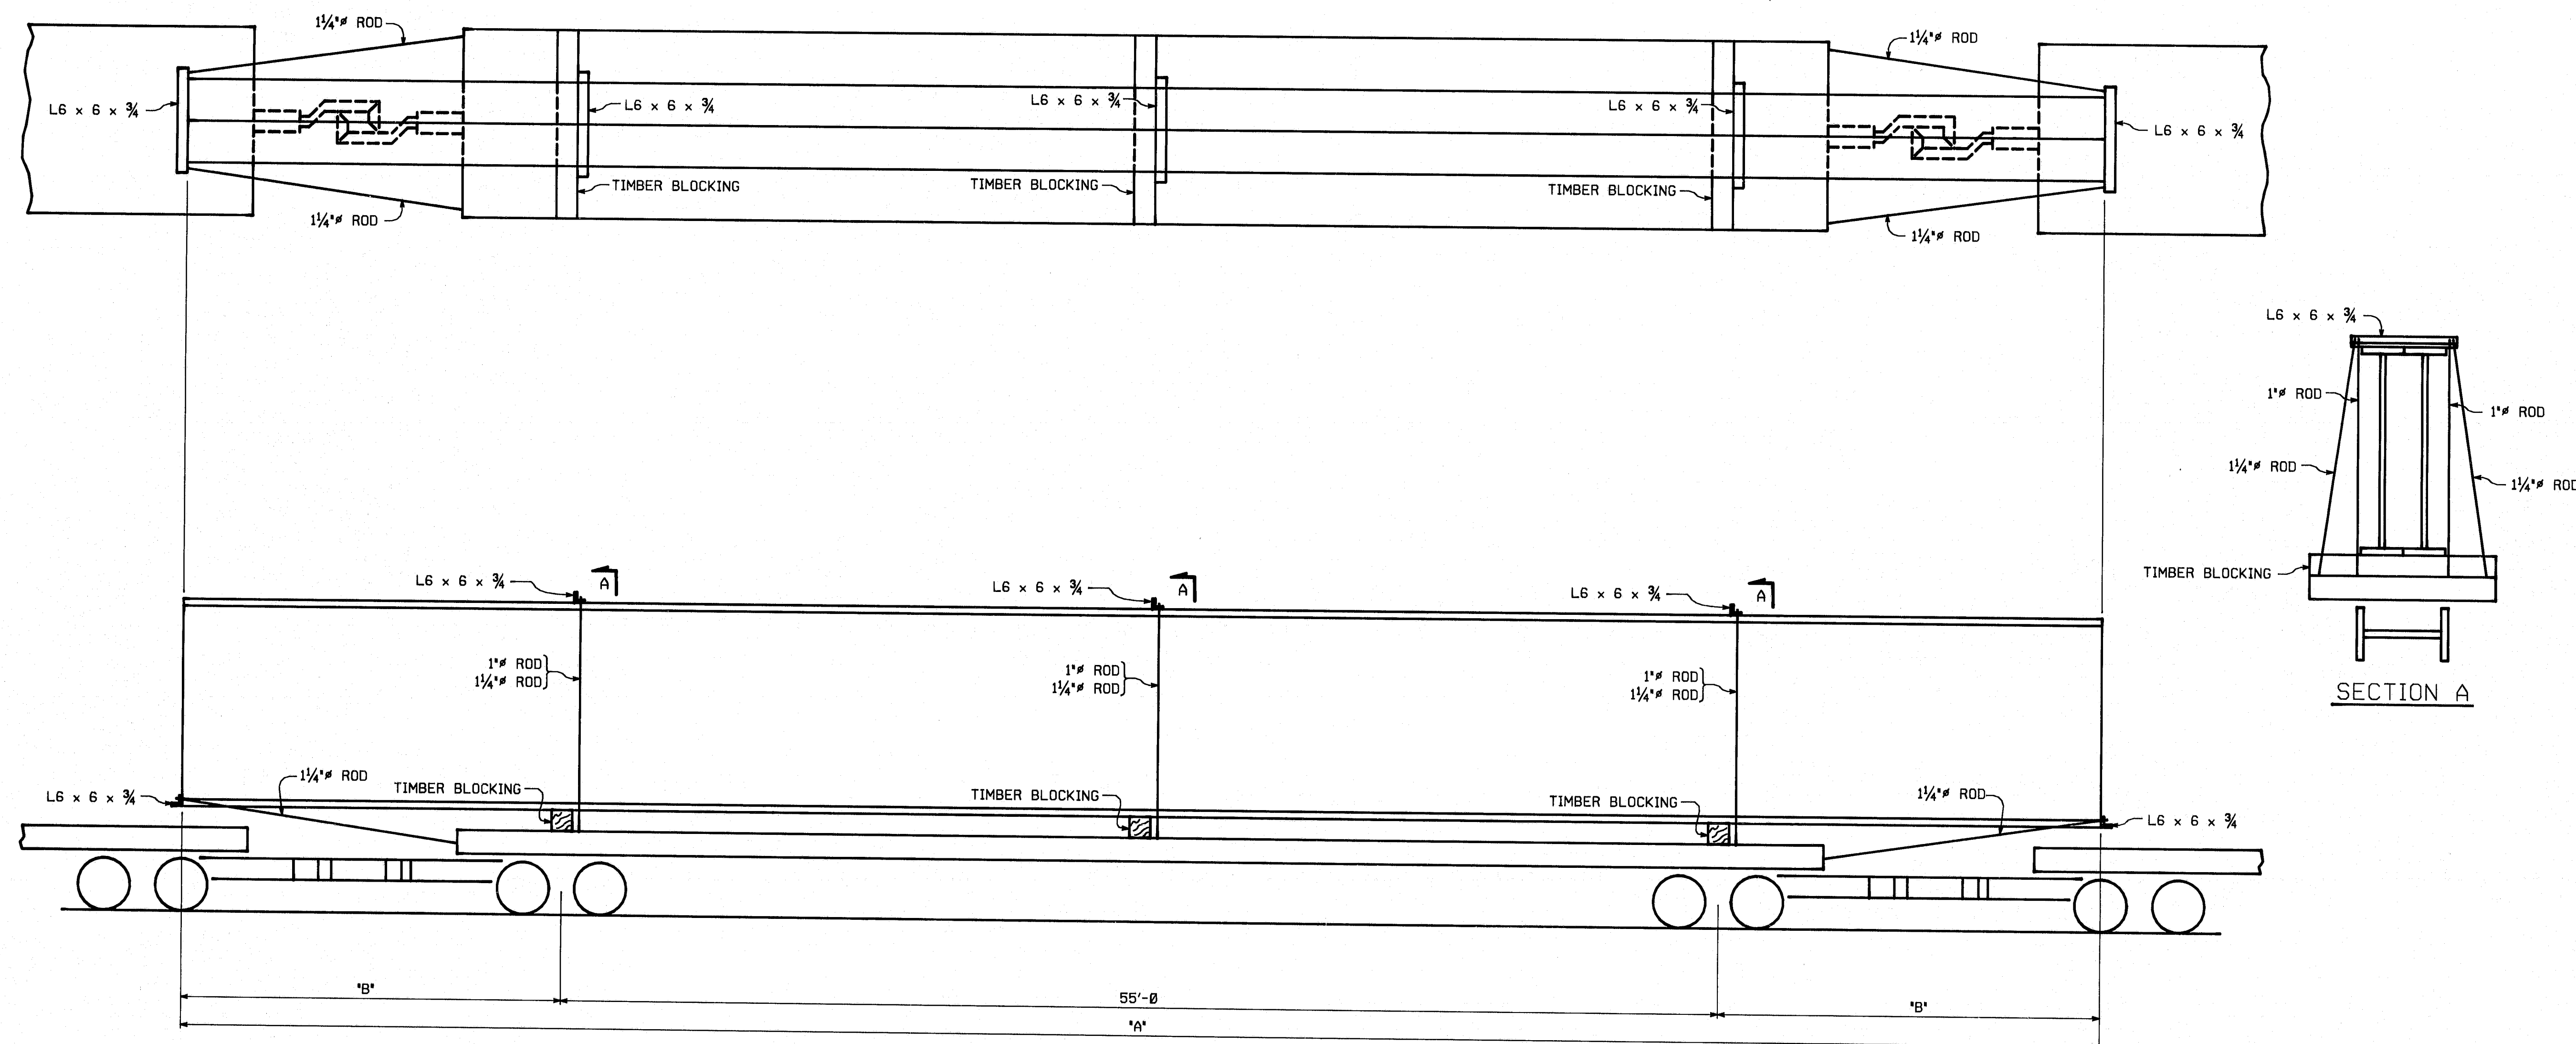

MARK	WEIGHT	"A"	"B"
G1L	74,975*	120'-0 1/4"	32'-6 1/8"
G2L	75,965*		
G3L	75,685*		
G4L	75,275*		
G5L	75,660*		
G6L	75,605*		
G7L	75,965*		
G8L	74,975*	120'-0 1/4"	32'-6 1/8"
G1M	41,870*	105'-0 7/8"	25'-0 7/8"
G2M	42,660*		
G3M	42,240*		
G4M	41,990*		
G5M	42,260*		
G6M	42,240*		
G7M	42,660*		
G8M	41,870*	105'-0 7/8"	25'-0 7/8"

MARK	WEIGHT	"A"	"B"
G1N	48,945*	90'-0 1/2"	17'-6 1/4"
G2N	49,620*		
G3N	49,525*		
G4N	49,225*		
G5N	49,225*		
G6N	49,525*		
G7N	49,620*		
G8N	48,945*	90'-0 1/2"	17'-6 1/4"
G1O	38,220*	105'-1 1/4"	25'-0 7/8"
G2O	39,020*		
G3O	38,595*		
G4O	38,225*		
G5O	38,370*		
G6O	38,595*		
G7O	39,020*		
G8O	38,220*	105'-1 1/4"	25'-0 7/8"

MARK	WEIGHT	"A"	"B"
G1P	52,900*	95'-0 7/8"	20'-0 7/8"
G2P	53,695*		
G3P	53,515*		
G4P	53,220*		
G5P	53,540*		
G6P	53,525*		
G7P	53,710*		
G8P	52,900*	95'-0 7/8"	20'-0 7/8"
G1Q	53,470*	126'-9"	35'-10 1/2"
G2Q	54,470*	126'-9"	35'-10 1/2"
G3Q	54,080*	126'-9"	35'-10 1/2"
G4Q	53,825*	126'-9"	35'-10 1/2"
G5Q	54,105*	126'-8 7/8"	35'-10 7/8"
G6Q	54,085*	126'-9"	35'-10 1/2"
G7Q	54,495*	126'-9 3/8"	35'-10 1/8"
G8Q	53,510*	126'-10"	35'-11"

NO.	REVISION	DATE
<p>1905 Old Philadelphia Pike Lancaster, Pennsylvania 17603 Phone 771/299-528</p> <p><b>HIGH STEEL STRUCTURES, INC.</b></p> <p>A Subsidiary of High Industries, Inc.</p>		
SHIPPING PROCEDURE		
1-395 BRIDGE OVER PENOBSCOT RIVER		
1-395 BRIDGE STA. 164+60.00		
PENOBSCOT COUNTY		
STATE OF MAINE		
DEPARTMENT OF TRANSPORTATION		
STATE CONTRACT OR REF. NO.	CONTRACTOR CIANBRO CORP.	
IN CHARGE: HINKLE	MADE BY: RW	CHK'D BY: TC
CONTRACT NUMBER: ME-84088-3	DRAWING NUMBER: SP1	
DATE: 4-8-85		

R95-177

[illegible][illegible][illegible][illegible][illegible][illegible][illegible][illegible][illegible][illegible]

	0	1	2	3	4	5	6	7	8
0									
1									
2									
3									
4									
5									
6									
7									
8									

[illegible][illegible][illegible][illegible][illegible][illegible]


	MISCELLANEOUS									
	0	1	2	3	4	5	6	7	8	9
0	SCUPPER SUPPORT ANGLES									
1	MS1,MS2,MS3-DETD ON DWG * 7									
2										
3	ANCHOR BOLTS, WASHERS &									
4	FABRIC PADS-DETD ON DWG * 1									
5										
6	POT BEARINGS-DETD ON DWG.									
7	ID 1001-1A thru IF #D 1003-1A									
8										
9										

[illegible][illegible][illegible][illegible]

NO	REVISION	DATE
<p>1. HIGH STEEL STRUCTURES, INC.</p> <p>INDEX</p> <p>I-395 BRIDGE OVER PENOBSCOT RIVER</p> <p>I-395 BRIDGE STA 104+60.00</p> <p>PENOBSCOT COUNTY</p> <p>STATE OF MAINE</p> <p>DEPARTMENT OF TRANSPORTATION</p> <p>STATE CONTRACT NO REF NO 0 CONTRACT FOR CIAMBRO COR</p> <p>IN CHARGE HINKLE MADE BY CS (SEE E) BY DATE</p> <p>CONTRACT NO ME-84088-3 (DRAWING NO) K1</p>		

R95-178




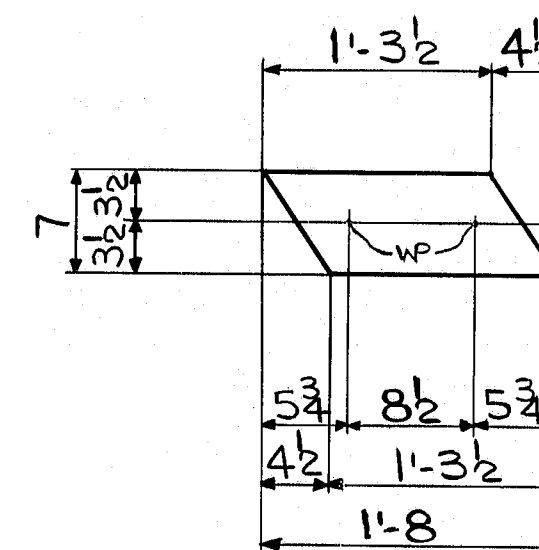


DETAIL OF BAR ~ mc

R95-179

NUMBER: 1-12 545885 NUMBER: 2 OF 4

AF 22683A

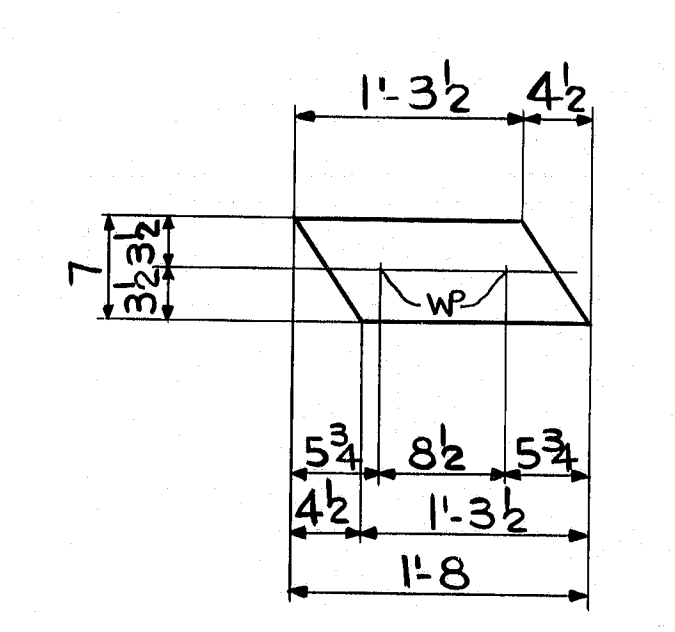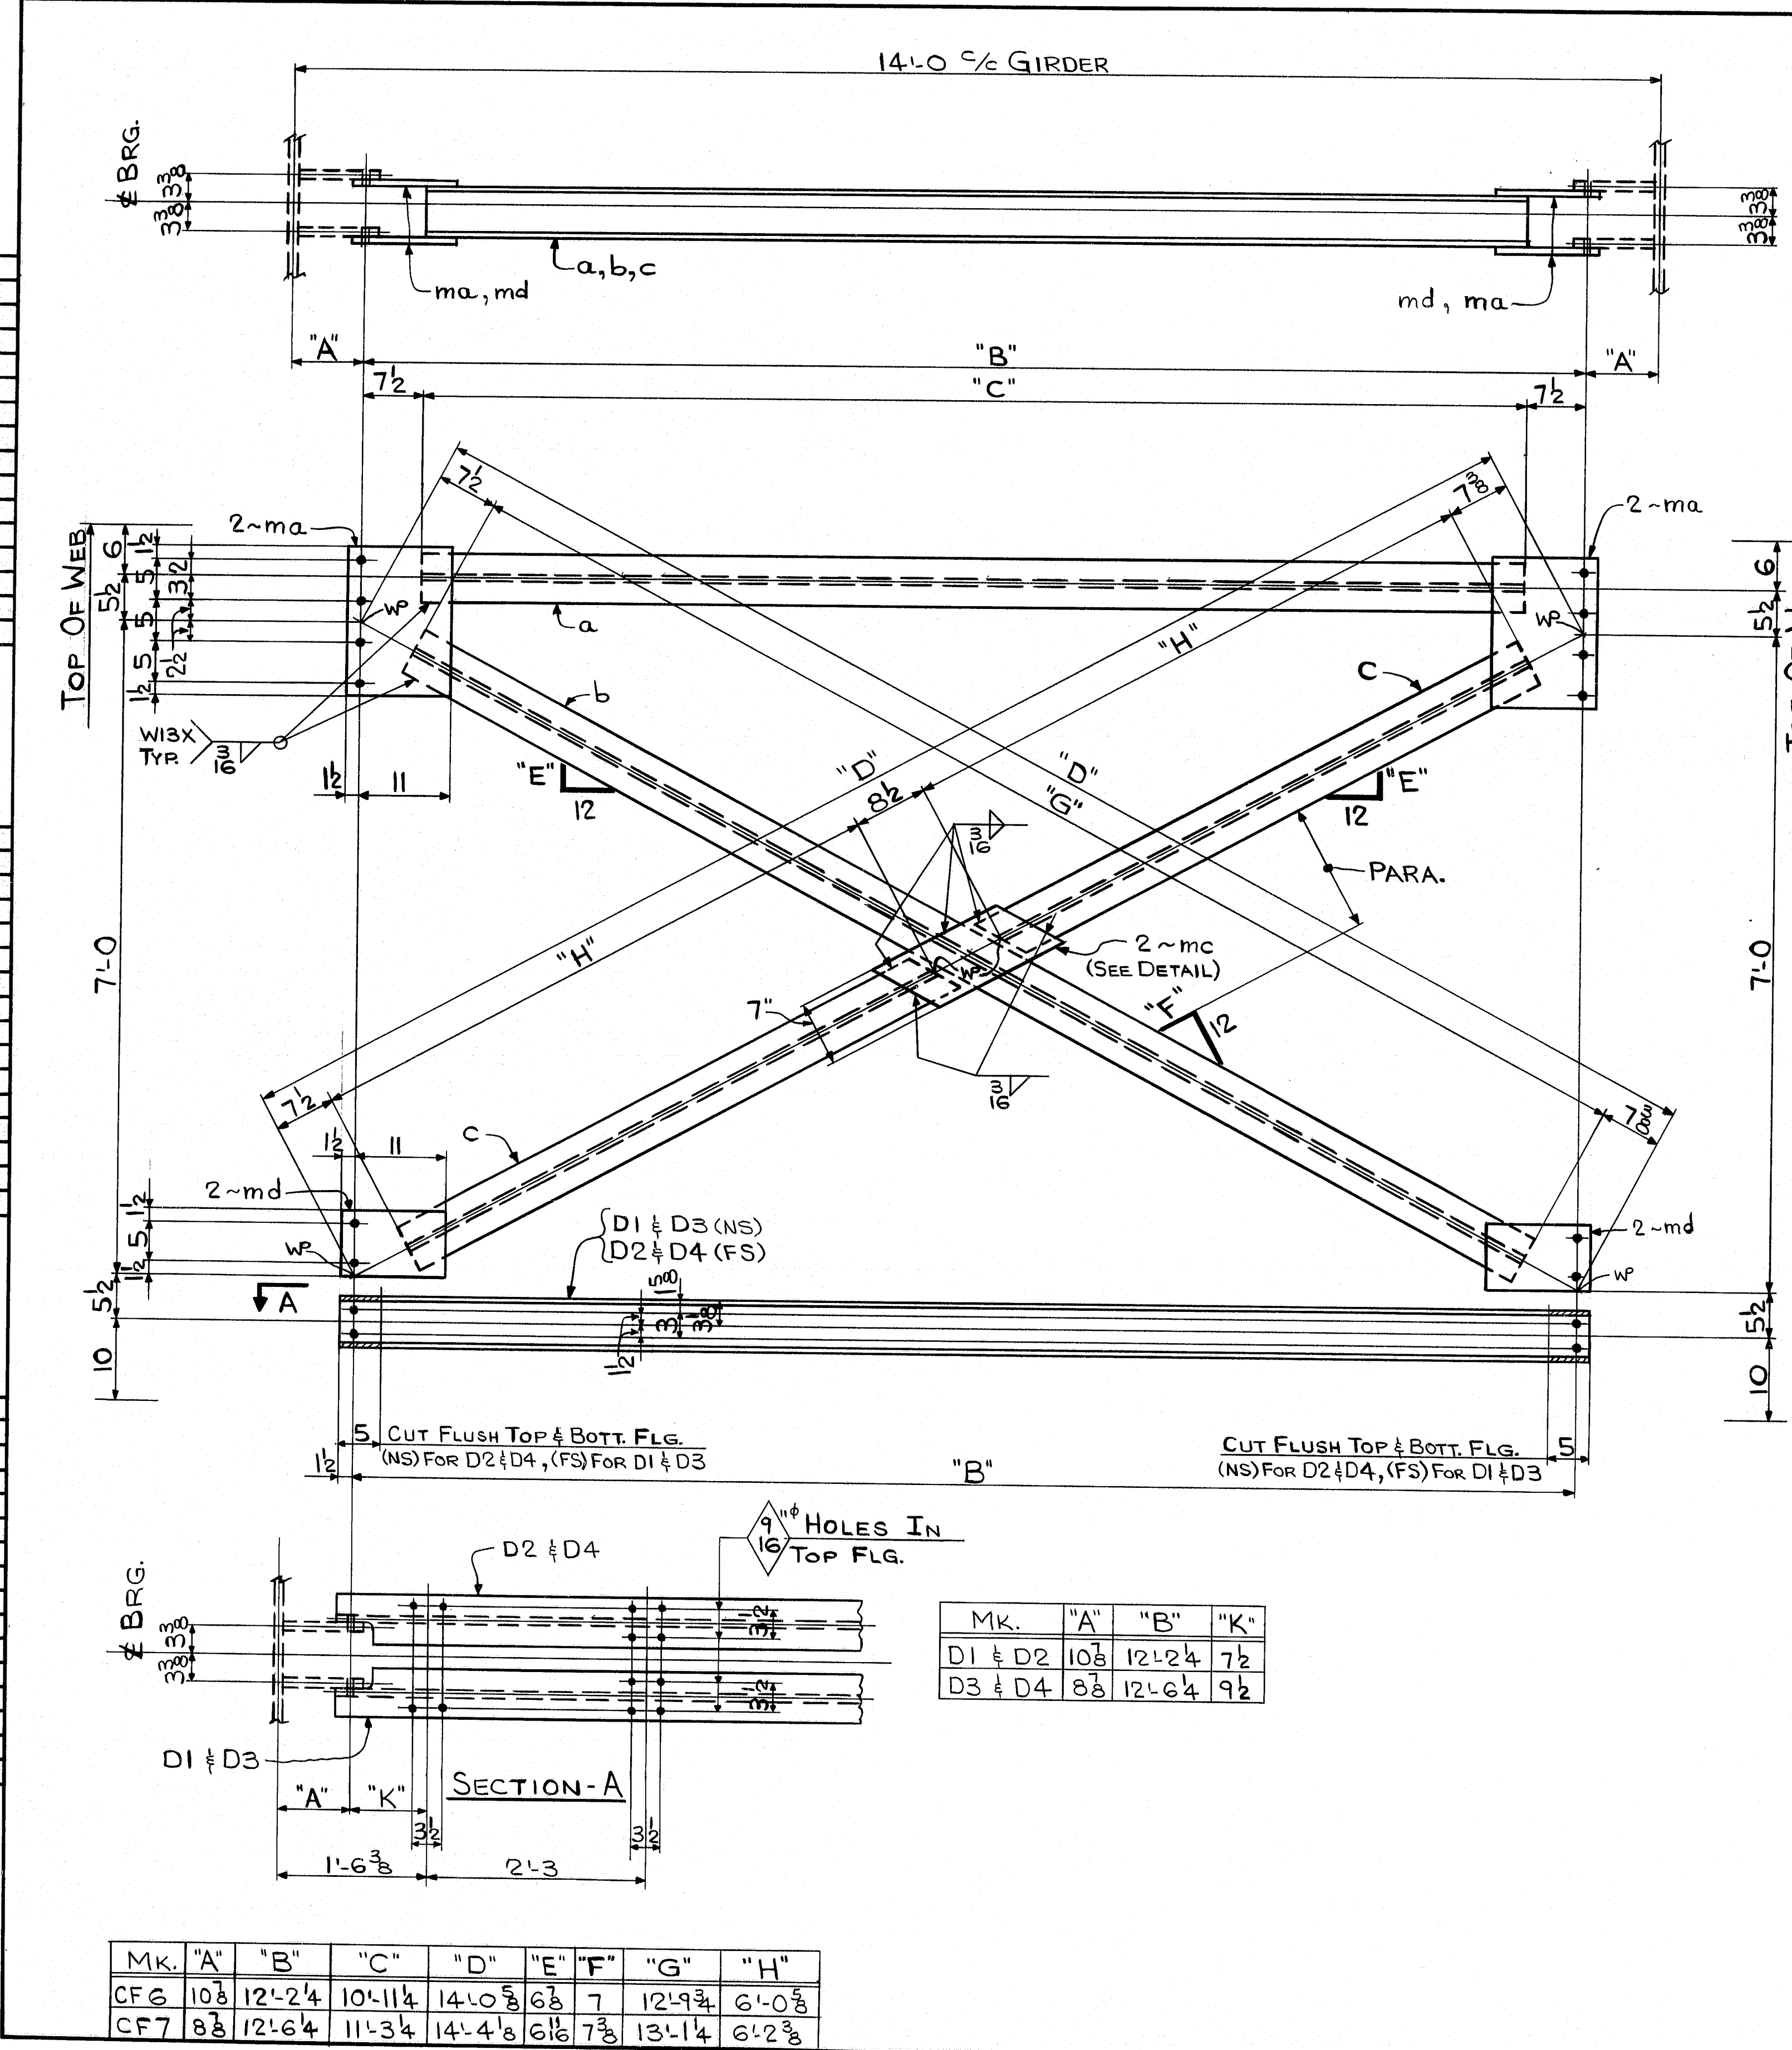

DETAIL OF BAR ~mc

MK.	"A"	"B"	"K"
D1 & D2	10 1/8	12'-2 1/4	7 1/2
D3 & D4	8 3/8	12'-6 1/4	9 1/2

MK.	"A"	"B"	"C"	"D"	"E"	"F"	"G"	"H"
CF6	10 1/8	12'-2 1/4	10'-11 1/4	14'-0 3/8	6 3/8	7	12'-9 3/4	6'-0 3/8
CF7	8 3/8	12'-6 1/4	11'-3 1/4	14'-4 1/8	6 1/8	7 3/8	13'-1 1/4	6'-2 3/8

**SHOP NOTE**  
 HOLES: 15" (U.N.)  
 BOLTS: NONE  
 PAINT: NONE

FOR GENERAL NOTES SEE DWG. N1

**R95-180** CODE: 5300

FED. ROAD DIST. NO.		STATE	FED. AID PROJ. NO.	
1		ME	116-395-8 (82) 176	

NO.	MARK	DESCRIPTION	LENGTH	REMARKS	ITEM	SHIP. WEIGHT E.A.
1	CF6	CROSSFRAME				917
2	CF7	CROSSFRAME				965
1	a	WG x 20	10 11 1/4	CF6		9/20
2	a		11 3 1/4	CF7		9/19
1	b		12 9 3/4	CF6		9/13
2	b		13 1 1/4	CF7		9/10
2	c		6 2 3/8	CF6		9/24
4	c	WG x 20	6 4 1/4	CF7		9/21
12	ma	# 12 x 2	1 6			9/21
6	mc	BAR 7 x 2	1 8	SEE DETAIL		9/21
12	md	BAR 8 x 2	1 0 1/2			9/21
1	D1	WG x 20	12 5 1/4			9/17 249
1	D2		12 5 1/4			9/17 249
2	D3		12 9 1/4			9/14 255
2	D4	WG x 20	12 9 1/4			9/14 255

NO.	REVISION	DATE

**HIGH STEEL STRUCTURES, INC.**

1905 Old Philadelphia Pike  
 Lancaster, Pennsylvania 17603  
 Phone 717/298-5211

A Subsidiary of High Industries, Inc.



**CROSSFRAME DETAILS (PIERS)**  
 I-395 BRIDGE OVER PENOBSCOT RIVER  
 I-395 BRIDGE STA. 164+60.00  
 PENOBSCOT COUNTY  
 STATE OF MAINE  
 DEPARTMENT OF TRANSPORTATION

STATE CONTRACT OR REF. NO. **G** CONTRACTOR **CIAMBRO CORP.**


IN CHARGE: **HINKLE** MADE BY: **JLC** CHK. D. **BJK** DATE: **7-27-84**

CONTRACT NUMBER: **ME-84088-3** DRAWING NUMBER: **3 OF 47**



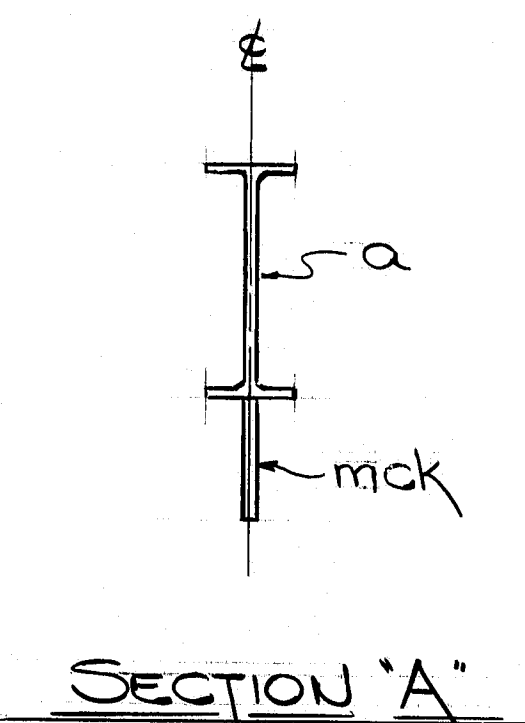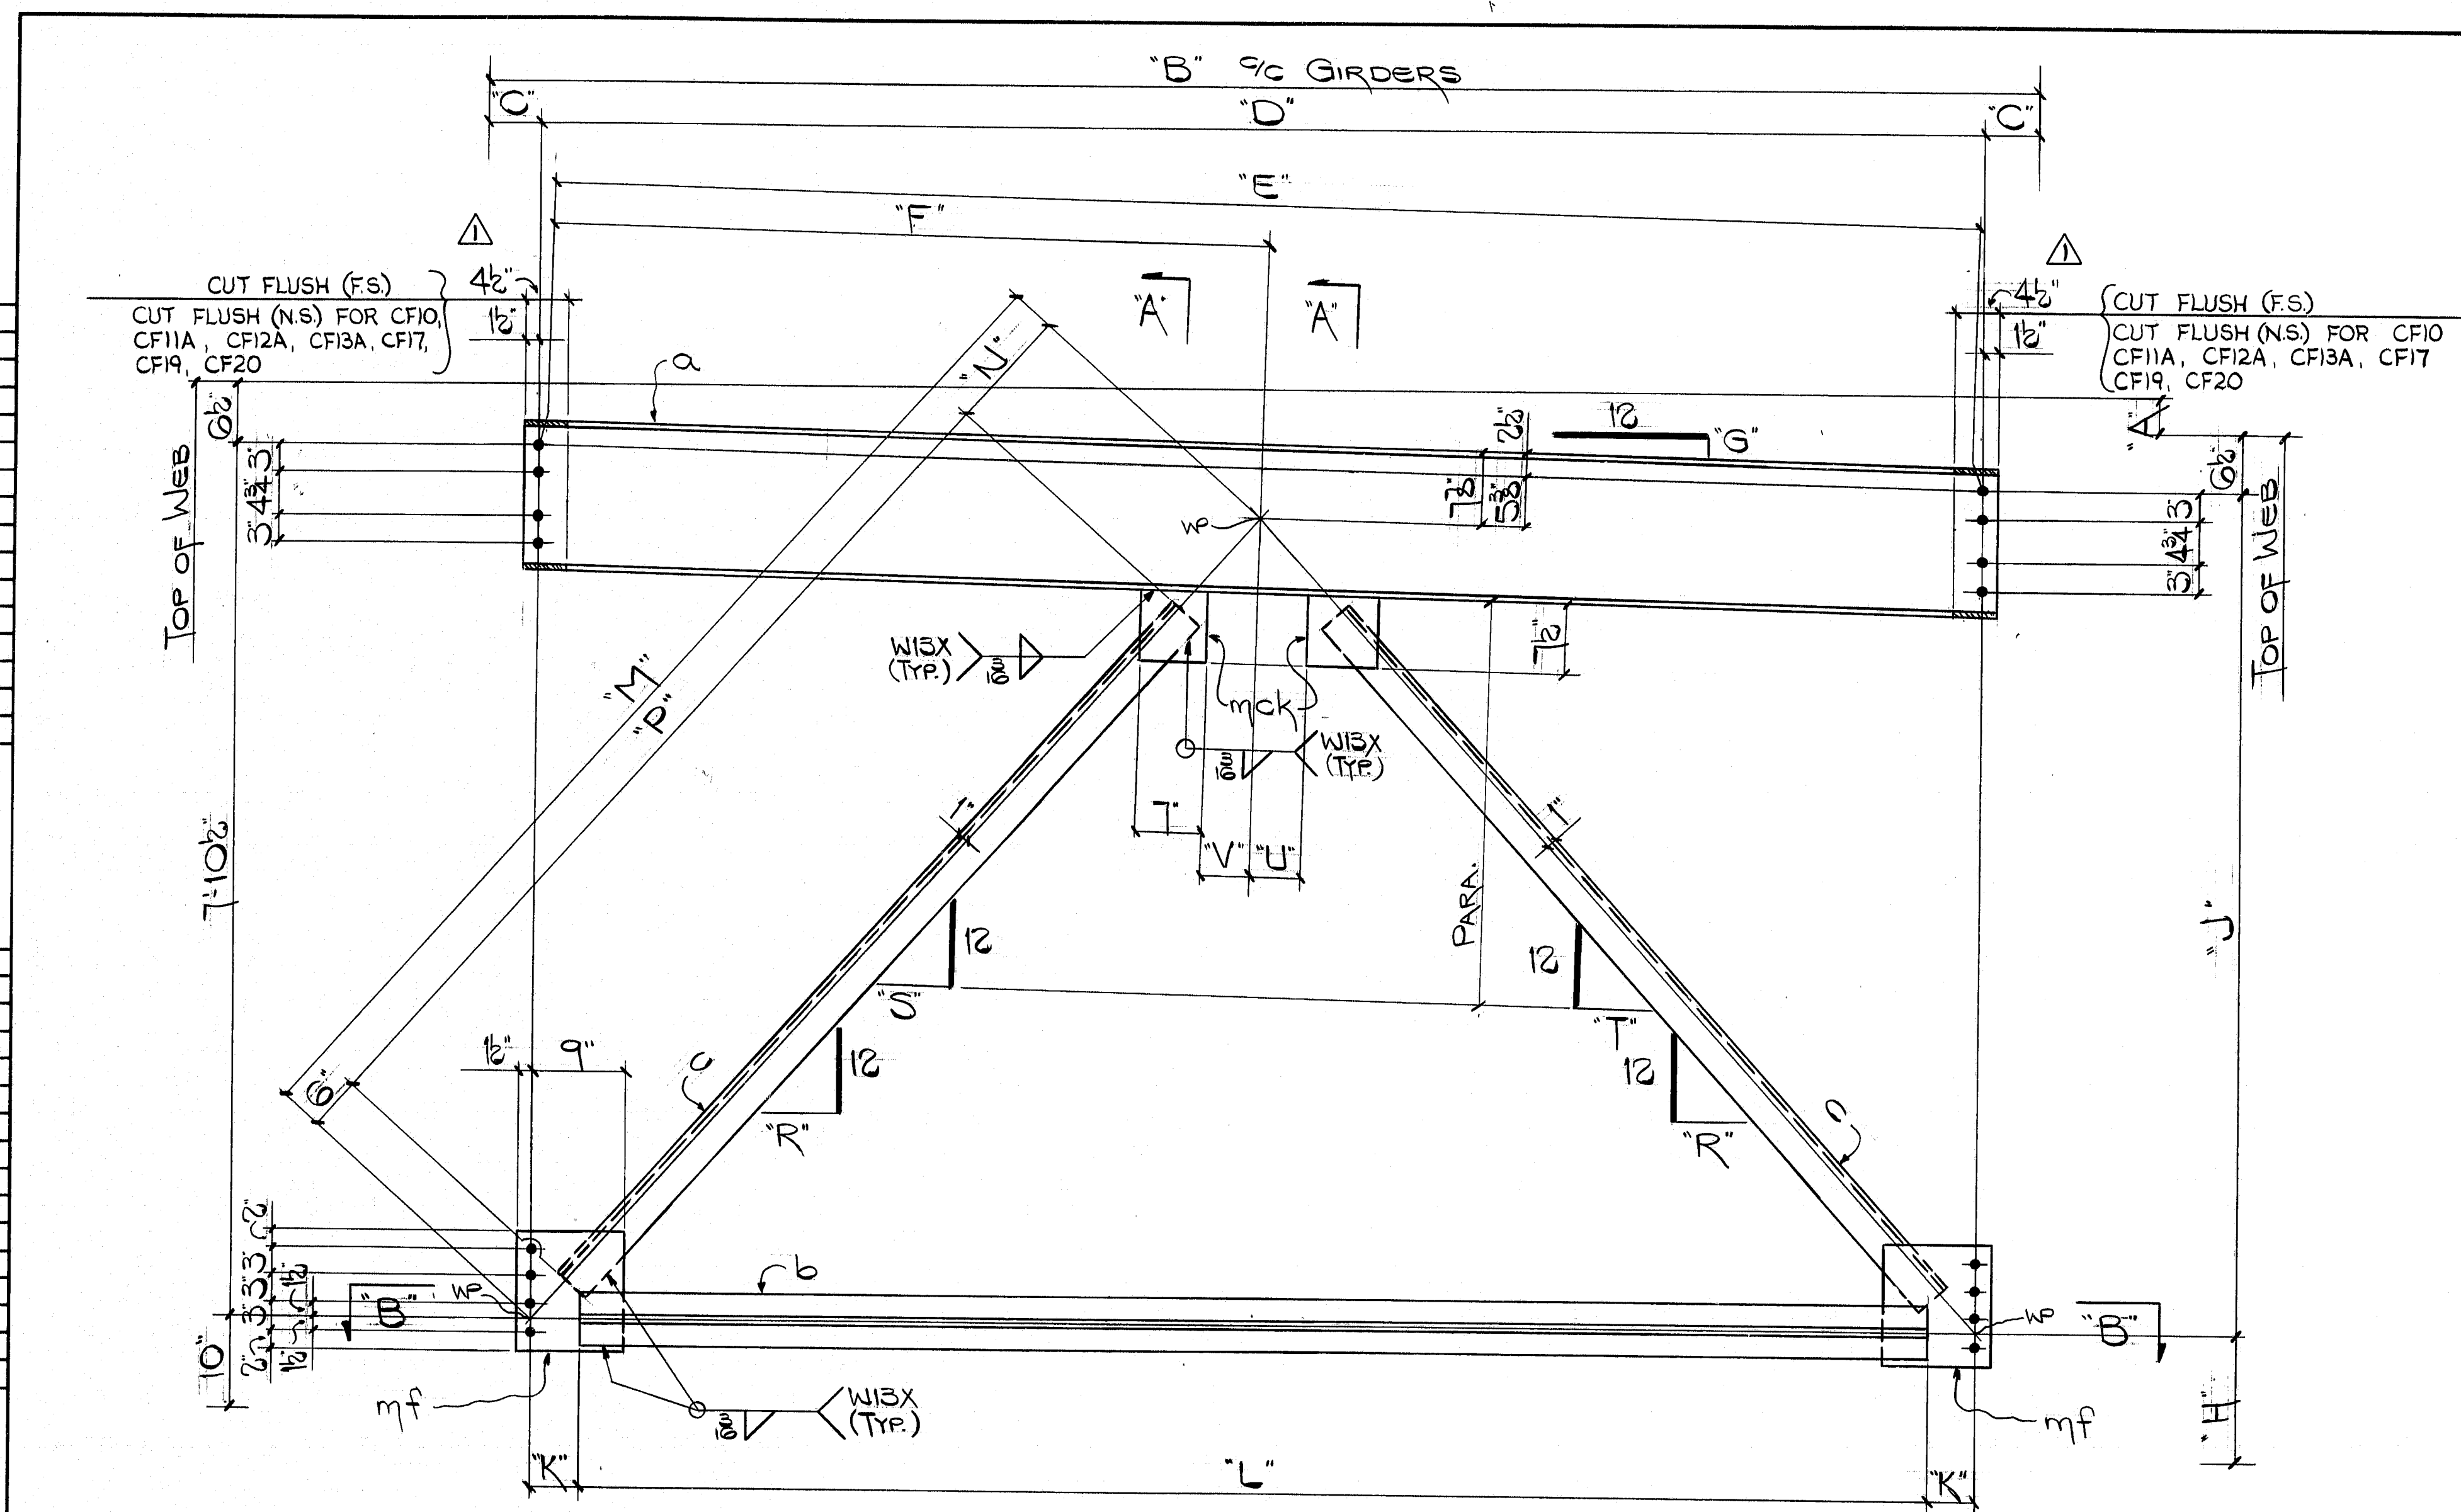

MARK	A	B	C	D	E	F	G	H	J	K	L	M	N	P	R	S	T	U	V
CF8	0	14'0"	7'8"	12'8"	12'8"	6'44"	0	10'	7'10"	3'4"	12'2"	9'9"	1'01"	8'34"	10'4"	10'4"	10'4"	5'4"	5'4"
CF9	2'		7'8"	12'8"	12'8"	6'44"	1'	1'0"	7'8"	3'4"		9'8"	1'15"	8'14"	10'6"	10'6"	10'6"	6'	5'
CF10	3'		7'8"	12'8"	12'8"	6'44"	4'	1'10"	7'7"	3'4"		9'7"	1'15"	8'08"	10'6"	10'6"	10'6"	6'	5'
CF11	2'		5'8"	13'0"	13'0"	6'6"	1'	1'0"	7'8"	5'4"		9'9"	1'15"	8'28"	10'6"	10'6"	11'	6'	5'
CF12	2'		5'8"	13'0"	13'0"	6'6"	1'	1'0"	7'8"	5'4"		9'9"	1'15"	8'28"	10'6"	10'6"	11'	6'	5'
CF13	3'		5'8"	13'0"	13'0"	6'6"	4'	1'10"	7'7"	5'4"		9'9"	1'15"	8'14"	10'4"	10'4"	11'4"	6'3"	5'
CF14	3'		5'8"	13'0"	13'0"	6'6"	4'	1'10"	7'7"	5'4"		9'9"	1'15"	8'14"	10'4"	10'4"	11'4"	6'3"	5'
CF15	3'		5'8"	13'0"	13'0"	6'6"	4'	1'10"	7'7"	5'4"		9'9"	1'15"	8'14"	10'4"	10'4"	11'4"	6'3"	5'
CF16	3'		5'8"	13'0"	13'0"	6'6"	4'	1'10"	7'7"	5'4"		9'9"	1'15"	8'14"	10'4"	10'4"	11'4"	6'3"	5'
CF17	2'	14'0"	5'8"	13'0"	13'0"	6'6"	1'	1'0"	7'8"	5'4"	12'2"	9'9"	1'15"	8'28"	10'6"	10'6"	11'	6'	5'
CF18	2'	14'0"	5'8"	13'14"	13'14"	6'6"	1'	1'0"	7'8"	5'4"	12'2"	9'9"	1'15"	8'28"	10'6"	10'6"	11'6"	6'	5'
CF19	3'	14'0"	5'8"	13'14"	13'14"	6'6"	4'	1'18"	7'7"	5'4"	12'2"	9'9"	1'15"	8'2"	10'6"	10'6"	11'4"	6'3"	5'
CF20	3'	14'0"	5'8"	13'14"	13'14"	6'6"	4'	1'18"	7'7"	5'4"	12'2"	9'9"	1'15"	8'2"	10'6"	10'6"	11'4"	6'3"	5'

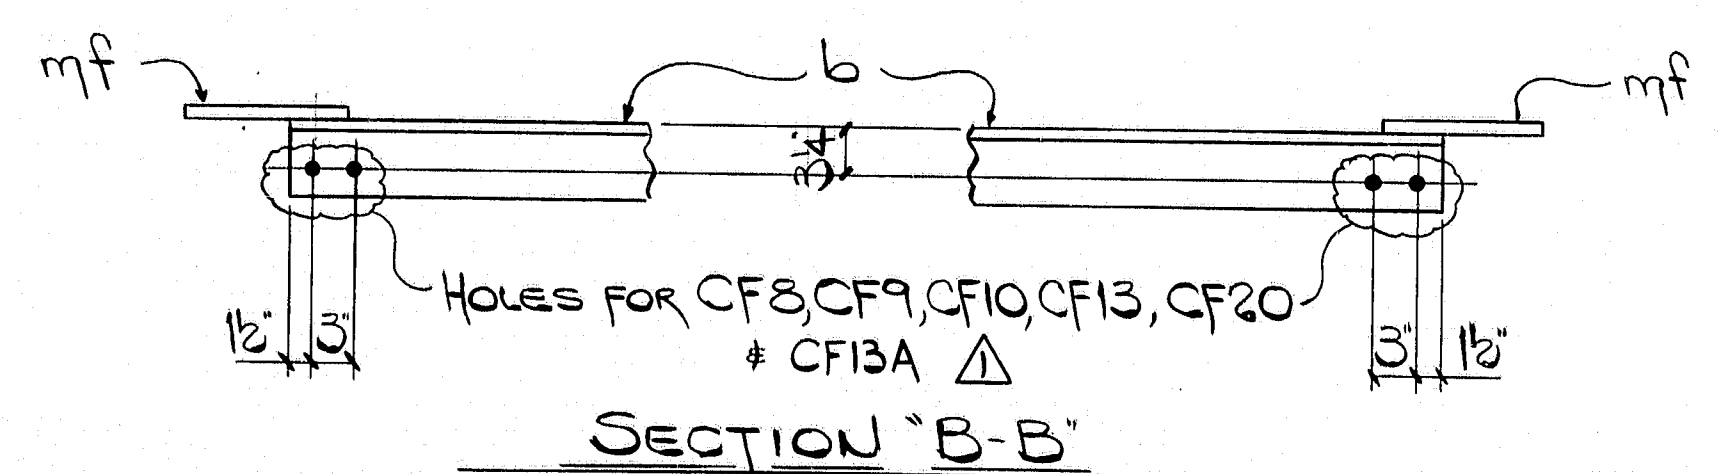


BILL OF MATERIAL					
NO.	MARK	DESCRIPTION	LENGTH	REMARKS	ITEM
ONE	CF8	CROSSFRAME			678.
ONE	CF9				669.
2	CF10				669.
2	CF11				682.
2	CF12				680.
3	CF13				680.
2	CF13A	CROSSFRAME			680.
1	a	W16x26	12 11/2	CF8	64
1	a	W16x26	12 11/2	CF9	5/23
2	a	W16x26	13 0	CF10	5/24
4	a	W16x26	13 3/4	CF11, CF11A	5/21
10	a	W16x26	13 4	CF12, CF12A	5/22
18	b	WT5x11	12 2	CF13, CF13A	9/3
2	c	4x4x8	8 3/4	CF8	9/11
2	c	4x4x8	8 1/4	CF9	9/14
4	c	4x4x8	8 08	CF10	9/15
8	c	4x4x8	8 28	CF11, CF11A	9/16
20	c	4x4x8	8 13	CF12, CF12A	9/18
36	mf	10x8	1 1		9/22
36	mck	BAR 7x8	0 7/2		9/22
ONE	CF17	CROSSFRAME			680.
ONE	CF18				689.
ONE	CF19				682.
ONE	CF20	CROSSFRAME			682.
1	a	W16x26	13 3/4	CF17	5/21
1	a	W16x26	13 4/2	CF18	5/25
2	a	W16x26	13 4/2	CF19, CF20	5/25
1	b	WT5x11	12 2	CF17	9/3
3	b	WT5x11	12 2/4	CF18, CF19, CF20	9/8
2	c	4x4x8	8 2/2	CF17	9/11
2	c	4x4x8	8 2/4	CF18	9/14
4	c	4x4x8	8 2	CF19, CF20	9/15
8	mf	10x8			
8	mck	BAR			


SHOP NOTE  
HOLES: 1/2"  
BOLTS: NONE  
PAINT: NONE

FOR GENERAL NOTES-SEE DWG. N1

R95-181



NO. 1	REVISION	REV. FRAMES TO	DATE 6-12-85
HIGH STEEL STRUCTURES, INC.			
1905 Old Philadelphia Pike Lancaster, Pennsylvania 17603 Phone 717/299-5211			
CROSSFRAME DETAILS (D1 MOD.)			
I-395 BRIDGE OVER PENOBSCOT RIVER			
I-395 BRIDGE STA 164+20.00			
PENOBSCOT COUNTY			
STATE OF MAINE			
DEPARTMENT OF TRANSPORTATION			
STATE CONTRACT OR REF. NO.	6	CONTRACTOR	CIANBRO CORP.
IN CHARGE	HINKLE	MADE BY	CS
CONTRACT NUMBER	ME-84088-3	CHK. BY	BJK
		DATE	11-27-84
		DRAWING NUMBER	4 OF 41

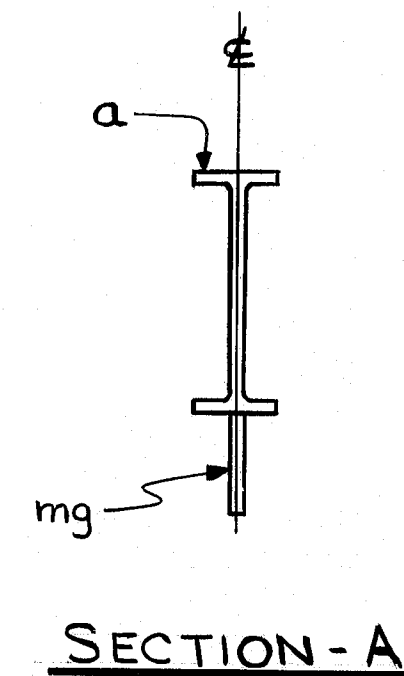


NO.	REVISION	DATE
<p><b>HIGH STEEL STRUCTURES, INC.</b></p>  <p>1905 Old Philadelphia Pike Lancaster, Pennsylvania 17603 Phone 717/298-6211</p> <p>A Subsidiary of High Industries, Inc.</p>		
CROSSFRAME DETAILS (D2 Mod.)		
I-395 BRIDGE STA. 164 +60.00		
PENSCOT COUNTY		
STATE OF MAINE		
DEPARTMENT OF TRANSPORTATION		
STATE CONTRACT OR REF. NO.	G	CONTRACTOR <b>CIAMBRO CORP.</b>
IN CHARGE	<b>HINKLE</b>	MADE BY <b>JLC</b> CHK. BY <b>BJK</b> DATE: <b>7-30-84</b>
CONTRACT NUMBER	<b>ME-40488-3</b>	DRAWING BY <b>5</b> OF <b>47</b>

R95-182



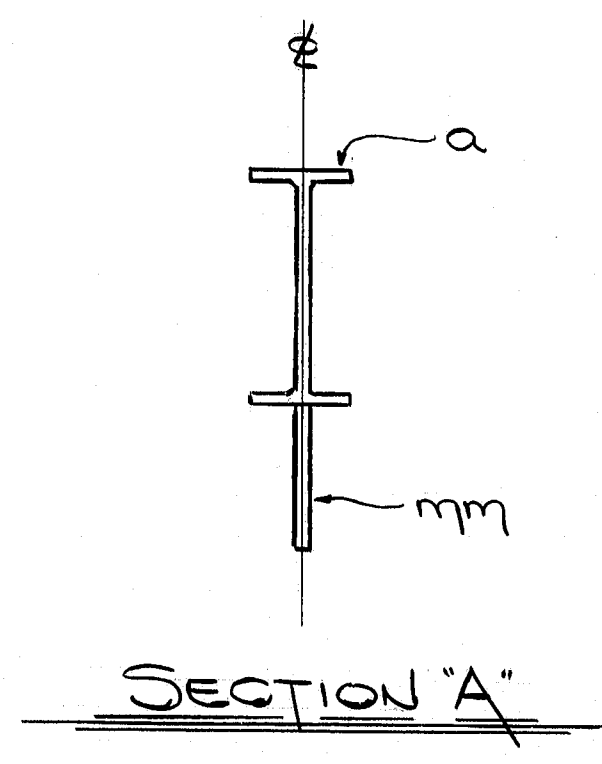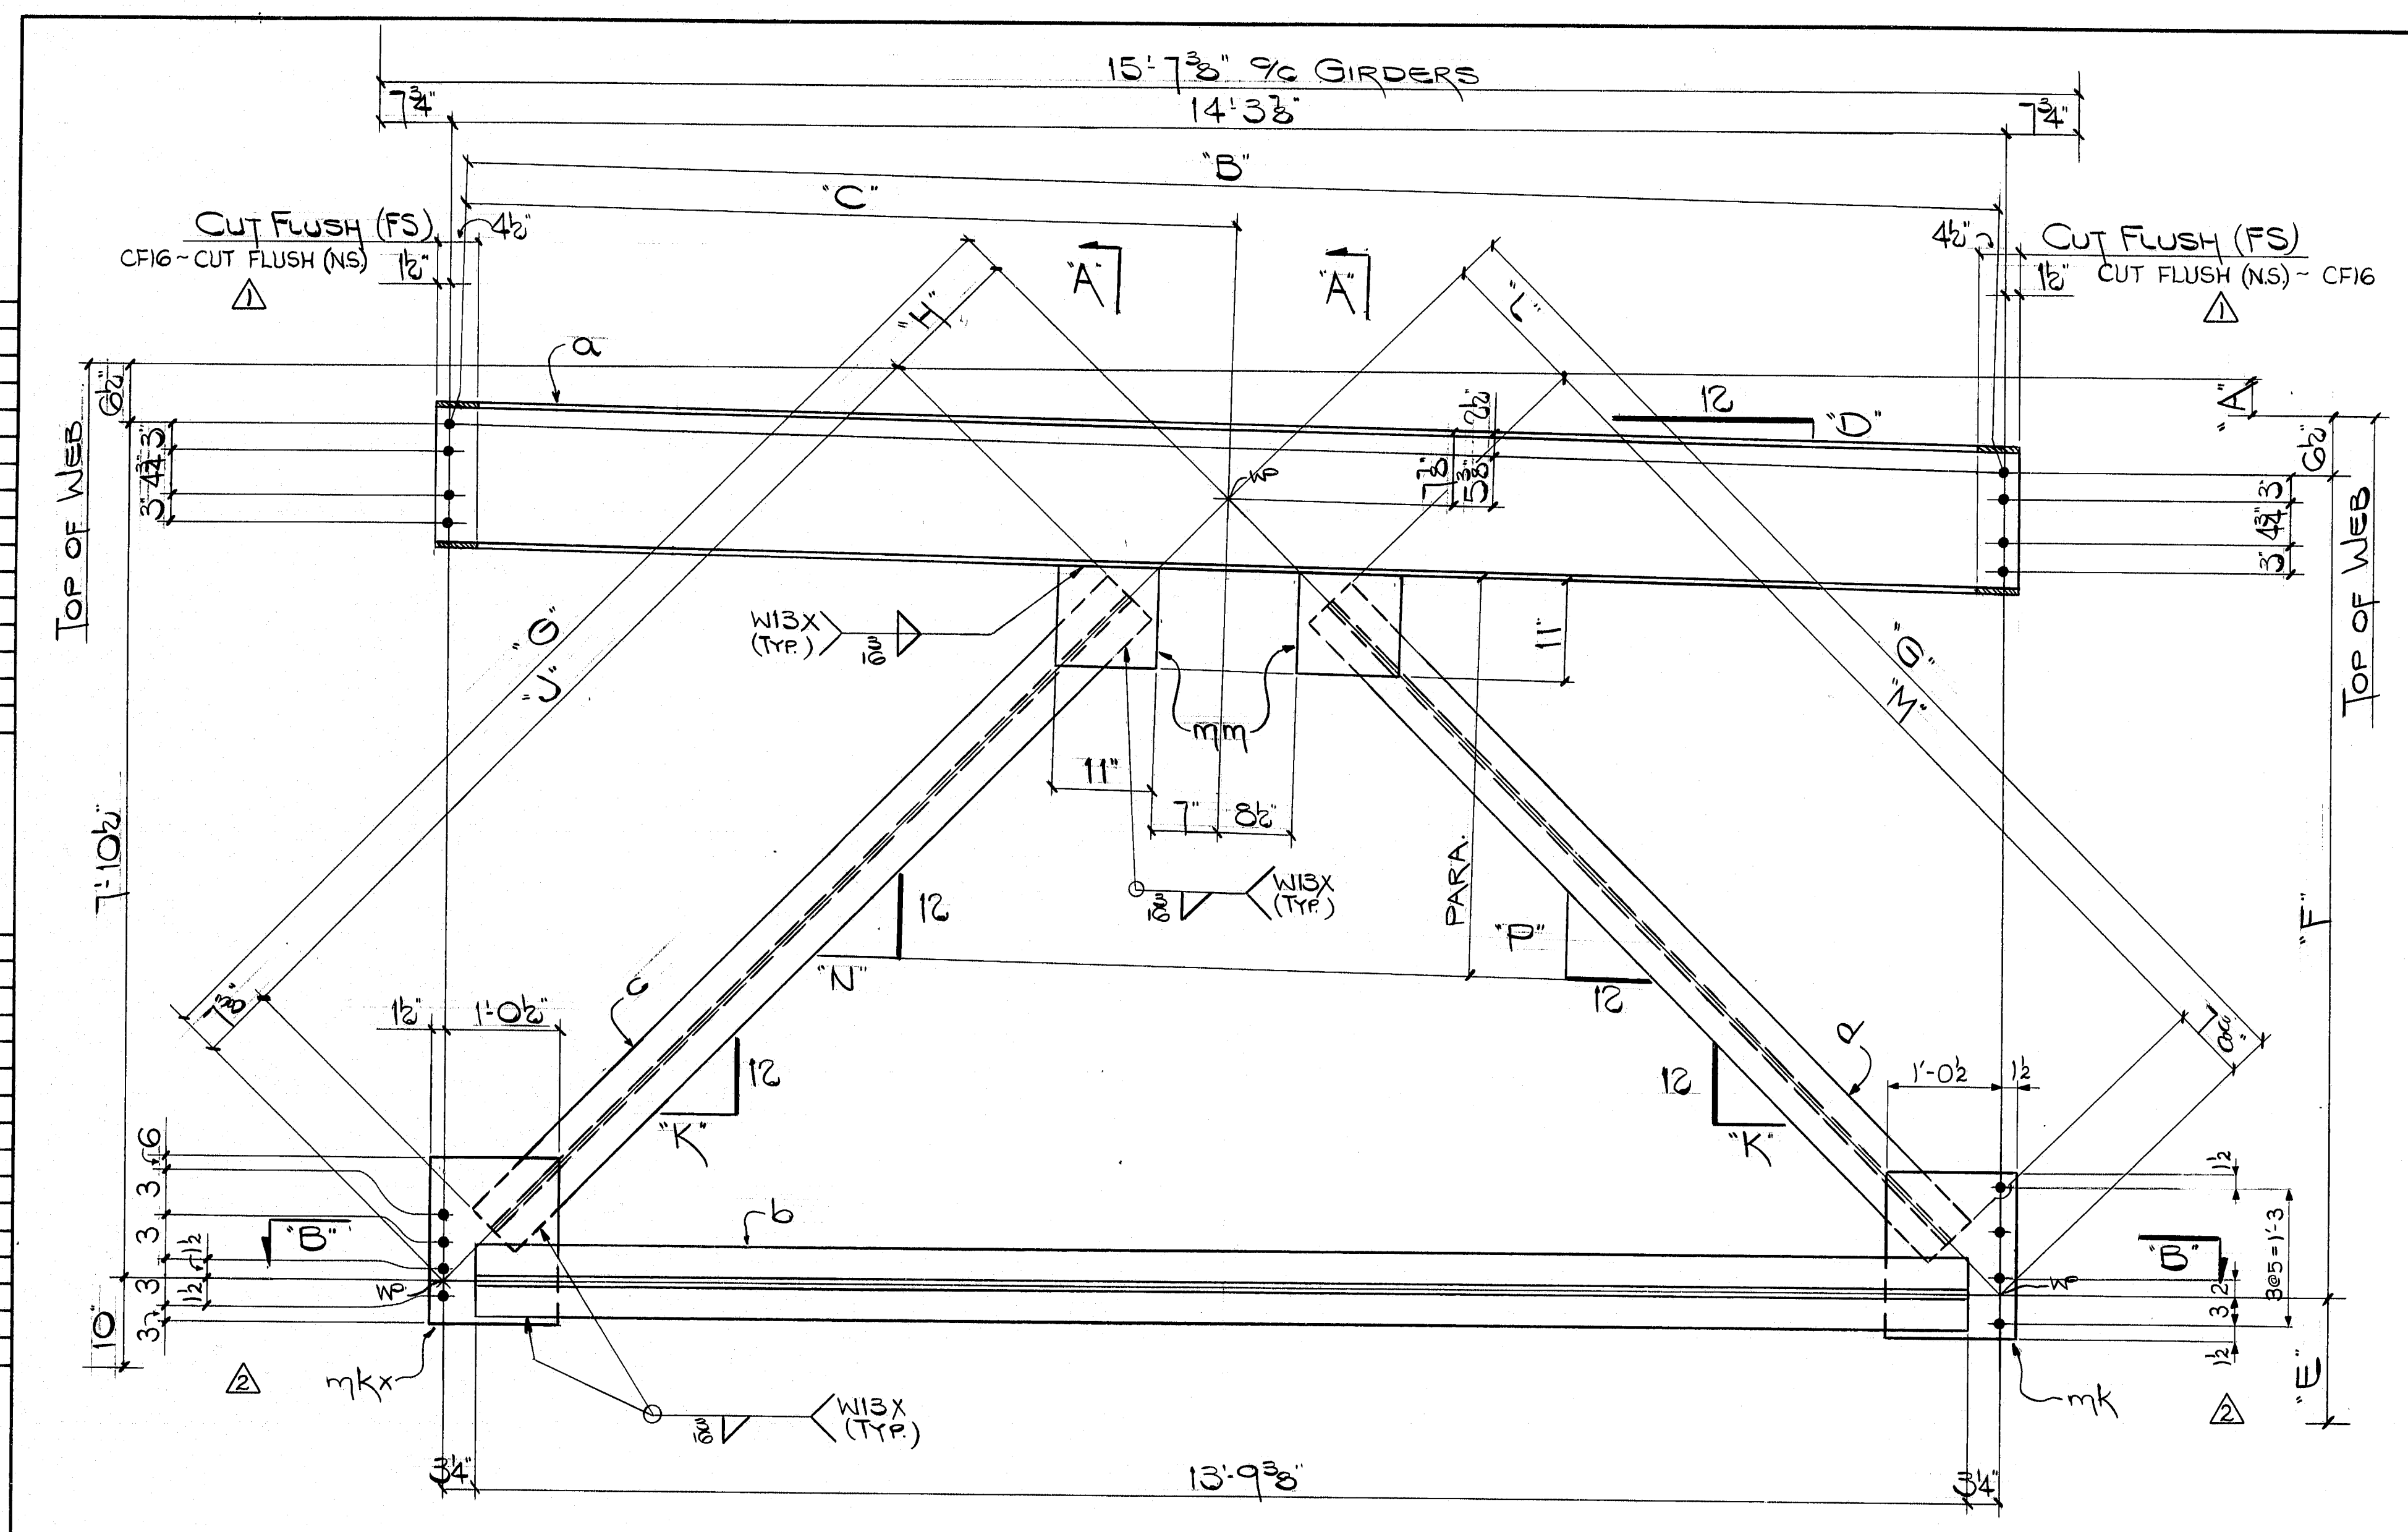

MARK	"A"	"B"	"C"	"D"	"E"	"F"	"G"	"H"	"J"	"K"	"L"	"M"	"N"	"P"
CF15	4'	14'3 1/2"	7'2 1/2"	4'	1'2"	7'0 1/2"	10'2 3/8"	1'3 1/2"	8'3 1/2"	11 1/8"	1'4"	8'3"	11 1/4"	11 1/8"
CF16	2'	14'3 3/8"	7'2"	5'	1'0"	7'8 1/2"	10'3 1/2"	1'3 1/2"	8'4"	11 1/8"	1'3 1/2"	8'4"	11 1/2"	12"

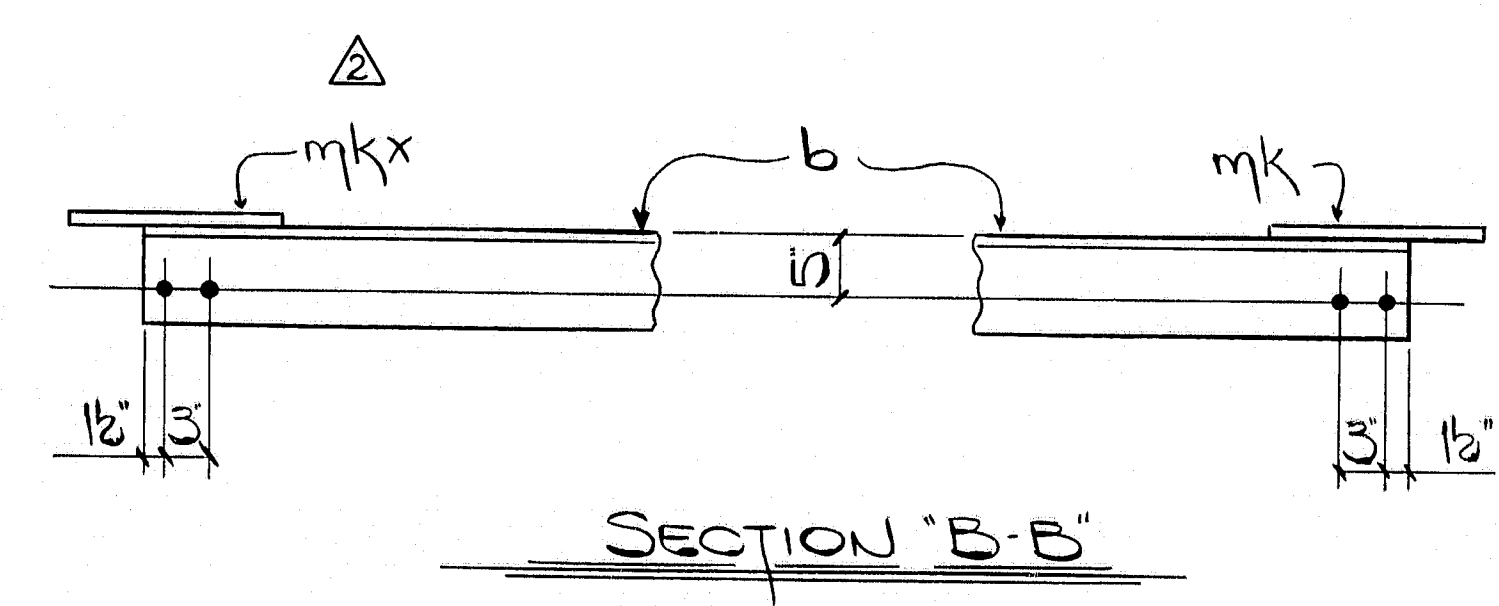

SHOP NOTE  
 HOLES: 1 1/2"  
 BOLTS: NONE  
 PAINT: NONE  
 FOR GENERAL NOTES-SEE DWG N1

R95-183

BILL OF MATERIAL					
NO.	MARK	DESCRIPTION	LENGTH	REMARKS	QTY
2		CF15 CROSSFRAME			970.
1		ONE CF16 CROSSFRAME			975.
2	a	W16x26	14'7 3/8"	CF15	5/20
1	a	W16x26	14'7 3/8"	CF16	6/20
3	b	WT7x21.5	13'9 3/8"		6/1
2	c	WT6x13	8'3 1/2"	CF15	6/28
1	c	WT6x13	8'4"	CF16	6/30
2	d	WT6x13	8'3"	CF15	6/29
1	d	WT6x13	8'4"	CF16	6/30
3	mkx	R 14 x 3/8	1'6"		9/22
3	mk	R 14 x 3/8	1'6"		9/22
6	mm	R 11 x 3/8	0'11"		9/22

NO. 1	REVISION	REV. BOT. LEFT QUSET R. TO MATCH GDR.	DATE 6-25-85
NO. 2	REVISION	REV. CF16 TO OPP. HAND	DATE 6-12-85

1905 Old Philadelphia Pike  
 Lancaster, Pennsylvania 17603  
 Phone 717/299-5211


**HIGH STEEL STRUCTURES, INC.**

CROSSFRAME DETAILS (DS MOD.)  
 I-395 BRIDGE OVER PENOBSCOT RIVER  
 I-395 BRIDGE STA 164+60.00  
 PENOBSCOT COUNTY  
 STATE OF MAINE  
 DEPARTMENT OF TRANSPORTATION


STATE CONTRACT OR REF. NO. 6 CONTRACTOR CIABRO CORP.

IN CHARGE: HINKLE MADE BY: CS CHK'D BY: BJK DATE: 11-27-84  
 CONTRACT NUMBER: ME84088-3 DRAWING NUMBER: 6 OF 47


AF 22653A

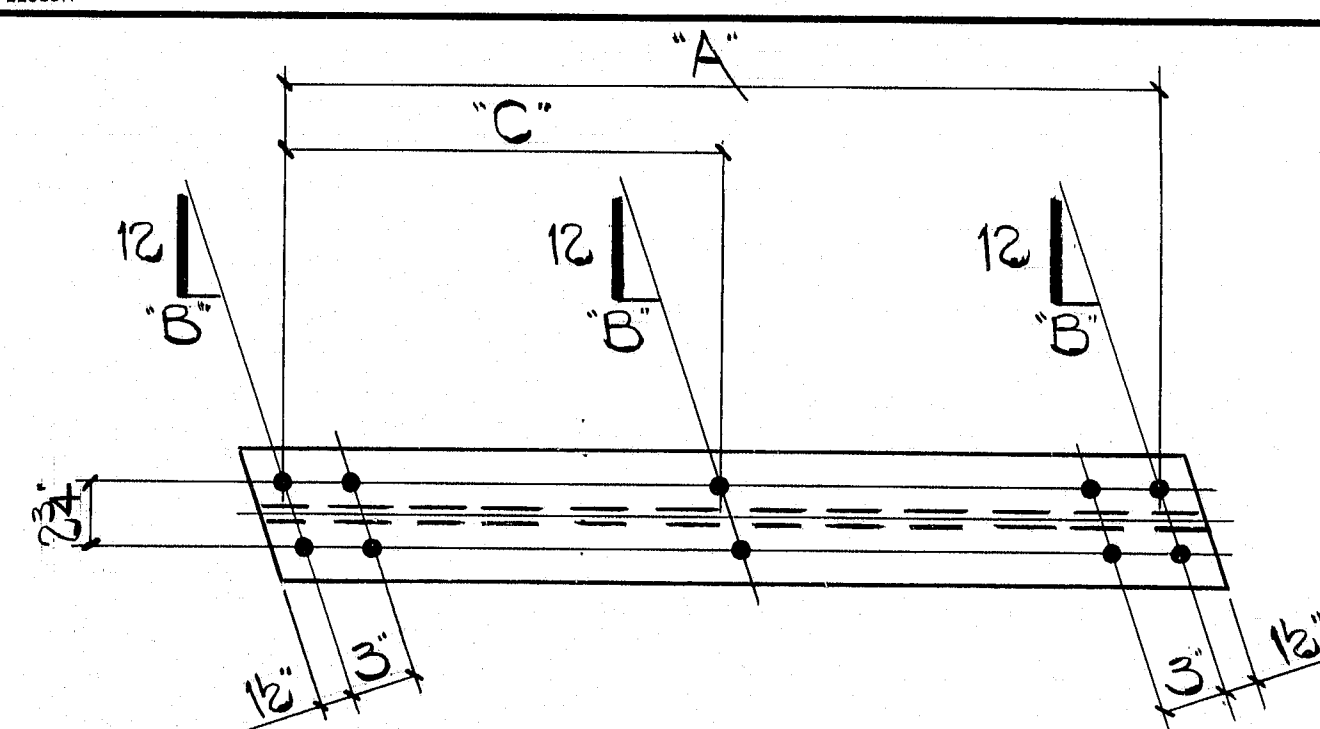

MARK	A	B	C	MARK	A	B	C
A1	14'11 1/4"	5 1/2"	7'5 3/8"	A9	15'0 3/4"	5 1/4"	7'9 1/2"
A2	14'11 3/8"	5 1/2"	7'5 1/2"	A10	15'10 1/4"	5 1/4"	7'11 1/8"
A3	14'10 3/8"	5 1/2"	7'5 3/8"	A11	15'9 3/8"	5 1/2"	7'10 3/8"
A4	14'10 3/4"	5 1/2"	7'5 3/8"	A12	16'1 1/8"	5 1/2"	8'0 1/8"
A5	15'3 3/8"	5 1/2"	7'7 1/2"	A13	16'1 1/8"	5"	8'0 1/8"
A6	15'2 3/8"	5 1/2"	7'7 1/2"	A14	14'11"	5 1/2"	7'5 1/2"
A7	15'6 3/8"	5 1/2"	7'9 3/8"	A15	14'10 3/8"	5 1/2"	7'5 1/2"
A8	15'6 3/8"	5 1/4"	7'9 3/8"	A16	14'10 3/8"	5 1/2"	7'5 1/2"

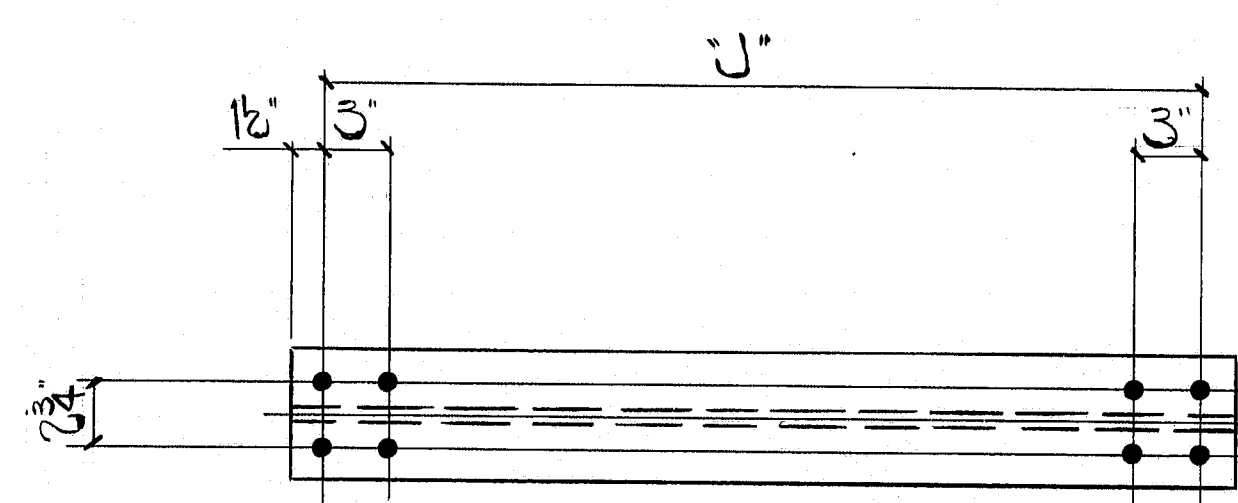


MARK	J	MARK	J
C1	13'6 1/2"	C3	14'2 1/2"
C2	13'11"	C4	14'6 1/2"

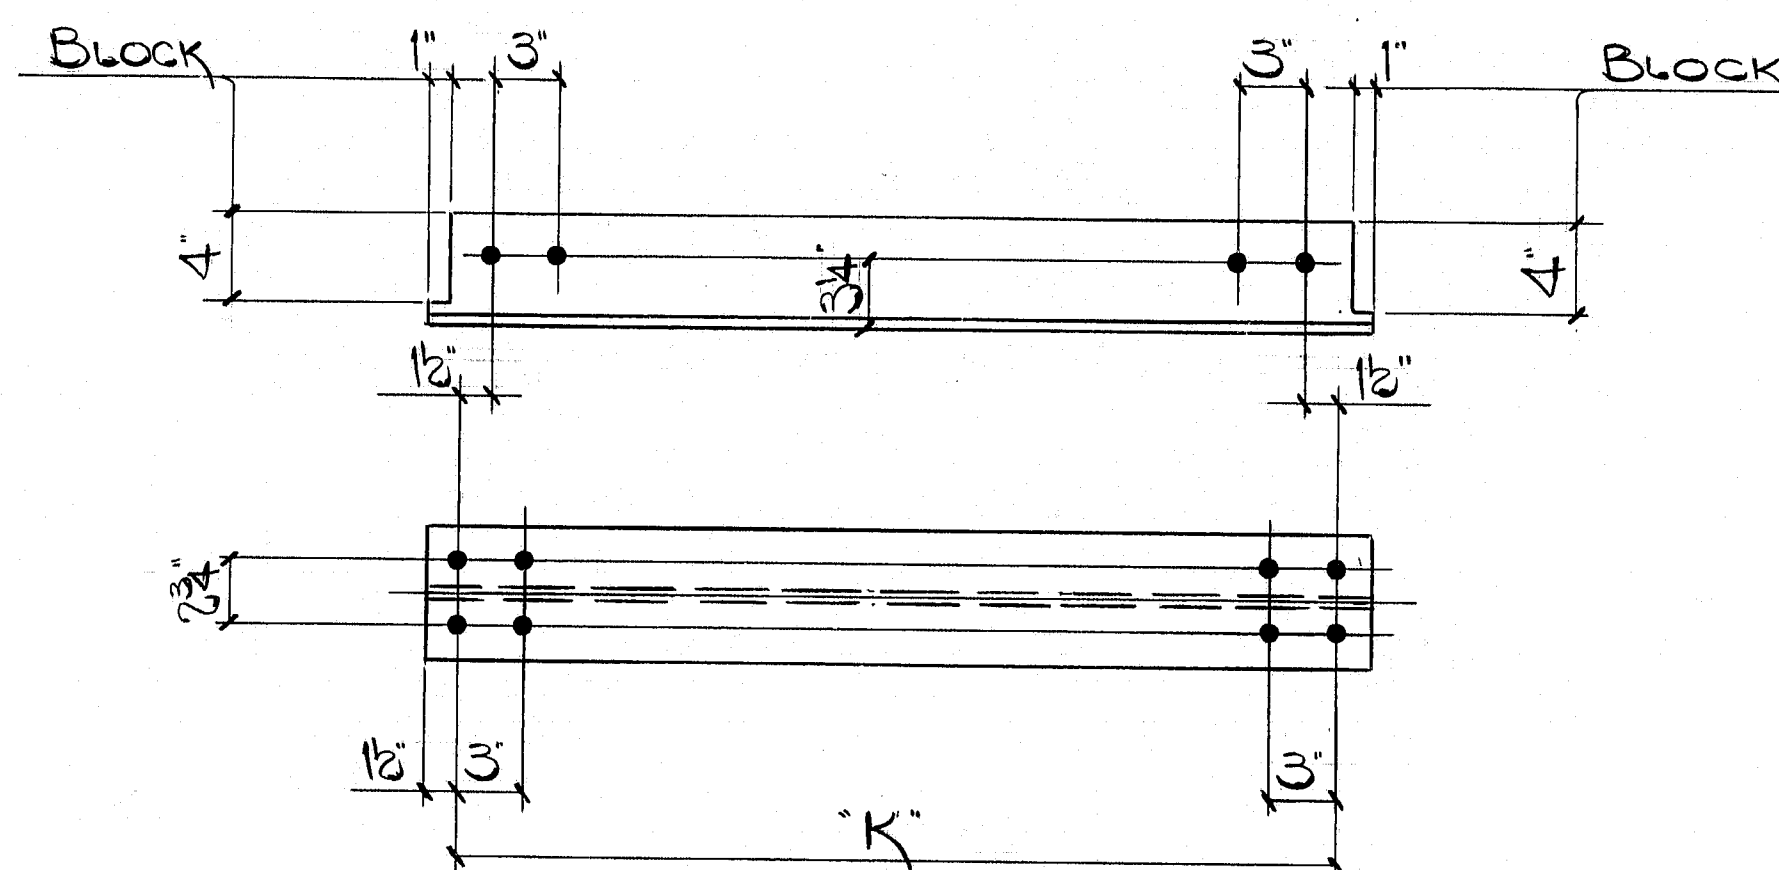

MARK	D	E	F	G	H	MARK	D	E	F	G	H
B1	14'11 1/4"	7'5 3/8"	5 1/2"	10 1/2"	mp	B9	15'6 3/8"	7'9 1/2"	5 1/4"	11 1/8"	mac
B2	14'11 3/8"	7'5 3/8"	5 1/2"	10 1/2"	ms	B10	15'10 1/4"	7'11 1/8"	5 1/4"	11 1/8"	mac
B3	14'10 3/8"	7'5 1/2"	5 1/2"	10 1/2"	mt	B11	15'9 3/8"	7'10 3/8"	5 1/2"	11 1/2"	mad
B4	14'10 3/4"	7'5 3/8"	5 1/2"	10 1/2"	mt	B12	16'1 1/8"	8'0 1/8"	5 1/2"	11 1/2"	mad
B5	15'3 3/8"	7'7 1/2"	5 1/2"	10 1/2"	mw	B13	16'1 1/8"	8'0 1/2"	5"	11 3/8"	maf
B6	15'2 3/8"	7'7 1/2"	5 1/2"	10 1/2"	my	B14	14'11"	7'5 1/2"	5 1/2"	10 1/4"	mag
B7	15'6 3/8"	7'9 3/8"	5 1/2"	10 1/2"	mqa	B15	14'10 3/8"	7'5 1/2"	5 1/2"	10 1/4"	mah
B8	15'6 3/8"	7'9 3/8"	5 1/4"	11 1/2"	mab	B16	14'10 3/8"	7'5 1/2"	5 1/2"	10 3/8"	mt

MARK	K	MARK	K
C5	13'6 1/2"	C8	14'6 1/2"
C6	13'11"	C9	14'10 3/8"
C7	14'2 1/2"		

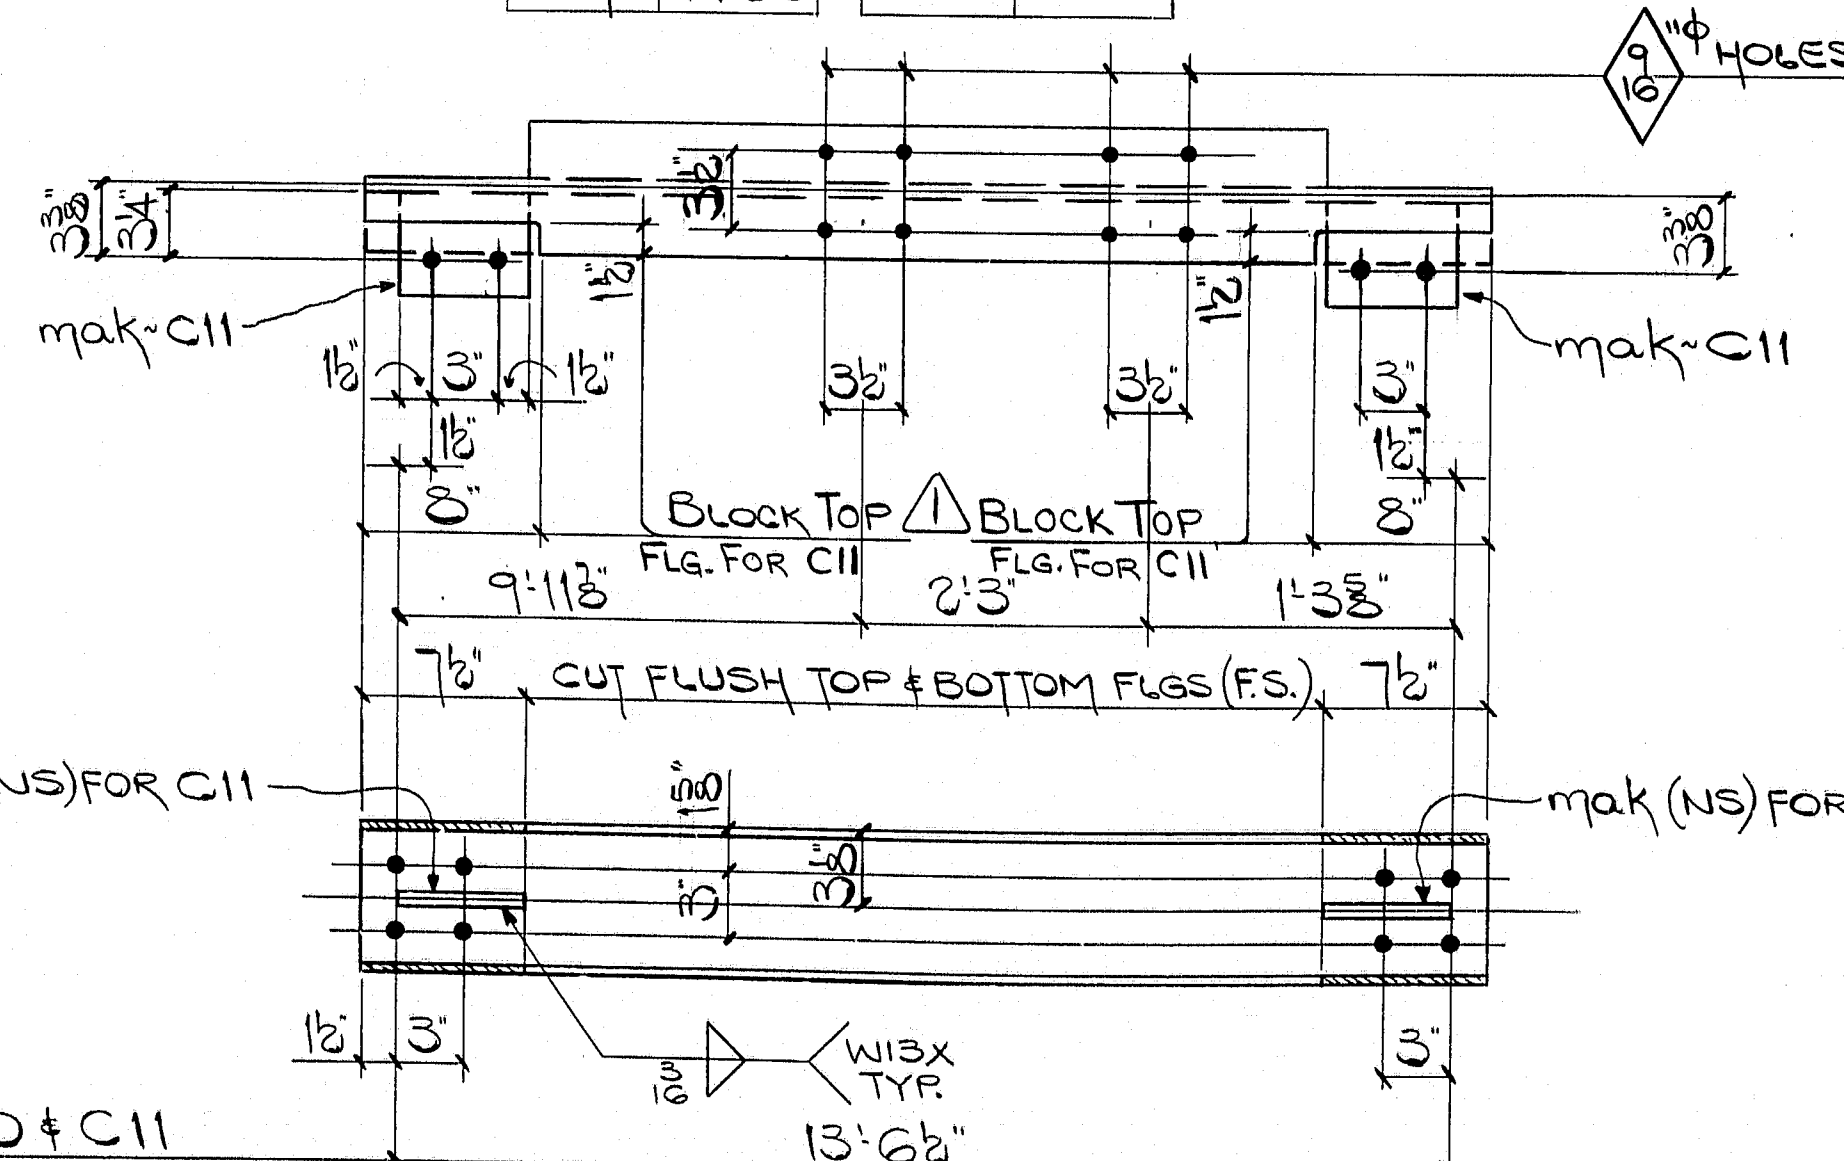

MS1	2'2 3/4"
MS2	1'6 3/4"
MS3	4'8 1/2"

BILL OF MATERIAL						
NO.	MARK	DESCRIPTION	LENGTH	REMARKS	ITEM	SHIP WEIGHT
22	C1	WT5x11	13 9/2		8 25	152
2	C2		14 2		8 23	156
2	C3		14 5 1/4		8 22	159
2	C4	WT5x11	14 9/2		8 21	163
52	C5	WT5x11	13 9/2		8 25	152
ONE	C6		14 2		8 23	156
ONE	C7		14 5 1/4		8 22	159
ONE	C8		14 9/2		8 21	163
3	C9	WT5x11	15 1 1/4		8 20	166
17	C10	WGx20	13 9/2		9 9	275
4	C11	WGx20	13 9/2		9 9	284
8	mak	BAR 4 1/2 x 1/2	0 6		9 21	
22	MS1	1/2 x 3 x 3/8	2 2 3/4		9 21	16
ONE	MS2	1/2 x 3 x 3/8	1 0 3/4		9 21	11
24	MS3	1/2 x 3 x 3/8	4 8 1/2		9 21	34

BILL OF MATERIAL						
NO.	MARK	DESCRIPTION	LENGTH	REMARKS	ITEM	SHIP WEIGHT
29	A1	WT5x11	15 5 1/4		8 16	170
9	A2		15 5 3/8		8 16	170
2	A3		15 4 3/4		8 19	170
74	A4		15 4 1/2		8 19	170
ONE	A5		15 9 1/4		8 12	173
2	A6		15 8 3/4		8 13	173
ONE	A7		16 0 1/2		8 9	177
ONE	A8		16 0 1/2		8 10	176
ONE	A9		15 11 1/2		8 11	176
ONE	A10		16 4		8 1	180
2	A11		16 3 3/8		8 8	179
ONE	A12		16 7 3/8		8 5	183
2	A13		16 6 1/2		8 6	182
17	A14		15 4 1/2		8 17	170
2	A15		15 4 3/8		8 18	170
2	A16	WT5x11	15 4 1/2		8 18	170
29	B1	WT5x11	15 5 1/4		8 16	181
9	B2		15 5 3/8		8 16	181
2	B3		15 4 3/4		8 19	180
74	B4		15 4 1/2		8 19	180
ONE	B5		15 9 1/4		8 12	184
2	B6		15 8 3/4		8 13	184
ONE	B7		16 0 1/2		8 9	188
ONE	B8		16 0 1/2		8 10	187
ONE	B9		15 11 1/2		8 11	187
ONE	B10		16 4		8 1	191
2	B11		16 3 3/8		8 8	190
ONE	B12		16 7 3/8		8 5	194
2	B13		16 6 1/2		8 6	193
17	B14		15 4 1/2		8 17	181
2	B15		15 4 3/8		8 18	180
2	B16	WT5x11	15 4 1/2		8 18	180
29	mp	BAR 6 x 2	1 0 3/8	B1	9 21	
9	ms		1 1	B2		
78	mt		1 1 1/2	B3, B4, B16		
1	mw		1 1 1/2	B5		
2	my		1 1 1/2	B6		
1	mqa		1 1 1/2	B7		
1	mab		1 1 1/2	B8		
2	mac		1 1 1/2	B9, B10		
3	mad		1 2 3/8	B11, B12		
2	mof		1 2 3/8	B13		
17	mog		1 1	B14		
2	mph	BAR 6 x 2	1 1	B15	9 21	

SHOP NOTE



HOLES: 15/16" (UNLESS NOTED)  
 BOLTS: NONE  
 PAINT: NONE  
 FOR GENERAL SHOP NOTES SEE DWG N1

R95-184 CODE: 5300


NO. 1	REVISION	REMOVE TOP FLG. BLOCK FOR C10	DATE 2-27-84
HIGH STEEL STRUCTURES, INC. 1905 Old Philadelphia Pike Lancaster, Pennsylvania 17603 Phone 717/299-5211 A Subsidiary of High Industries, Inc.			
CROSSFRAMES I-395 BRIDGE OVER PENOBSCOT RIVER I-395 BRIDGE STA. 164+20.00 PENOBSCOT COUNTY STATE OF MAINE DEPARTMENT OF TRANSPORTATION			
STATE CONTRACT OR REF. NO.	6	CONTRACTOR	CIANERO CORP.
IN CHARGE	HINKLE	MADE BY	C.S. JLC
CHARGE	ME-84088-3	CHK. DATE	9-26-84
DRAWING NUMBER	7	OF	47



AF 22003A

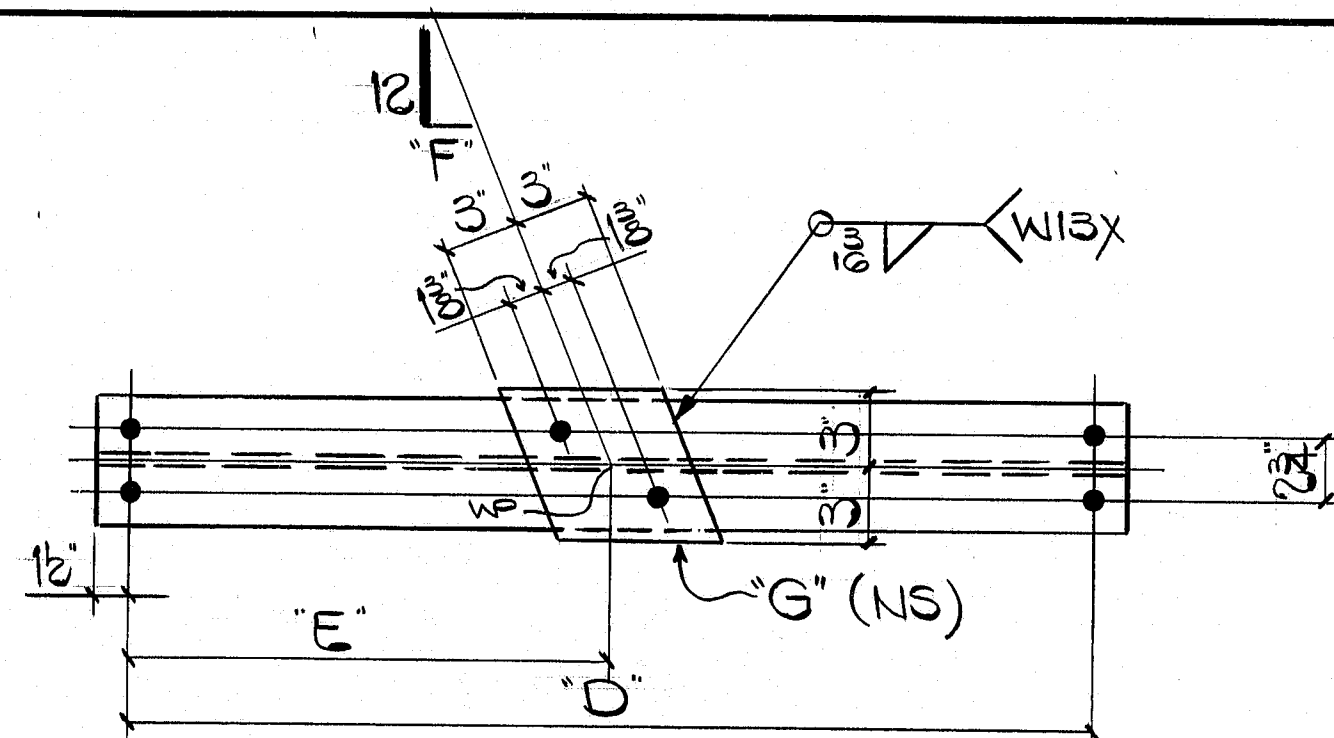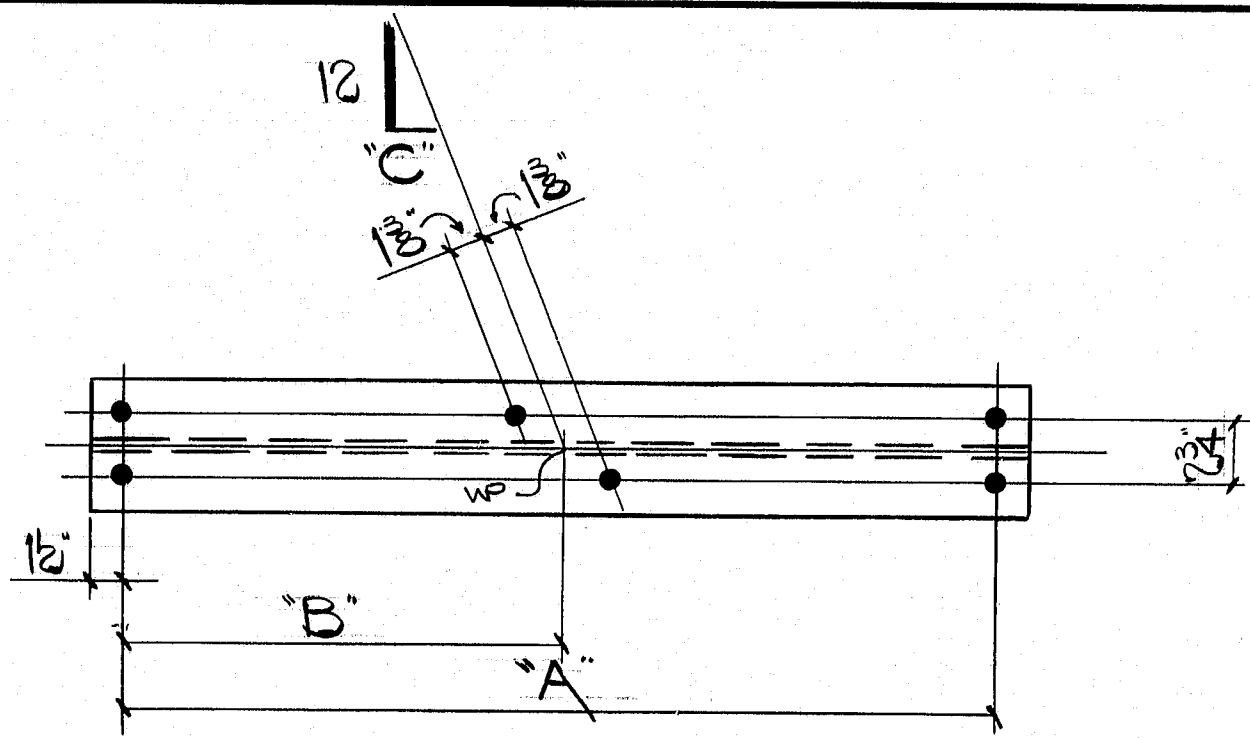


MARK	"A"	"B"	"C"	MARK	"A"	"B"	"C"
HB1	26'08"	12'11 1/2"	6 1/8"	HB25	26'08"	13'3 1/2"	7 1/8"
HB3	26'10"	13'4 1/2"	7 1/8"	HB27	26'11"	13'0 1/2"	6 1/8"
HB5	25'6"	12'9"	6 1/2"	HB29	26'04"	12'11 1/4"	6 1/8"
HB7	23'7 1/2"	11'9 1/2"	5 1/2"	HB31	25'9 1/2"	12'10 1/2"	6 1/8"
HB9	22'7 1/2"	11'3 1/2"	4 1/2"	HB33	26'11 1/2"	13'5 1/2"	7 1/8"
HB11	26'11 1/4"	13'5 1/2"	7 1/8"	HB35	26'7 1/2"	13'1 1/4"	6 1/8"
HB13	26'6 1/2"	13'3 1/2"	7 1/8"	HB37	26'8 1/2"	13'2"	6 1/8"
HB15	26'7 1/2"	13'3 1/2"	7 1/8"	HB39	26'10 1/2"	13'3 1/2"	6"
HB19	23'10 1/2"	11'10 1/2"	5 1/2"	HB41	27'0 1/2"	13'4 1/2"	5 1/2"
HB21	21'10"	10'10 1/2"	3 1/2"	HB43	26'7 1/2"	13'1 1/2"	5 1/2"
HB23	21'6 1/2"	10'9 1/2"	3 1/2"	HB45	26'9 1/4"	13'2 1/2"	5 1/2"
HB25	26'7 1/2"	13'4 1/2"	7 1/8"	HB47	26'11 1/2"	13'3 1/2"	5 1/2"
HB27	21'5 1/2"	10'8 1/2"	3 1/2"	HB49	25'9 1/2"	12'9 1/2"	6 1/2"
HB29	25'9 1/2"	12'10 1/2"	6 1/8"				

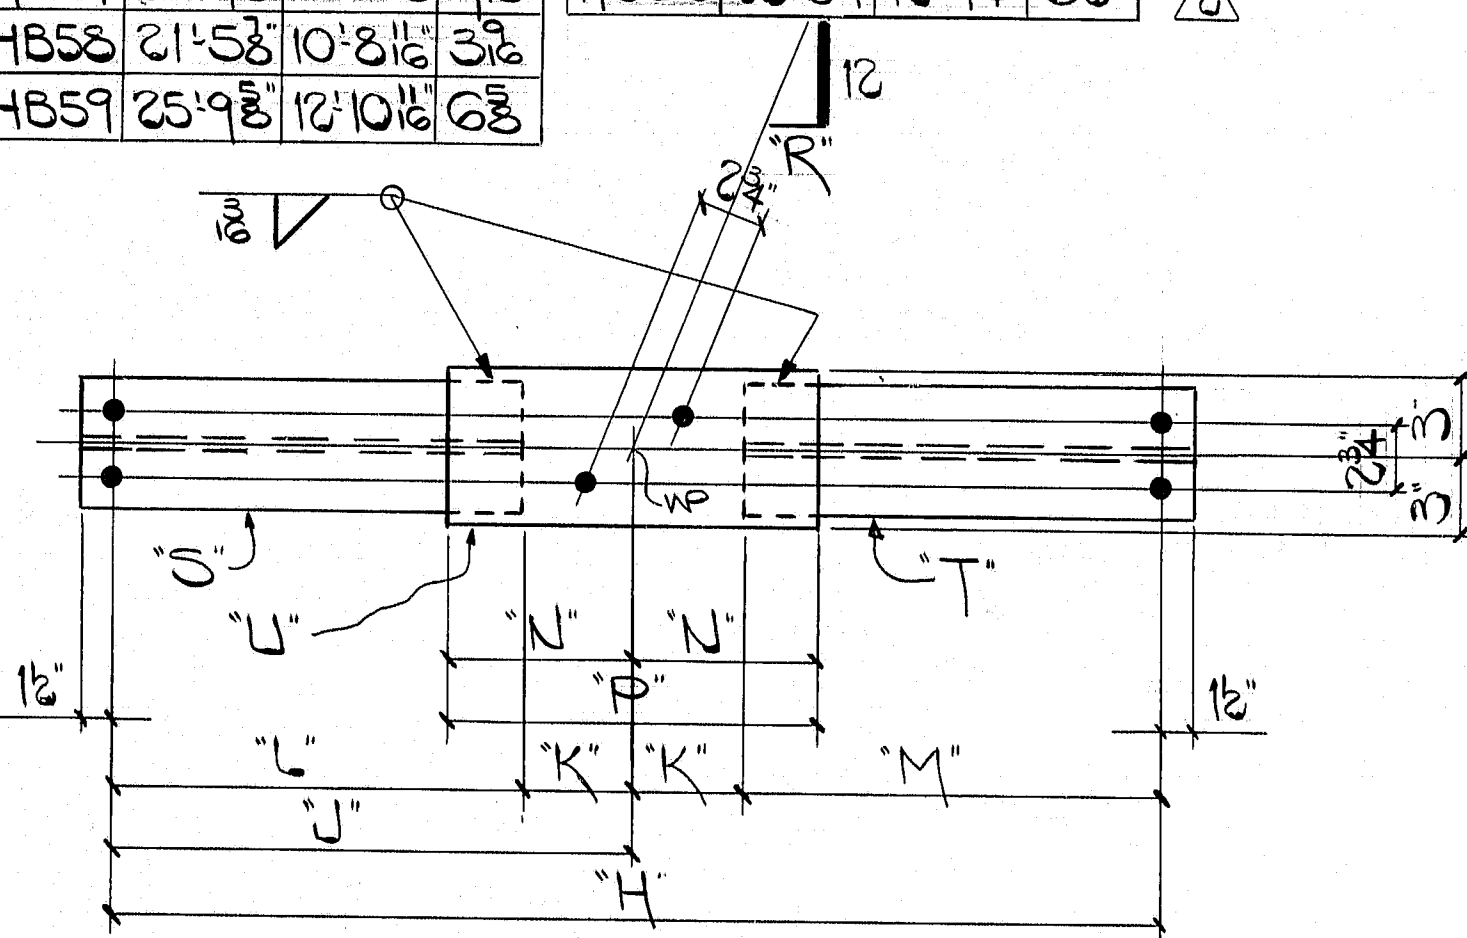

MARK	"H"	"J"	"K"	"L"	"M"	"N"	"P"	"R"	"S"	"T"	"U"
HB49	25'6 1/2"	12'9 1/2"	5 1/2"	12'4"	12'3 1/4"	9"	1'6"	6 1/2"	mckambk	mda	
HB50	23'7 1/2"	11'9 1/2"	5 1/2"	11'4 1/2"	11'5 1/2"	8 1/2"	1'5"	5 1/2"	mbm	mbn	mcf
HB51	26'7 1/2"	13'4 1/2"	6"	12'10 1/2"	12'9 1/2"	9 1/2"	1'7"	7 1/8"	mcm	mcp	md
HB52	26'7 1/2"	13'3 1/2"	6"	12'9 1/2"	12'10 1/2"	9 1/2"	1'7"	7 1/8"	mbm	mbt	md
HB53	21'5 1/2"	10'8 1/2"	3 1/2"	10'3 1/2"	10'4 1/2"	8"	1'4"	3 1/2"	mcm	mbw	mcq
HB54	26'8 1/2"	13'3 1/2"	6"	12'9 1/2"	12'10 1/2"	9 1/2"	1'7"	7 1/8"	mbm	mca	md
HB55	25'9 1/2"	12'10 1/2"	5 1/2"	12'4 1/2"	12'5 1/2"	9"	1'6"	6 1/2"	mcb	mcc	mch

MARK	"D"	"E"	"F"	"G"	MARK	"D"	"E"	"F"	"G"
HB2	26'08"	12'11 1/2"	6 1/8"	mam	HB26	26'08"	13'3 1/2"	7 1/8"	map
HB4	26'10"	13'4 1/2"	7 1/8"	mam	HB28	26'11"	13'0 1/2"	6 1/8"	mam
HB6	25'6"	12'9"	6 1/2"	mcp	HB30	26'04"	12'11 1/4"	6 1/8"	mam
HB8	23'7 1/2"	11'9 1/2"	5 1/2"	mas	HB32	25'9 1/2"	12'10 1/2"	6 1/8"	mab
HB10	22'7 1/2"	11'3 1/2"	4 1/2"	mpt	HB34	26'9 1/2"	13'4 1/2"	7 1/8"	mab
HB12	26'11 1/4"	13'5 1/2"	7 1/8"	man	HB36	25'9 1/2"	12'9 1/2"	6 1/8"	mab
HB14	26'6 1/2"	13'3 1/2"	7 1/8"	mcp	HB38	25'10 1/2"	12'9 1/2"	6 1/8"	mab
HB16	26'7 1/2"	13'3 1/2"	7 1/8"	mcp	HB40	26'08"	12'10 1/2"	6"	mab
HB20	23'10 1/2"	11'10 1/2"	5 1/2"	maw	HB42	26'2 1/2"	12'11 1/2"	5 1/2"	mab
HB22	21'10"	10'10 1/2"	3 1/2"	maw	HB44	26'5 1/4"	13'0 1/2"	5 1/2"	maw
HB24	21'6 1/2"	10'9 1/2"	3 1/2"	mab	HB46	26'3 1/2"	12'11 1/2"	5 1/2"	maw
HB26	26'08"	13'3 1/2"	7 1/8"	map	HB48	26'1 1/2"	12'10 1/2"	5 1/2"	maw

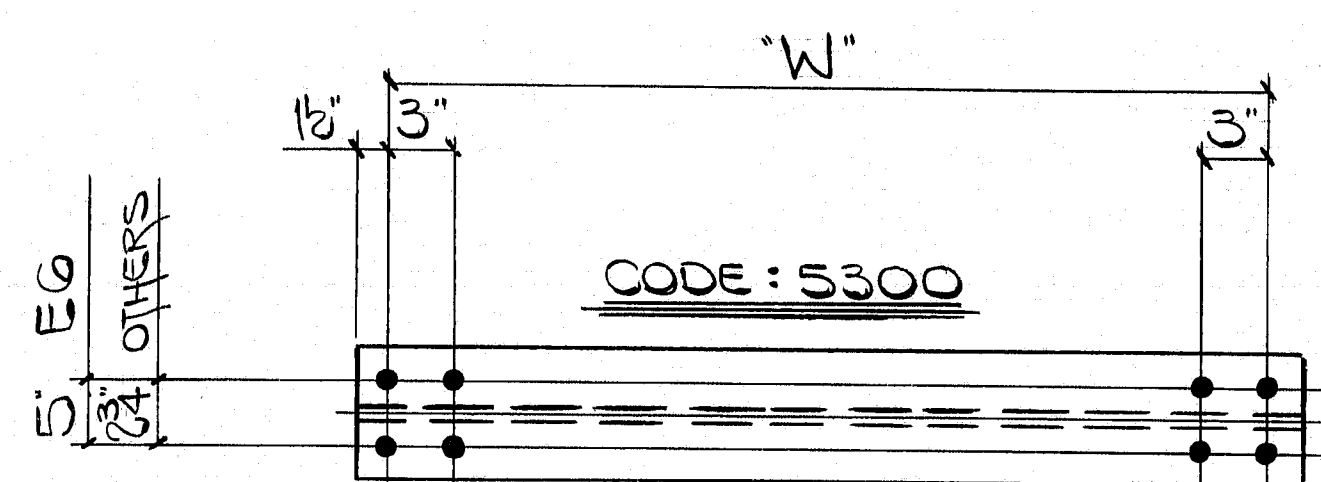

SHOP NOTE DIFFERENT WEIGHT WT'S.

MARK	"W"	MARK	"W"
E1	13'6 1/2"	E4	14'6 1/2"
E2	13'11"	E5	14'10 1/2"
E3	14'2 1/2"	E6	13'6 1/2"

BILL OF MATERIAL					
NO.	MARK	DESCRIPTION	LENGTH	REMARKS	ITEM
1	HB46	WT5 x 11	26'08"		1 300
1	HB48	WT5 x 11	26'4 1/2"		1 298
6	mam	BAR G x 2	0 10 1/2"	HB2, HB28, HB30	2 291
15	man		0 10 1/2"	HB4, HB12	
18	mab		0 10 1/2"	HB6	
6	mas		0 9 1/2"	HB8	
8	mat		0 8 1/2"	HB10	
7	maw		0 9 1/2"	HB18, HB20, HB44, HB46, HB48	
4	may		0 8 1/2"	HB22	
6	mcb		0 8 1/2"	HB24	
114	E1	WT5 x 11	13'9 1/2"		3 152
3	E2		14'2"		3 156
3	E3		14'5 1/2"		3 159
3	E4		14'9 1/2"		3 163
3	E5	WT5 x 11	15'14"		3 166
21	E6	WT7 x 21.5	13'9 1/2"		3 297

SHOP NOTE

HOLES: 1/2"

BOLTS: NONE

PAINT: NONE

FOR GENERAL SHOP NOTES SEE DWG. N1

R95-185

Code: 5500 (U.N.)

FED. ROAD DIV. NO.		STATE	FED. AID PROJ. NO.
1		Me	HG395-8(82)176

BILL OF MATERIAL					
NO.	MARK	DESCRIPTION	LENGTH	REMARKS	ITEM
2	HB1	WT5 x 11	26'3 1/2"		1 289
11	HB3		27'1 1/2"		1 298
6	HB5		25'9"		1 283
7	HB7		23'10 1/2"		1 264
8	HB9		22'10 1/2"		1 252
4	HB11		27'2 1/4"		1 300
6	HB13		26'9 1/2"		1 295
7	HB15		26'10 1/2"		1 296
4	HB19		24'1 1/2"		1 266
4	HB21		22'1"		1 243
6	HB23		21'9 1/2"		1 240
7	HB25		26'11 1/2"		1 297
1	HB27		26'4"		1 290
3	HB29		26'3 1/4"		1 289
3	HB31		26'0 1/2"		1 286
1	HB33		27'2 1/2"		1 300
1	HB35		26'10 1/2"		1 296
1	HB37		26'11 1/2"		1 297
1	HB39		27'1 1/2"		1 298
1	HB41		27'1 1/2"		1 300
1	HB43		26'10 1/2"		1 296
1	HB45		27'1 1/2"		1 298
1	HB47		26'11 1/2"		1 297
1	HB49		26'10 1/2"		1 296
1	HB51		26'10 1/2"		1 296
1	HB53		26'10 1/2"		1 296
1	HB55		26'10 1/2"		1 296
2	HB2	WT5 x 11	26'3 1/2"		1 289
11	HB4		27'1 1/2"		1 298
6	HB6		25'9"		1 283
7	HB8		23'10 1/2"		1 264
8	HB10		22'10 1/2"		1 252
4	HB12		27'2 1/4"		1 300
6	HB14		26'9 1/2"		1 295
6	HB16		26'10 1/2"		1 296
4	HB20		24'1 1/2"		1 266
4	HB22		22'1"		1 243
6	HB24		21'9 1/2"		1 240
7	HB26		26'11 1/2"		1 297
3	HB28		26'4"		1 290
3	HB30		26'3 1/4"		1 289
3	HB32		26'0 1/2"		1 286
1	HB34		27'2 1/2"		1 300
1	HB36		26'10 1/2"		1 296
1	HB38		26'11 1/2"		1 297
1	HB40		26'10 1/2"		1 296
1	HB42		26'10 1/2"		1 296
  

NO.	REV.	REVISION	DATE
1	1	REV. REVISION	11-19-84

HIGH STEEL STRUCTURES, INC.	
1905 Old Philadelphia Pike Lancaster, Pennsylvania 17603 Phone 717/298-5211	
A Subsidiary of High Industries, Inc.	
HORIZONTAL BRACING & CROSSFRAMES	
I-395 BRIDGE OVER PENOBSCOT RIVER	
I-395 BRIDGE STA. 164+60.00	
PENOBSCOT COUNTY	
STATE OF MAINE	
DEPARTMENT OF TRANSPORTATION	
STATE CONTRACT OR REF. NO.	CONTRACTOR
IN CHARGE: HINKLE	MADE C.S. CHK'D. JLC
BY: HINKLE	DATE: 9-26-84
CONTRACT NUMBER: ME-84088-3	DRAWING NUMBER: 8 OF 47



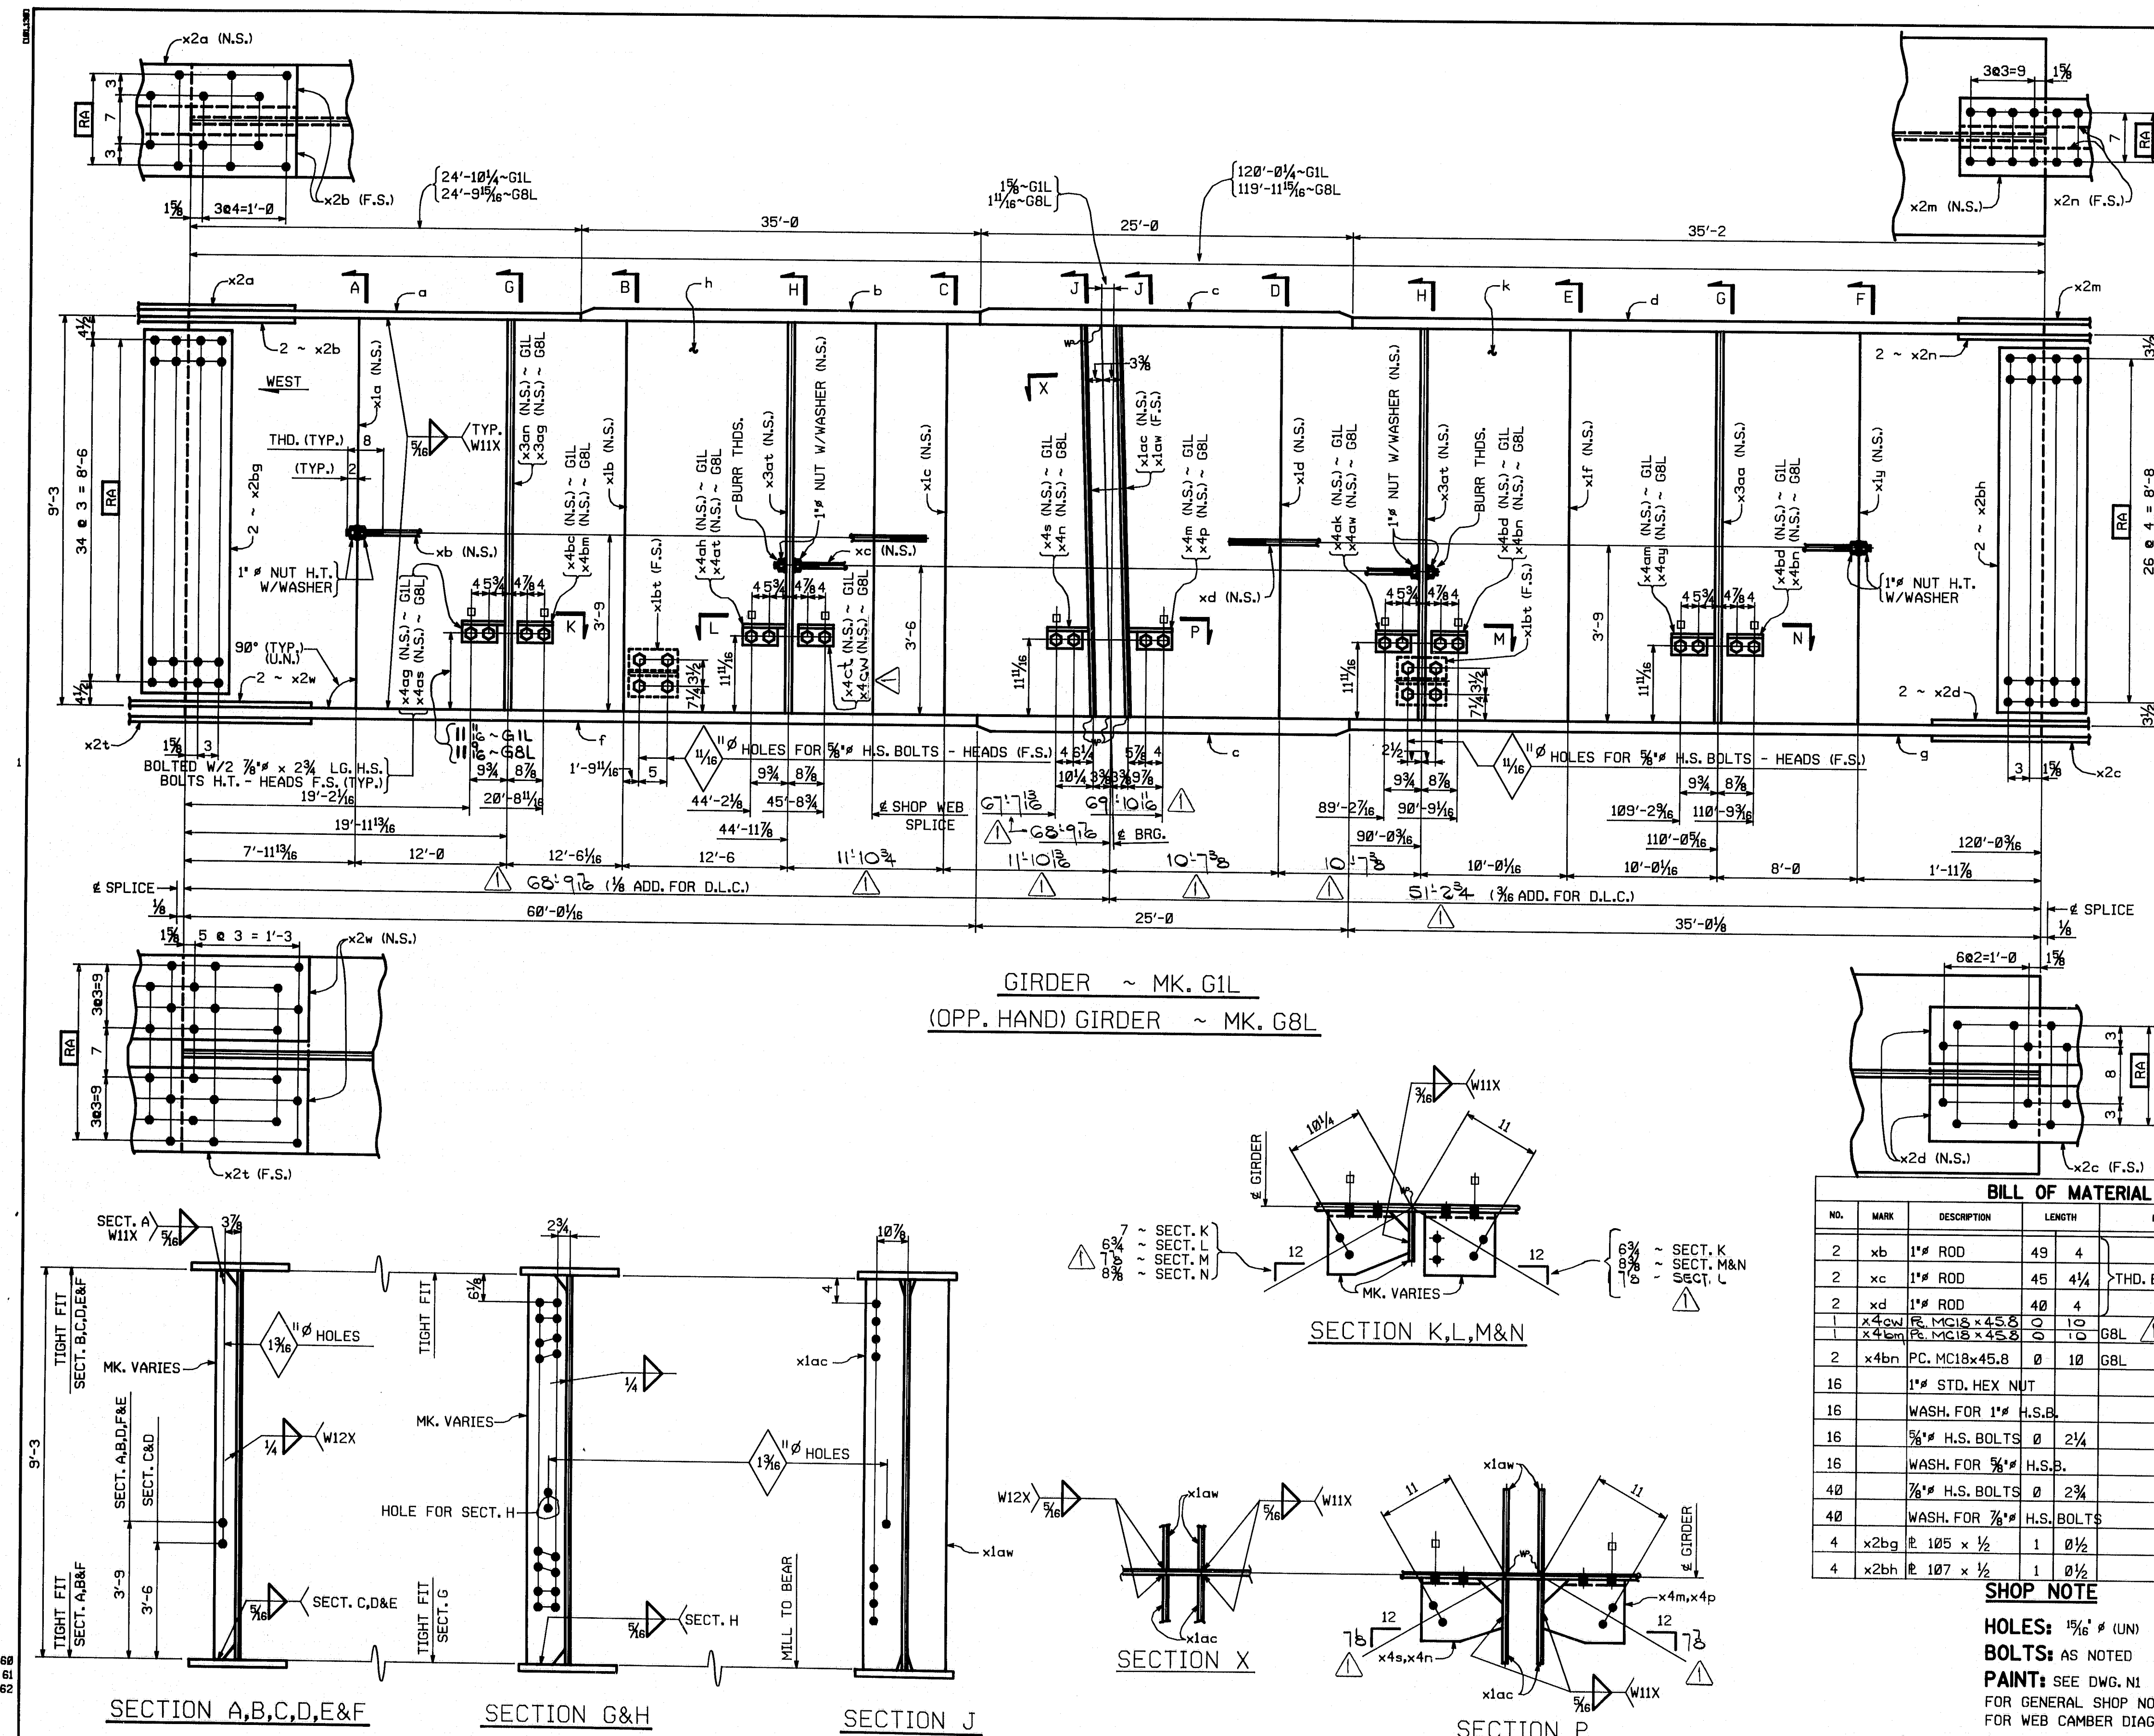

BILL OF MATERIAL					
NO.	MARK	DESCRIPTION	LENGTH	REMARKS	ITEM
2	xb	1" ROD	49	4	5
2	xc	1" ROD	45	4 1/2	5
2	xd	1" ROD	40	4	5
2	x4bn	PC. MC18x45.8	0	10	5
16		1" STD. HEX NUT			14
16		WASH. FOR 1" H.S.B.			12
16		5/8" H.S. BOLTS	0	2 1/4	13
16		WASH. FOR 5/8" H.S.B.			10
4	x2bg	1" 105 x 1/2	1	0 1/2	
4	x2bh	1" 107 x 1/2	1	0 1/2	

#### SHOP NOTE

BOLTS: AS NOTED  
PAINT: SEE DWG. N1  
FOR GENERAL SHOP NOTES, SEE DWG. N1.  
FOR WEB CAMBER DIAGRAM, SEE DWG. WCI.

BILL OF MATERIAL					
NO.	MARK	DESCRIPTION	LENGTH	REMARKS	ITEM
ONE	GIL	GIRDER			74,725
ONE	G8L	GIRDER		(OPP. HAND)	74,725
1	h	111 x 3/4	50	0 1/2	GIL
1	a	16 x 1"	24	10 1/4	GIL
1	a	16 x 1"	24	9 1/2	G8L
2	b	28 x 1 1/2	35	0	
4	c	28 x 2 1/4	25	0	
2	d	28 x 1 1/2	35	2	
2	f	28 x 1 1/2	60	0 1/2	
2	g	28 x 1 1/2	35	0 1/2	
1	h	111 x 3/4	50	0 1/2	G8L
2	k	111 x 3/4	70	0 1/2	
2	x2a	16 x 1/2	2	6 1/2	
4	x2b	BAR 6 x 3/4	2	6 1/2	
2	x2c	19 x 1 1/2	2	6 1/2	
4	x2d	BAR 8 x 7/8	2	6 1/2	
2	x2m	11 x 1/2	2	0 1/2	
4	x2n	BAR 4 x 3/4	2	0 1/2	
2	x2t	28 x 7/8	3	0 1/2	
4	x2w	12 x 1"	3	0 1/2	
2	x1a	BAR 6 x 3/8	9	3	
2	x1b	BAR 6 x 3/8			
2	x1c	BAR 6 x 3/8			
2	x1d	BAR 5 x 1/2			
2	x1f	BAR 5 x 1/2			
2	x1y	BAR 7 x 3/8			
4	x1ac	12 x 1 1/2			
4	x1aw	12 x 1 1/2	9	3	
4	x1bt	WT 6X13	0	8	
2	x3aa	BAR 7 x 3/8	9	3	
1	x3ag	BAR 7 x 1/2	9	3	G8L
1	x3an	BAR 7 x 1/2	9	3	GIL
4	x3at	BAR 7 x 1/2	9	3	
1	x4m	PC. MC18x45.8	0	11 1/2	GIL
1	x4n				G8L
1	x4p				G8L
1	x4s				GIL
1	x4ag				GIL
1	x4ah				GIL
1	x4ak				GIL
1	x4am				GIL
1	x4as				G8L
1	x4at				G8L
1	x4aw				G8L
1	x4ay				0 11 1/2 G8L
1	x4at				0 10 GIL
1	x4as				0 10 GIL
2	x4bd	PC. MC18x45.8	0	10	GIL

NO. 1 REVISION 1-12-85

DATE 1-12-85

1905 Old Philadelphia Pike  
Lancaster, Pennsylvania 17603  
Phone 717/299-525

**HIGH STEEL STRUCTURES, INC.**

GIRDERS GIL, G8L

I-395 BRIDGE OVER PENOBSCOT RIVER

I-395 BRIDGE STA. 164+60.00

PENOBSCOT COUNTY

STATE OF MAINE

DEPARTMENT OF TRANSPORTATION

STATE CONTRACT OR REF. NO. 6 CONTRACTOR CIANBRO CORP.

IN CHARGE HINKLE MADE BY S.J.A. CHK'D BY J.L.C. DATE 9-27-84


CONTRACT NUMBER ME-84088-3 DRAWING NUMBER 9 OF 47

R95-186

CODE:4000





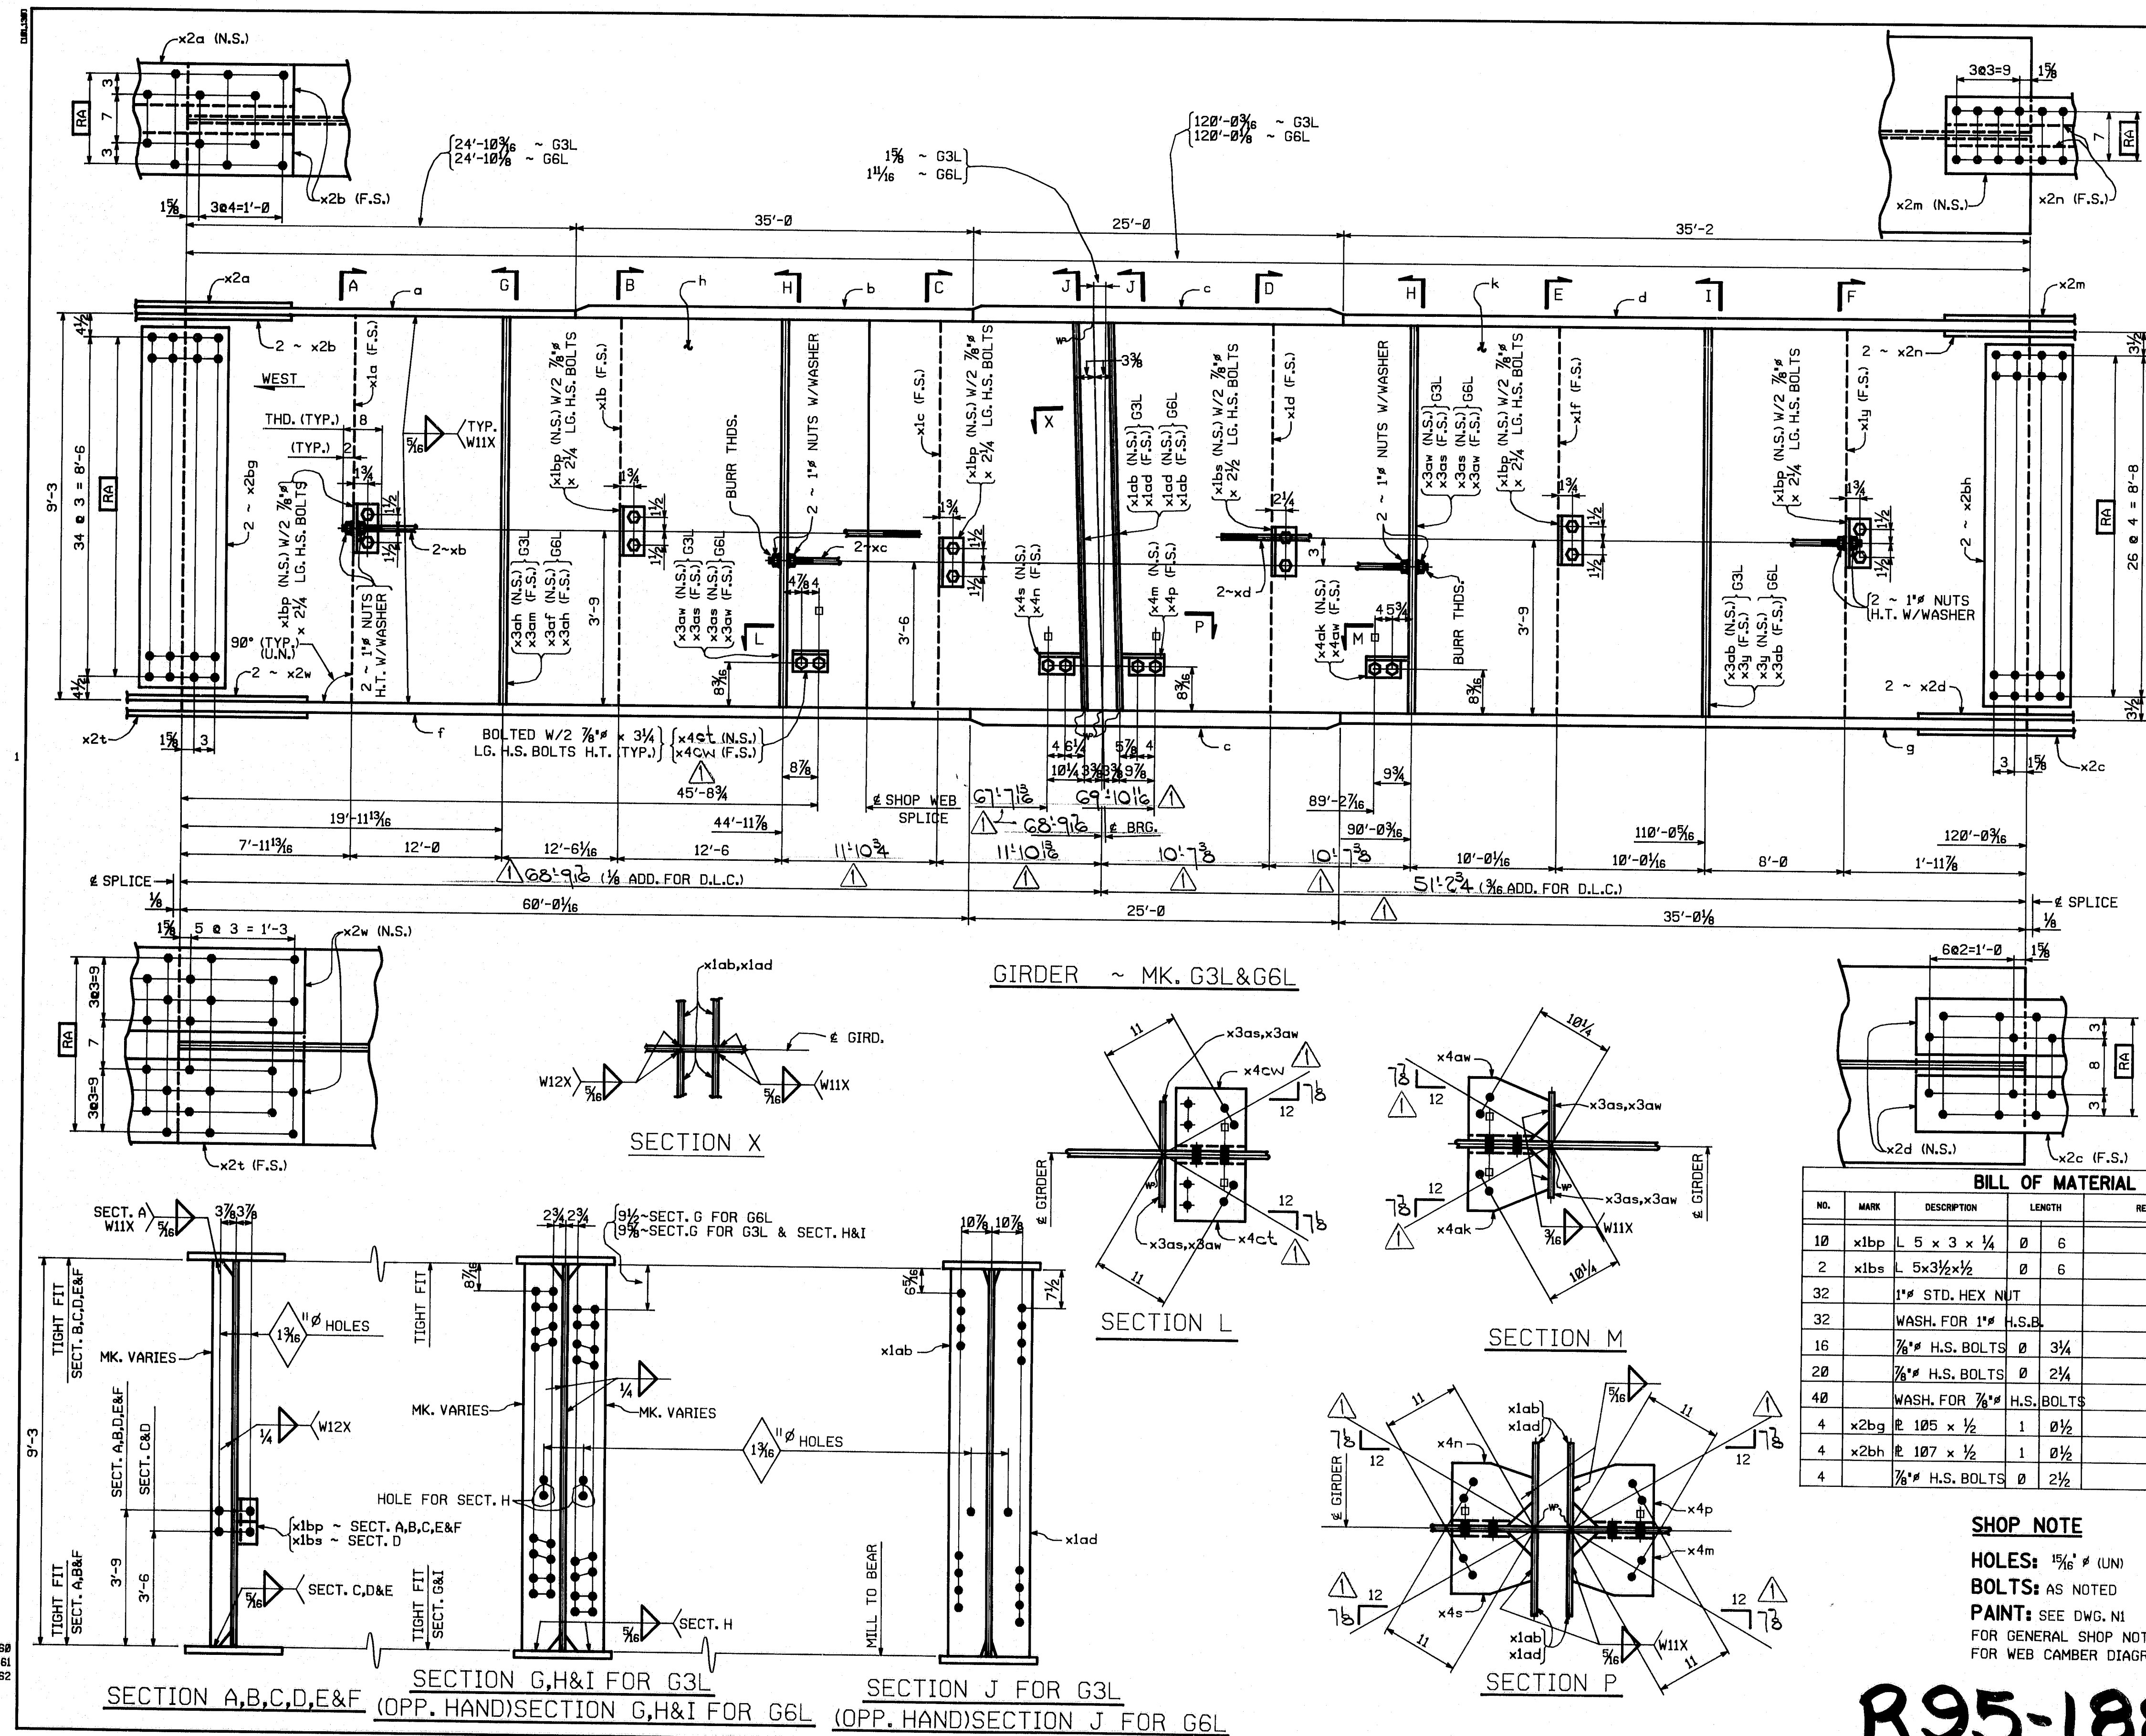

NO.	MARK	DESCRIPTION	LENGTH	REMARKS	ITEM	SHIP WEIGHT
10	x1bp	L 5 x 3 x 1/4	0	6		
2	x1bs	L 5 x 3 1/2 x 1/2	0	6		
32		1" STD. HEX NUT			B1 14	
32		WASH. FOR 1" H.S. B.			B1 12	
4	x2bg	L 105 x 1/2	1	0 1/2		
4	x2bh	L 107 x 1/2	1	0 1/2		
4		3/4" H.S. BOLTS	0	2 1/2	B1 6	

**SHOP NOTE**

HOLES: 15/16" (UN)

BOLTS: AS NOTED

PAINT: SEE DWG. N1

FOR GENERAL SHOP NOTES, SEE DWG. N1.

FOR WEB CAMBER DIAGRAM, SEE DWG. WCI.

FED. ROAD DIV. NO.		STATE	FED. ROAD PROJ. NO.
1	ME.	1-10-395-8182176	

BILL OF MATERIAL						
NO.	MARK	DESCRIPTION	LENGTH	REMARKS	ITEM	SHIP WEIGHT
ONE	G3L	GIRDER				75.605
ONE	G6L	GIRDER				75.605
1	a	L 16 x 1"	24	10 3/8	G3L	
1	a	L 16 x 1"	24	10 3/8	G6L	
2	b	L 28 x 1 1/2	35	0		
4	c	L 28 x 2 1/4	25	0		
2	d	L 28 x 1 1/2	35	2		
2	f	L 28 x 1 1/2	60	0 1/8		
2	g	L 28 x 1 1/2	35	0 1/8		
1	h	L 111 x 3/4	50	0 3/8	G3L	
1	h	L 111 x 3/4	50	0 3/8	G6L	
2	k	L 111 x 3/4	70	0 3/8		
2	x2a	L 16 x 1"	2	6 1/2		
4	x2b	BAR 6 x 3/4	2	6 1/2		
2	x2c	L 19 x 1 1/8	2	6 1/2		
4	x2d	BAR 8 x 7/8	2	6 1/2		
2	x2m	L 11 x 1 1/2	2	0 1/2		
4	x2n	BAR 4 x 3/4	2	0 1/2		
2	x2t	L 28 x 7/8	3	0 1/2		
4	x2w	L 12 x 1"	3	0 1/2		
2	x1a	BAR 6 x 3/8	9	3		
2	x1b	BAR 6 x 3/8				
2	x1c	BAR 6 x 3/8				
2	x1d	BAR 5 x 1/2				
2	x1f	BAR 5 x 1/2				
2	x1y	BAR 7 x 3/8				
4	x1ab	L 12 x 1 1/8				
4	x1ad	L 12 x 1 1/8				
2	x3y	BAR 7 x 3/8				
2	x3ab	BAR 7 x 3/8				
1	x3am	BAR 7 x 1/2			G3L	
1	x3af				G6L	
4	x3as					
2	x3ah					
4	x3aw	BAR 7 x 1/2	9	3		
2	x4m	PC. MC18x45.8	0	11 1/2		
2	x4n					
2	x4p					
2	x4s					
2	x4ak					
2	x4aw					
2	x4ct					
2	x4cw	PC. MC18x45.8	0	10		
4	xb	1" ROD	49	4		5.9
4	xc	1" ROD	45	4 1/4	THD. BOTH ENDS	5.4
4	xd	1" ROD	40	4		5.2


NO.	REVISION	DATE	REMARKS
1	1-12-85		Revised span length

HIGH STEEL STRUCTURES, INC.		1005 Old Philadelphia Pike Lancaster, Pennsylvania 17603 Phone 717/299-9231	
GIRDERS		G3L, G6L	
I-395 BRIDGE OVER PENOBSCOT RIVER			
I-395 BRIDGE STA. 16+60.00			
PENOBSCOT COUNTY			
STATE OF MAINE			
DEPARTMENT OF TRANSPORTATION			
STATE CONTRACT OR REF. NO.	6	CONTRACTOR	CIANBRO CORP.
IN CHARGE	HINKLE	MADE BY	S.J.A.
CHANGED		CHK'D. BY	JLC
CONTRACT NUMBER	ME-84088-3	DATE	9-28-84
DRAWING NUMBER	11 OF 47		

**R95-188**



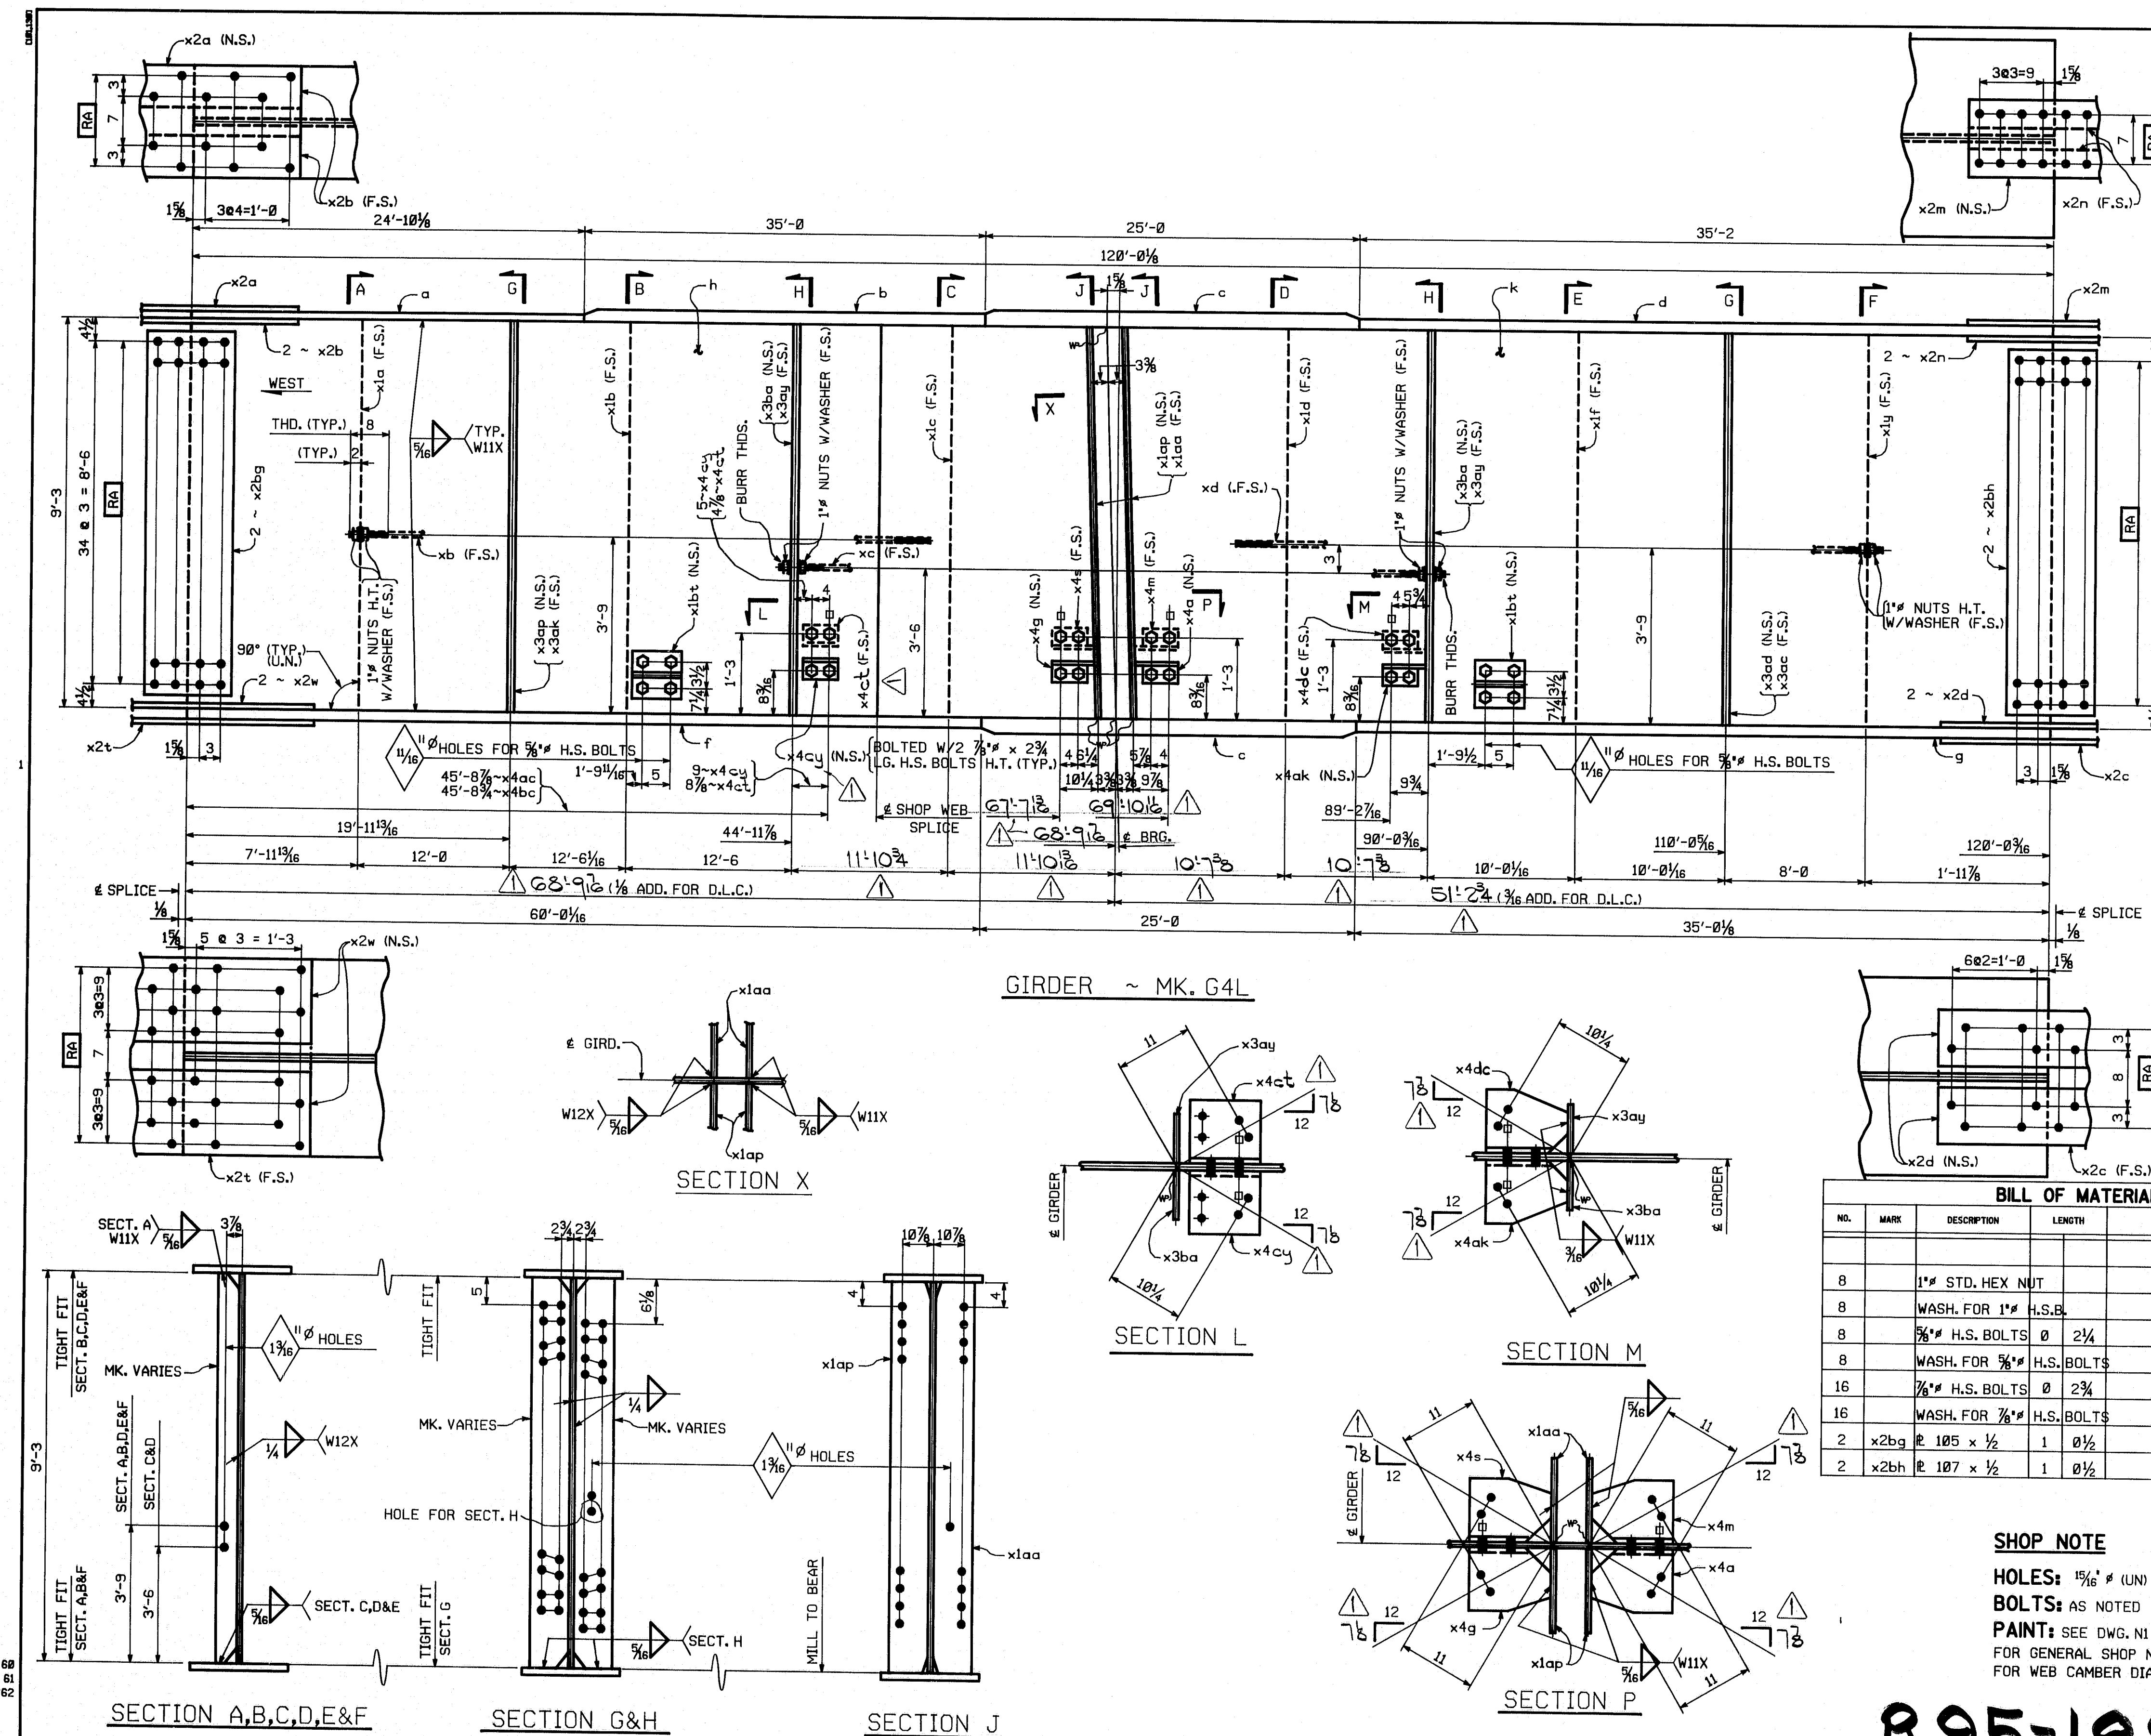

FED. ROAD DIV. NO.		STATE	FED. AID PROJ. NO.
1		ME.	1-10-395-8(82)176

BILL OF MATERIAL						
NO.	MARK	DESCRIPTION	LENGTH	REMARKS	ITEM	SHR. WEIGHT LB.
ONE	G4L	GIRDER				75275
1	a	16 x 1"	24	10 1/2		
1	b	28 x 1 1/2	35	0		
2	c	28 x 2 1/4	25	0		
1	d	28 x 1 1/2	35	2		
1	f	28 x 1 1/2	60	0 1/2		
1	g	28 x 1 1/2	35	0 1/2		
1	h	111 x 3/4	50	0 3/8		
1	k	111 x 3/4	70	0 3/8		
1	x2a	16 x 1/2	2	6 1/2		
2	x2b	BAR 6 x 3/4	2	6 1/2		
1	x2c	19 x 1 1/8	2	6 1/2		
2	x2d	BAR 8 x 7/8	2	6 1/2		
1	x2m	11 x 1/2	2	0 1/2		
2	x2n	BAR 4 x 3/4	2	0 1/2		
1	x2t	28 x 7/8	3	0 1/2		
2	x2w	12 x 1"	3	0 1/2		
1	x1a	BAR 6 x 3/8	9	3		
1	x1b	BAR 6 x 3/8				
1	x1c	BAR 6 x 3/8				
1	x1d	BAR 5 x 1/2				
1	x1f	BAR 5 x 1/2				
1	x1y	BAR 7 x 3/8				
2	x1aa	12 x 1 1/8				
2	x1ap	12 x 1 1/8				
1	x3ac	BAR 7 x 3/8				
1	x3ad	BAR 7 x 3/8				
1	x3ak	BAR 7 x 1/2				
1	x3ap					
2	x3ay					
2	x3ba	BAR 7 x 1/2	9	3		
2	x1bt	WT 6 x 13	0	8		
1	x4m	PC, MC18x45.8	0	11 1/2		
1	x4a					
1	x4g					
1	x4s					
1	x4ak		0	11 1/2		
1	x4ct		0	10		
1	x4ay	PC, MC18x45.8	0	9 1/2		
1	x4dc	PC, MC18x45.8	0	11 1/2		
8	1"	STD. HEX NUT				
8	WASH.	FOR 1" H.S.B.				
8	3/8"	H.S. BOLTS	0	2 1/4		
8	WASH.	FOR 3/8" H.S. BOLTS				
16	3/8"	H.S. BOLTS	0	2 3/4		
16	WASH.	FOR 3/8" H.S. BOLTS				
2	x2bg	105 x 1/2	1	0 1/2		
2	x2bh	107 x 1/2	1	0 1/2		

NO.	MARK	DESCRIPTION	LENGTH	REMARKS	ITEM	SHR. WEIGHT LB.
8	1"	STD. HEX NUT			BJ 14	
8	WASH.	FOR 1" H.S.B.			BJ 12	
8	3/8"	H.S. BOLTS	0	2 1/4	BJ 3	
8	WASH.	FOR 3/8" H.S. BOLTS			BJ 10	
16	3/8"	H.S. BOLTS	0	2 3/4	BJ 7	
16	WASH.	FOR 3/8" H.S. BOLTS			BJ 11	
2	x2bg	105 x 1/2	1	0 1/2		
2	x2bh	107 x 1/2	1	0 1/2		

NO.	REVISION	REASON	DATE
1	1	Revised span length	1-12-85

**HIGH STEEL STRUCTURES, INC.**

1905 Old Philadelphia Pike  
 Lancaster, Pennsylvania 17603  
 Phone 717/299-525

**GIRDER** G4L

I-395 BRIDGE OVER PENOBSCOT RIVER

I-395 BRIDGE STA. 164+60.00

PENOBSCOT COUNTY

STATE OF MAINE

DEPARTMENT OF TRANSPORTATION

STATE CONTRACT OR REF. NO. 6 CONTRACTOR CIAMBRO CORP.

IN CHARGE HINKLE MADE BY S.J.A. CHK'D BY J.L.C. DATE 9-28-84


CONTRACT NUMBER ME-84088-3 DRAWING NUMBER 12 OF 47

R95-189

CODE:4000





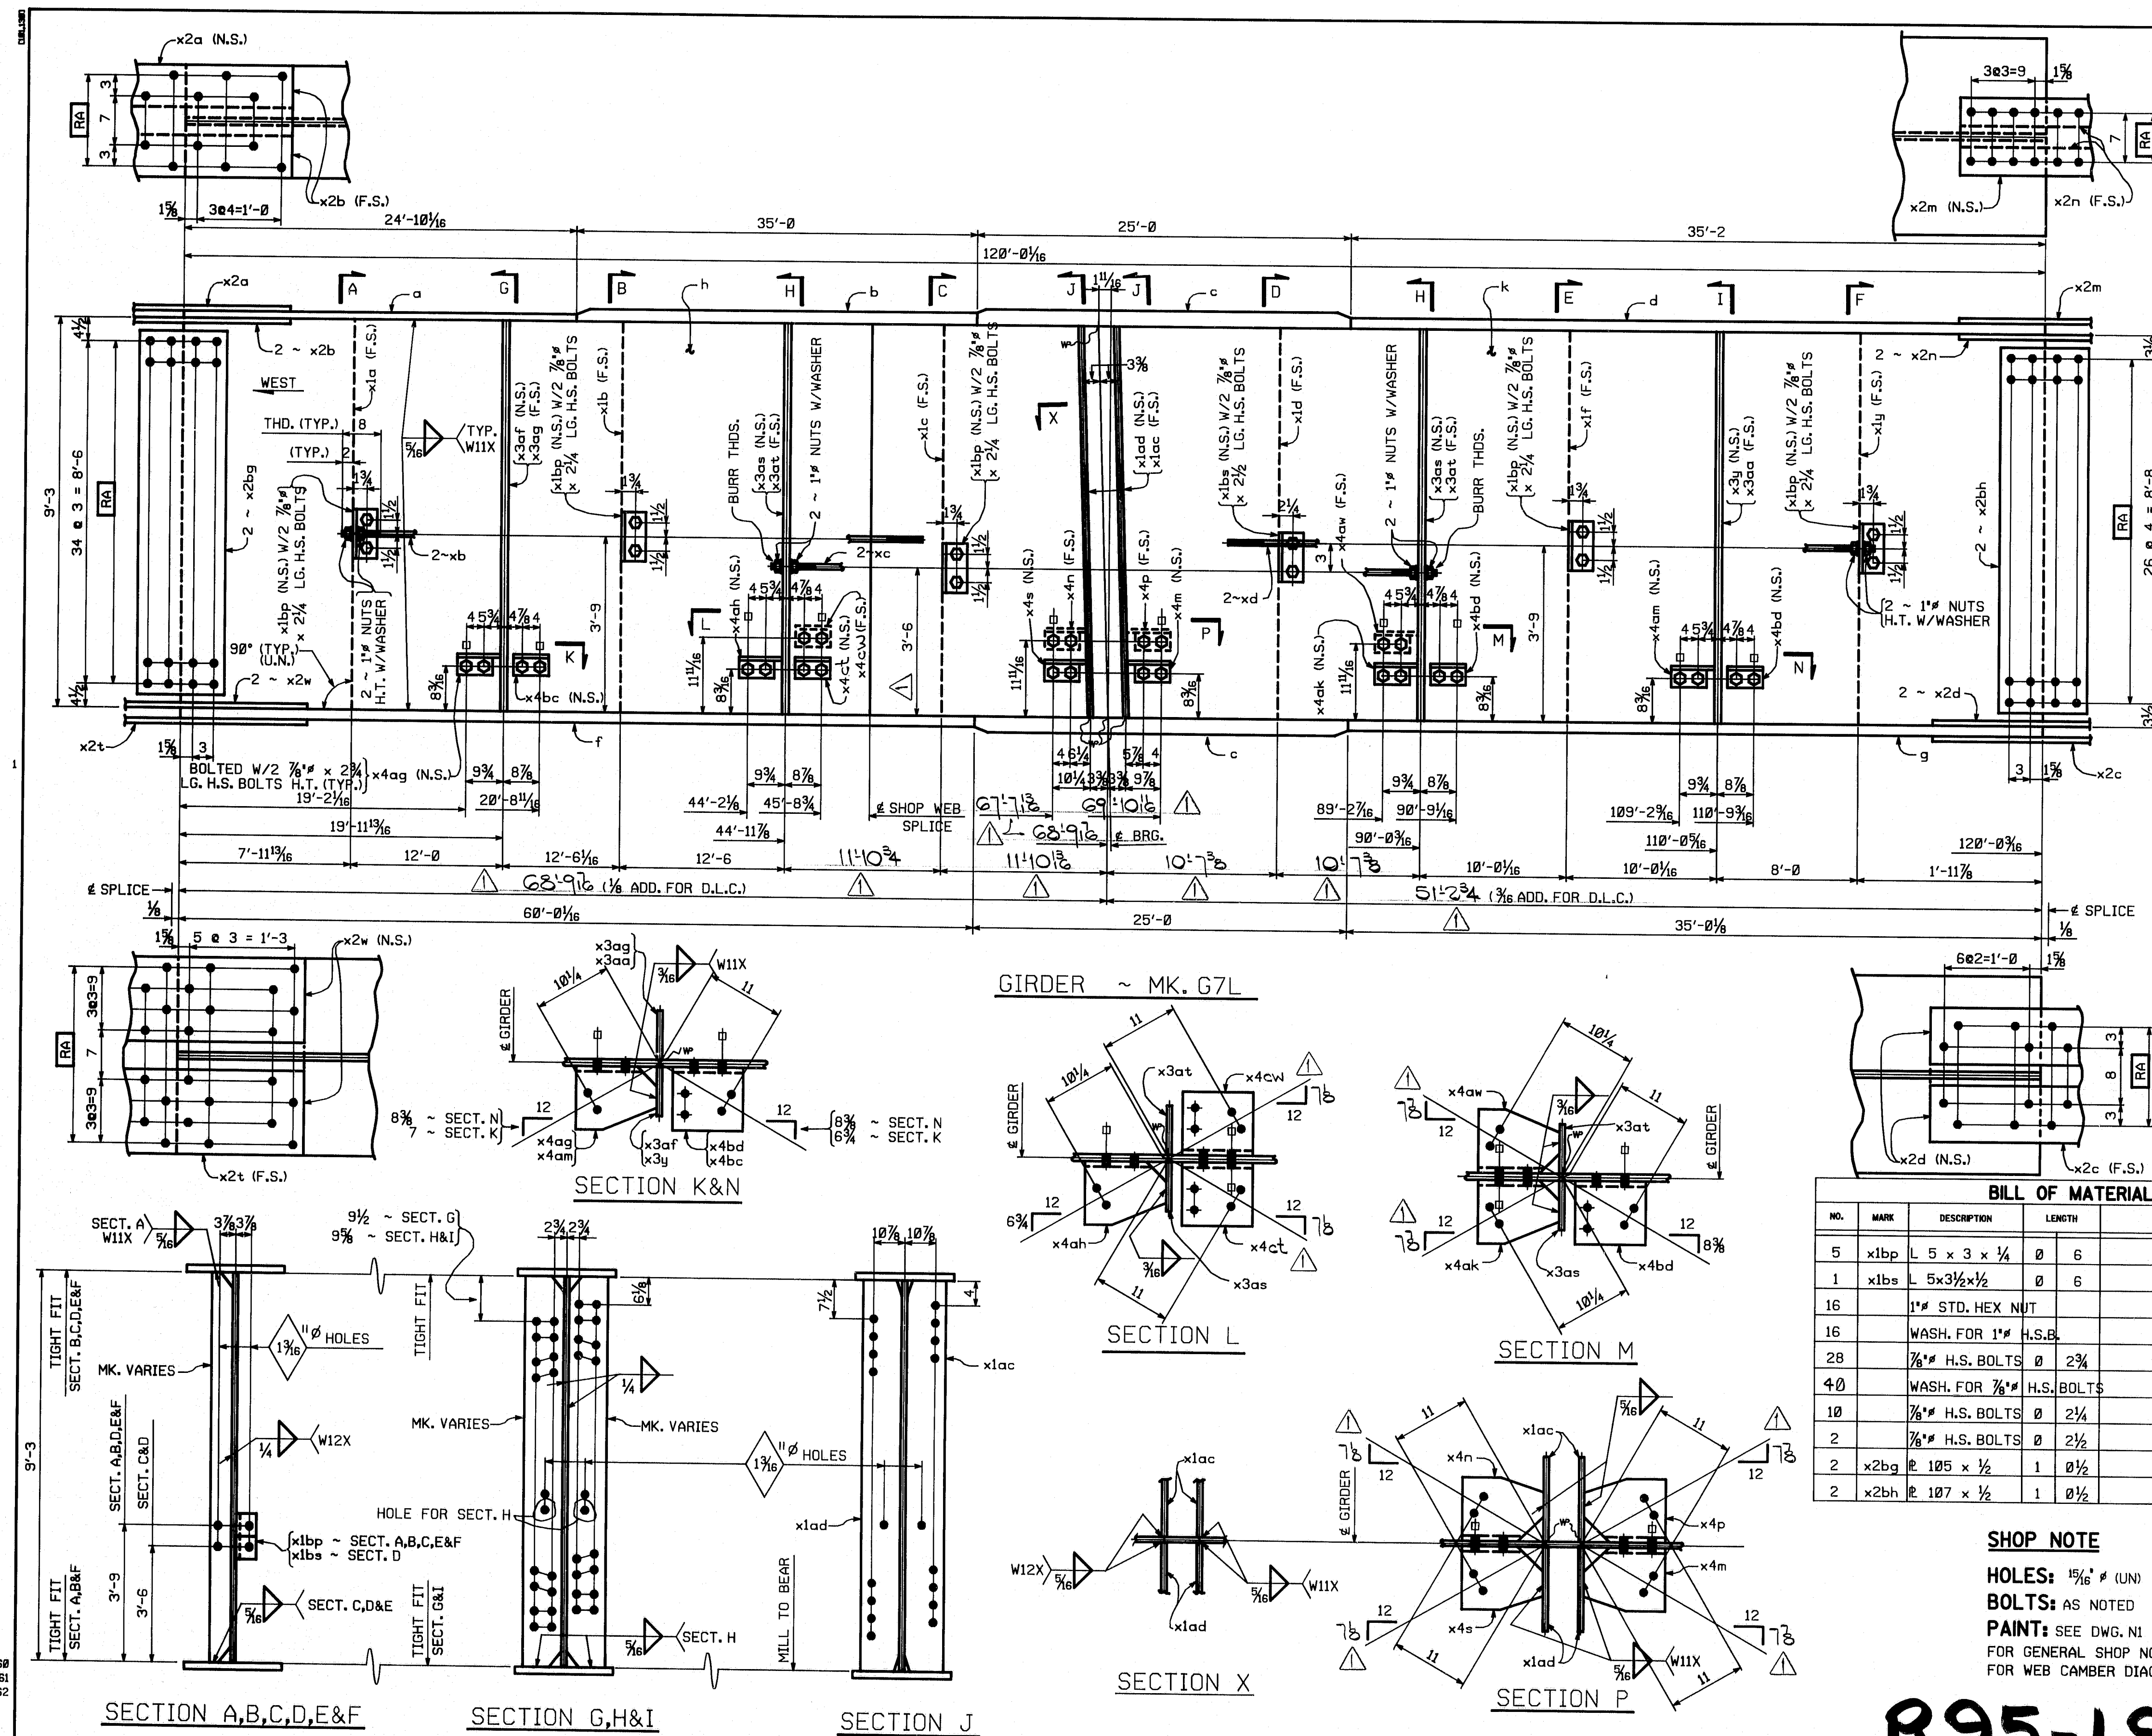

BILL OF MATERIAL					
NO.	MARK	DESCRIPTION	LENGTH	REMARKS	ITEM
1	x1bp	L 5 x 3 x 1/4	0	6	
1	x1bs	L 5 x 3 1/2 x 1/2	0	6	
16		1" STD. HEX NUT			B1 14
16		WASH. FOR 1" H.S.B.			B1 12
28		3/8" H.S. BOLTS	0	2 3/4	B1 7
40		WASH. FOR 3/8" H.S. BOLTS			B1 11
10		3/8" H.S. BOLTS	0	2 1/2	B1 5
2		3/8" H.S. BOLTS	0	2 1/2	B1 6
2	x2bg	105 x 1/2	1	0 1/2	
2	x2bh	107 x 1/2	1	0 1/2	

**SHOP NOTE**  
 HOLES: 15/16" # (UN)  
 BOLTS: AS NOTED  
 PAINT: SEE DWG. N1  
 FOR GENERAL SHOP NOTES, SEE DWG. N1.  
 FOR WEB CAMBER DIAGRAM, SEE DWG. W1.

FED. ROAD DIV. NO.		STATE	FED. AID PROJ. NO.
1		ME.	I-16-395-8(82)176

BILL OF MATERIAL					
NO.	MARK	DESCRIPTION	LENGTH	REMARKS	ITEM
ONE	G7L	GIRDER			75965
1	a	16 x 1"	24	10 1/16	
1	b	28 x 1 1/2	35	0	
2	c	28 x 2 1/4	25	0	
1	d	28 x 1 1/2	35	2	
1	f	28 x 1 1/2	60	0 1/16	
1	g	28 x 1 1/2	35	0 1/16	
1	h	111 x 3/4	50	0 1/16	
1	k	111 x 3/4	70	0 1/16	
1	x2a	16 x 1/2	2	6 1/2	
2	x2b	BAR 6 x 3/4	2	6 1/2	
1	x2c	19 x 1 1/4	2	6 1/2	
2	x2d	BAR 8 x 7/8	2	6 1/2	
1	x2m	11 x 1/2	2	0 1/2	
2	x2n	BAR 4 x 3/4	2	0 1/2	
1	x2t	28 x 7/8	3	0 1/2	
2	x2w	12 x 1"	3	0 1/2	
1	x1a	BAR 6 x 9/16	9	3	
1	x1b	BAR 6 x 9/16			
1	x1c	BAR 6 x 9/16			
1	x1d	BAR 5 x 1/2			
1	x1f	BAR 5 x 1/2			
1	x1y	BAR 7 x 9/16			
2	x1ac	12 x 1 1/4			
2	x1ad	12 x 1 1/4			
1	x3y	BAR 7 x 9/16			
1	x3aa	BAR 7 x 9/16			
1	x3af	BAR 7 x 1/2			
1	x3ag	BAR 7 x 1/2			
2	x3aa	BAR 7 x 1/2			
2	x3at	BAR 7 x 1/2	9	3	
1	x4m	PC. MC18x45.8	0	11 1/2	
1	x4n				
1	x4p				
1	x4s				
1	x4ak				
1	x4ag				
1	x4ah				
1	x4aw				
1	x4am		0	11 1/2	
1	x4ct		0	10	
1	x4cw		0	10	
2	x4bd	PC. MC18x45.8	0	10	
2	xb	1" ROD	49	4	5 9
2	xc	1" ROD	45	4 1/4	5 4
2	xd	1" ROD	40	4	5 2

NO.	REVISION	Revised span length	DATE 1-12-85
1		Control #16	

**HIGH STEEL STRUCTURES, INC.**  
 1805 Old Philadelphia Pike  
 Lancaster, Pennsylvania 17603  
 Phone 717/299-9221  
 A Subsidiary of High Industries, Inc.

GIRDER		G7L
I-395 BRIDGE OVER PENOBSCOT RIVER		
I-395 BRIDGE STA. 16+60.00		
PENOBSCOT COUNTY		
STATE OF MAINE		
DEPARTMENT OF TRANSPORTATION		
STATE CONTRACT OR REF. NO.	6	CONTRACTOR CIANBRO CORP.
IN CHARGE HINKLE	MADE BY S.J.A.	CHK'D BY J.L.C. DATE 1-28-84
CONTRACT NUMBER ME-84088-3	DRAWING NUMBER 14 OF 47	

**R95-191**










AP 22683A

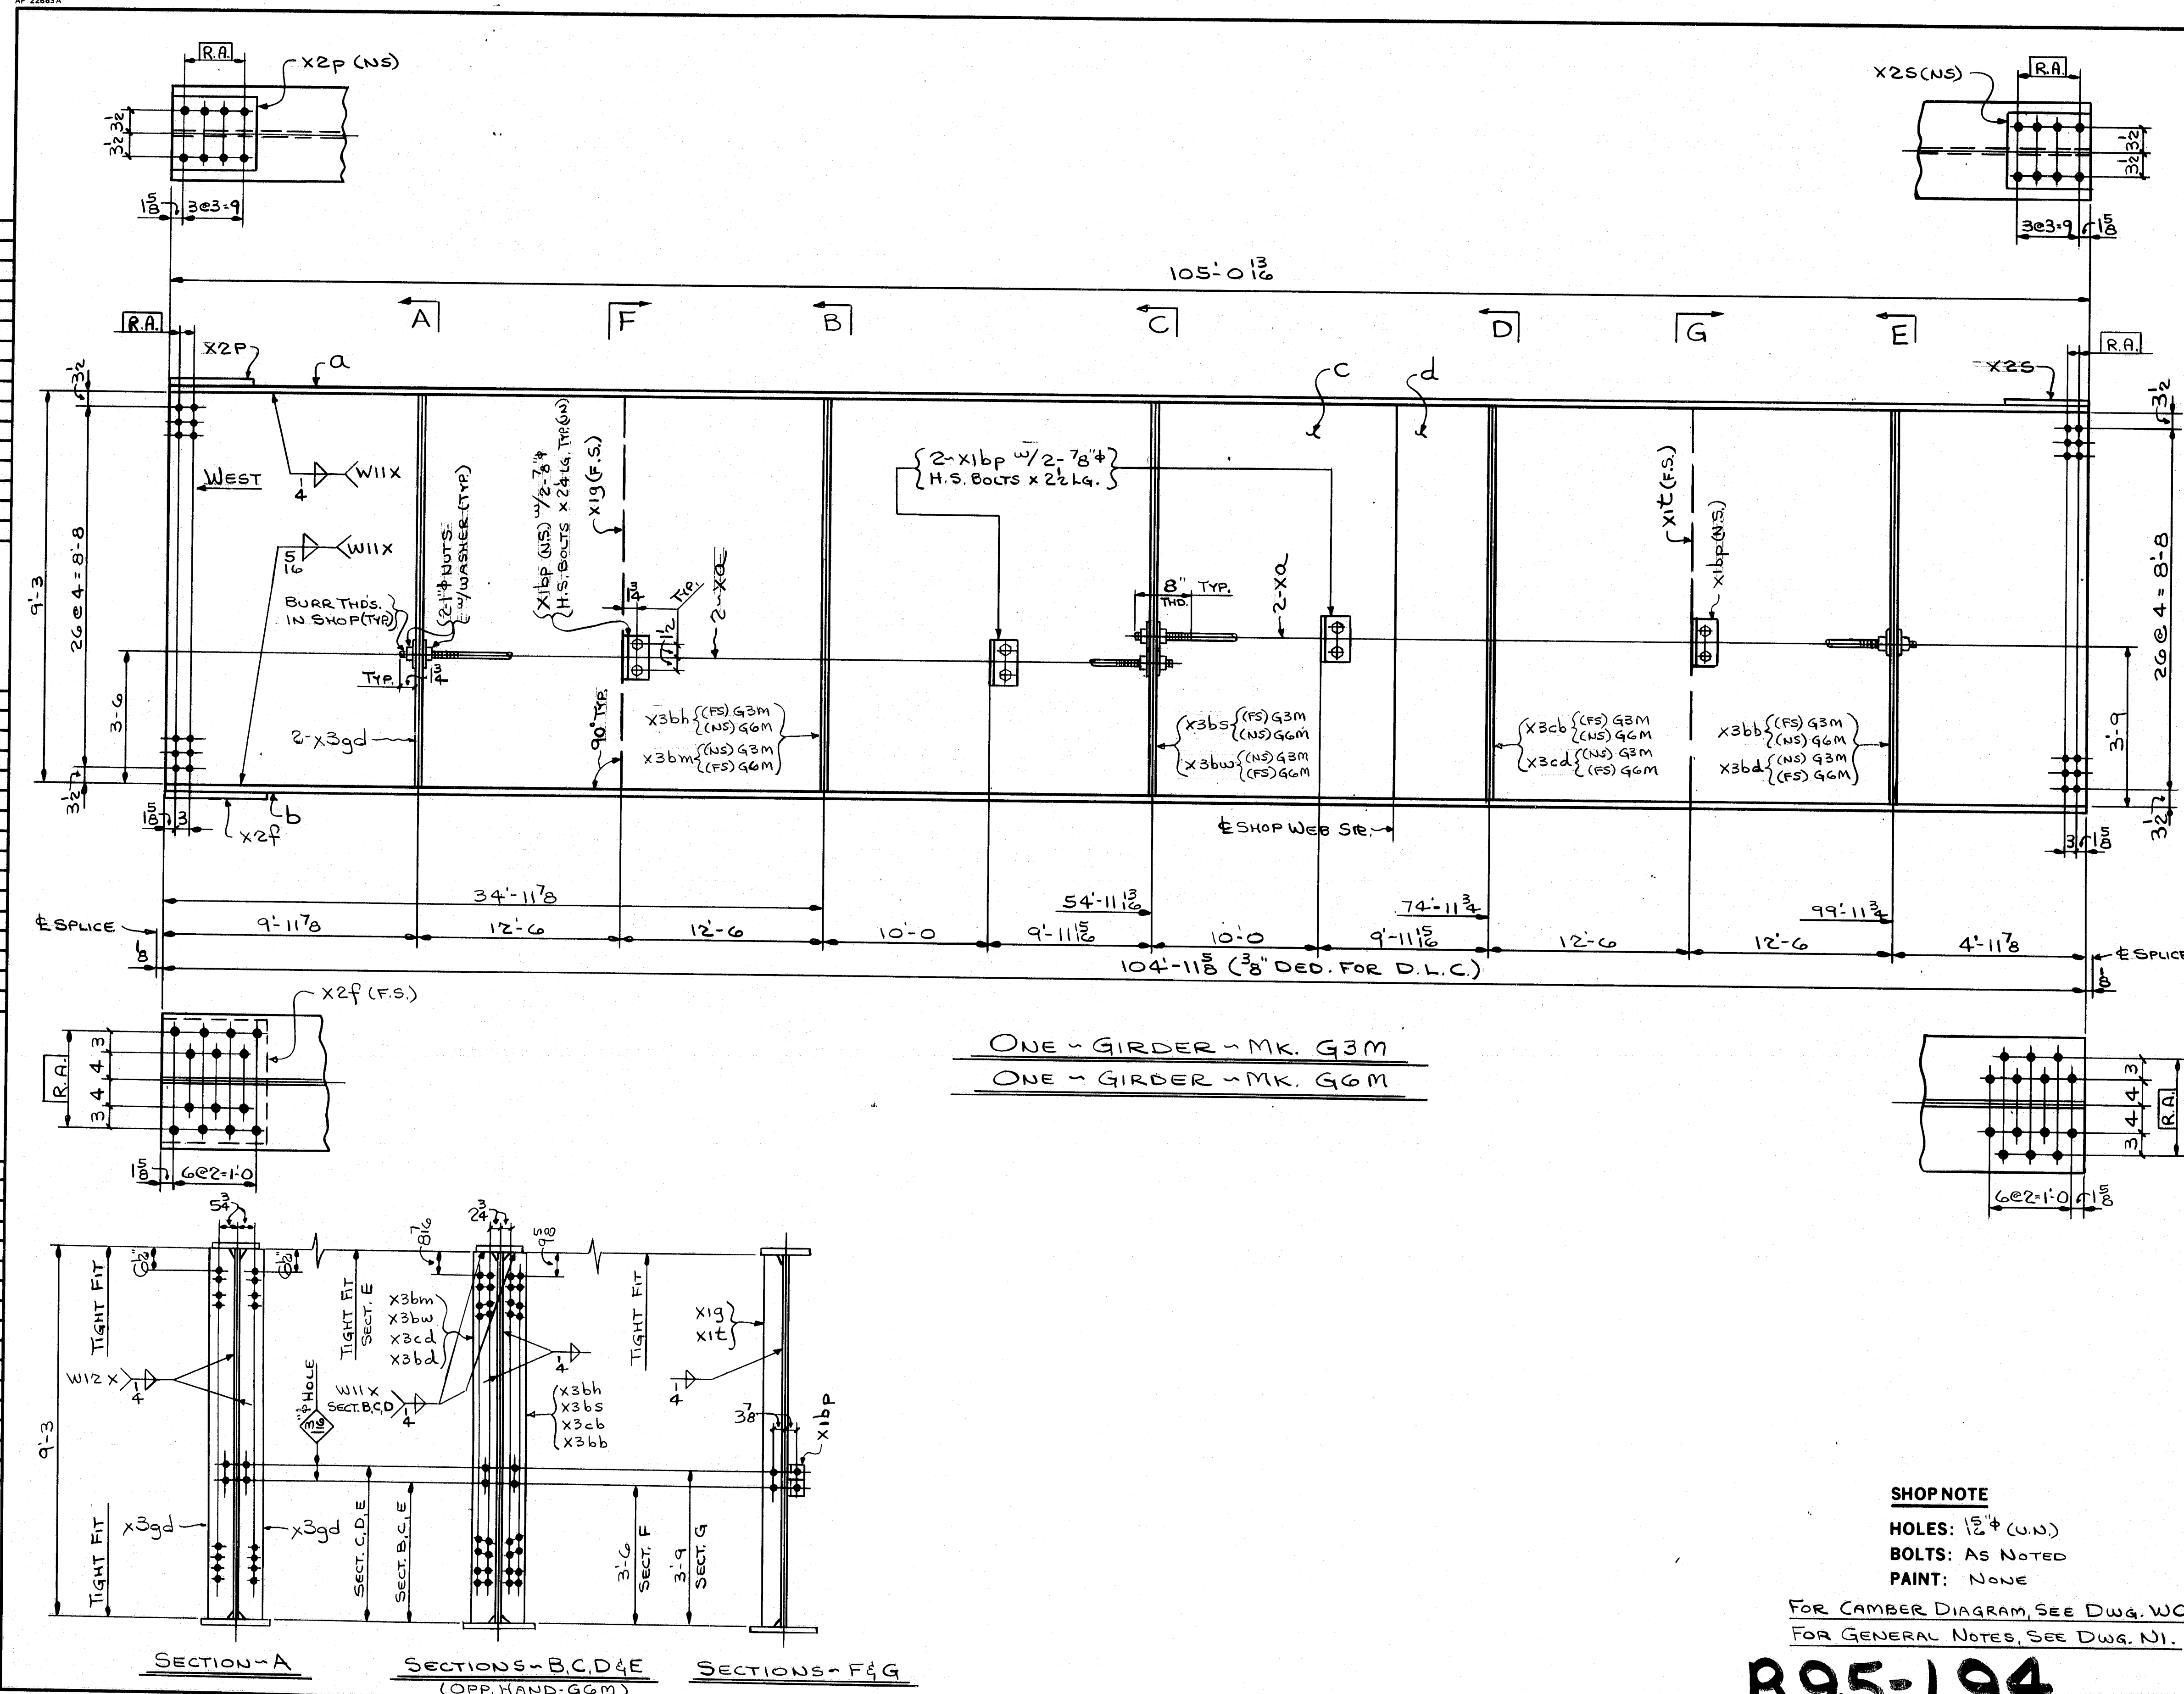

**SHOP NOTE**  
 HOLES: 1/2" (U.N.)  
 BOLTS: AS NOTED  
 PAINT: NONE  
 FOR CAMBER DIAGRAM, SEE DWG. WC1.  
 FOR GENERAL NOTES, SEE DWG. N1.

**R95-194**


FED. ROAD DIV. NO.		STATE	FED. AID PROJ. NO.
1		ME	194-395-8(82)176

BILL OF MATERIAL						
NO.	MARK	DESCRIPTION	LENGTH	REMARKS	ITEM	TOTAL WEIGHT
ONE	G3M	GIRDER				42240
ONE	G6M	GIRDER				42240
2	a	R. 14 x 3/4	105 0 1/2			10,000
2	b	R. 20 x 1 1/2	104 11 3/8			28,721
2	c	R. 111 x 1 1/2	70 0 1/2			18,727
2	d	R. 111 x 1 1/2	35 0 1/4			9,000
2	X2f	R. 19 x 3/8	1 3/8	FILL		12,250
2	X2P	R. 11 x 3/4	1 0 8	FILL		28,21
2	X2S	R. 11 x 1/2	1 0 8	FILL		15,81
8	Xa	1" ROD	45 4	THD. BOTH ENDS	5 3/4	4,876
32		1" STD. HEX NUTS			8 1/4	8,72
32		WASH. FOR 1" NUTS			8 1/4	8,72
2	X3cd	BAR 7 X 1/2	9 3			10,000
8		3" H.S. BOLTS	0 24		81 5	
8		3" H.S. BOLTS	0 24		81 6	16,52
16		WASH. FOR 3" H.S. BOLTS			81 11	

NO.	REVISION	DATE
<p><b>HIGH STEEL STRUCTURES, INC.</b></p> <p>1905 Old Philadelphia Pike Lancaster, Pennsylvania 17603 Phone 717/299-5211</p> <p>A Subsidiary of High Industries, Inc.</p>		
<p><b>GIRDERS G3M &amp; G6M</b></p> <p><b>I-395 BRIDGE OVER PENOBSCOT RIVER</b></p> <p><b>I-395 BRIDGE STA. 164+60.00</b></p> <p><b>PENOBSCOT COUNTY</b></p> <p><b>STATE OF MAINE</b></p> <p><b>DEPARTMENT OF TRANSPORTATION</b></p>		
STATE CONTRACT OR REF. NO.	CONTRACTOR	
6	CIANBRO CORP.	
IN CHARGE	MADE BY	CHKD. BY
HINKLE	G.F.Z.	JLC
CONTRACT NUMBER	DRAWING NUMBER	DATE
ME-84088-3	17 OF 47	9-28-84




AP 22683A

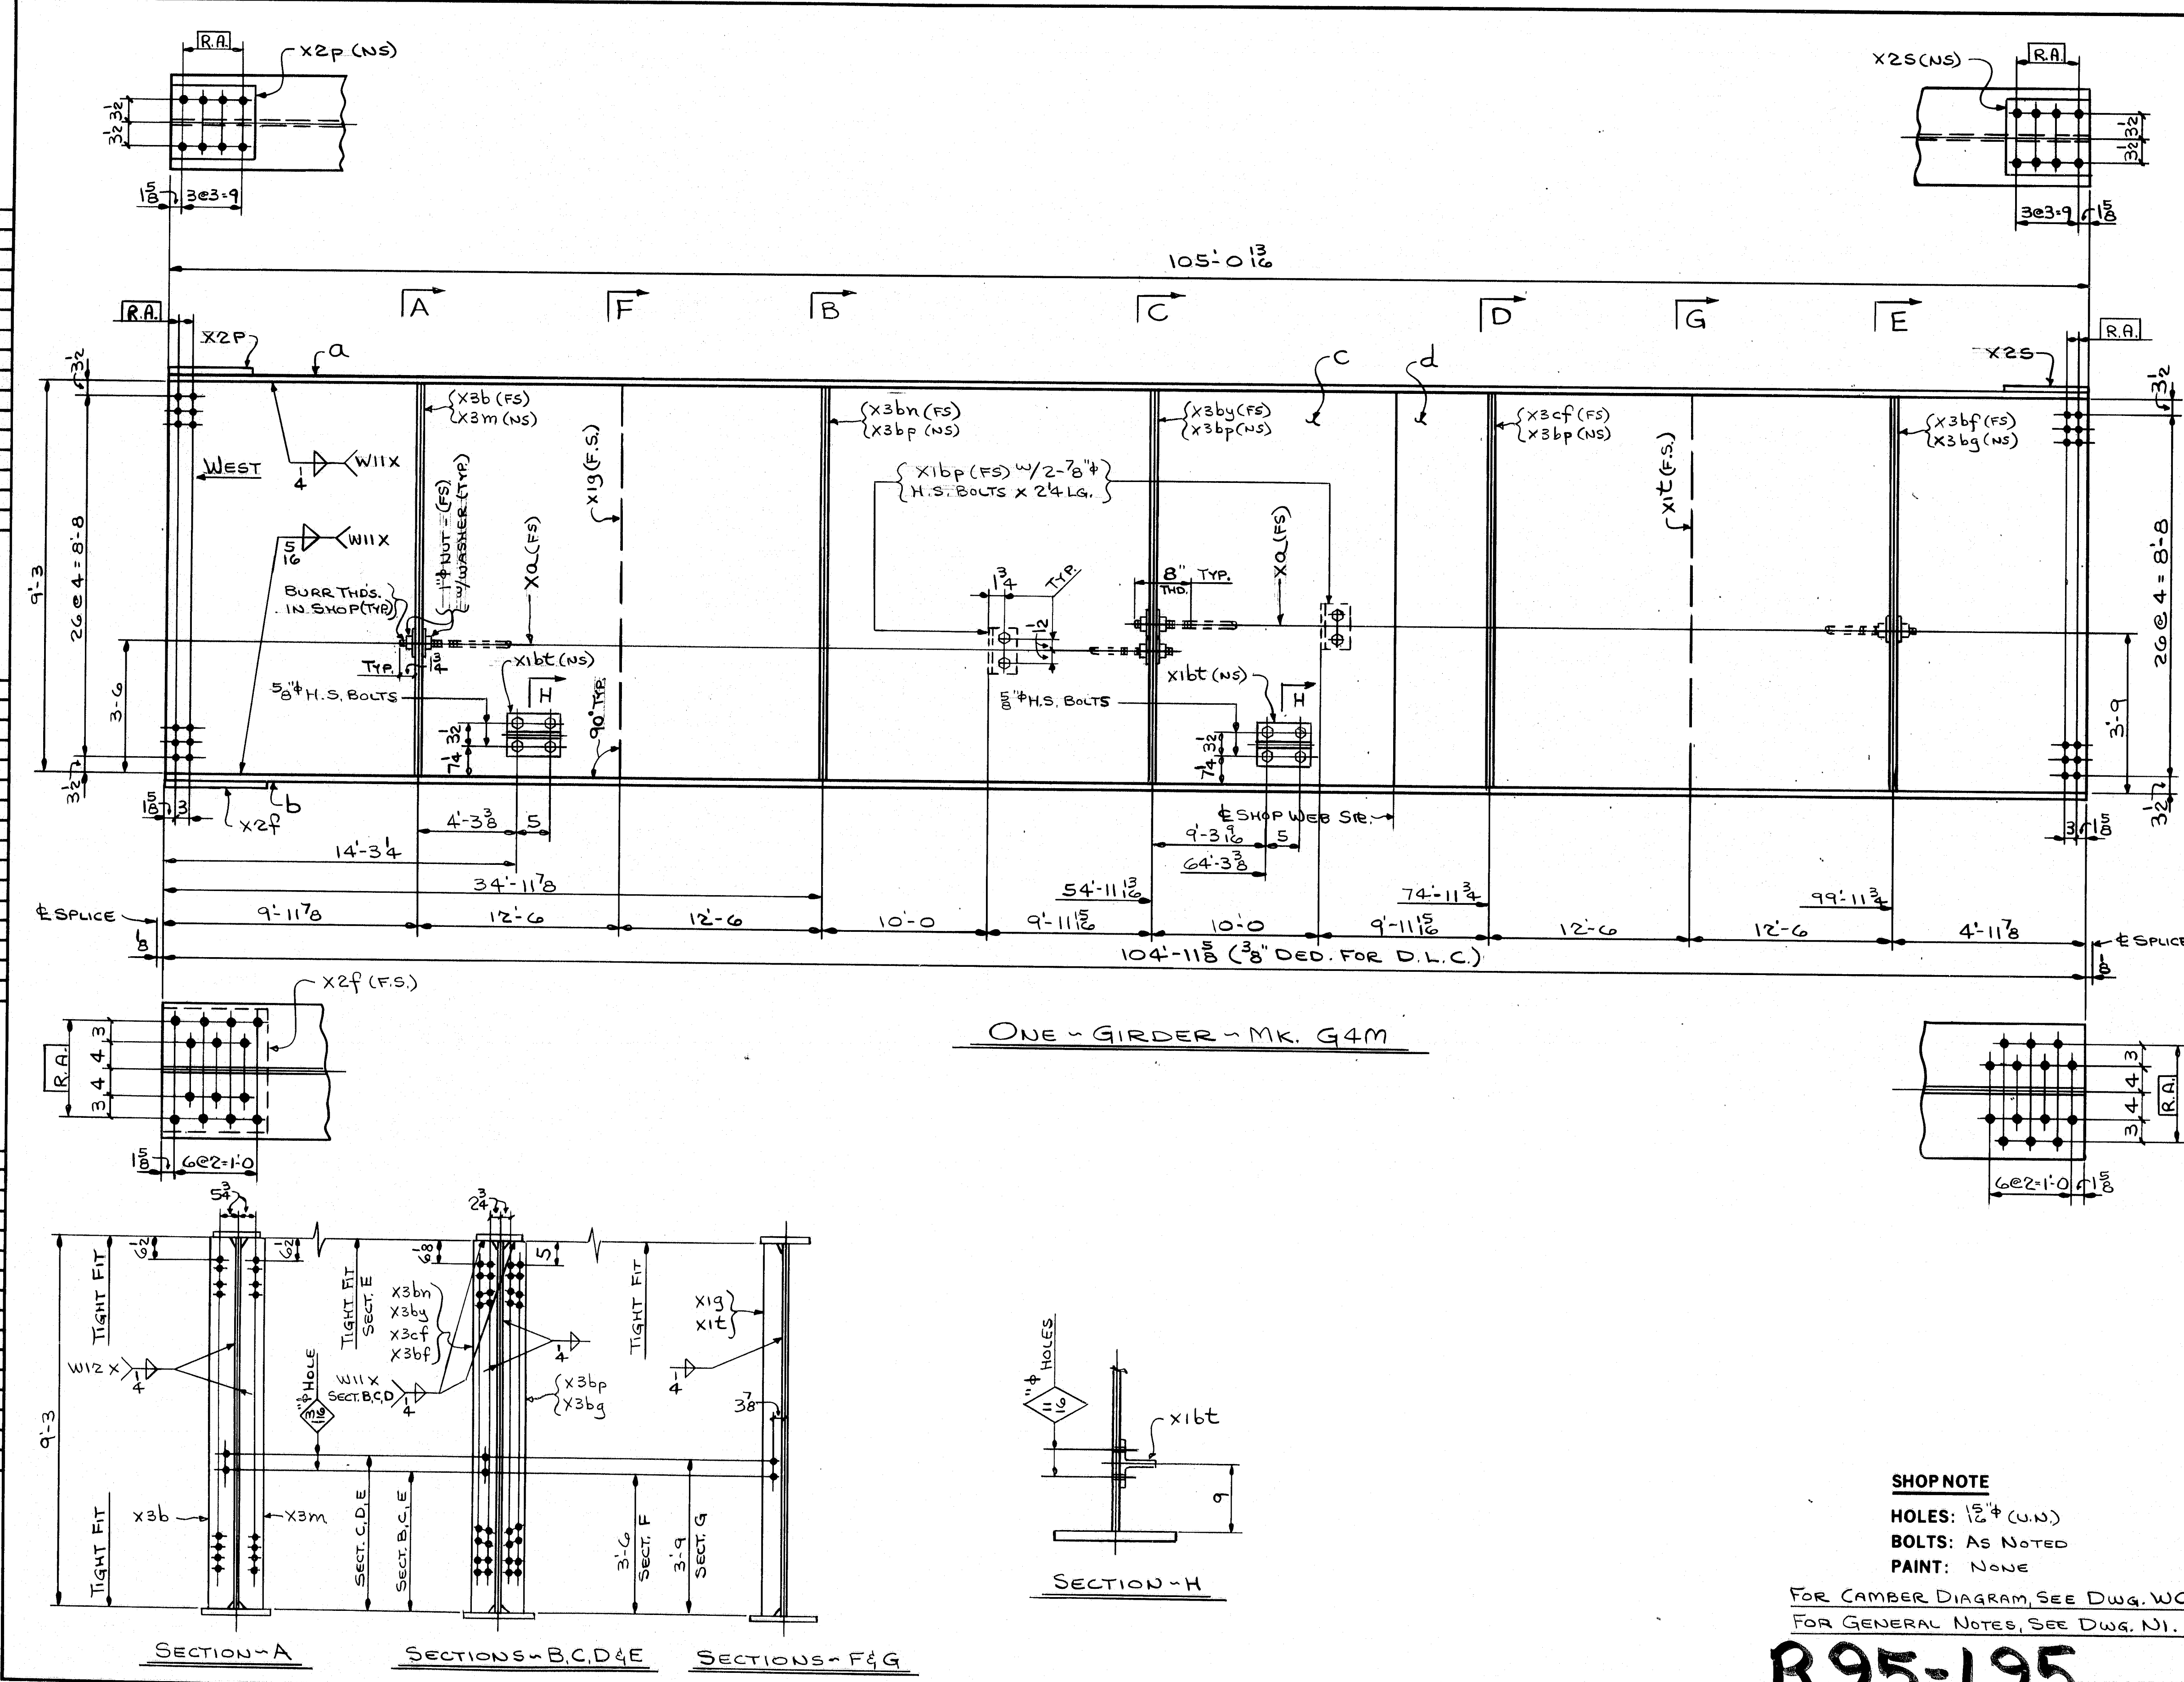

ONE GIRDER - MK. G4M

SECTION-A      SECTIONS-B,C,D,E      SECTIONS-F&G

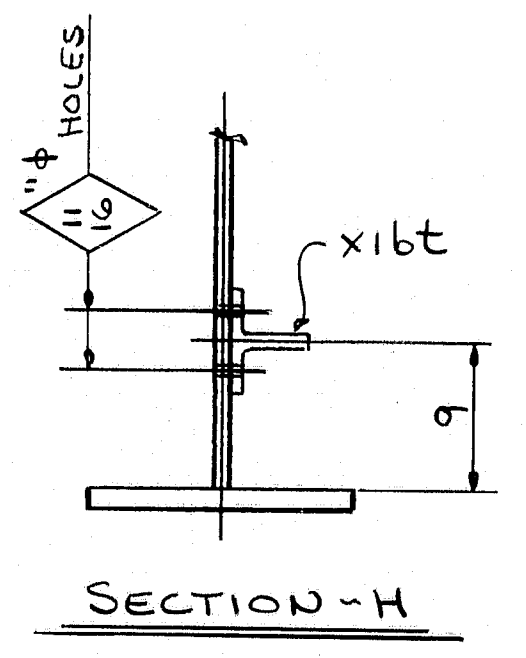

SHOP NOTE  
HOLES: 1/2" (U.N.)  
BOLTS: AS NOTED  
PAINT: NONE

FOR CAMBER DIAGRAM, SEE DWG. WCI.  
FOR GENERAL NOTES, SEE DWG. NI.

R95-195

FED. ROAD DIV. NO.	STATE	FED. AID PROJ. NO.
1	ME	11G395-8(82)176

BILL OF MATERIAL					
NO.	MARK	DESCRIPTION	LENGTH	REMARKS	TOTAL WEIGHT

NO.	REVISION	DATE

HIGH STEEL STRUCTURES, INC.

1005 Old Philadelphia Pike  
Lancaster, Pennsylvania 17603  
Phone 717/299-5211

A Subsidiary of High Industries, Inc.

GIRDER G4M

I-395 BRIDGE OVER PENOBSCOT RIVER

I-395 BRIDGE STA. 164+60.00

PENOBSCOT COUNTY

STATE OF MAINE

DEPARTMENT OF TRANSPORTATION

STATE CONTRACT OR REF. NO. 6 CONTRACTOR CIAMBRO CORP.

IN CHARGE: HINKLE MADE BY: G.F.Z. CHK'D BY: J.L.C. DATE: 9-28-84

CONTRACT NUMBER: ME-84088-3 DRAWING NUMBER: 18 OF 47






AP 22683A




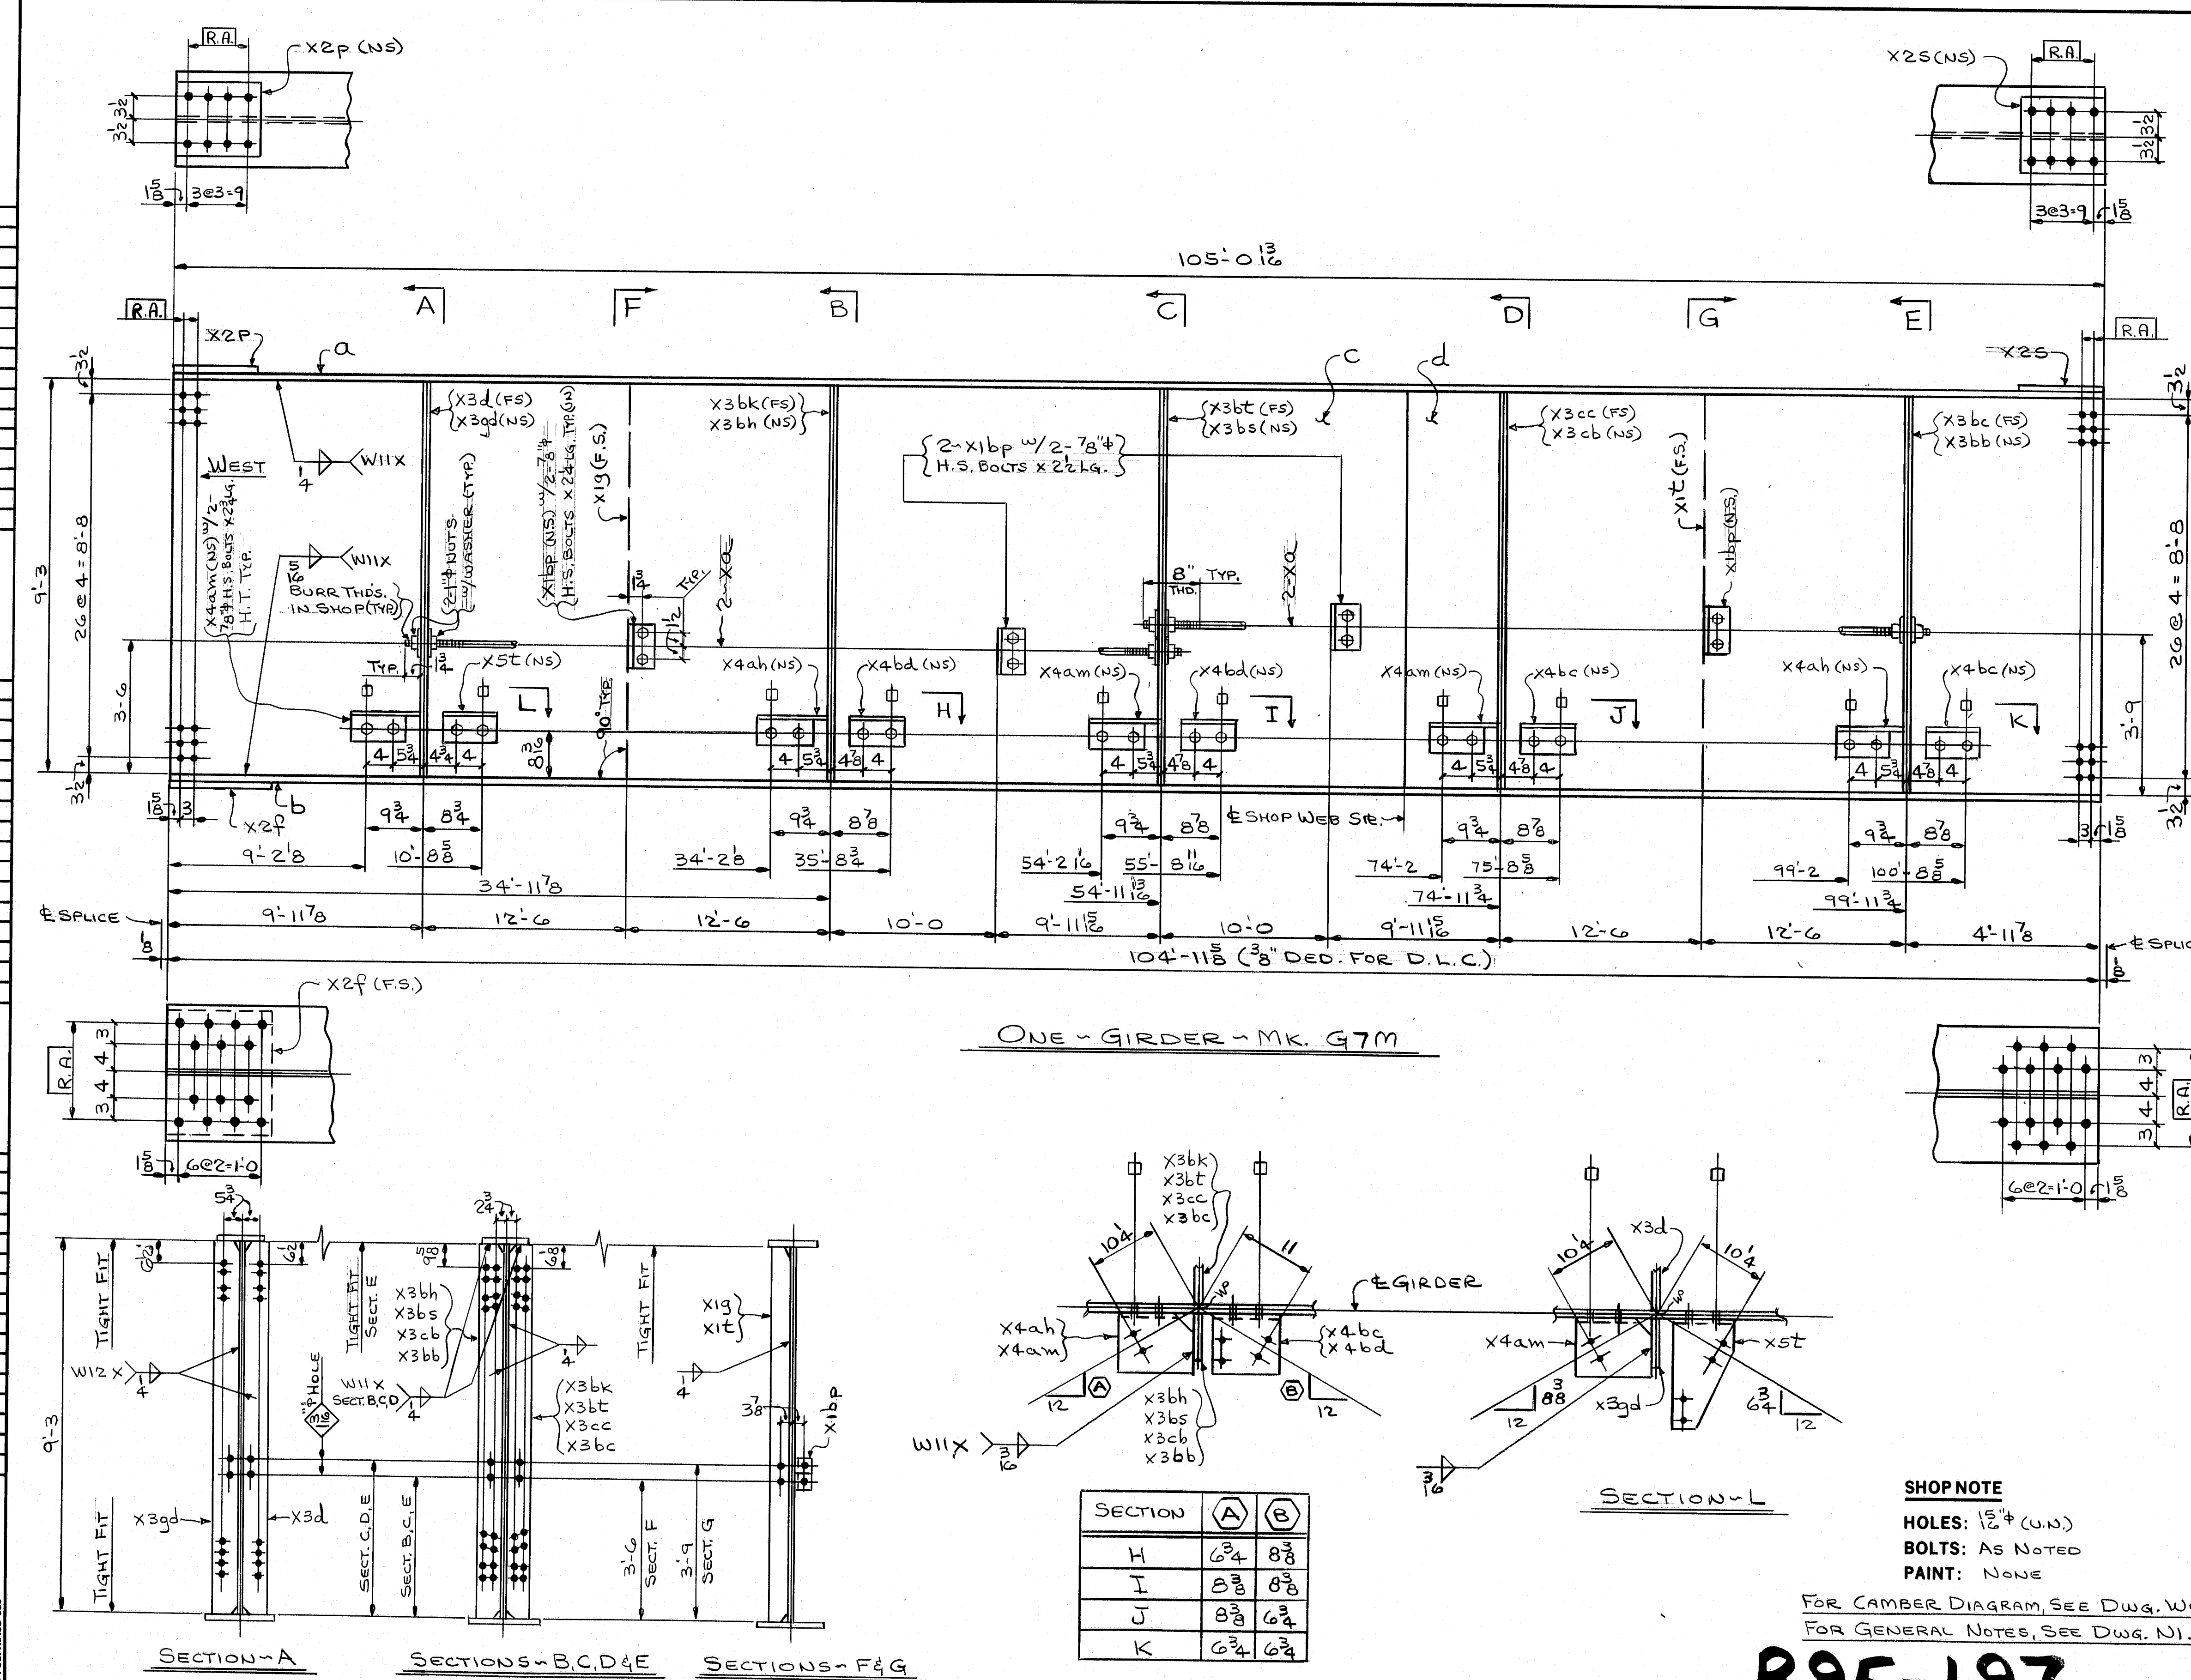

FED. ROAD DIST. NO.	STATE	FED. AID PROJ. NO.
1	ME	114395-8(82)176

BILL OF MATERIAL					
NO.	MARK	DESCRIPTION	LENGTH	REMARKS	TOTAL WEIGHT
ONE	G7M	GIRDER			47660
ONE	a	PL 14 x 3/4	105 0 1/2		
ONE	b	PL 20 x 1 1/2	104 11 3/8		
ONE	c	PL 111 x 1 1/2	70 0 1/2		
ONE	d	PL 111 x 1 1/2	35 0 1/4		
ONE	x2f	PL 19 x 3/8	1 3/8	FILL	
ONE	x2p	PL 11 x 3/4	1 0 8	FILL	
ONE	x2s	PL 11 x 1/2	1 0 8	FILL	
4	x2a	1" STD. HEX NUTS	45 4	THD. BOTH ENDS	5 3
16		1" STD. HEX NUTS			81 14
16		WASH. FOR 1" NUTS			81 12
6	x1bp	LS 3 x 3/4	0 6		
ONE	x1g	BAR 5 x 1/2	9 3		
	x1t	BAR 5 x 1/2			
	x3gd	BAR 7 x 1/2			
	x3d				
	x3bb				
	x3bc				
	x3bh				
	x3bk				
	x3bs				
	x3bt				
	x3cb				
ONE	x3cc	BAR 7 x 1/2	9 3		81 5
4		7/8" H.S. BOLTS	0 24		81 6
4		7/8" H.S. BOLTS	0 22		81 11
28		WASH. FOR 7/8" H.S. BOLTS			81 11
20		7/8" H.S. BOLTS	0 24		81 7
2	x4ah	PL MC18 x 45.8	0 11 1/2		
3	x4am		0 11 1/2		
2	x4bc		0 10		
2	x4bd	PL MC18 x 45.8	0 10		
ONE	x5t	PL MC18 x 45.8	0 8 3/4		

NO.	REVISION	DATE
HIGH STEEL STRUCTURES, INC.		
1905 Old Philadelphia Pike Lancaster, Pennsylvania 17603 Phone 717/299-5211		
A Subsidiary of High Industries, Inc.		
GIRDER G7M		
I-395 BRIDGE OVER PENOBSCOT RIVER		
I-395 BRIDGE STA. 164+60.00		
PENOBSCOT COUNTY		
STATE OF MAINE		
DEPARTMENT OF TRANSPORTATION		
STATE CONTRACT OR REF. NO.	CONTRACTOR	DATE
6	CLAUDE GRP.	9-28-84
IN CHARGE: HINKLE	MADE BY: G.F.F.	CHK'D BY: JLC
CONTRACT NUMBER: ME-84088-3	DRAWING NUMBER: 20 OF 47	

R95-197

CODE: 4000






AF 2285A




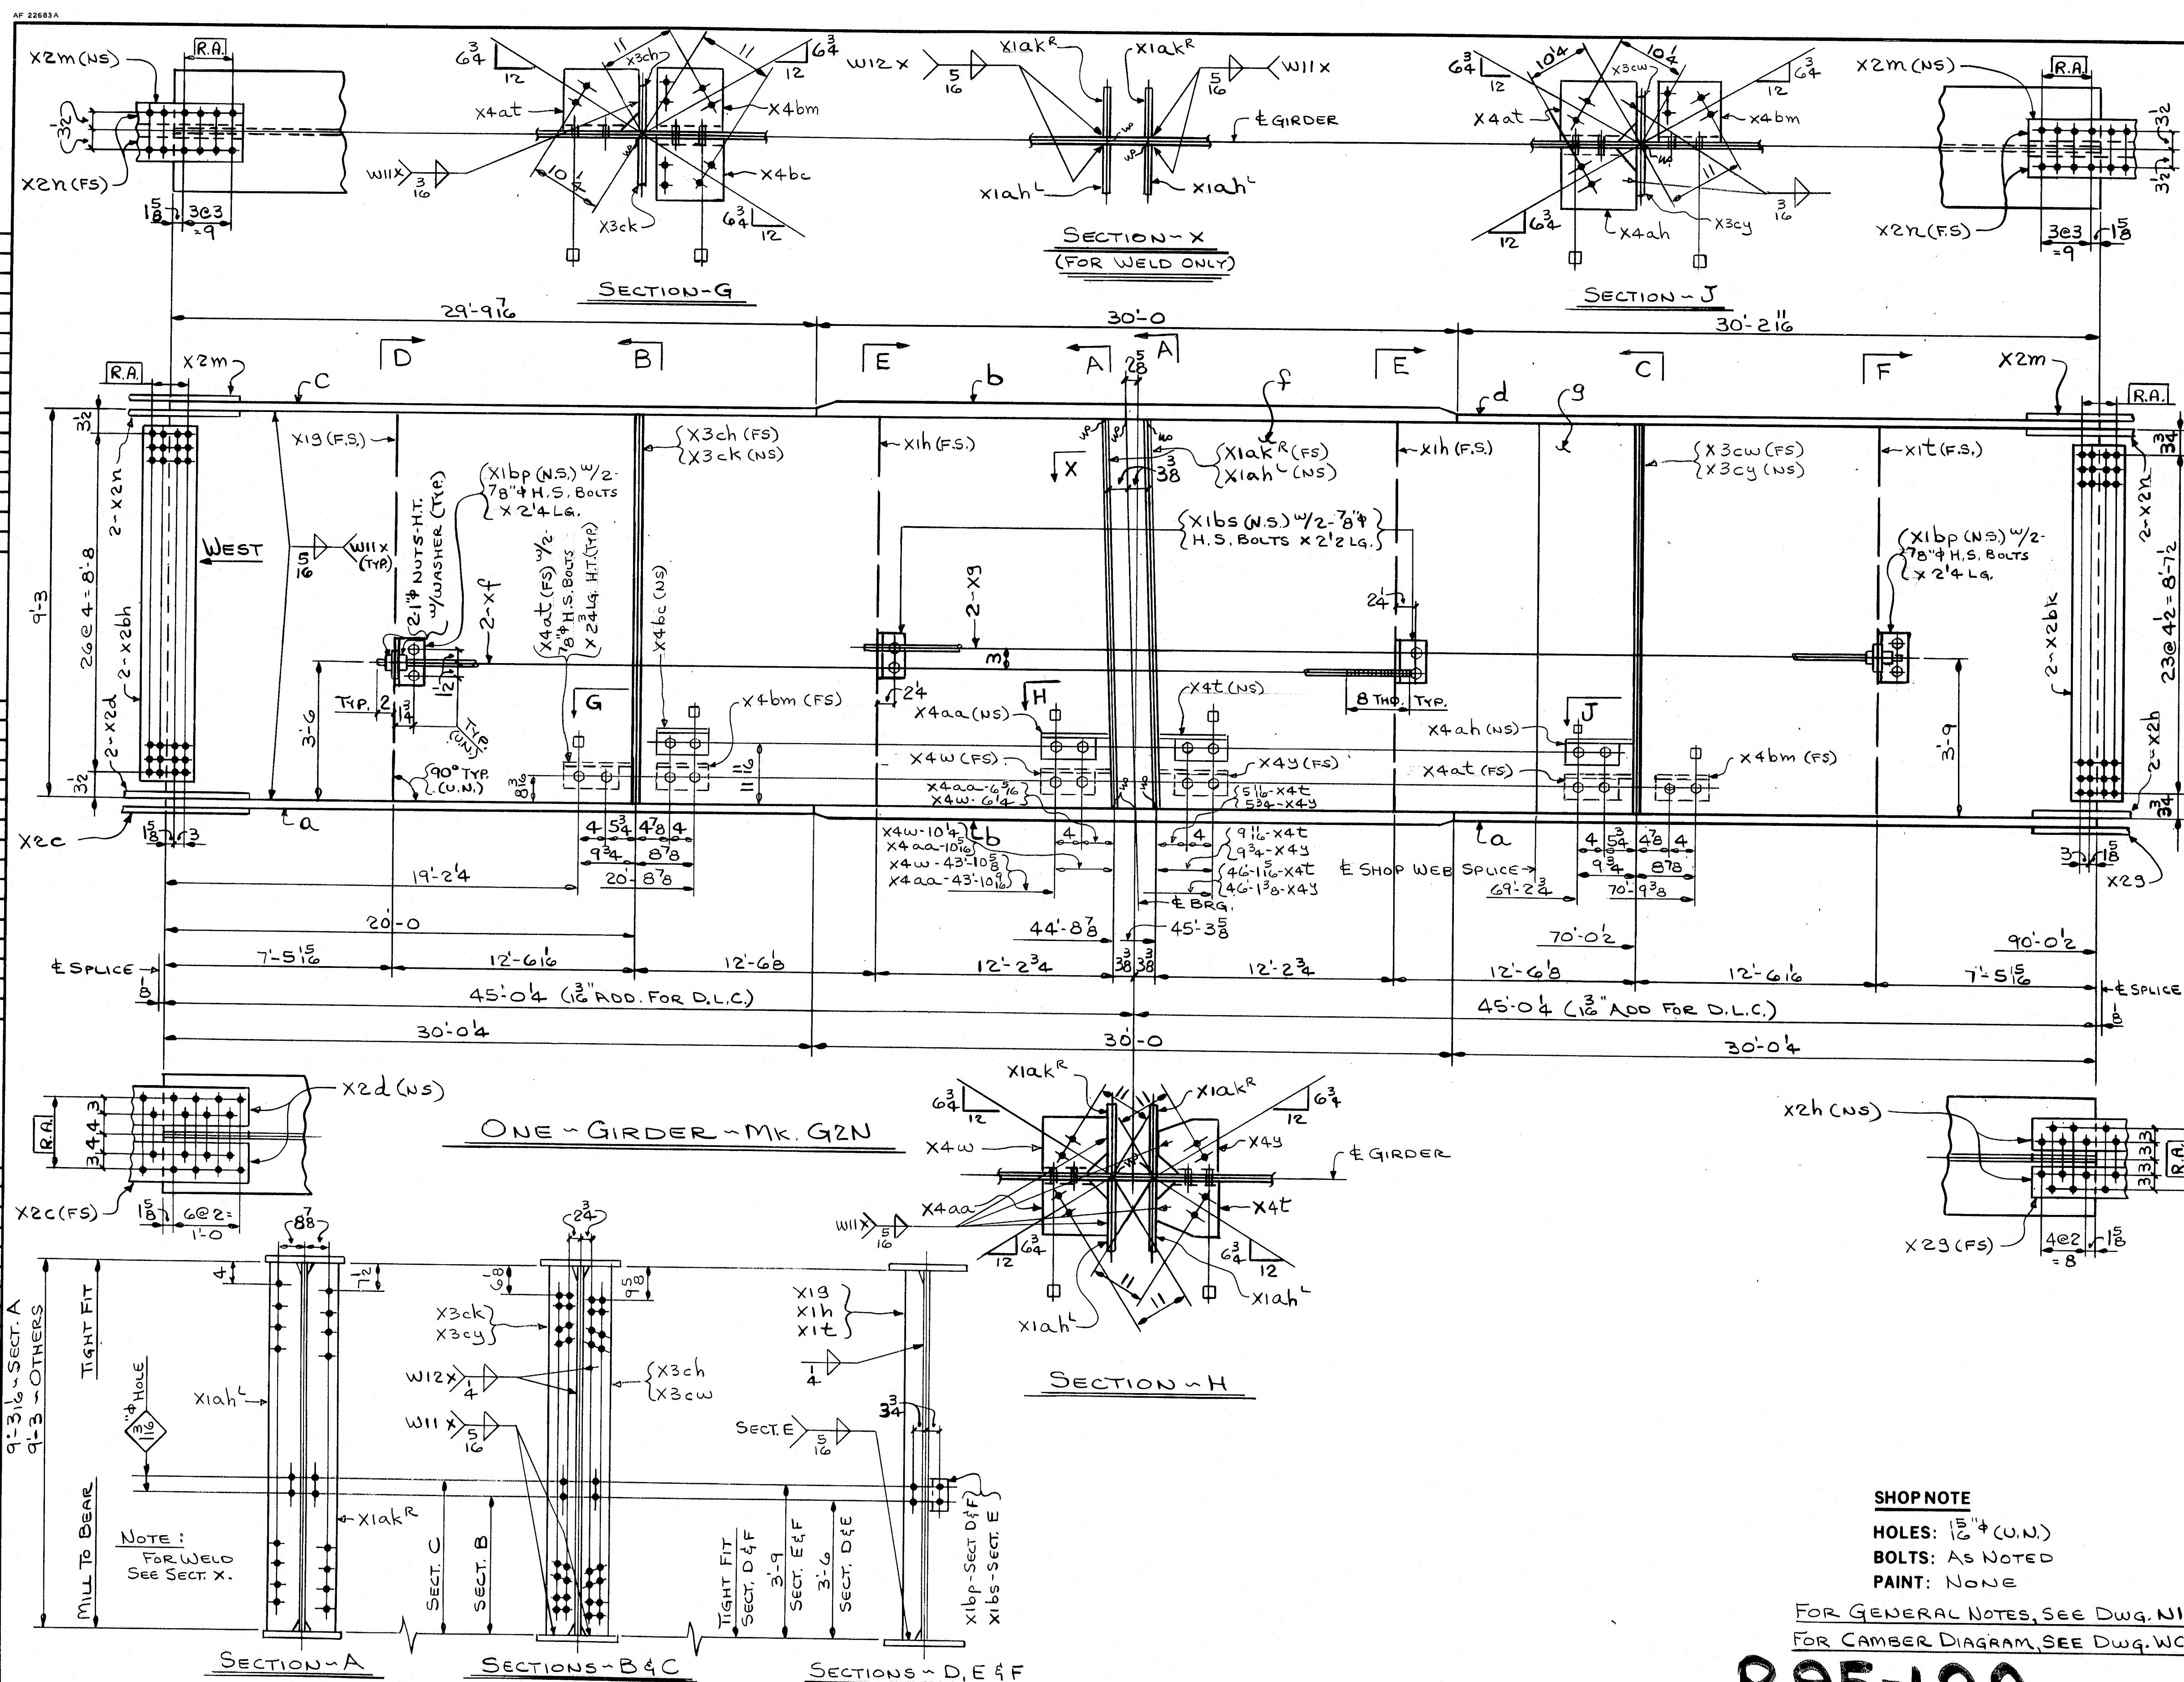

FED. ROAD DIV. NO.		STATE		FED. AID PROJ. NO.	
1		ME		EIG-395-8(82)174	

BILL OF MATERIAL					
NO.	MARK	DESCRIPTION	LENGTH	REMARKS	TOTAL WEIGHT
ONE	G2N	GIRDER			49,620
2	a	PL 24 x 1 1/4	30' 0 1/4"		
2	b	PL 24 x 2	30' 0"		
ONE	c	PL 24 x 1 1/4	29' 9 1/2"		
1	d	PL 24 x 1 1/4	30' 2 1/2"		
1	f	PL 111 x 1 1/2	65' 0"		
ONE	g	PL 111 x 1 1/2	25' 0 1/2"		
2	xp	1" ROD	50' 0 1/2"	THD. BOTH ENDS	5' 10"
2	xg	1" ROD	50' 2 1/4"	THD. BOTH ENDS	5' 11"
2	xih	BAR 5 x 1/2	9' 3"		
ONE	xig	BAR 5 x 1/2	9' 3"		
ONE	xit	BAR 5 x 1/2	9' 3"		

NO.	REVISION	DATE
1		


HIGH STEEL STRUCTURES, INC.	
1905 Old Philadelphia Pike Lancaster, Pennsylvania 17603 Phone 717/299-5211	
A Subsidiary of High Industries, Inc.	

GIRDER		G2N	
I-395 BRIDGE OVER PENOBSCOT RIVER			
I-395 BRIDGE STA. 164 + 60.00			
PENOBSCOT COUNTY			
STATE OF MAINE			
DEPARTMENT OF TRANSPORTATION			
STATE CONTRACT OR REF. NO.	6	CONTRACTOR	CLANBRO CORP.
IN CHARGE:	HINKLE	MADE BY:	G.F.Z.
CONTRACT NUMBER:	ME-84088-3	CHK'D BY:	JLC
		DATE:	10-1-84
		DRAWING NUMBER:	22 OF 47

R95-199 Code: 4000

AP 22689A

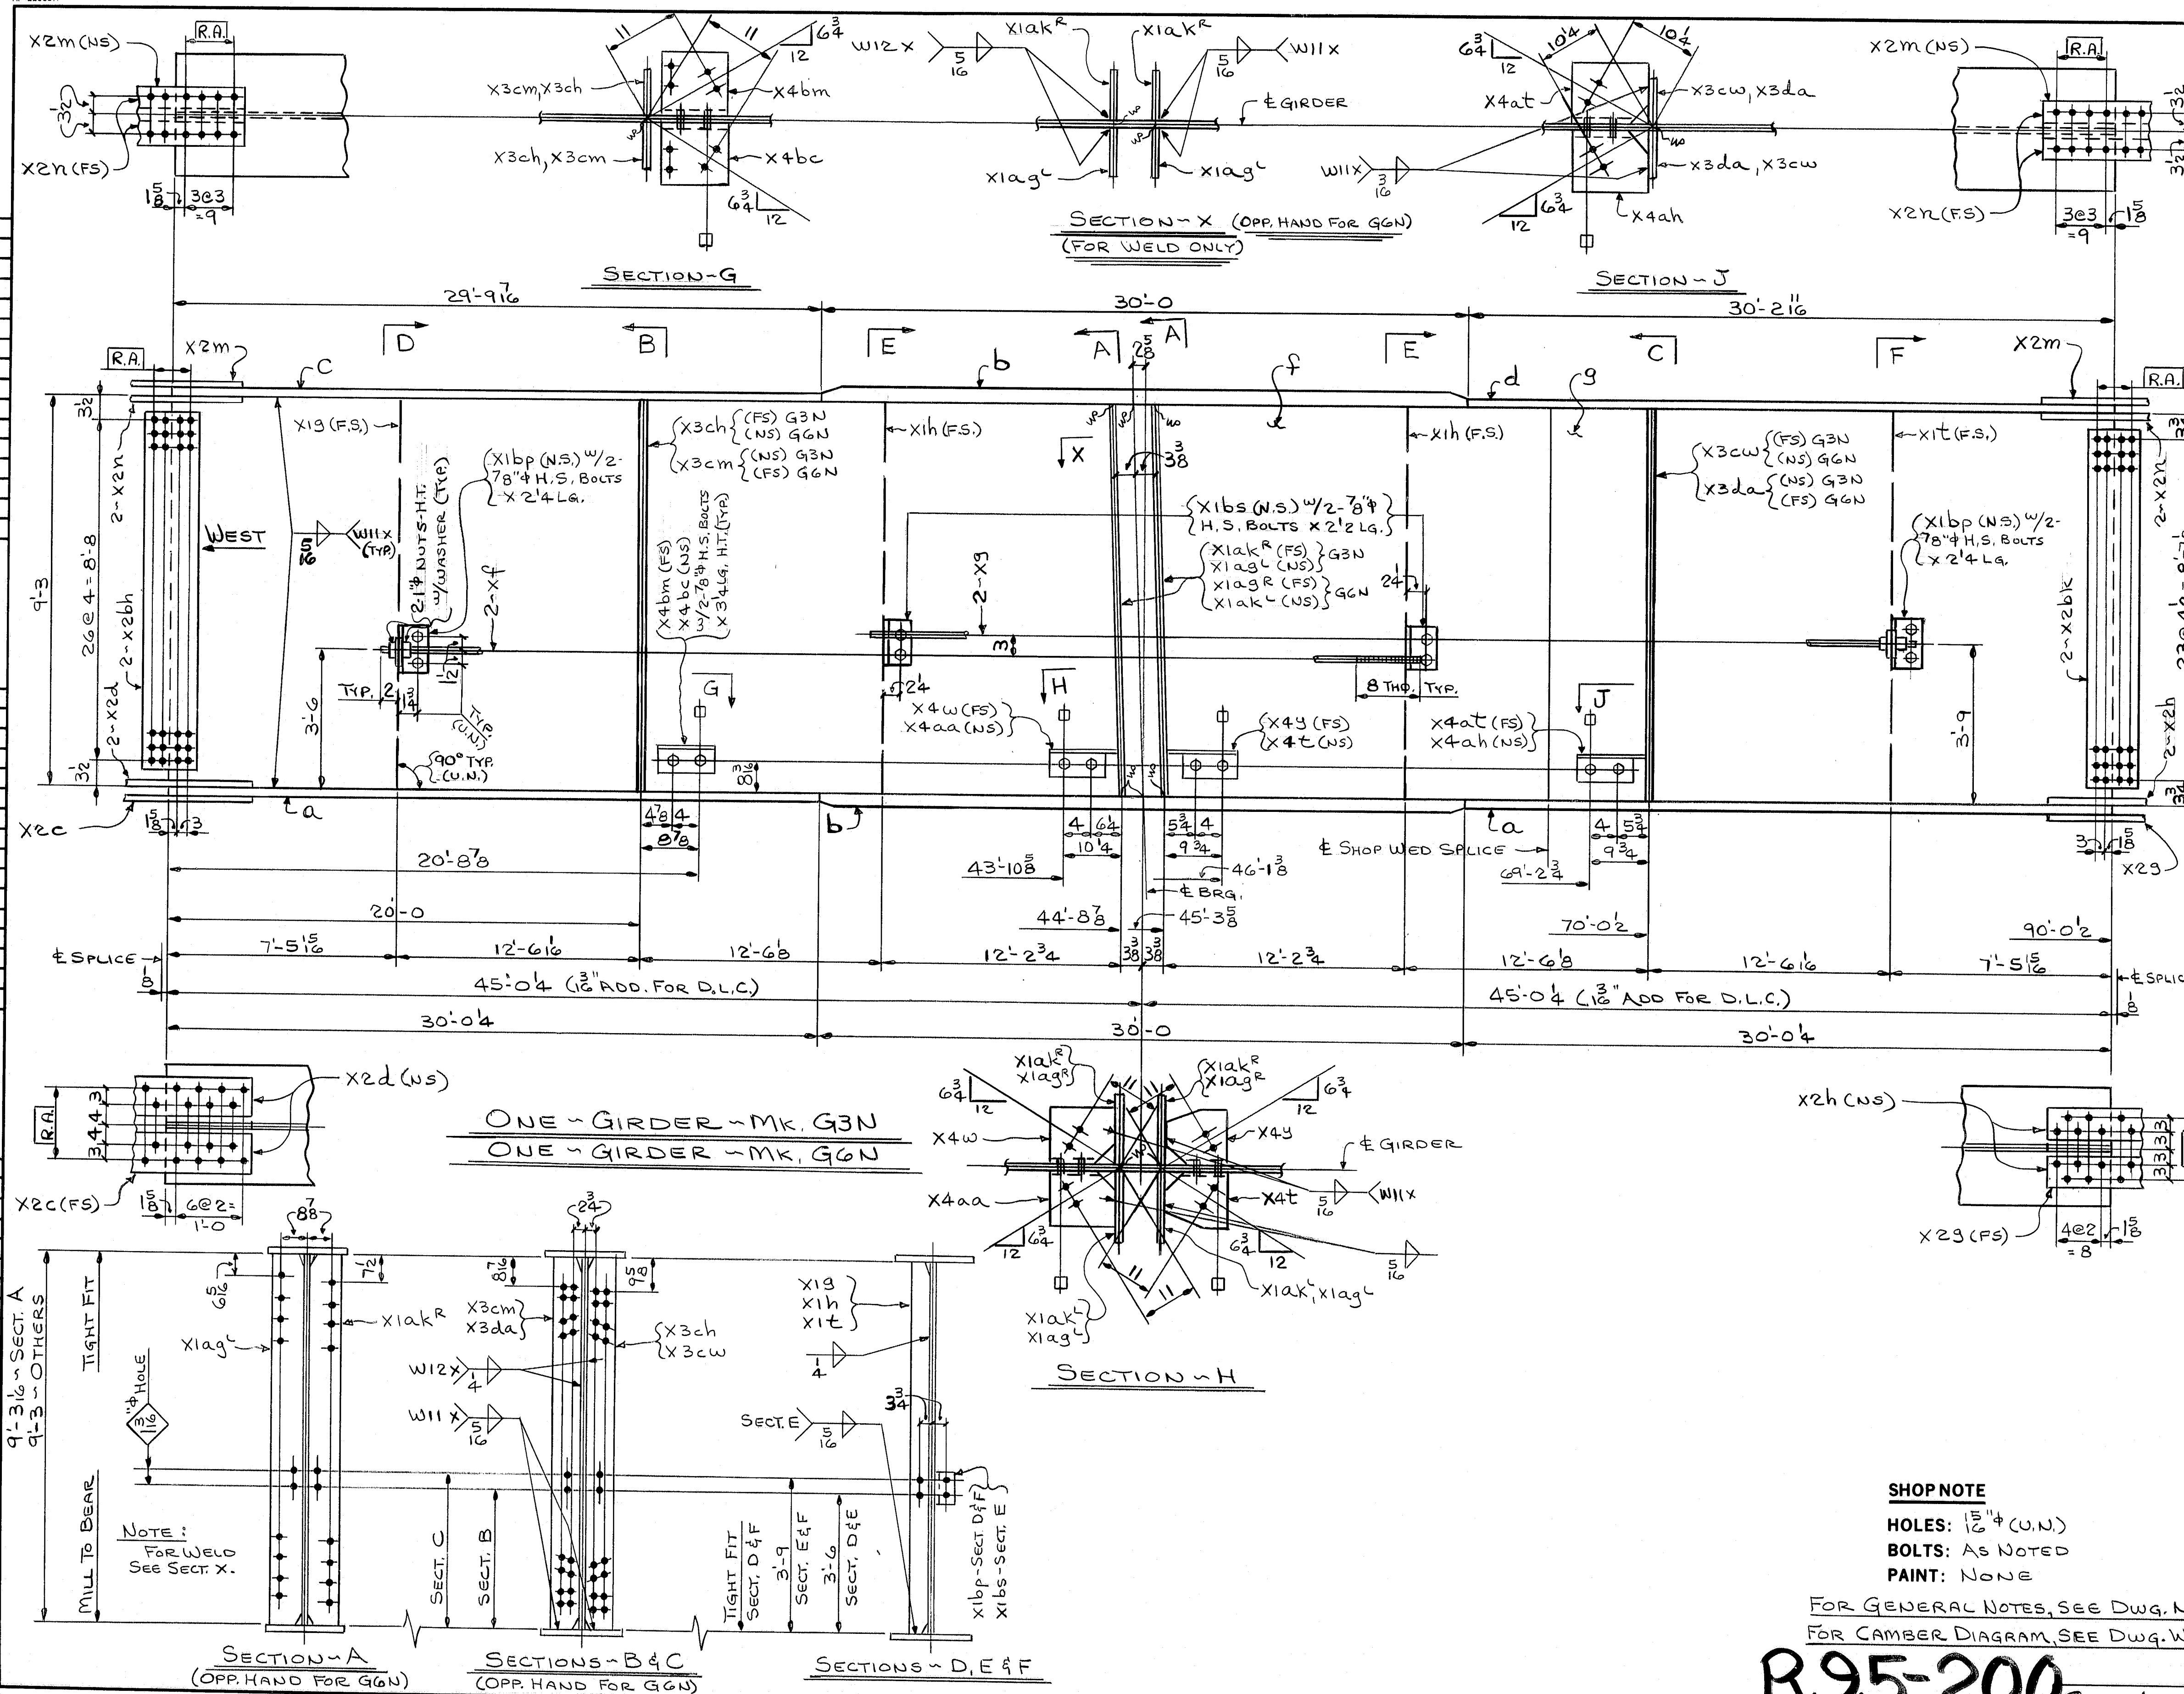

FED. ROAD DIV. NO.		STATE	FED. AID PROJ. NO.	
1		ME	11G-395-8(82)174	

BILL OF MATERIAL						
NO.	MARK	DESCRIPTION	LENGTH	REMARKS	ITEM	TOTAL WEIGHT
ONE	G3N	GIRDER				49,525
ONE	G6N	GIRDER				49,525
4	a	PL 24 x 1 1/4	30' 0 1/4			
4	b	PL 24 x 2	30' 0			
2	c	PL 24 x 1 1/4	29' 9 1/2			
2	d	PL 24 x 1 1/4	30' 2 1/2			
2	f	PL 111 x 1 1/2	65' 0			
2	g	PL 111 x 1 1/2	25' 0 1/2			
4	x f	1" ROD	50' 0 1/2	THD. BOTH ENDS	5' 10	
4	x g	1" ROD	50' 2 1/4	THD. BOTH ENDS	5' 11	
4	x1h	BAR 5 x 1/2	9' 3			
2	x1g	BAR 5 x 1/2	9' 3			
2	x1f	BAR 5 x 1/2	9' 3			
2	x2c	PL 19 x 1 1/2	2' 6 1/2			
4	x2d	BAR 8 x 7/8	2' 6 1/2			
2	x2g	PL 15 x 1 1/2	1' 10 1/2			
4	x2h	BAR 6 x 3/4	1' 10 1/2			
4	x2m	PL 11 x 1/2	2' 0 1/2			
8	x2n	BAR 4 x 3/4	2' 0 1/2			
4	x2bh	PL 107 x 1/2	1' 0 1/2			
4	x2bk	PL 106 1/2 x 1/2	1' 0 1/2			
16		1" STD. HEX. NUTS			B1 14	
16		WASH. FOR 1" RODS			B1 12	
32		WASH. FOR 7/8" H.S. BOLTS			B1 11	
8		7/8" H.S. BOLTS	0' 24		B1 5	
8		7/8" H.S. BOLTS	0' 22		B1 6	
16		7/8" H.S. BOLTS	0' 34		B1 8	
4	x1ag <sup>R</sup>	PL 10 x 1"	9' 3 1/2	x1ag <sup>R</sup> -G3N x1ag <sup>R</sup> -G6N		
4	x1ak <sup>R</sup>	PL 10 x 1"	9' 3 1/2	x1ak <sup>R</sup> -G3N x1ak <sup>R</sup> -G6N		
4	x1bs	5 x 3 1/2 x 1/2	0' 6			
4	x1bp	5 x 3 x 1/4	0' 6			
2	x3ch	BAR 7 x 1/2	9' 3			
↑	x3cm	↑	↑			
	x3cw	↑	↑			
	x3da	BAR 7 x 1/2	9' 3			
	x4t	PL MC18 x 45.8	0' 11 1/2			
	x4w	↑	0' 11 1/2			
	x4y		0' 11 1/2			
	x4aa		0' 11 1/2			
	x4ah		0' 11 1/2			
	x4at		0' 11 1/2			
↓	x4bc	↓	0' 10			
2	x4bm	PL MC18 x 45.8	0' 10			

SHOP NOTE

HOLES: 1 1/2" (U.N.)  
BOLTS: AS NOTED  
PAINT: NONE


FOR GENERAL NOTES, SEE DWG. N1.  
FOR CAMBER DIAGRAM, SEE DWG. W1.

R95-200 Code: 4000

NO.	REVISION	DATE
<p><b>HIGH STEEL STRUCTURES, INC.</b></p> <p>1905 Old Philadelphia Pike Lancaster, Pennsylvania 17603 Phone 717/299-5211</p> <p>A Subsidiary of High Industries, Inc.</p>		
<p><b>GIRDERS G3N &amp; G6N</b></p> <p><b>I-395 BRIDGE OVER PENOBSCOT RIVER</b></p> <p><b>I-395 BRIDGE STA. 164 + 60.00</b></p> <p><b>PENOBSCOT COUNTY</b></p> <p><b>STATE OF MAINE</b></p> <p><b>DEPARTMENT OF TRANSPORTATION</b></p>		
<p>STATE CONTRACT OR REF. NO. <b>6</b> CONTRACTOR <b>CIANBRO CORP.</b></p>		
<p>IN CHARGE: <b>HINKLE</b> MADE BY: <b>G.F.Z.</b> CHK'D BY: <b>J.L.C.</b> DATE: <b>10-1-84</b></p>		
<p>CONTRACT NUMBER: <b>ME-84088-3</b> DRAWING NUMBER: <b>23 OF 47</b></p>		



AP 22883A

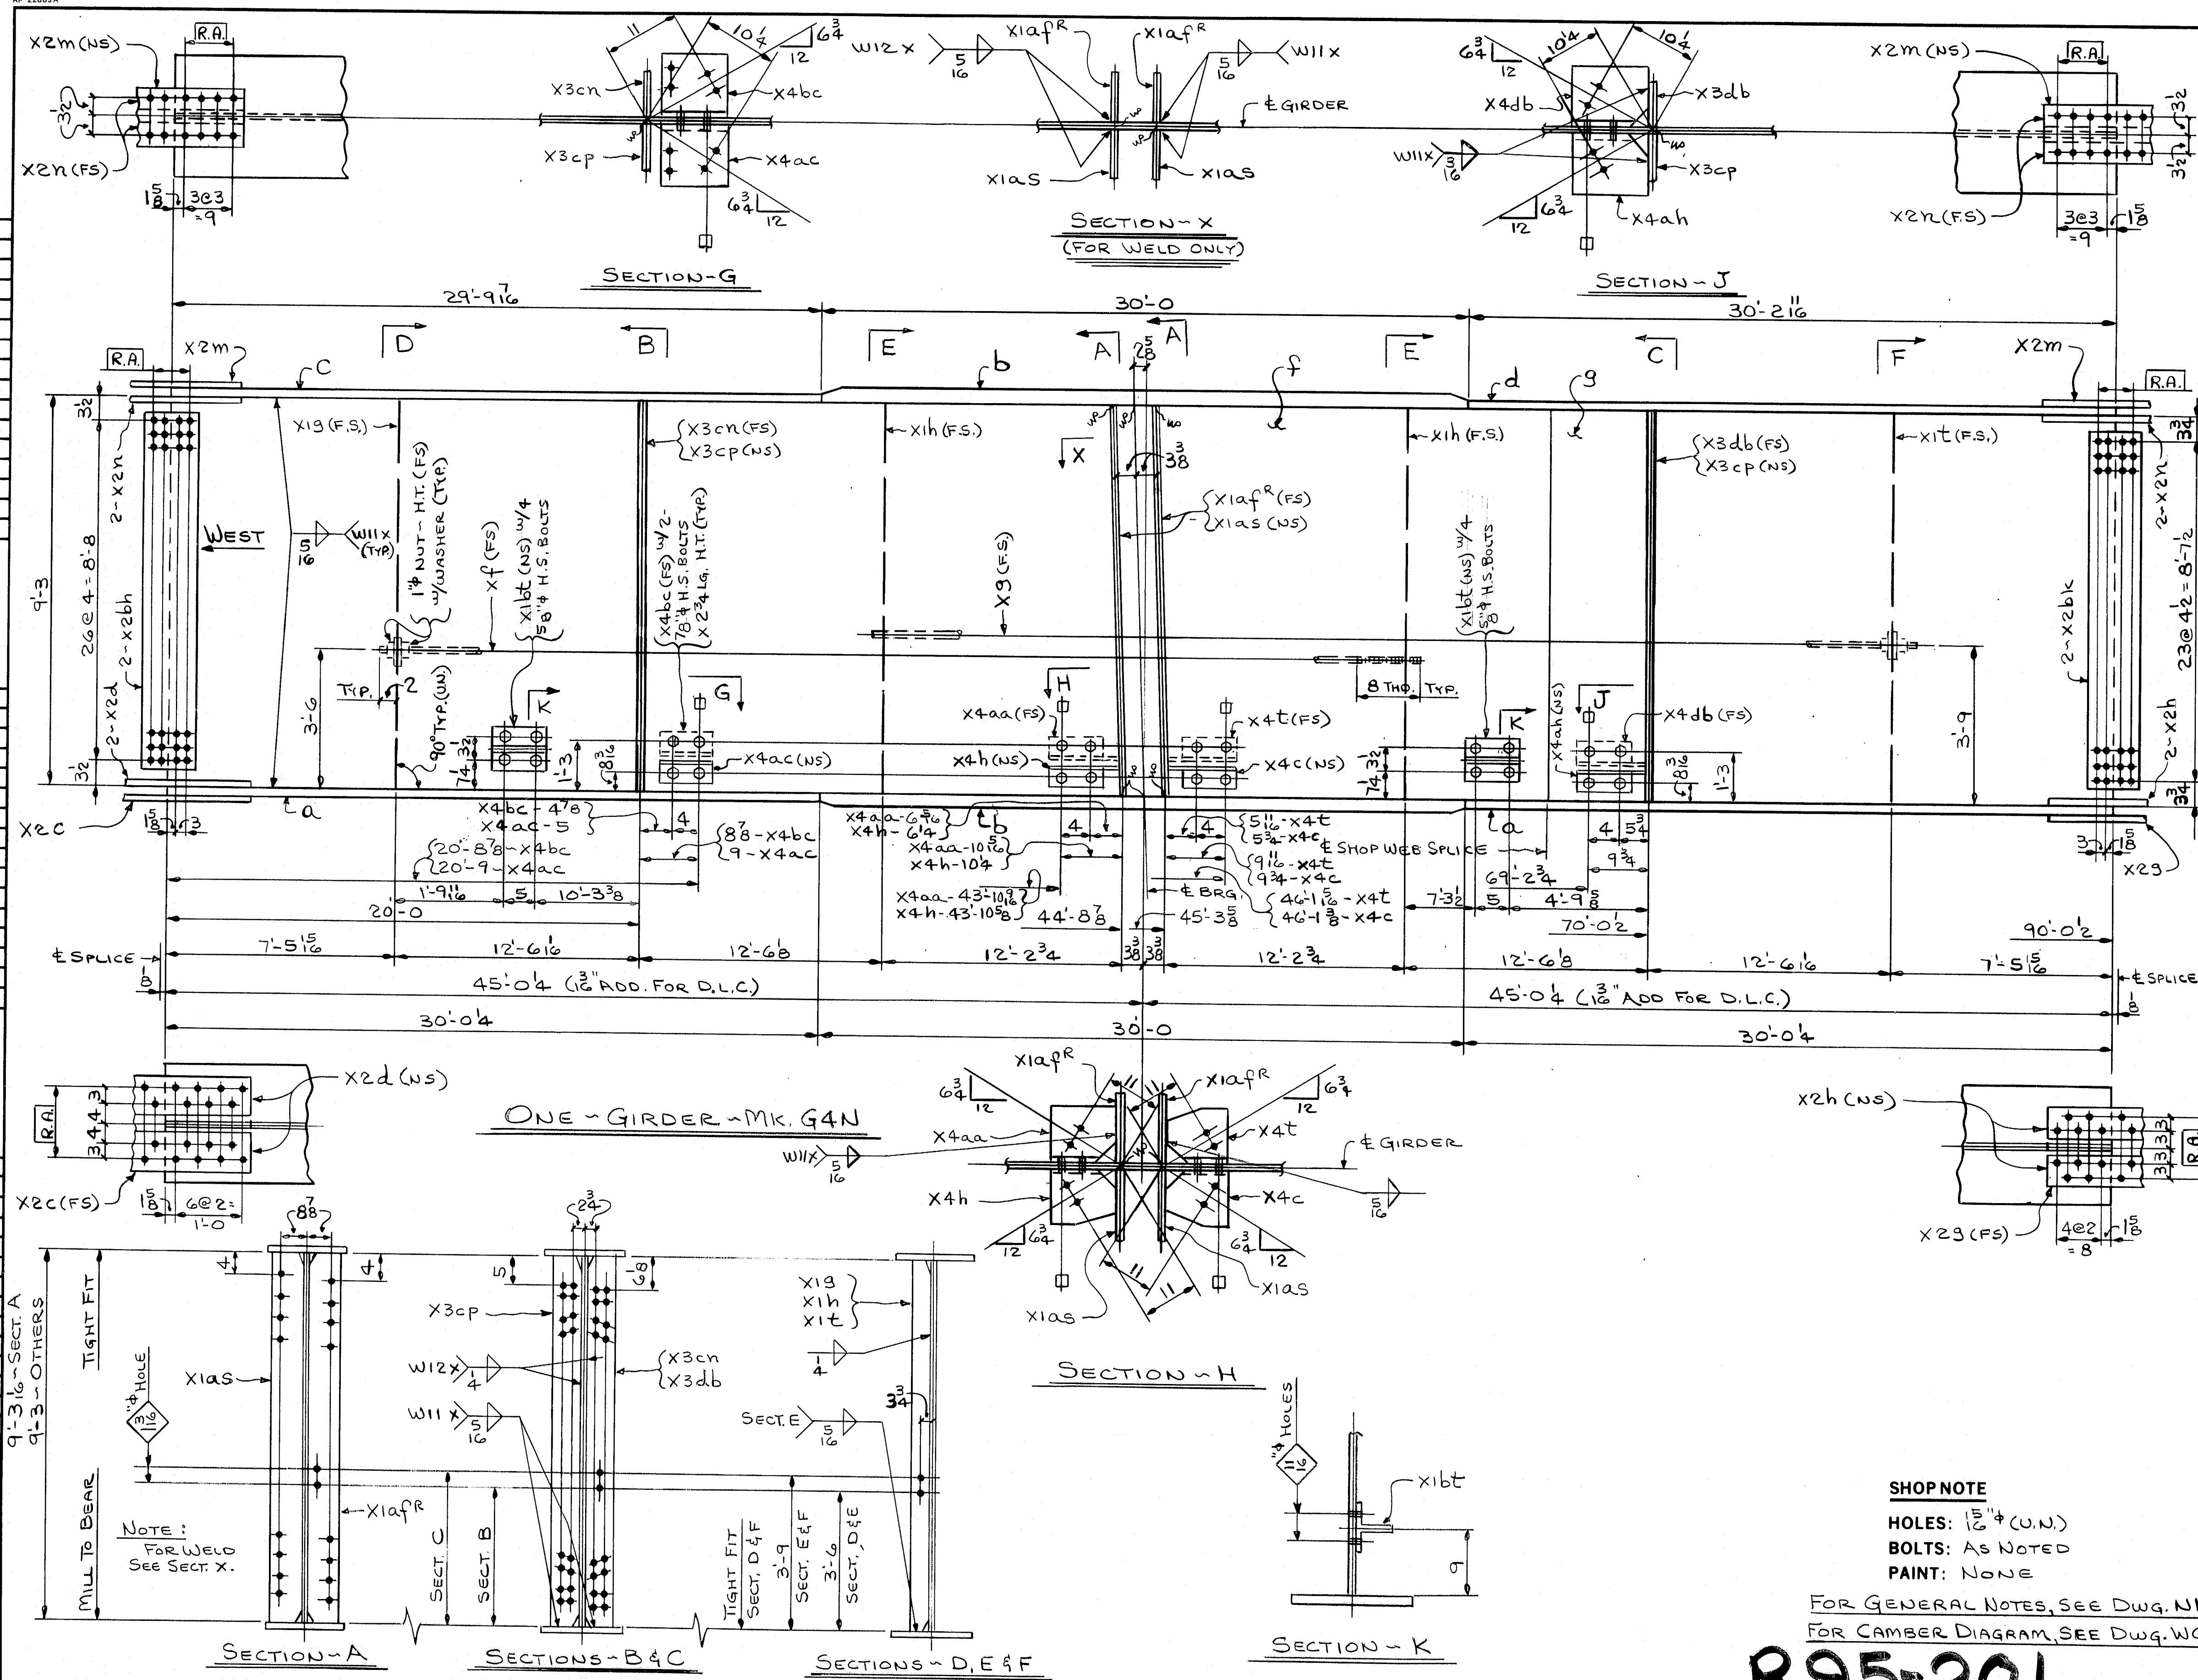

FED. ROAD DIST. NO.	STATE	FED. AID PROJ. NO.
1	ME	11G-395-8(82)174

BILL OF MATERIAL					
NO.	MARK	DESCRIPTION	LENGTH	REMARKS	ITEM
ONE	G4N	GIRDER			49,255
2	a	PL 24 x 1 1/4	30' 0 1/4		
2	b	PL 24 x 2	30' 0		
ONE	c	PL 24 x 1 1/4	29' 9 1/2		
ONE	d	PL 24 x 1 1/4	30' 2 1/2		
ONE	f	PL 111 x 1 1/2	65' 0		
ONE	g	PL 111 x 1 1/2	25' 0 1/2		
ONE	x4	1" ROD	50' 0 2	THD BOTH ENDS	5 10
ONE	x9	1" ROD	50' 2 4	THD BOTH ENDS	5 11
2	x1h	BAR 5 x 1/2	9' 3		
ONE	x13	BAR 5 x 1/2	9' 3		
ONE	x1t	BAR 5 x 1/2	9' 3		
ONE	x2c	PL 19 x 1 1/2	2' 6 1/2		
2	x2d	BAR 8 x 7/8	2' 6 1/2		
ONE	x29	PL 15 x 1 1/2	1' 10 1/2		
2	x2h	BAR 6 x 3/4	1' 10 1/2		
2	x2m	PL 11 x 1/2	2' 0 1/2		
4	x2n	BAR 4 x 3/4	2' 0 1/2		
2	x2bh	PL 107 x 1/2	1' 0 1/2		
2	x2bk	PL 106 x 1/2	1' 0 1/2		
4		1" STD. HEX. NUTS			8 14
4		WASH. FOR 1" RODS			8 12
16		WASH. FOR 7/8" H.S. BOLTS			8 11
16		7/8" H.S. BOLTS	0' 2 1/4		8 7
8		5/8" H.S. BOLTS	0' 2 1/4		8 3
8		WASH. FOR 5/8" H.S. BOLTS			8 10
2	x1bt	WT 6 x 13	0' 8		
2	x1af	PL 10 x 1"	9' 3 1/2		
2	x1as	PL 10 x 1"	9' 3 1/2		
2	x3cp	BAR 7 x 1/2	9' 3		
ONE	x3cn	BAR 7 x 1/2	9' 3		
ONE	x3db	BAR 7 x 1/2	9' 3		
ONE	x4c	PL MC18 x 45.8	0' 11 1/2		
ONE	x4h	0' 11 1/2			
ONE	x4t	0' 11 1/2			
ONE	x4aa	0' 11 1/2			
ONE	x4ac	0' 9 1/2			
ONE	x4bc	0' 10			
ONE	x4ah	PL MC18 x 45.8	0' 11 1/2		
ONE	x4db	PL MC18 x 45.8	0' 11 1/2		


# SHOP NOTE

HOLES: 1 1/2" (U.N.)  
BOLTS: AS NOTED  
PAINT: NONE

FOR GENERAL NOTES, SEE DWG. N1.  
FOR CAMBER DIAGRAM, SEE DWG. W1.

R95-201 Code: 4000


NO.	REVISION	DATE
HIGH STEEL STRUCTURES, INC.		
1905 Old Philadelphia Rd. Lancaster, Pennsylvania 17603 Phone 717/299-5211		
A Subsidiary of High Industries, Inc.		
GIRDER G4N		
I-395 BRIDGE OVER PENOBSCOT RIVER		
I-395 BRIDGE STA. 164 + 60.00		
PENOBSCOT COUNTY		
STATE OF MAINE		
DEPARTMENT OF TRANSPORTATION		
STATE CONTRACT OR REF. NO.	CONTRACTOR	DATE
6	CIANBRO CORP.	10-1-84
IN CHARGE: HINKLE	MADE BY: G.F.Z.	CHK'D BY: J.L.C.
CONTRACT ME-84088-3	DRAWING NUMBER	24 OF 47

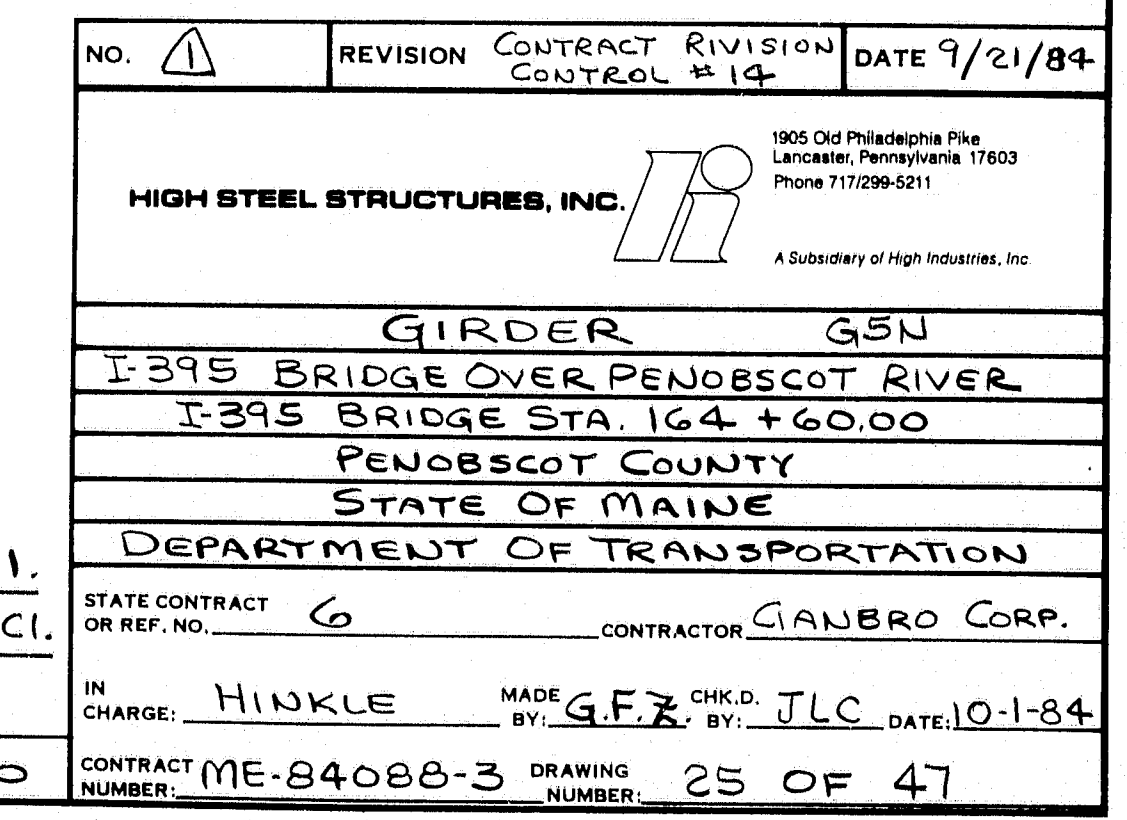

**R95-202** Code: 4000



AF 22693A

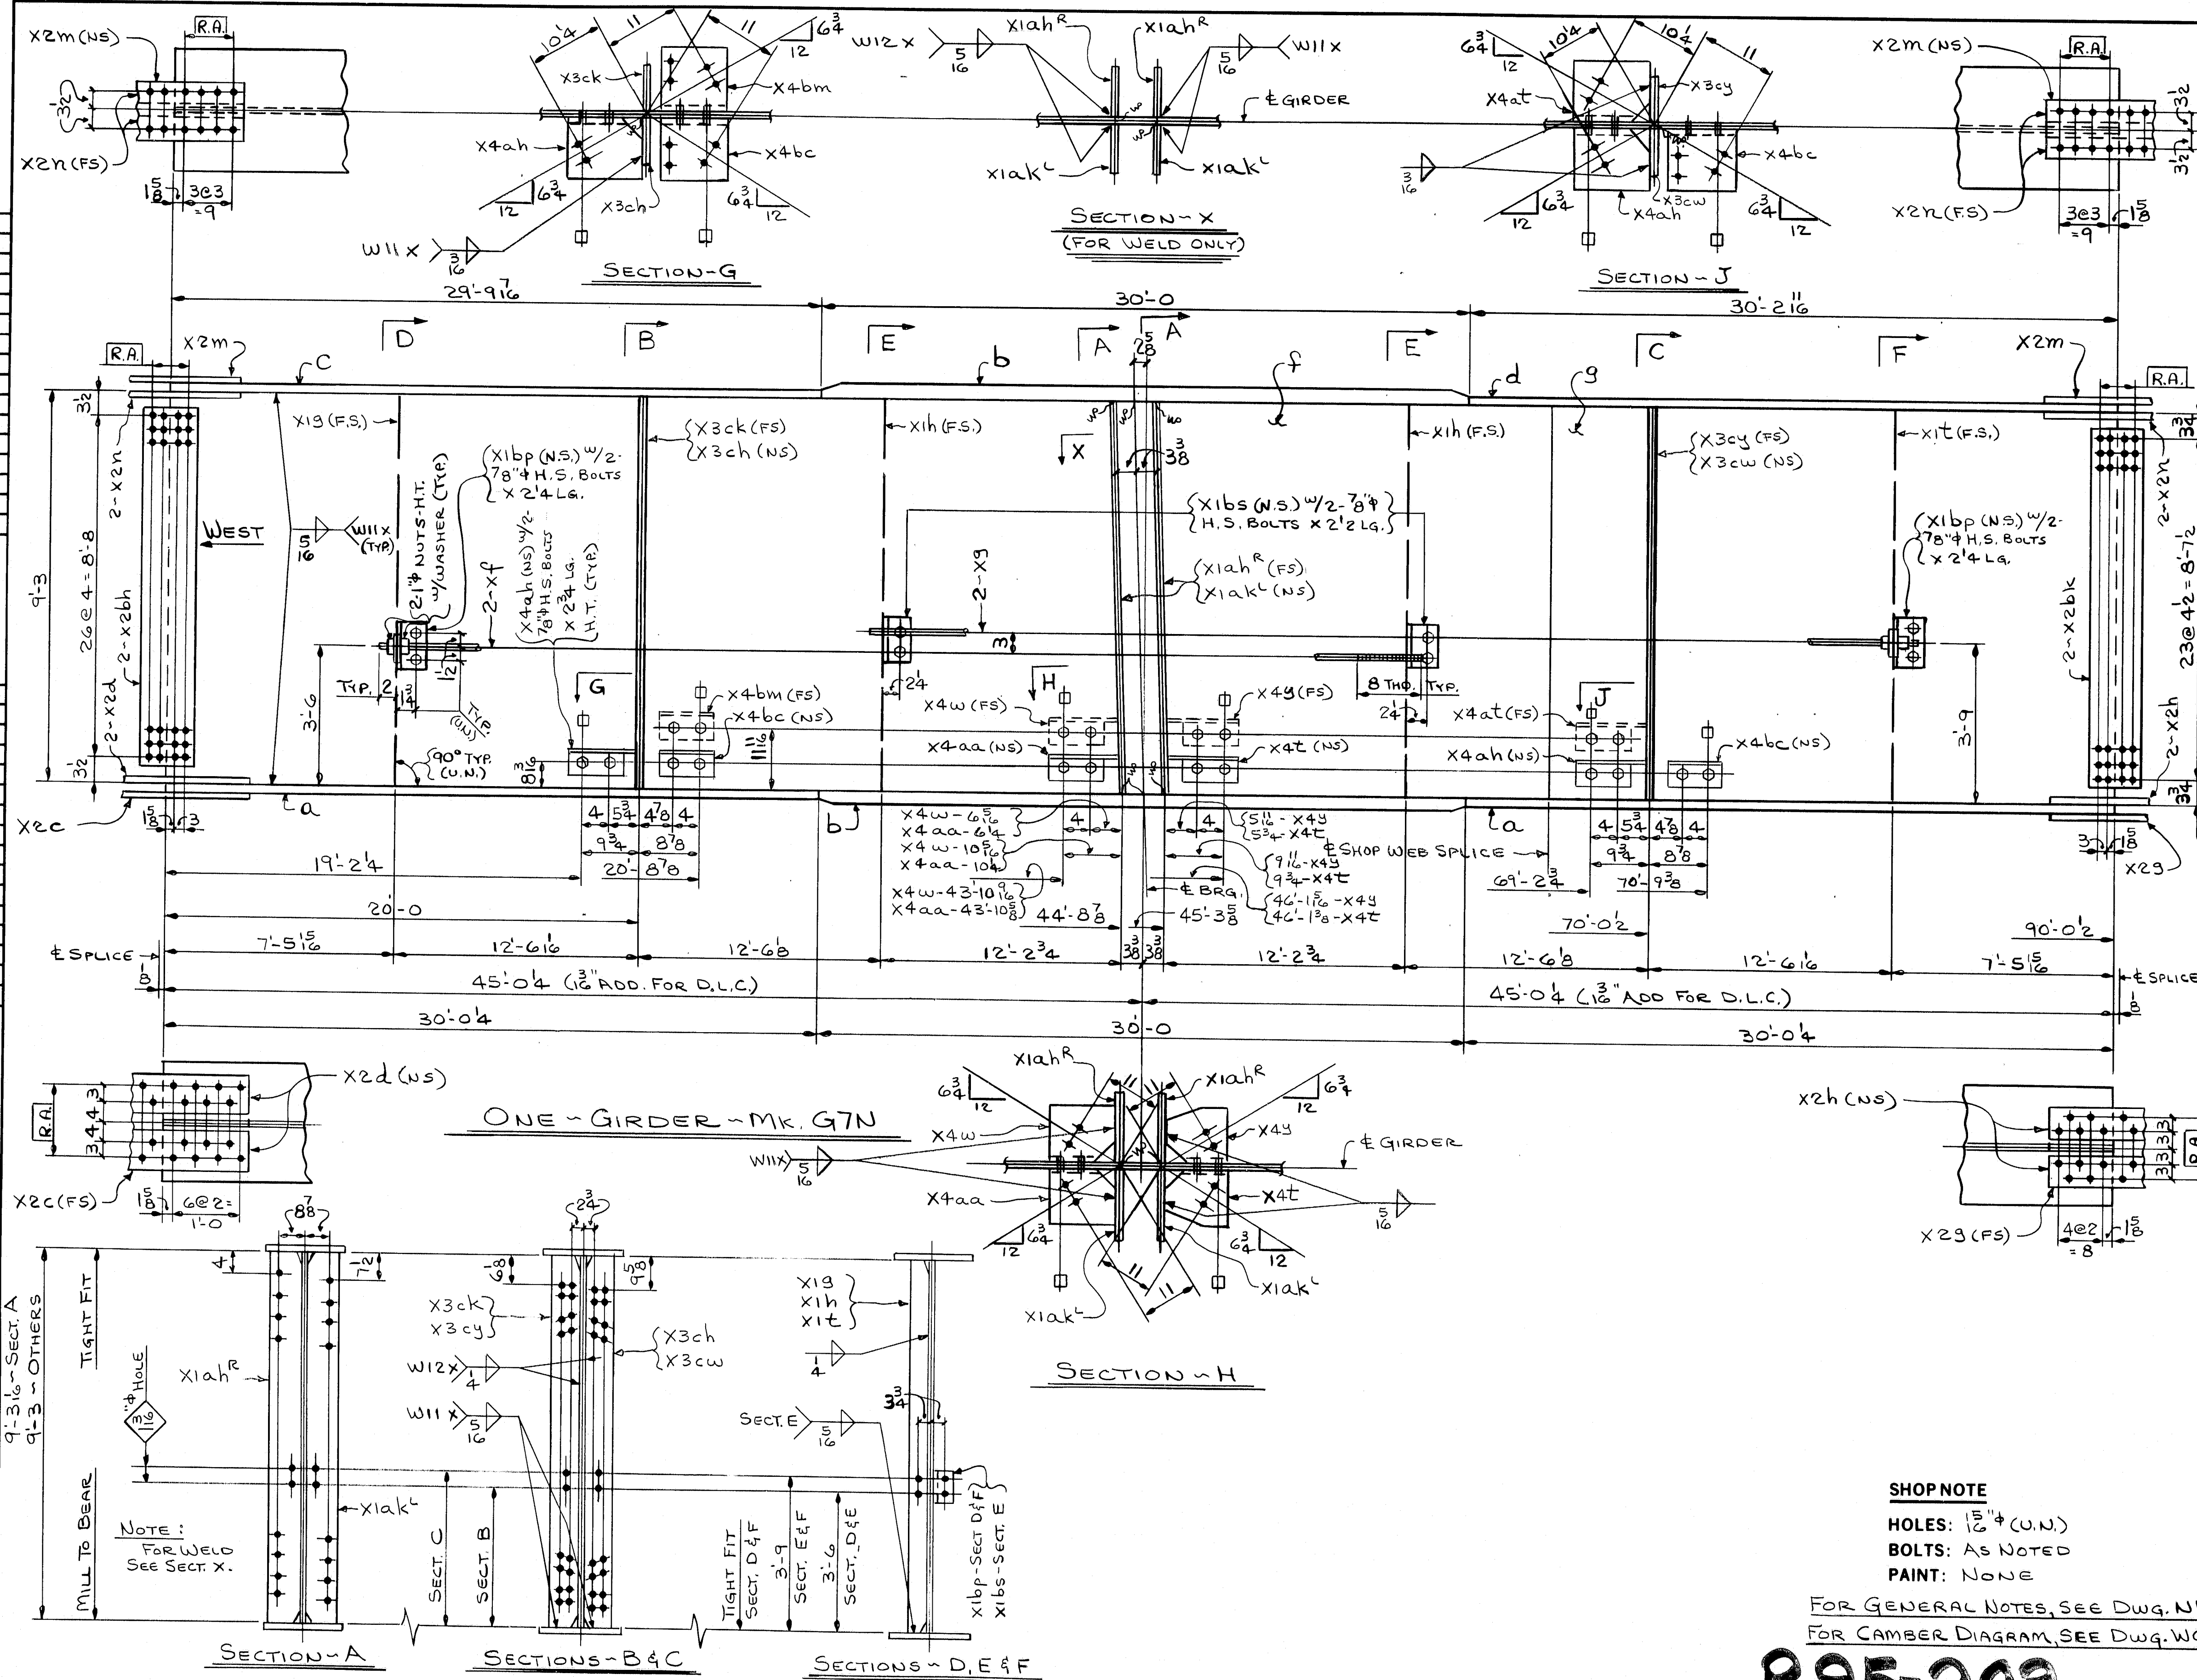

SHOP NOTE

BOLTS: AS NOTED  
PAINT: NONE

FOR GENERAL NOTES, SEE DWG. N1.  
FOR CAMBER DIAGRAM, SEE DWG. WCI.

R95-203 Code: 4000


FED. ROAD DIV. NO.		STATE		FED. AID PROJ. NO.	
1		ME		114-395-0(02)174	

BILL OF MATERIAL						
NO.	MARK	DESCRIPTION	LENGTH	REMARKS	ITEM	TOTAL WEIGHT
ONE	G7N	GIRDER				49,620
2	a	PL 24 x 1 1/2	30' 0 1/4			
2	b	PL 24 x 2	30' 0			
ONE	c	PL 24 x 1 1/2	29' 9 1/2			
↑	d	PL 24 x 1 1/2	30' 2 1/2			
↑	f	PL 111 x 1 1/2	45' 0			
ONE	g	PL 111 x 1 1/2	25' 0 1/2			
2	x f	1" ROD	50' 0 2	THD. BOTH ENDS	5' 10	
2	x g	1" ROD	50' 2 1/2	THD. BOTH ENDS	5' 11	
2	x i h	BAR 5 x 1/2	9' 3			
ONE	x i s	BAR 5 x 1/2	9' 3			
ONE	x i t	BAR 5 x 1/2	9' 3			
ONE	x 2 c	PL 19 x 1 1/2	2' 6 1/2			
2	x 2 d	BAR 8 x 3/8	2' 6 1/2			
ONE	x 2 g	PL 15 x 1 1/2	1' 10 1/2			
2	x 2 h	BAR 6 x 3/4	1' 10 1/2			
2	x 2 m	PL 11 x 1/2	2' 0 1/2			
4	x 2 n	BAR 4 x 3/4	2' 0 1/2			
2	x 2 b h	PL 107 x 1/2	1' 0 1/2			
2	x 2 b k	PL 106 1/2 x 1/2	1' 0 1/2			
8		1" STD. HEX. NUTS			8' 14	
8		WASH. FOR 1" RODS			8' 12	
28		WASH. FOR 3/8" H.S. BOLTS			8' 11	
4		3/8" H.S. BOLTS	0' 2 1/4		8' 5	
4		3/8" H.S. BOLTS	0' 2 1/2		8' 6	
20		3/8" H.S. BOLTS	0' 2 3/4		8' 7	
2	x i a h	PL 10 x 1"	9' 3 1/2			
2	x i a k	PL 10 x 1"	9' 3 1/2			
2	x i b s	5 x 3 1/2 x 1/2	0' 6			
2	x i b p	5 x 3 x 1/4	0' 6			
ONE	x 3 c h	BAR 7 x 1/2	9' 3			
↑	x 3 c k	↑	↑			
↓	x 3 c w	↓	↓			
ONE	x 3 c y	BAR 7 x 1/2	9' 3			
ONE	x 4 t	PL MC 18 x 45.8	0' 11 1/2			
↑	x 4 w	↑	0' 11 1/2			
↑	x 4 y	↑	0' 11 1/2			
↑	x 4 a a	↑	0' 11 1/2			
↑	x 4 a t	↑	0' 11 1/2			
ONE	x 4 b m	↑	0' 10			
2	x 4 b c	↓	0' 10			
2	x 4 a h	PL MC 18 x 45.8	0' 11 1/2			

NO.	REVISION	DATE
<p><b>HIGH STEEL STRUCTURES, INC.</b></p> <p>1905 Old Philadelphia Pike Lancaster, Pennsylvania 17603 Phone 770-286-5211</p> <p>A Subsidiary of High Industries, Inc.</p>		
<p><b>GIRDER G7N</b></p> <p>I-395 BRIDGE OVER PENOBSCOT RIVER</p> <p>I-395 BRIDGE STA. 164 + 60.00</p> <p>PENOBSCOT COUNTY</p> <p>STATE OF MAINE</p> <p>DEPARTMENT OF TRANSPORTATION</p>		
<p>STATE CONTRACT OR REF. NO. <b>6</b> CONTRACTOR <b>CIANBRO CORP.</b></p>		
<p>IN CHARGE: <b>HINKLE</b> MADE BY: <b>G.F.Z.</b> CHK.D. BY: <b>JLC</b> DATE: <b>10-1-84</b></p>		
<p>CONTRACT NUMBER: <b>ME-84088-3</b> DRAWING NUMBER: <b>26 OF 47</b></p>		




AP 2288A

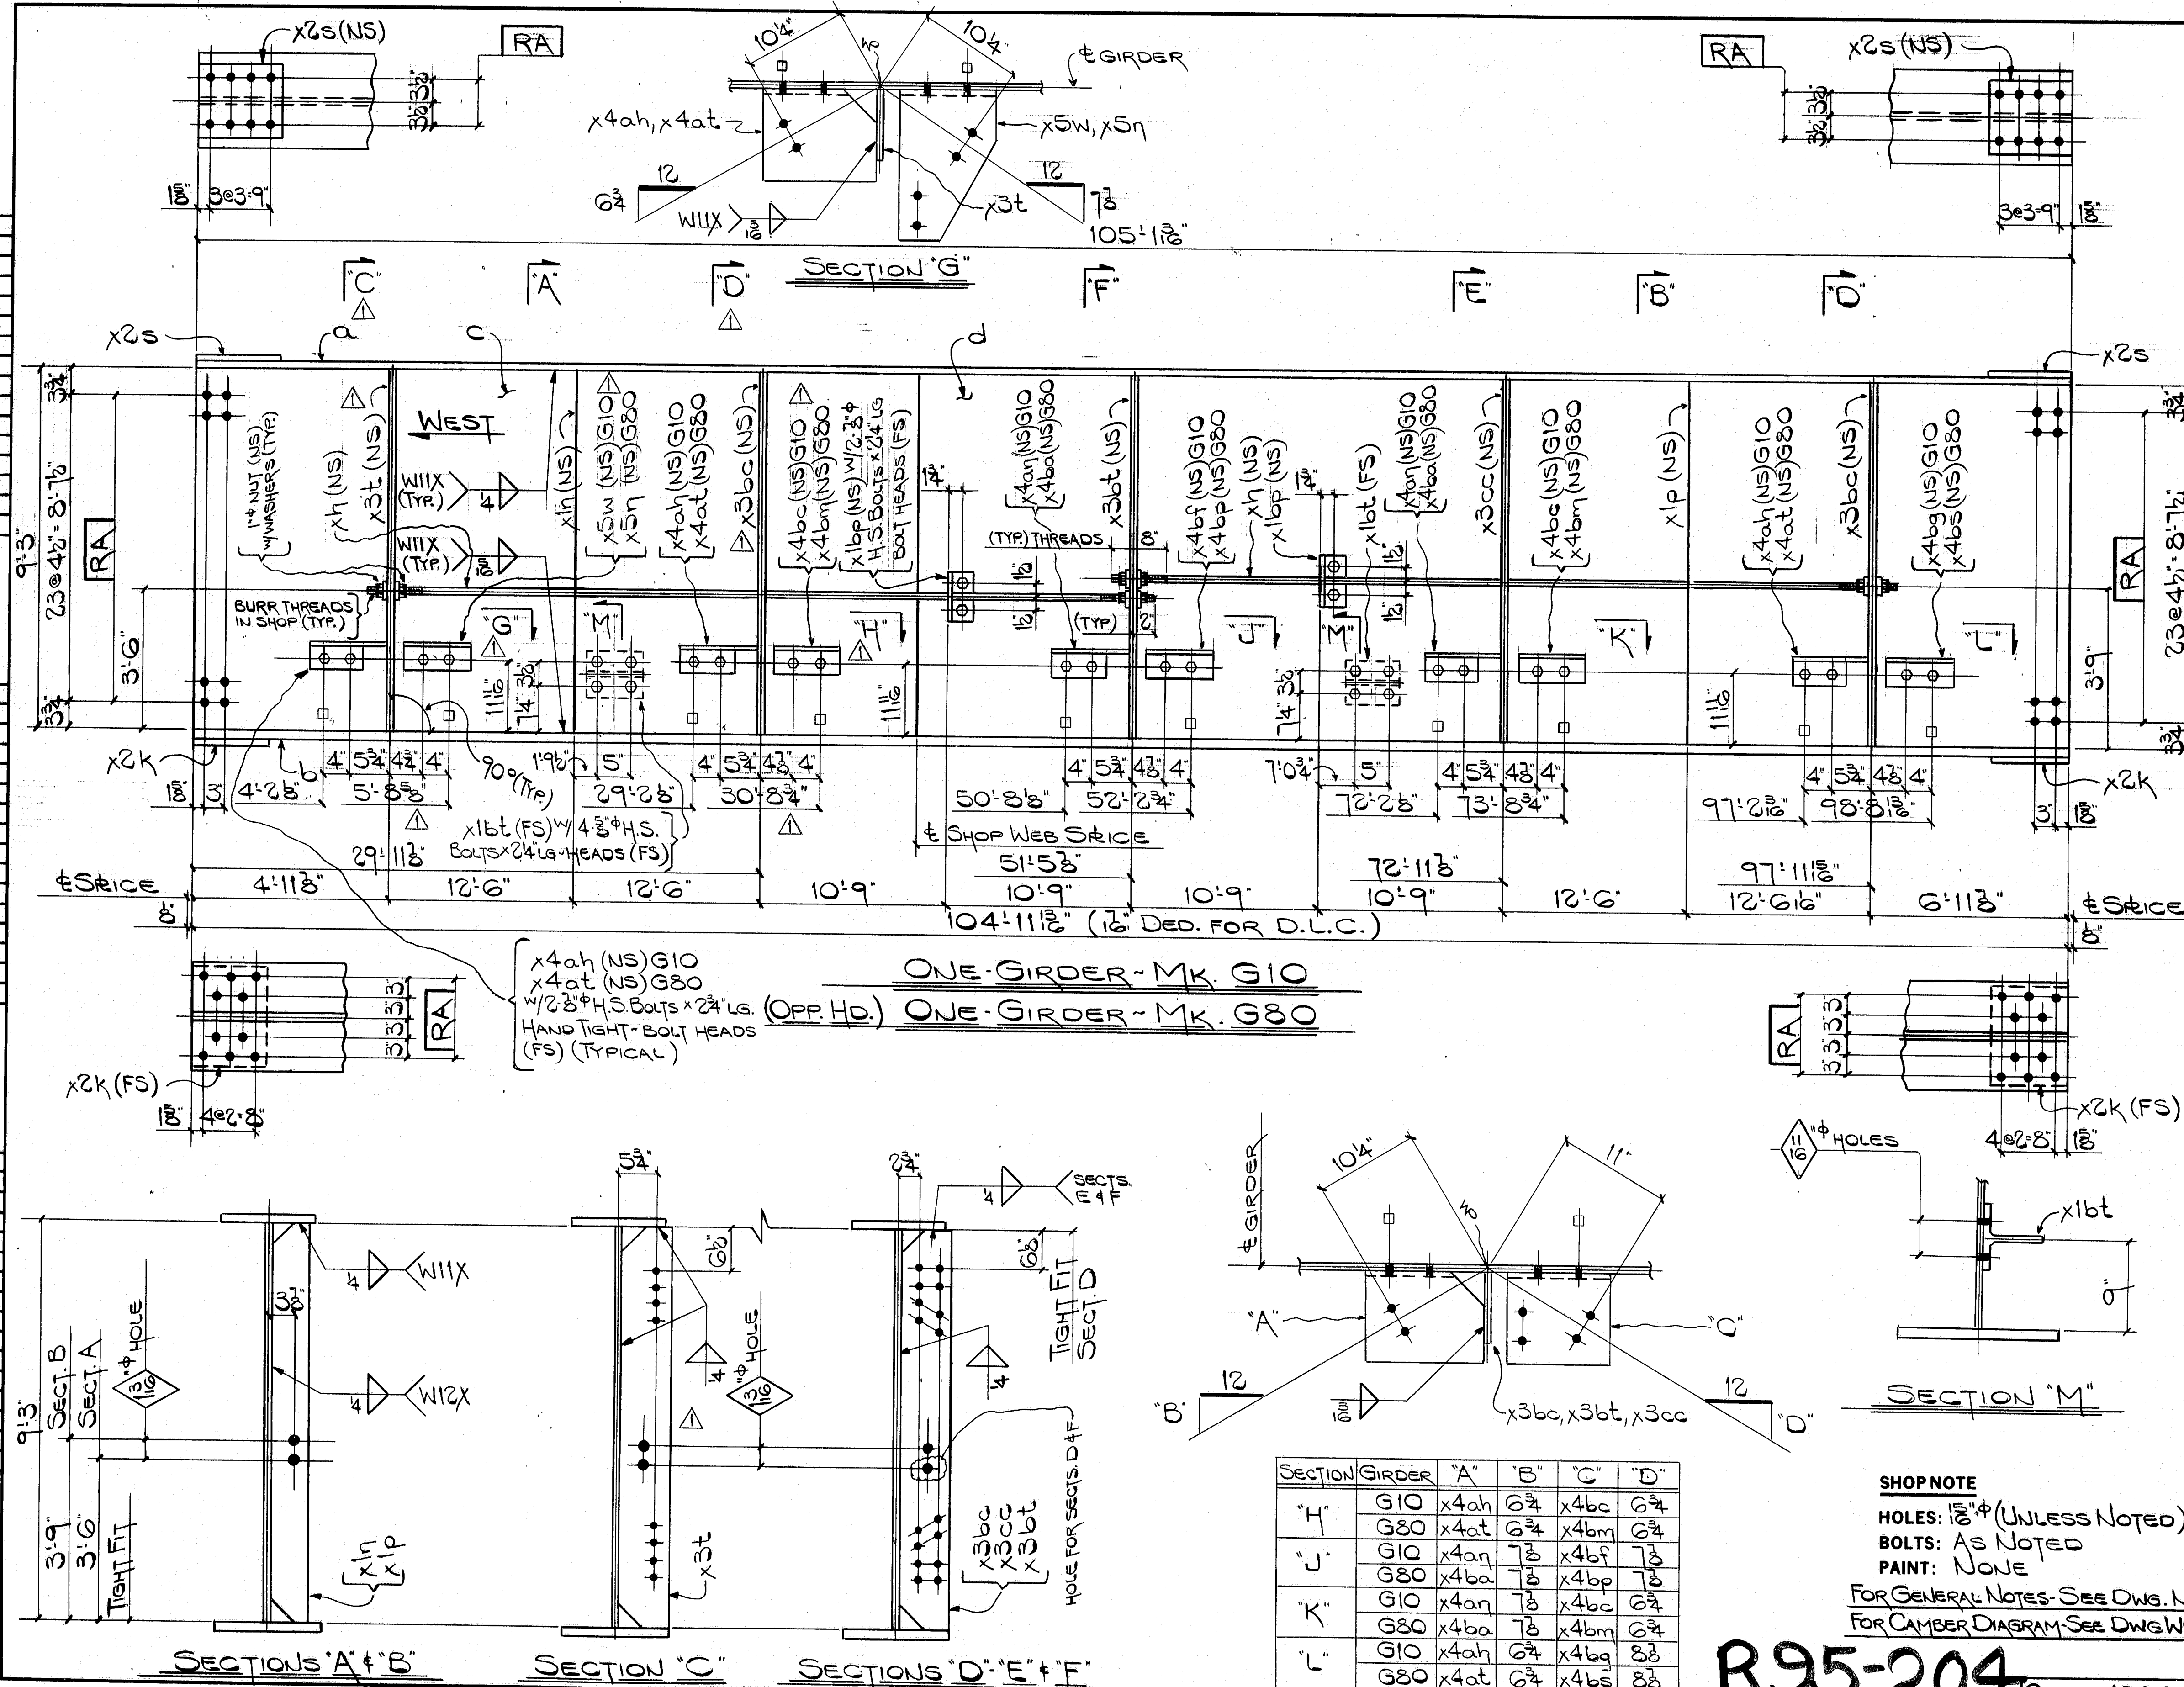

FED. ROAD DIV. NO.		STATE		FED. AID PROJ. NO.	
1		ME		116358(82)176	

BILL OF MATERIAL					
NO.	MARK	DESCRIPTION	LENGTH	REMARKS	ITEM WEIGHT
ONE GIRDER ~ MK. G10					
ONE GIRDER ~ MK. G80 (OPPHD.)					
2	a	R. 14 x 3/4	105' 1 1/2"		38,220
2	b	R. 10 x 1	104' 1 1/2"		27,111
2	c	R. 11 1/2 x 1 1/2	35' 6 1/2"		8,271
2	d	R. 11 1/2 x 1 1/2	69' 6 1/2"		18,445
4	x2k	Fill R. 15 x 4	0' 11 1/2"		3,274
4	x2s	Fill R. 11 x 2	1' 0 1/2"		2,770
2	x1n	BAR 5 x 2	9' 3"		78,638
2	x1p	BAR 5 x 2	9' 3"		78,638
4	x1bp	5 x 3 x 4	0' 6"		2,500
4	x1bt	WT 6 x 13	0' 8"		17,241
2	x3t	BAR 7 x 2	9' 3"		10,108
4	x3bc	BAR 7 x 2	9' 3"		22,416
2	x3bt	BAR 7 x 2	9' 3"		10,108
2	x3cc	BAR 7 x 2	9' 3"		10,108
3	x4ah	R. MC18 x 45.8	0' 11 1/2"	G10	121,677
3	x4at		0' 11 1/2"	G80	
2	x4bc		0' 10"	G10	70,248
2	x4bm		0' 10"	G80	
ONE	x5w		0' 8 3/4"	G10	28,102
ONE	x5n		0' 8 3/4"	G80	
2	x4an		0' 11 1/2"	G10	24,278
2	x4ba		0' 11 1/2"	G80	
ONE	x4bf		0' 10"	G10	5,217
ONE	x4bp		0' 10"	G80	
ONE	x4bg		0' 10"	G10	
ONE	x4bs	R. MC18 x 45.8	0' 10"	G80	
4	xh	1" Rod	46' 10"	THREAD BOTH ENDS	5,546
16		8" H.S. BOLT	0' 24"		5' 3"
16		WASHERS FOR 8" H.S. BOLTS			5' 10"
8		8" H.S. BOLT	0' 24"		5' 3"
40		8" H.S. BOLT	0' 24"		5' 1"
48		WASHERS FOR 8" H.S. BOLTS			5' 11"
16		1" STD. HEX. NUTS			5' 14"
16		WASHERS FOR 1" RODS			5' 12"

NO.	REVISION	const. joint moved central +/- 15'	DATE	11-19-84
-----	----------	---------------------------------------	------	----------

HIGH STEEL STRUCTURES, INC.				1905 Old Philadelphia Pike Lancaster, Pennsylvania 17603 Phone 717/299-5211	
A Subsidiary of High Industries, Inc.					
GIRDER ~ G10 & G80					
I-395 Bridge over Penobscot River					
I-395 Bridge Sta. 164 + 60.00					
PENOBSCOT COUNTY					
STATE OF MAINE					
DEPARTMENT OF TRANSPORTATION					
STATE CONTRACT OR REF. NO.		G		CONTRACTOR	
				CIANBRO CORP.	
IN CHARGE:		HINKLE		MADE BY: CS	
				CHK'D BY: JLC	
				DATE: 9-27-84	
CONTRACT NUMBER:		ME-84028-3		DRAWING NUMBER:	
				27 of 47	


**R95-204** Code: 4000







AF 22693A

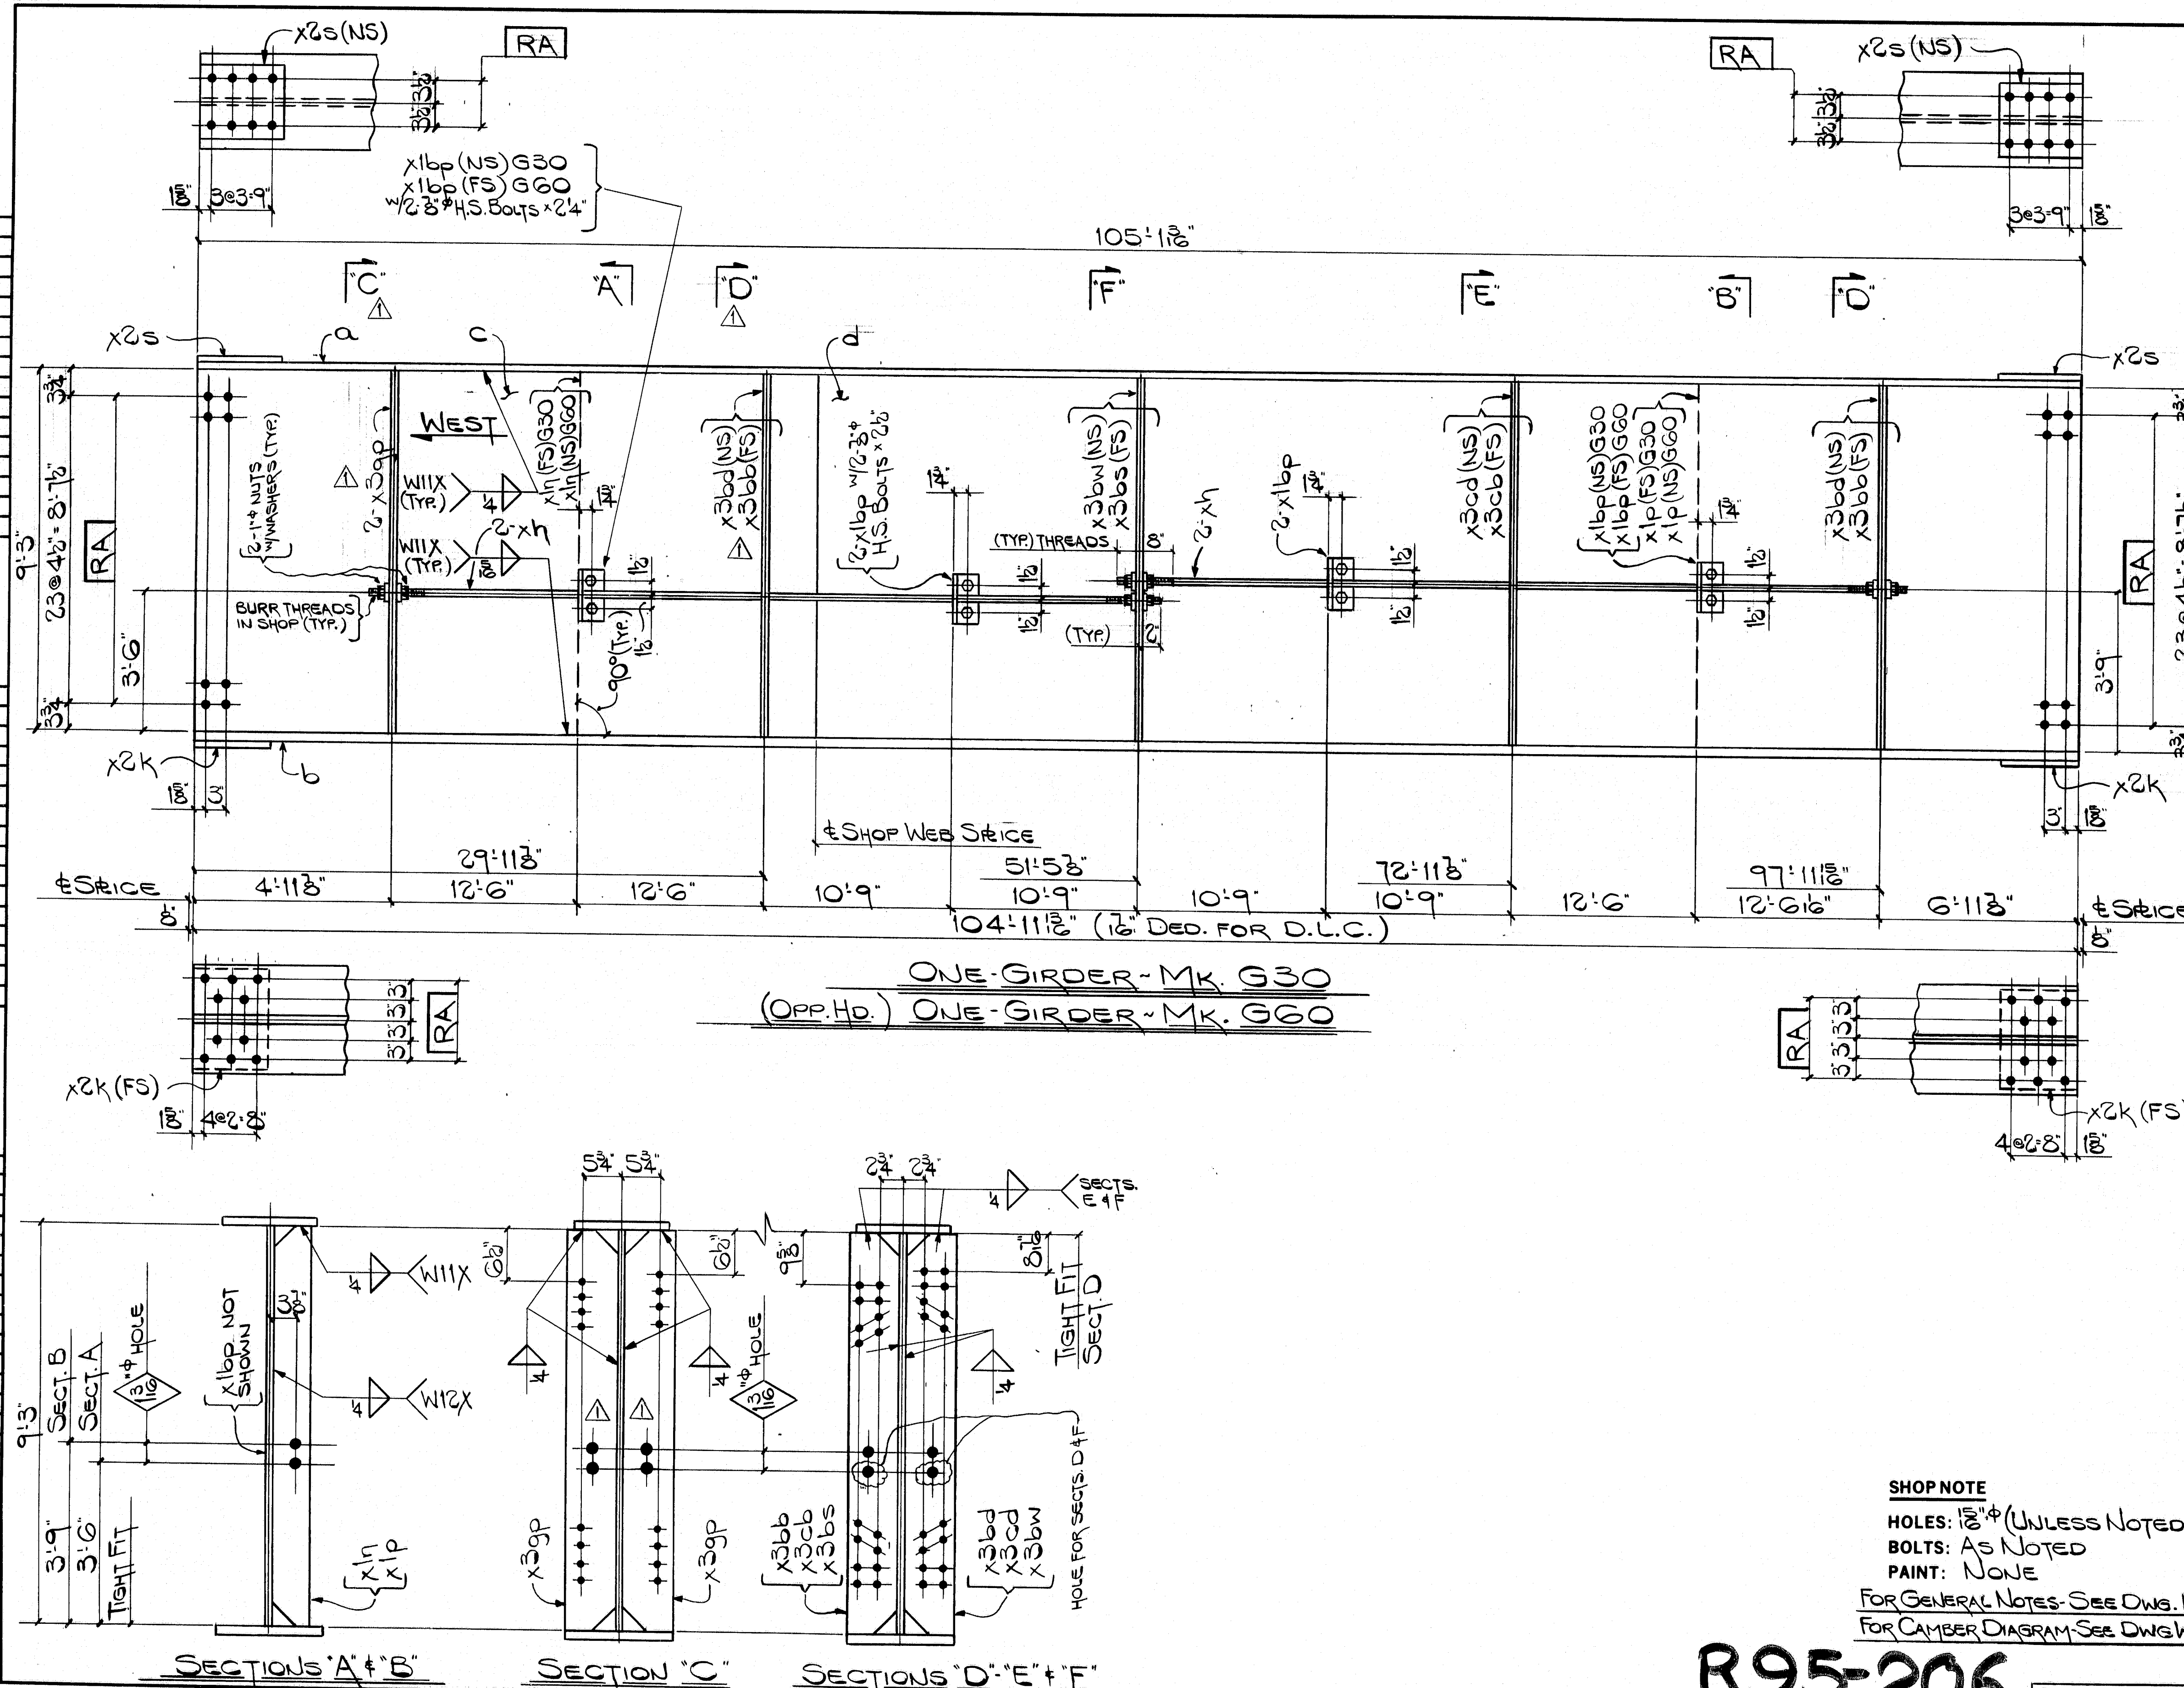

NO.	MARK	DESCRIPTION	LENGTH	REMARKS	ITEM	TOTAL WEIGHT
-----	------	-------------	--------	---------	------	--------------

NO.	MARK	DESCRIPTION	LENGTH	REMARKS	ITEM	TOTAL WEIGHT
1		ONE GIRDER-MK. G30				38.575
2	a	ONE GIRDER-MK. G60 (OPP. HD.)				38.575
2	a	R. 14 x 3/4	105' 1 1/2"			
2	b	R. 16 x 1	104' 11 1/2"			
2	c	R. 111 x 1 1/2	35' 6 1/2"			
2	d	R. 111 x 1 1/2	69' 6 1/2"			
4	x2k	FILL R. 15 x 4	0' 11 1/2"			
4	x2s	FILL R. 11 x 2	1' 0 1/2"			
2	x1n	BAR 5 x 2	9' 3"			
2	x1p	BAR 5 x 2	9' 3"			
12	x1bp	5 x 3 x 4	0' 6"			
4	x3bb	BAR 7 x 2	9' 3"			
4	x3bd	BAR 7 x 2	9' 3"			
4	x3bp	BAR 7 x 2	9' 3"			
2	x3bs	BAR 7 x 2	9' 3"			
2	x3bw					
2	x3cb					
2	x3cd	BAR 7 x 2	9' 3"			
8	xh	1" ROD	46' 10"	THREAD BOTH ENDS	5' 5 1/2"	
8		8" H.S. BOLT	0' 24"		5' 1/2"	
8		8" H.S. BOLT	0' 22"		5' 1/2"	
16		WASHERS FOR 8" H.S. BOLTS			5' 1"	
32		1" STD. HEX NUTS			5' 1/4"	
32		WASHERS FOR 1" RODS			5' 1/2"	

# SHOP NOTE

HOLES: 1 1/2" (UNLESS NOTED)  
 BOLTS: AS NOTED  
 PAINT: NONE  
 FOR GENERAL NOTES-SEE DWG. N1  
 FOR CAMBER DIAGRAM-SEE DWG. WC1


R95-206

CODE: 4000

NO.	REVISION	const. joint moved	DATE 11-19-84
<p>HIGH STEEL STRUCTURES, INC.</p> <p>1905 Old Philadelphia Pike              Leicestershire, Pennsylvania 17033              Phone 717/299-5211</p> <p>A Subsidiary of High Industries, Inc.</p>			
<p>GIRDER - G30 &amp; G60</p> <p>I-395 BRIDGE OVER PENOBSCOT RIVER</p> <p>I-395 BRIDGE STA. 164 + 60.00</p> <p>PENOBSCOT COUNTY</p> <p>STATE OF MAINE</p> <p>DEPARTMENT OF TRANSPORTATION</p> <p>STATE CONTRACT OR REF. NO. 6</p> <p>CONTRACTOR CIANGRO CORP.</p>			
IN CHARGE	MADE BY	CHK'D BY	DATE
HINKLE	CS	JLC	9-27-84
CONTRACT	ME-840288-3	DRAWING	29 OF 47



AP 22083A

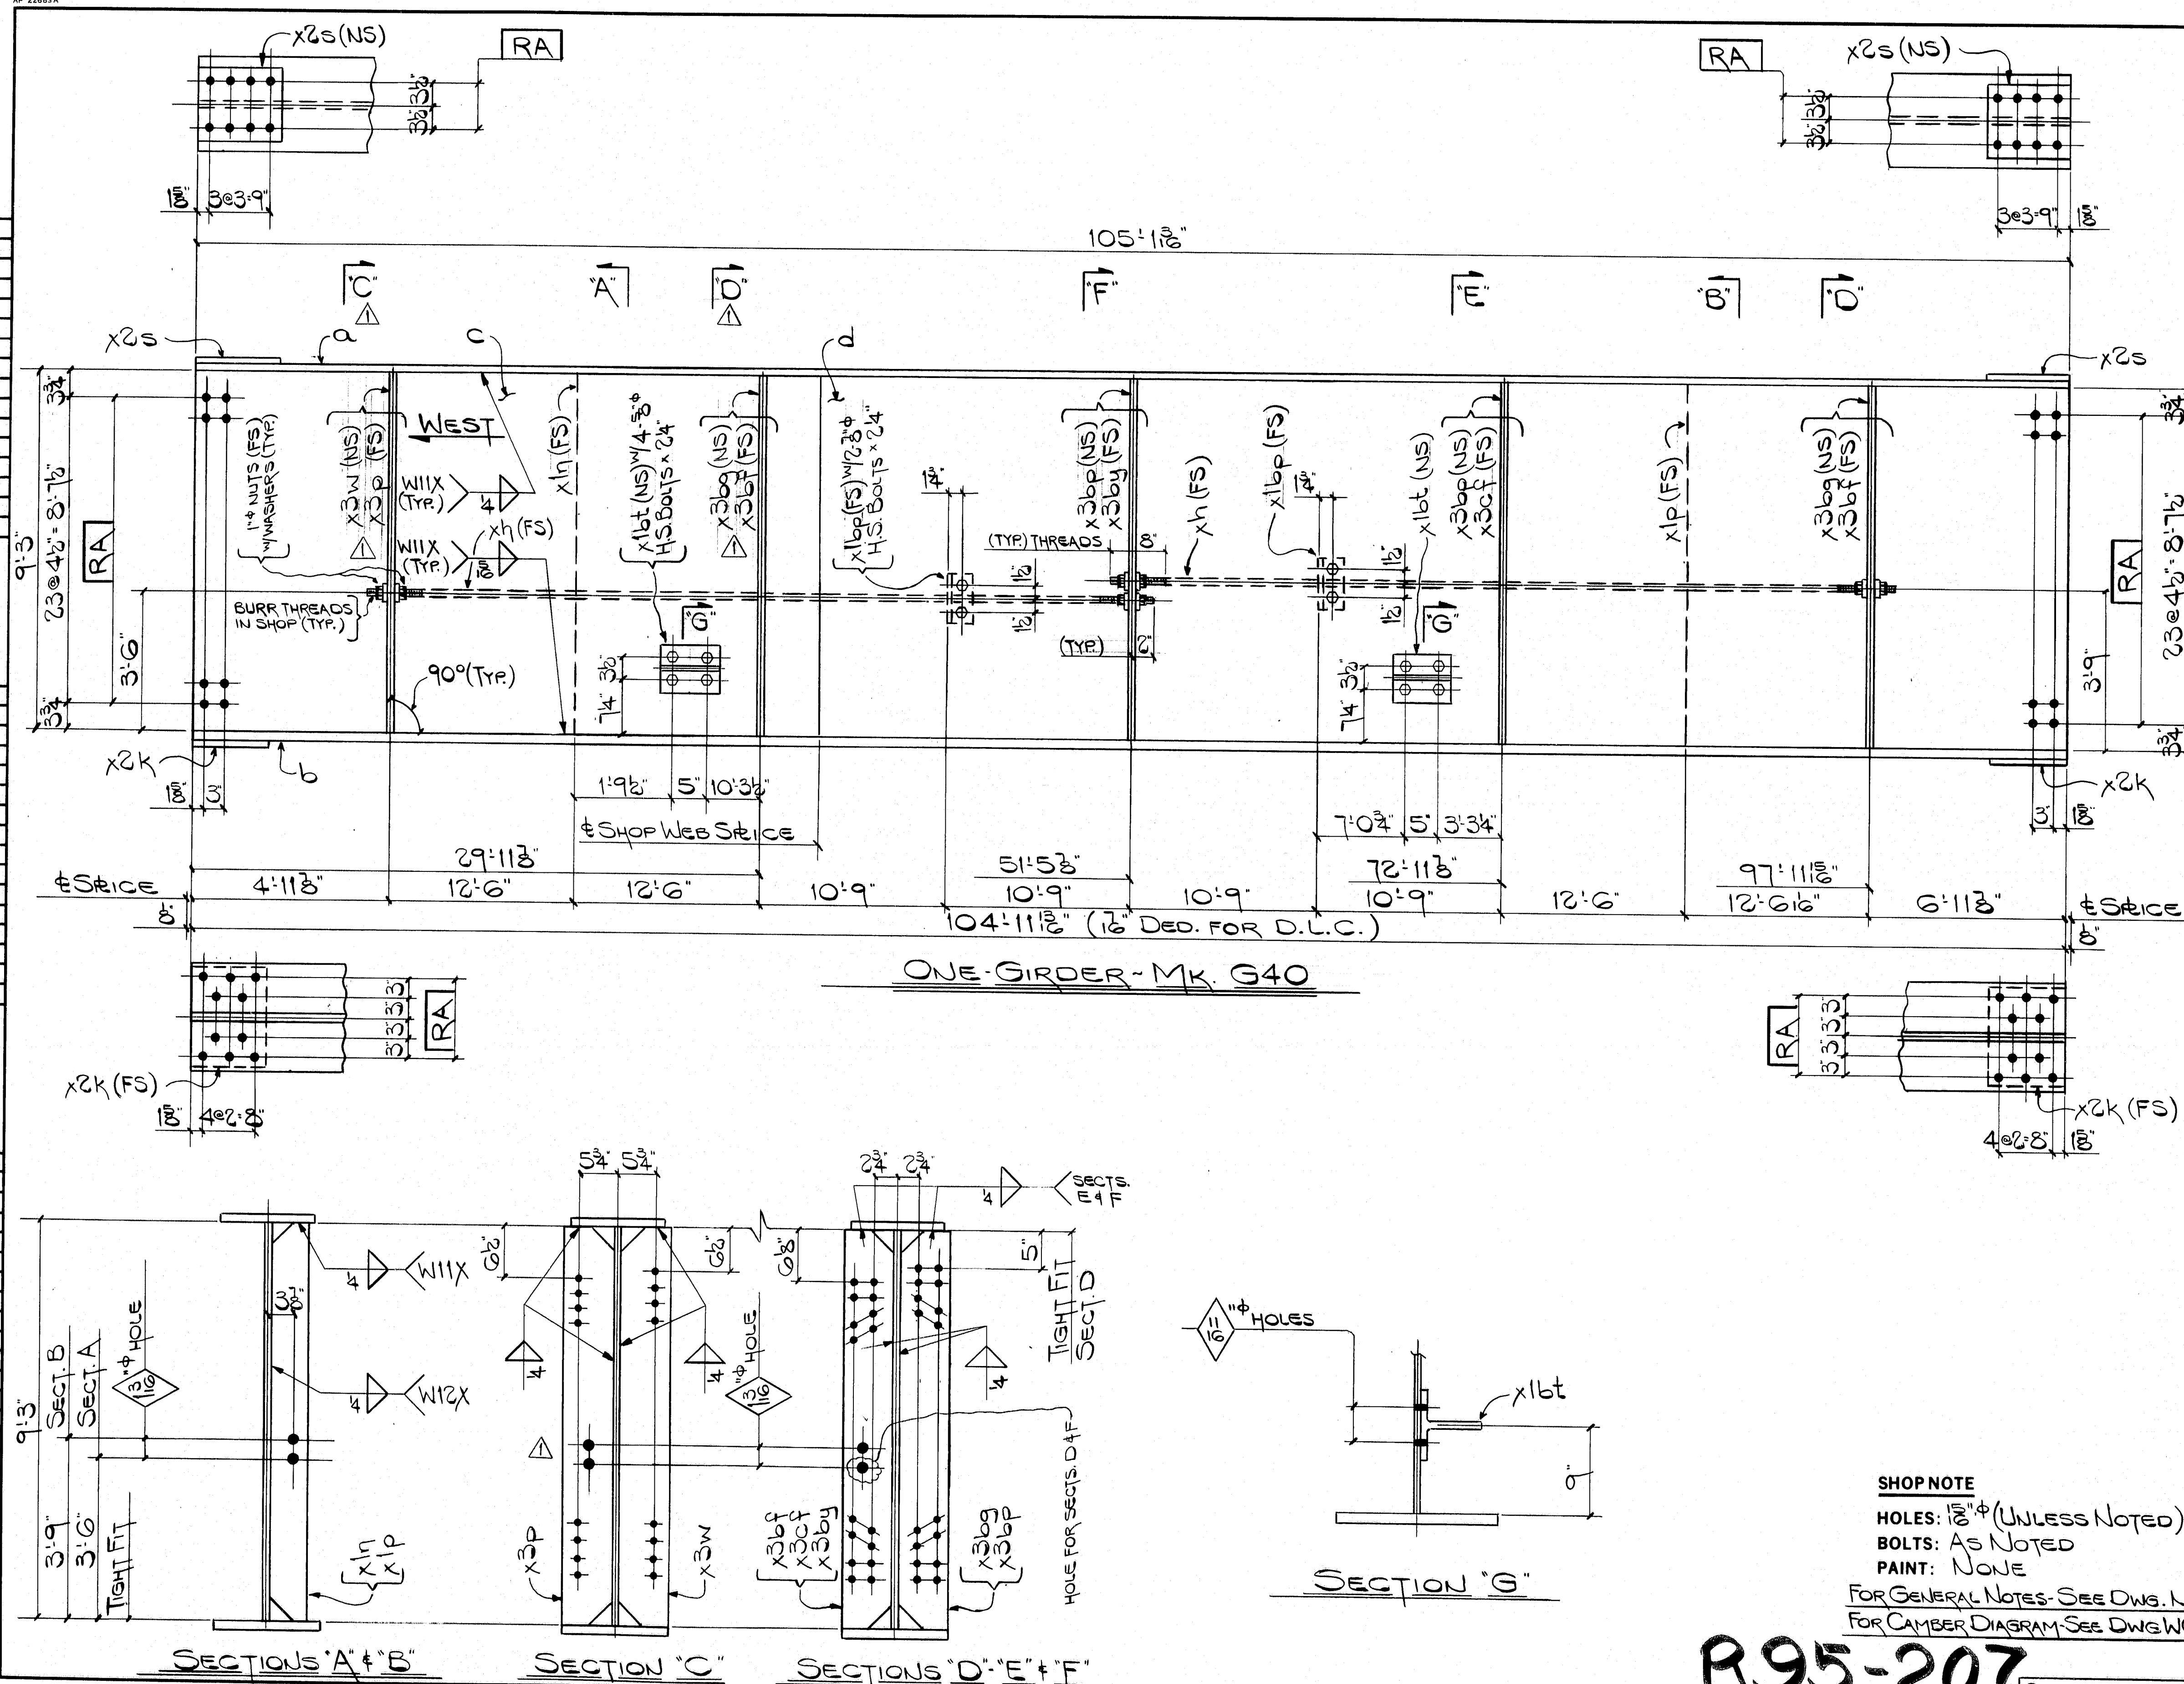

FED. ROAD DIST. NO.	STATE	FED. AID PROJ. NO.
1	ME	113358(02)176


BILL OF MATERIAL					
NO.	MARK	DESCRIPTION	LENGTH	REMARKS	TOTAL WEIGHT
ONE GIRDER - MK. G40					
ONE	a	R. 14 x 24	105' 1 1/8"		30.225
ONE	b	R. 16 x 1	104' 1 1/8"		
ONE	c	R. 111 x 16	35' 6 1/2"		
ONE	d	R. 111 x 16	69' 6 1/2"		
2	x2k	FILL R. 15 x 4	0' 11 1/8"		
2	x2s	FILL R. 11 x 2	1' 0 1/8"		
ONE	x1n	BAR 5 x 2	9' 3"		
ONE	x1p	BAR 5 x 2	9' 3"		
2	x1bp	5 x 3 x 4	0' 6"		
2	x3b	BAR 7 x 2	9' 3"		
2	x3bf				
ONE	x3w				
ONE	x3p				
2	x3bp				
ONE	x3by				
ONE	x3cf	BAR 7 x 2	9' 3"		
2	xh	1" ROD	46' 10"	THREAD BOTH ENDS	5' 5 1/2"
2	x1bt	WTG x 13	0' 8"		
8		3" H.S. BOLT	0' 24"		8' 3"
8		WASHERS FOR 3" H.S. BOLTS			8' 10"
4		3" H.S. BOLT	0' 24"		8' 3"
4		WASHERS FOR 3" H.S. BOLTS			8' 11"
8		1" STD. HEX. NUTS			8' 14"
8		WASHERS FOR 1" RODS			8' 12"

# SHOP NOTE

HOLES: 1 1/8" (UNLESS NOTED)  
 BOLTS: AS NOTED  
 PAINT: NONE  
 FOR GENERAL NOTES - SEE DWG. N1  
 FOR CAMBER DIAGRAM - SEE DWG. WCI

**R95-207** CODE: 4000

NO.	1	REVISION	const. joint moved	DATE	11-19-84
<p><b>HIGH STEEL STRUCTURES, INC.</b></p> <p>1905 Old Philadelphia Pike              LANCASTER, PENNSYLVANIA 17603              Phone 717/299-0211</p> <p>A Subsidiary of High Industries, Inc.</p>					
<p><b>GIRDER - G40</b></p> <p><b>I-395 BRIDGE OVER PENOBSCOT RIVER</b></p> <p><b>1-395 BRIDGE STA. 164 + 60.00</b></p> <p><b>PENOBSCOT COUNTY</b></p> <p><b>STATE OF MAINE</b></p> <p><b>DEPARTMENT OF TRANSPORTATION</b></p>					
STATE CONTRACT OR REF. NO.	6	CONTRACTOR	CIANBRO CORP.		
IN CHARGE:	HINKLE	MADE BY:	CS	CHK'D BY:	JLC
DATE:	9-27-84				
CONTRACT NUMBER:	ME-84088-3	DRAWING NUMBER:	30	OF 47	

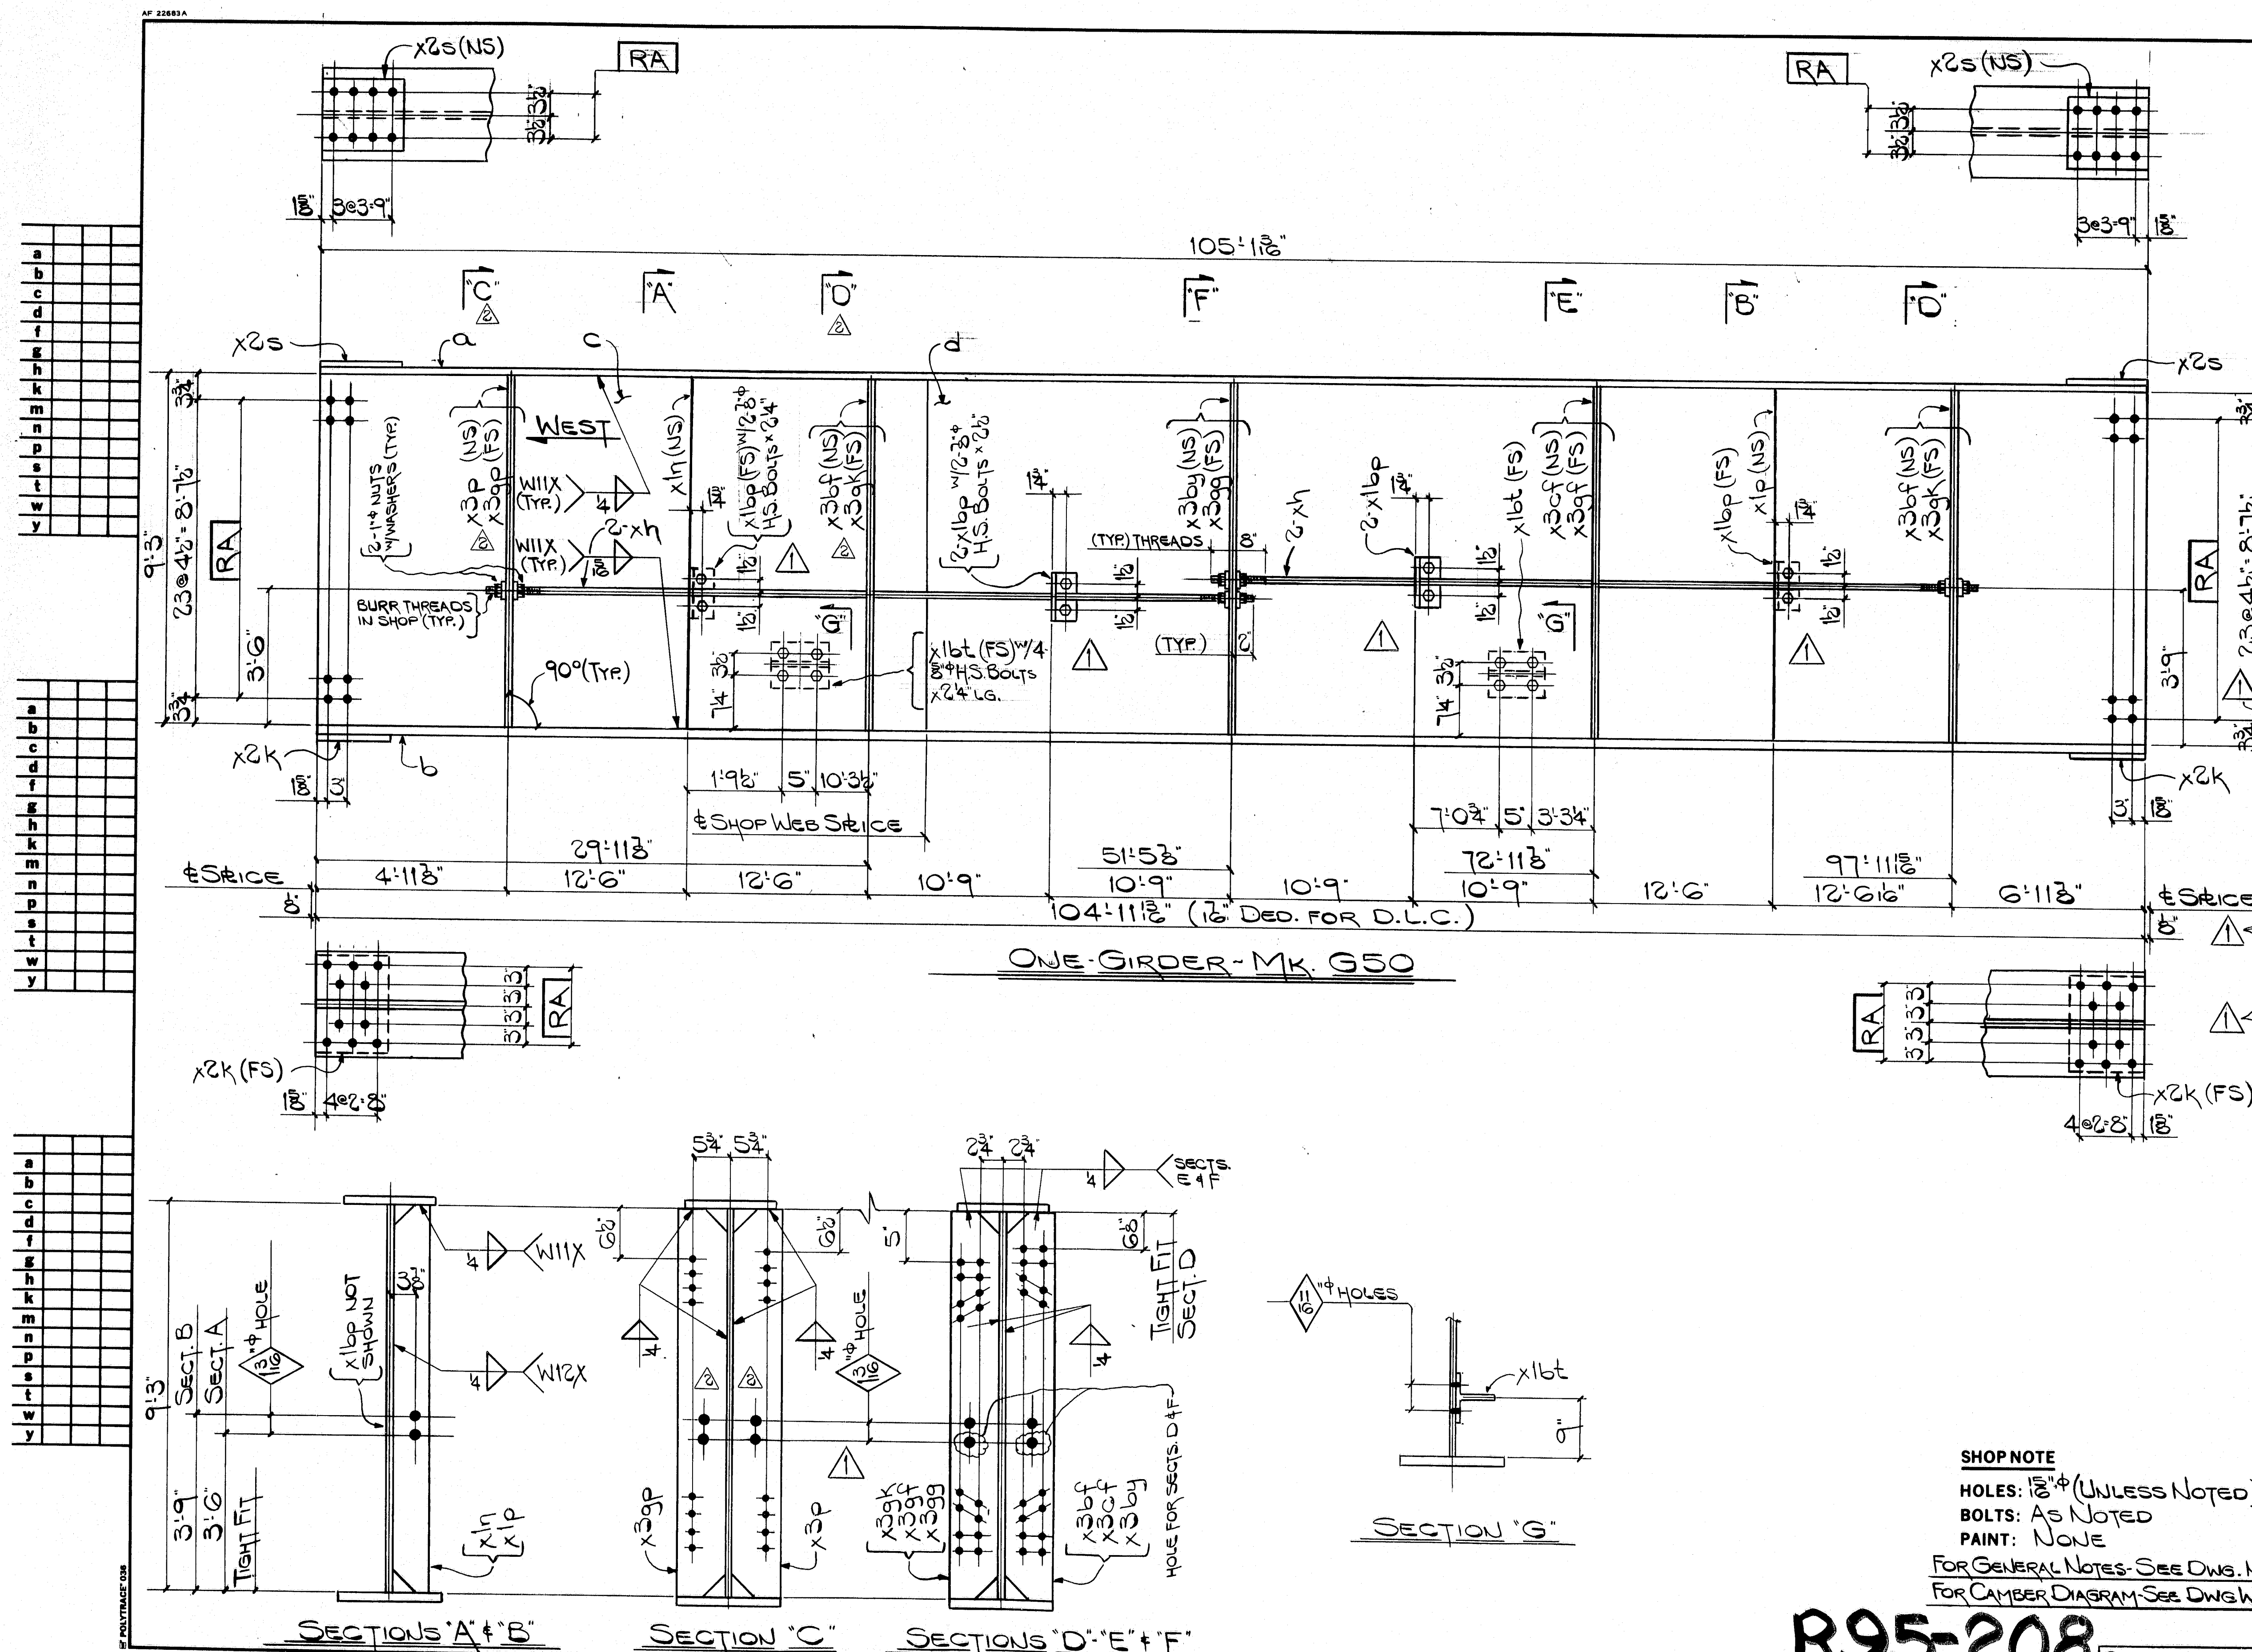

FED. ROAD DIV. NO.		STATE	FED. AID PROJ. NO.
1		ME	HG 358(82)176


BILL OF MATERIAL						
NO.	MARK	DESCRIPTION	LENGTH	REMARKS	ITEM	TOTAL WEIGHT
ONE		GIRDER - MK. G50				3337
ONE	a	R. 14 x 24	105 1/2			
ONE	b	R. 16 x 1	104 11/16			
ONE	c	R. 111 x 16	35 6/16			
ONE	d	R. 111 x 16	69 6/16			
2	x2k	FILL R. 15 x 4	0 11/8			
2	x2s	FILL R. 11 x 2	1 0/8			
ONE	x1n	BAR 5 x 2	9 3			75.67
ONE	x1p	BAR 5 x 2	9 3			75.67
6	x1bp	5 x 3 x 4	0 6	△		14.00
2	x3bf	BAR 7 x 2	9 3			112.50
2	x3gk			△		112.50
ONE	x3p					75.67
ONE	x3gp			△		112.50
ONE	x3bg					112.50
ONE	x3gg			△		112.50
ONE	x3gf					112.50
ONE	x3gf	BAR 7 x 2	9 3	△		112.50

## SHOP NOTE

BOLTS: AS NOTED  
PAINT: NONE


FOR GENERAL NOTES-SEE DWG. N1  
FOR CAMBER DIAGRAM-SEE DWG. WC

**R95-208** **CODE:4000**

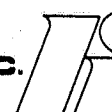	②	Const. joint moved. control # 15	11-19-84
NO.	①	REVISION contract revision control # 14	DATE 9-20-84
HIGH STEEL STRUCTURES, INC.			1905 Old Philadelphia Pk. Lancaster, Pennsylvania 17603 Phone 717/298-5211
		A Subsidiary of High Industries, Inc.	
GIRDER # G50			
I-395 BRIDGE OVER PENOBSCOT RIVER			
I-395 BRIDGE STA. 164 + 20.00			
PENOBSCOT COUNTRY			
STATE OF MAINE			
DEPARTMENT OF TRANSPORTATION			
STATE CONTRACT OR REF. NO.		CONTRACTOR	CIANBRO CORP.
G			
CHARGE:	HINKLE	MADE BY:	CSK CHD: JLC DATE: 9-27-84
INVOICE:			
ME-84028-3 DRAWING		31 OF 47	



AP 22883A

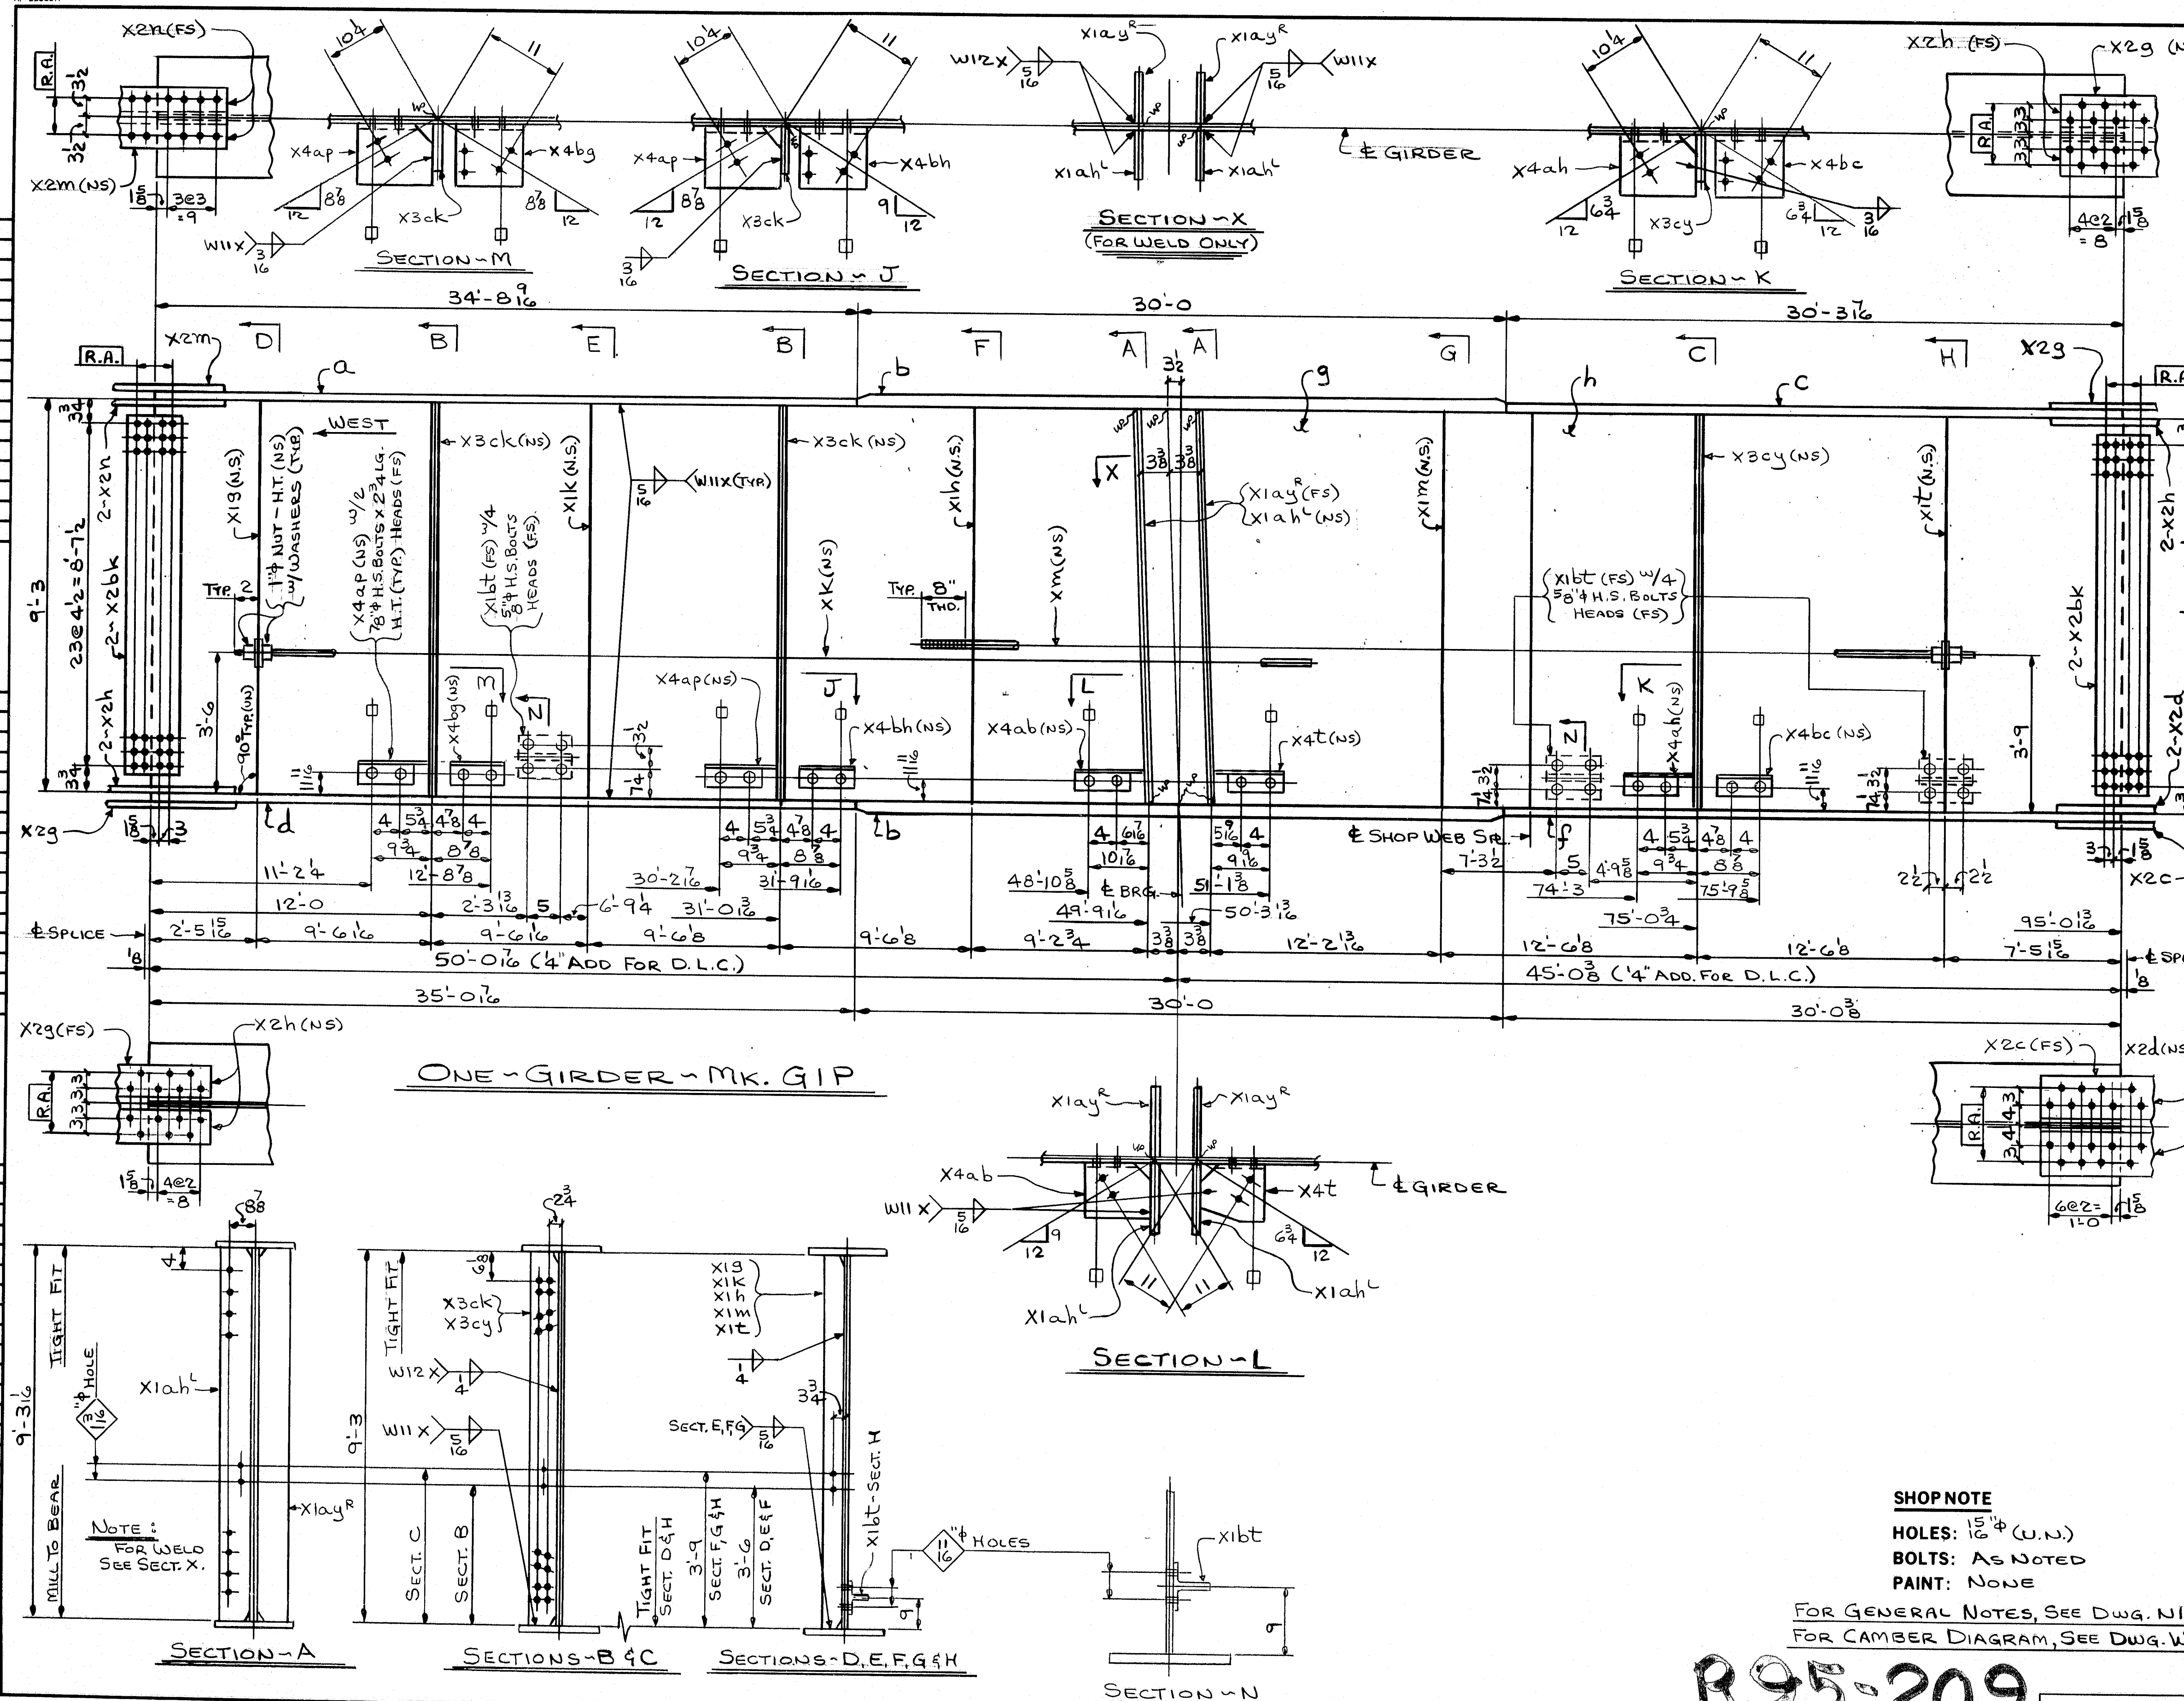

FED. ROAD DIST. NO.	STATE	FED. AID PROJ. NO.
1	ME	116-395-8(20)04

BILL OF MATERIAL					
NO.	MARK	DESCRIPTION	LENGTH	REMARKS	TOTAL WEIGHT
ONE	GIP	GIRDER			52900
ONE	a	PL 24 x 14	34 8 1/2		
2	b	PL 24 x 24	30 0		
ONE	c	PL 24 x 14	30 3 1/2		
	d	PL 24 x 14	35 0 1/2		
	f	PL 24 x 14	30 0 3/8		
	g	PL 111 x 16	66 1		
	h	PL 111 x 16	28 11 1/2		
	X19	BAR 5 x 1/2	9 3		
	X1h				
	X1k				
	X1m				
	X1t	BAR 5 x 1/2	9 3		
	XK	1" ROD	57 0 4	THD. BOTH ENDS	5 12
ONE	Xm	1" ROD	50 2 3/4	THD. BOTH ENDS	5 11
4		WASH. FOR 1" ROD			
4		1" STR. HEX. NUTS			
2	X23	PL 15 x 1/2	1 10 1/2		
4	X2h	BAR 6 x 3/4	1 10 1/2		
ONE	X2m	PL 11 x 1/2	2 0 1/2		
2	X2n	BAR 4 x 3/4	2 0 1/2		
4	X2b	PL 10 1/2 x 1/2	1 0 1/2		
ONE	X2c	PL 19 x 1/2	2 6 1/2		
2	X2d	BAR 8 x 7/8	2 6 1/2		
2	X3ck	BAR 7 x 1/2	9 3		
ONE	X3cy	BAR 7 x 1/2	9 3		
3	X1bt	WT 6 x 13	0 8		
16		WASH. FOR 8" H.S. BOLTS			
16		8" H.S. BOLTS	0 2 3/4		
12		8" H.S. BOLTS	0 2 4		
12		WASH. FOR 5" H.S. BOLTS			
2	X1ah	PL 10 x 1"	9 3 1/2		
2	X1ay	PL 10 x 1"	9 3 1/2		
ONE	X4t	PL MC 18 x 4.5.8	0 11 1/2		
	X4ab		0 11 1/2		
	X4ah		0 11 1/2		
	X4bc		0 10		
	X4bh		0 10		
ONE	X4bg		0 10		
2	X4ap	PL MC 18 x 4.5.8	0 11 1/2		


**SHOP NOTE**  
 BOLTS: AS NOTED  
 PAINT: NONE  
 FOR GENERAL NOTES, SEE DWG. N1.  
 FOR CAMBER DIAGRAM, SEE DWG. WC2

NO.	REVISION	DATE
HIGH STEEL STRUCTURES, INC.		
1395 BRIDGE OVER PENOBSCOT RIVER		
1-395 BRIDGE STA. 164 + 60.00		
PENOBSCOT COUNTY		
STATE OF MAINE		
DEPARTMENT OF TRANSPORTATION		
STATE CONTRACT OR REF. NO.	CONTRACTOR	DATE
6	GAMBRO CORP.	
IN CHARGE:	MADE BY:	CHKD. BY:
HINKLE	G.F.Z.	J.L.C.
CONTRACT NUMBER:	DRAWING NUMBER:	DATE:
ME-84088-3	32 OF 47	10-1-84

**R95-209** CODE: 4000



AP 22082A

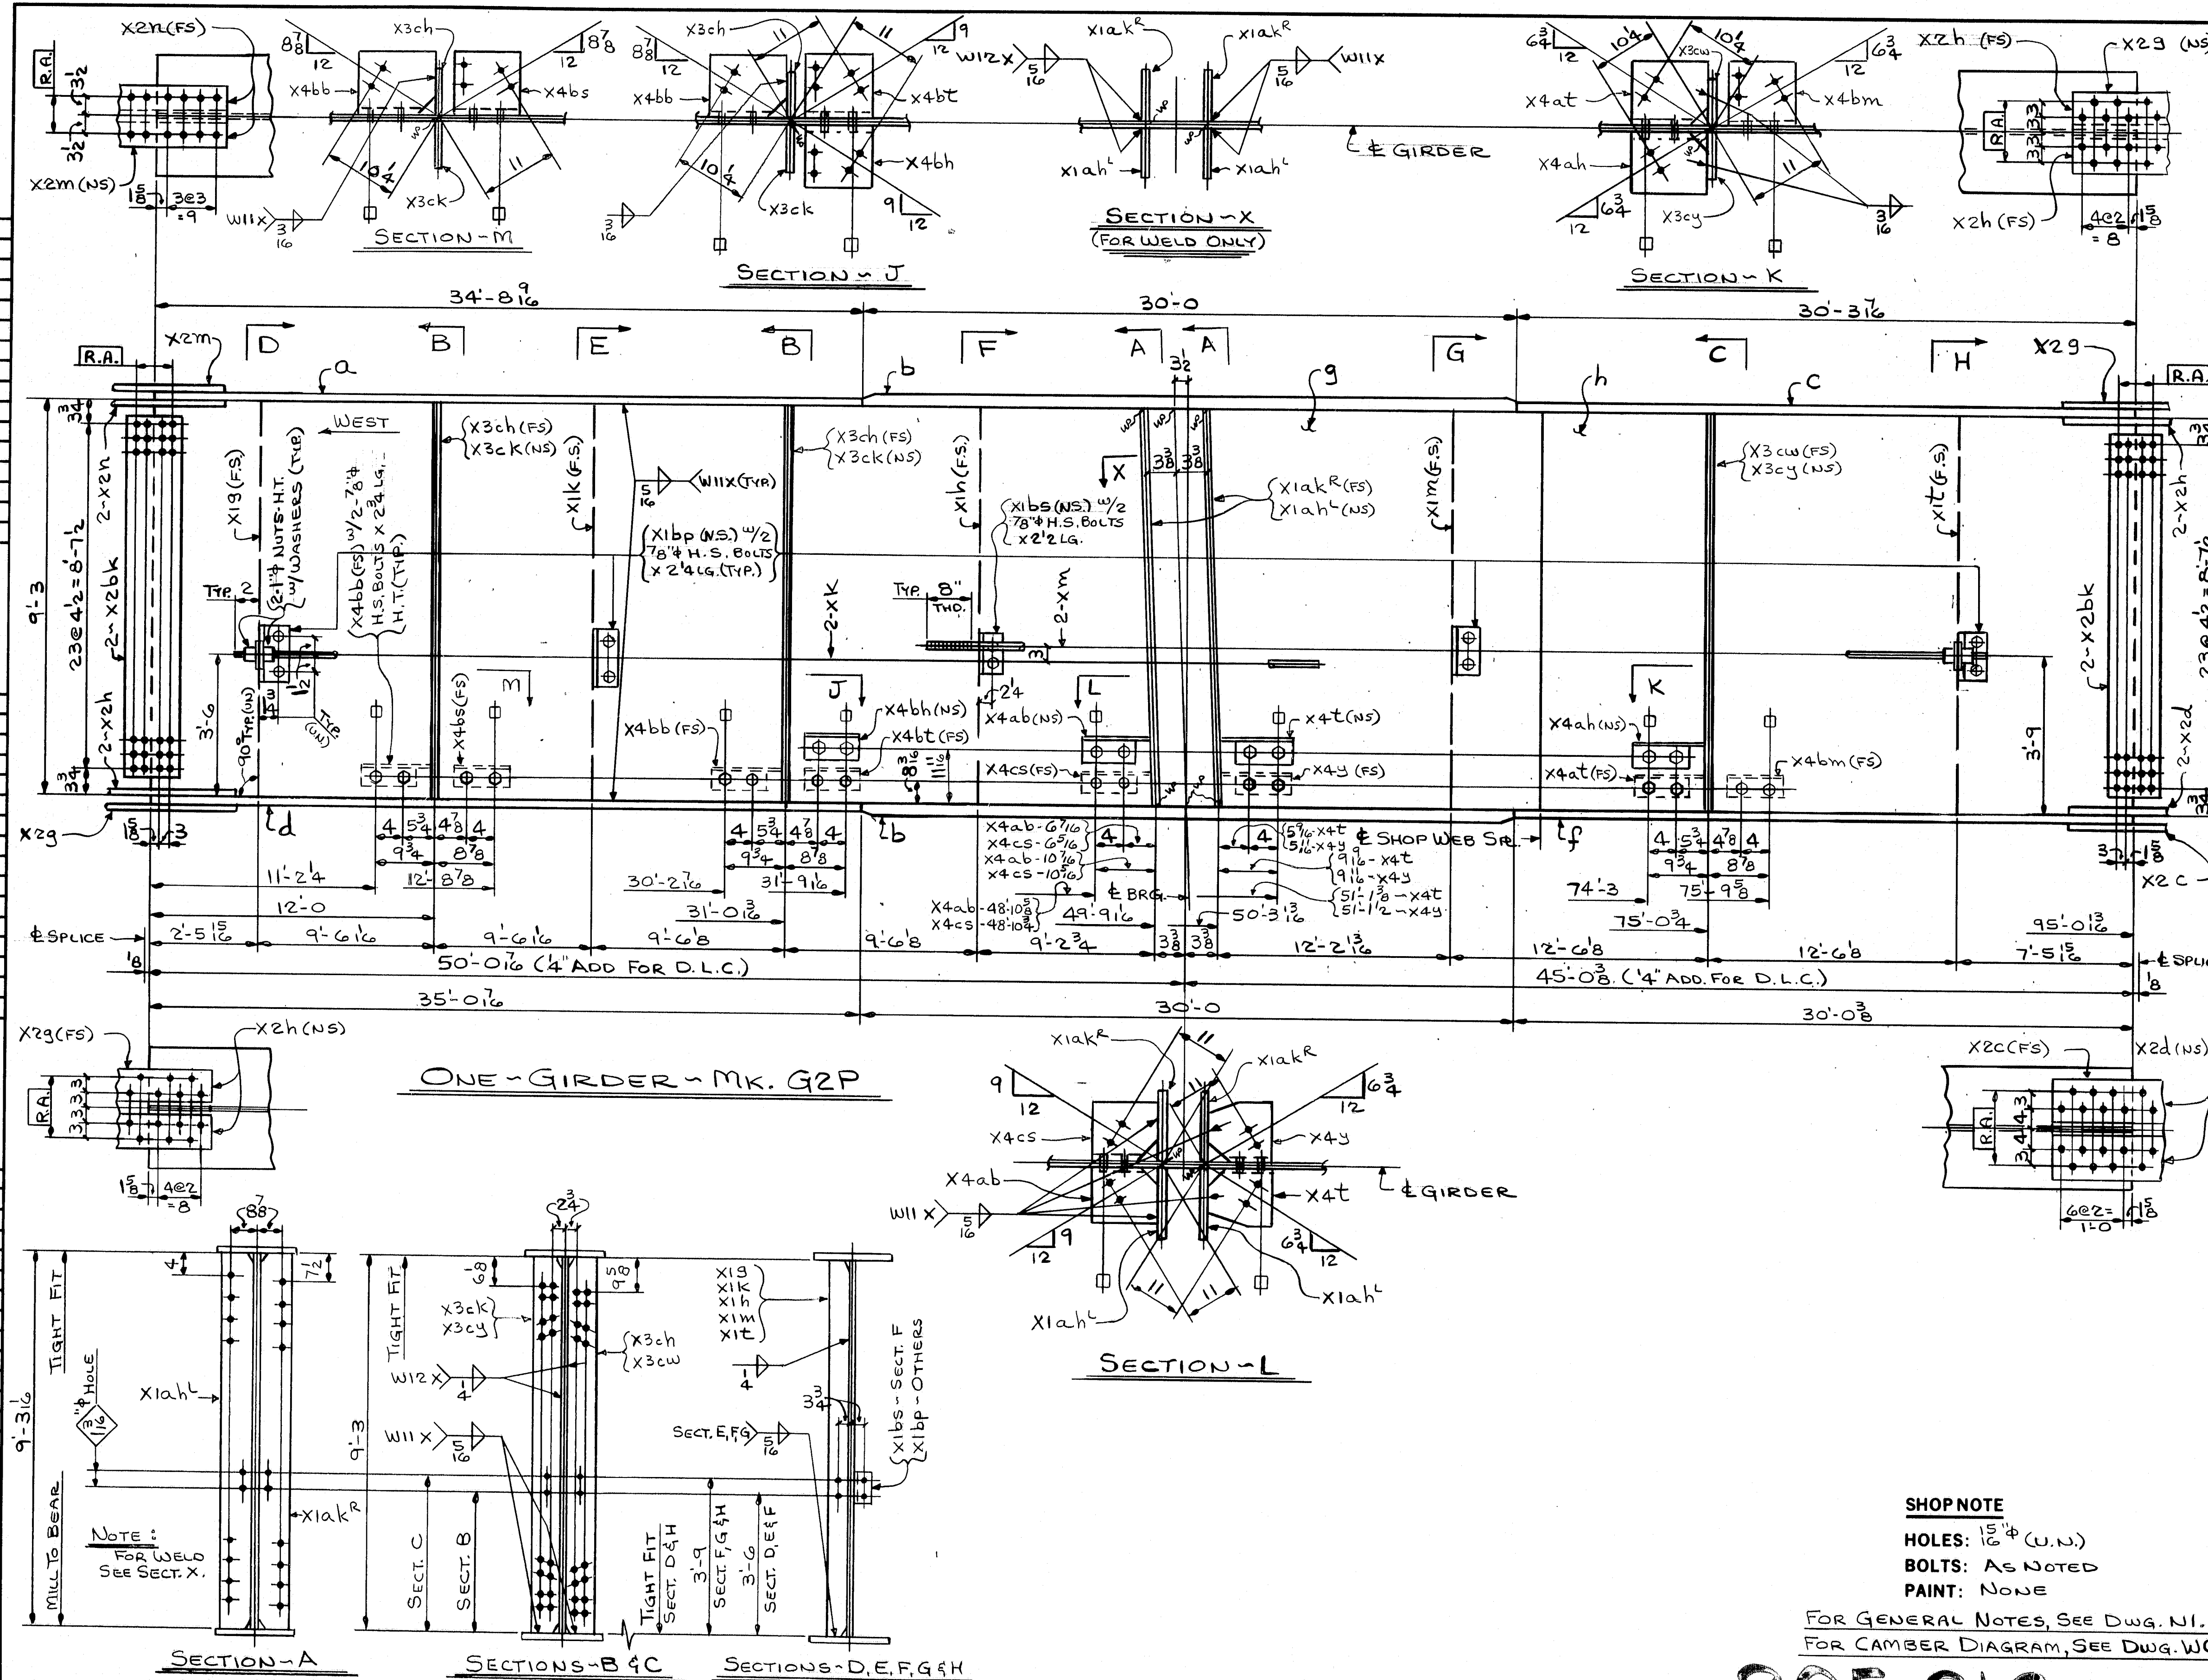

FED. ROAD DIST. NO.		STATE		FED. AID PROJ. NO.	
1		ME		116-395-8(8)104	

BILL OF MATERIAL						
NO.	MARK	DESCRIPTION	LENGTH	REMARKS	ITEM	TOTAL WEIGHT
ONE	G2P	GIRDER				53,495
ONE	X3cy	BAR 7x12	9 3			
ONE	a	R. 24x14	34 8 1/2			
2	b	R. 24x24	30 0			
ONE	c	R. 24x14	30 3 1/2			
	d	R. 24x14	35 0 1/2			
	f	R. 24x14	30 0 3/8			
	g	R. 111x1 1/2	28 1			
	h	R. 111x1 1/2	28 1 1/2			
	X19	BAR 5x1/2	9 3			
	X1h					
	X1k					
	X1m					
ONE	X1t	BAR 5x1/2	9 3			
2	XK	1" ROD	57 0 4	THD. BOTH ENDS	5 1/2	
2	Xm	1" ROD	50 2 3/4	THD. BOTH ENDS	5 1/2	
		WASH. FOR 1" ROD			8 1/2	
		1" STD. HEX. NUTS			8 1/4	
2	X29	R. 15x1 1/2	1 10 1/2			
4	X2h	BAR 6x3/4	1 10 1/2			
ONE	X2m	R. 11x1/2	2 0 1/2			
2	X2N	BAR 4x3/4	2 0 1/2			
4	X2bk	R. 106x2x1/2	1 0 1/2			
ONE	X2C	R. 19x1 1/2	2 6 1/2			
2	X2d	BAR 8x7/8	2 6 1/2			
2	X1ak	R. 10x1	9 3 1/2			
2	X1ah	R. 10x1	9 3 1/2			
ONE	X3cw	BAR 7x12	9 3			
34		WASH. FOR 7/8" H.S. BOLTS			8 1/2	
24		7/8" H.S. BOLTS	0 2 3/4		8 1/2	
2		7/8" H.S. BOLTS	0 2 1/2		8 1/4	
8		7/8" H.S. BOLTS	0 2 1/4		8 1/4	
2	X3ch	BAR 7x1/2	9 3			
2	X3ck	BAR 7x1/2	9 3			
4	X1bp	5x3x4	0 6			
ONE	X1bs	5x3x2x1/2	0 6			
2	X4bb	R. MC18x45.8	0 11 1/2			
ONE	X4bh		0 10			
	X4bm		0 10			
	X4bs		0 10			
	X4bt		0 10			
	X4cs		0 11 1/2			
	X4ab		0 11 1/2			
	X4ah		0 11 1/2			
	X4at		0 11 1/2			
	X4t		0 11 1/2			
ONE	X43	R. MC18x45.8	0 11 1/2			

NO.	REVISION	DATE


**SHOP NOTE**  
 HOLES: 15/16" (U.N.)  
 BOLTS: AS NOTED  
 PAINT: NONE  
 FOR GENERAL NOTES, SEE DWG. N1.  
 FOR CAMBER DIAGRAM, SEE DWG. WC2

**R95-210** CODE: 4000





AP 22683A

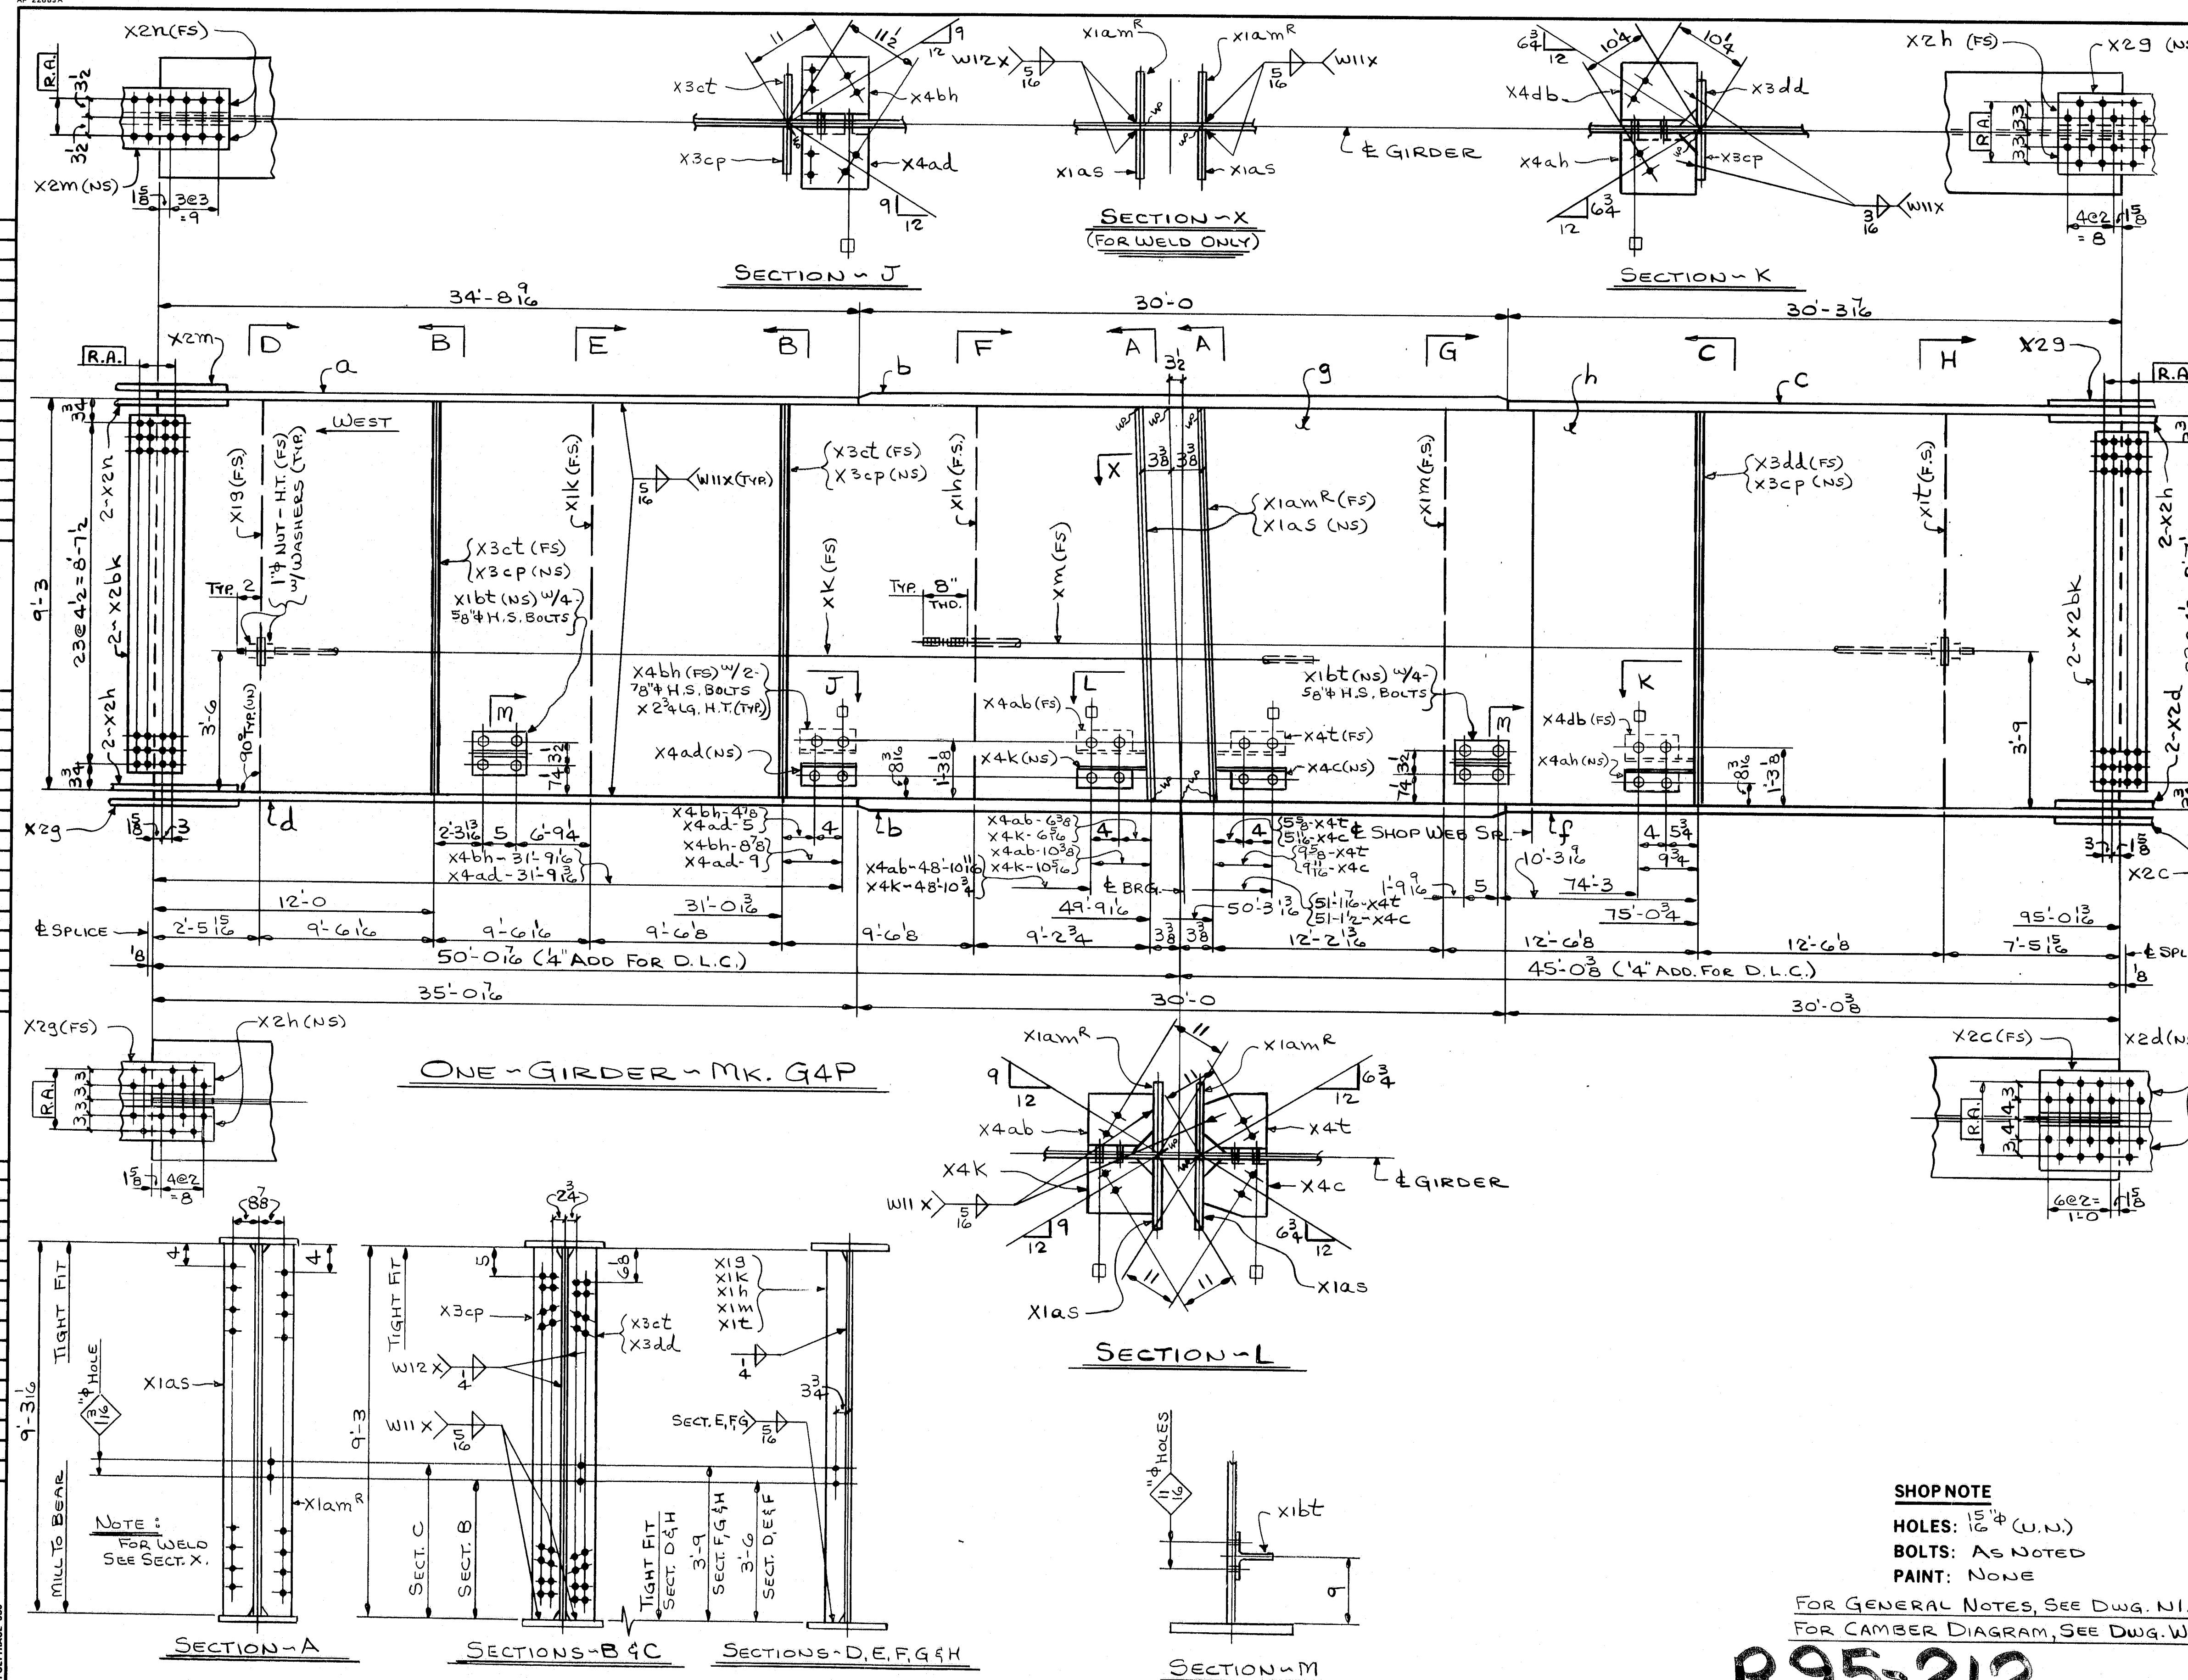

FED. ROAD DIV. NO.	STATE	FED. AID PROJ. NO.
1	ME	119-395-8(22)104

BILL OF MATERIAL					
NO.	MARK	DESCRIPTION	LENGTH	REMARKS	TOTAL WEIGHT
ONE	G4P	GIRDER			53220
ONE	a	R. 24 x 14	34	8 1/2	
2	b	R. 24 x 24	30	0	
ONE	c	R. 24 x 14	30	3 1/2	
	d	R. 24 x 14	35	0 1/2	
	f	R. 24 x 14	30	0 3/8	
	g	R. 111 x 16	66	1	
	h	R. 111 x 16	28	1 1/2	
	X19	BAR 5 x 1/2	9	3	
	X1h				
	X1k				
	X1m				
	X1t	BAR 5 x 1/2	9	3	
	XK	1" ROD	57	0 4	THD. BOTH ENDS 5 1/2
ONE	Xm	1" ROD	50	2 4	THD. BOTH ENDS 5 1/2
4		WASH. FOR 1" ROD			5 1/2
4		1" STD. HEX. NUTS			5 1/2
2	X29	R. 15 x 16	1	10 1/2	
4	X2h	BAR 6 x 3/4	1	10 1/2	
ONE	X2m	R. 11 x 12	2	0 2	
2	X2n	BAR 4 x 3/4	2	0 2	
4	X2bk	R. 10 1/2 x 1/2	1	0 2	
ONE	X2c	R. 19 x 16	2	6 2	
2	X2d	BAR 8 x 7/8	2	6 2	
2	X1am	R. 10 x 1	9	3 1/2	
2	X1as	R. 10 x 1	9	3 1/2	
8		WASH. FOR 5/8" H.S. BOLTS			8 1/10
16		WASH. FOR 3/4" H.S. BOLTS			8 1/11
16		3/4" H.S. BOLTS	0	2 4	8 1/11
8		3/4" H.S. BOLTS	0	2 4	8 1/11
2	X1bt	WT 6 x 13	0	8	
3	X3cp	BAR 7 x 1/2	9	3	
2	X3ct	BAR 7 x 1/2	9	3	
ONE	X3dd	BAR 7 x 1/2	9	3	
	X4c	R. MC18 x 45.8	0	11 1/2	
	X4k		0	11 1/2	
	X4t		0	11 1/2	
	X4ab		0	11 1/2	
	X4ad		0	9 1/2	
ONE	X4bh		0	10	
ONE	X4ab	R. MC18 x 45.8	0	11 1/2	
ONE	X4db	R. MC18 x 45.8	0	11 1/2	

SHOP NOTE  
HOLES: 1/8" (U.N.)  
BOLTS: AS NOTED  
PAINT: NONE

FOR GENERAL NOTES, SEE DWG. N1.  
FOR CAMBER DIAGRAM, SEE DWG. WC2

R95-212 CODE: 4000

NO.	REVISION	DATE

HIGH STEEL STRUCTURES, INC.  
 1905 Old Philadelphia Pike  
 Laytonville, Pennsylvania 17603  
 Phone 717/296-5211  
 A Subsidiary of High Industries, Inc.


GIRDER G4P  
 I-395 BRIDGE OVER PENOBSCOT RIVER  
 I-395 BRIDGE STA. 164+60.00  
 PENOBSCOT COUNTY  
 STATE OF MAINE  
 DEPARTMENT OF TRANSPORTATION

STATE CONTRACT OR REF. NO. 6 CONTRACTOR CANBRO CORP.

IN CHARGE: HINKLE MADE BY: G.F.Z. CHK'D BY: J.L.C. DATE: 10-1-84  
 CONTRACT NUMBER: ME-84088-3 DRAWING NUMBER: 35 OF 47



AP 22683A

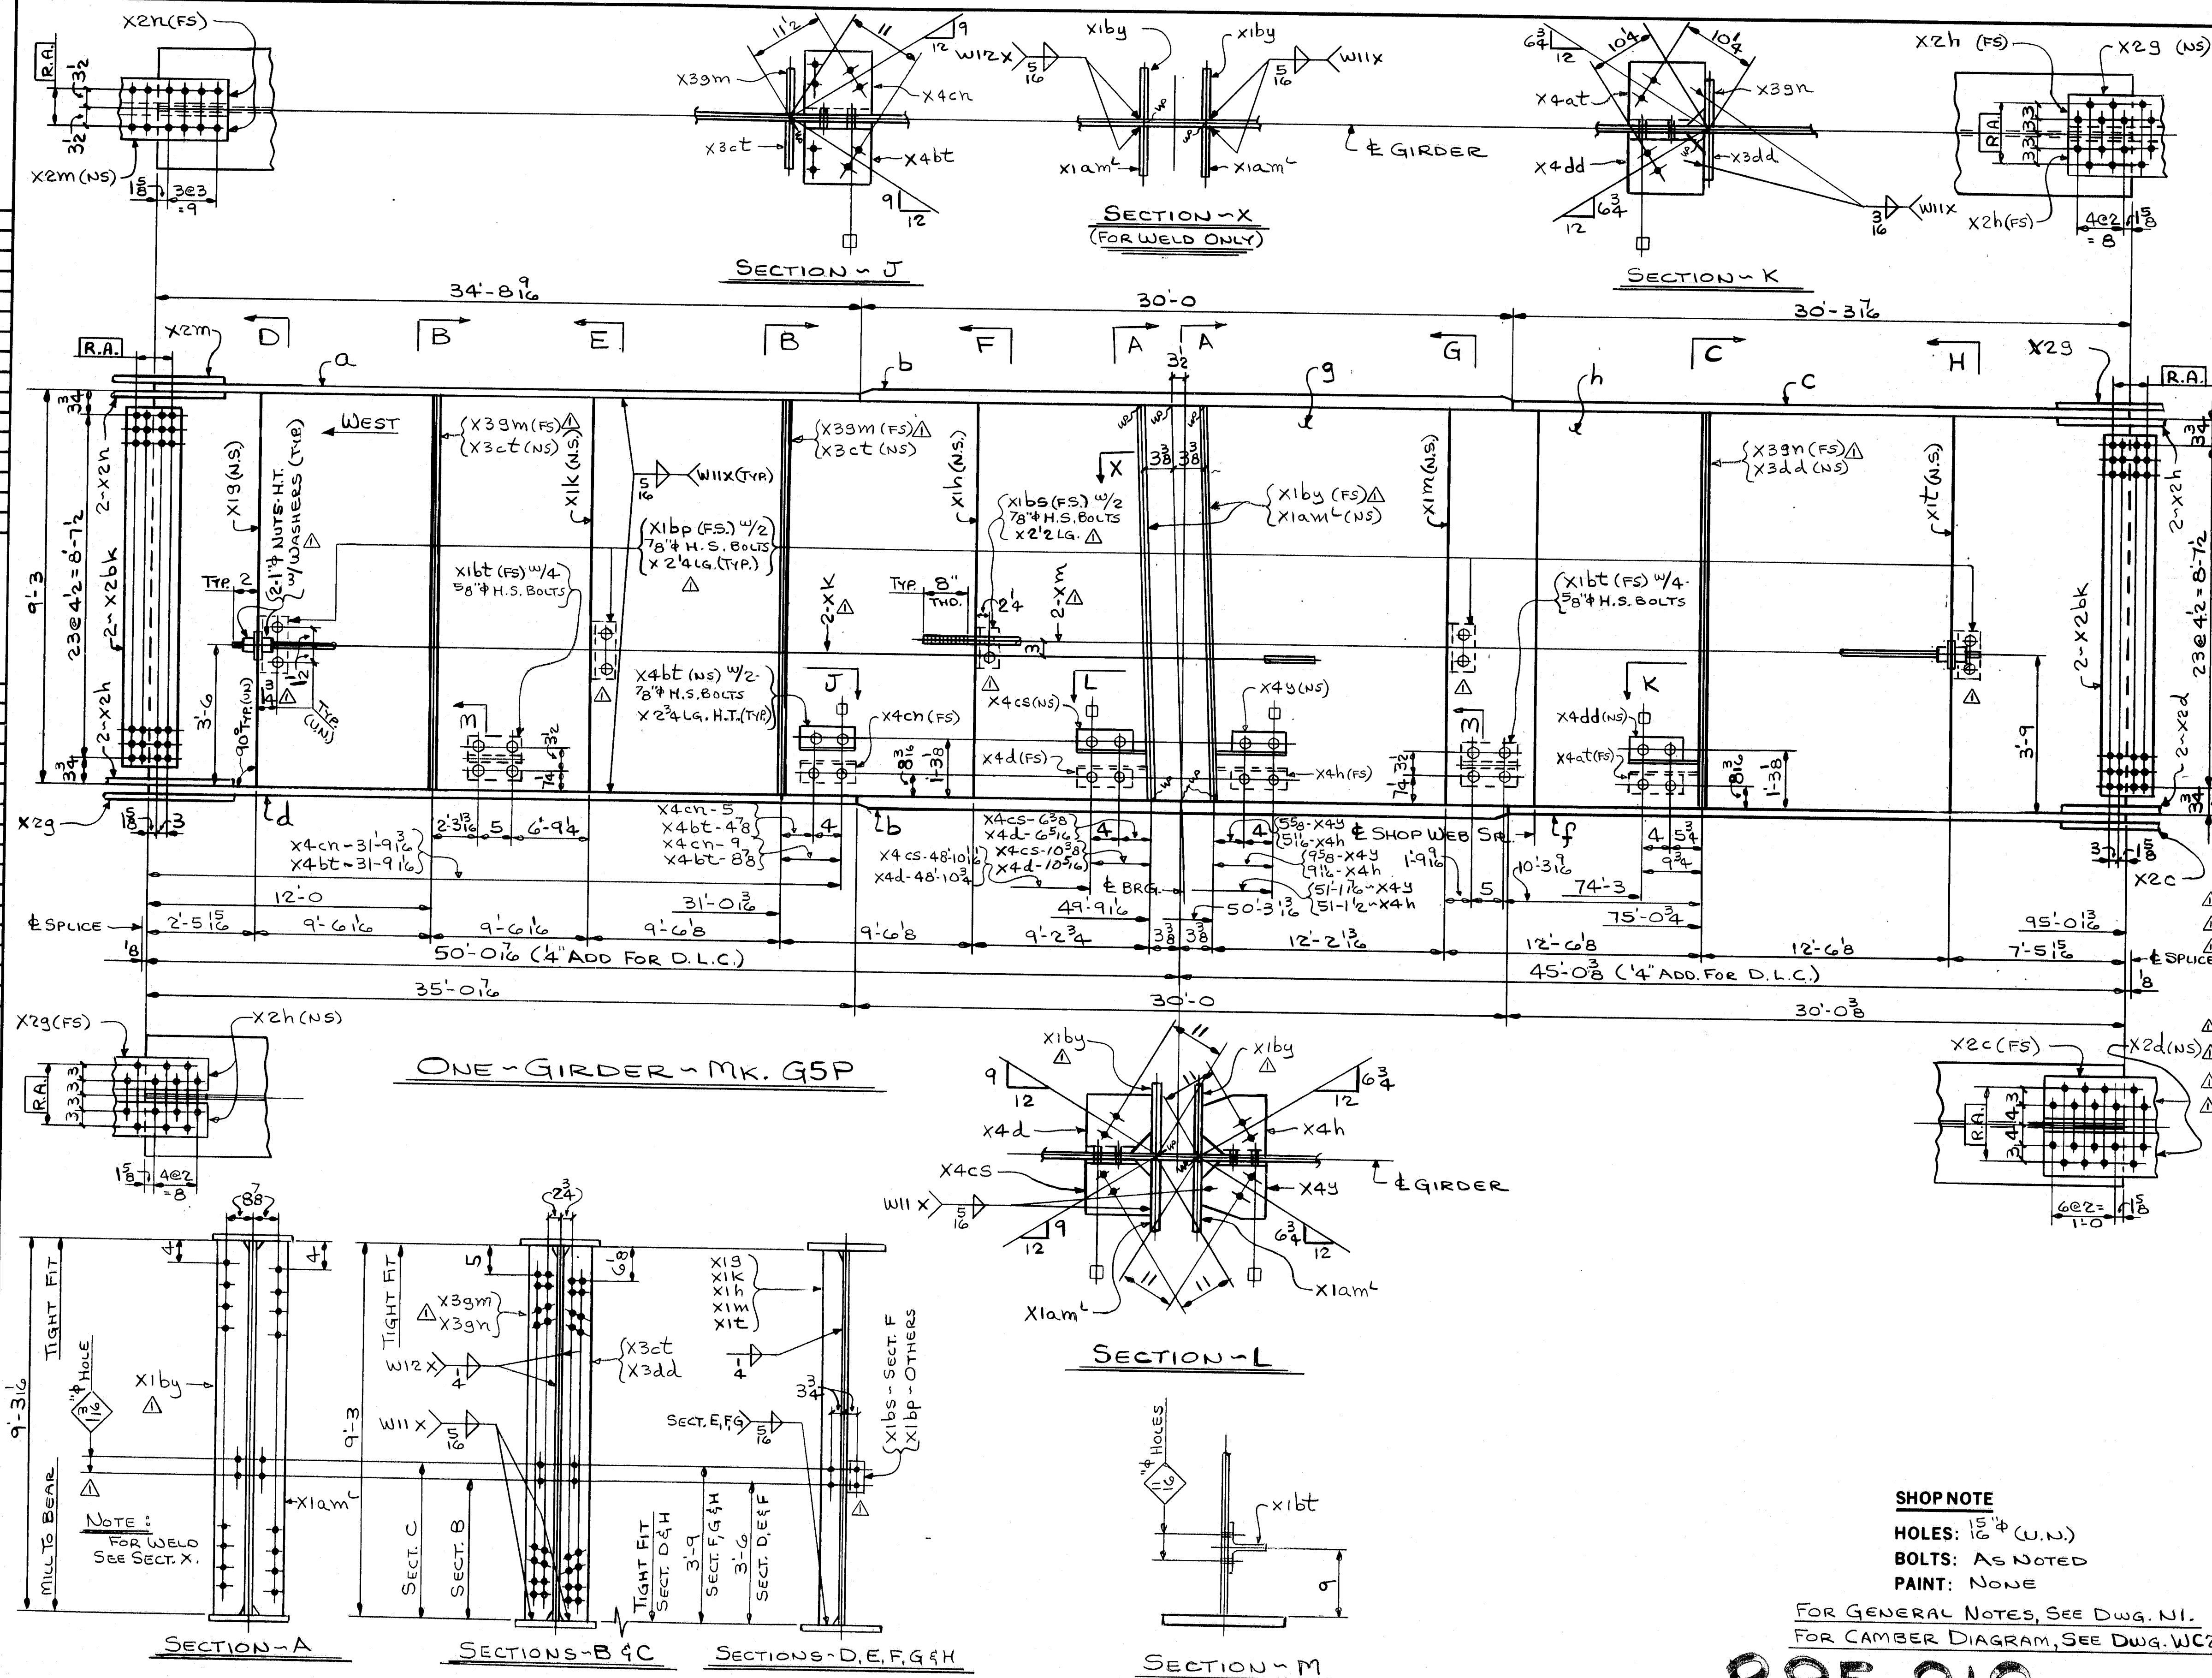


FED. ROAD DIV. NO.		STATE	FED. AID PROJ. NO.
1		ME	116-395-8(28)104

BILL OF MATERIAL						
NO.	MARK	DESCRIPTION	LENGTH	REMARKS	ITEM	TOTAL WEIGHT
ONE	G5P	GIRDER				53,540
ONE	X4dd	PL MC18x45.8	0	11 1/2		
ONE	a	R. 24x14	34	8 1/2		
2	b	R. 24x24	30	0		
ONE	c	R. 24x14	30	3 1/2		
↑	d	R. 24x14	35	0 1/2		
	f	R. 24x14	30	0 3/8		
	g	R. 111x1 1/2	66	1		
	h	R. 111x1 1/2	28	11 1/2		
	X19	BAR 5x1/2	9	3		
	X1h			↑		
	X1k			↑		
	X1m			↑		
ONE	X1t	BAR 5x1/2	9	3		
Δ	2	XK	1" ROD	57	0 4 THD. BOTH ENDS	5 1/2
	2	Xm	1" ROD	50	2 3/4 THD. BOTH ENDS	5 1/2
	8					8 1/2
Δ	8		1" STD. HEX. NUTS			8 1/2
	2	X23	R. 15x1 1/2	1	10 1/2	
	4	X2h	BAR 6x3/4	1	10 1/2	
ONE	X2m	R. 11x1/2	2	0 2		
	2	X2n	BAR 4x3/4	2	0 2	
	4	X2bk	R. 10 1/2x1/2	1	0 2	
ONE	X2c	R. 19x1 1/2	2	6 2		
	2	X2d	BAR 8x7/8	2	6 2	
	2	X1b3	R. 10x1"	9	3 1/2	
	2	X1qm	R. 10x1"	9	3 1/2	
	8		WASH. FOR 5/8" H.S. BOLTS			8 1/2
	26		WASH. FOR 5/8" H.S. BOLTS			8 1/2
Δ	16		5/8" H.S. BOLTS	0	2 3/4	8 1/2
Δ	2		5/8" H.S. BOLTS	0	2 2	8 1/2
	8		5/8" H.S. BOLTS	0	2 4	8 1/2
	8		5/8" H.S. BOLTS	0	2 4	8 1/2
	2	X1bt	WT 6x13	0	8	17 3/4
	4	X1bp	5x3x1/4	0	6	
ONE	X1bs	5x3x1/2	0	6		
Δ	2	X3gm	BAR 7x1/2	9	3	22 1/2
ONE	X3gn			↑		
	2	X3ct		↑		
ONE	X3dd	BAR 7x1/2	9	3		
↑	X4d	PL MC18x45.8	0	11 1/2		
	X4h		0	11 1/2		
	X4y		0	11 1/2		
	X4bt		0	10		
↑	X4cn		0	9 1/2		
	ONE X4cs		0	11 1/2		
ONE	X4at	PL MC18x45.8	0	11 1/2		

NO.	Δ	REVISION	CONTRACT REVISION	DATE
			CONTROL 114	9/28/84

HIGH STEEL STRUCTURES, INC.

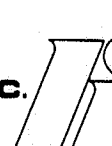

A Subsidiary of High Industries, Inc.

GIRDER		G5P
I-395 BRIDGE OVER PENOBSCOT RIVER		
I-395 BRIDGE STA. 164+60.00		
PENOBSCOT COUNTY		
STATE OF MAINE		
DEPARTMENT OF TRANSPORTATION		

STATE CONTRACT OR REF. NO.	G	CONTRACTOR	CIAMRO CORP.
-------------------------------	---	------------	--------------

IN CHARGE:	HINKLE	MADE BY:	G.F.Z.	CHK'D BY:	J.L.C.	DATE:	10-1-84
---------------	--------	-------------	--------	--------------	--------	-------	---------

CONTRACT NUMBER:	ME-84088-3	DRAWING NUMBER:	36 OF 47
---------------------	------------	--------------------	----------

**SHOP NOTE**

HOLES: 15/16" (U.N.)  
 BOLTS: AS NOTED  
 PAINT: NONE


FOR GENERAL NOTES, SEE DWG. N1.  
 FOR CAMBER DIAGRAM, SEE DWG. WCZ

**R95-213**

CODE: 4000



AF 22893A

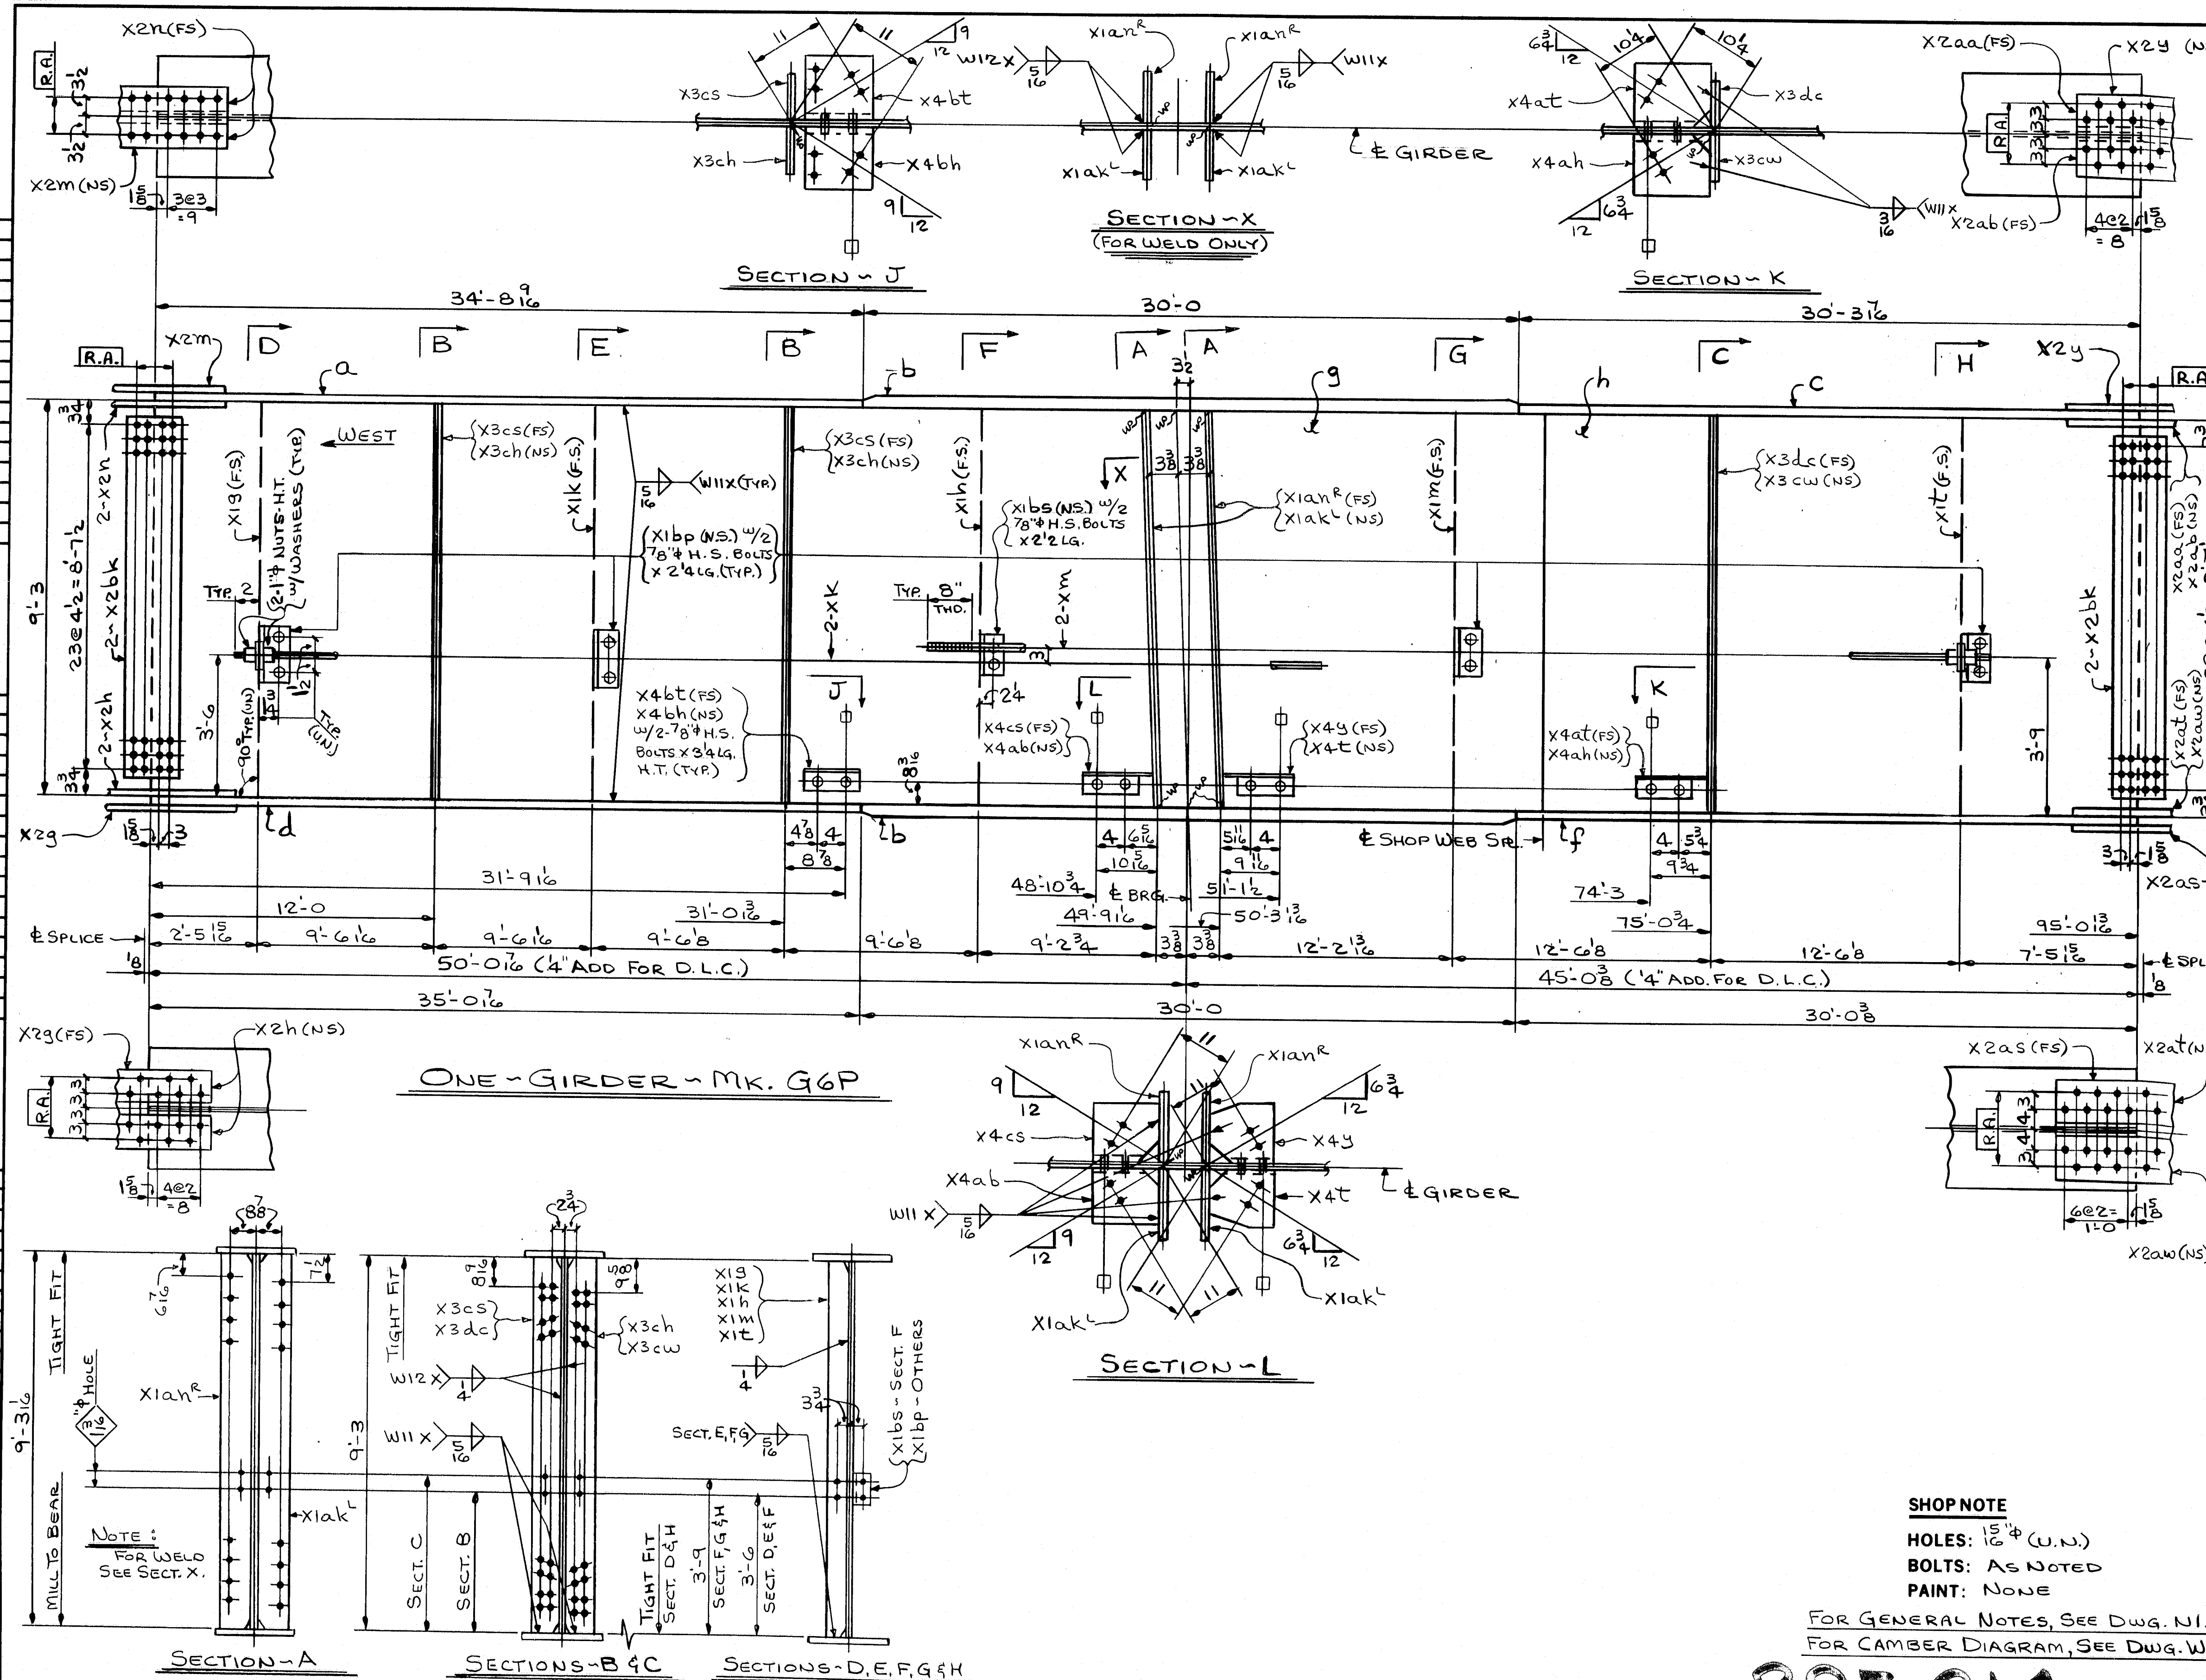

BILL OF MATERIAL		NO.	MARK	DESCRIPTION	LENGTH	REMARKS	ITEM	TOTAL WEIGHT
ONE	G6P			GIRDER				53.525
ONE	A			R. 24 x 14	34 8 1/16			
2	B			R. 24 x 24	30 0			
ONE	C			R. 24 x 14	30 3 1/16			
	D			R. 24 x 14	35 0 1/16			
	F			R. 24 x 14	30 0 1/16			
	G			R. 111 x 16	66 1			
	H			R. 111 x 16	28 11 1/2			
	X19			BAR 5 x 1/2	9 3			
	X1h							
	X1k							
	X1m							
ONE	X1t			BAR 5 x 1/2	9 3			
2	XK			1" ROD	57 0 4	THD. BOTH ENDS	5 12	
2	XM			1" ROD	50 2 3/4	THD. BOTH ENDS	5 11	
				WASH. FOR 1" ROD			8 1/2	
				1" STD. HEX. NUTS			8 1/2	
ONE	X23			R. 15 x 16	1 10 1/2			
2	X2h			BAR 6 x 3/4	1 10 1/2			
ONE	X2m			R. 11 x 12	2 0 1/2			
2	X2n			BAR 4 x 3/4	2 0 1/2			
4	X2bk			R. 10 6/8 x 1/2	1 0 1/2			
ONE	X2aa			BAR 6 1/2 x 3/4	1 10 1/2			
	X2ab			BAR 6 1/2 x 3/4	1 10 1/2			
	X2as			R. 19 1/4 x 1/6	2 6 1/2			
	X2at			R. 8 1/4 x 7/8	2 6 1/2			
ONE	X2aw			R. 8 1/4 x 7/8	2 6 1/2			
18				WASH. FOR 8" H.S. BOLTS			8 1/2	
8				8" H.S. BOLTS	0 3 1/4		8 1/2	
2				8" H.S. BOLTS	0 2 1/2		8 1/2	
8				8" H.S. BOLTS	0 2 1/4		8 1/2	
ONE	X2y			R. 15 1/2 x 16	1 10 1/2			
2	X1an			R. 10 x 11	9 3 1/16			
2	X1ak			R. 10 x 11	9 3 1/16			
4	X1bp			5 x 3 1/2 x 1/2	0 6			
ONE	X1bs			5 x 3 1/2 x 1/2	0 6			
2	X3cs			BAR 7 x 1/2	9 3			
2	X3ch							
ONE	X3cw							
	X3dc			BAR 7 x 1/2	9 3			
	X4t			R. MC 18 x 45.8	0 11 1/2			
	X4y				0 11 1/2			
	X4ab				0 11 1/2			
	X4ah				0 11 1/2			
	X4at				0 11 1/2			
	X4bh				0 10			
	X4bt				0 10			
ONE	X4cs			R. MC 18 x 45.8	0 11 1/2			

**SHOP NOTE**  
 HOLES: 1 5/8" (U.N.)  
 BOLTS: AS NOTED  
 PAINT: NONE  
 FOR GENERAL NOTES, SEE DWG. N1.  
 FOR CAMBER DIAGRAM, SEE DWG. WC2

**R95-214** Code: 4000

**HIGH STEEL STRUCTURES, INC.**  
 1905 Old Philadelphia Pike  
 Lancaster, Pennsylvania 17603  
 Phone 717/299-5211  
 A Subsidiary of High Industries, Inc.

**GIRDER G6P**  
 I-395 BRIDGE OVER PENOBSCOT RIVER  
 I-395 BRIDGE STA. 164 + 60.00  
 PENOBSCOT COUNTY  
 STATE OF MAINE  
 DEPARTMENT OF TRANSPORTATION


STATE CONTRACT OR REF. NO. **6** CONTRACTOR **CLANBRO CORP.**

IN CHARGE: **HINKLE** MADE BY: **G.F.F.** CHK'D BY: **J.L.C.** DATE: **10-2-84**

CONTRACT NUMBER: **ME-84088-3** DRAWING NUMBER: **37 OF 47**



AF 2283A

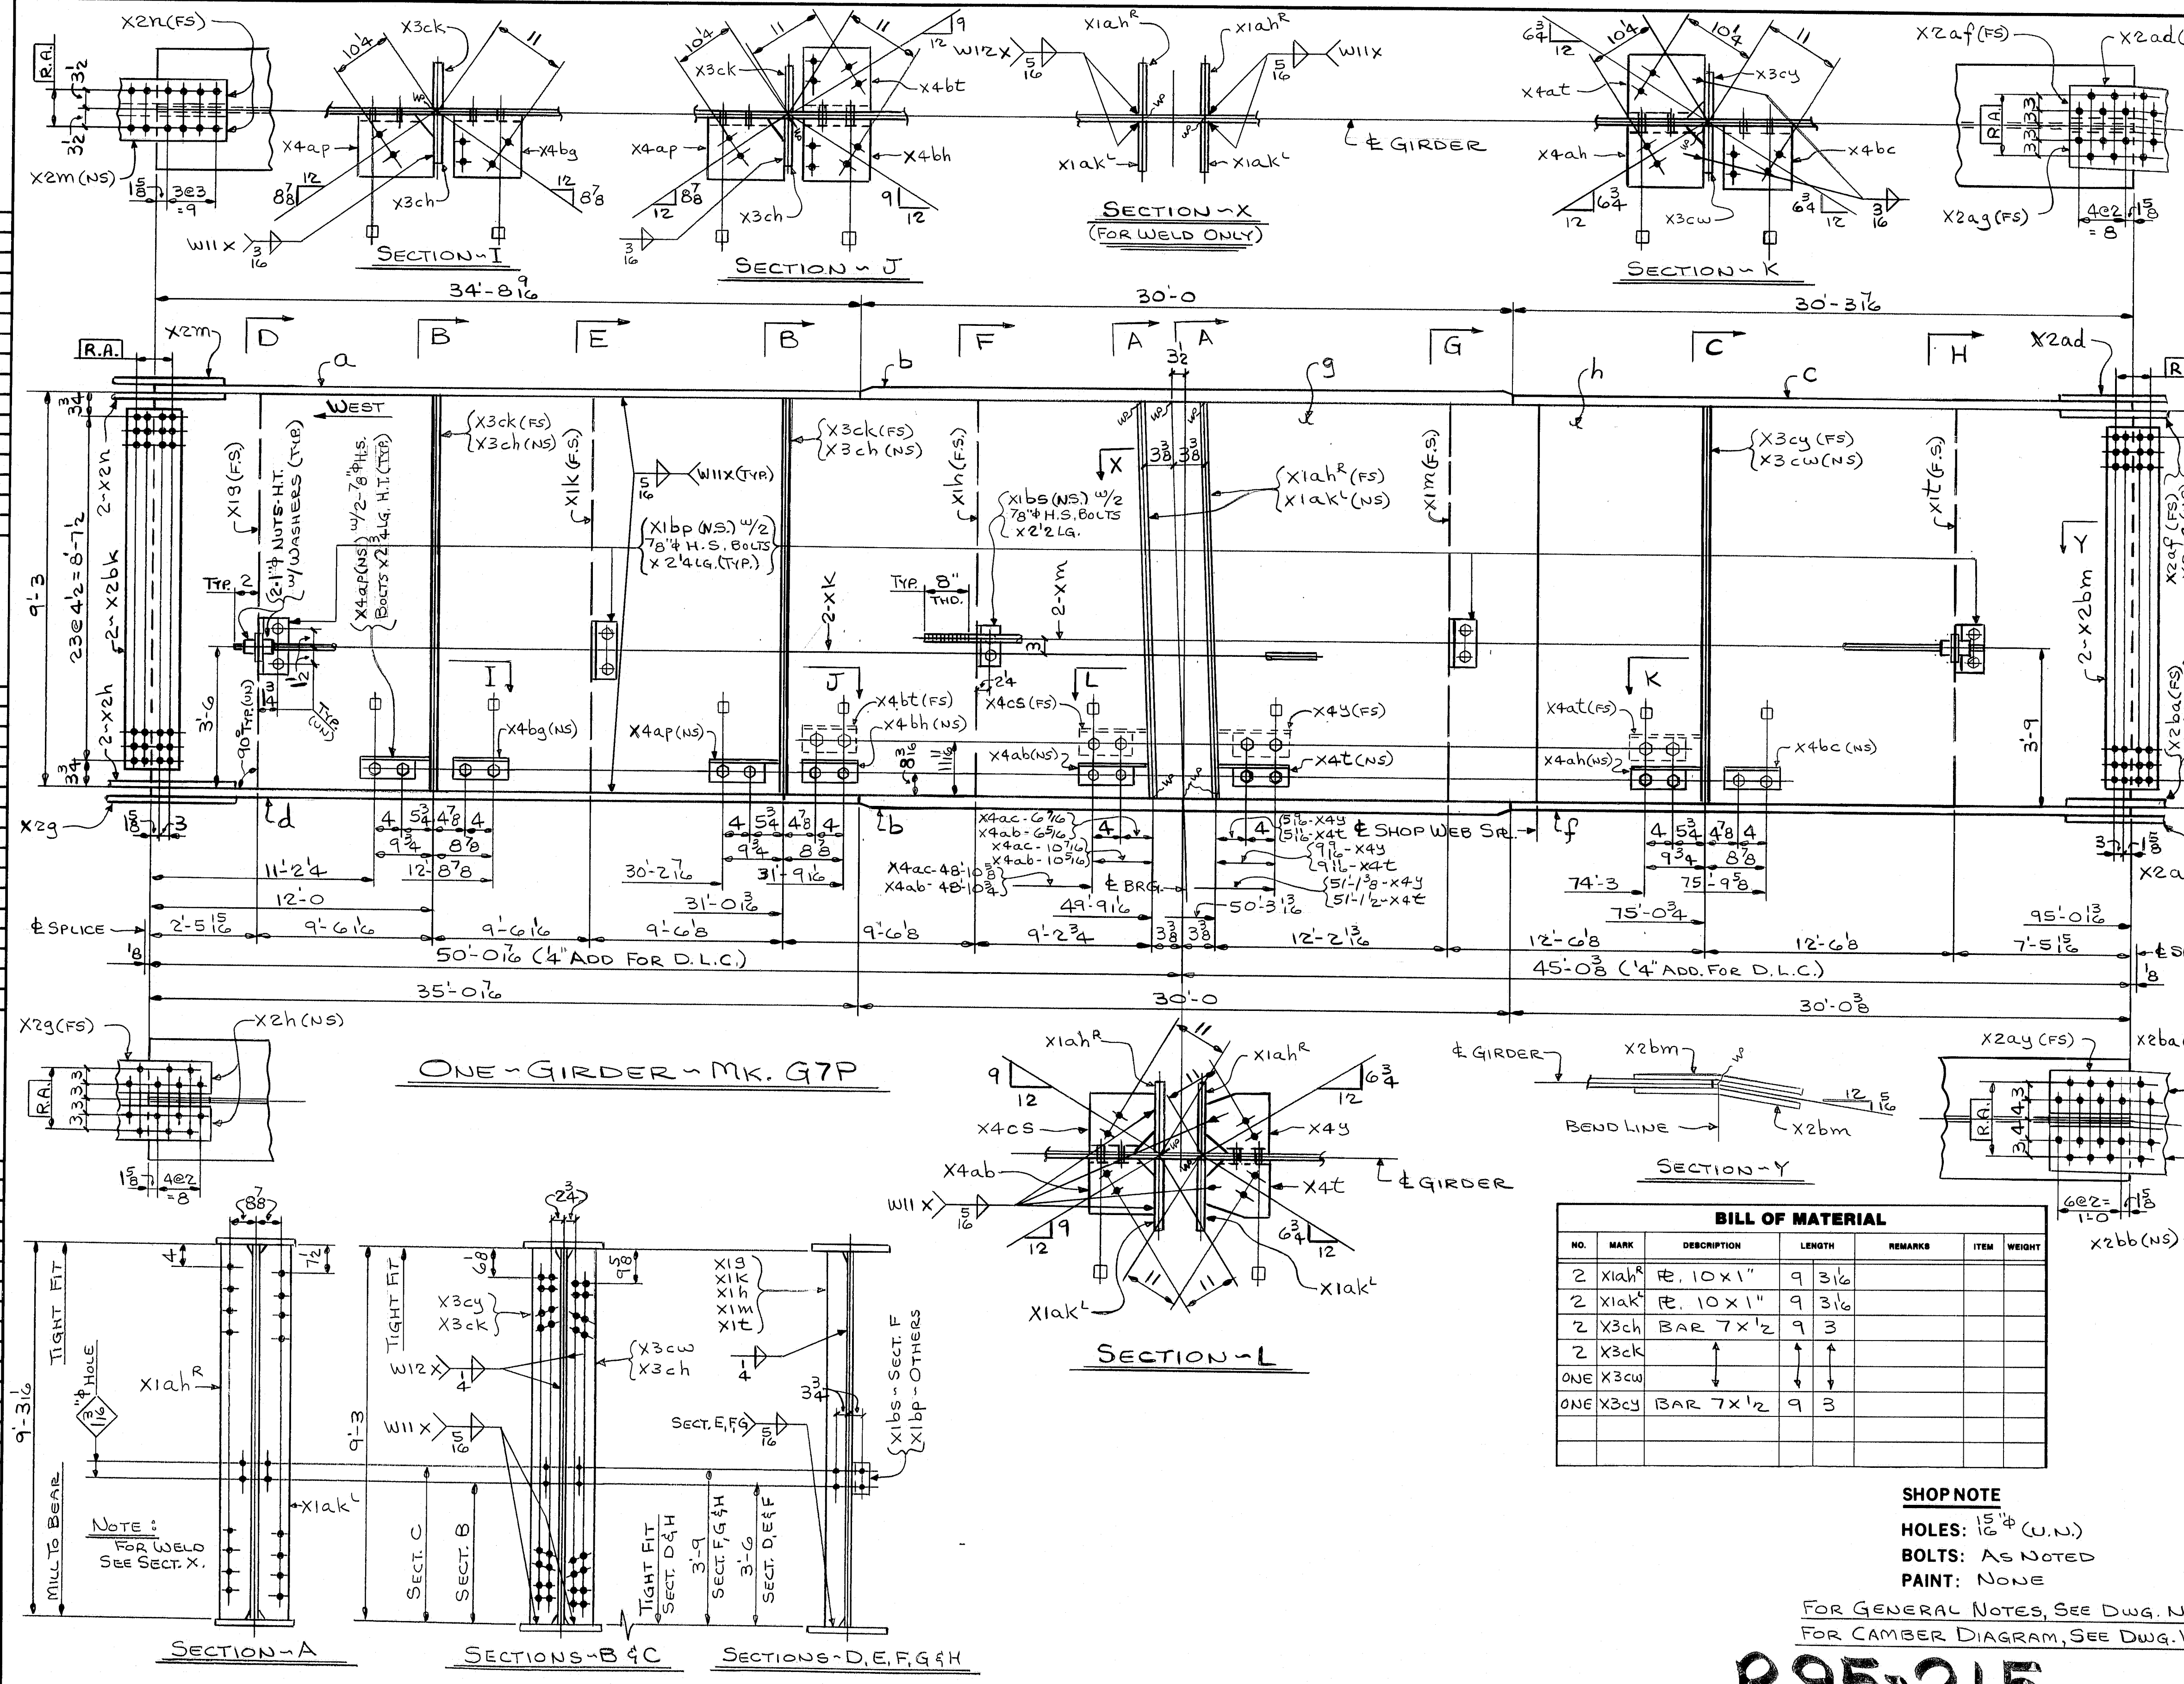

REV. NO.	STATE	FED. AID PROJ. NO.
1	ME	IG-395-8(82)176

BILL OF MATERIAL					
NO.	MARK	DESCRIPTION	LENGTH	REMARKS	TOTAL WEIGHT
ONE	G7P	GIRDER			53710
ONE	a	PL 24 x 14	34 8 1/2		
2	b	PL 24 x 24	30 0		
ONE	c	PL 24 x 14	30 3 1/2		
	d	PL 24 x 14	35 0 1/2		
	f	PL 24 x 14	30 0 1/2		
	g	PL 111 x 16	66 1		
	h	PL 111 x 16	28 1 1/2		
	X13	BAR 5 x 1/2	9 3		
	X1h				
	X1k				
	X1m				
ONE	X1t	BAR 5 x 1/2	9 3		
2	Xk	1" ROD	57 0 4	THD. BOTH ENDS	5 12
2	Xm	1" ROD	50 2 3/4	THD. BOTH ENDS	5 11
8		WASH. FOR 1" ROD			1 1/2
8		1" STD. HEX. NUTS			1 1/2
ONE	X23	PL 15 x 1/2	1 10 1/2		
2	X2h	BAR 6 x 3/4	1 10 1/2		
ONE	X2m	PL 11 x 1/2	2 0 1/2		
2	X2n	BAR 4 x 3/4	2 0 1/2		
2	X2k	PL 10 1/2 x 1/2	1 0 1/2		
2	X2bm	PL 10 1/2 x 1/2	1 0 1/2	BENT	
ONE	X2ad	PL 15 1/2 x 1/2	1 10 1/2		
	X2af	BAR 6 1/2 x 3/4	1 10 1/2		
	X2a3	BAR 6 1/2 x 3/4	1 10 1/2		
ONE	X2a4	PL 19 1/2 x 1/2	2 6 1/2		
34		WASH. FOR 3/4" H.S. BOLTS			8 1/2
24		3/4" H.S. BOLTS	0 2 3/4		8 1/2
2		3/4" H.S. BOLTS	0 2 2		8 1/2
8		3/4" H.S. BOLTS	0 2 4		8 1/2
ONE	X2ba	PL 8 1/2 x 7/8	2 6 1/2		
ONE	X2bb	PL 8 1/2 x 7/8	2 6 1/2		
4	X1bp	5 x 3 x 1/4	0 6		
ONE	X1bs	5 x 3 x 1/2	0 6		
	X44	PL MC18 x 4.5	0 11 1/2		
	X4t		0 11 1/2		
	X4ab		0 11 1/2		
	X4cs		0 11 1/2		
	X4ah		0 11 1/2		
	X4at		0 11 1/2		
	X4bc		0 10		
	X4bg		0 10		
	X4bh		0 10		
	X4bt		0 10		
2	X4ap	PL MC18 x 4.5	0 11 1/2		

BILL OF MATERIAL					
NO.	MARK	DESCRIPTION	LENGTH	REMARKS	ITEM WEIGHT
2	X1ah	PL 10 x 1"	9 3 1/2		
2	X1ak	PL 10 x 1"	9 3 1/2		
2	X3ch	BAR 7 x 1/2	9 3		
2	X3ck				
ONE	X3cw				
ONE	X3cy	BAR 7 x 1/2	9 3		

SHOP NOTE  
HOLES: 1 1/2" (U.N.)  
BOLTS: AS NOTED  
PAINT: NONE

FOR GENERAL NOTES, SEE DWG. N1.  
FOR CAMBER DIAGRAM, SEE DWG. WCZ

R95-215 CODE: 4000

NO.	REVISION	DATE
HIGH STEEL STRUCTURES, INC.		
1905 Old Philadelphia Pike Lancaster, Pennsylvania 17603 Phone 717/299-5211		
A Subsidiary of High Industries, Inc.		
GIRDER G7P		
I-395 BRIDGE OVER PENOBSCOT RIVER		
I-395 BRIDGE STA. 164+60.00		
PENOBSCOT COUNTY		
STATE OF MAINE		
DEPARTMENT OF TRANSPORTATION		
STATE CONTRACT OR REF. NO.	CONTRACTOR	DATE
6	CLANERO CORP.	
IN CHARGE:	MADE BY:	CHK'D BY:
HINKLE	G.F.F.	J.L.C.
CONTRACT NUMBER:	DRAWING NUMBER:	DATE:
ME-84088-3	38 OF 47	10-2-84











