


F.H.A. REG. NO.	STATE	PROJECT NUMBER	SHEET NO.	TOTAL SHEETS
1	MAINE			

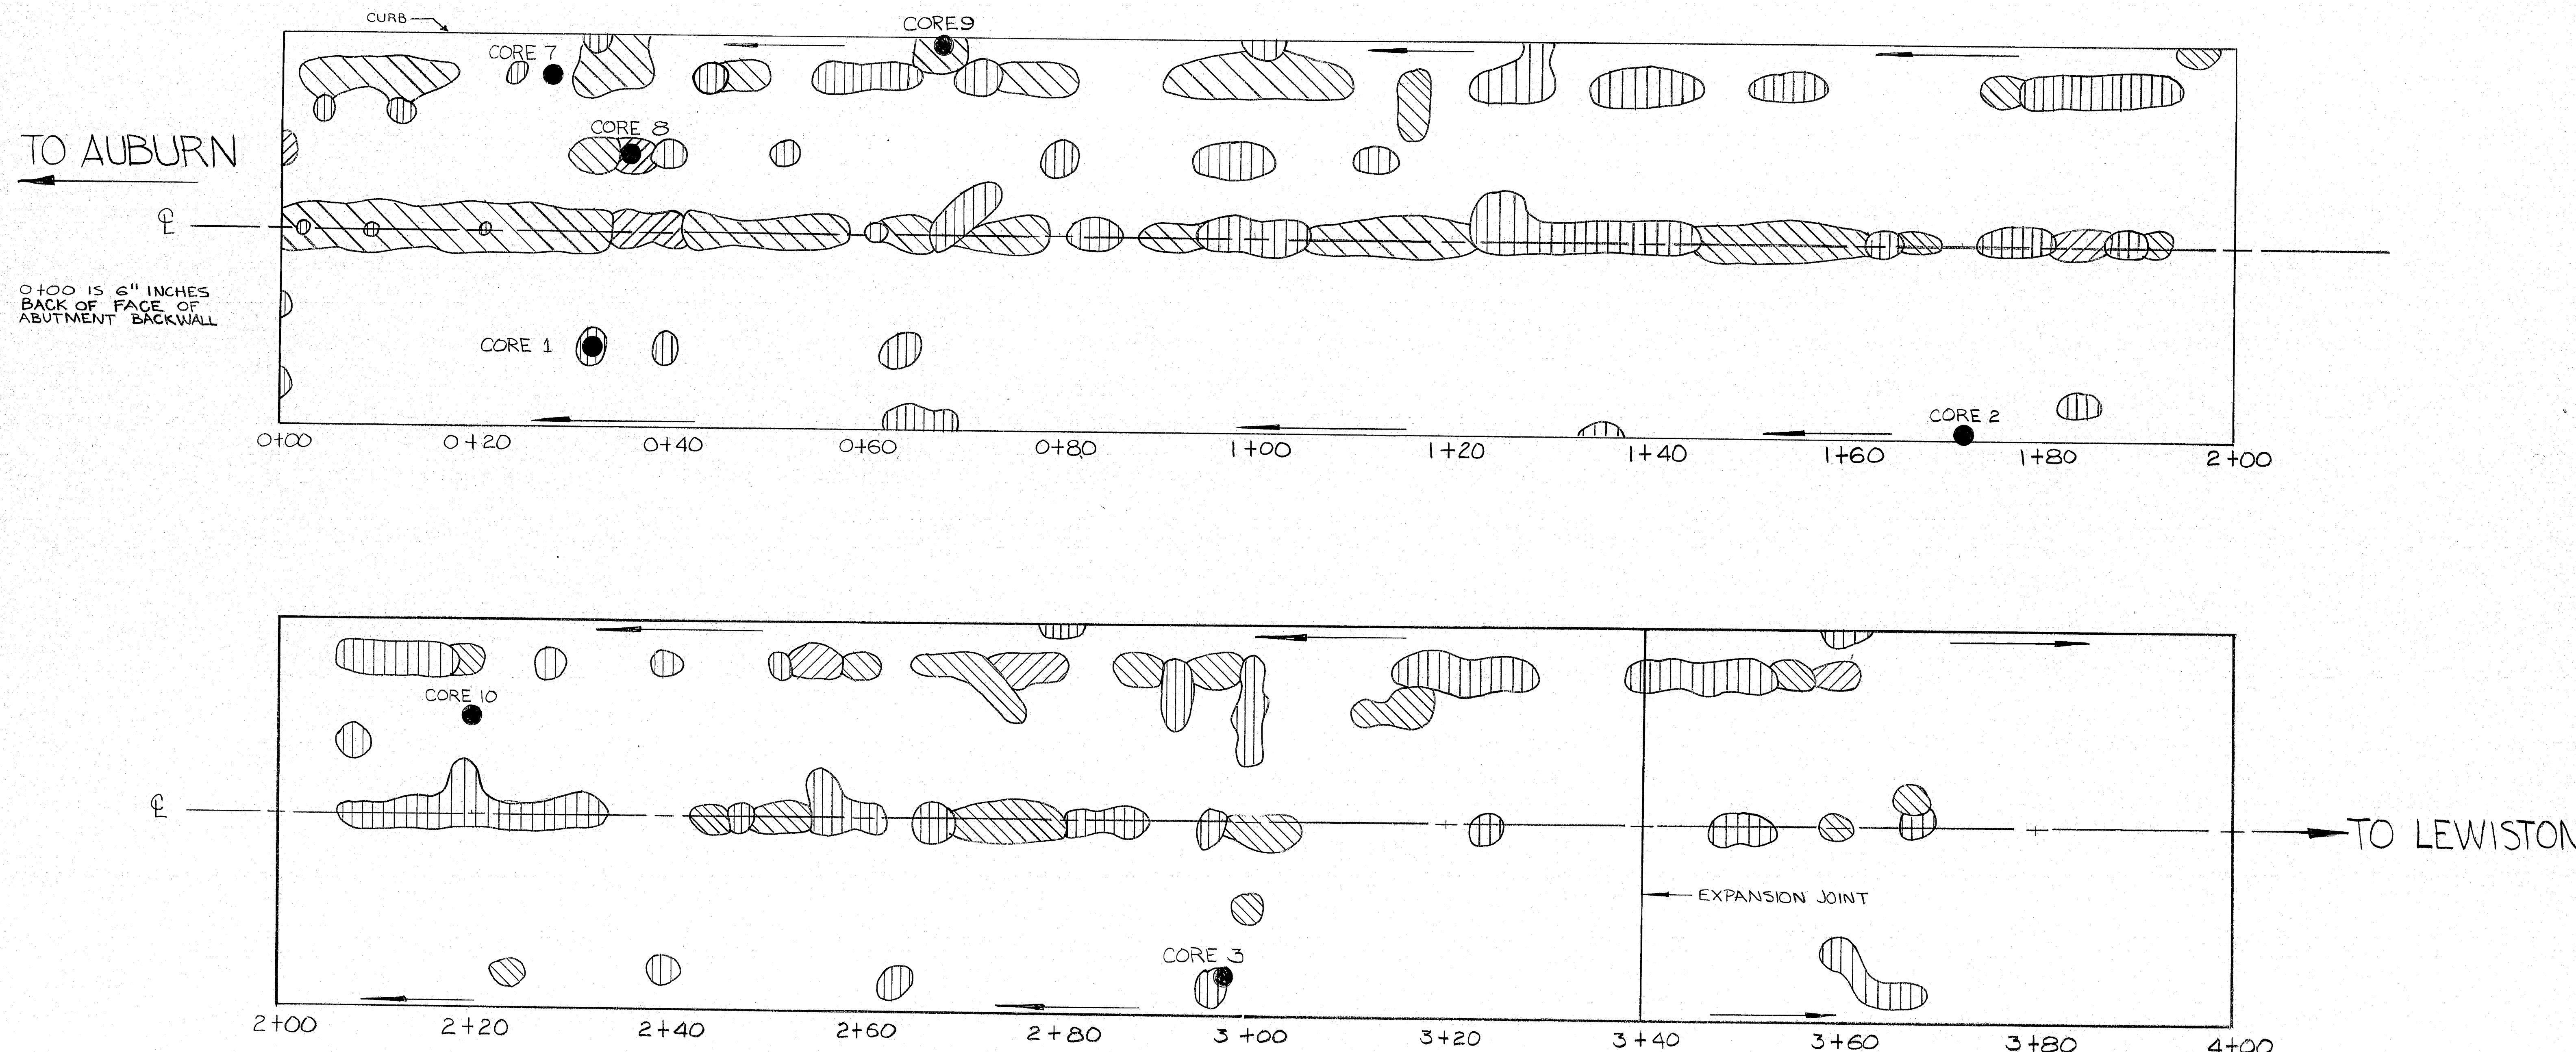


PLAN

LEGEND

- DIRECTION OF DRAINAGE
- BRIDGE DRAIN

0.30-0.39 VOLTS	0.60-0.69 VOLTS
0.40-0.49 VOLTS	0.70-0.79 VOLTS
0.50-0.59 VOLTS	0.80-0.89 VOLTS

SCALE

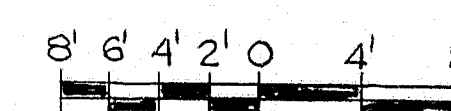

STATIONING	PERCENT OF DECK READINGS ALL READINGS ABOVE THESE VOLTS					
	0.30	0.40	0.50	0.60	0.70	0.80
0+00 - 7+15	17%	6%	1%	0.2%	—	—

NOTE: AVERAGE OF ALL READINGS ON THE BRIDGE IS 0.19



119-389

STATE OF MAINE
DEPARTMENT OF TRANSPORTATION

BRIDGE DECK EVALUATION
(VOLT-METER SURVEY)
SOUTH BRIDGE
OVER
ANDROSCOGGIN RIVER
LEWISTON-AUBURN

PROJECT DESIGN ENGINEER	BY	DATE
DESIGN - DETAIL	CDH	12-84
CHECKED	CDH	12-84
REVISIONS		
FIELD CHANGES		

F.W.A. REG. NO.	STATE	PROJECT NUMBER	SHEET NO.	TOTAL SHEETS
1	MAINE			

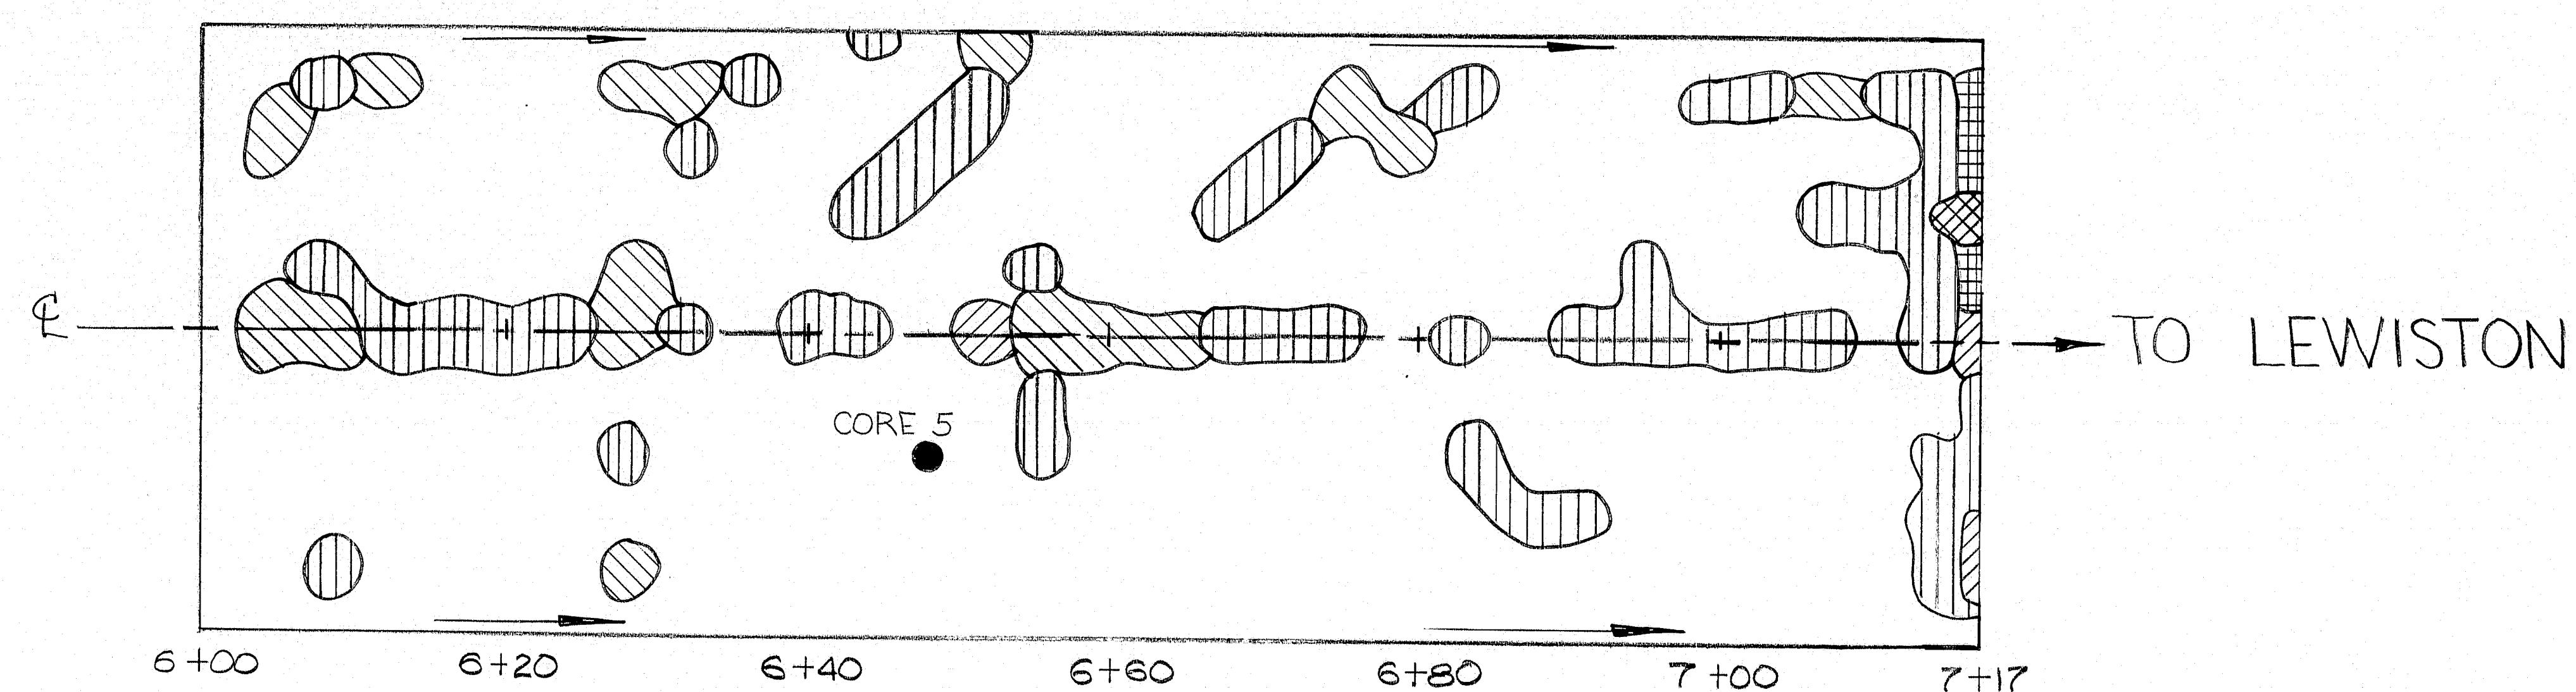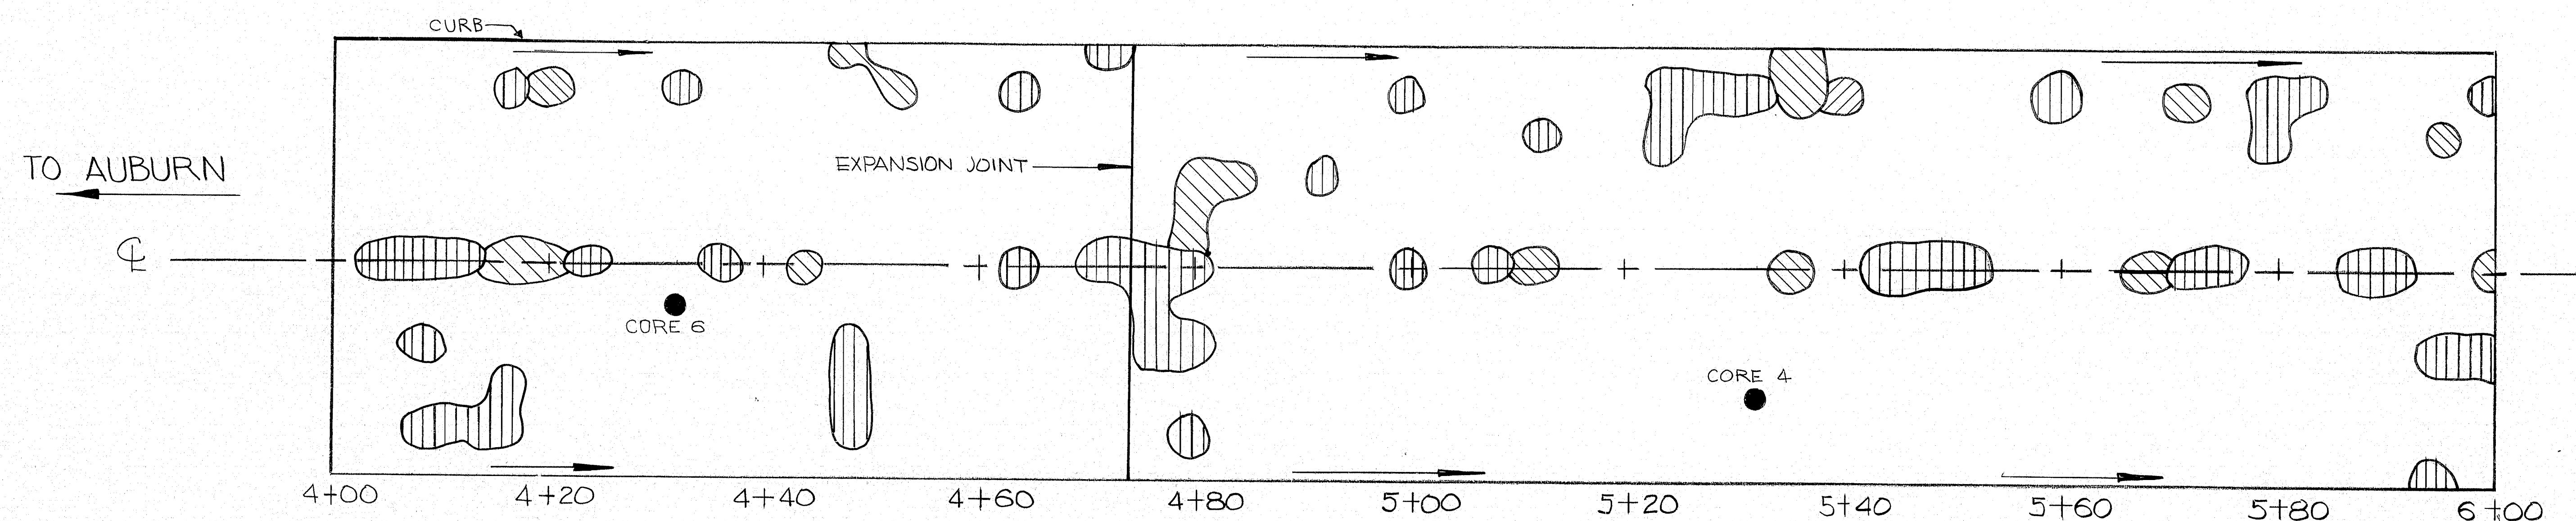

PLAN

PROJECT DESIGN ENGINEER	BY	DATE
DESIGN - DETAILED	CDH LTR	12-84
CHECKED	CDH	12-84
REVISIONS		
FIELD CHANGES		

BRUNING 44-132-6710

119-390

STATE OF MAINE
DEPARTMENT OF TRANSPORTATION

BRIDGE DECK EVALUATION
(VOLT-METER SURVEY)
SOUTH BRIDGE
OVER
ANDROSCOGGIN RIVER
LEWISTON-AUBURN

SHEET 2 OF 2 AUGUSTA, MAINE SEPT. 1984