


ELEVATION OF CABLE BENT

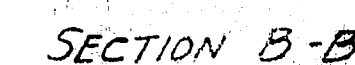

Note Riv. $\frac{3}{8}$ " holes $\frac{15}{16}$ " ϕ except as noted

REVISION DATE REMARK 1-7-38 Redrawn. 7-26-39 Revised as built.	P.W.A. PROJECT NO. ME1010 DEER ISLE SEDGWICK BRIDGE DISTRICT BRIDGE OVER EGGEMOGGIN REACH FROM LITTLE DEER ISLE TO SEDGWICK HANCOCK COUNTY, MAINE
	CABLE BENTS
ROBINSON AND STEINMAN ENGINEERS NEW YORK CITY	SCALE 1" = 10' DRAWING NUMBER RS3310 - 510 SEPTEMBER 4, 1937

124-18

