RS 3310 - S106

Note - For cable stay brackets and change in covering plate, see Sheets S-142, S-143, S-144

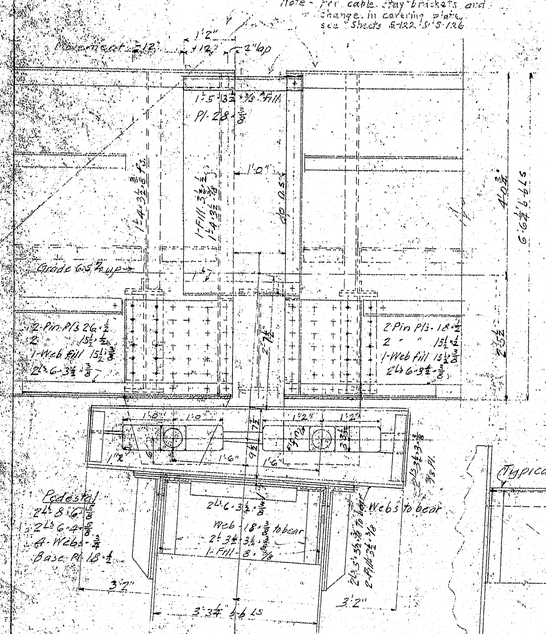

SECTION A-A

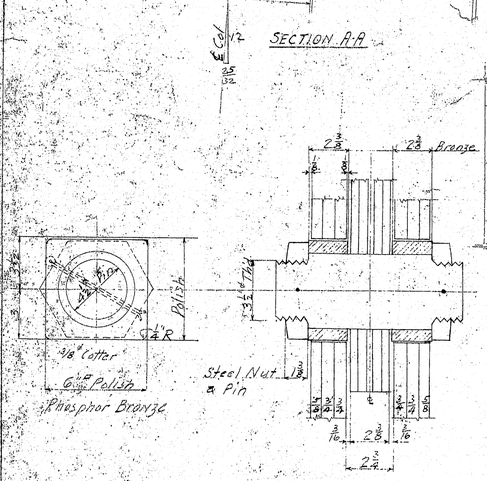

DETAIL OF EXPANSION BEARING

Scale 3"=1'-0"

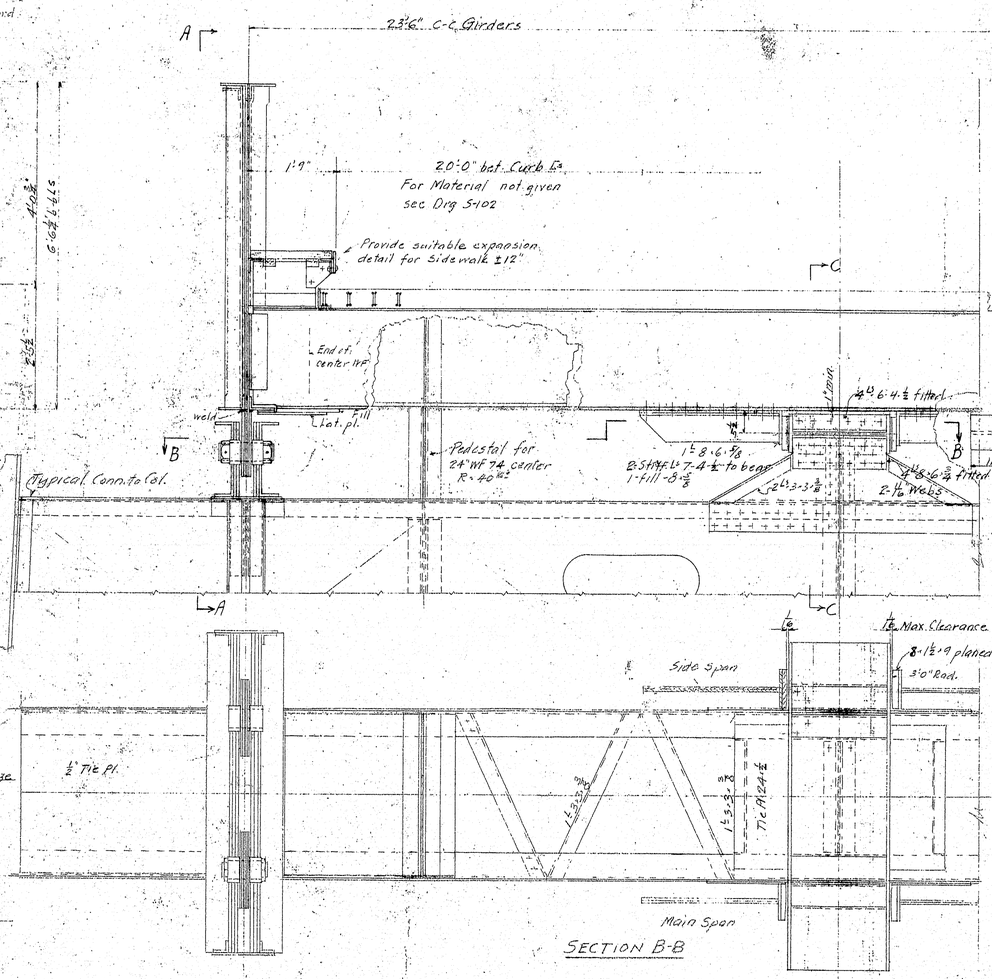

SECTION B-B

SECTION C-C

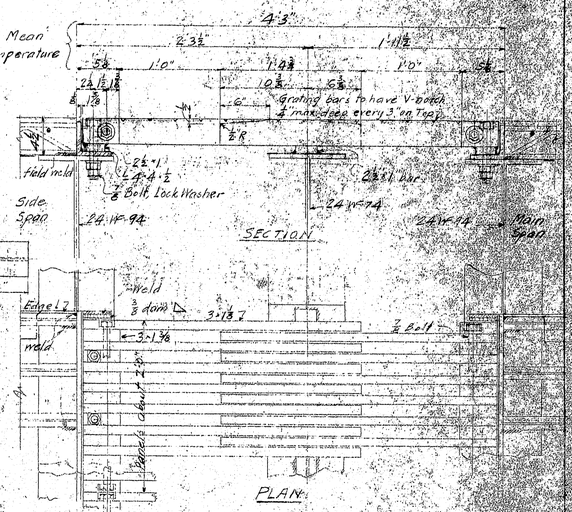

SECTION

PLAN

DETAIL OF EXPANSION GRATING

Scale 1 1/2"=1'-0"

Rivets 3/4" Open holes 15/16" unless noted
For drainage of gutter see Sheet S-124

7-26-37 Revised as built

SUPERSTRUCTURE

P.W.A. PROJECT NO. ME 1010 D

DEER ISLE SEDGWICK BRIDGE, DISTRICT
BRIDGE OVER EGGEMOGGIN REACH
FROM LITTLE DEER ISLE TO SEDGWICK
HANCOCK COUNTY, MAINE

FLOOR EXPANSION JOINTS AT MAIN TOWERS

ROBINSON AND STEINMAN
ENGINEERS
NEW YORK CITY

SCALE 1"=1'-0"
DRAWING NO. 106
RS 3310 S 106
SEPTEMBER 8, 1936

124-20

LITHO IN U.S.A.