RS 3310 - 510

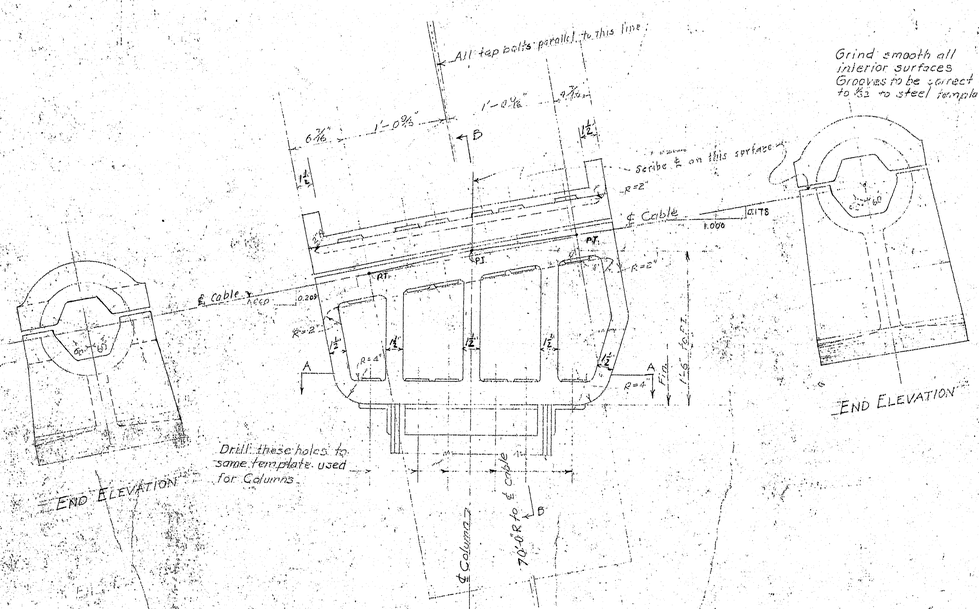

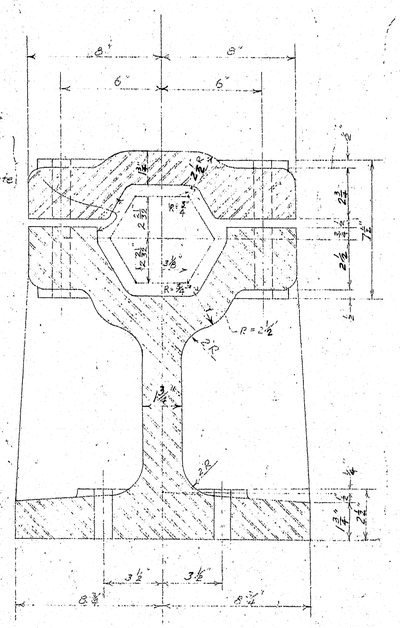

ELEVATION OF CABLE BENT SADDLE
4 Required : Cast Steel annealed
Scale 1½"=1'-0"

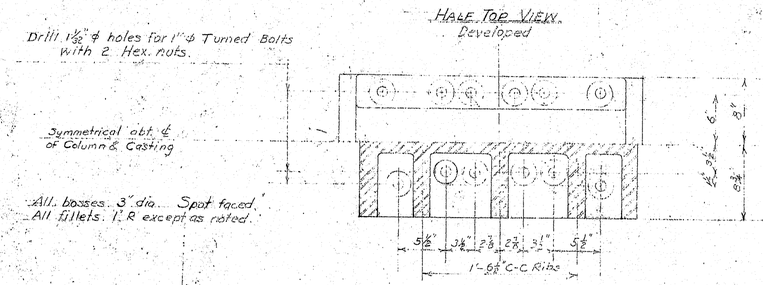

HALF SECTION A-A

ESTIMATED WEIGHT OF ONE CABLE BENT SADDLE	CONTRACT DWG.	AS BUILT
	2000#	1660
TOTAL FOR BRIDGE	8000#	6640

REVISION	
DATE	REMARK
1-7-38	Reduction of thickness and correction of R.
7-26-39	Revised as built

SUPERSTRUCTURE

P.W.A. PROJECT NO. ME 1010D

DEER ISLE SEDGWICK BRIDGE DISTRICT

BRIDGE OVER EGGEMOGGIN REACH
FROM LITTLE DEER ISLE TO SEDGWICK
HANCOCK COUNTY, MAINE

CABLE BENT SADDLES

ROBINSON AND STEINMAN
ENGINEERS
NEW YORK CITY

SCALE AS NOTED
DRAWING NUMBER
RS 3310 - 510
SEPTEMBER 1937

124-22