




PIER NO. 6 Looking North

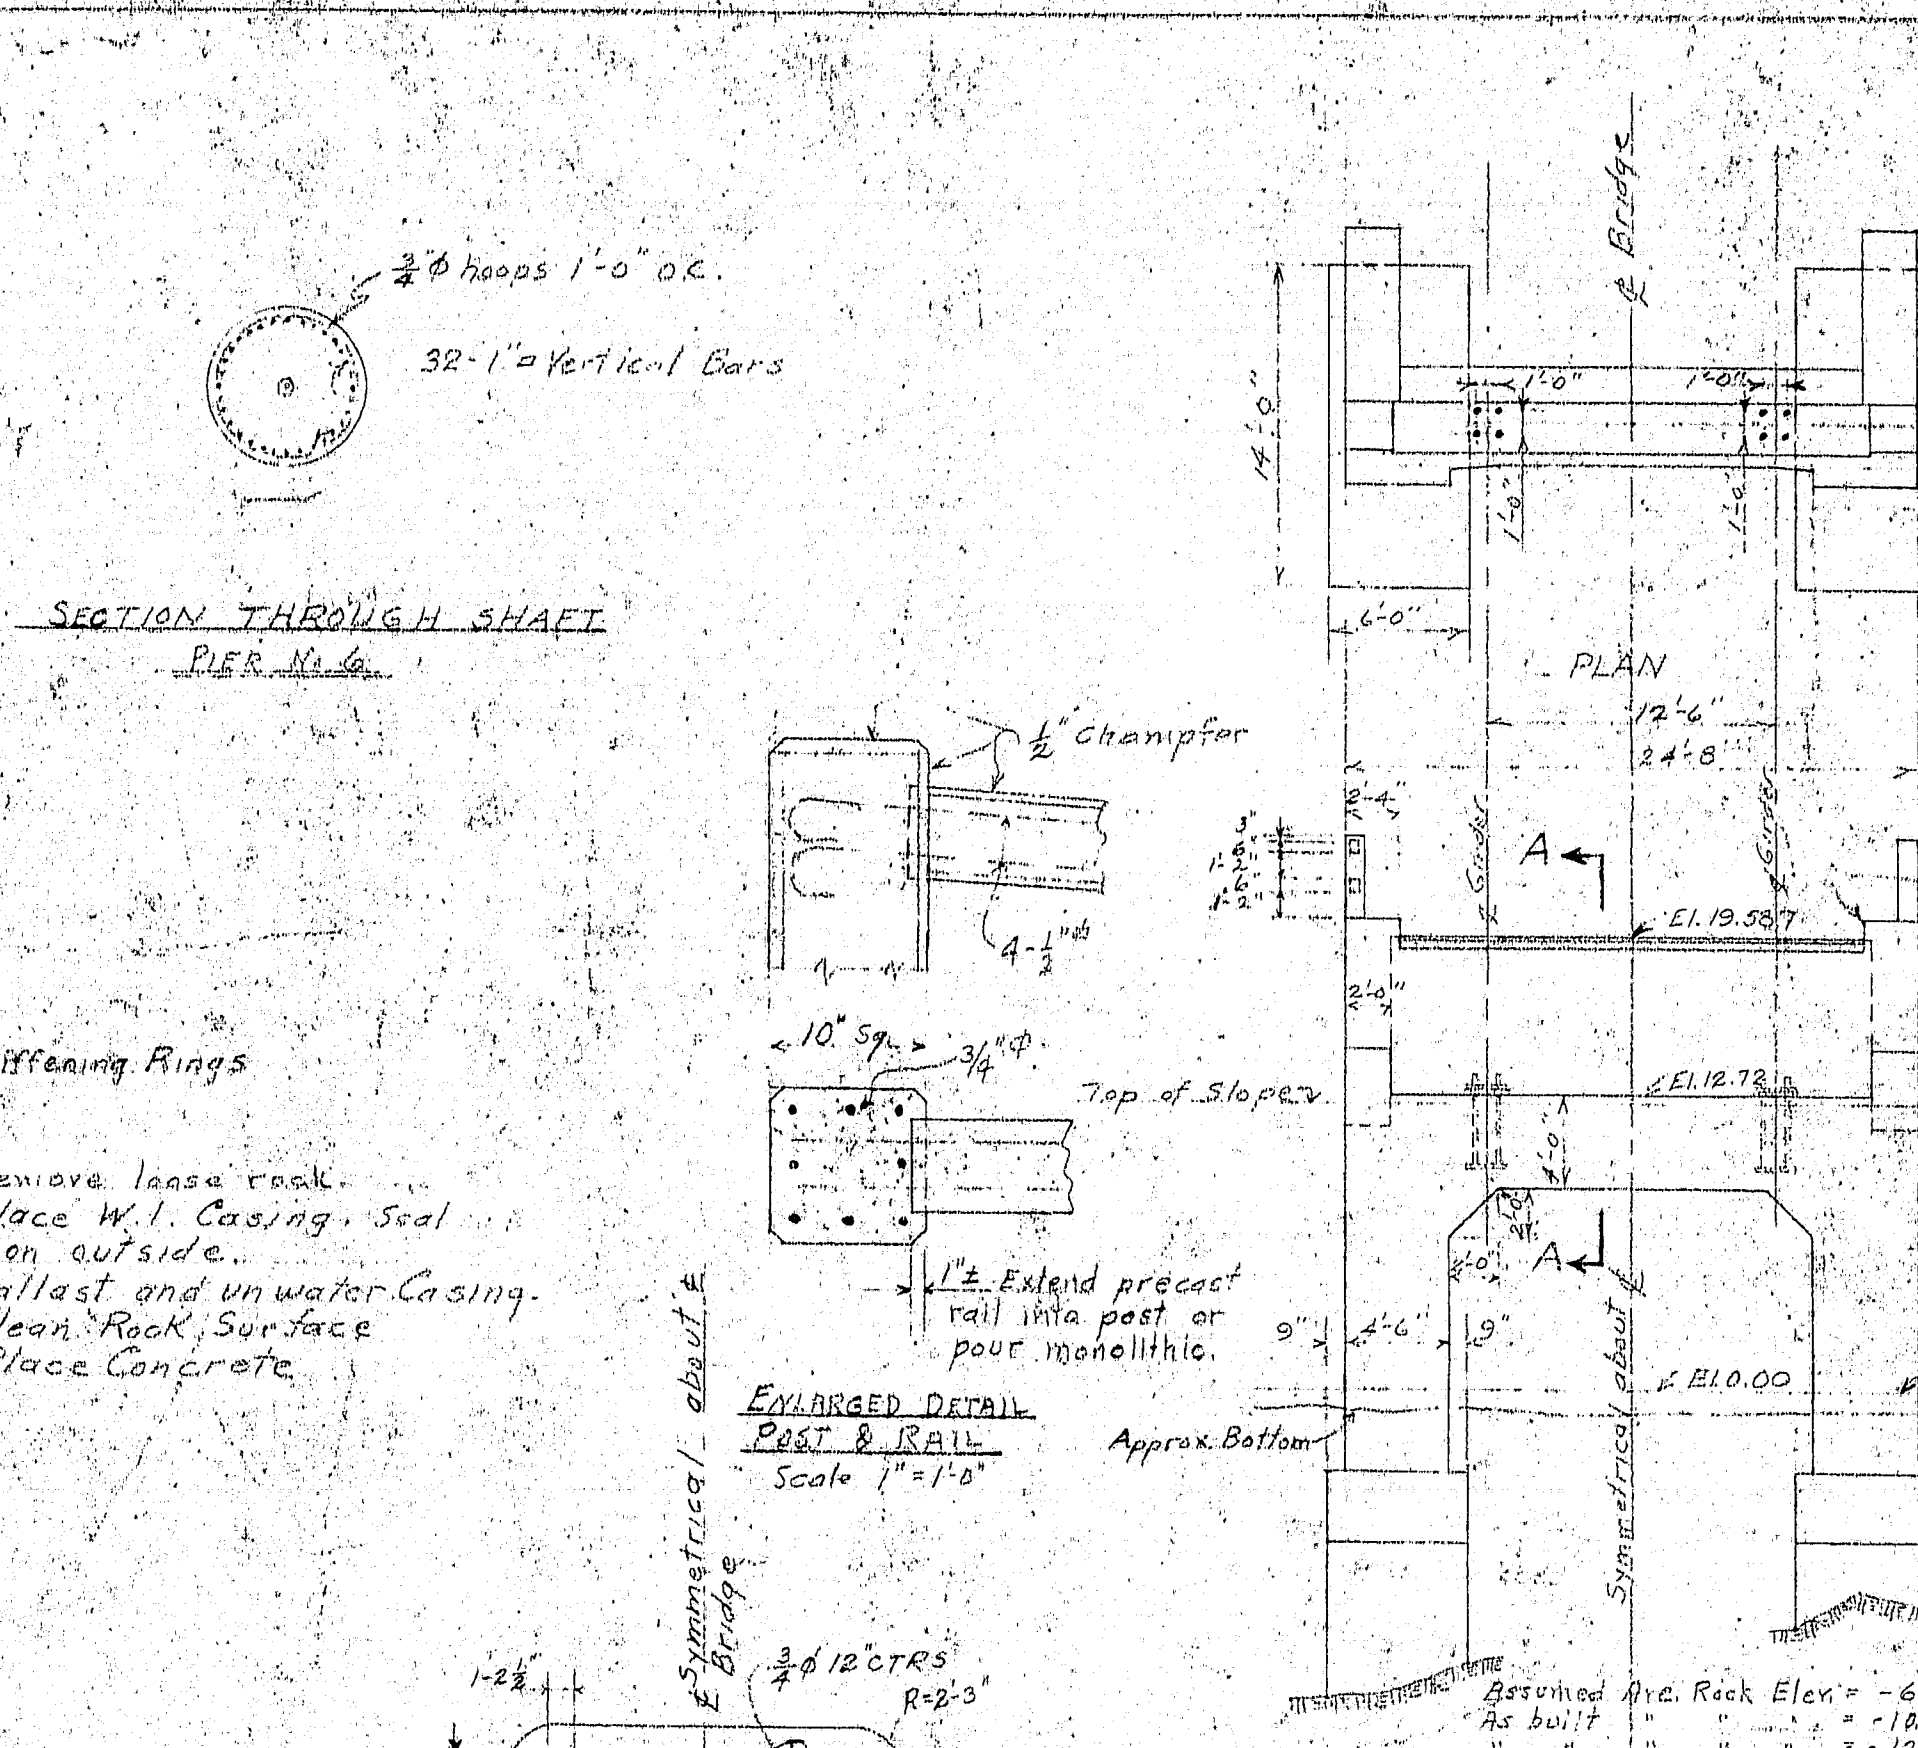


PIER NO. 7 Looking North

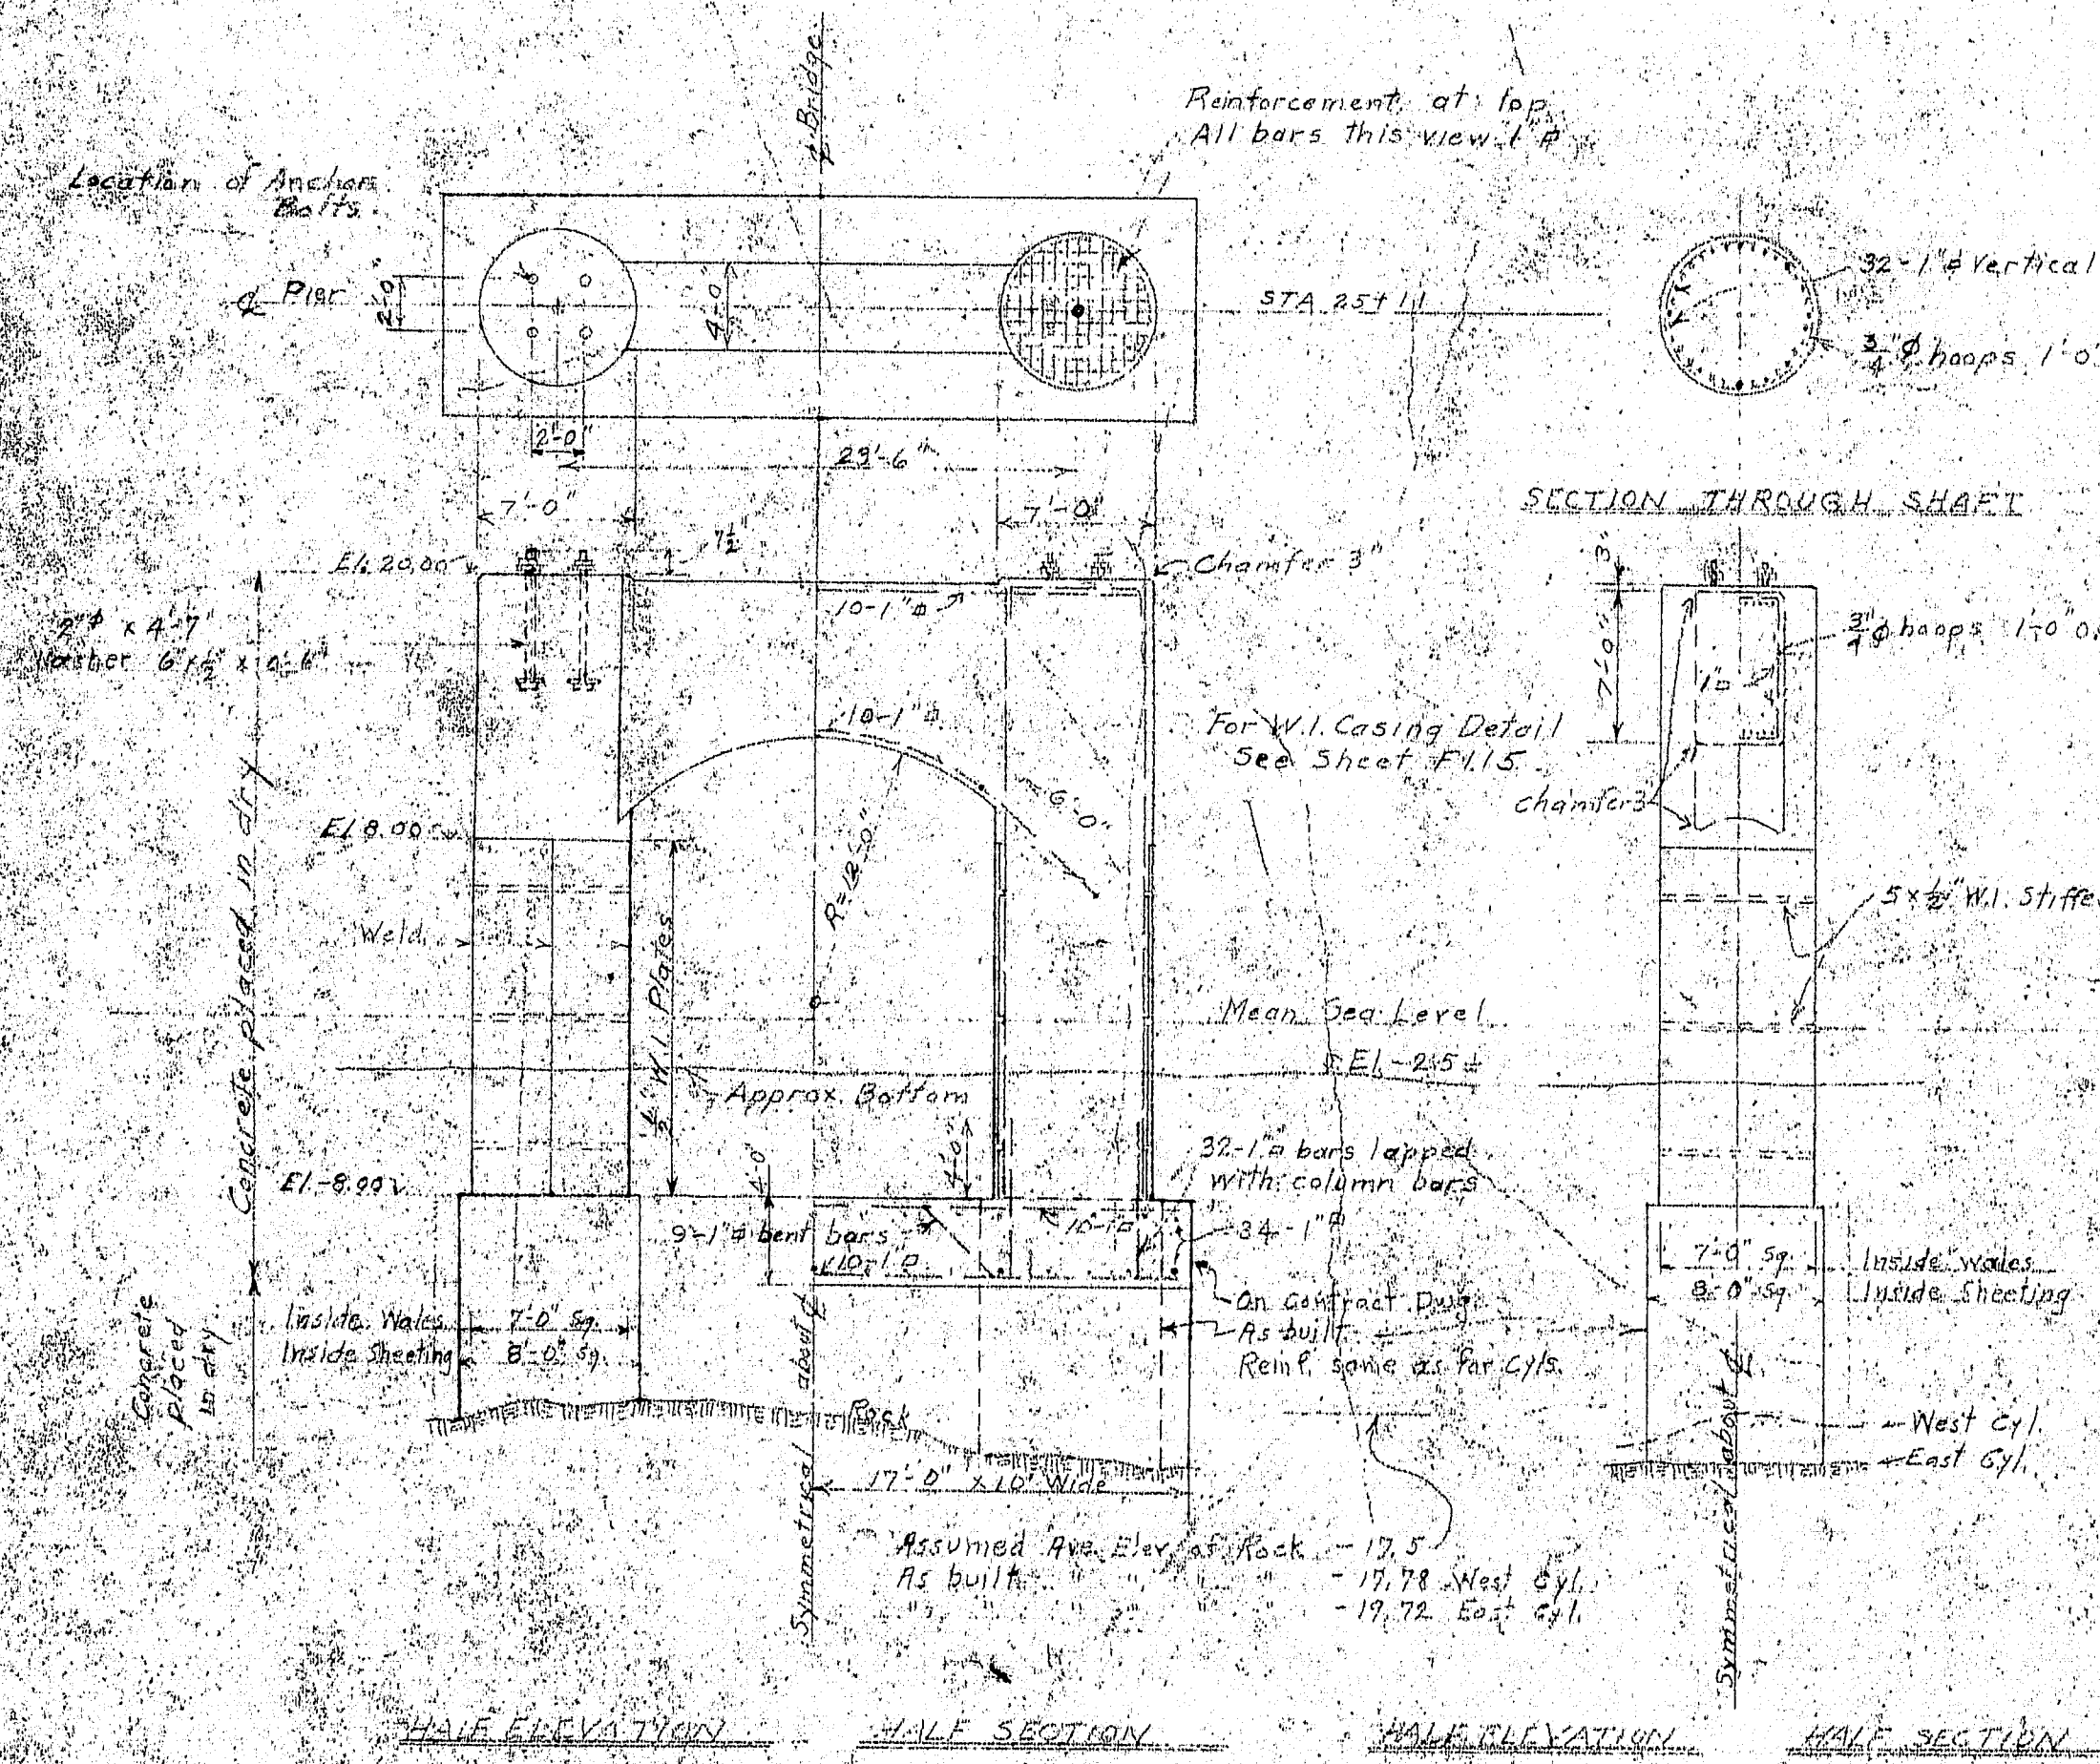


PIER NO. 3 Looking North

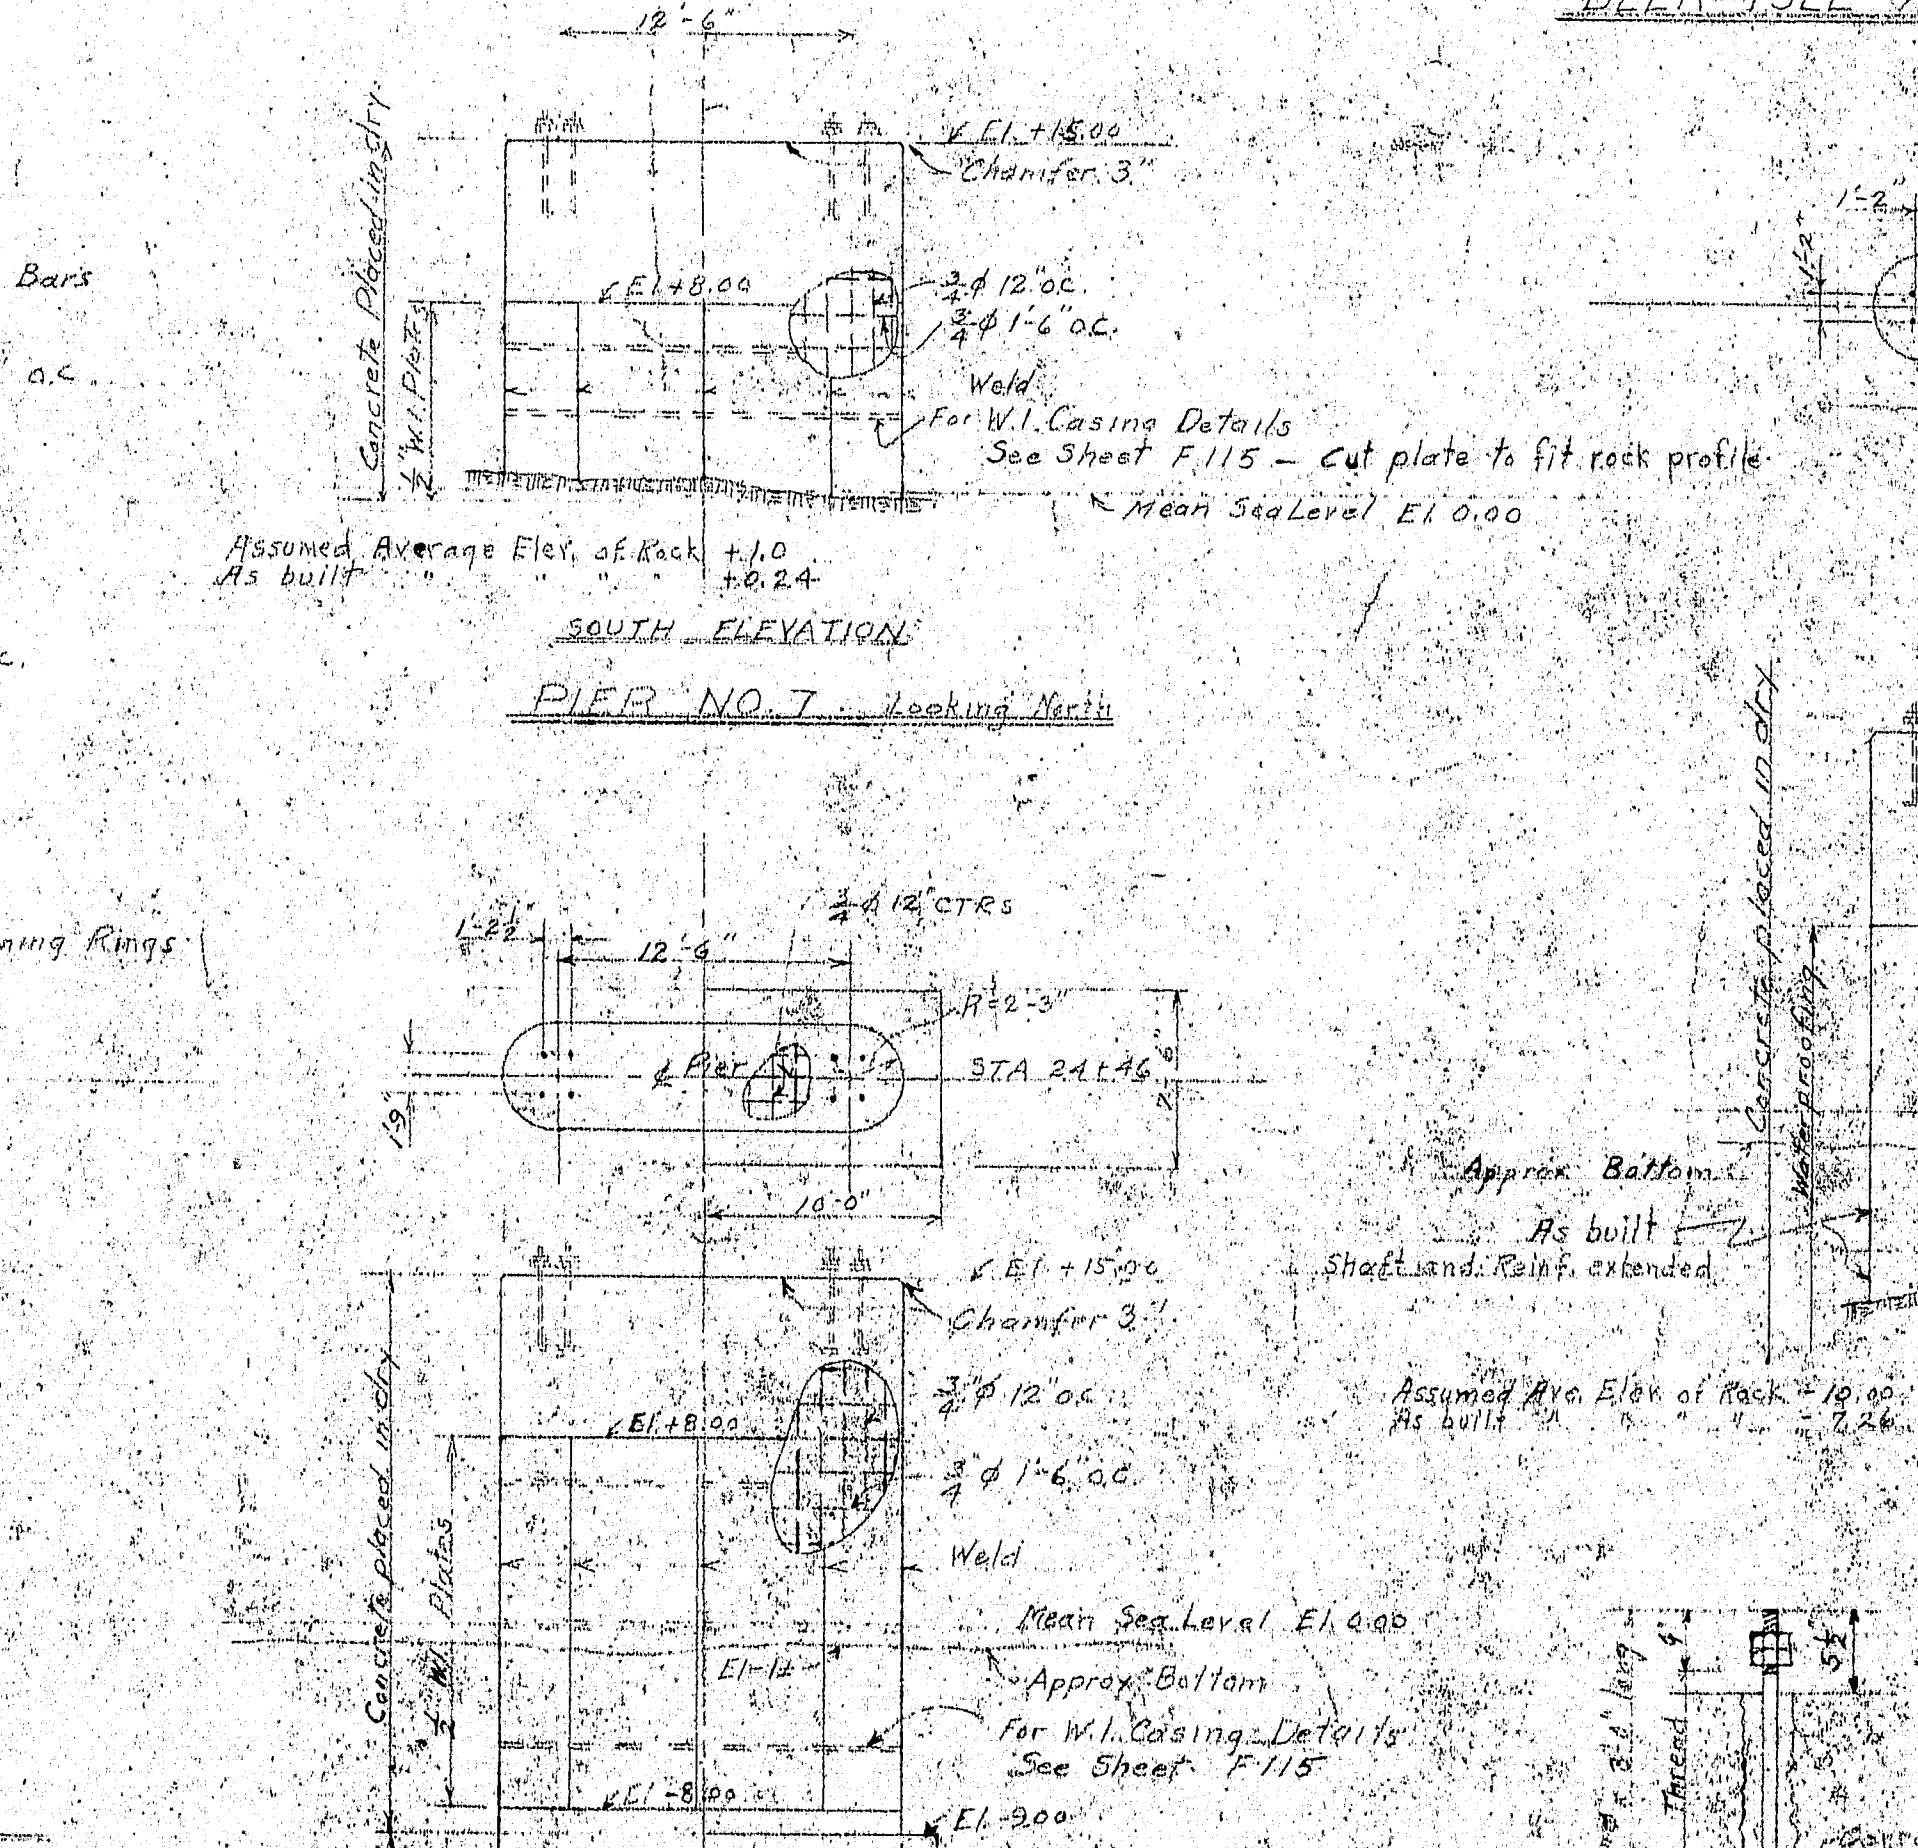


PIER NO. 2 Looking North

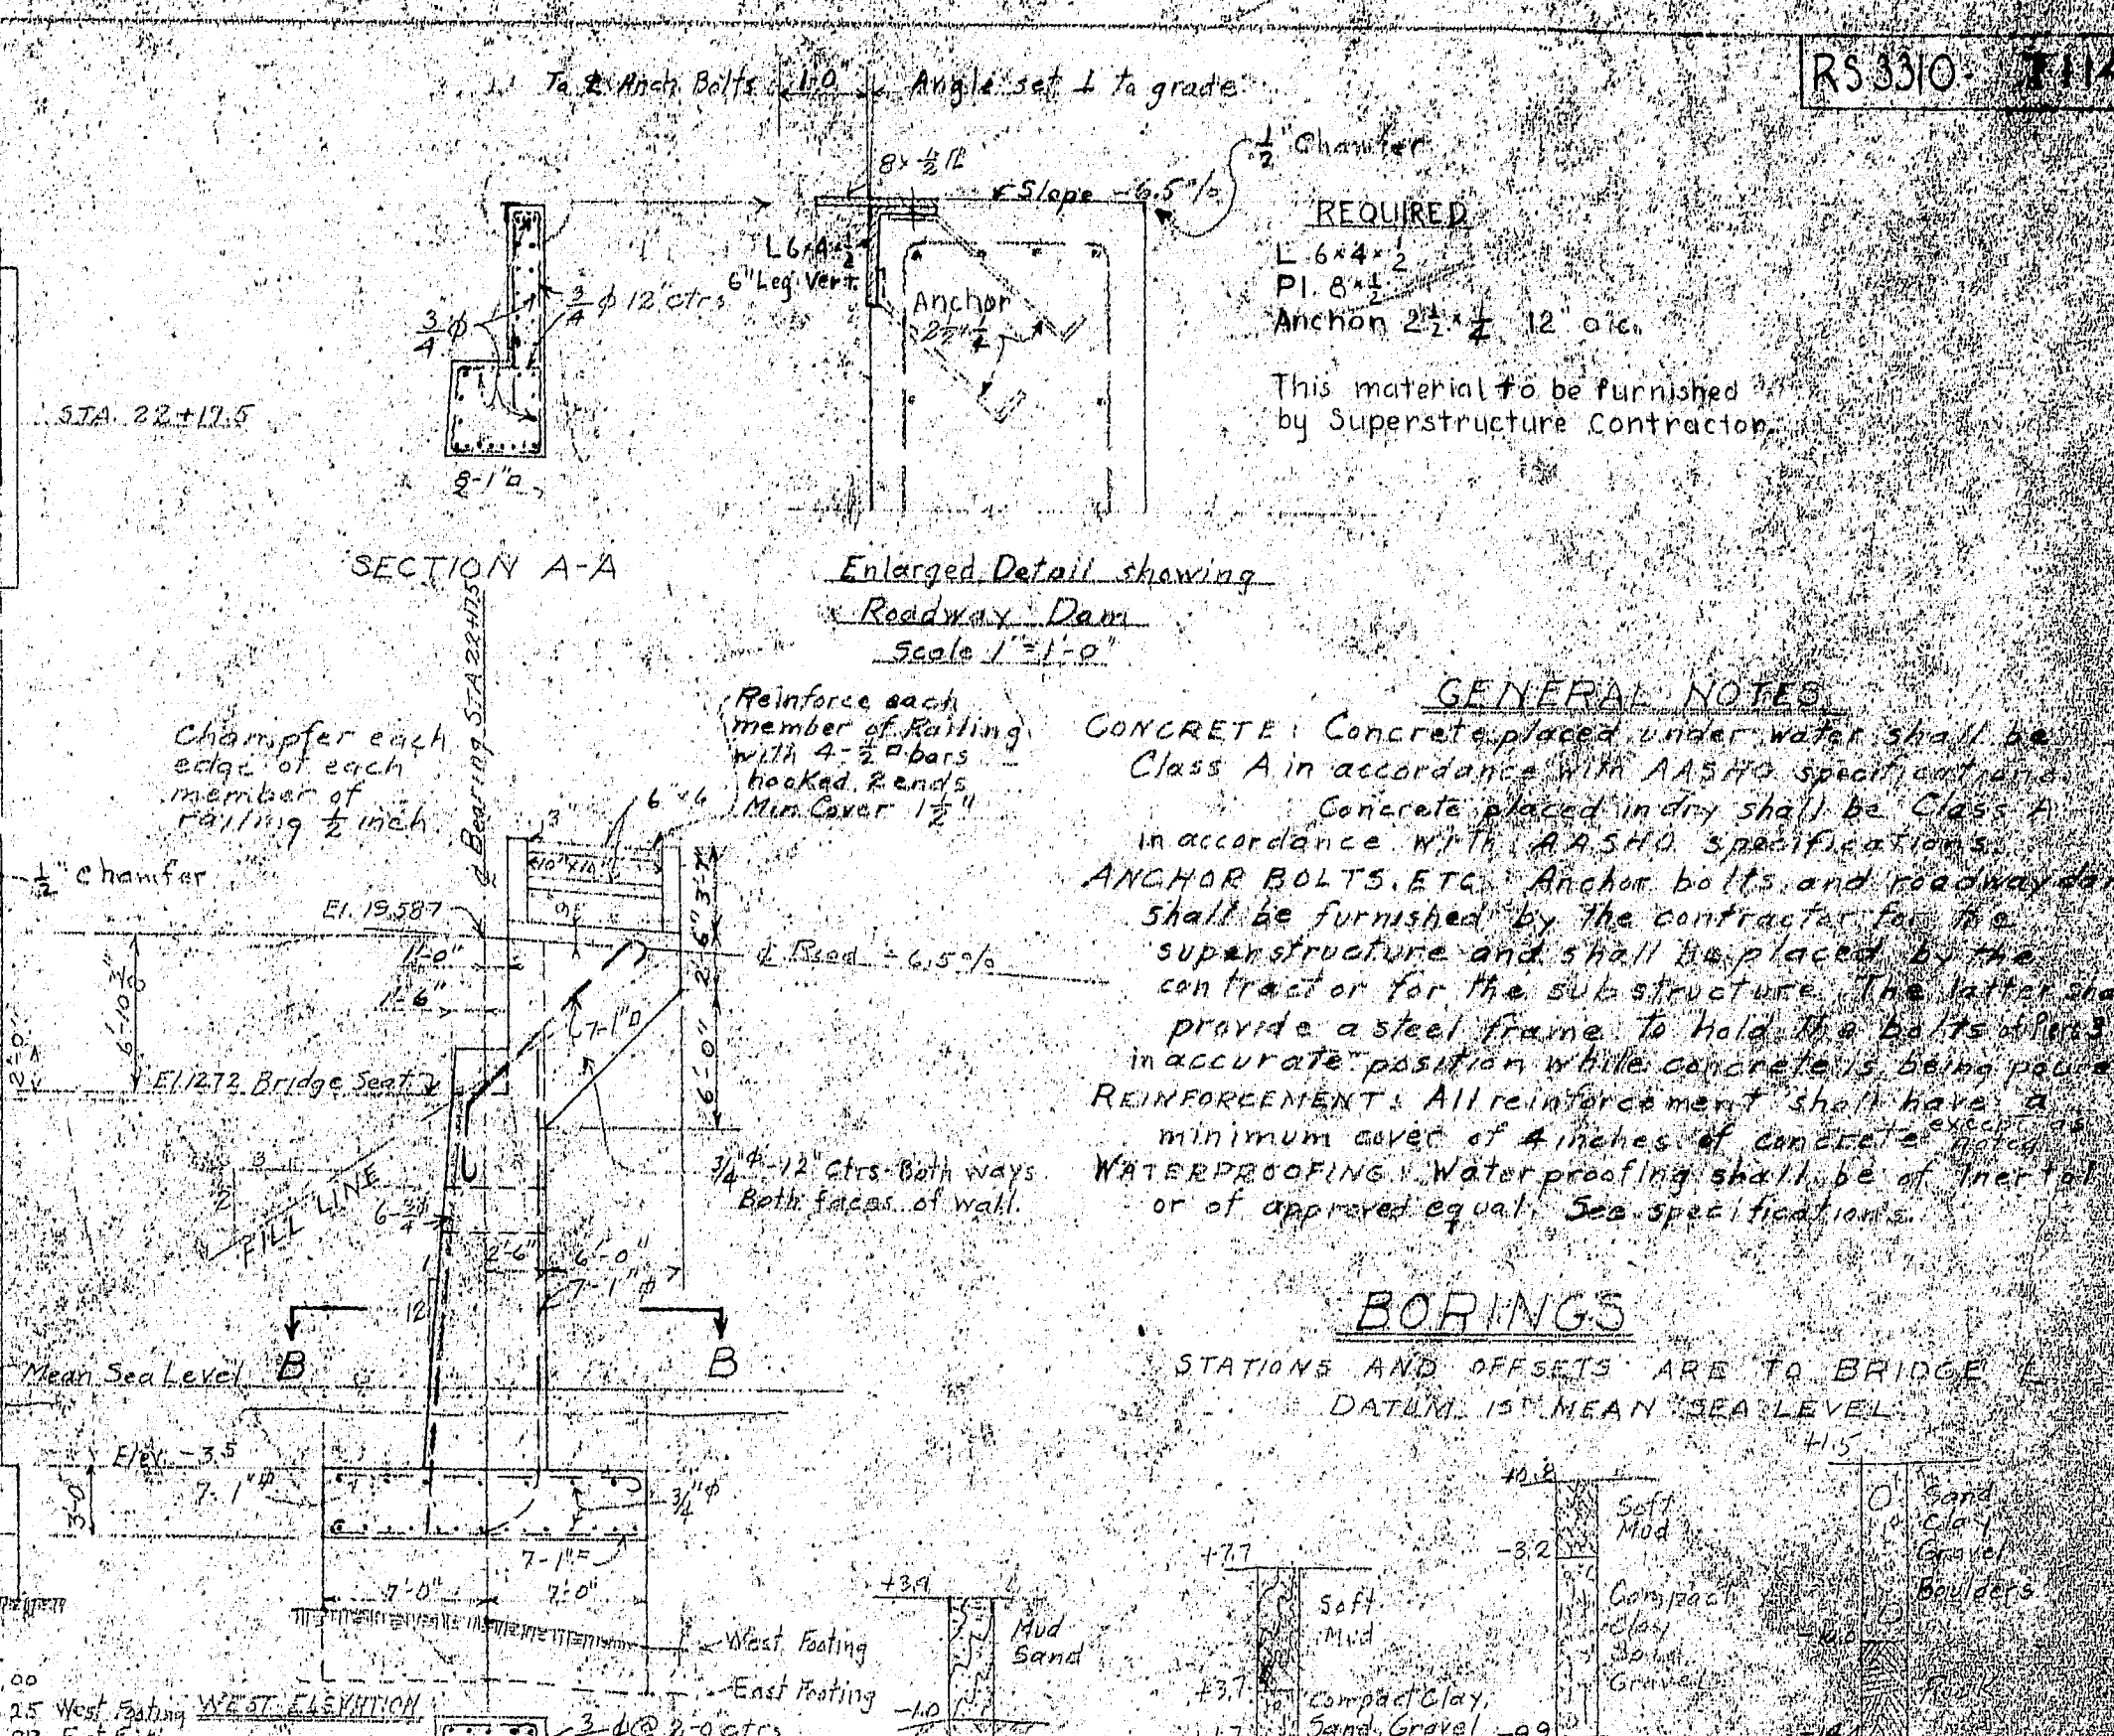


DEER ISLE ABUTMENT

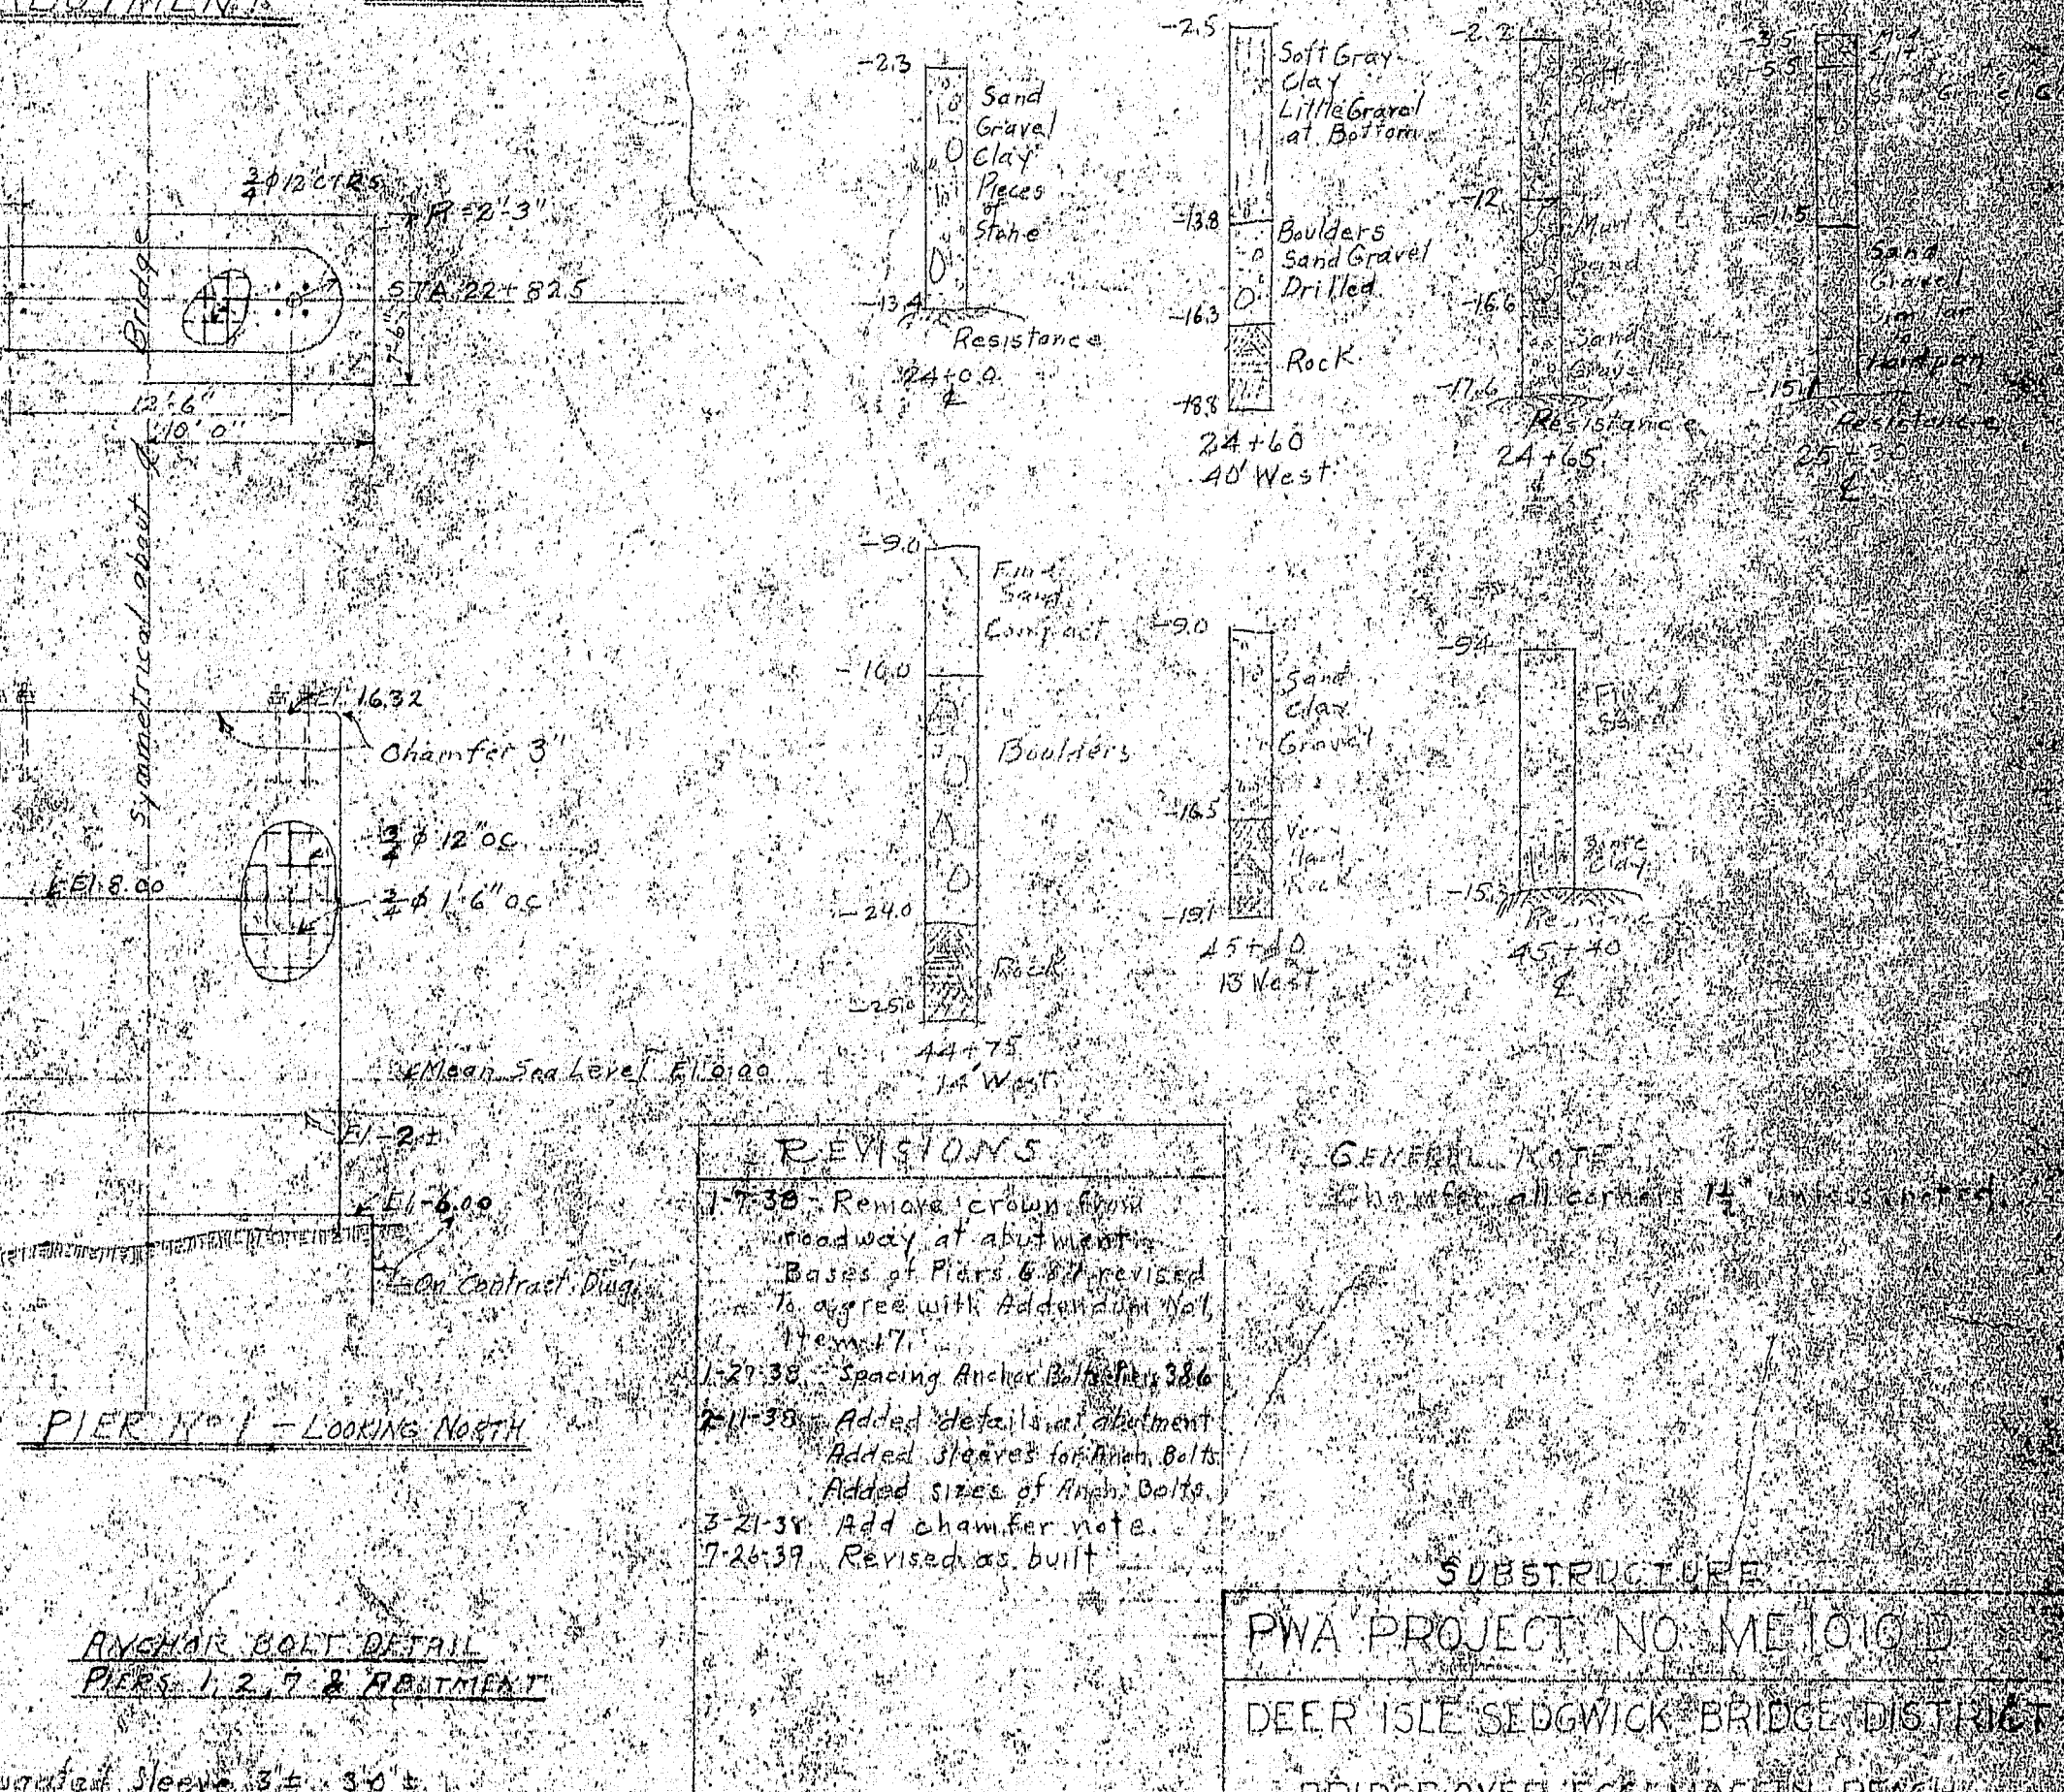


PIER NO. 1 Looking North

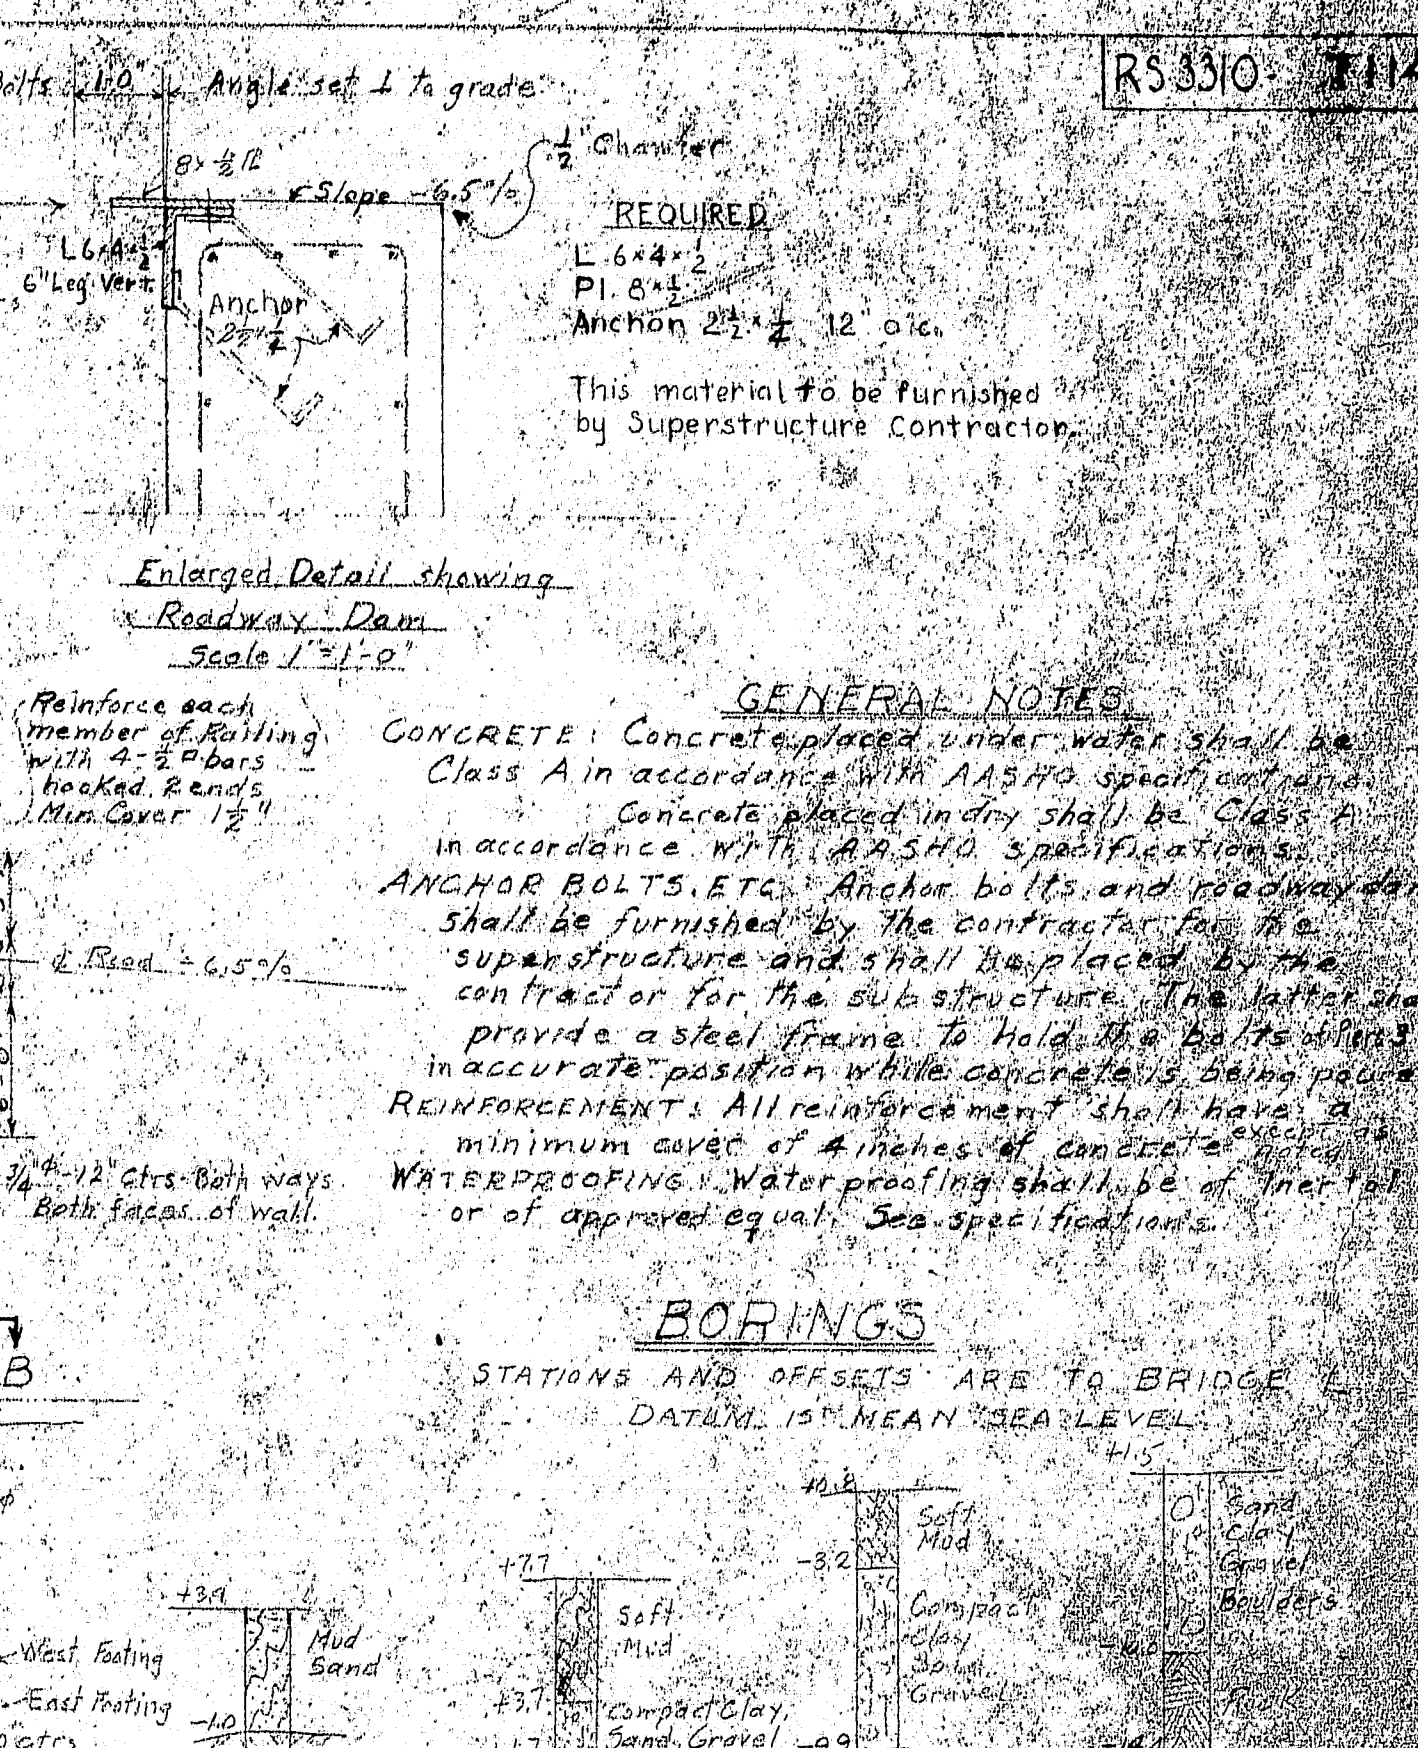


DEER ISLE ABUTMENT

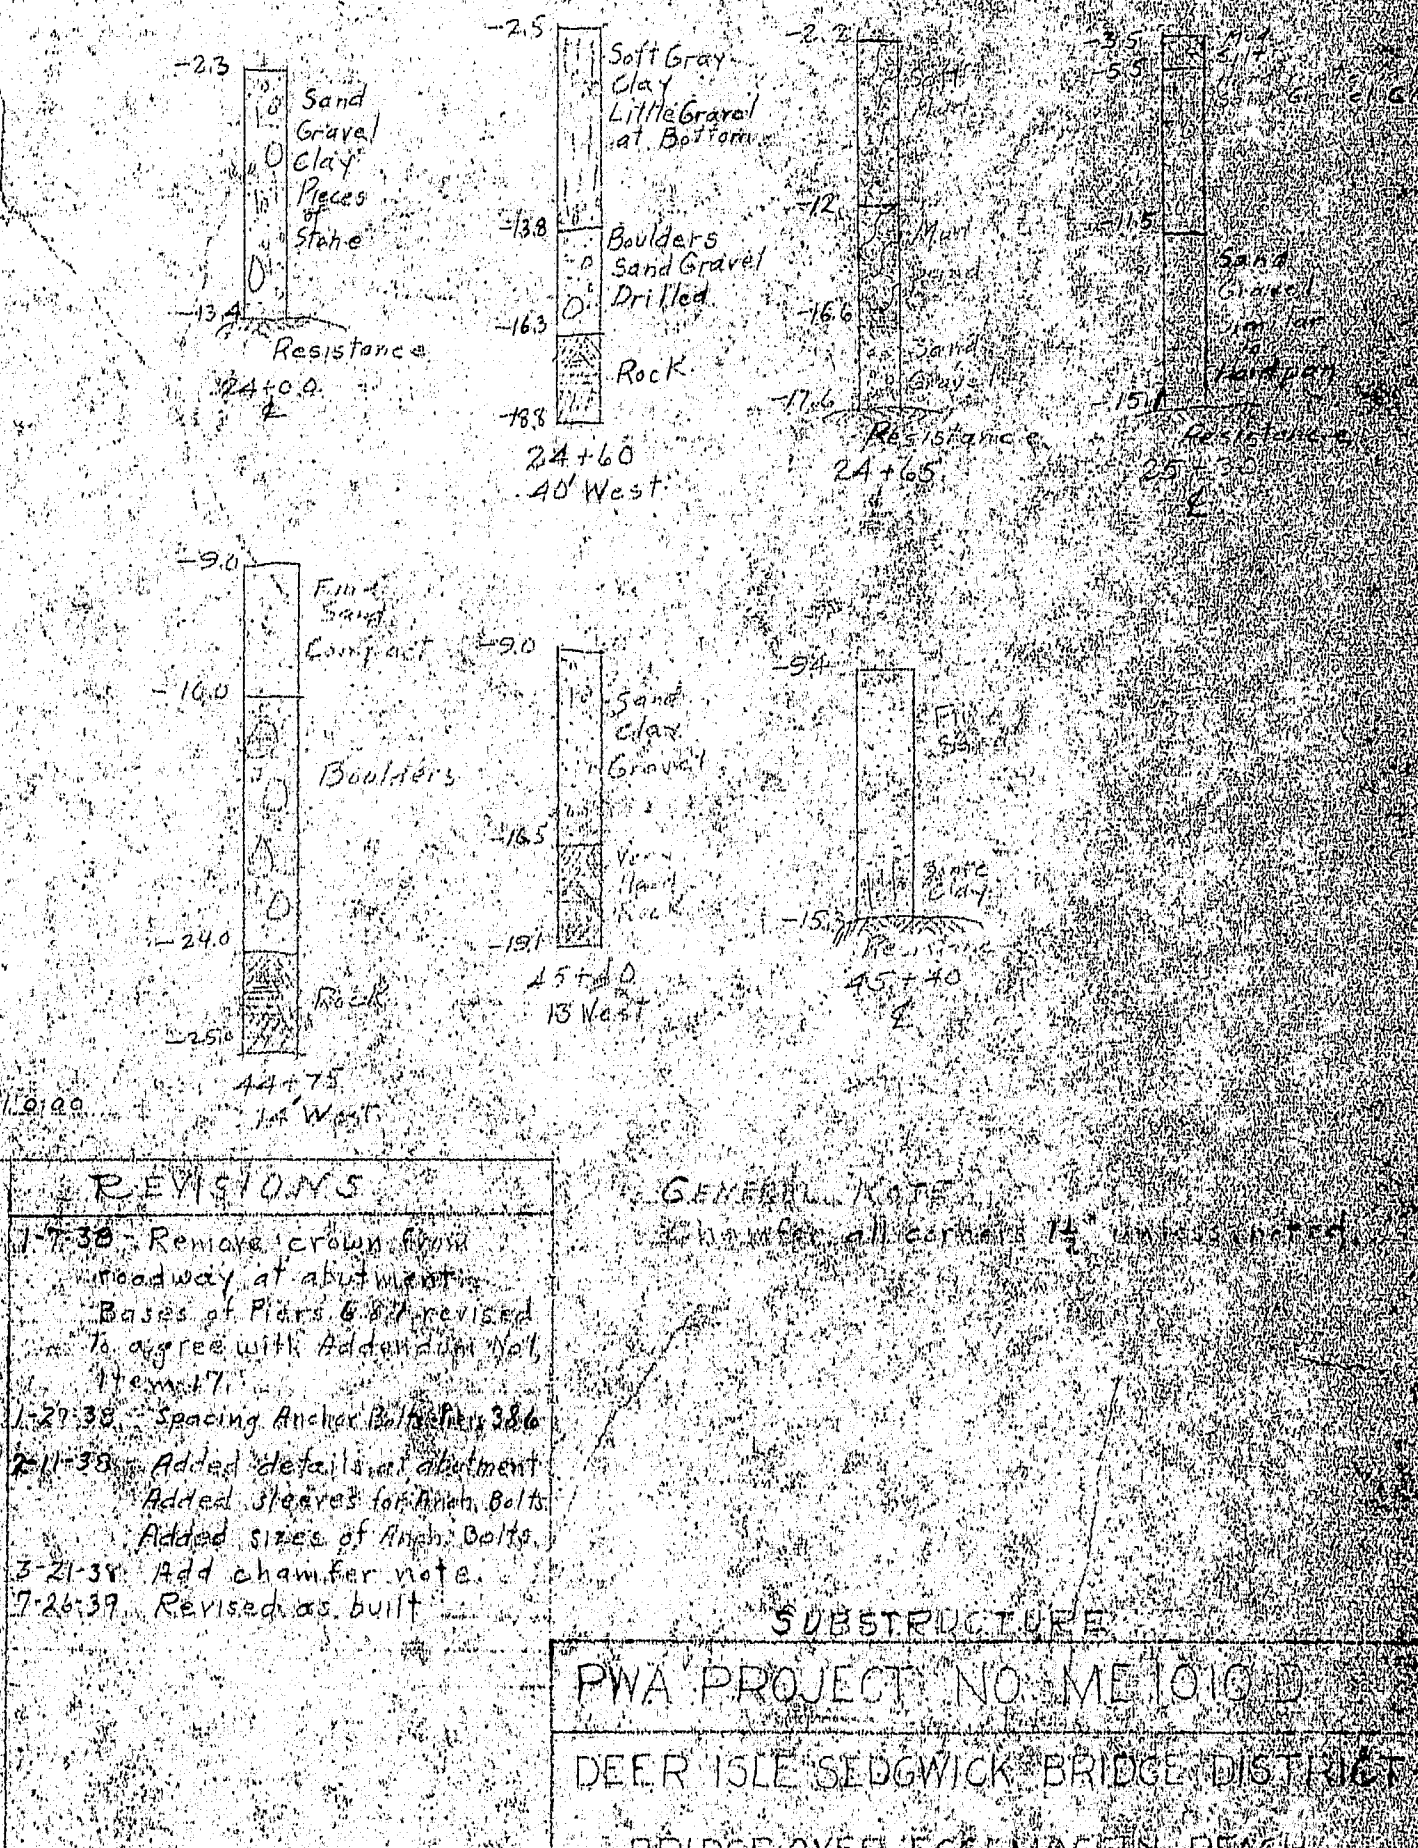


PIER NO. 1 Looking North

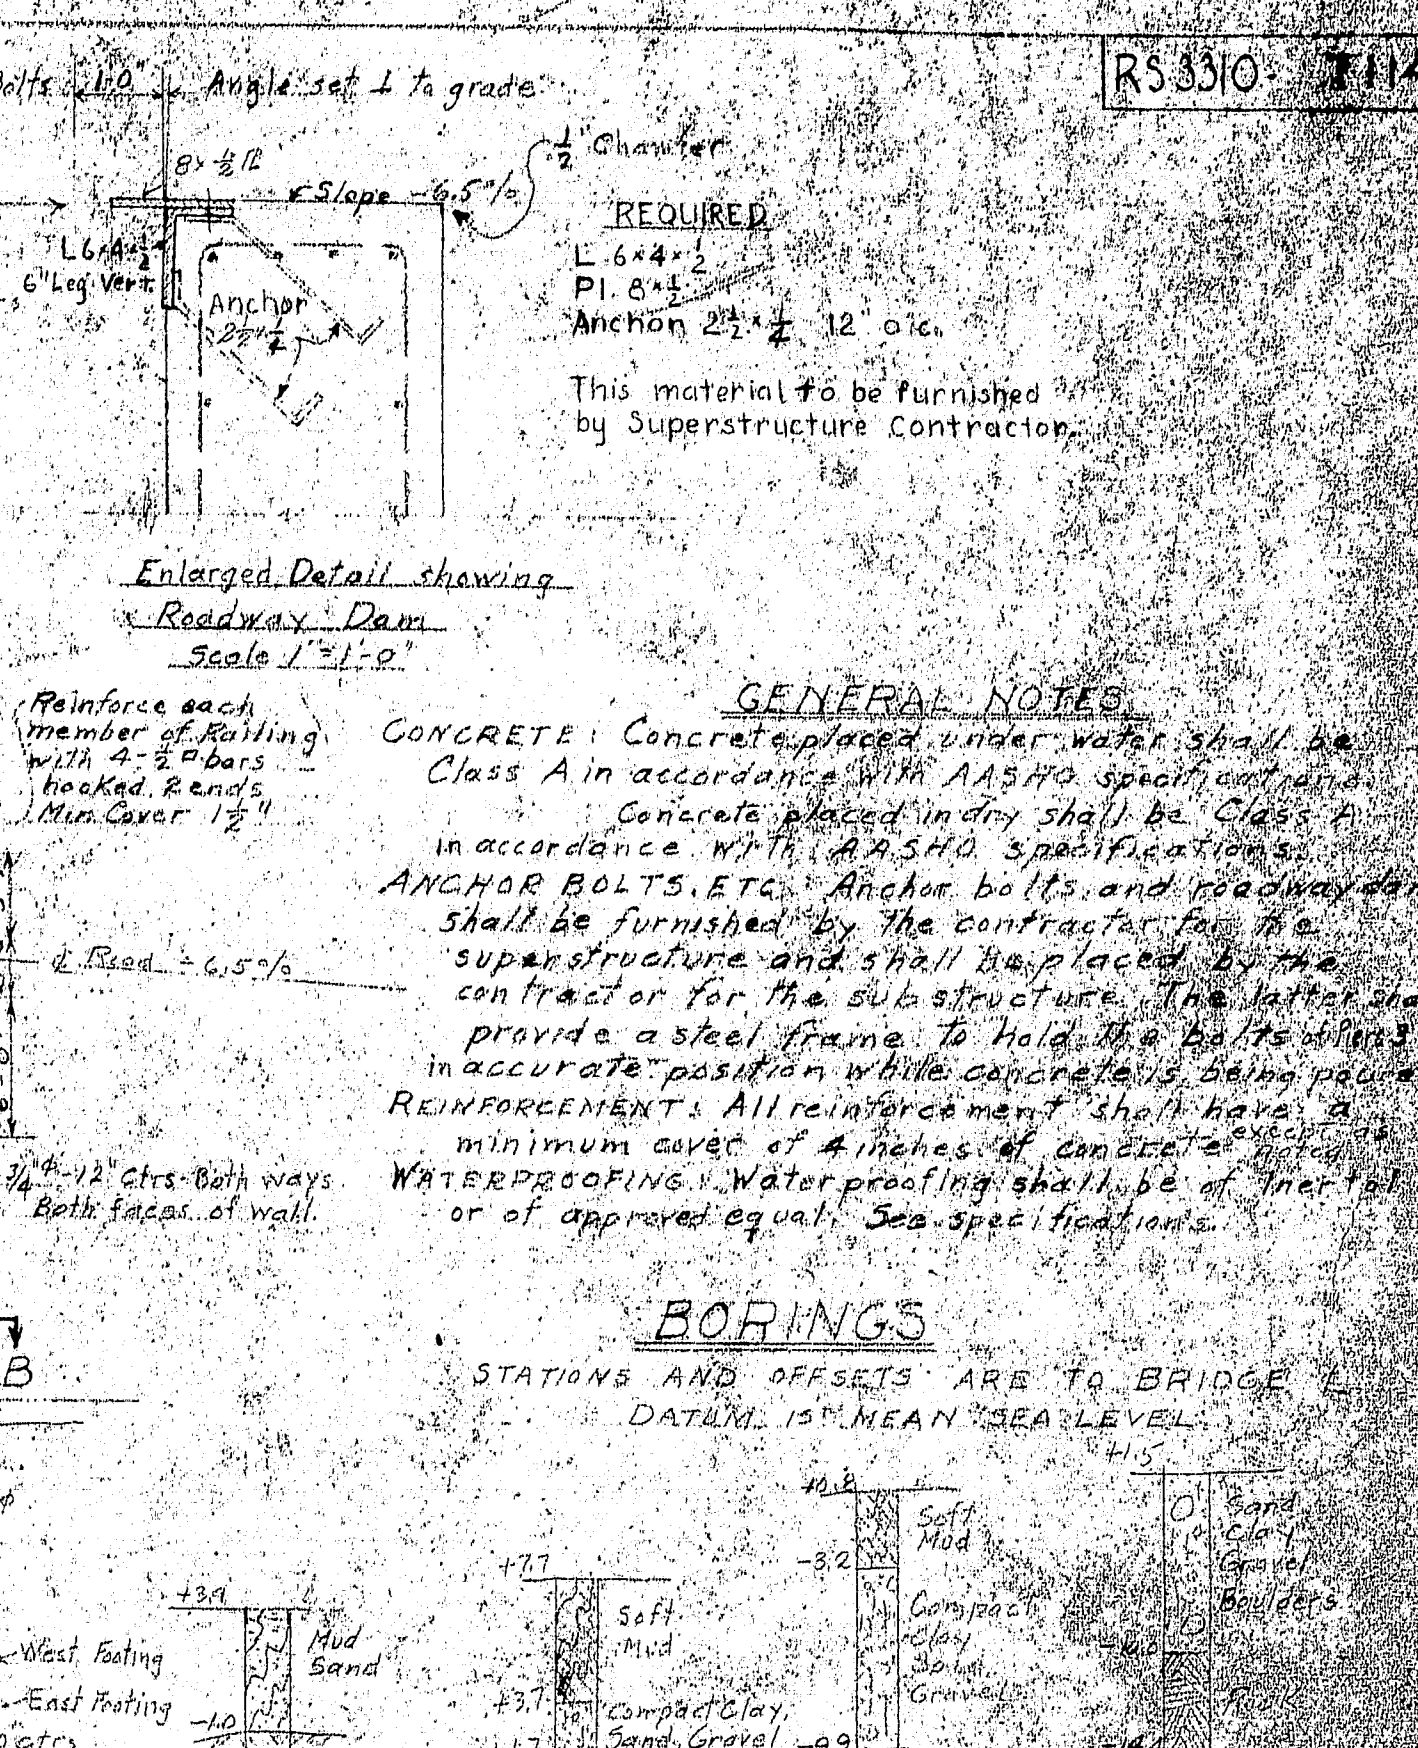


DEER ISLE ABUTMENT

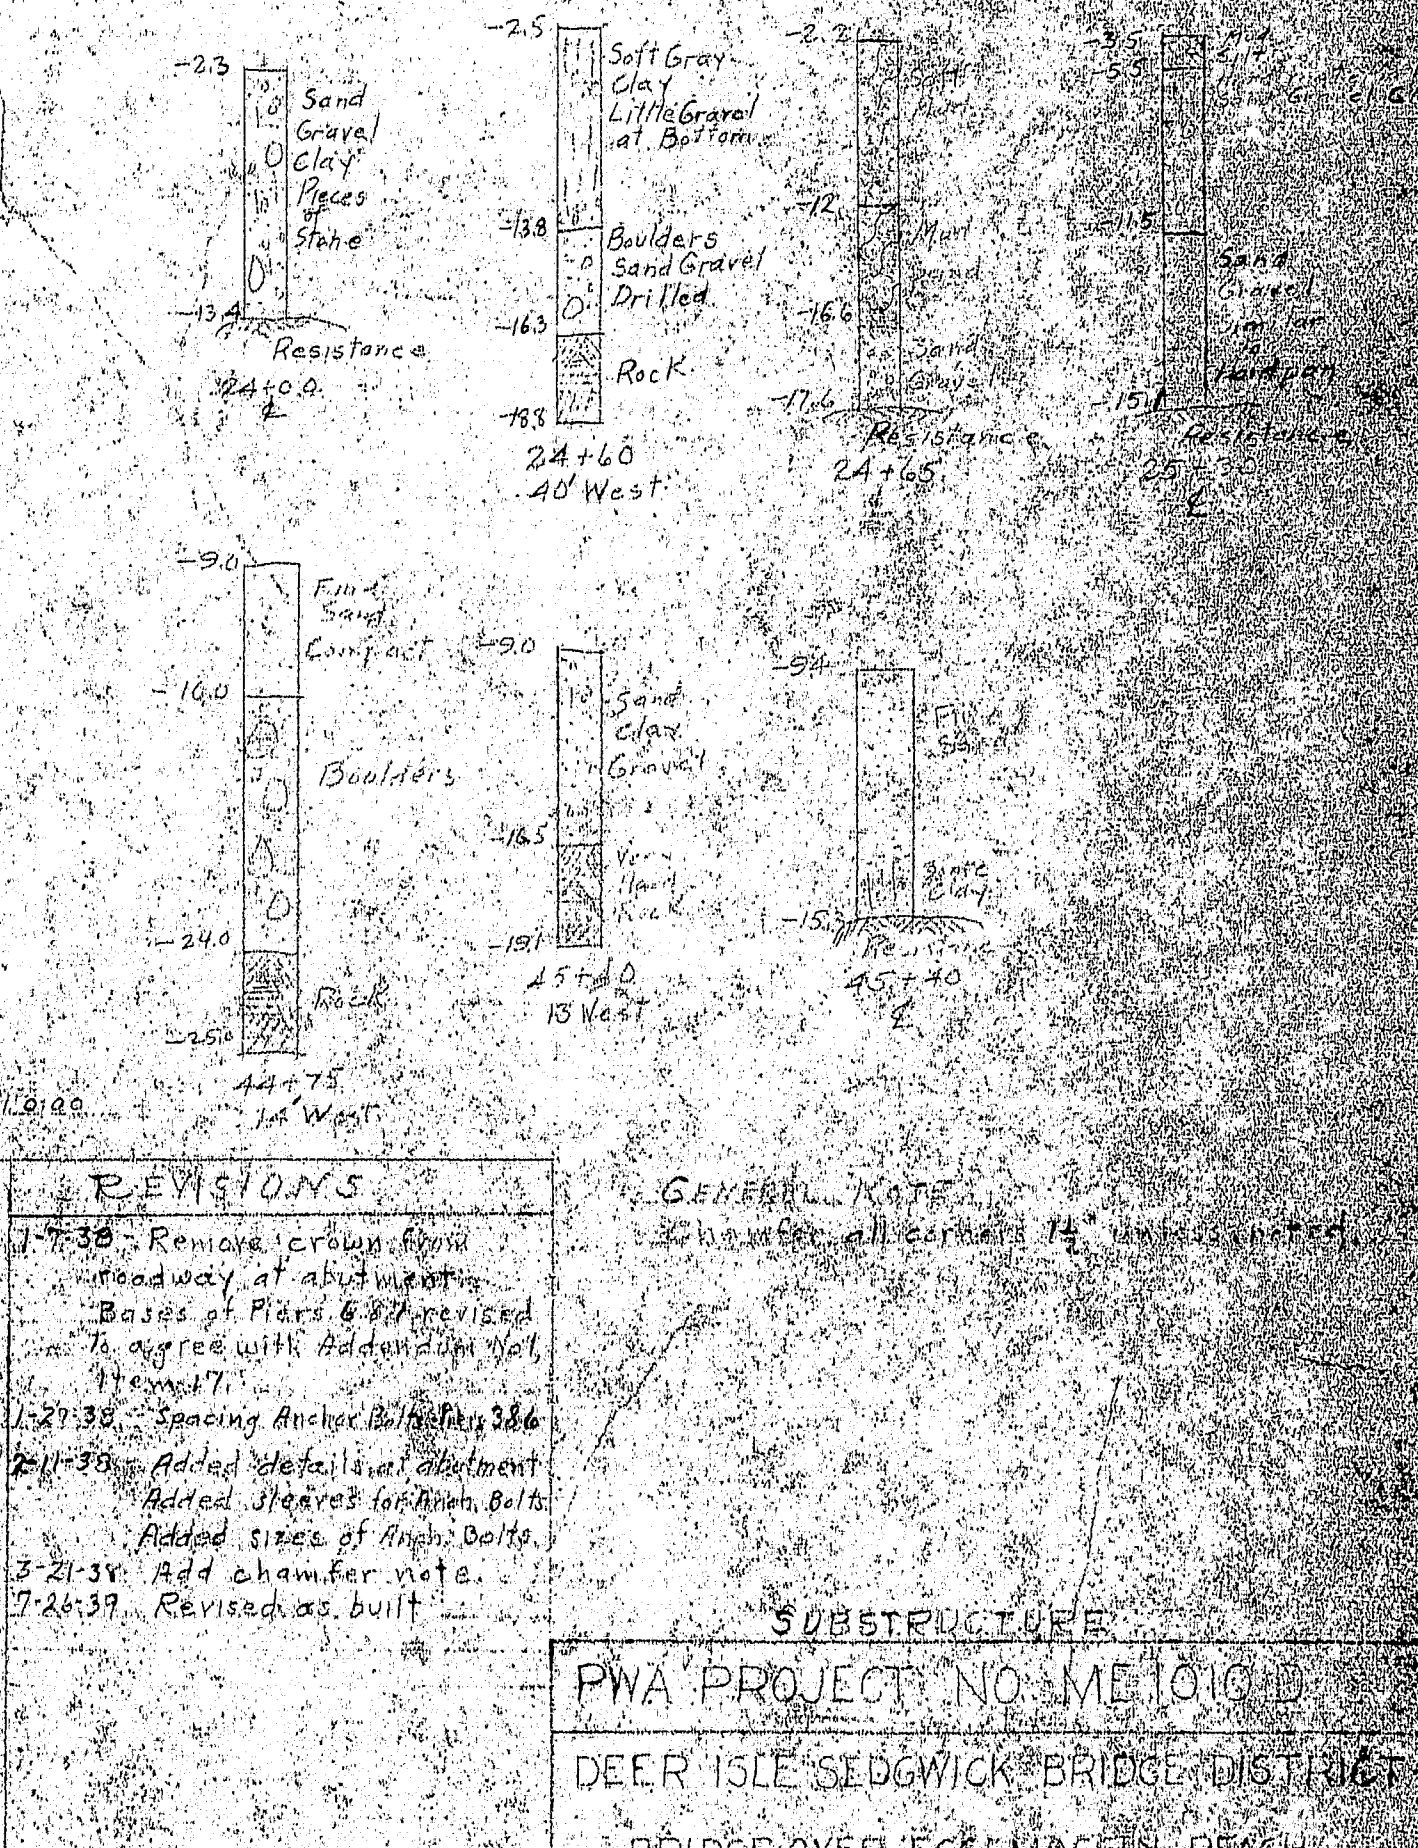


PIER NO. 1 Looking North

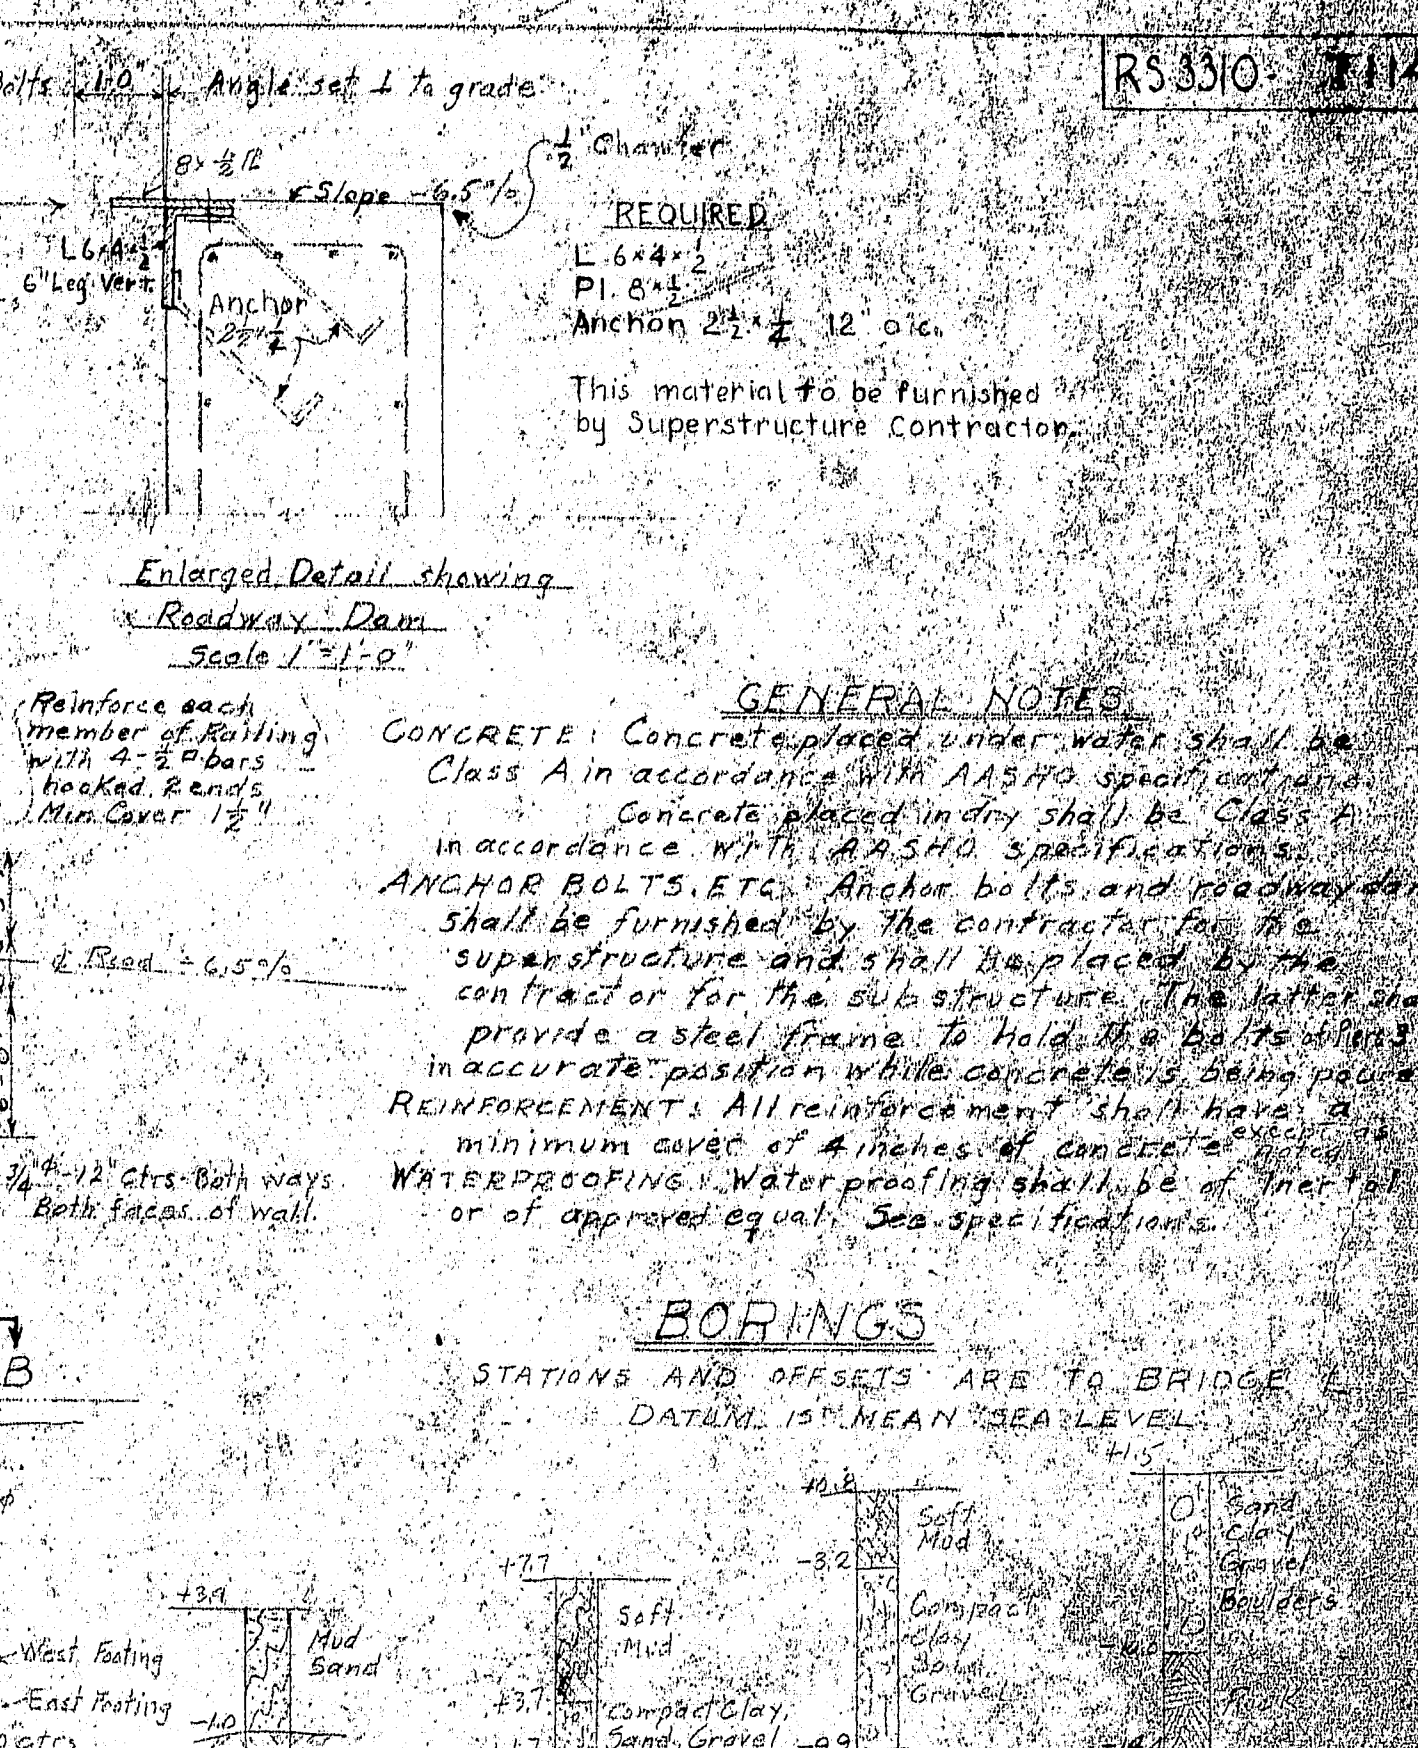


DEER ISLE ABUTMENT

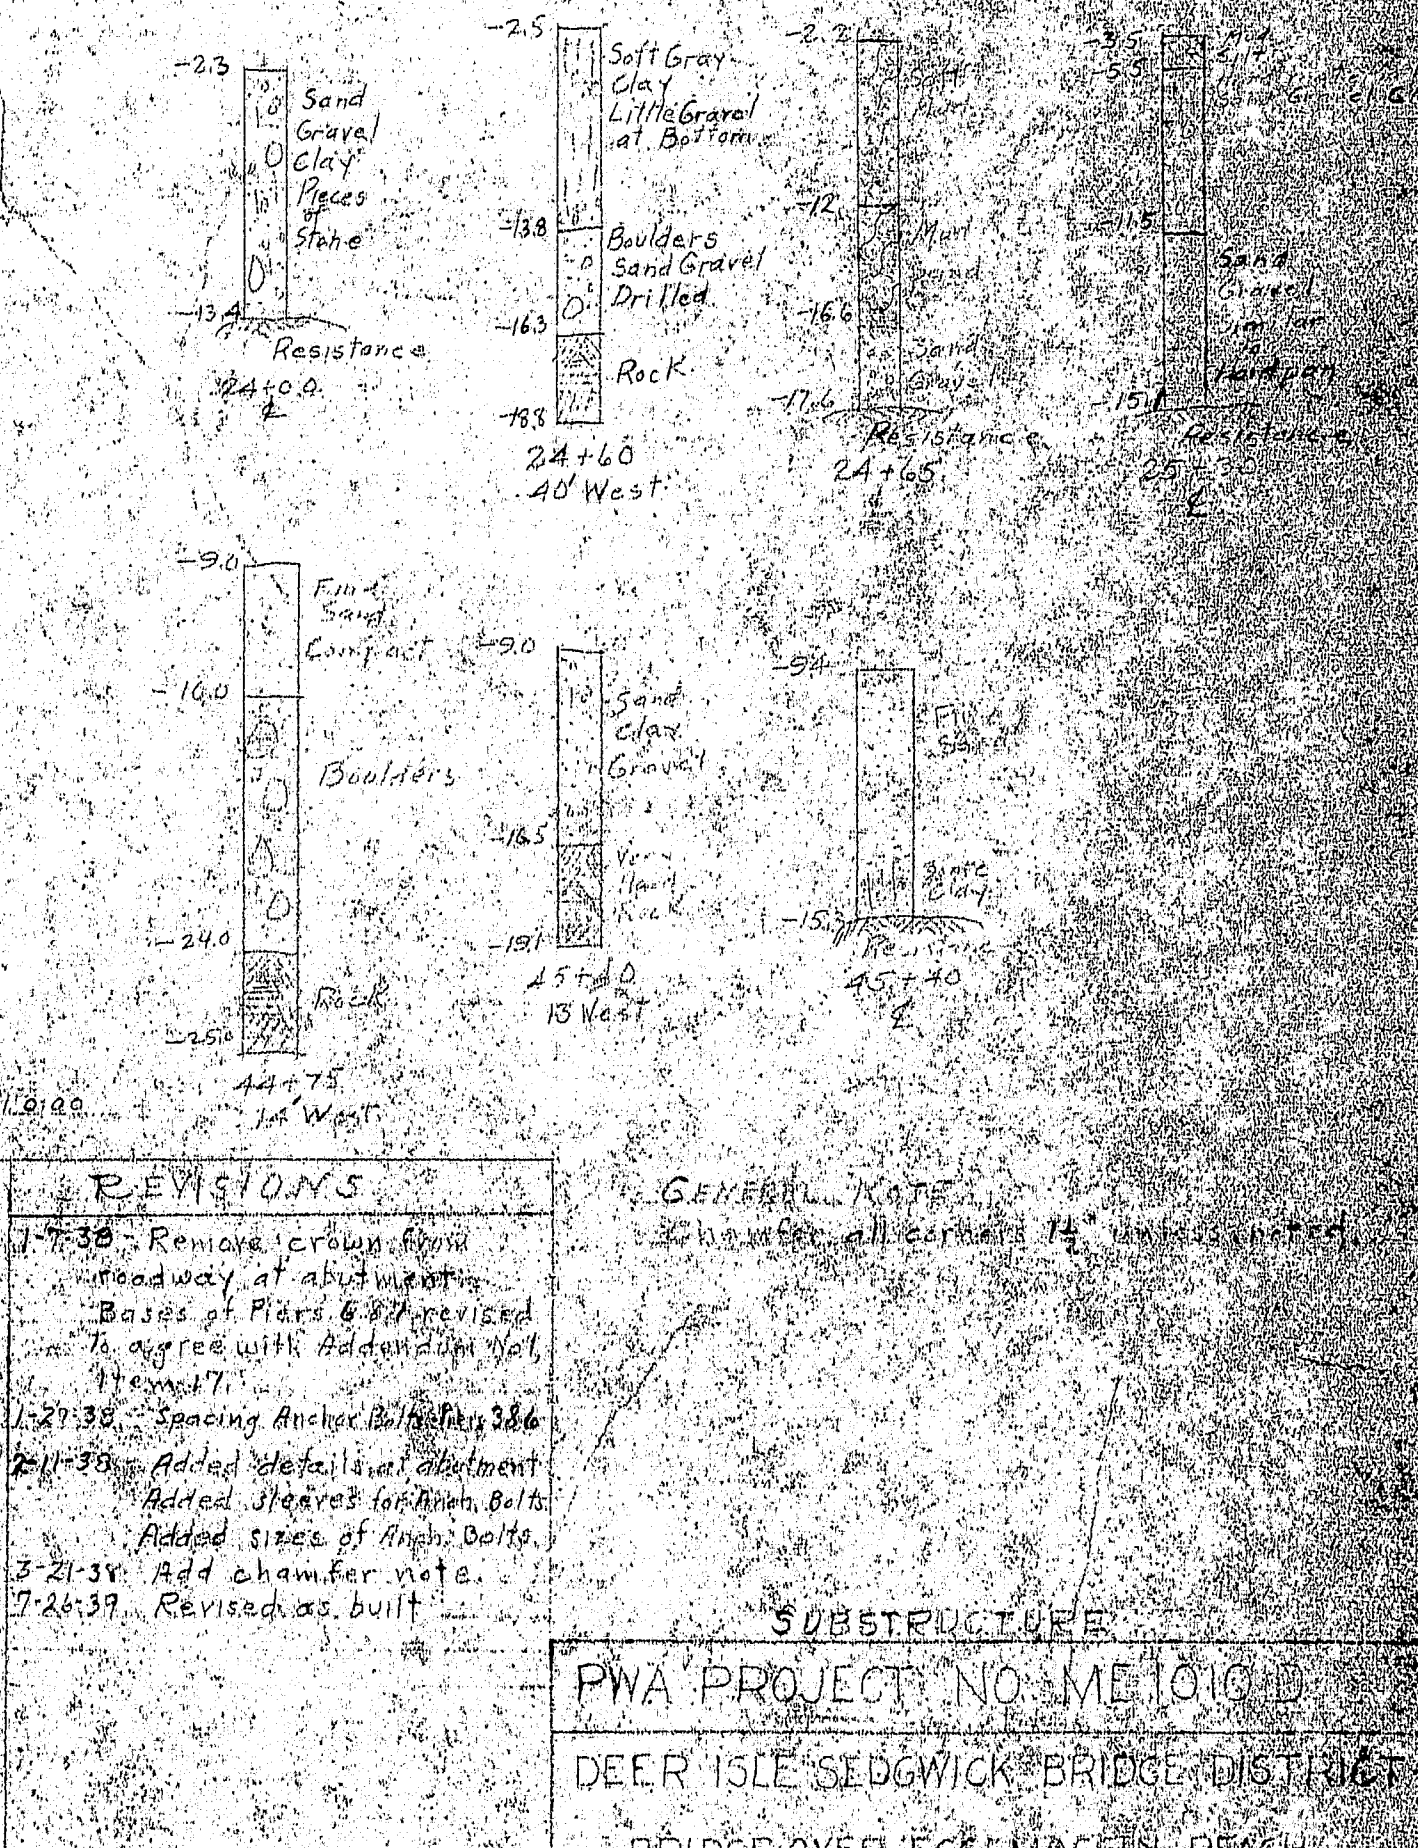


PIER NO. 1 Looking North

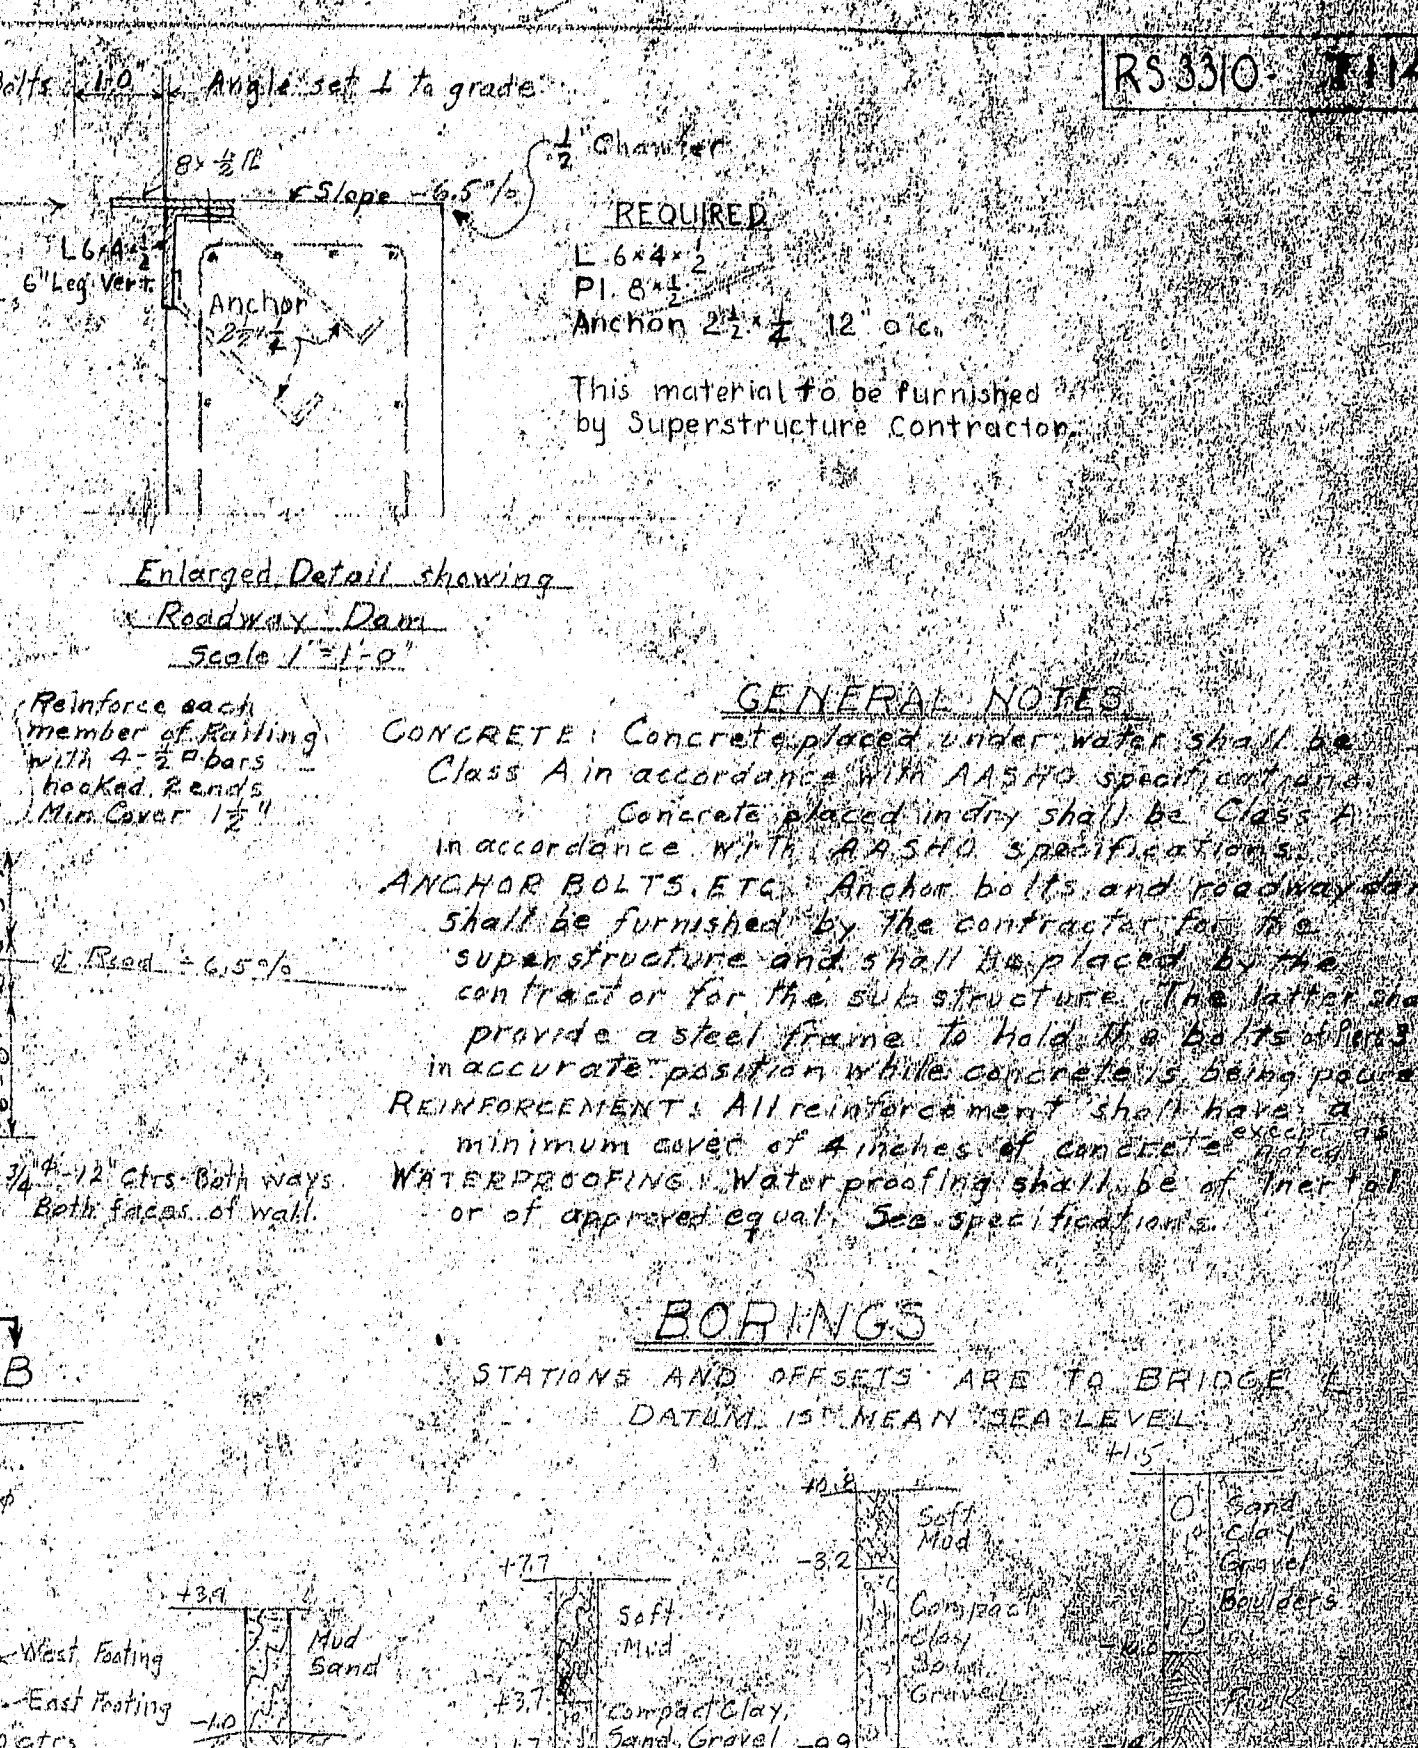


DEER ISLE ABUTMENT

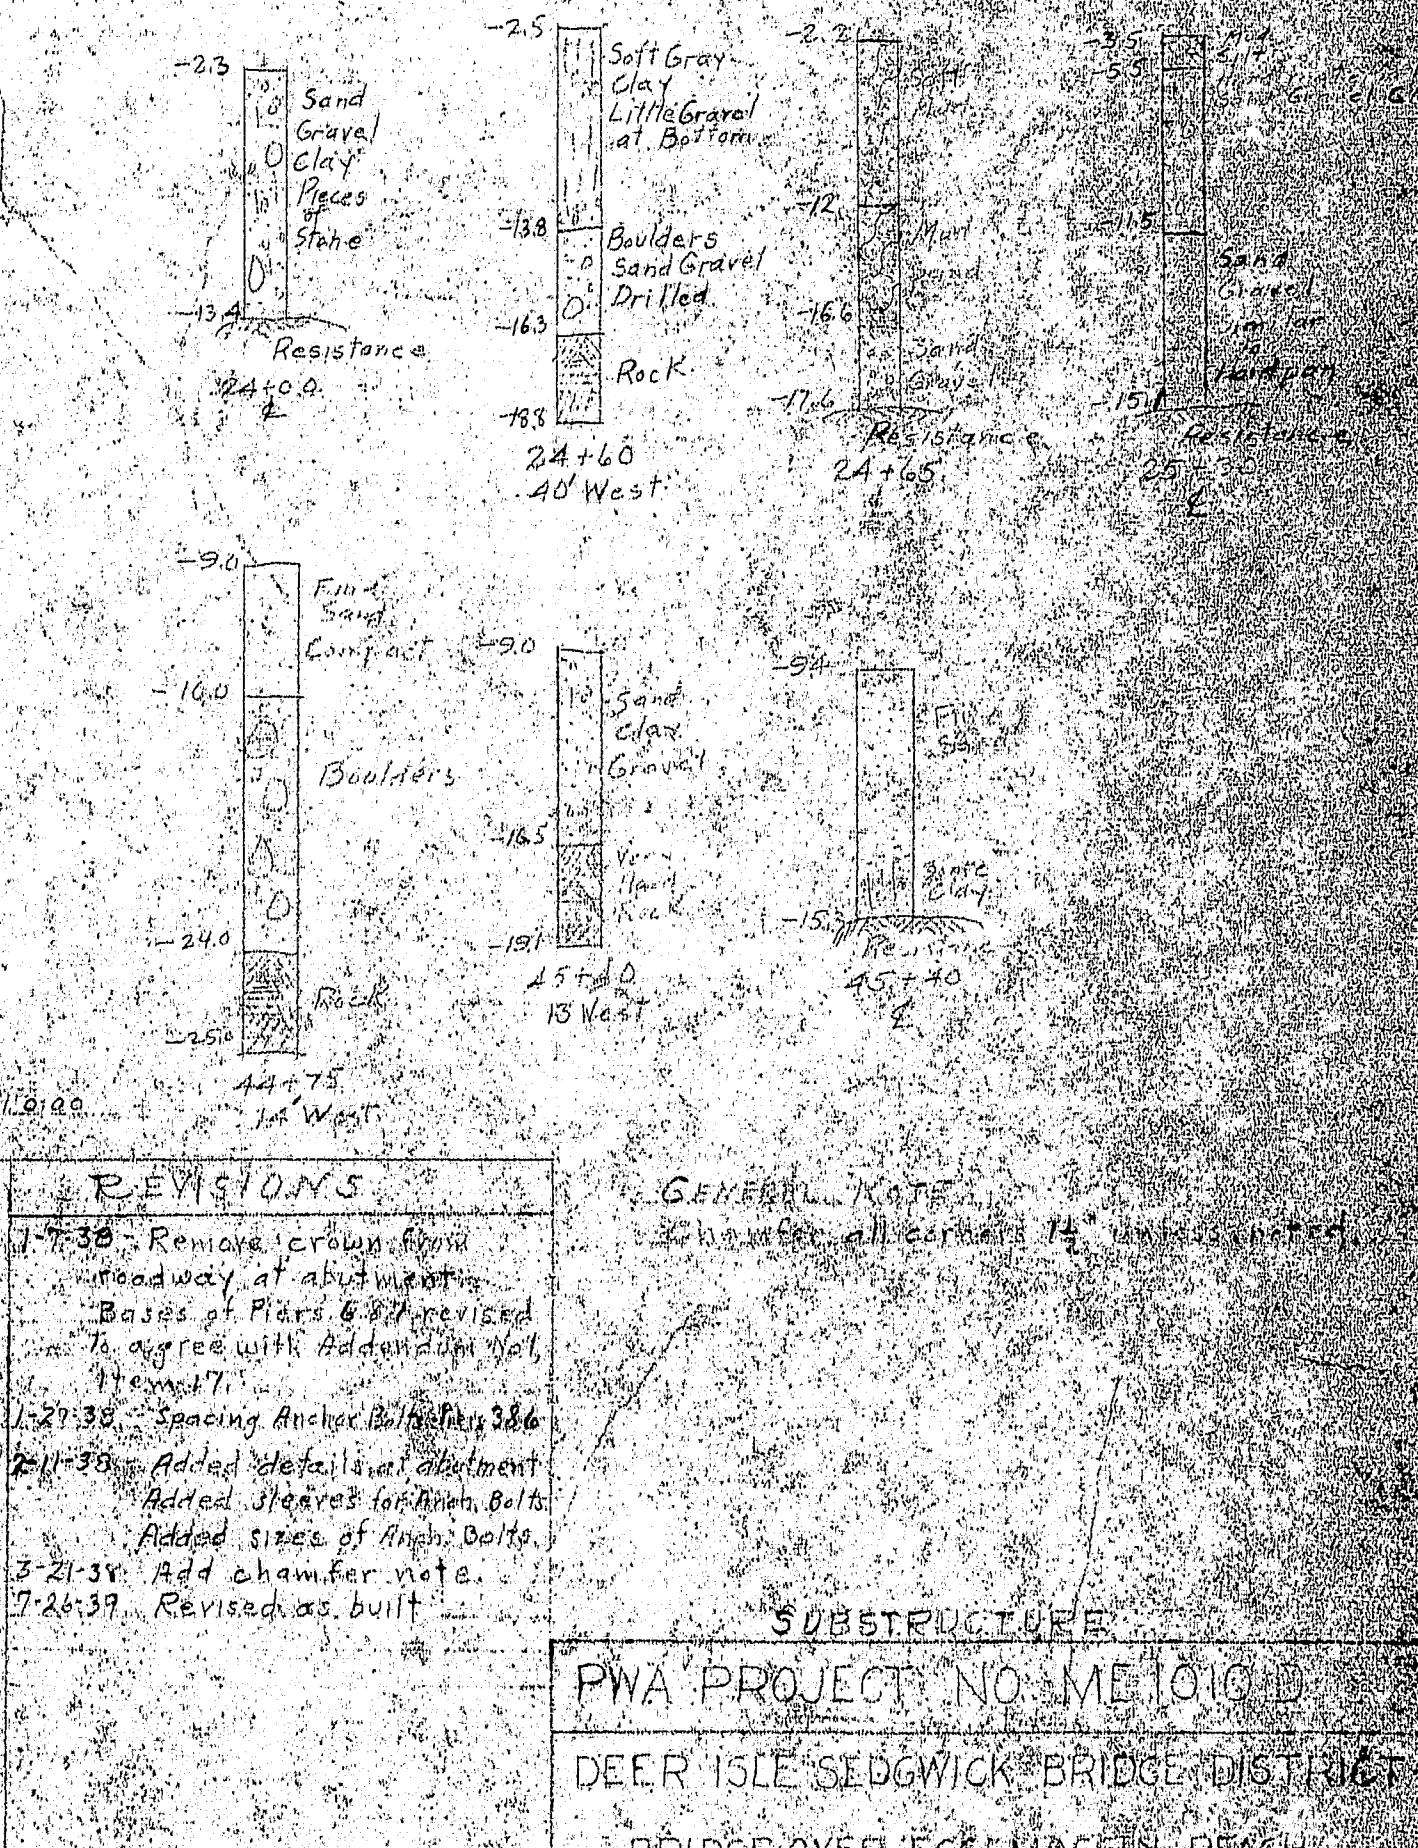


PIER NO. 1 Looking North

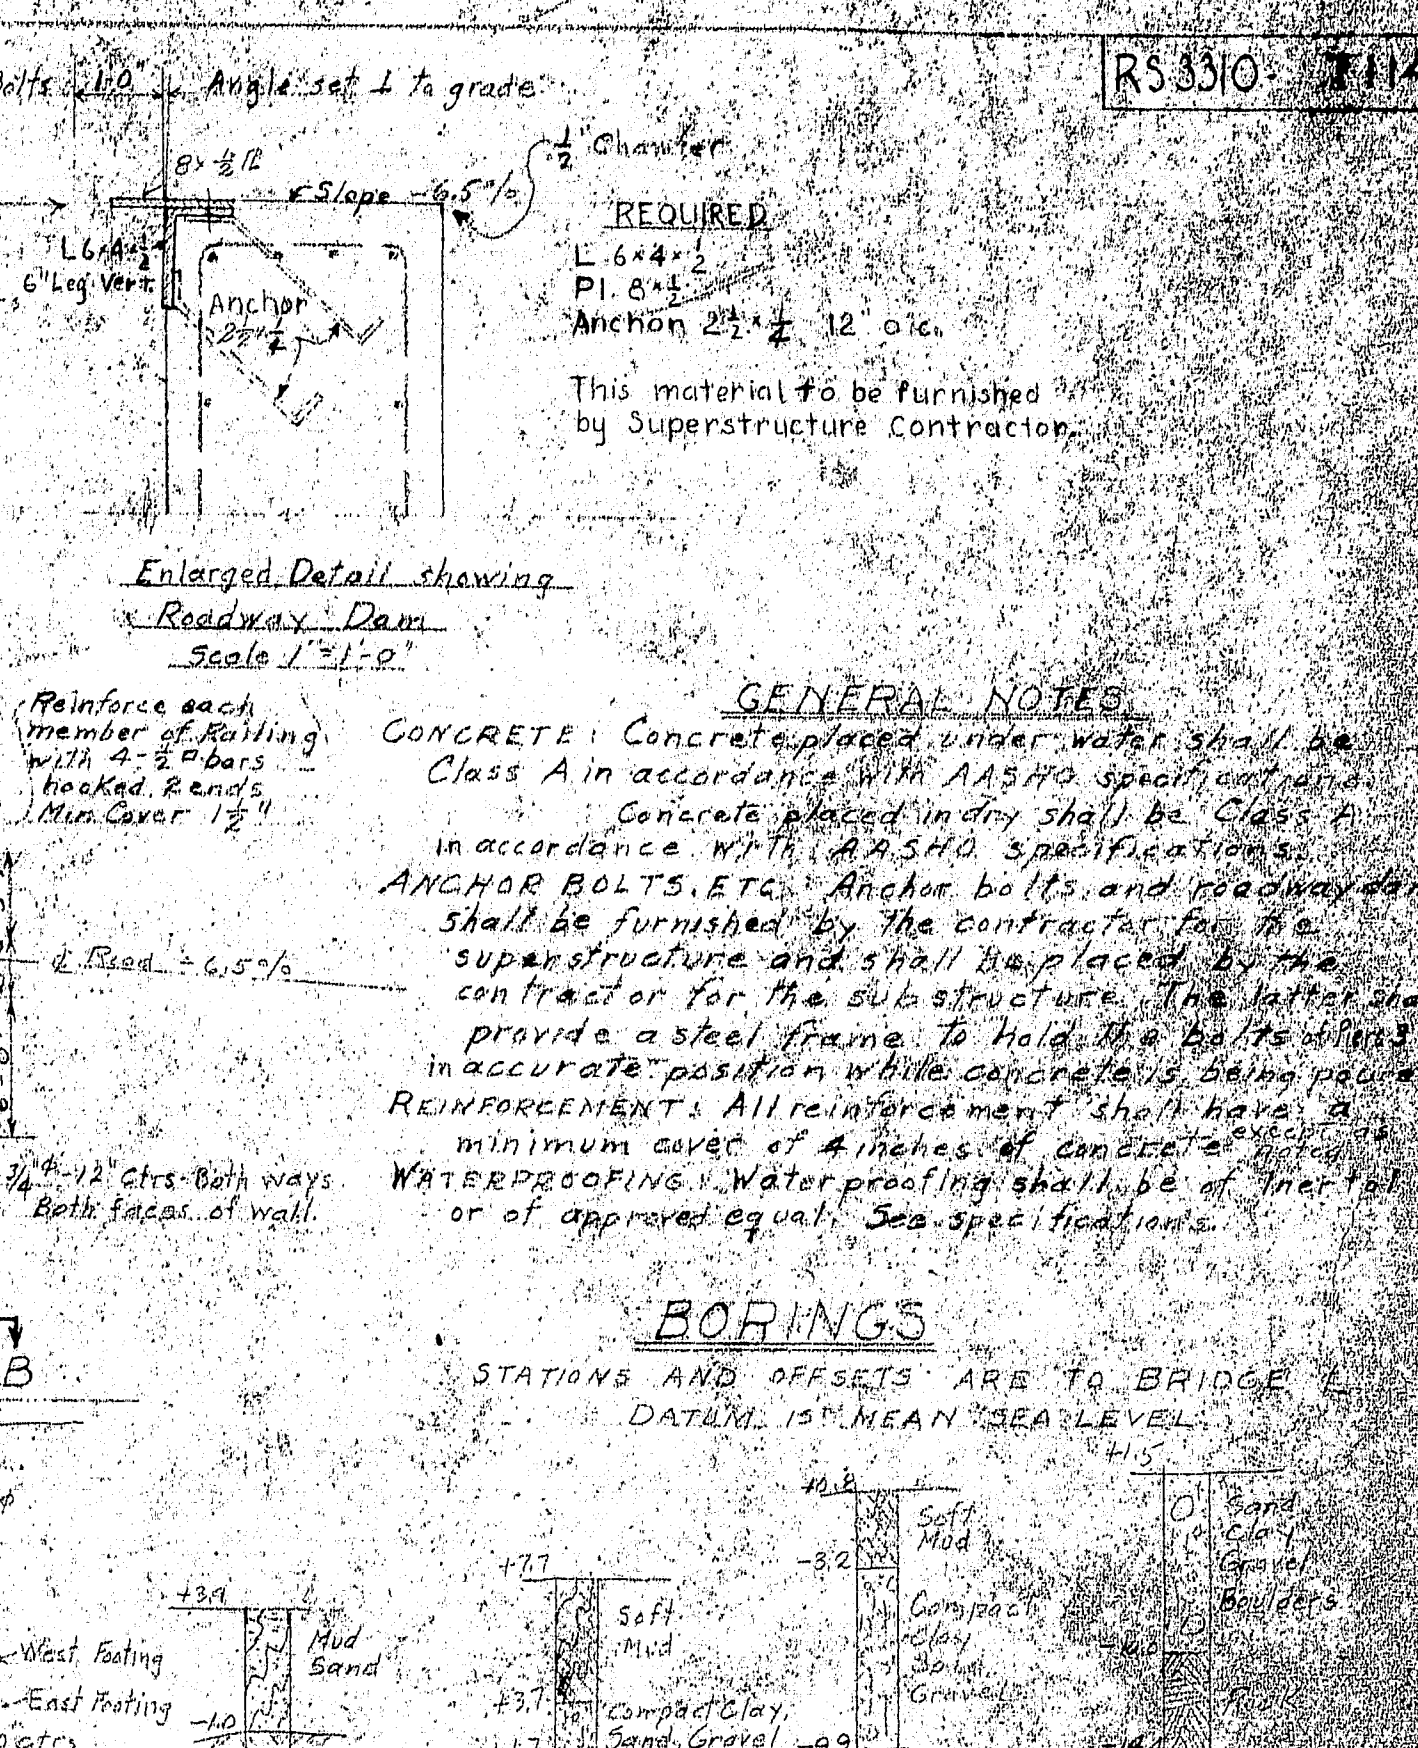


DEER ISLE ABUTMENT

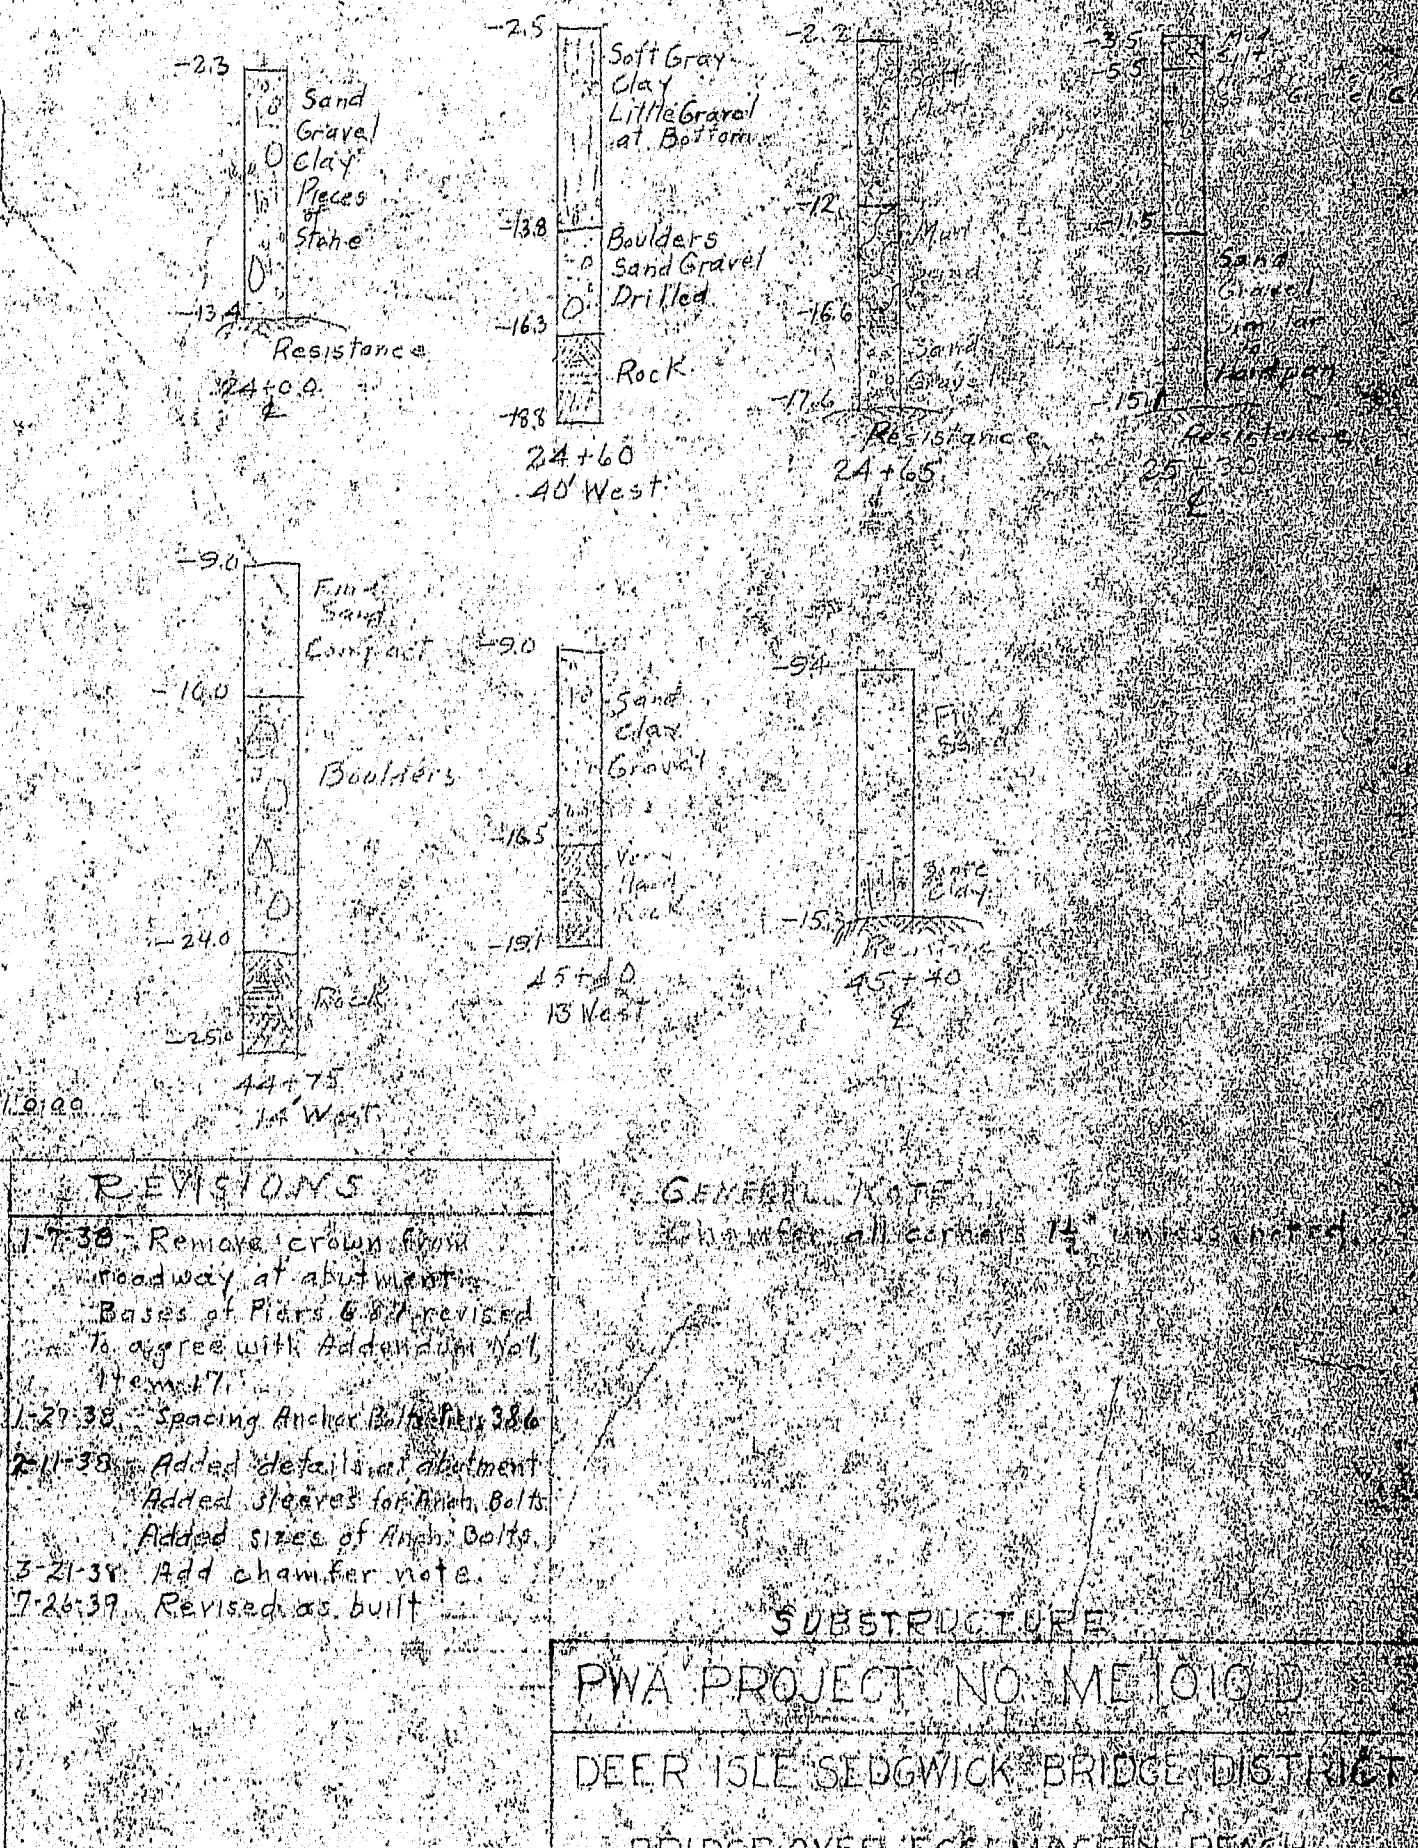


PIER NO. 1 Looking North

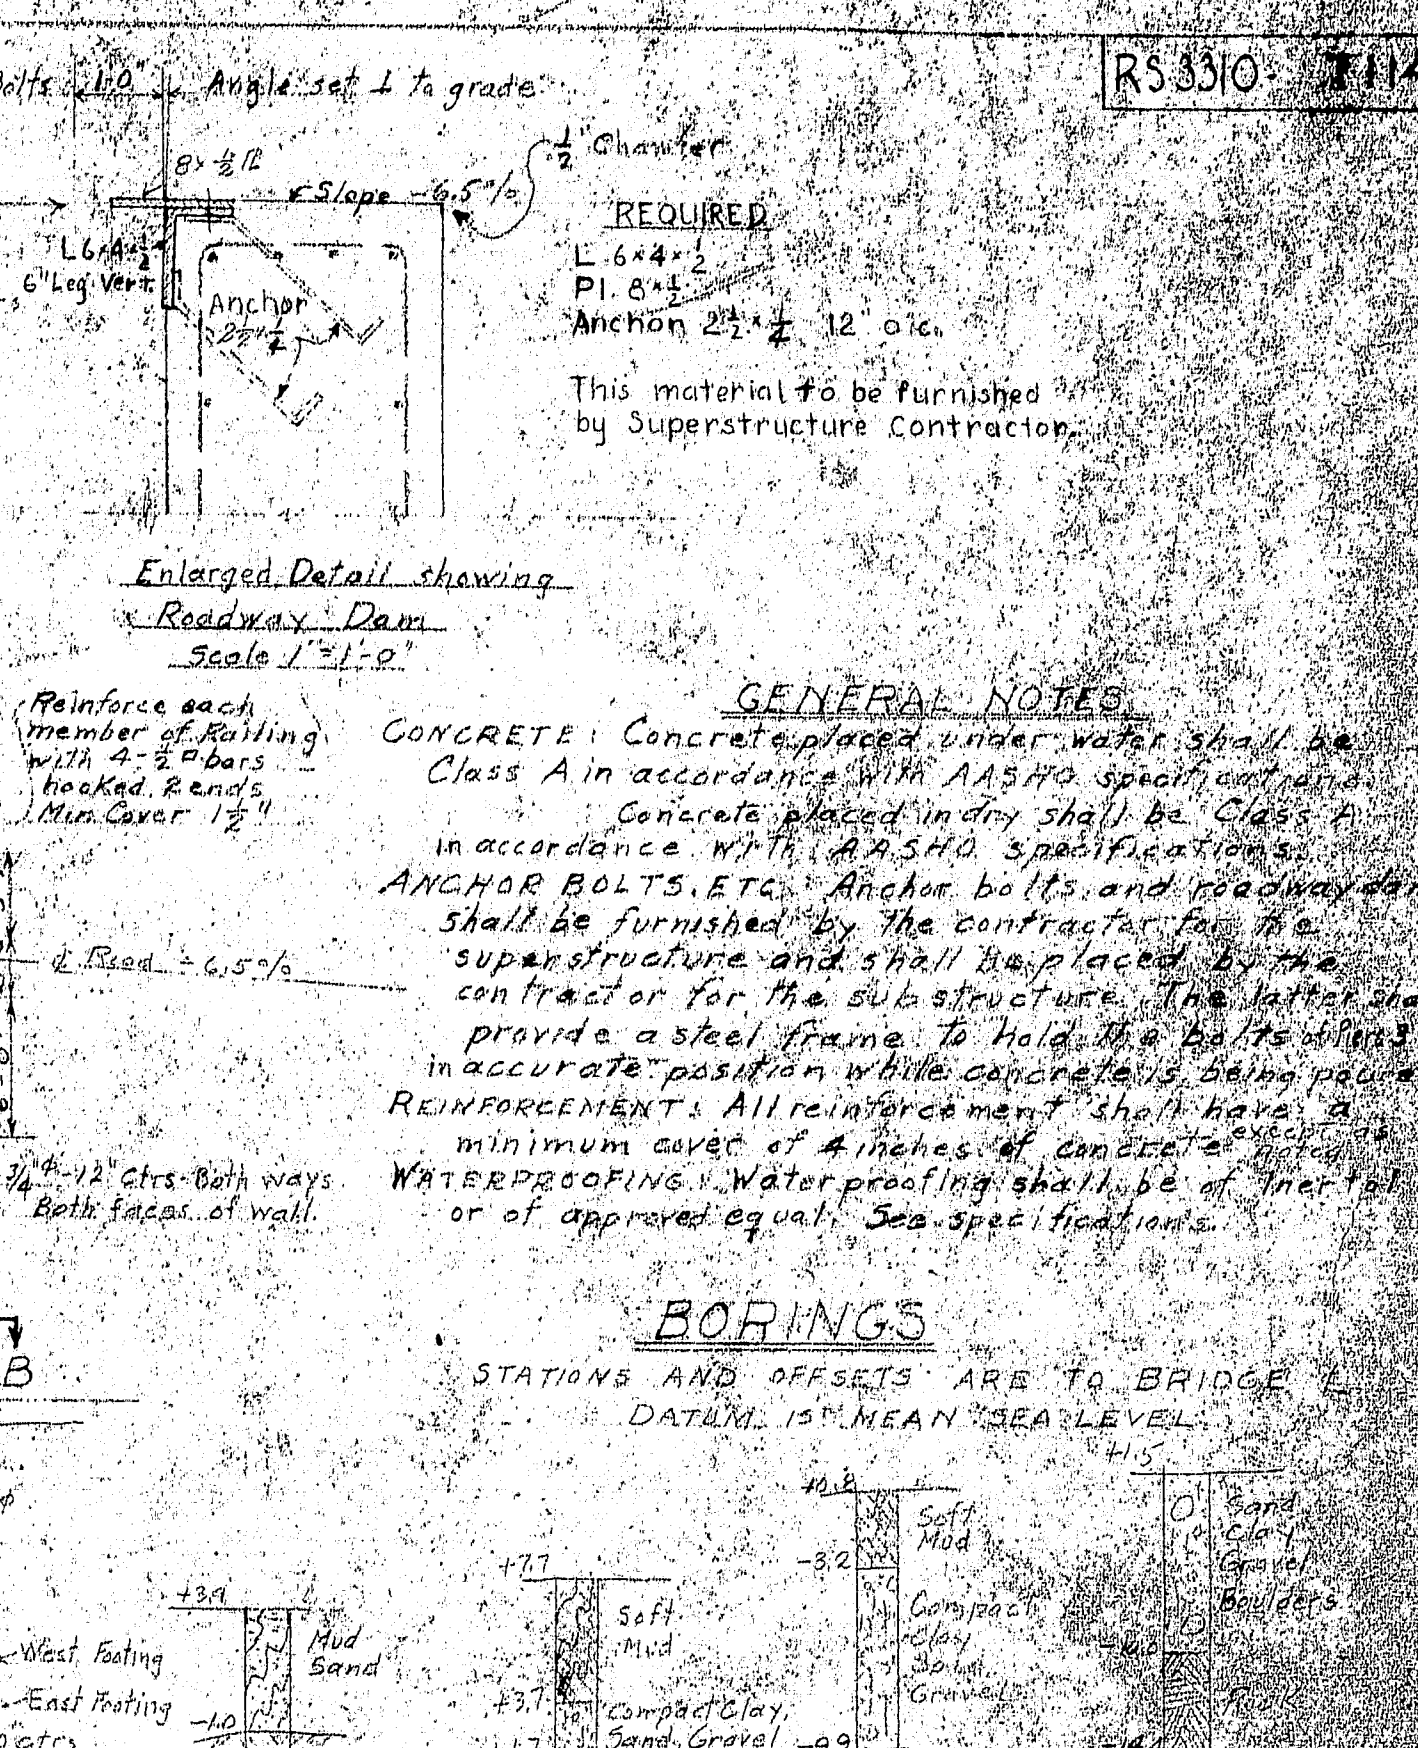


DEER ISLE ABUTMENT

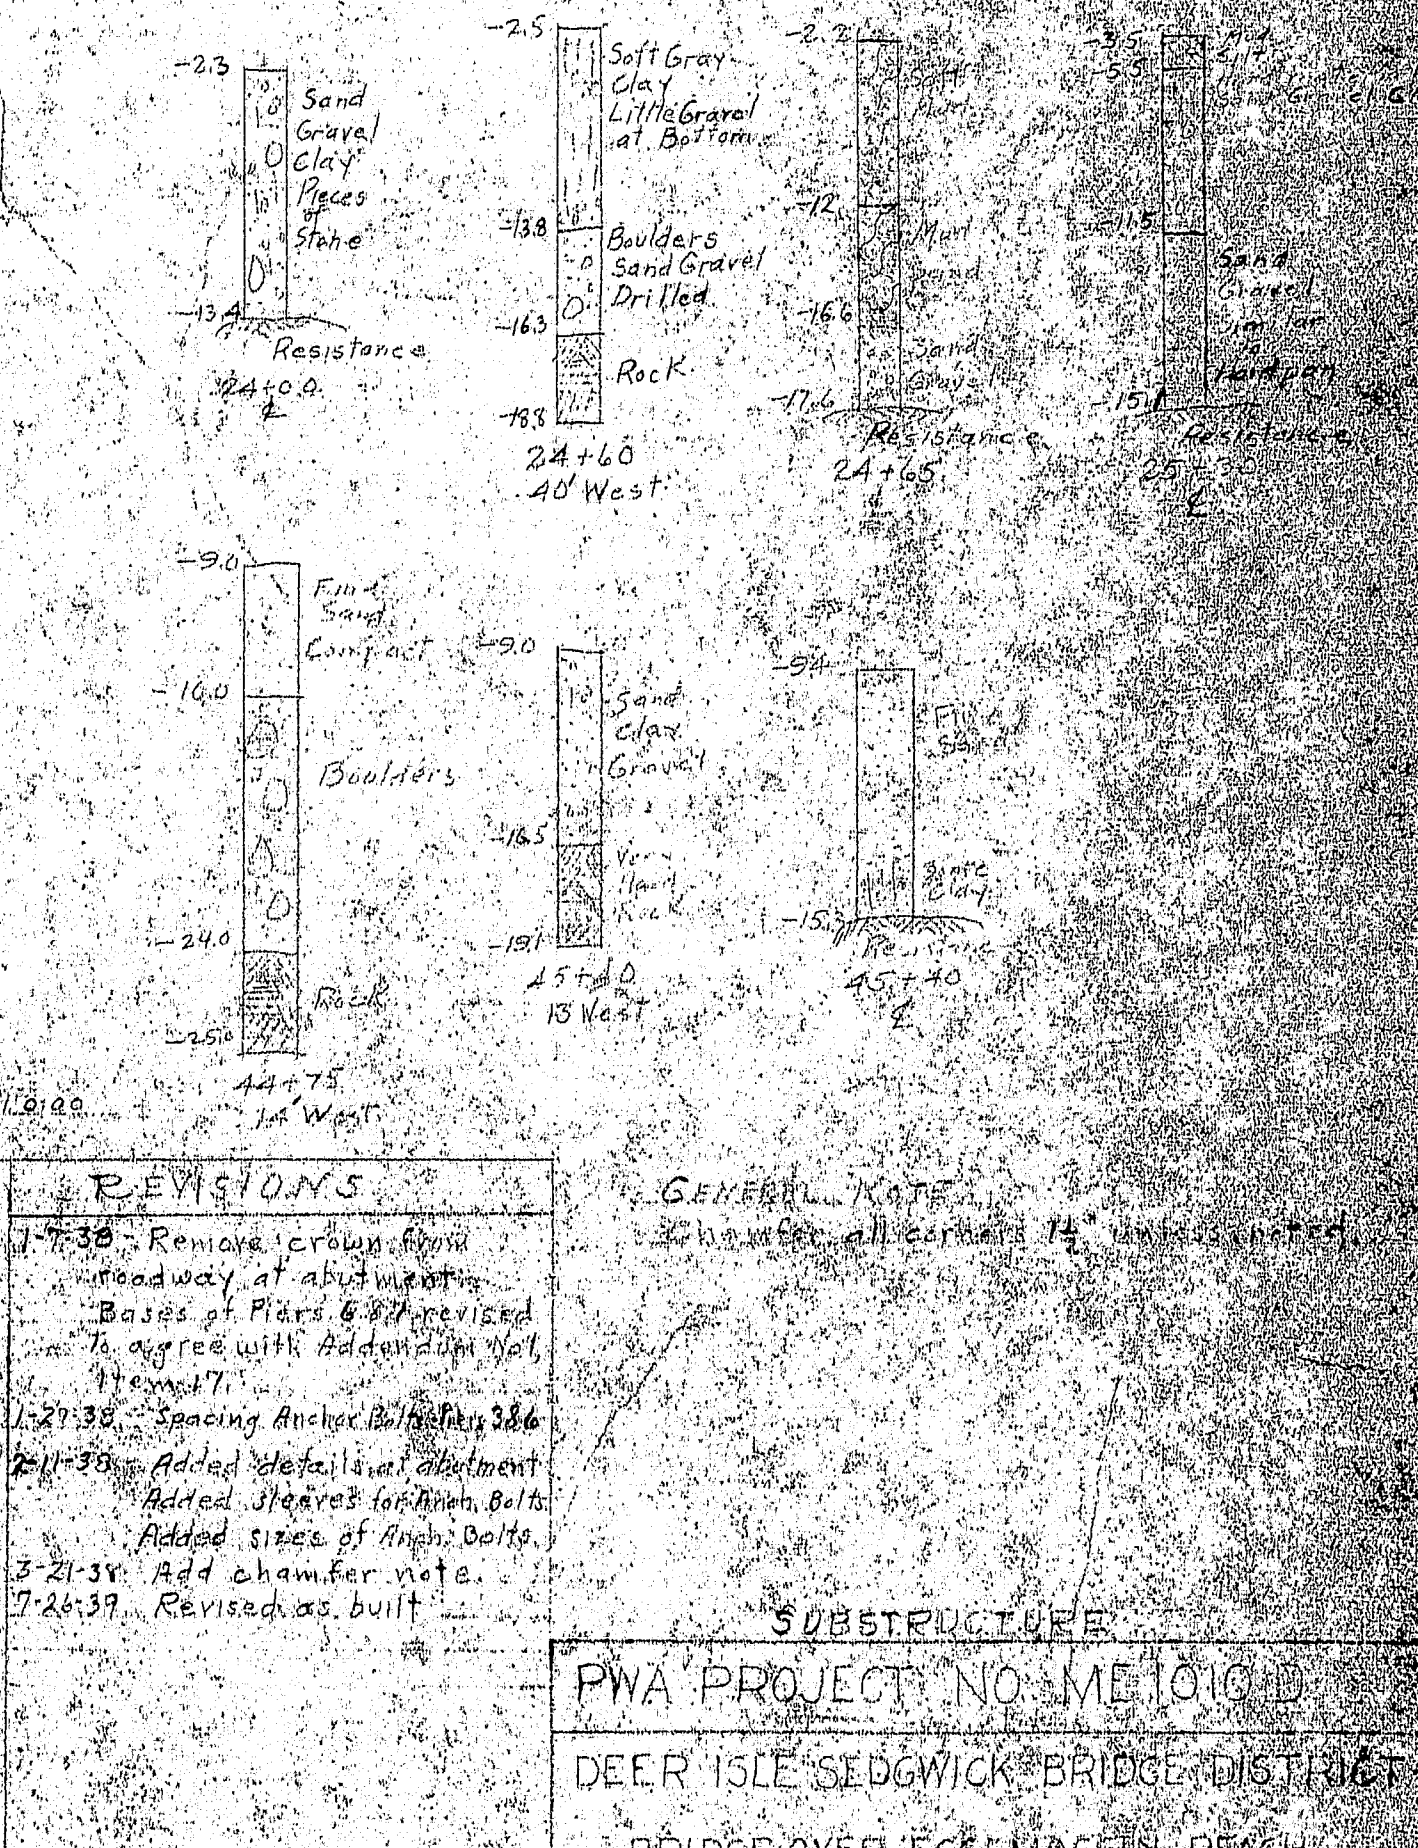


PIER NO. 1 Looking North

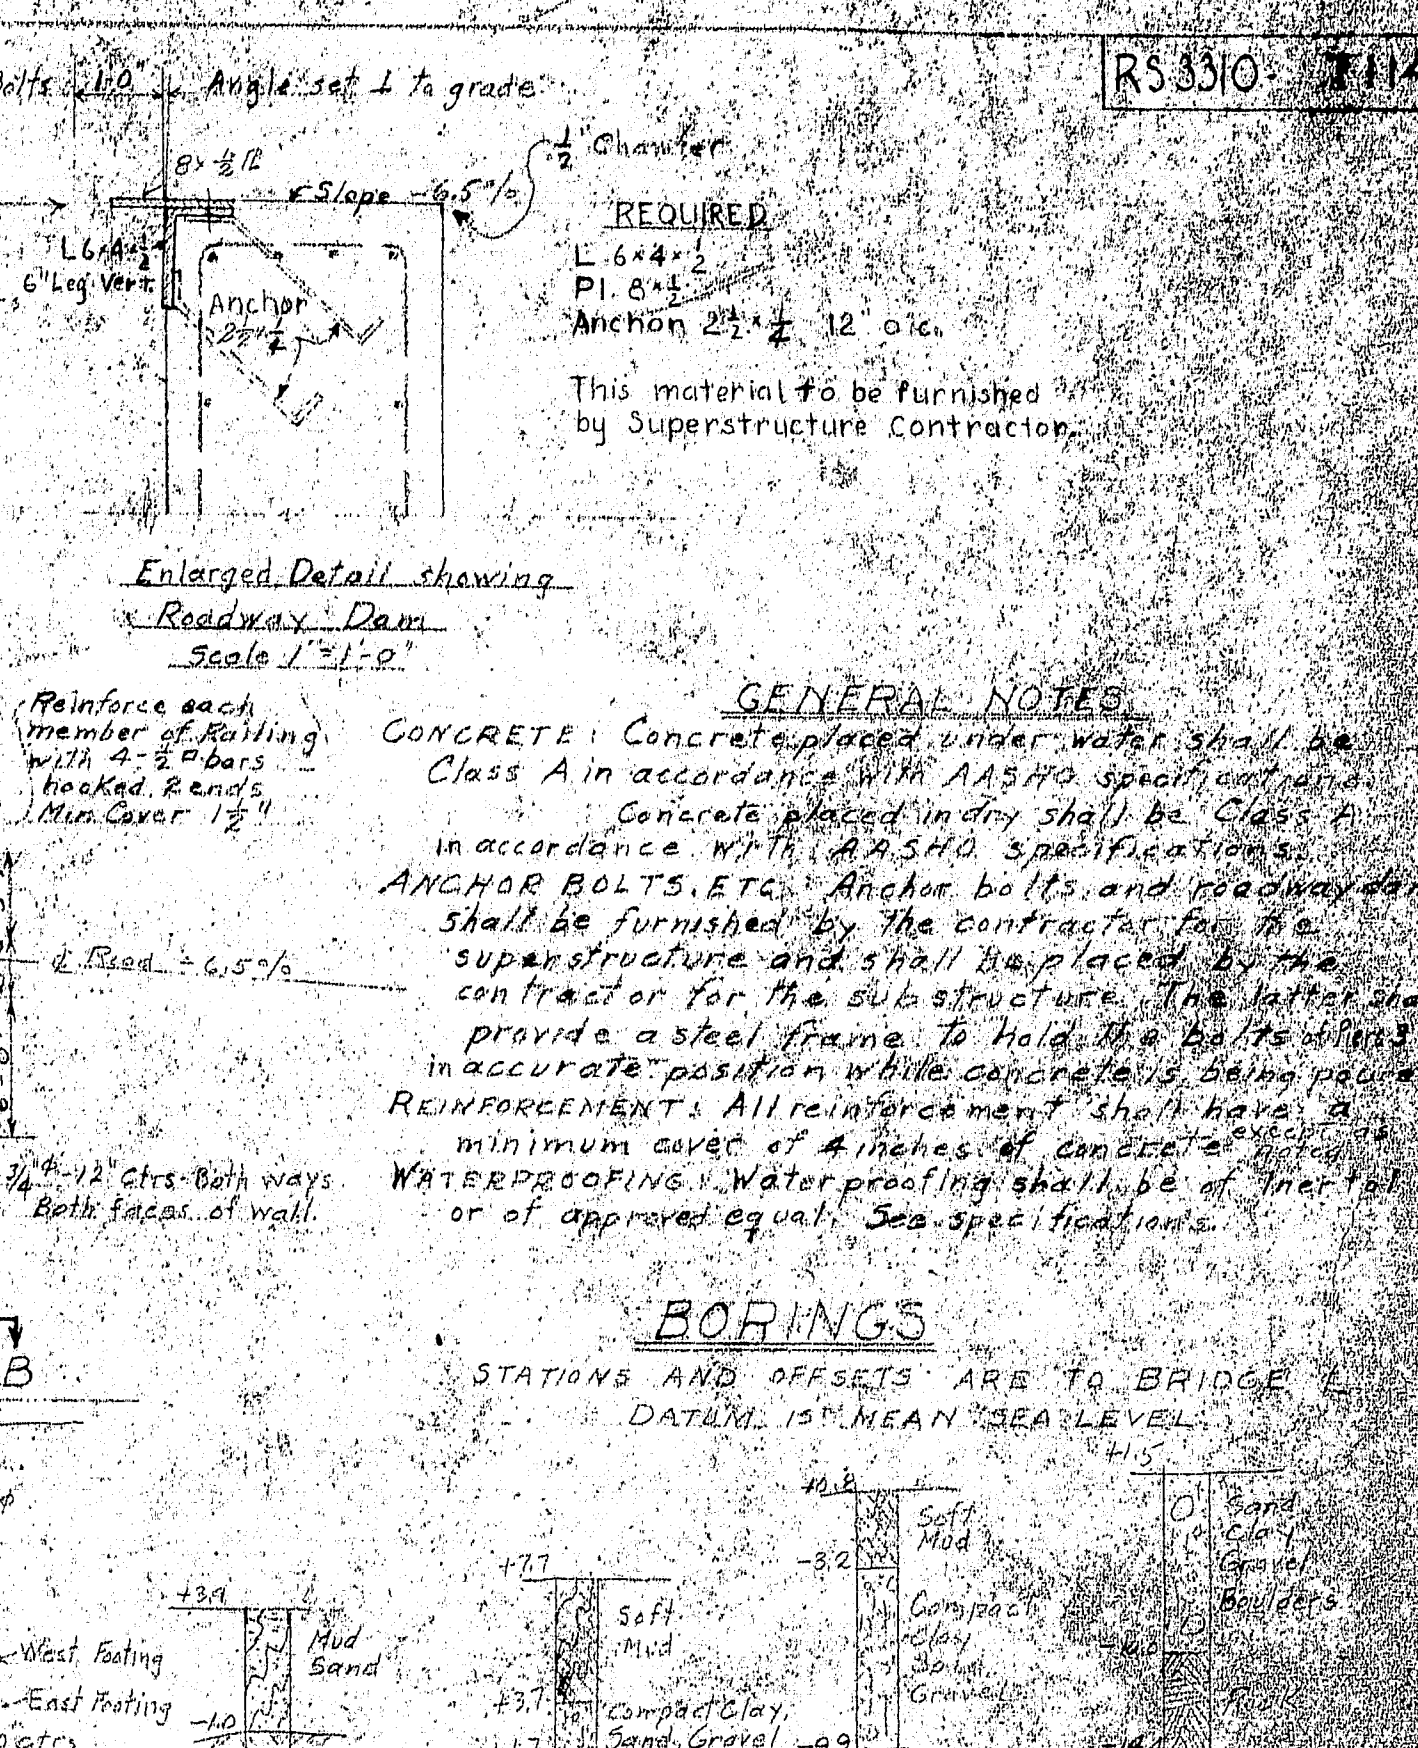


DEER ISLE ABUTMENT

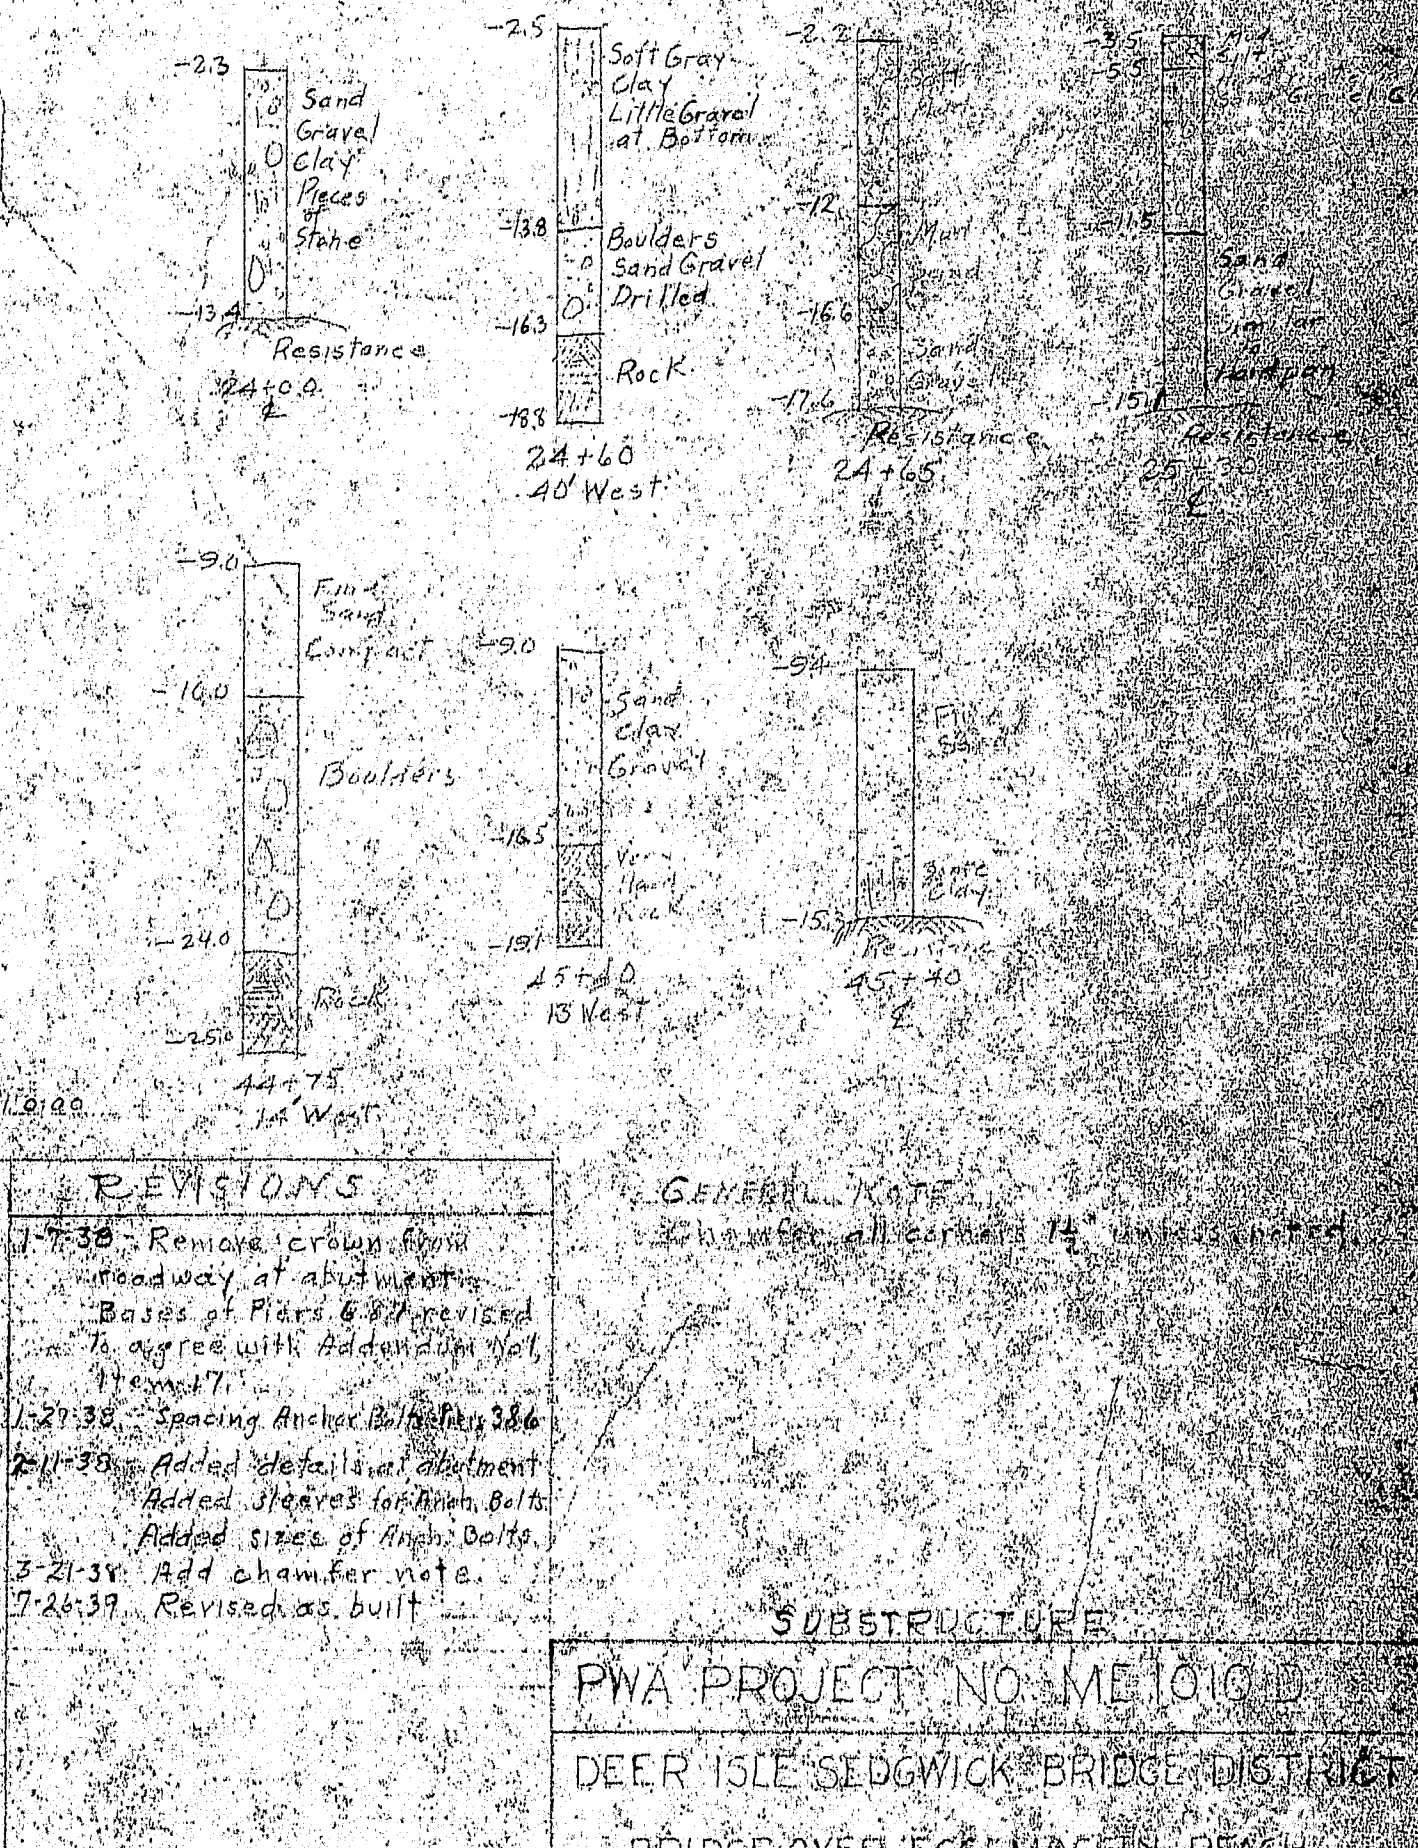


PIER NO. 1 Looking North

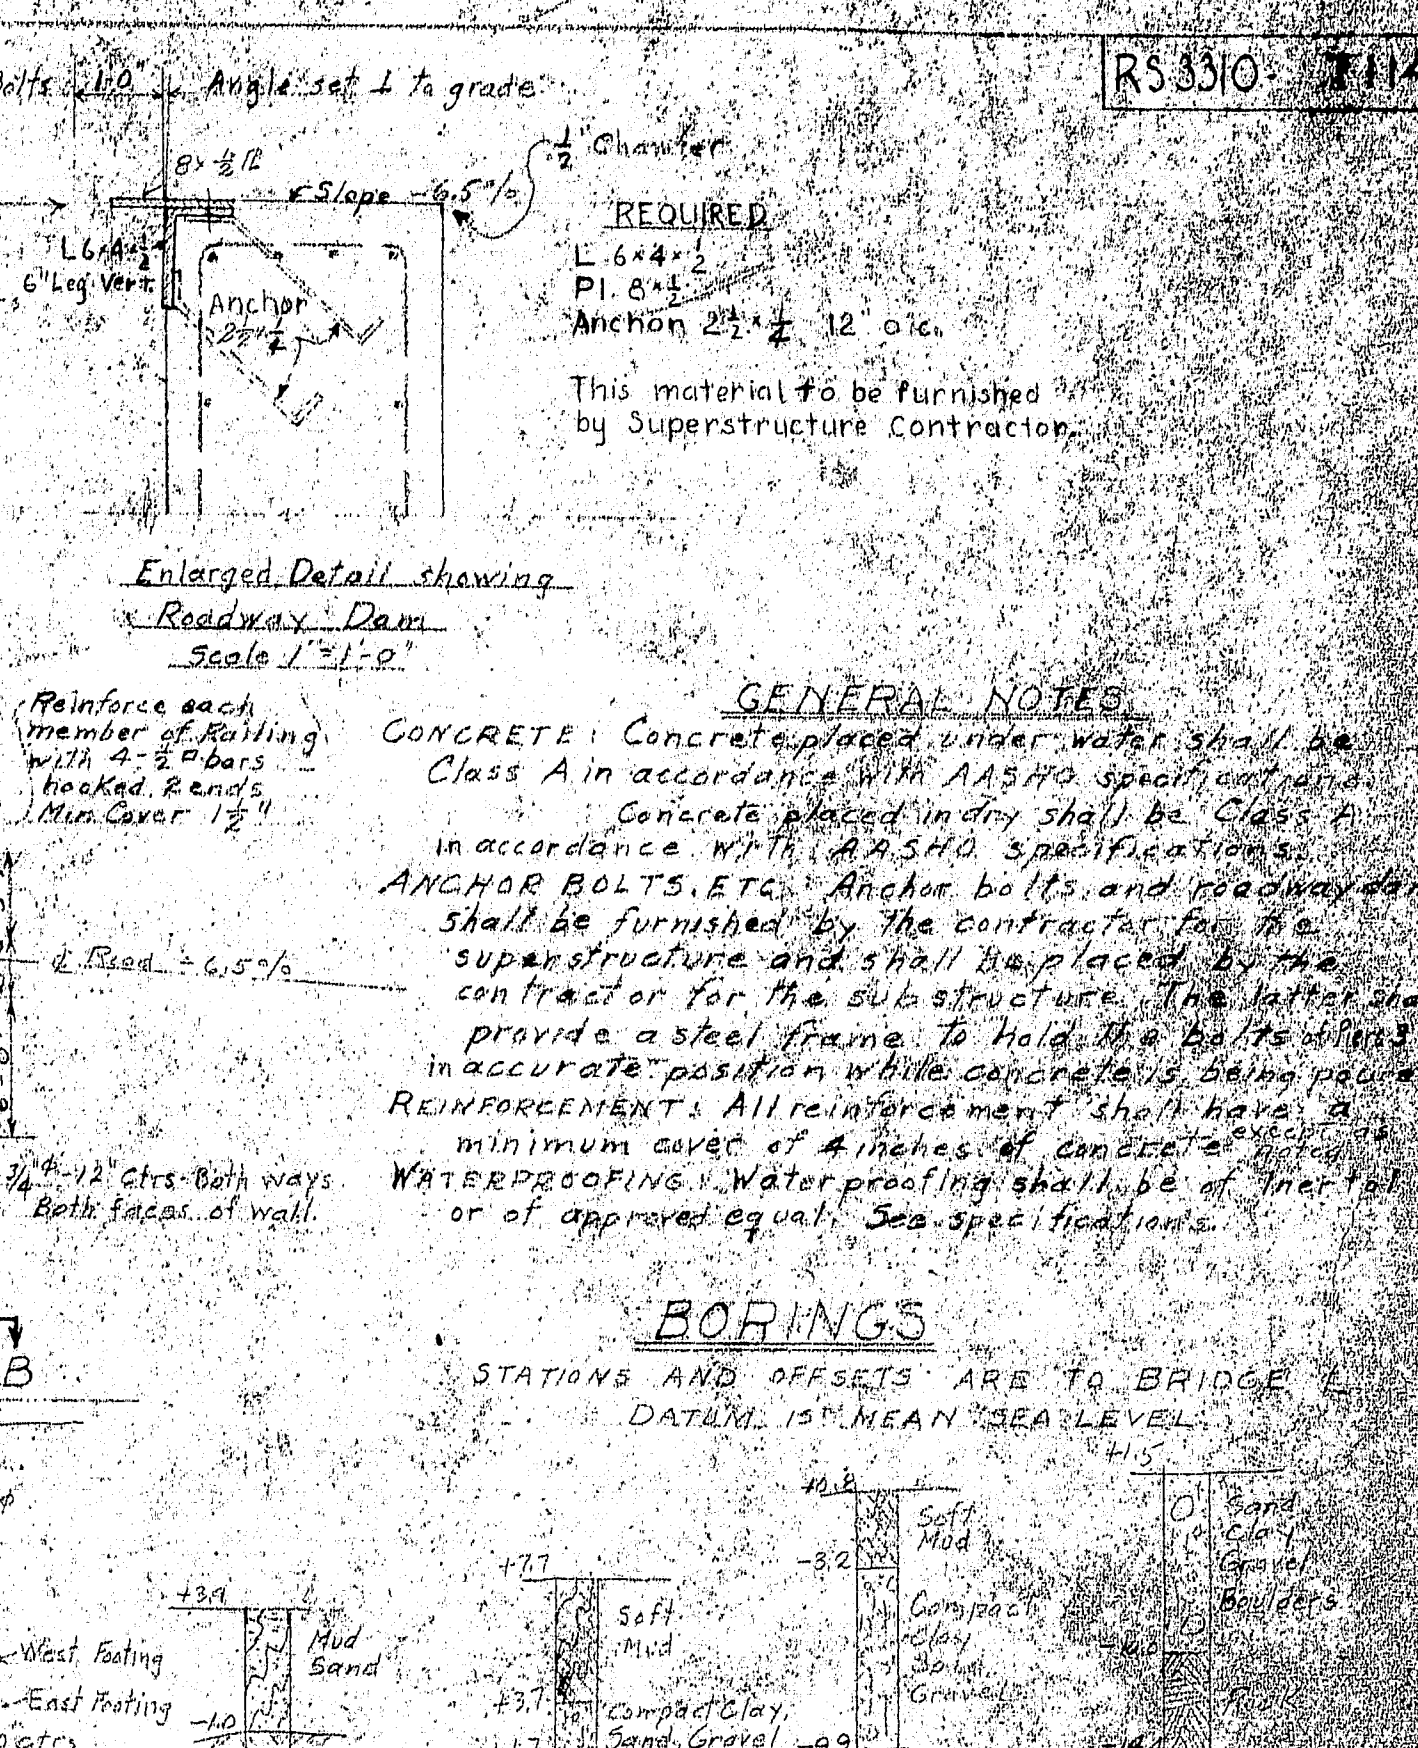


DEER ISLE ABUTMENT

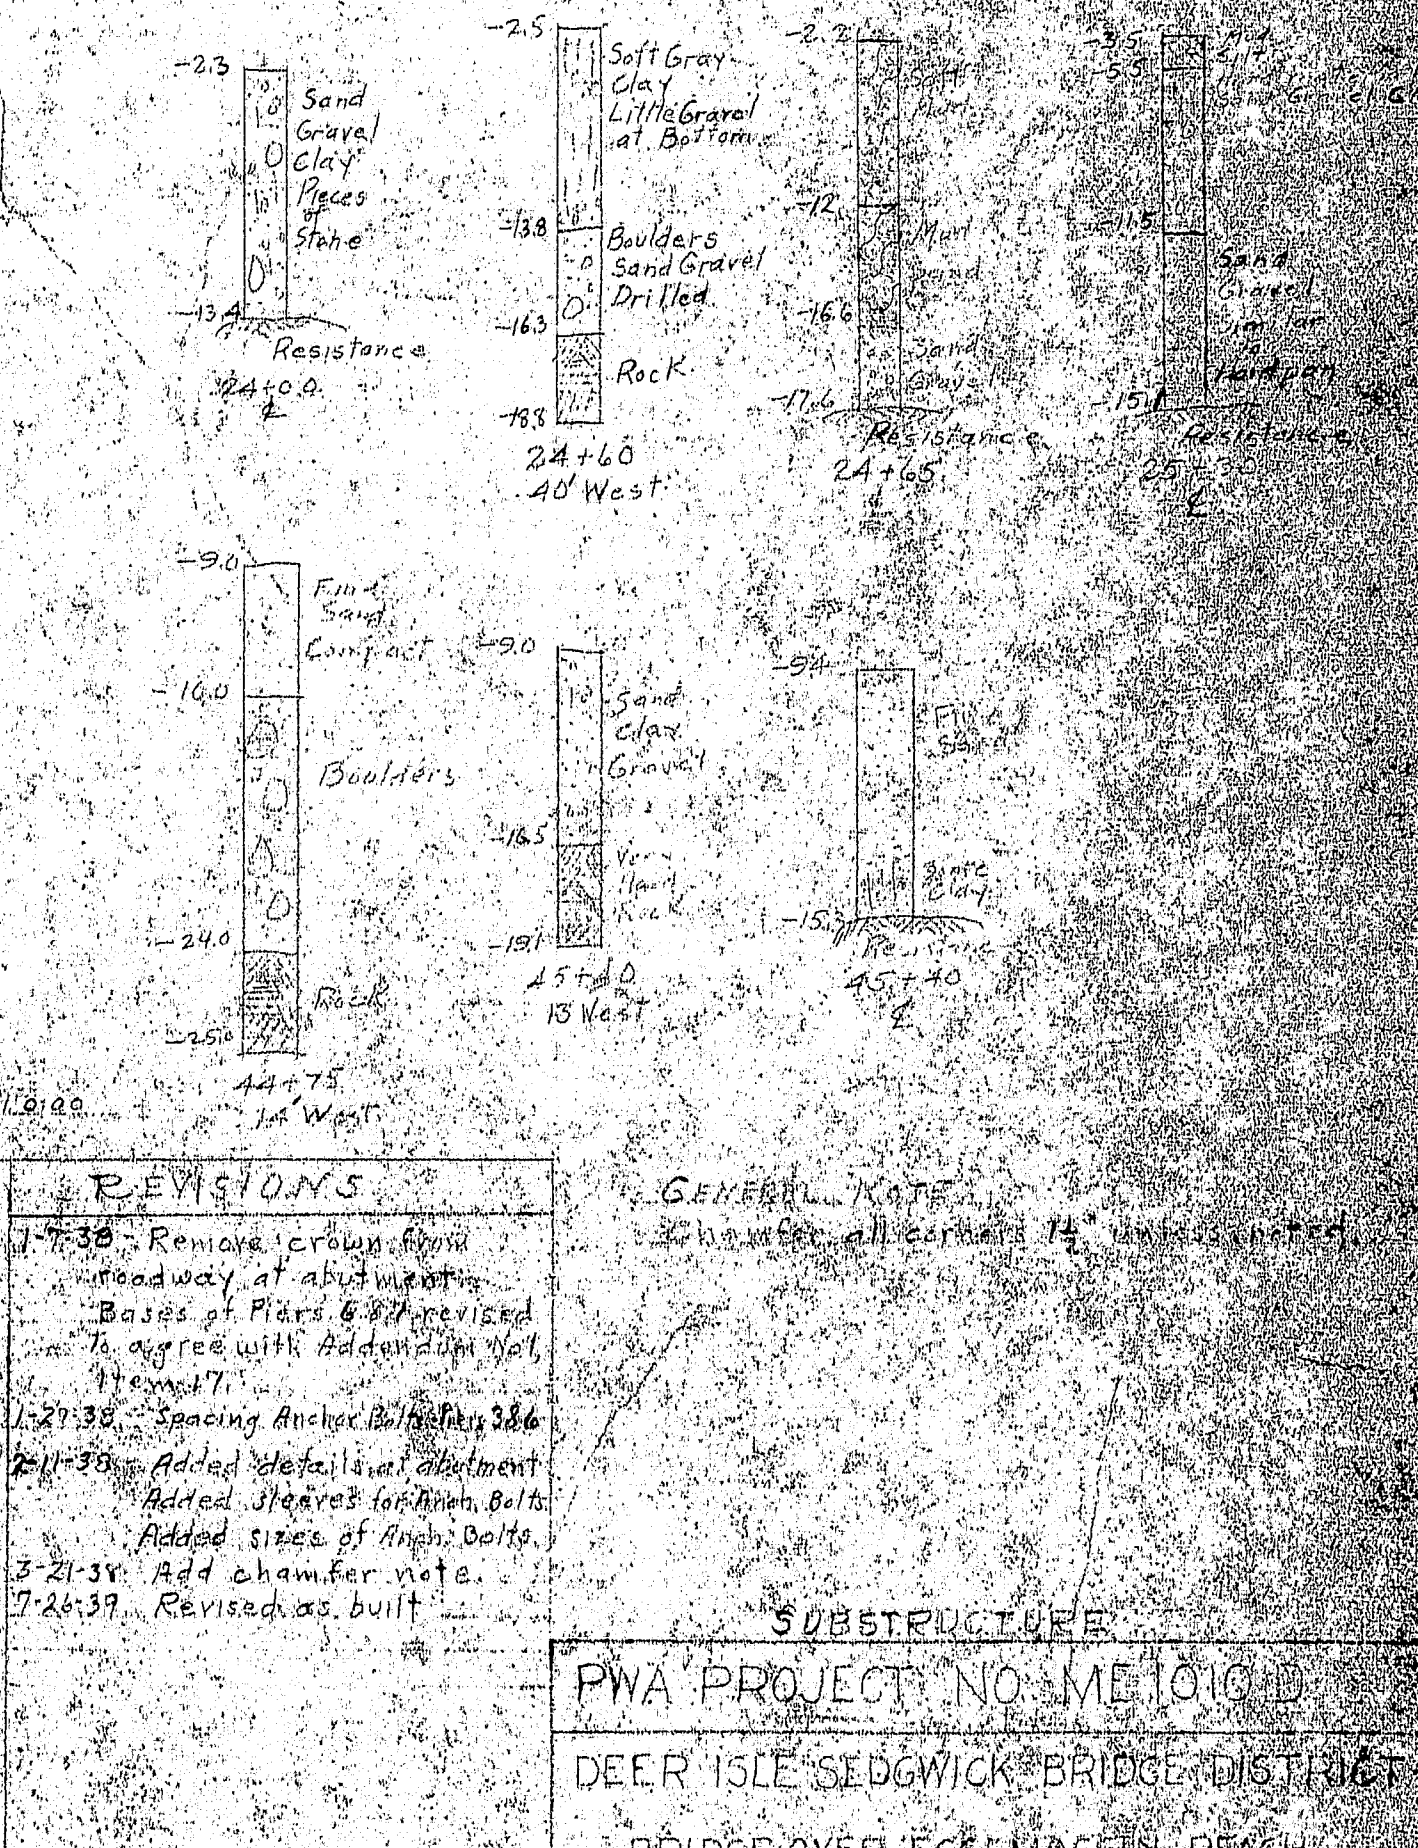


PIER NO. 1 Looking North

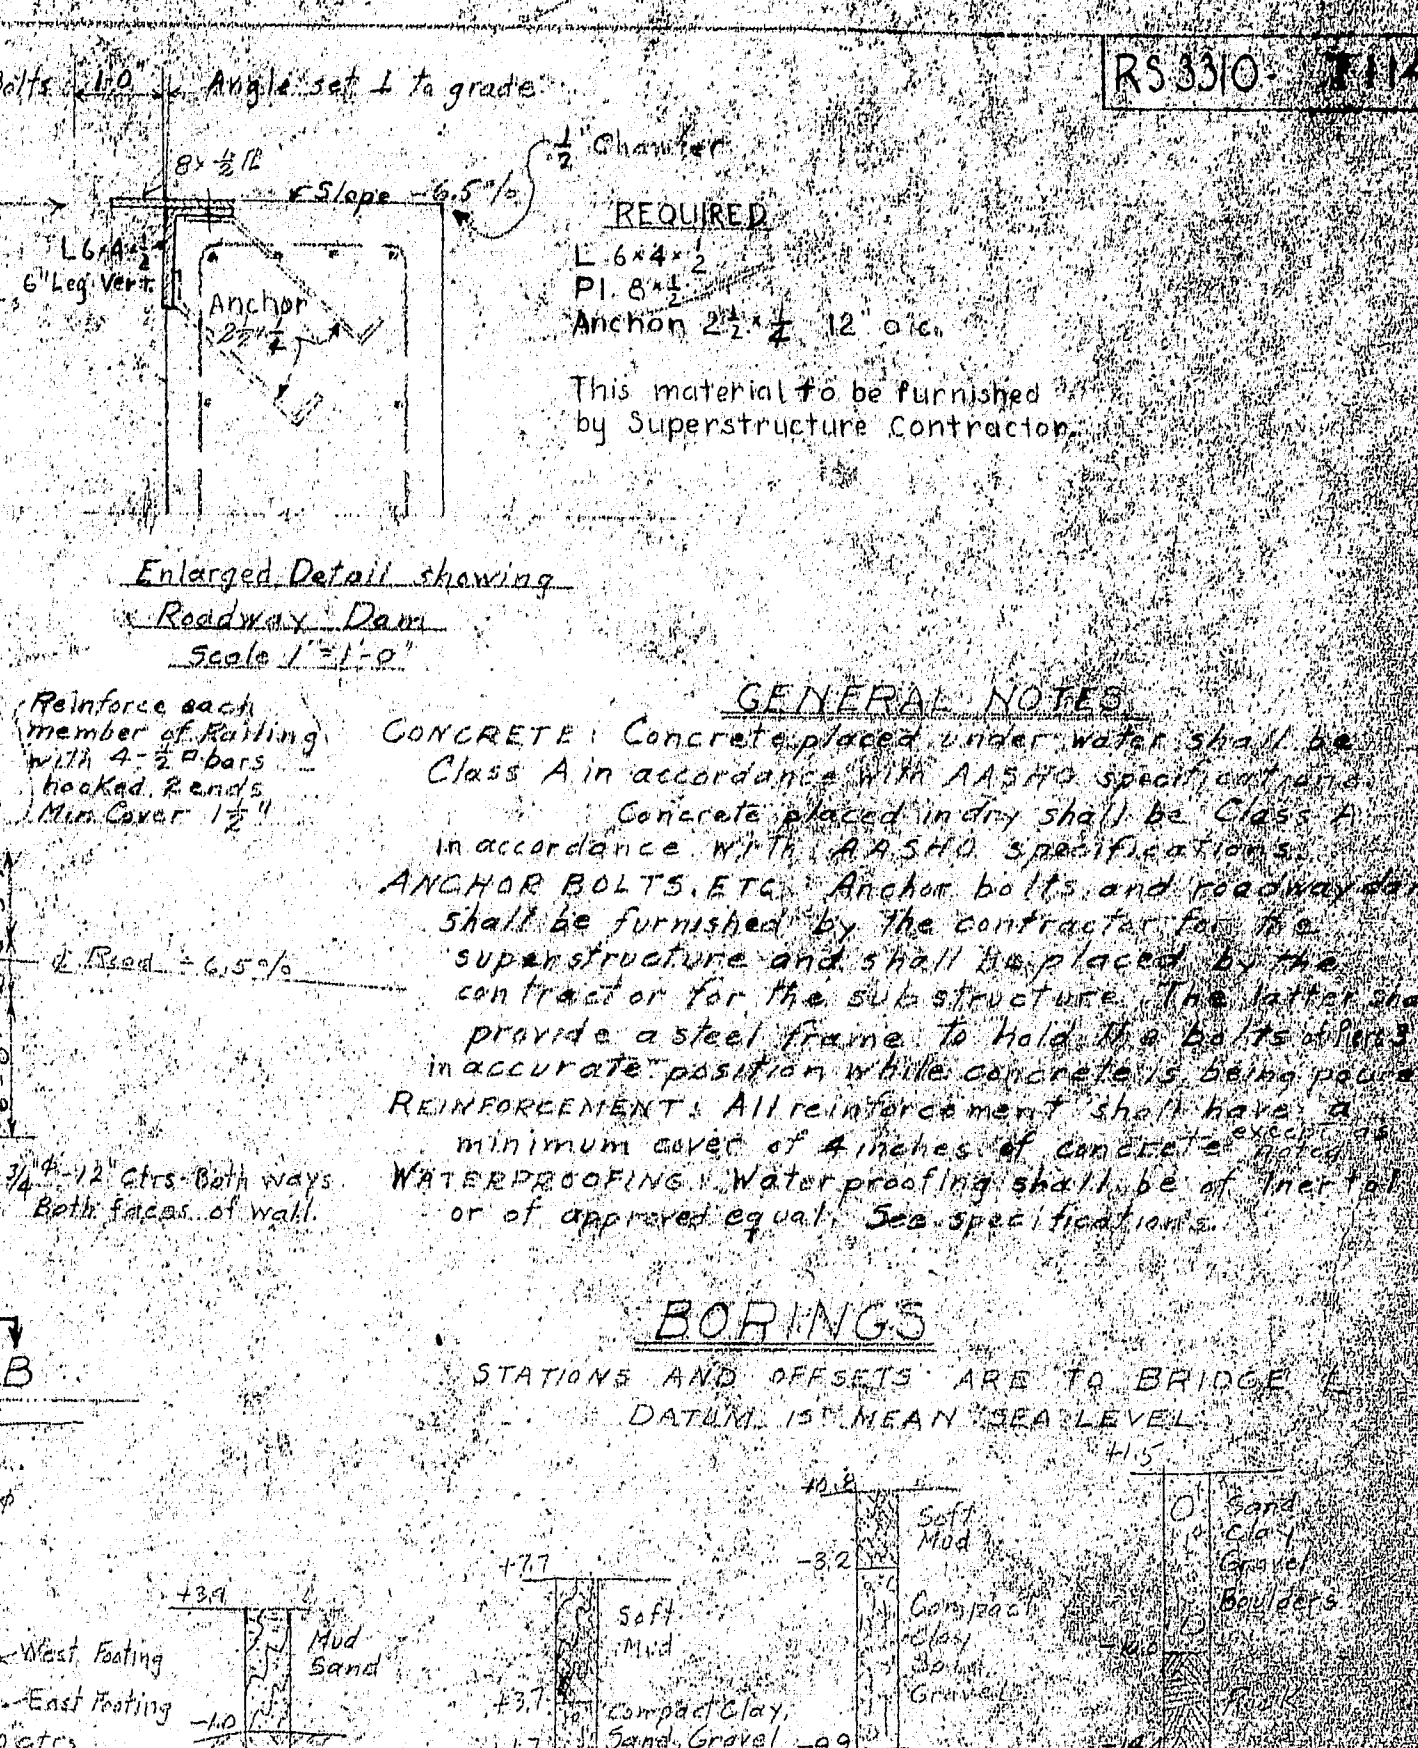


DEER ISLE ABUTMENT

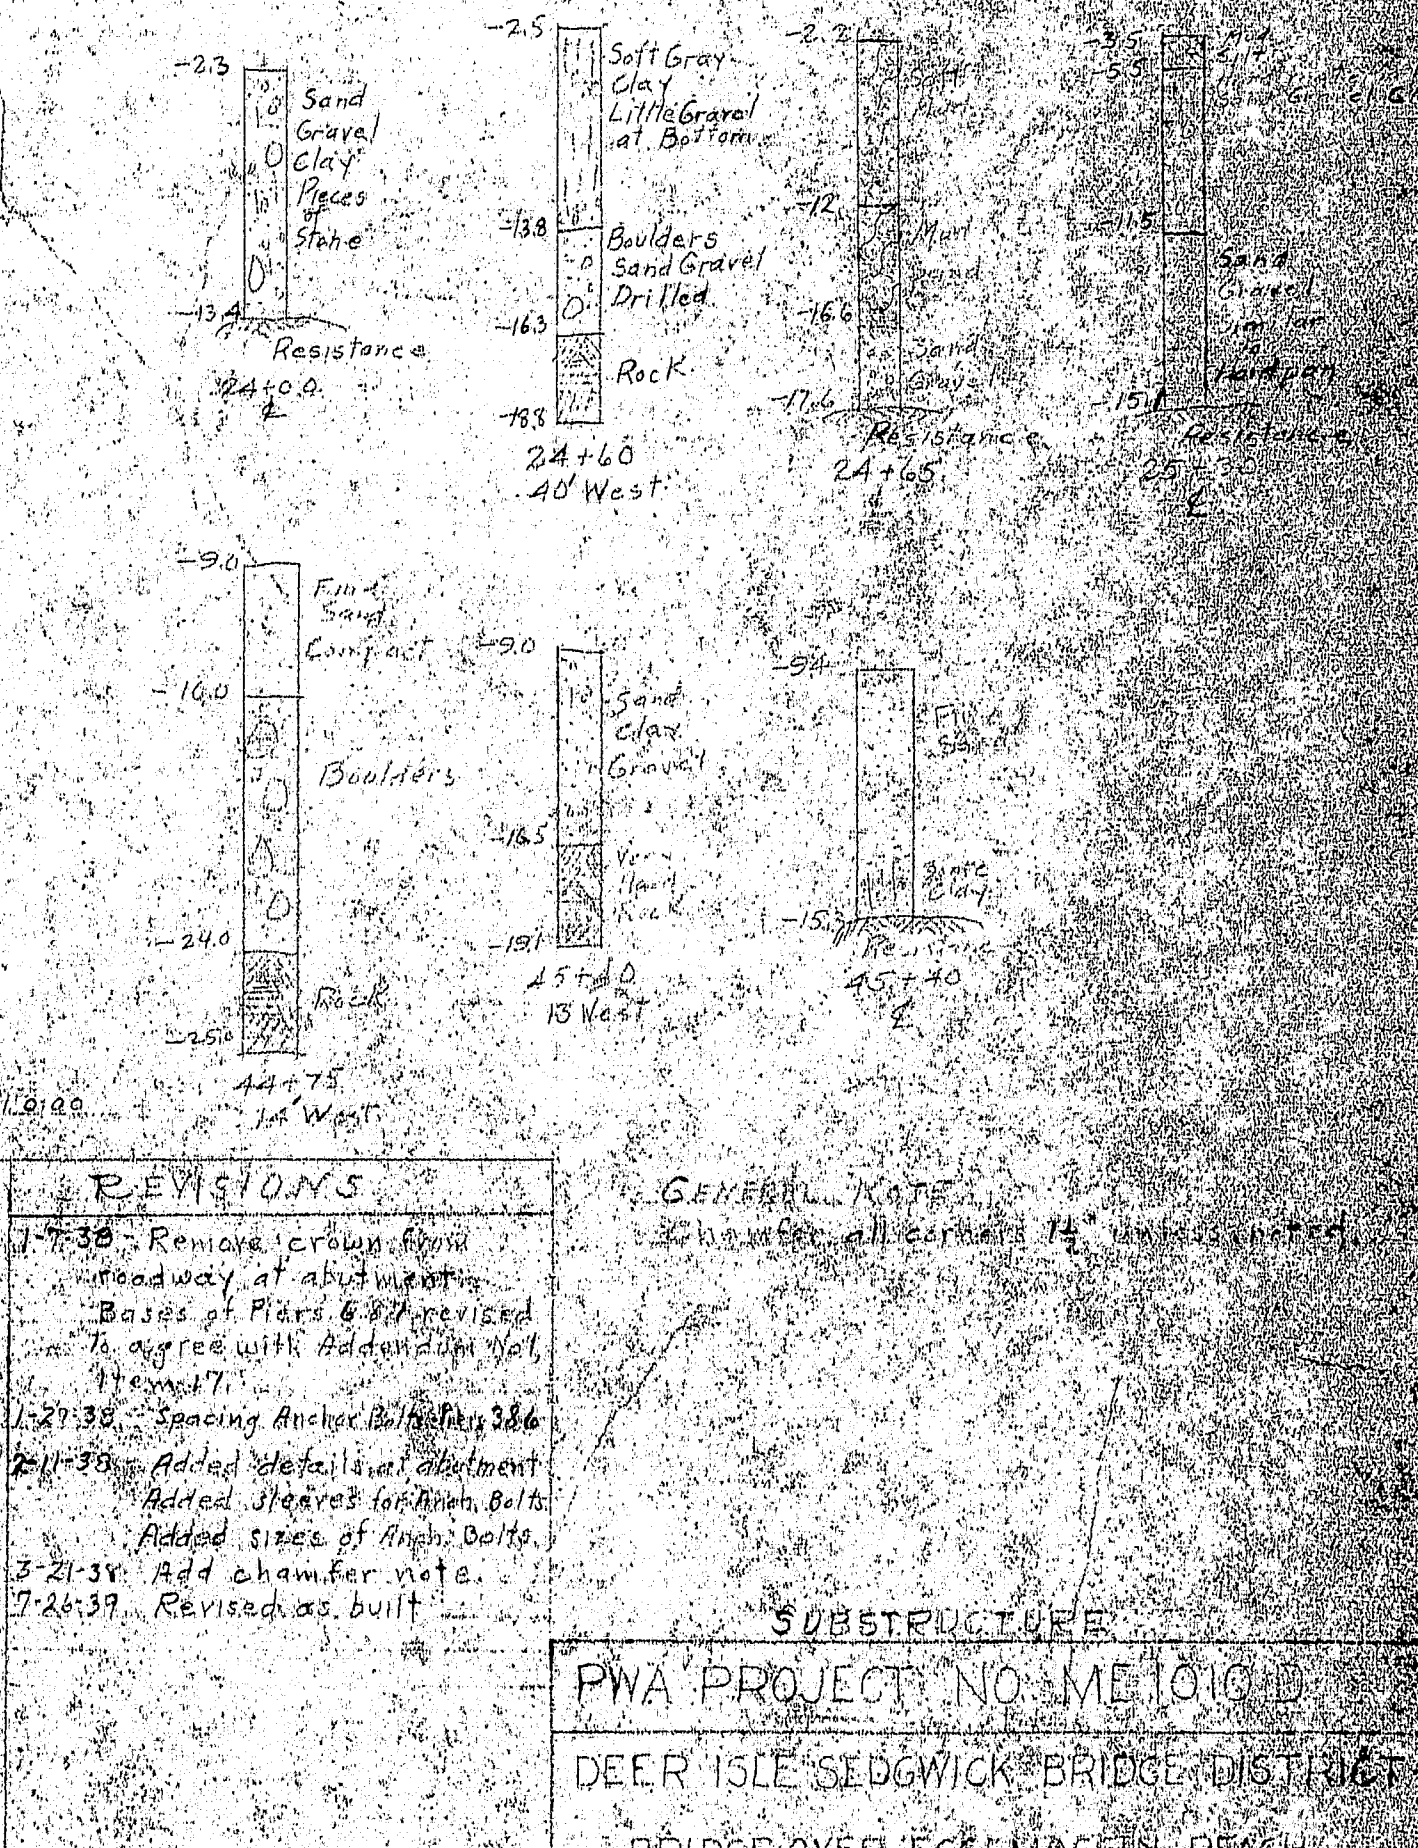


PIER NO. 1 Looking North

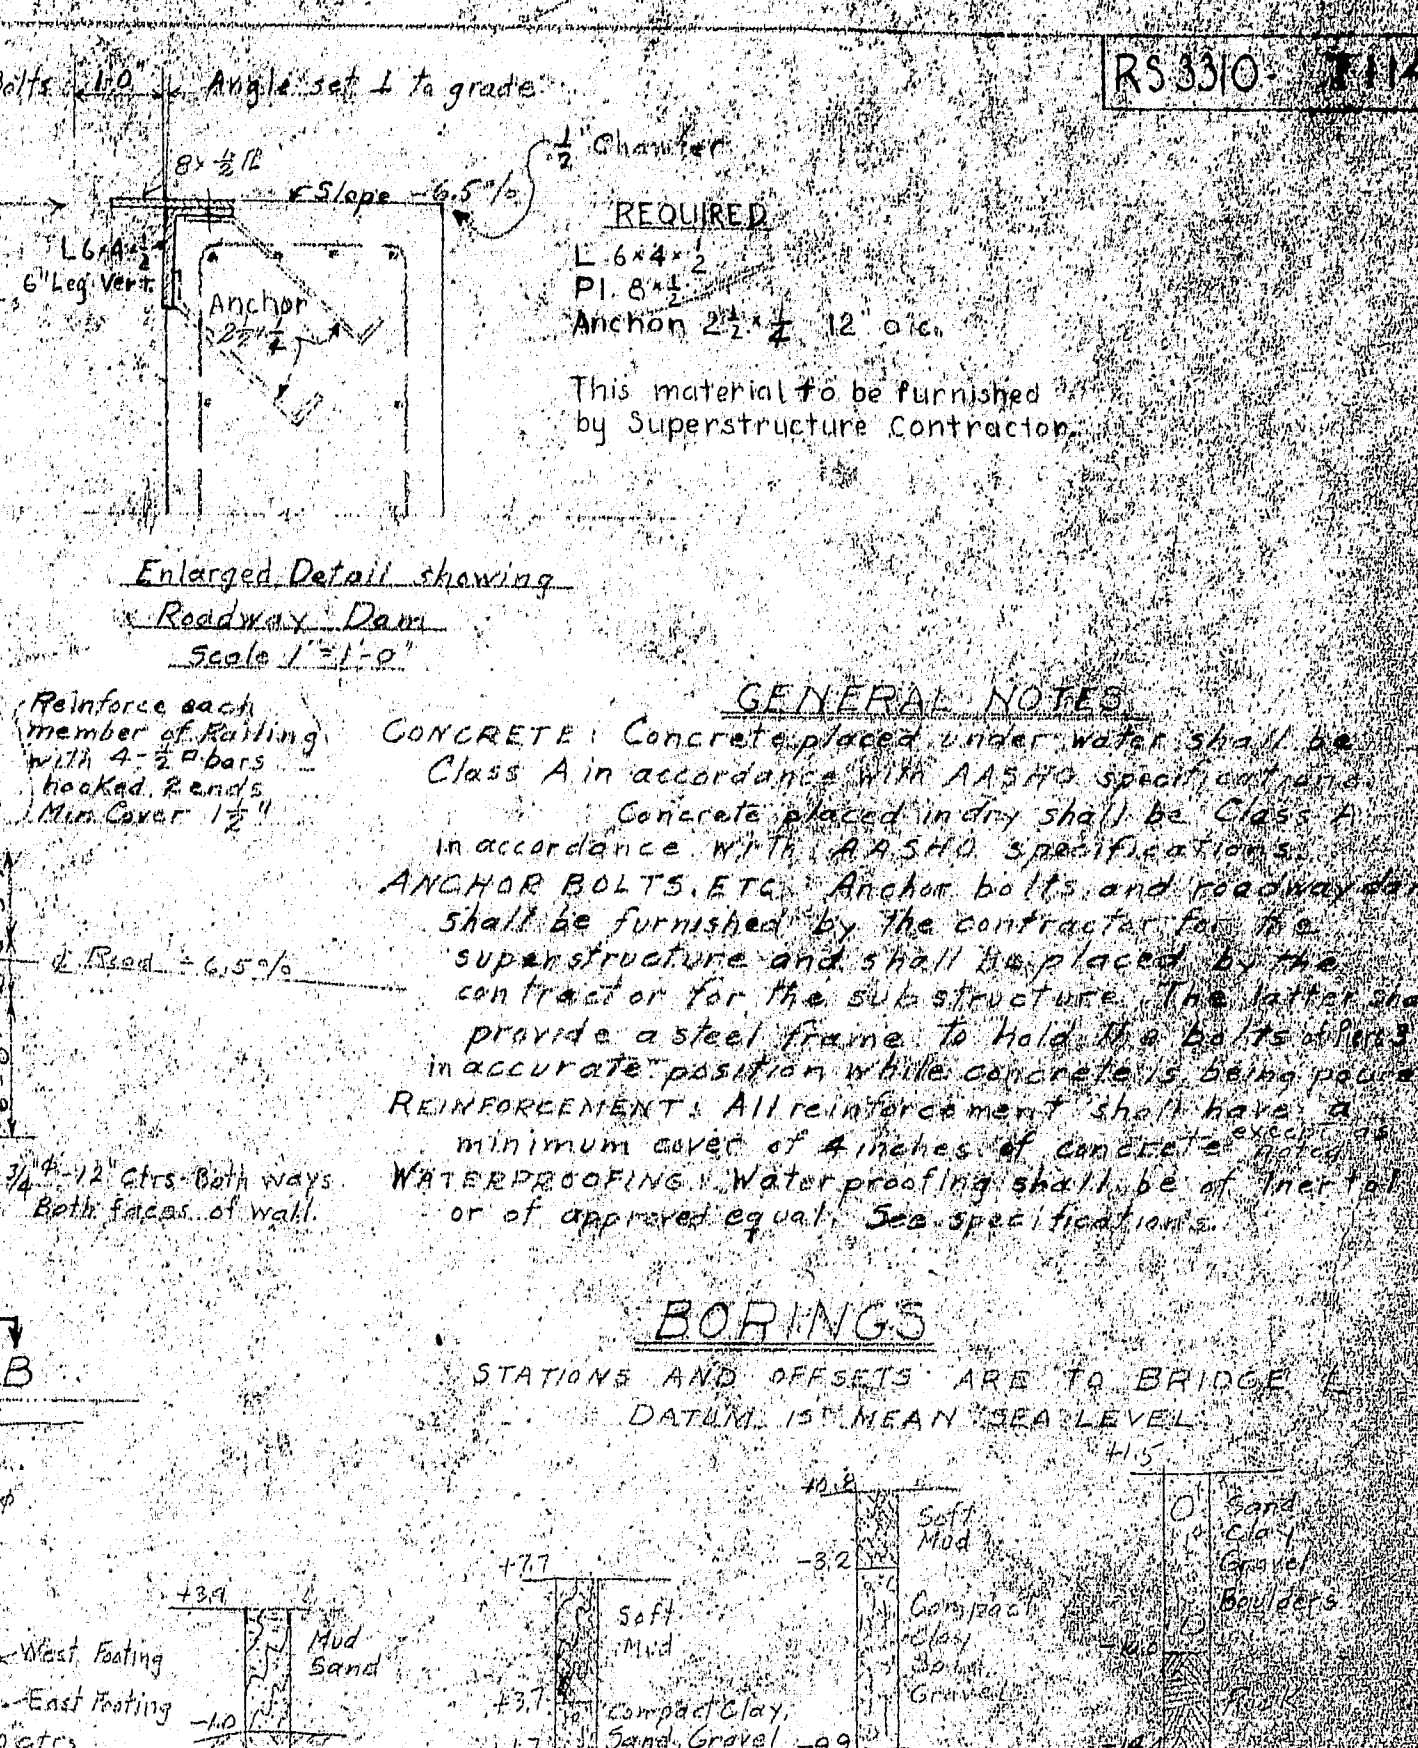


DEER ISLE ABUTMENT

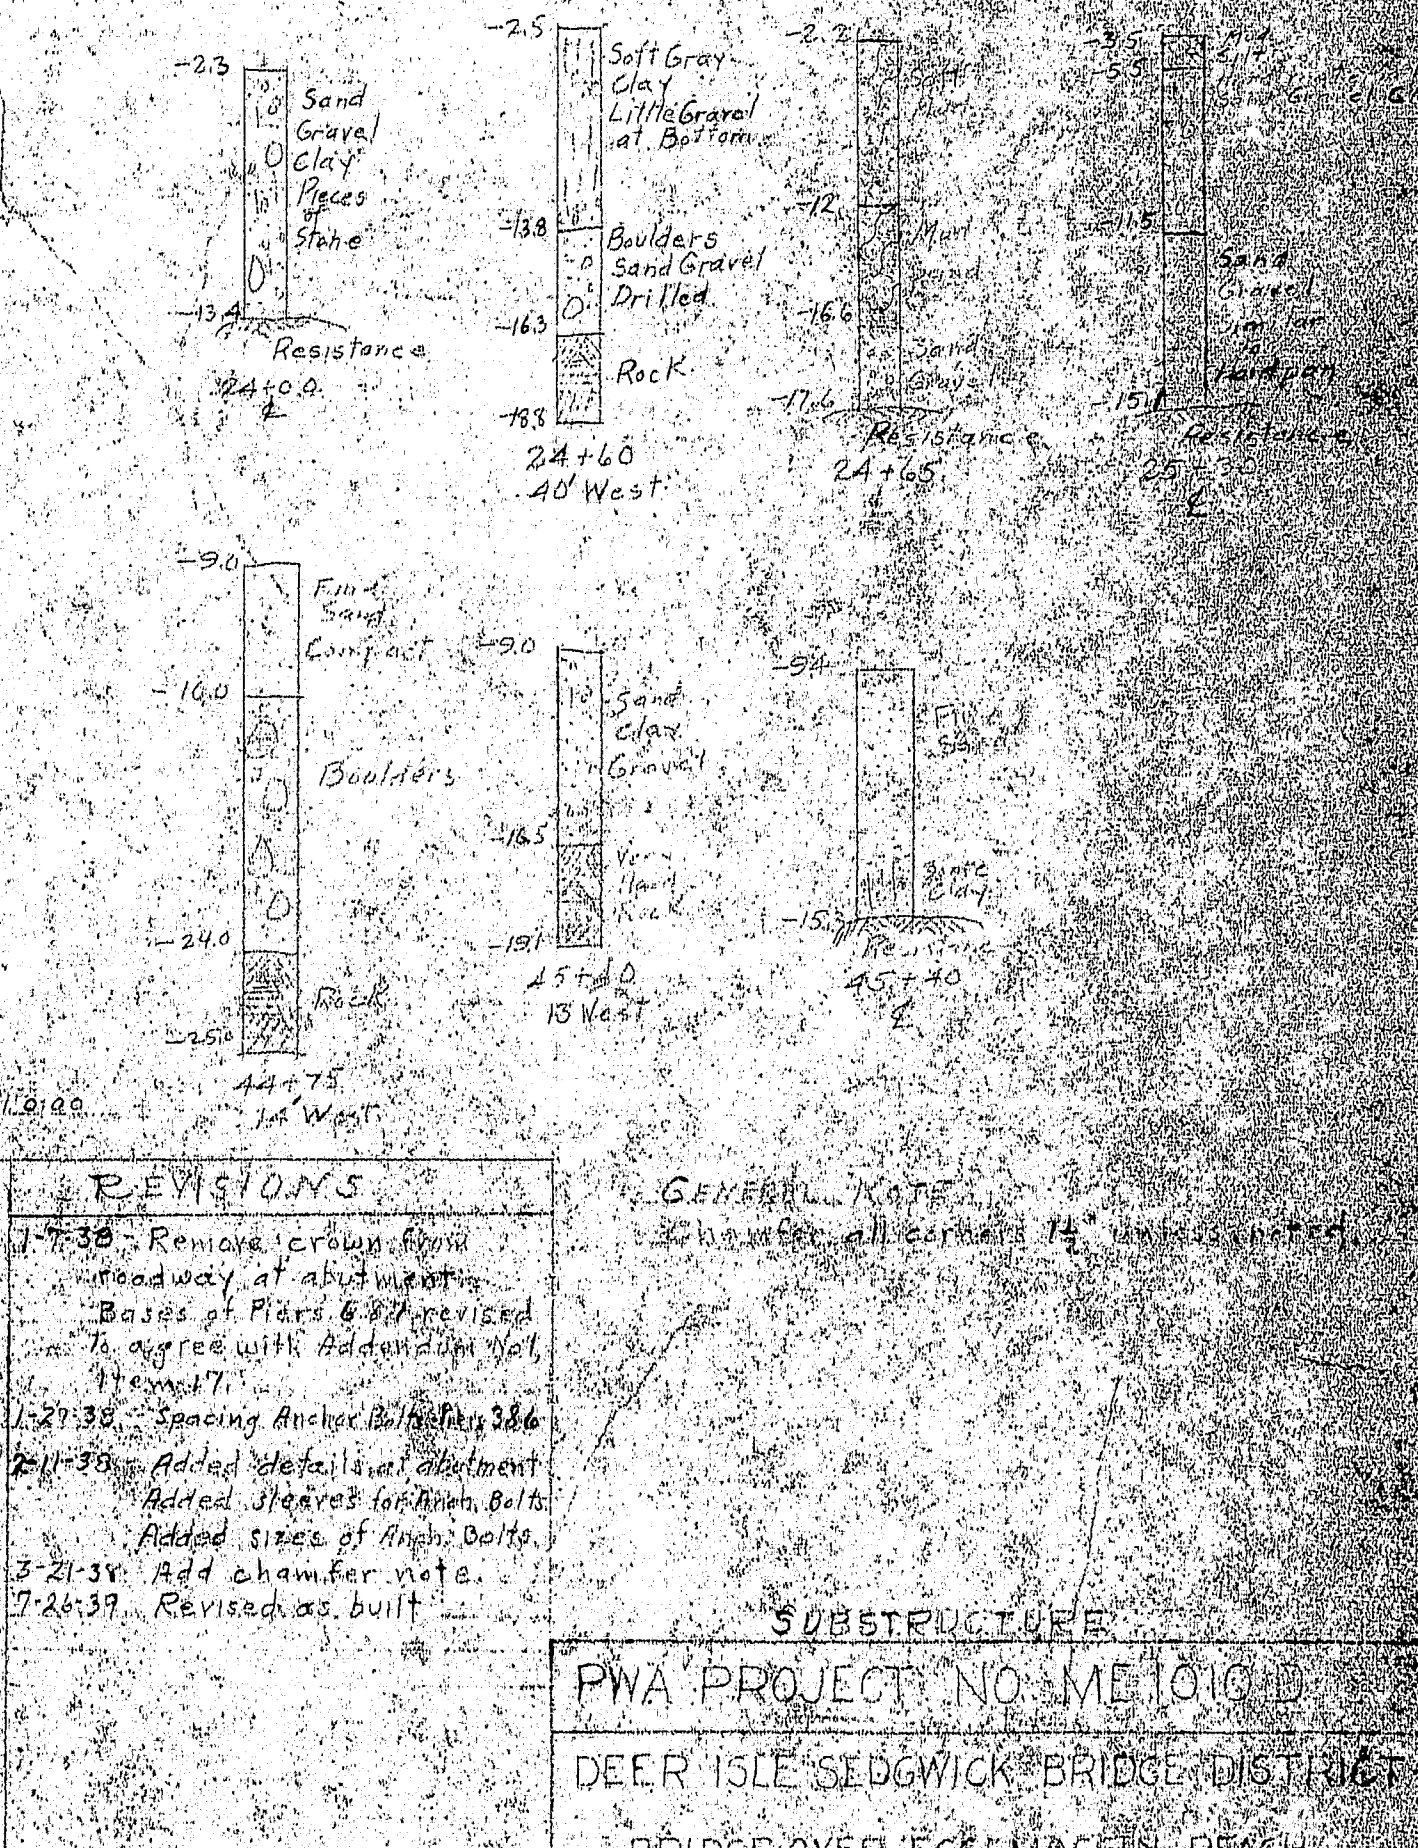


PIER NO. 1 Looking North

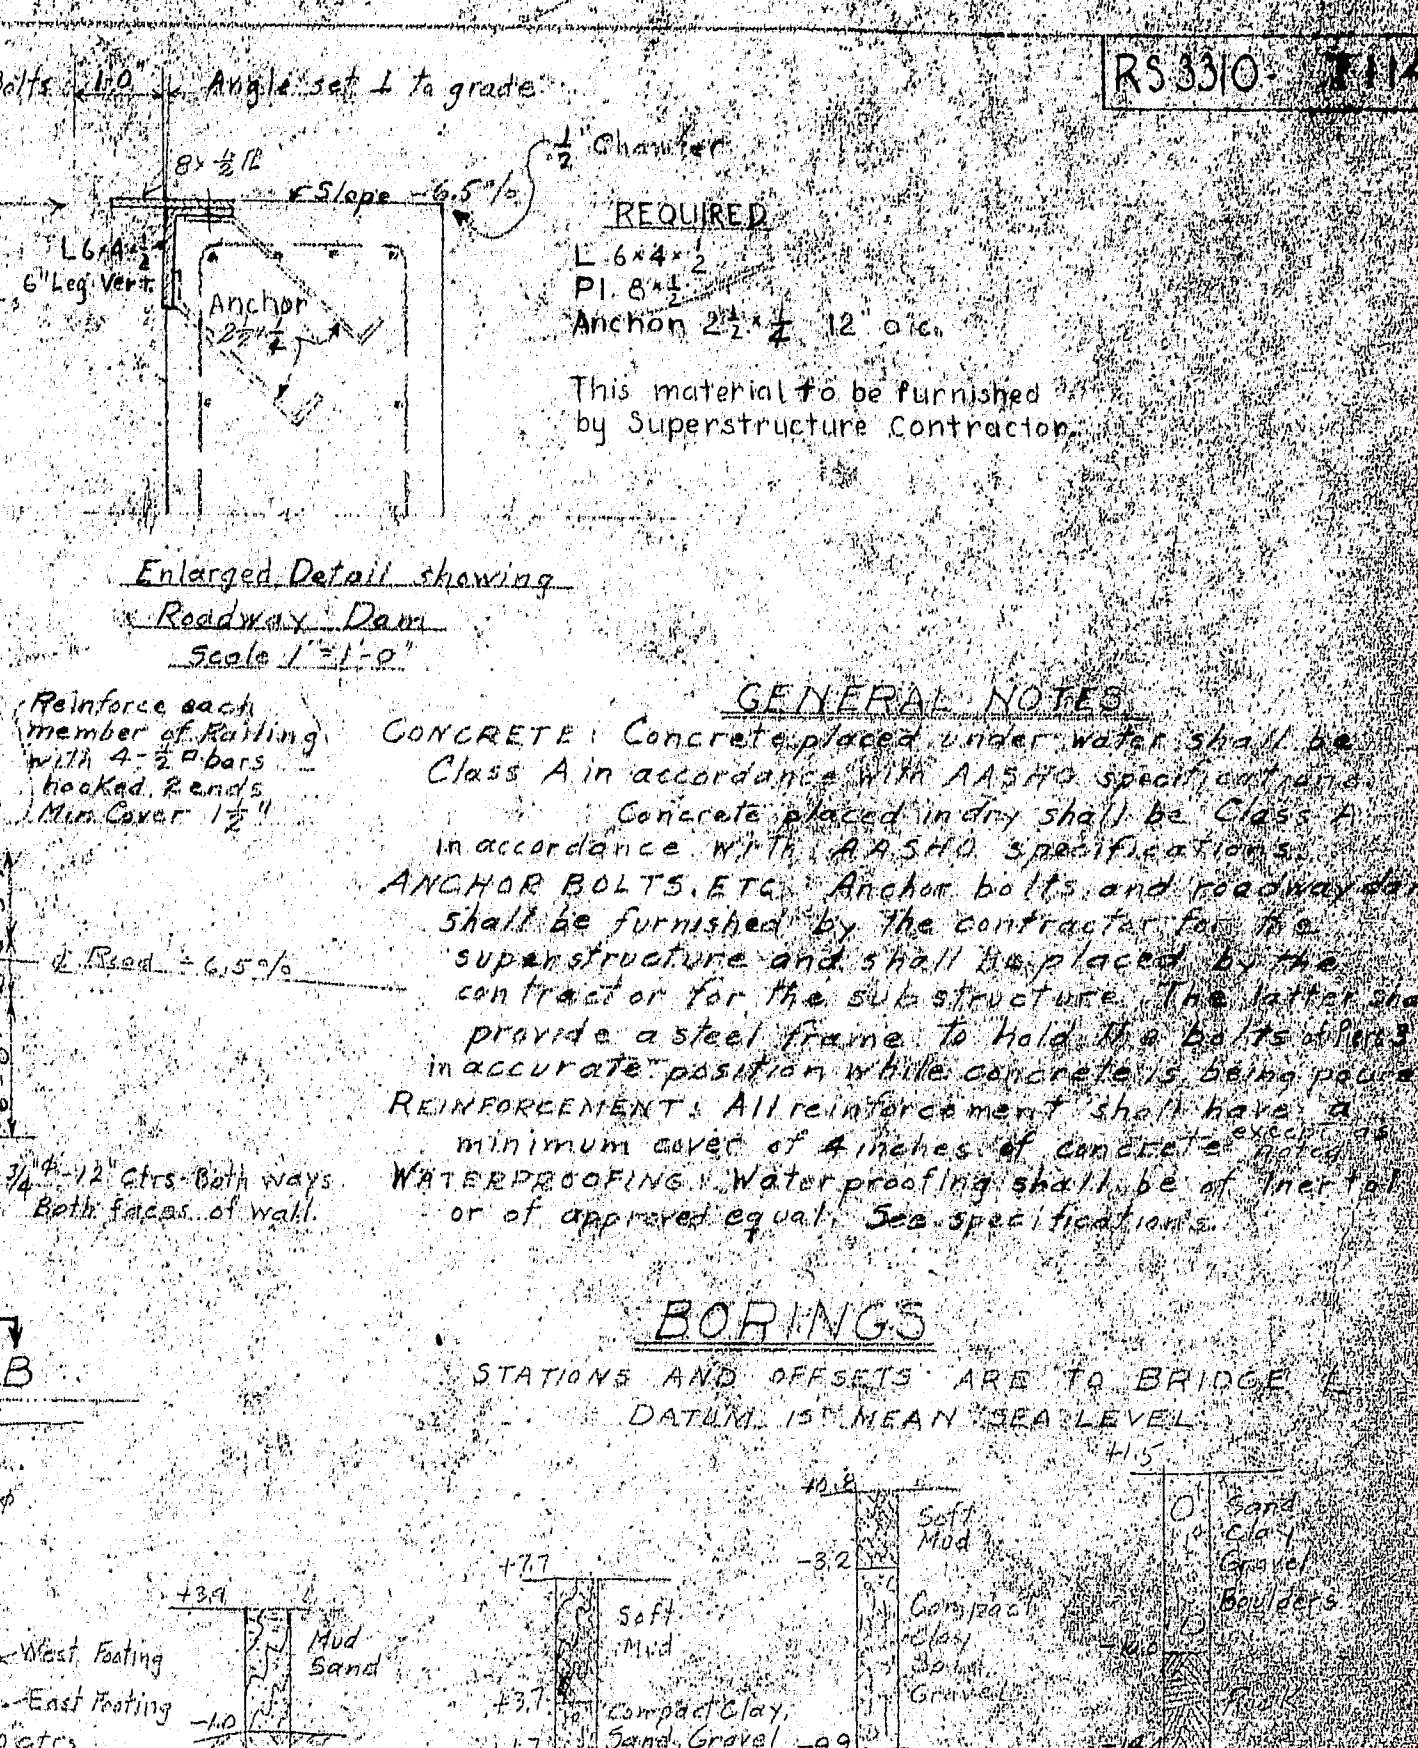


DEER ISLE ABUTMENT

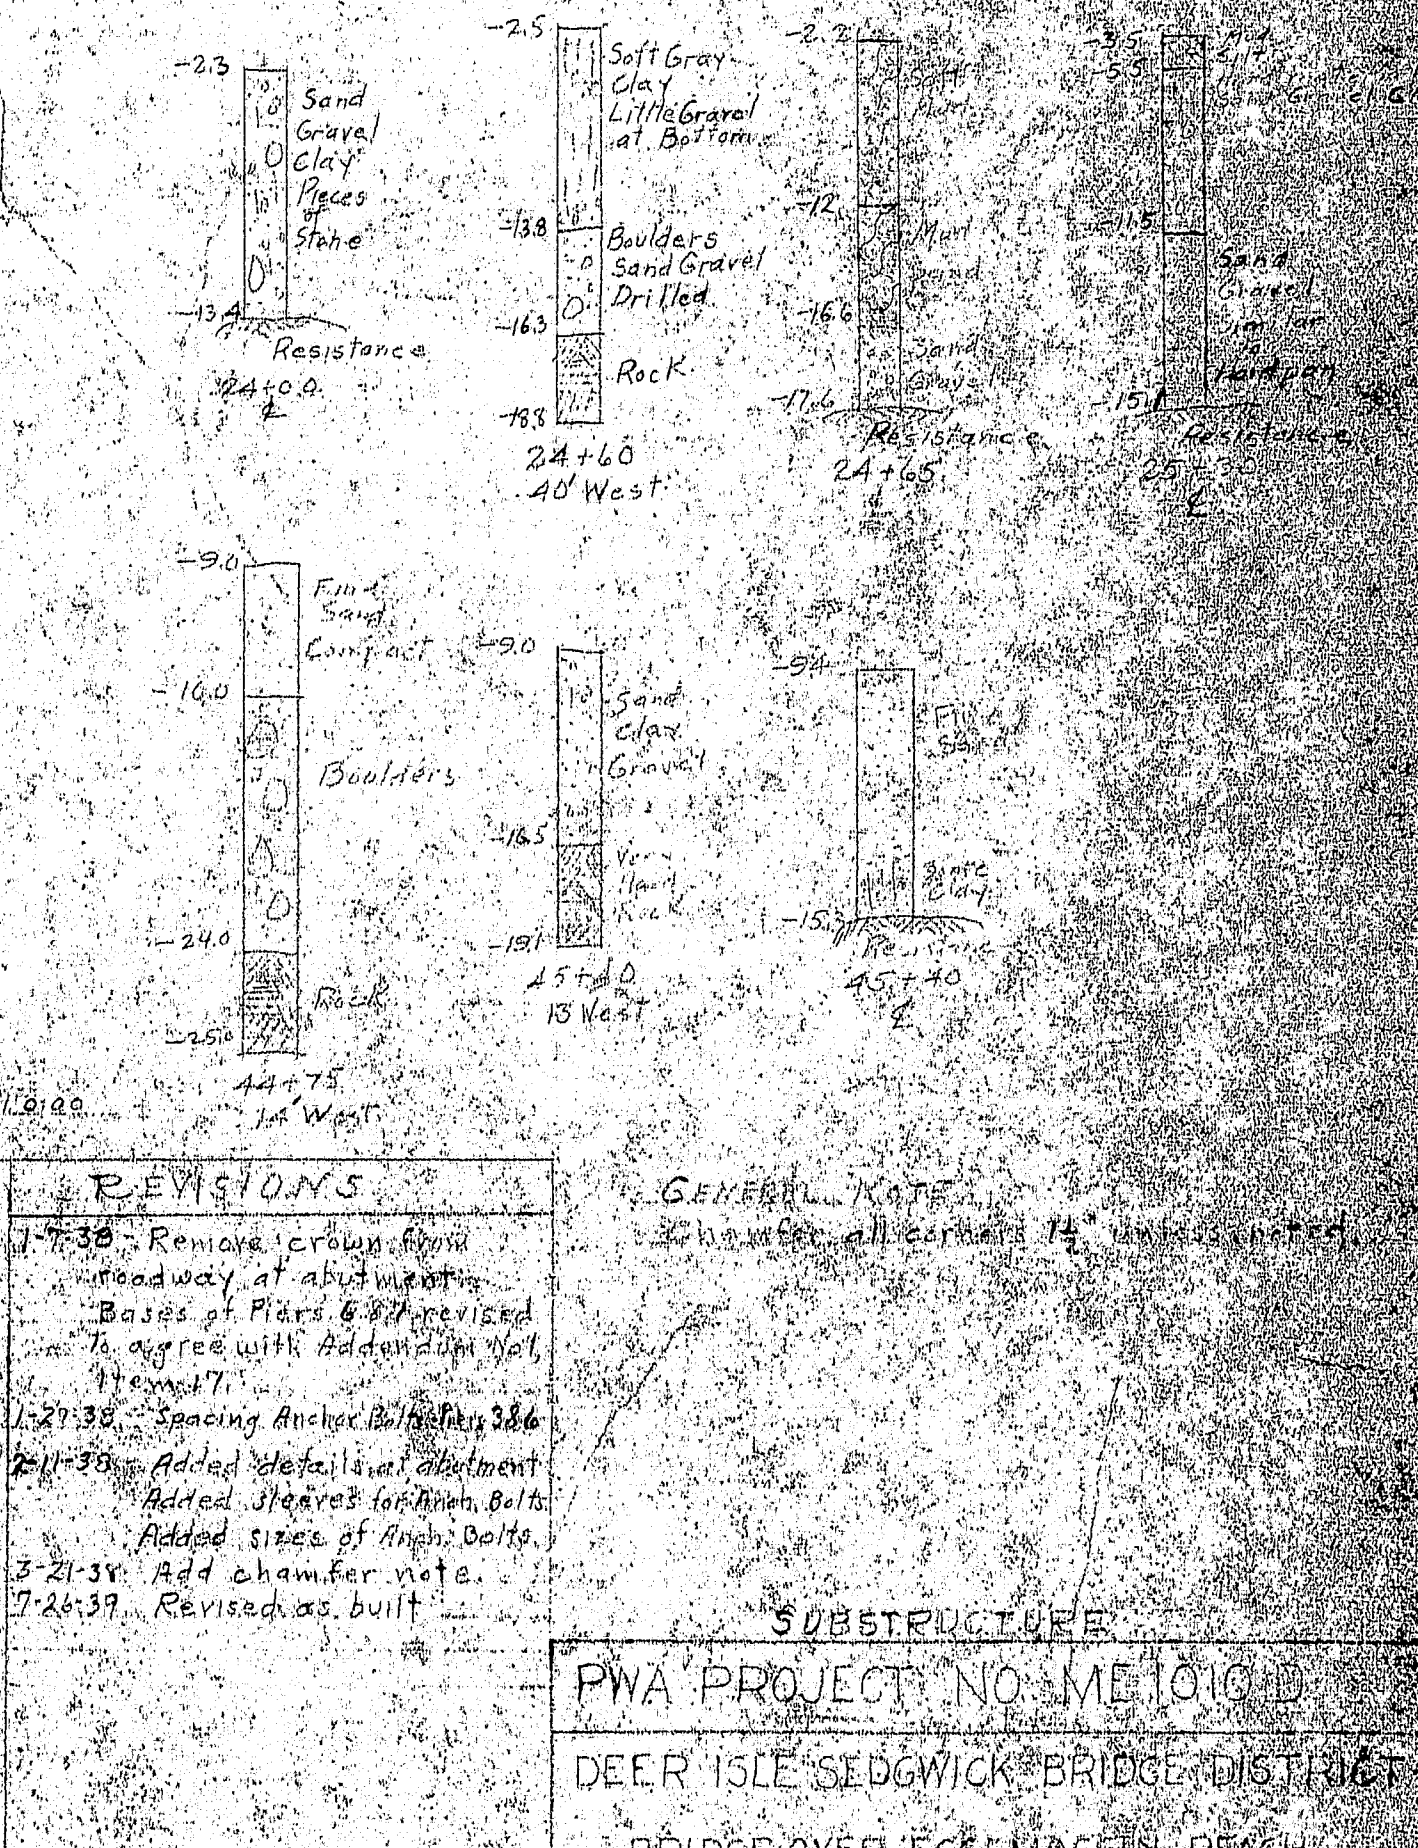


PIER NO. 1 Looking North

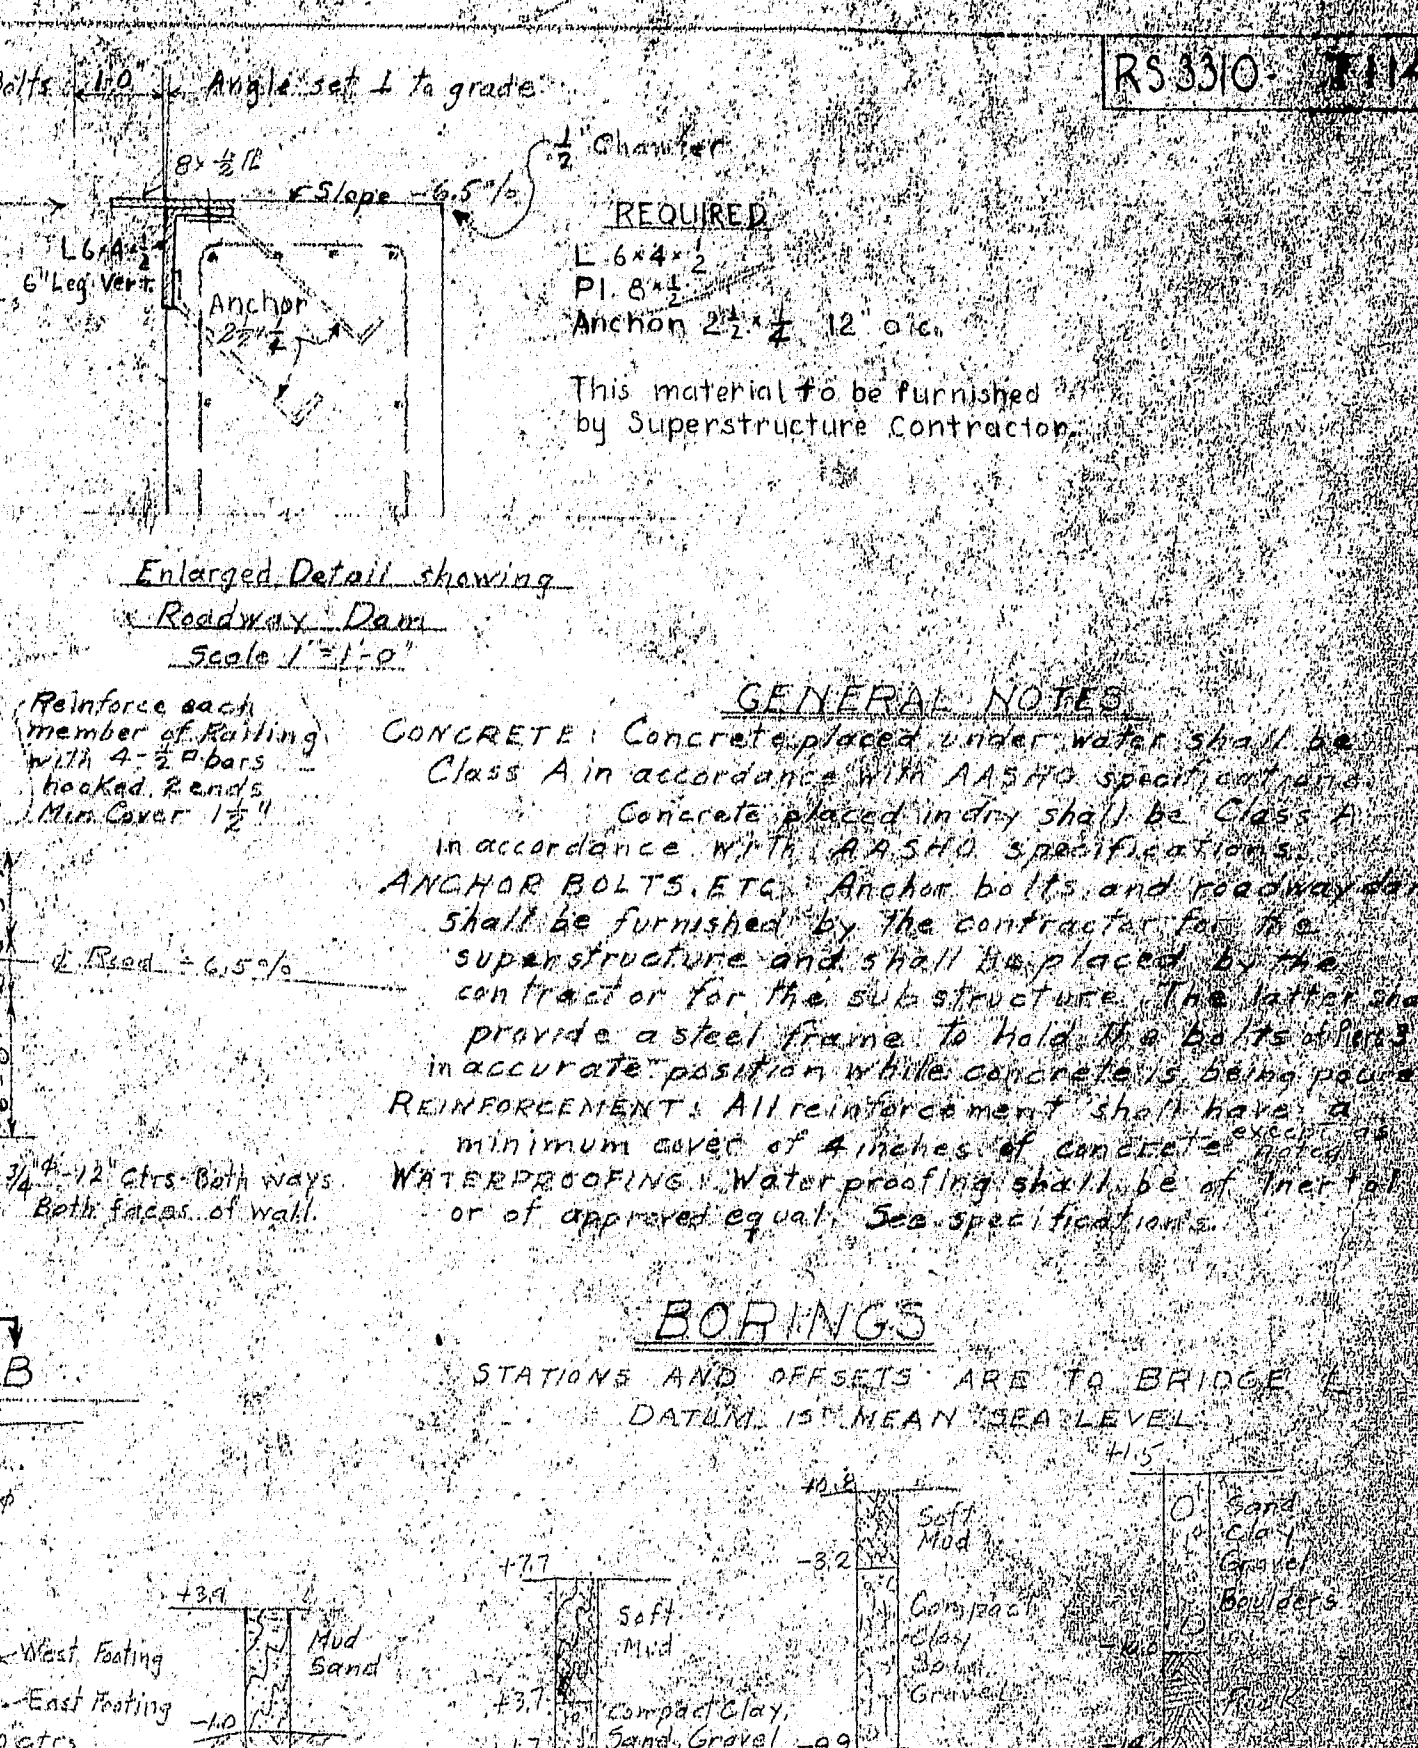


DEER ISLE ABUTMENT

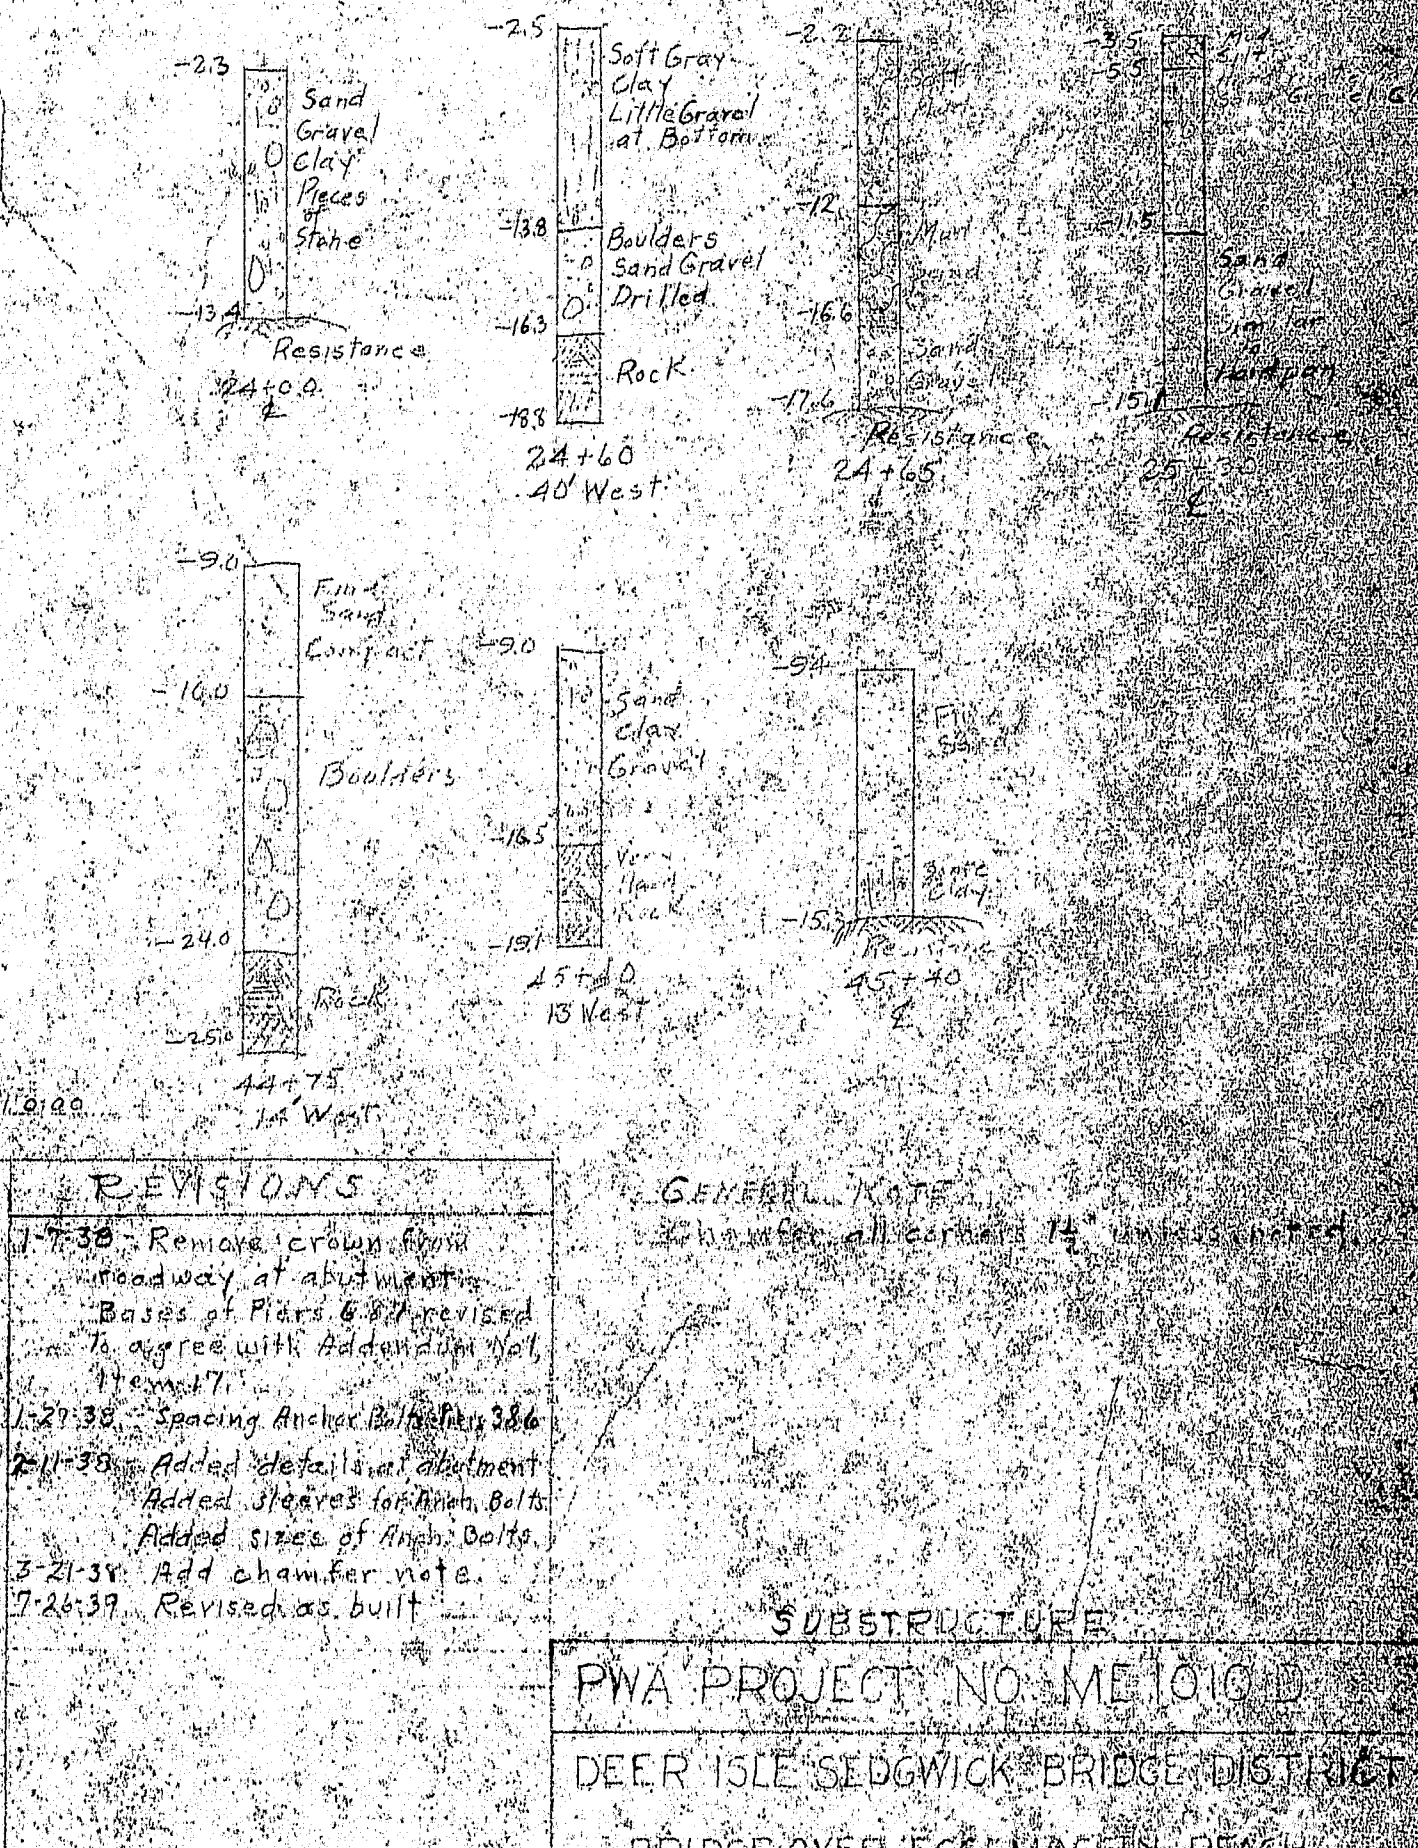


PIER NO. 1 Looking North

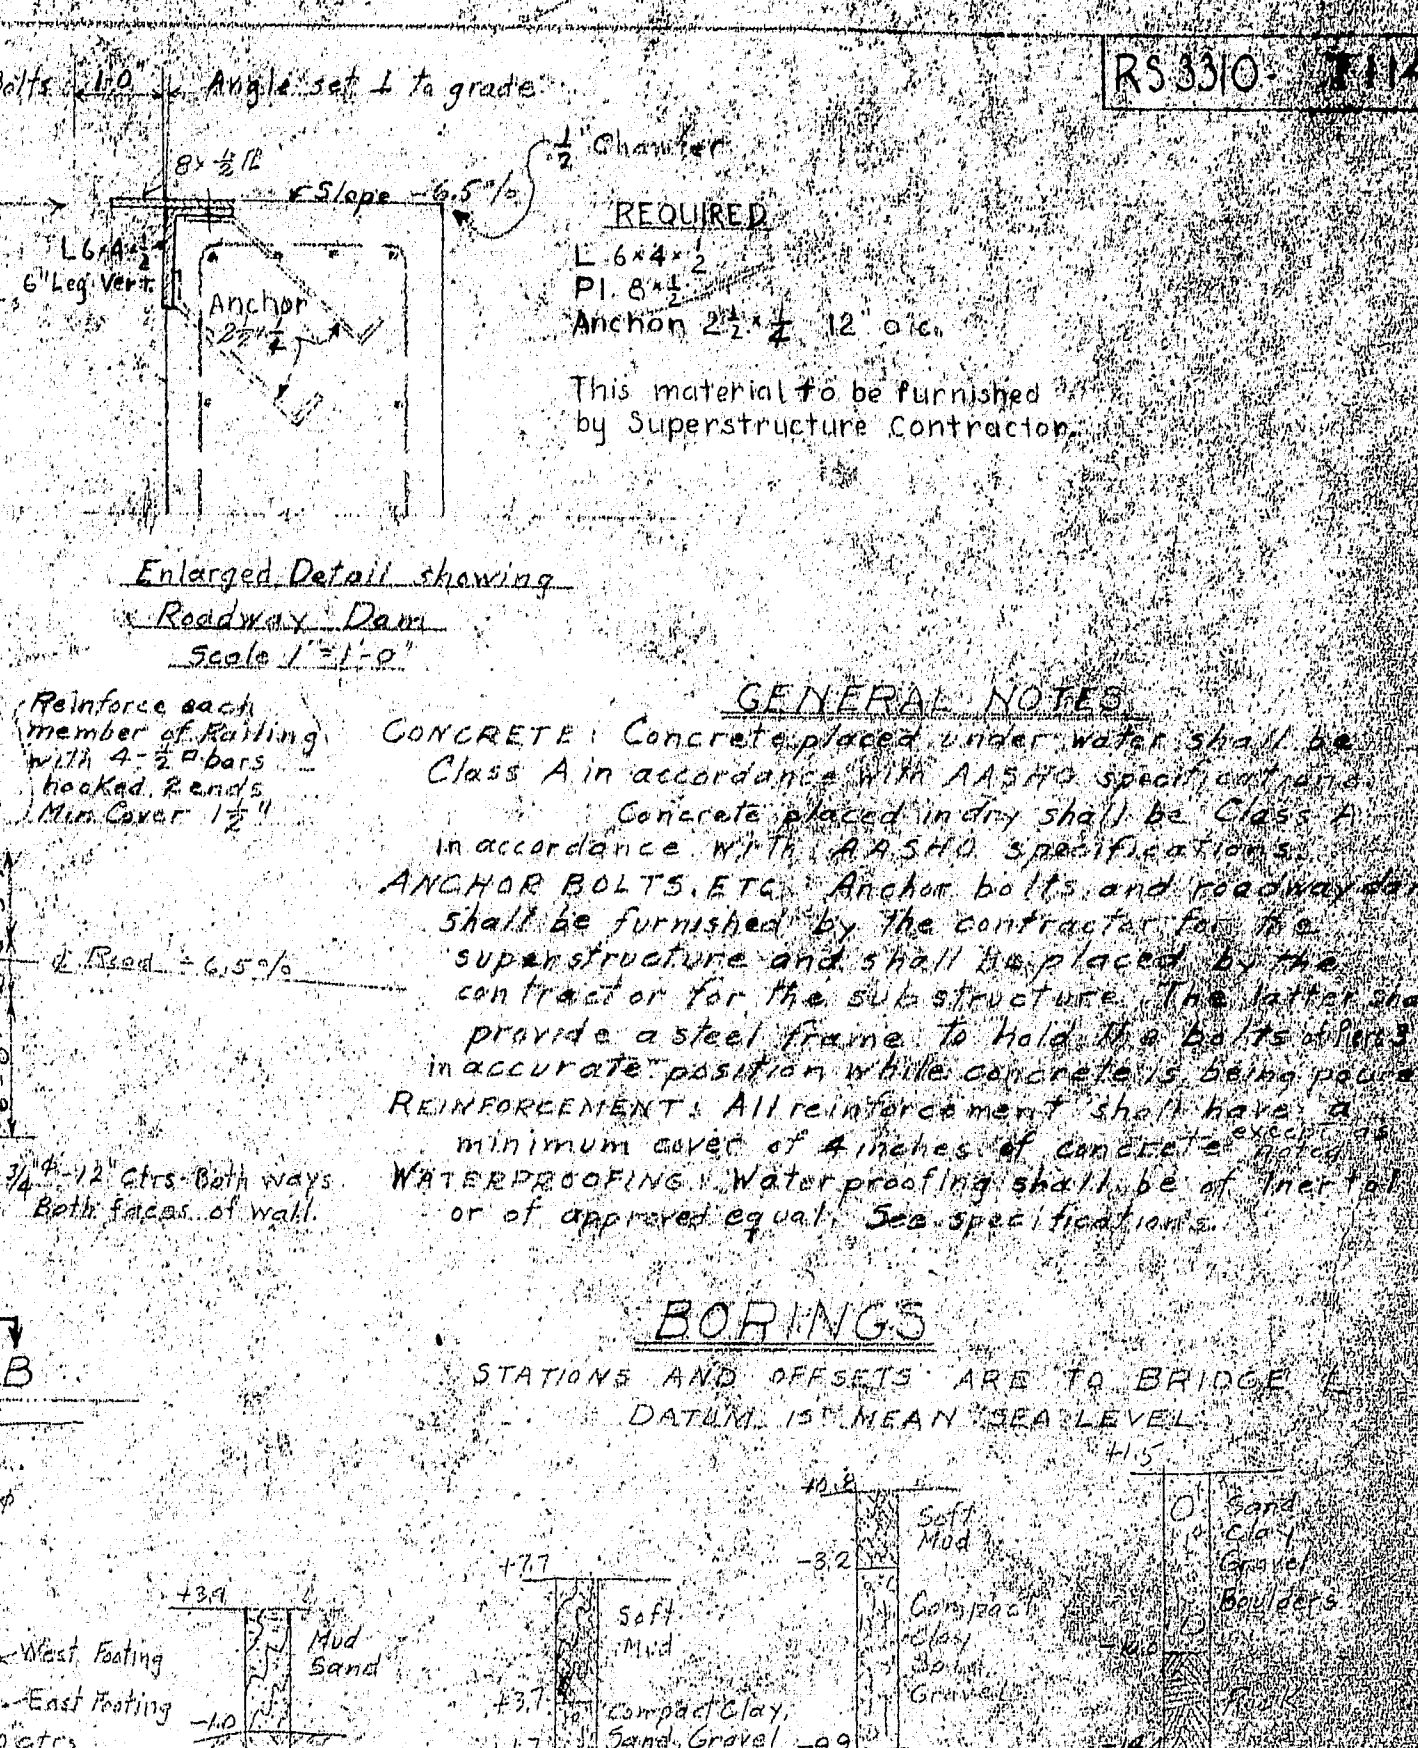


DEER ISLE ABUTMENT

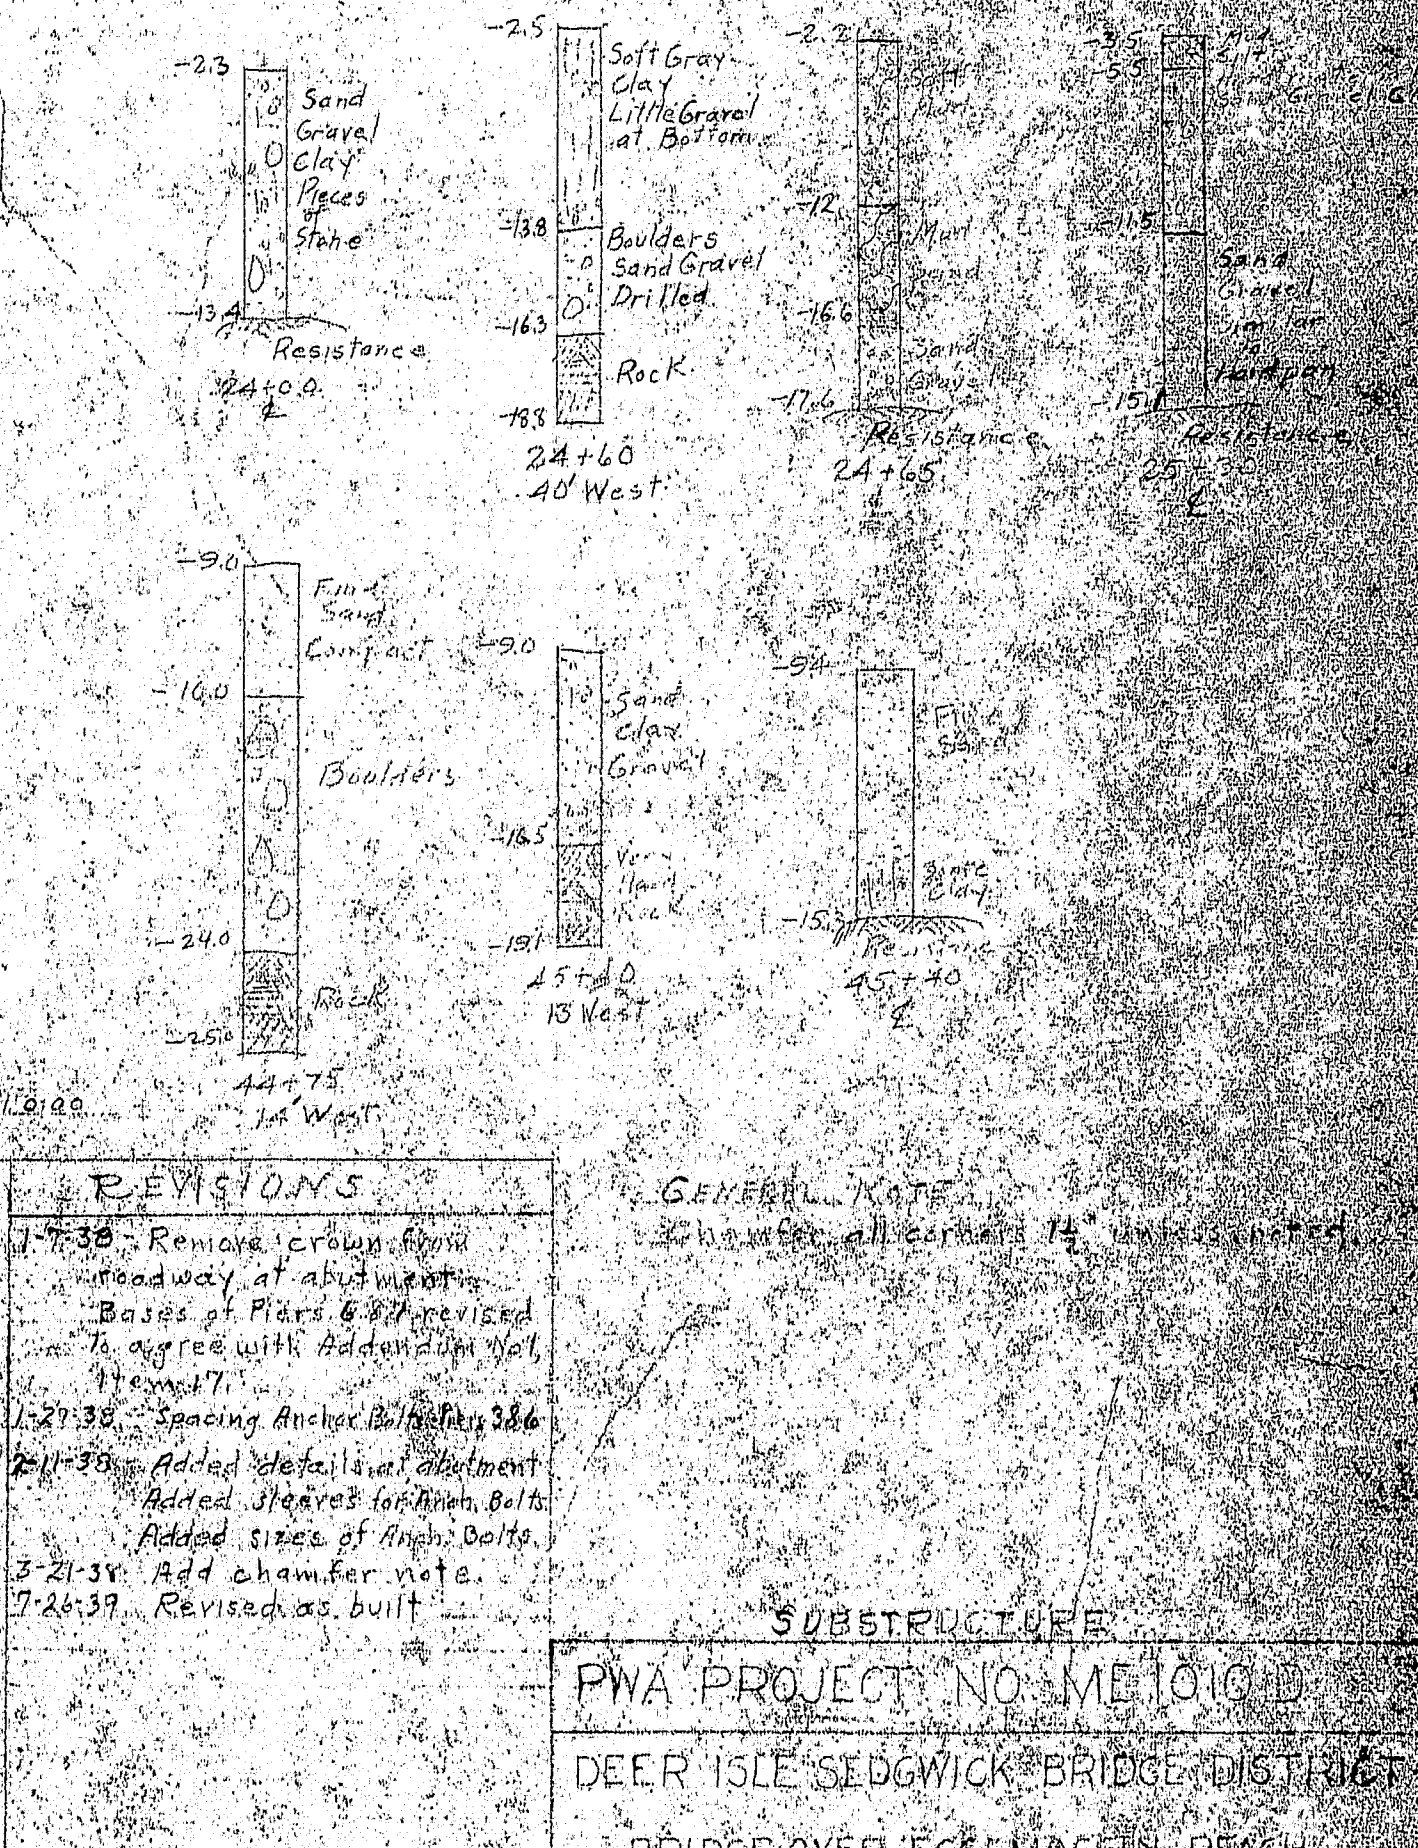


PIER NO. 1 Looking North

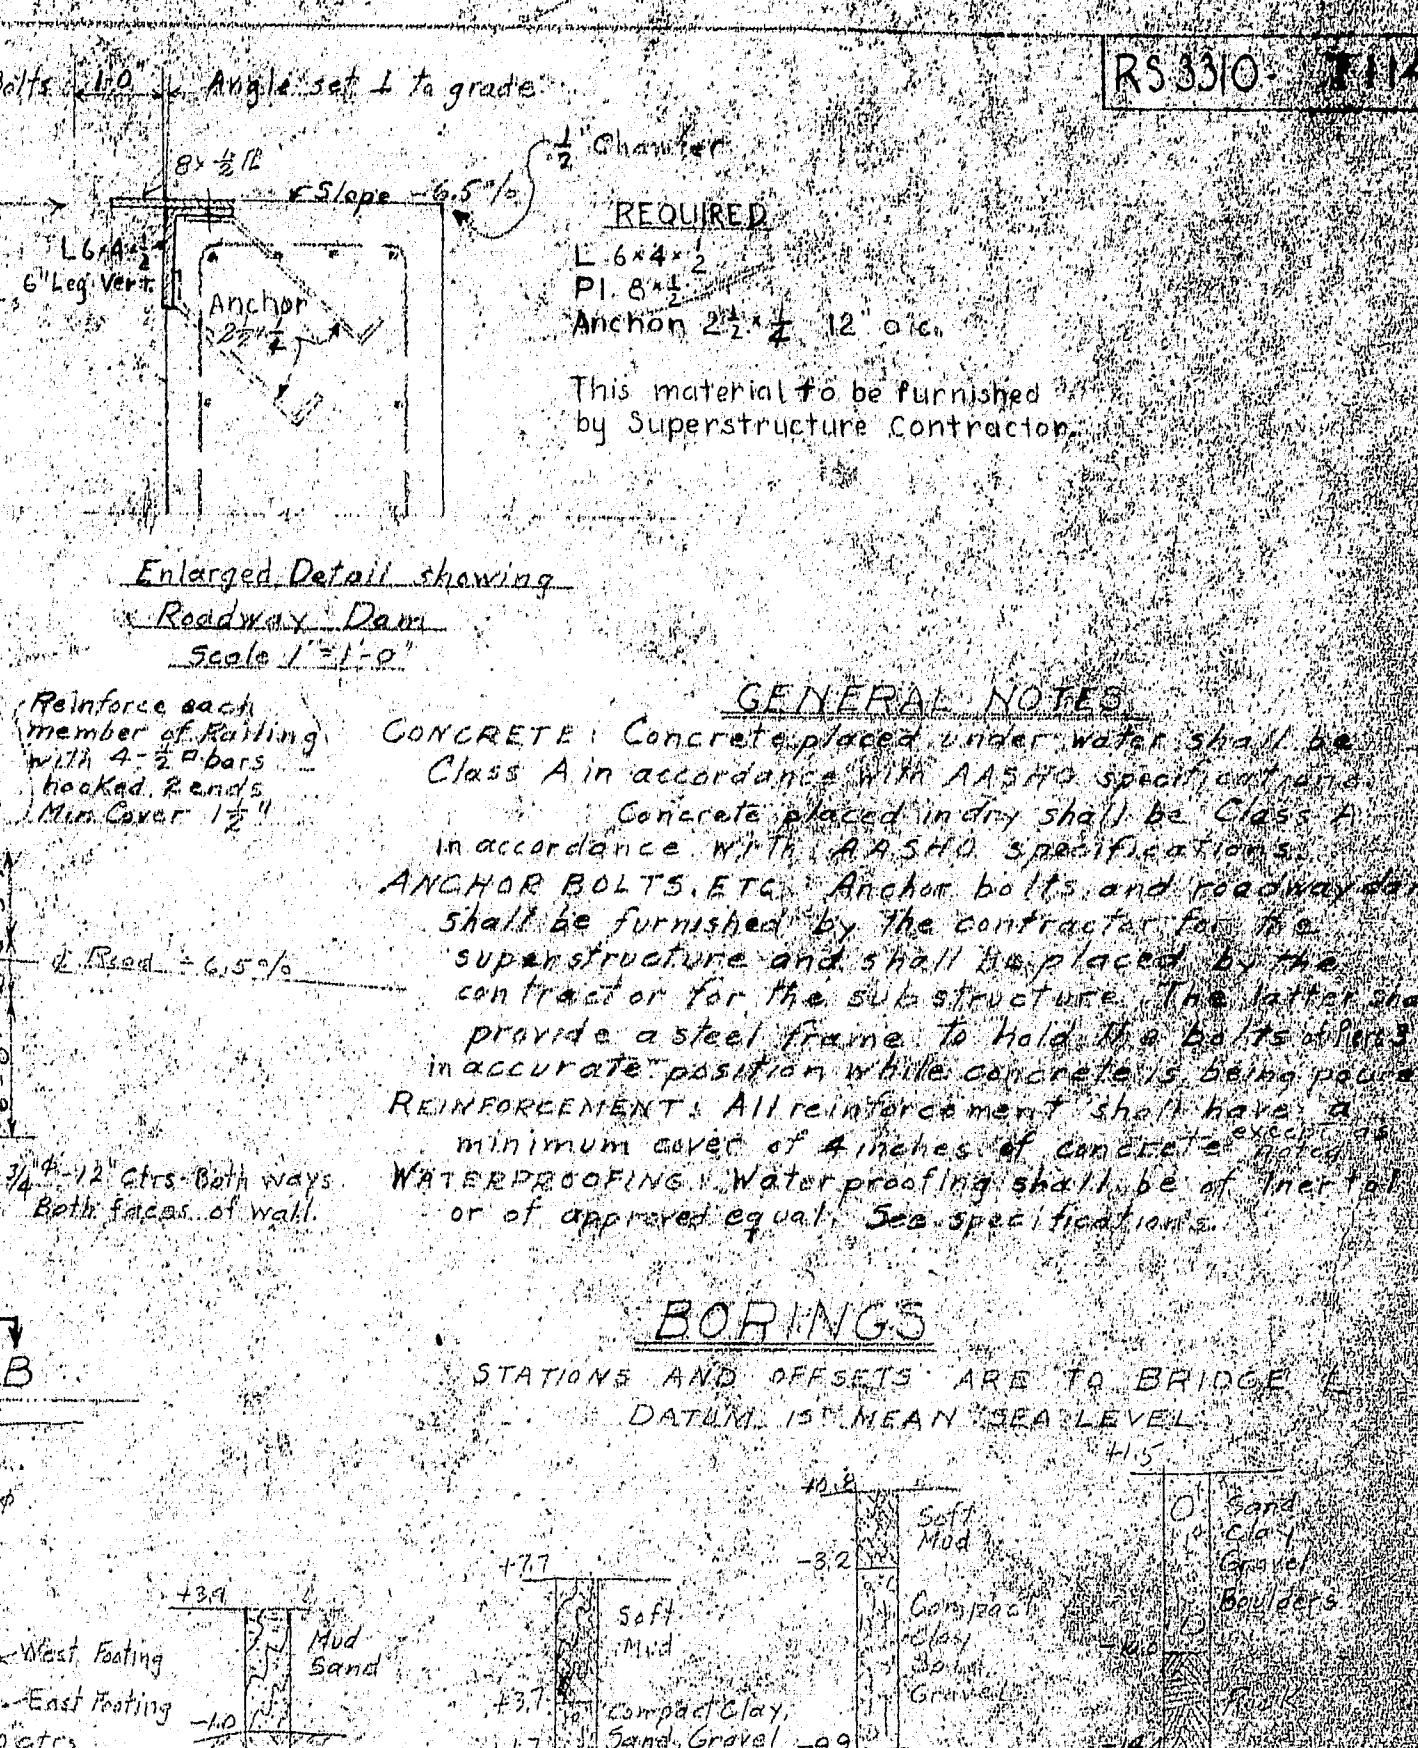


DEER ISLE ABUTMENT

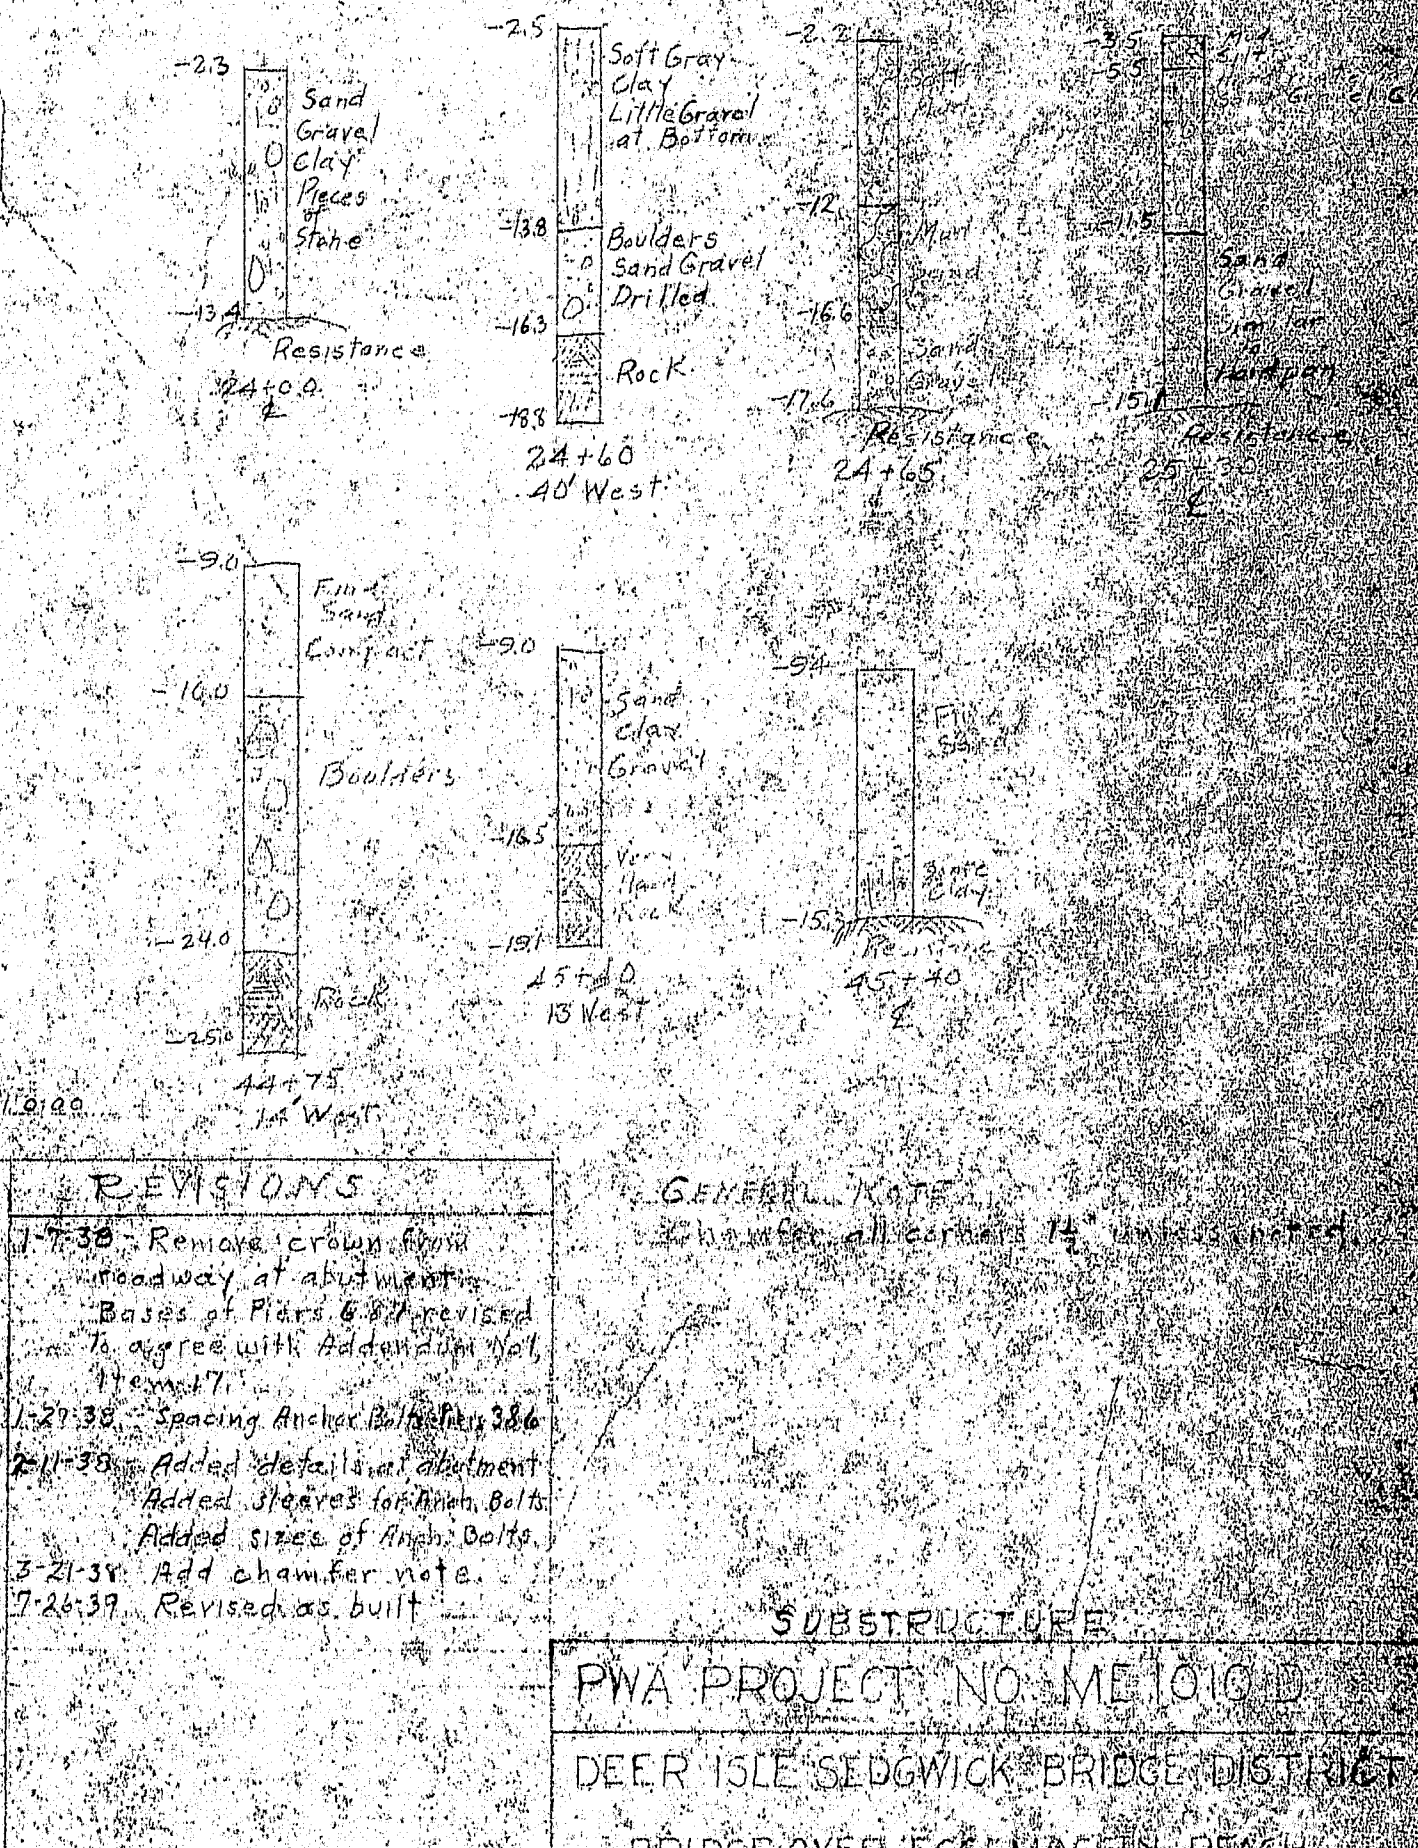


PIER NO. 1 Looking North

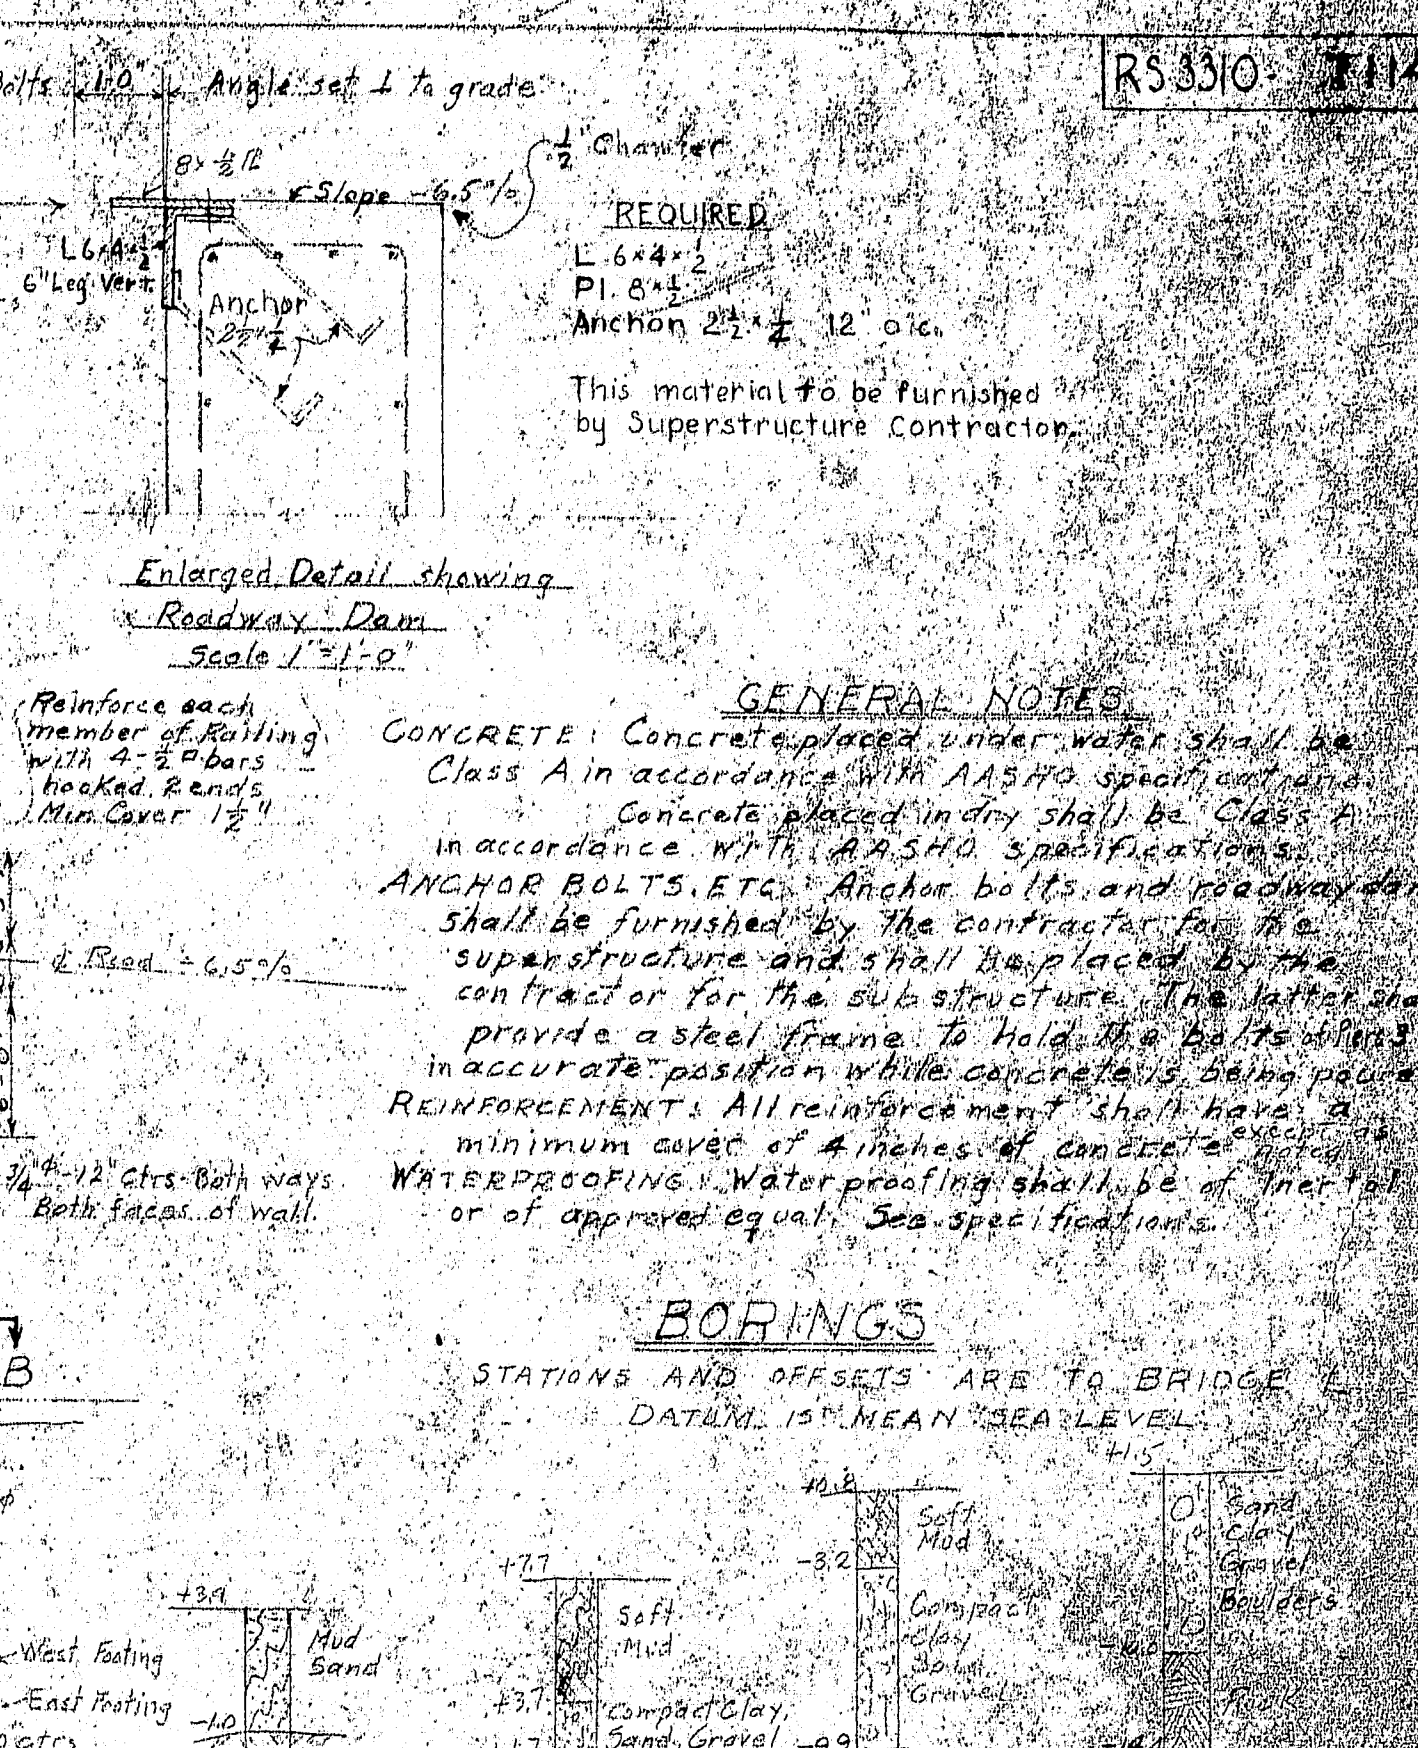


DEER ISLE ABUTMENT

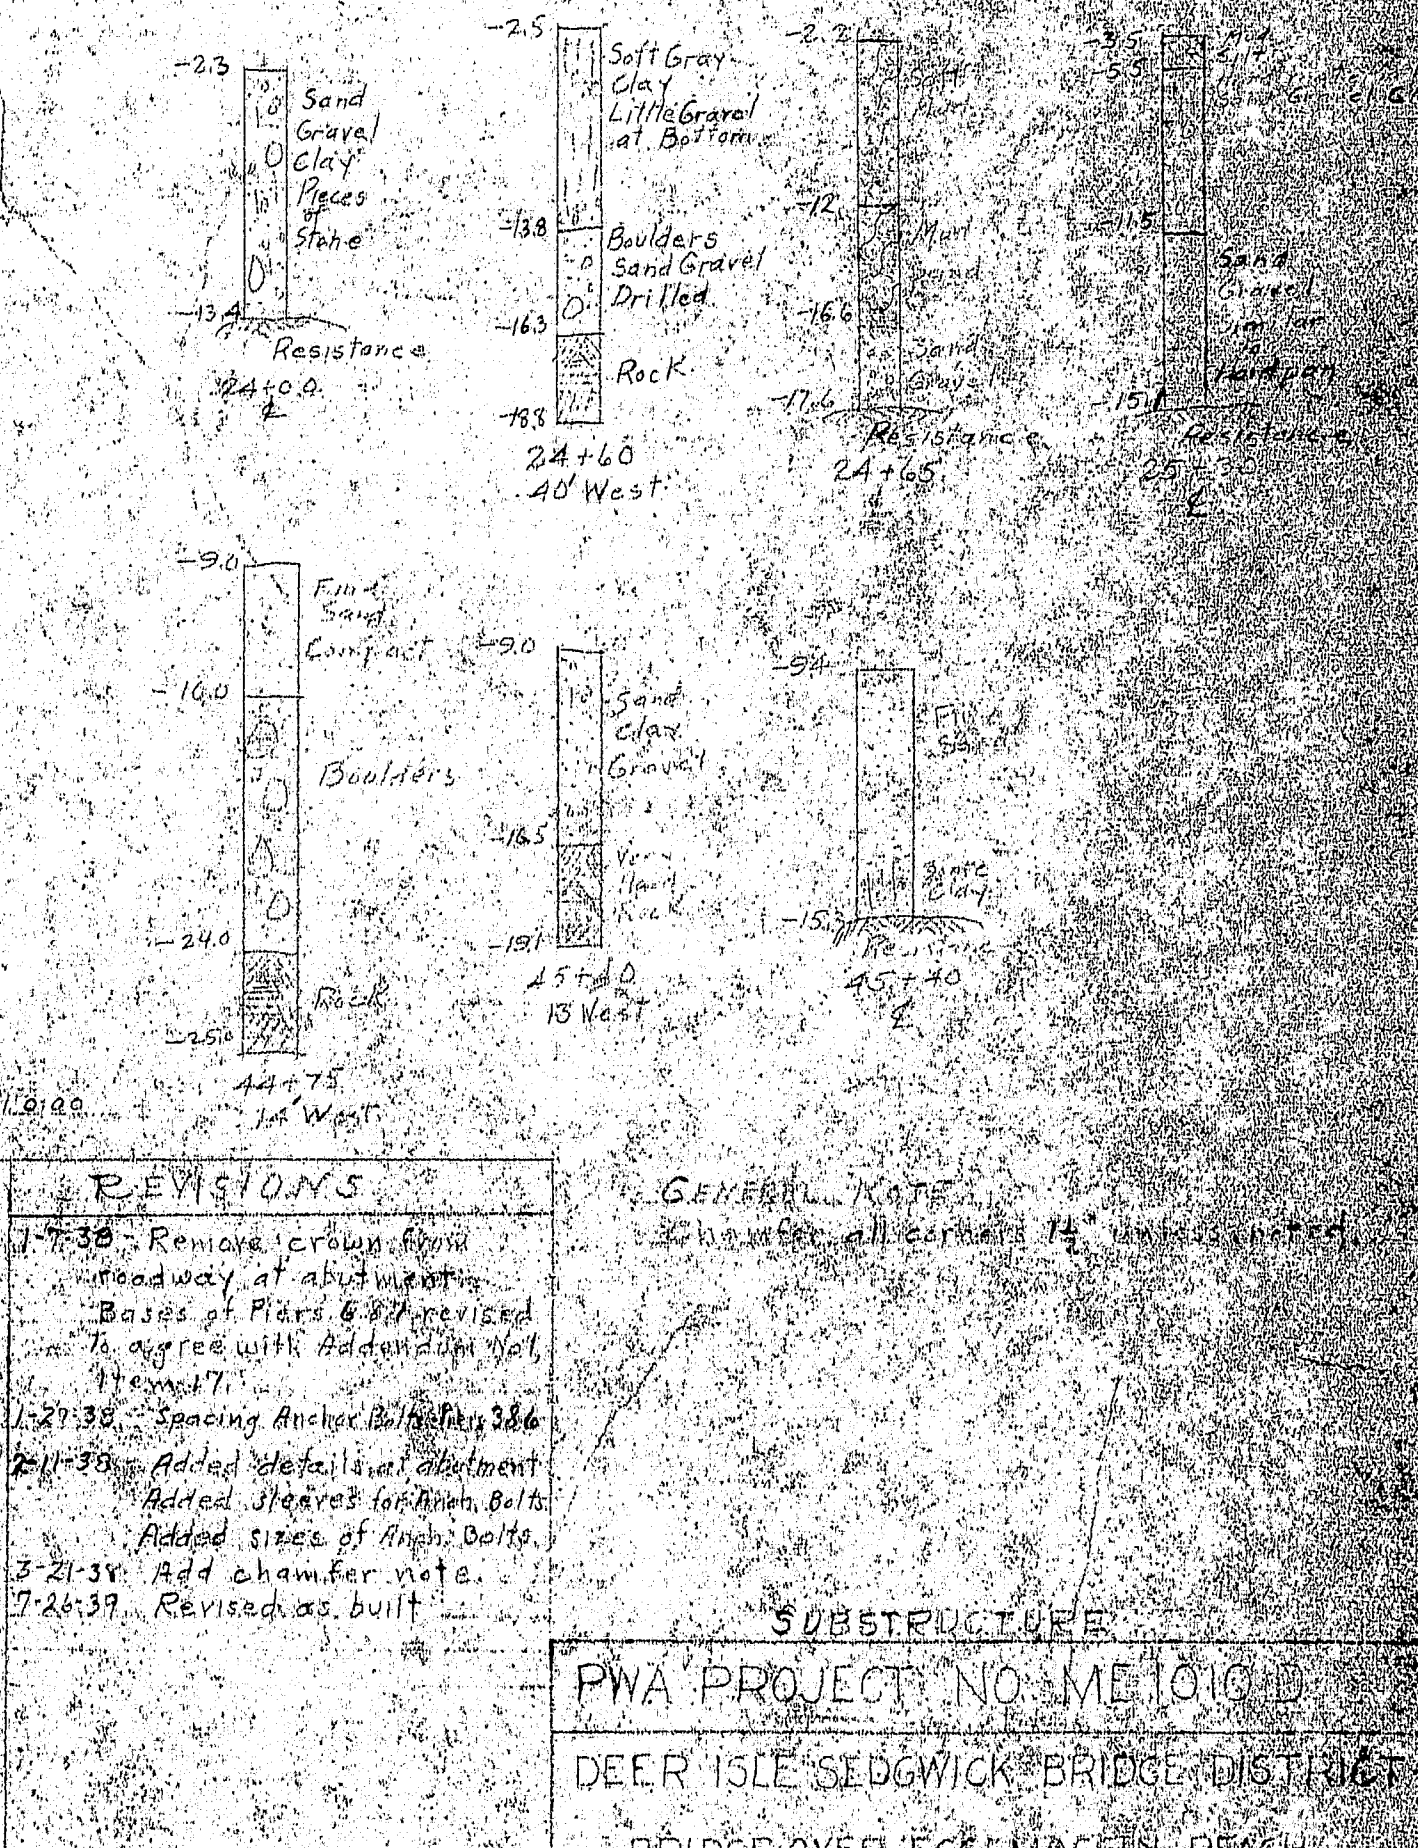


PIER NO. 1 Looking North

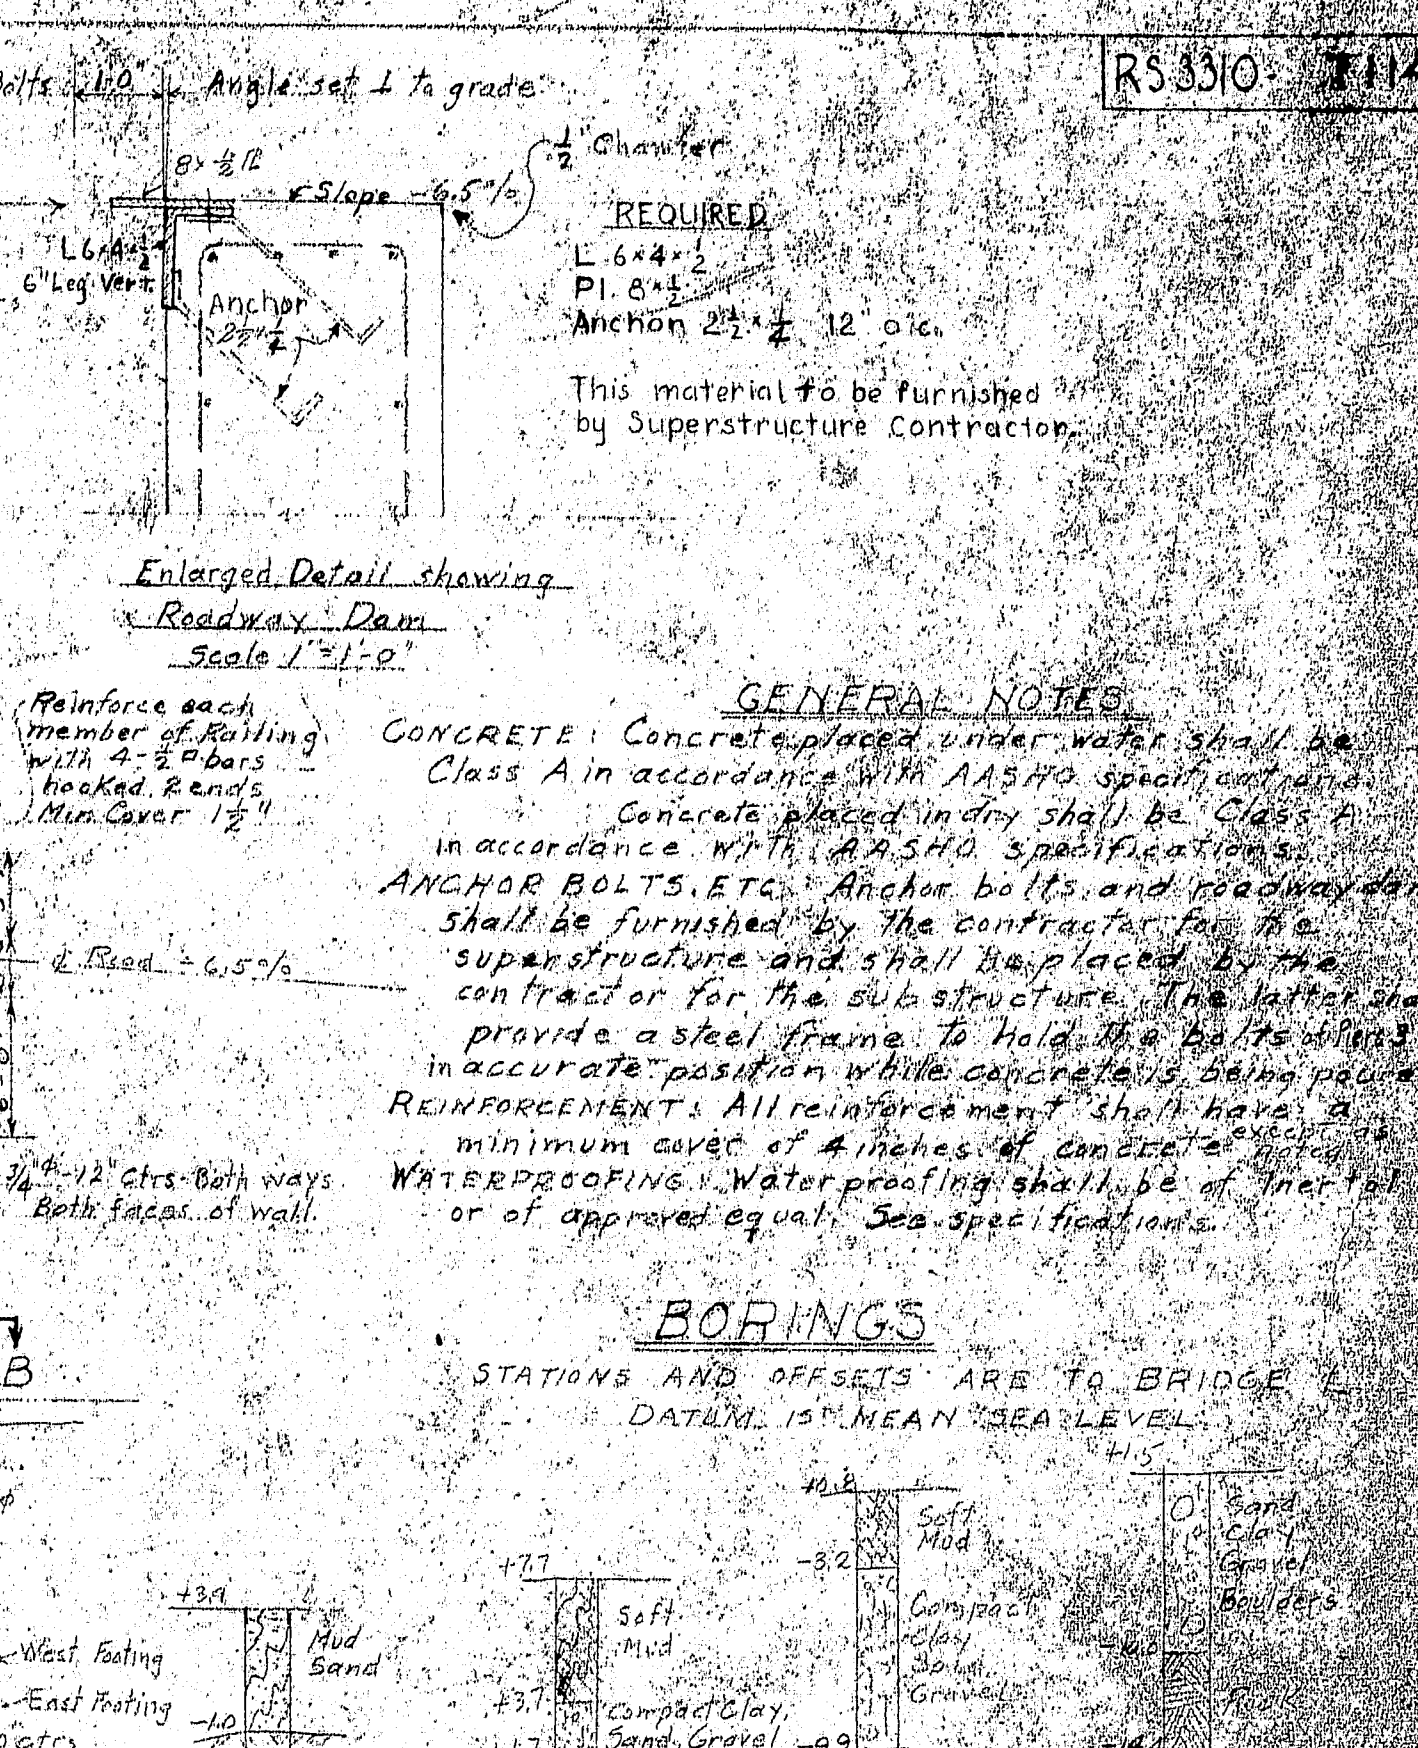


DEER ISLE ABUTMENT

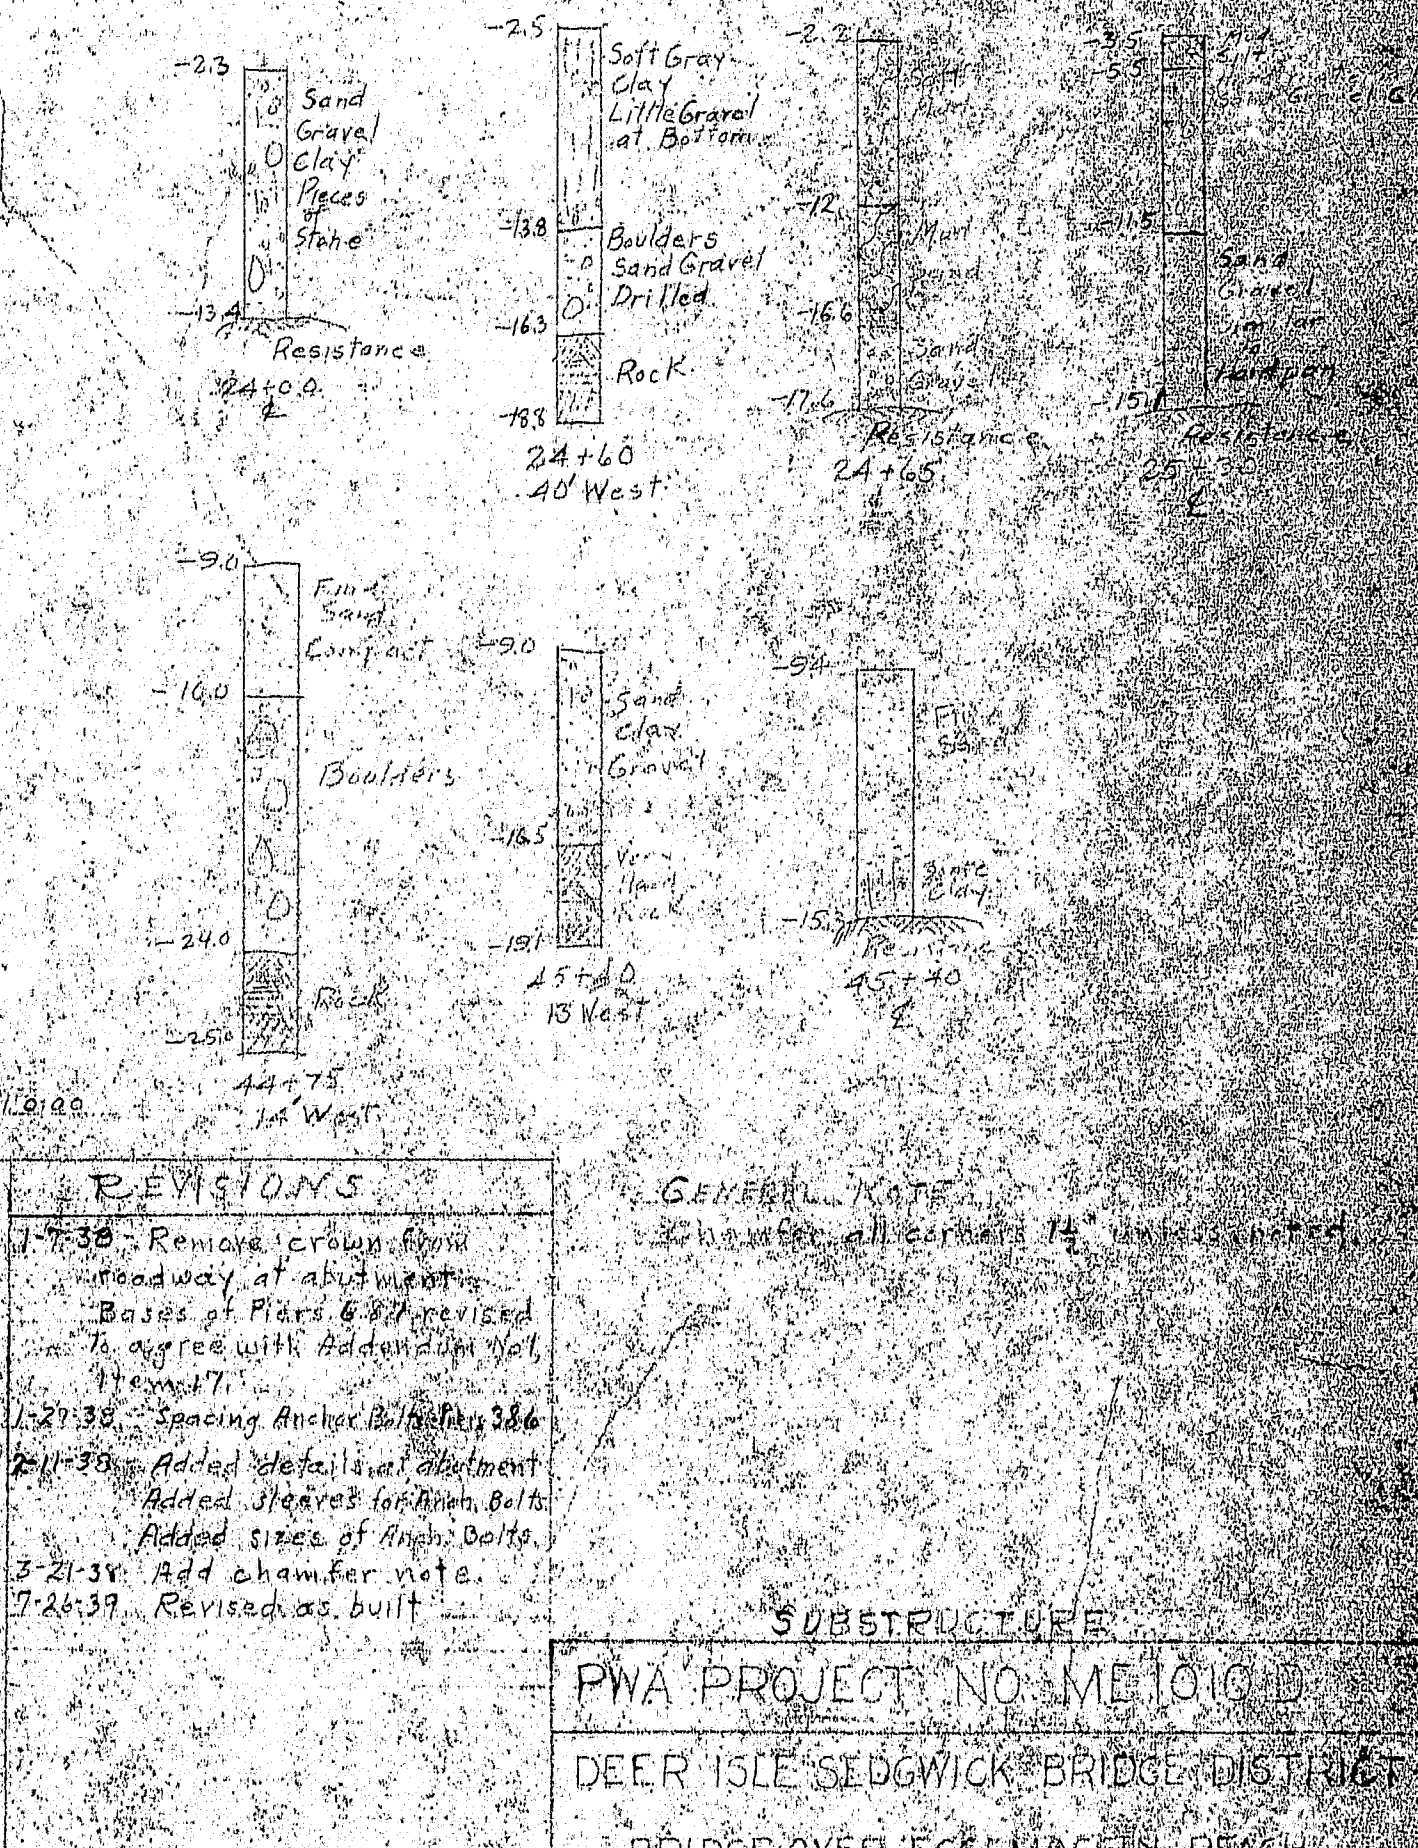


PIER NO. 1 Looking North

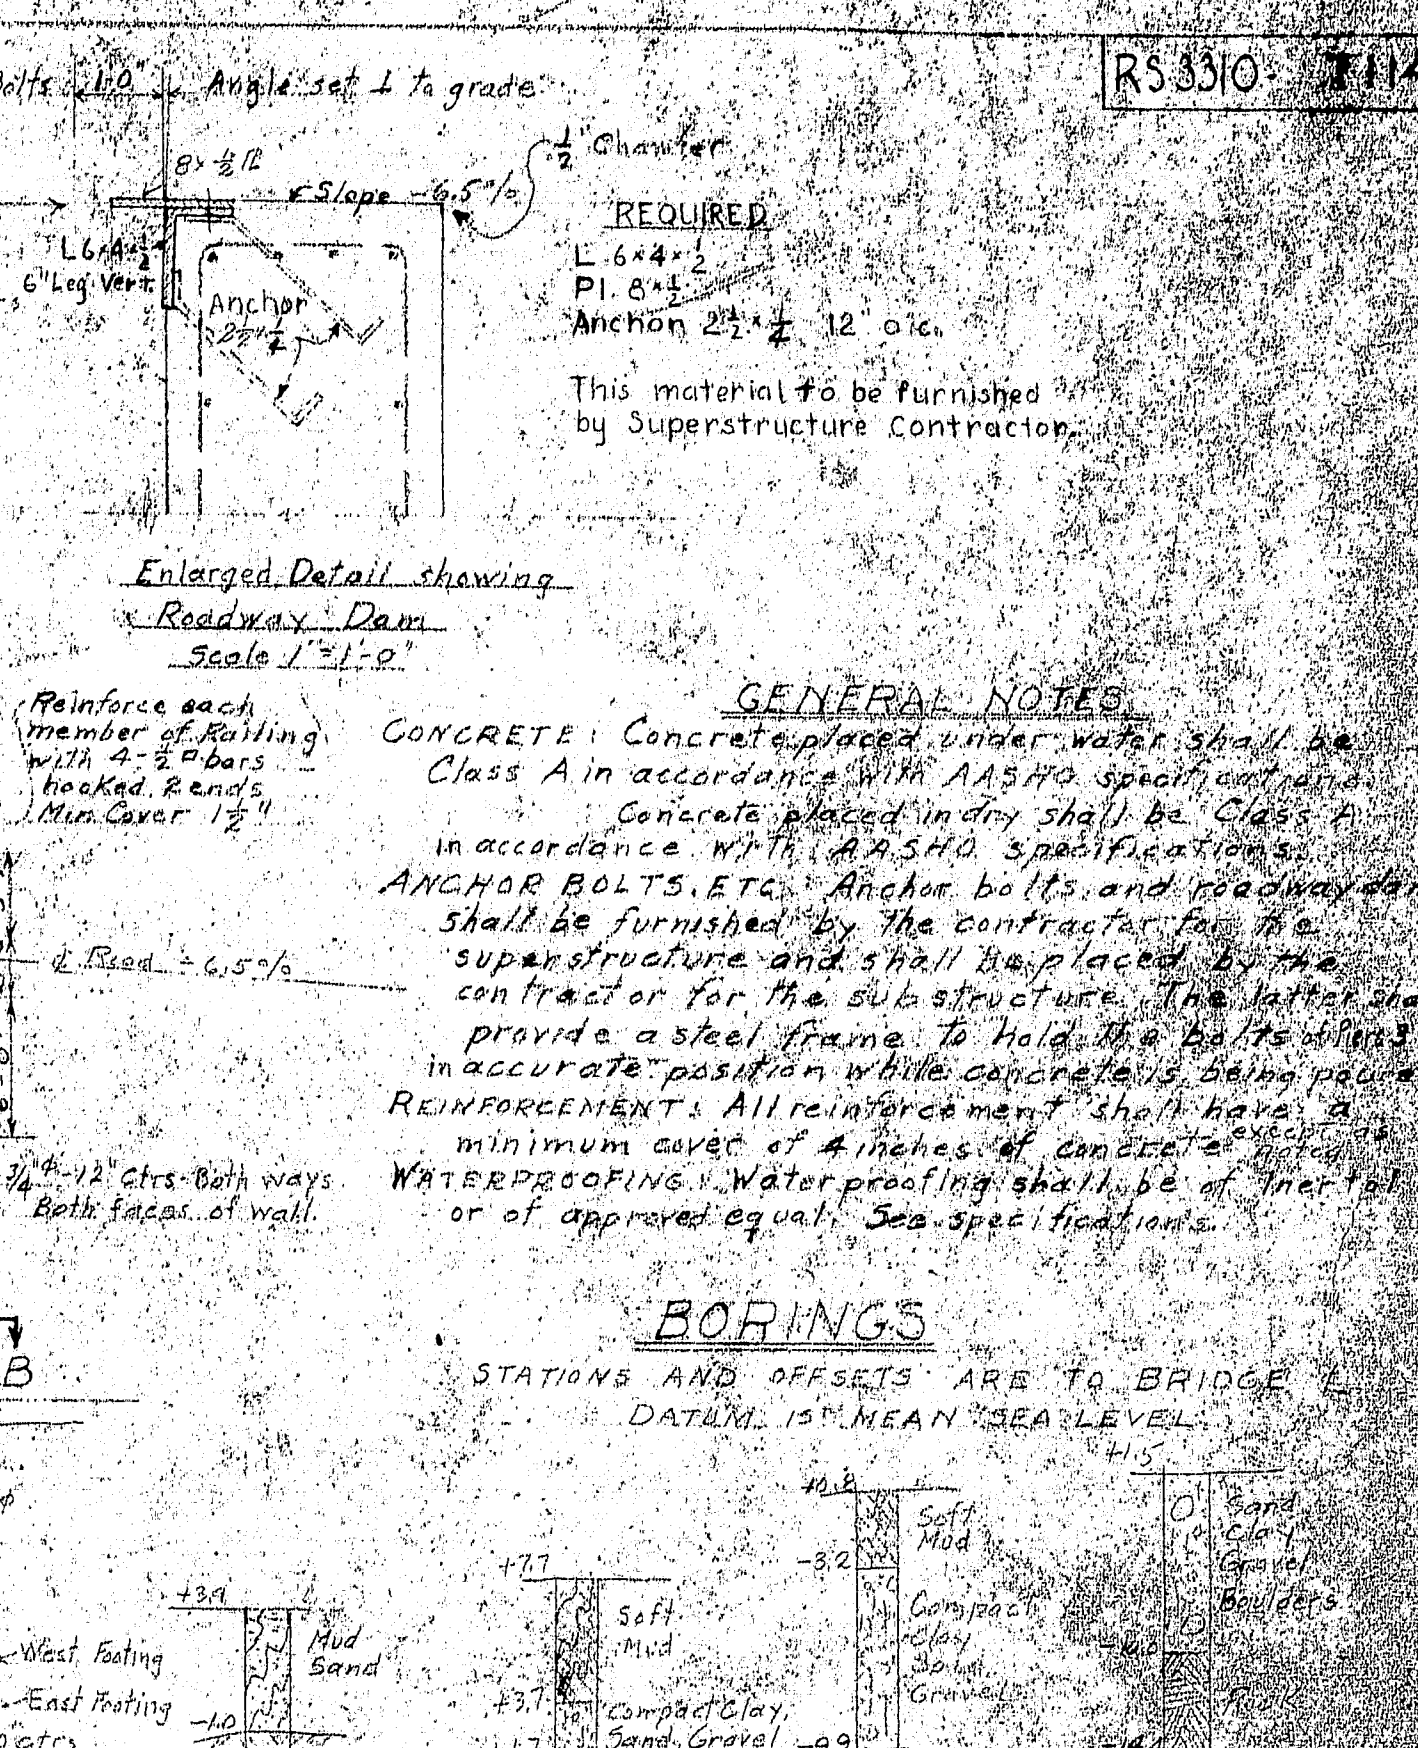


DEER ISLE ABUTMENT

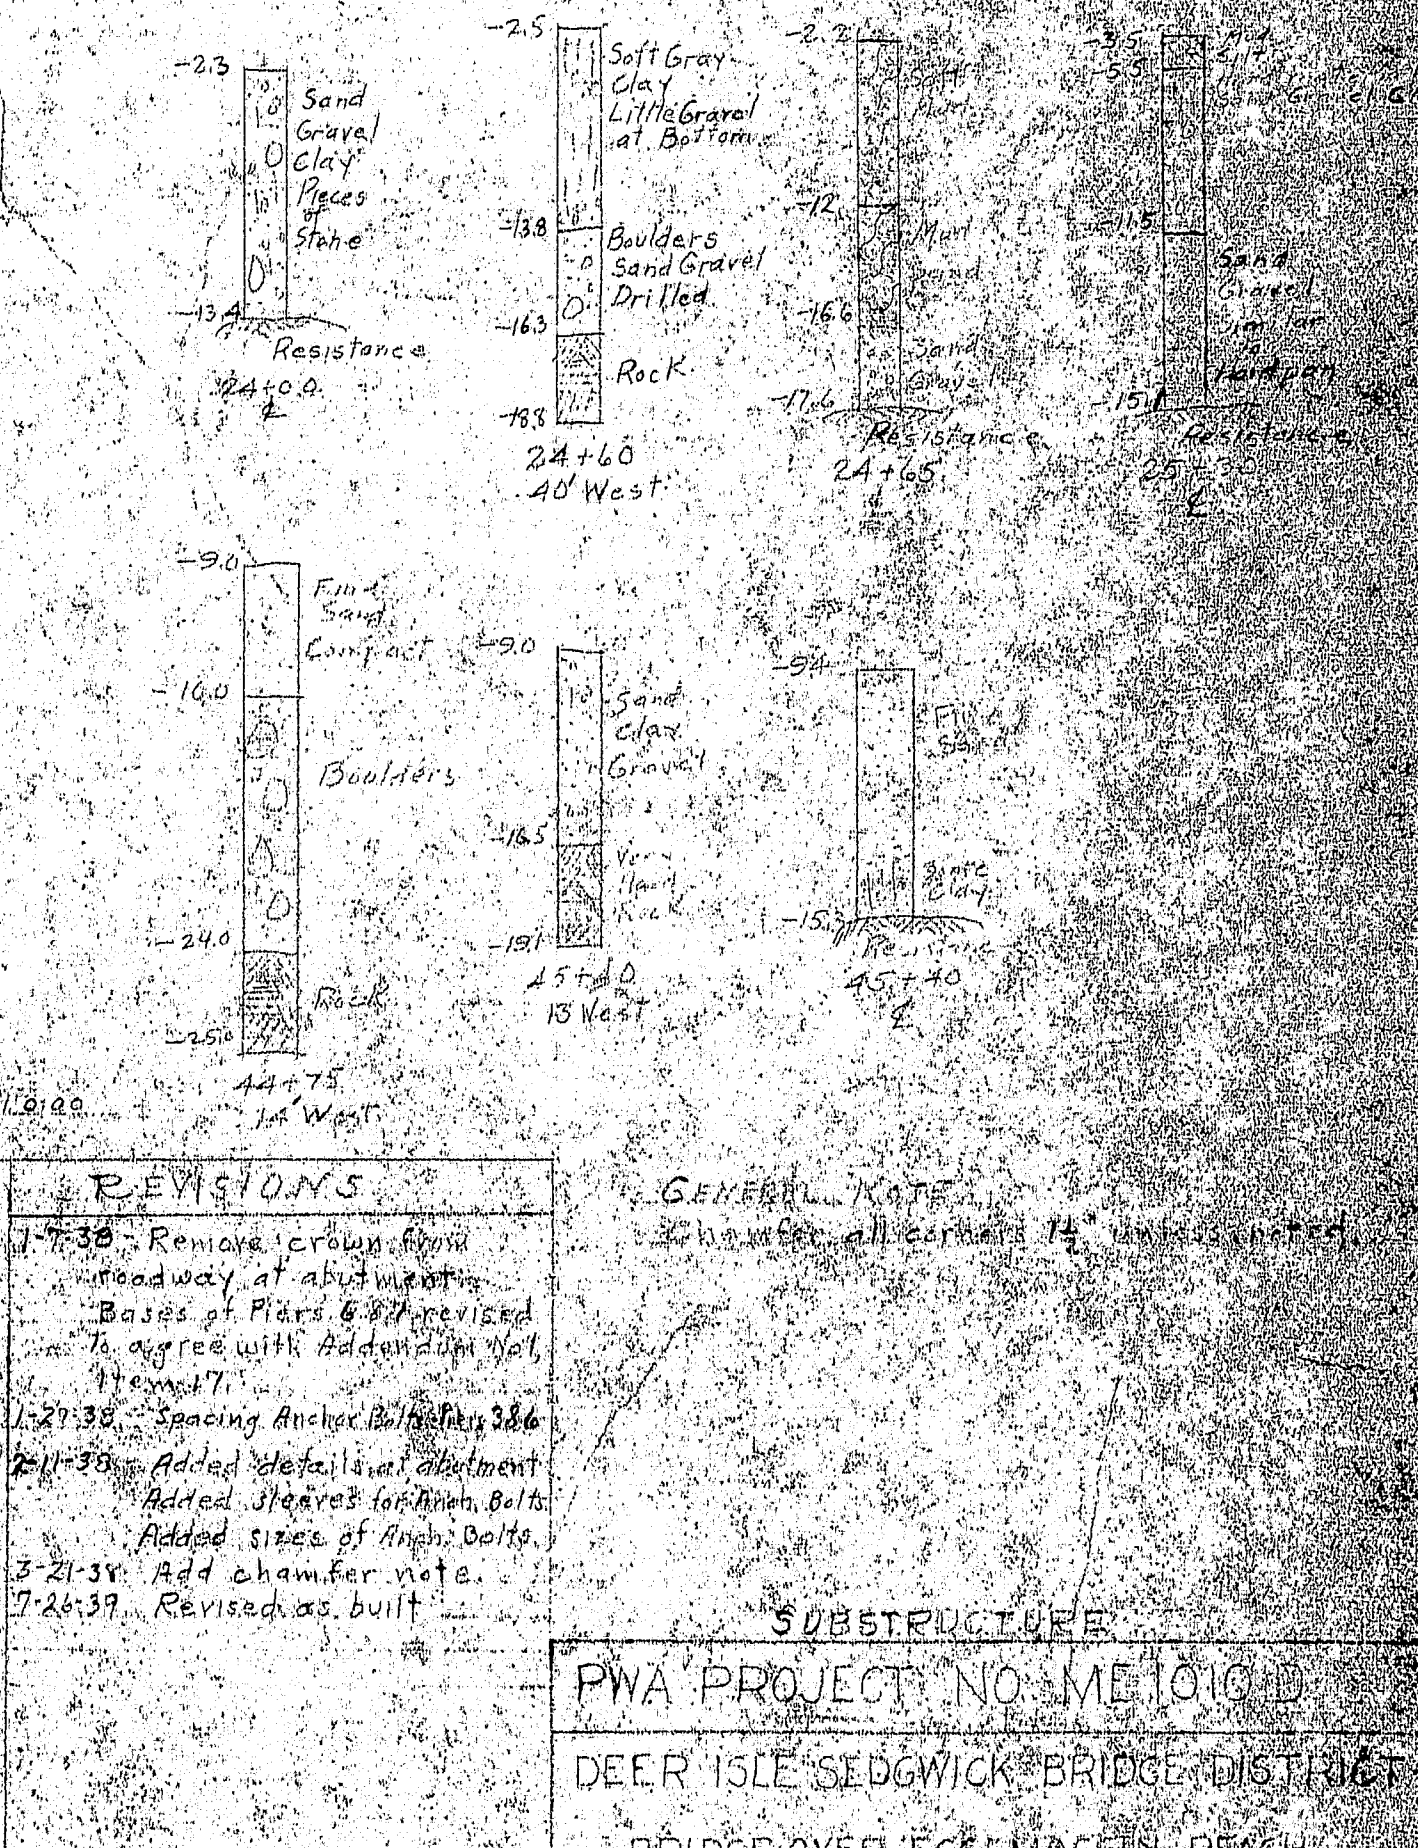


PIER NO. 1 Looking North

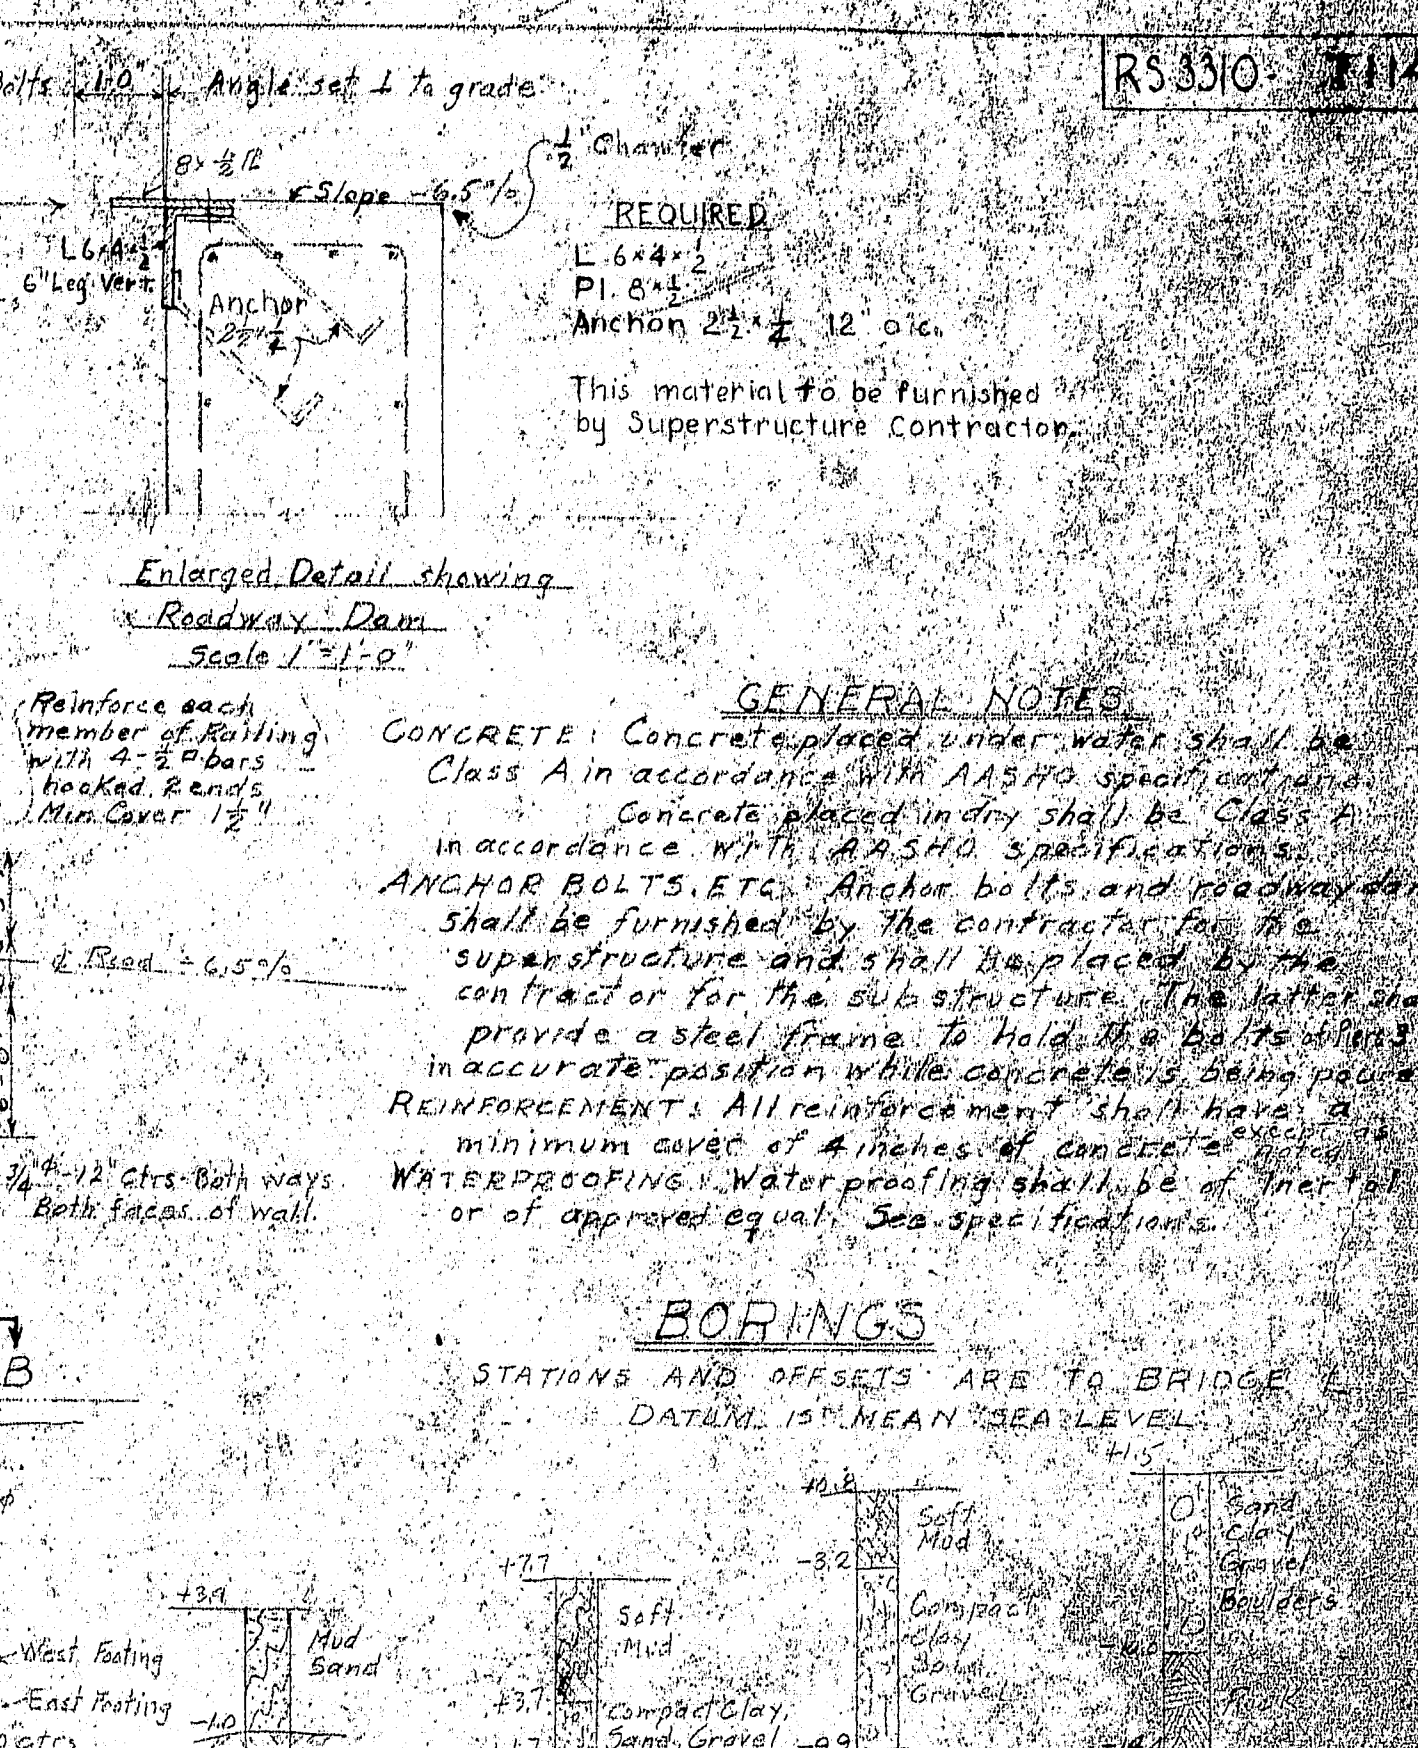


DEER ISLE ABUTMENT

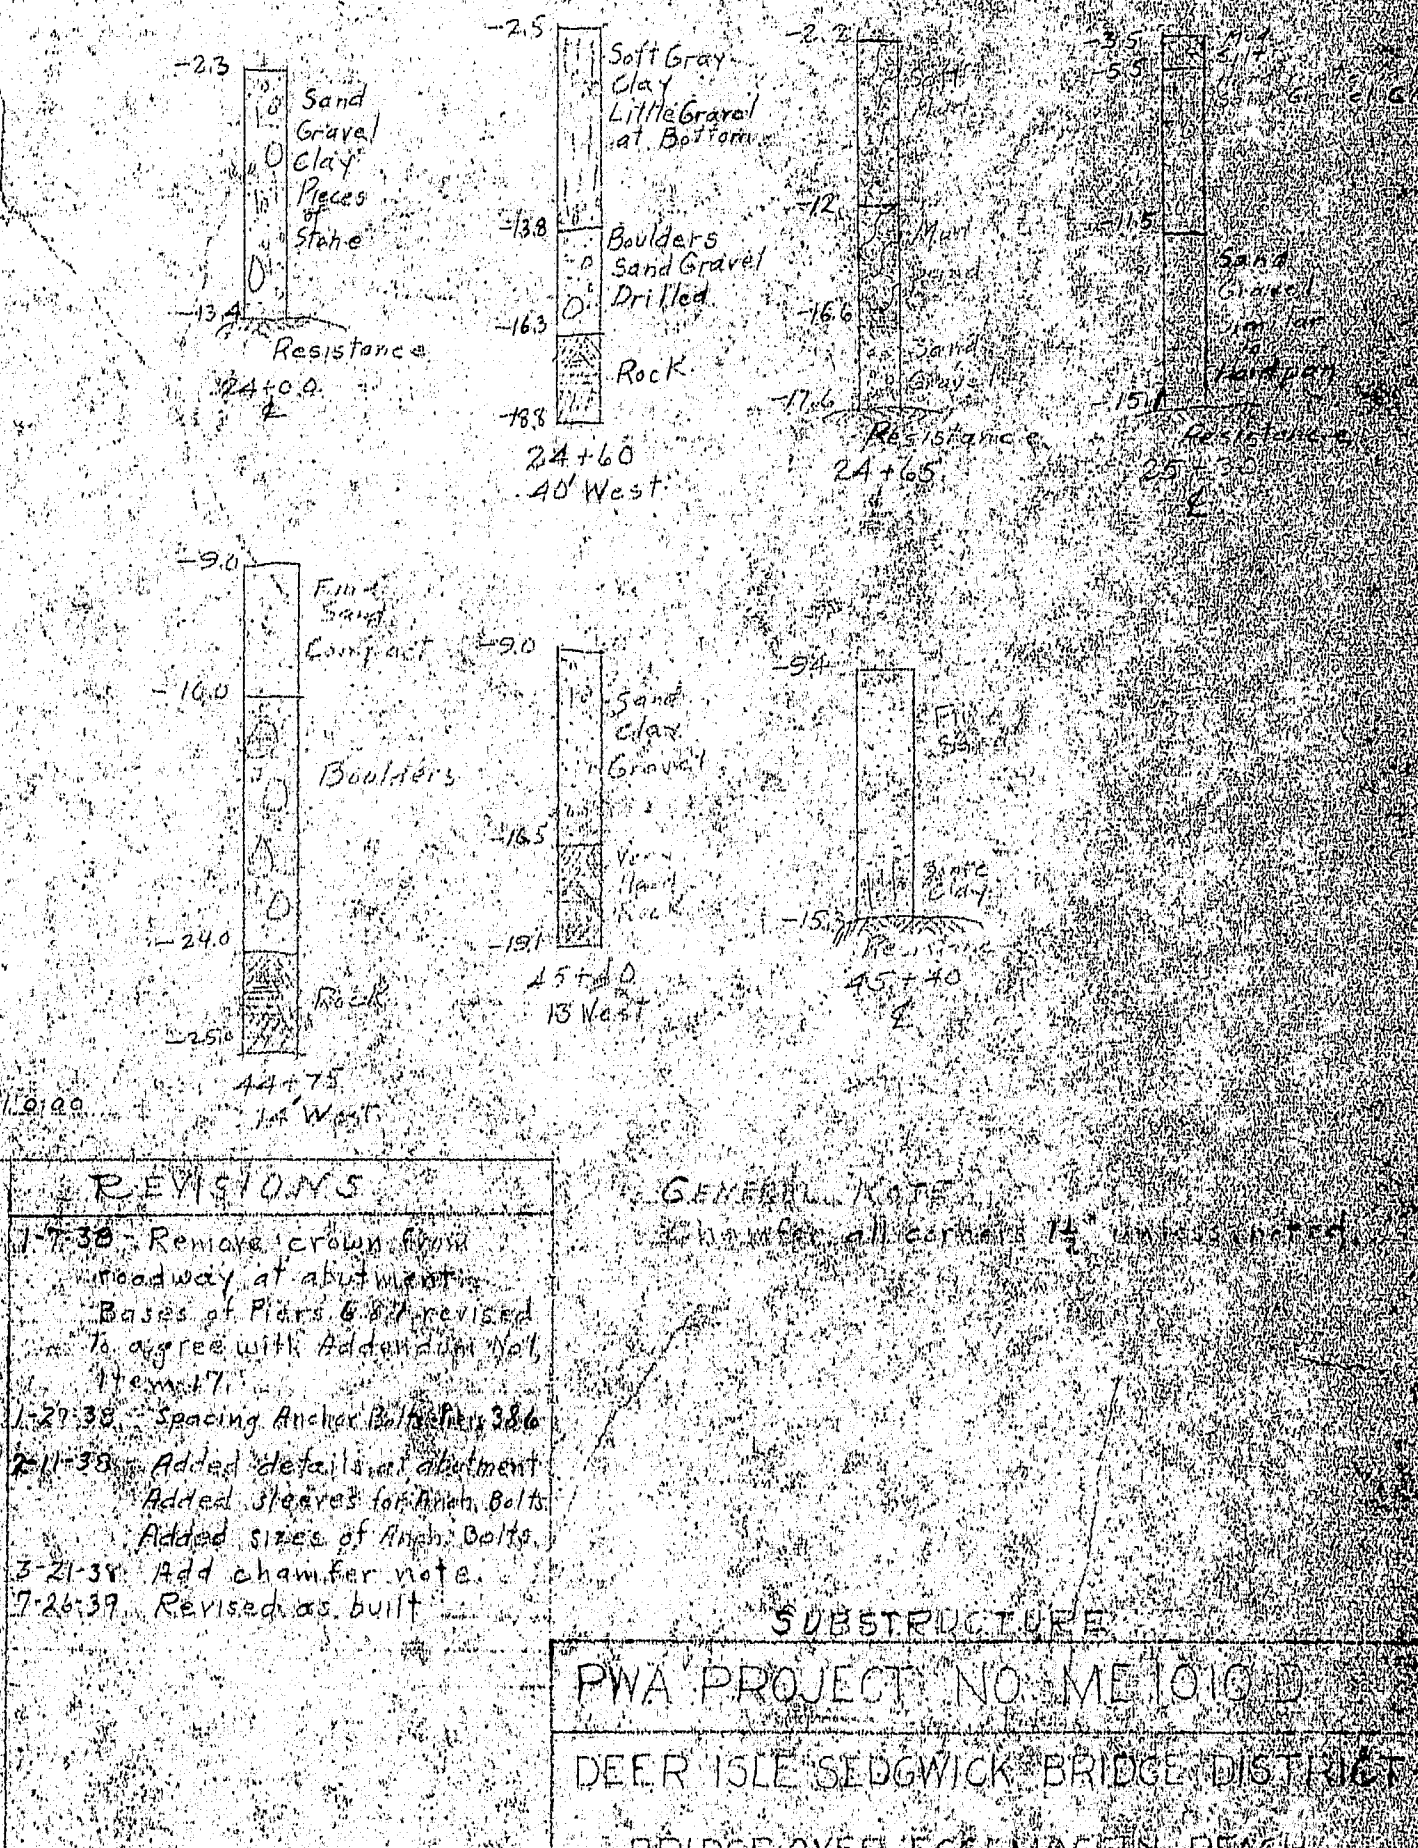


PIER NO. 1 Looking North

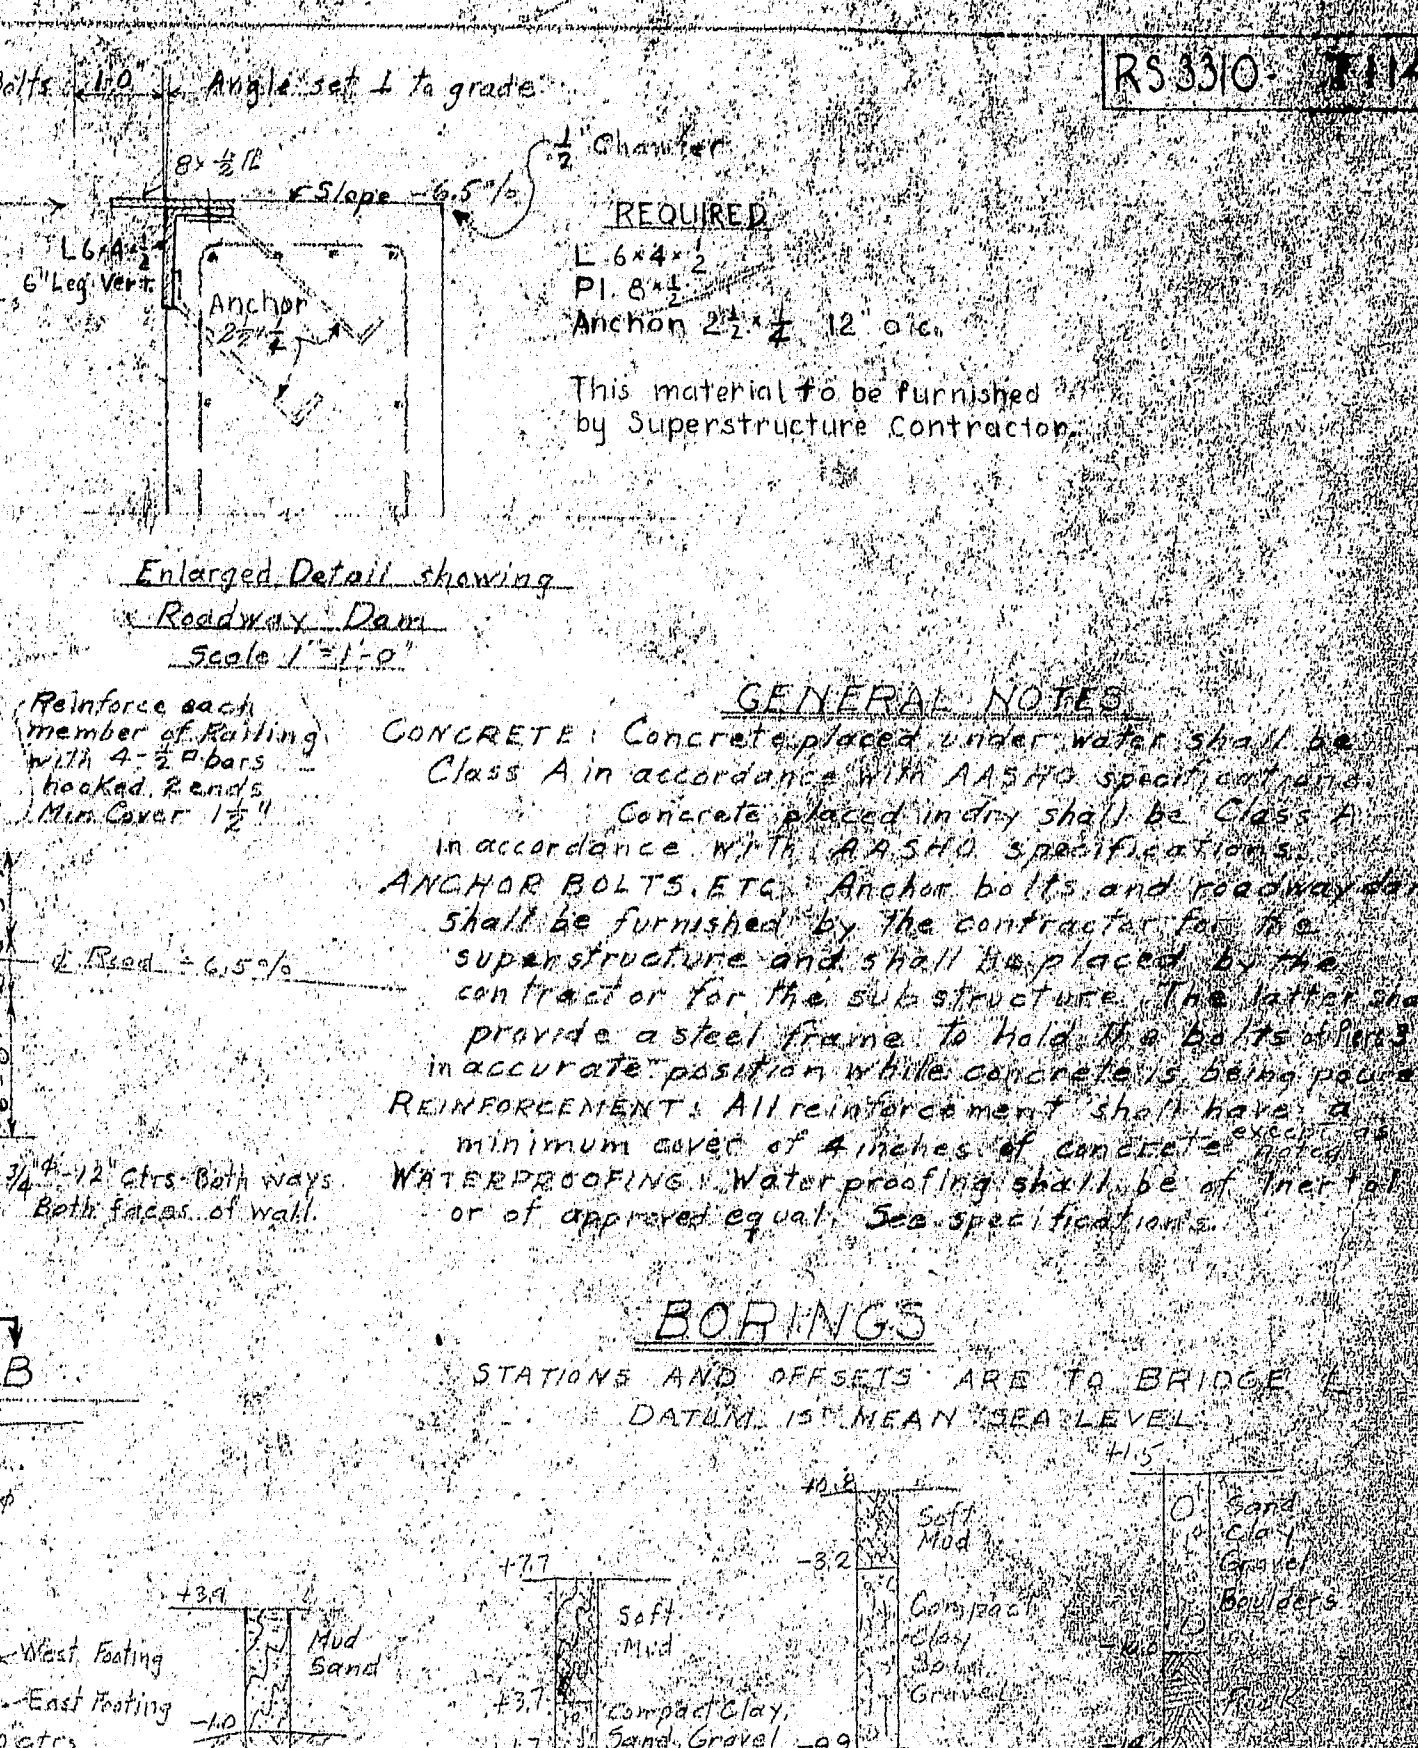


DEER ISLE ABUTMENT

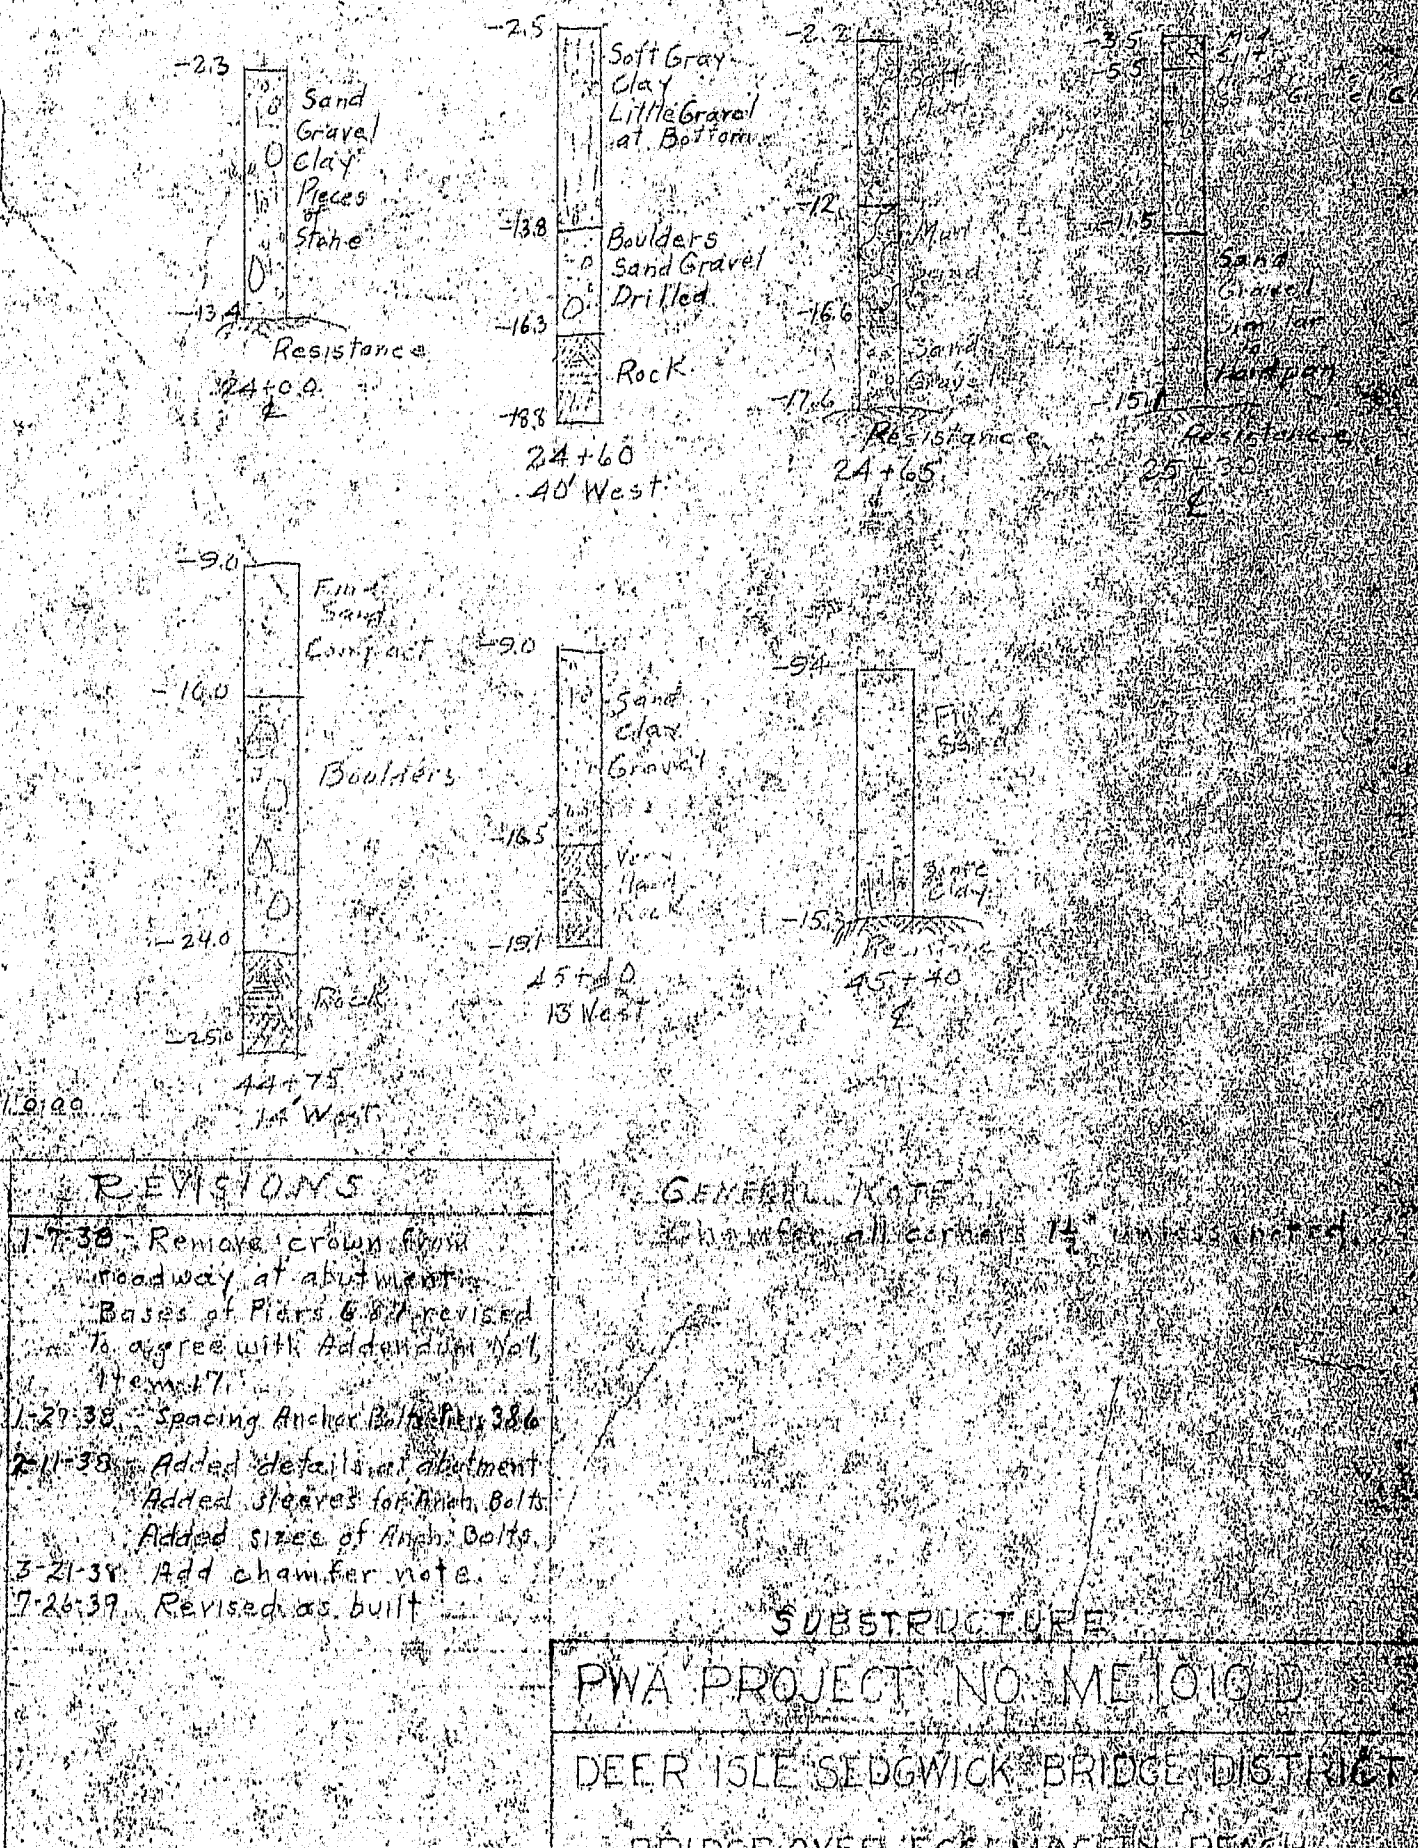


PIER NO. 1 Looking North

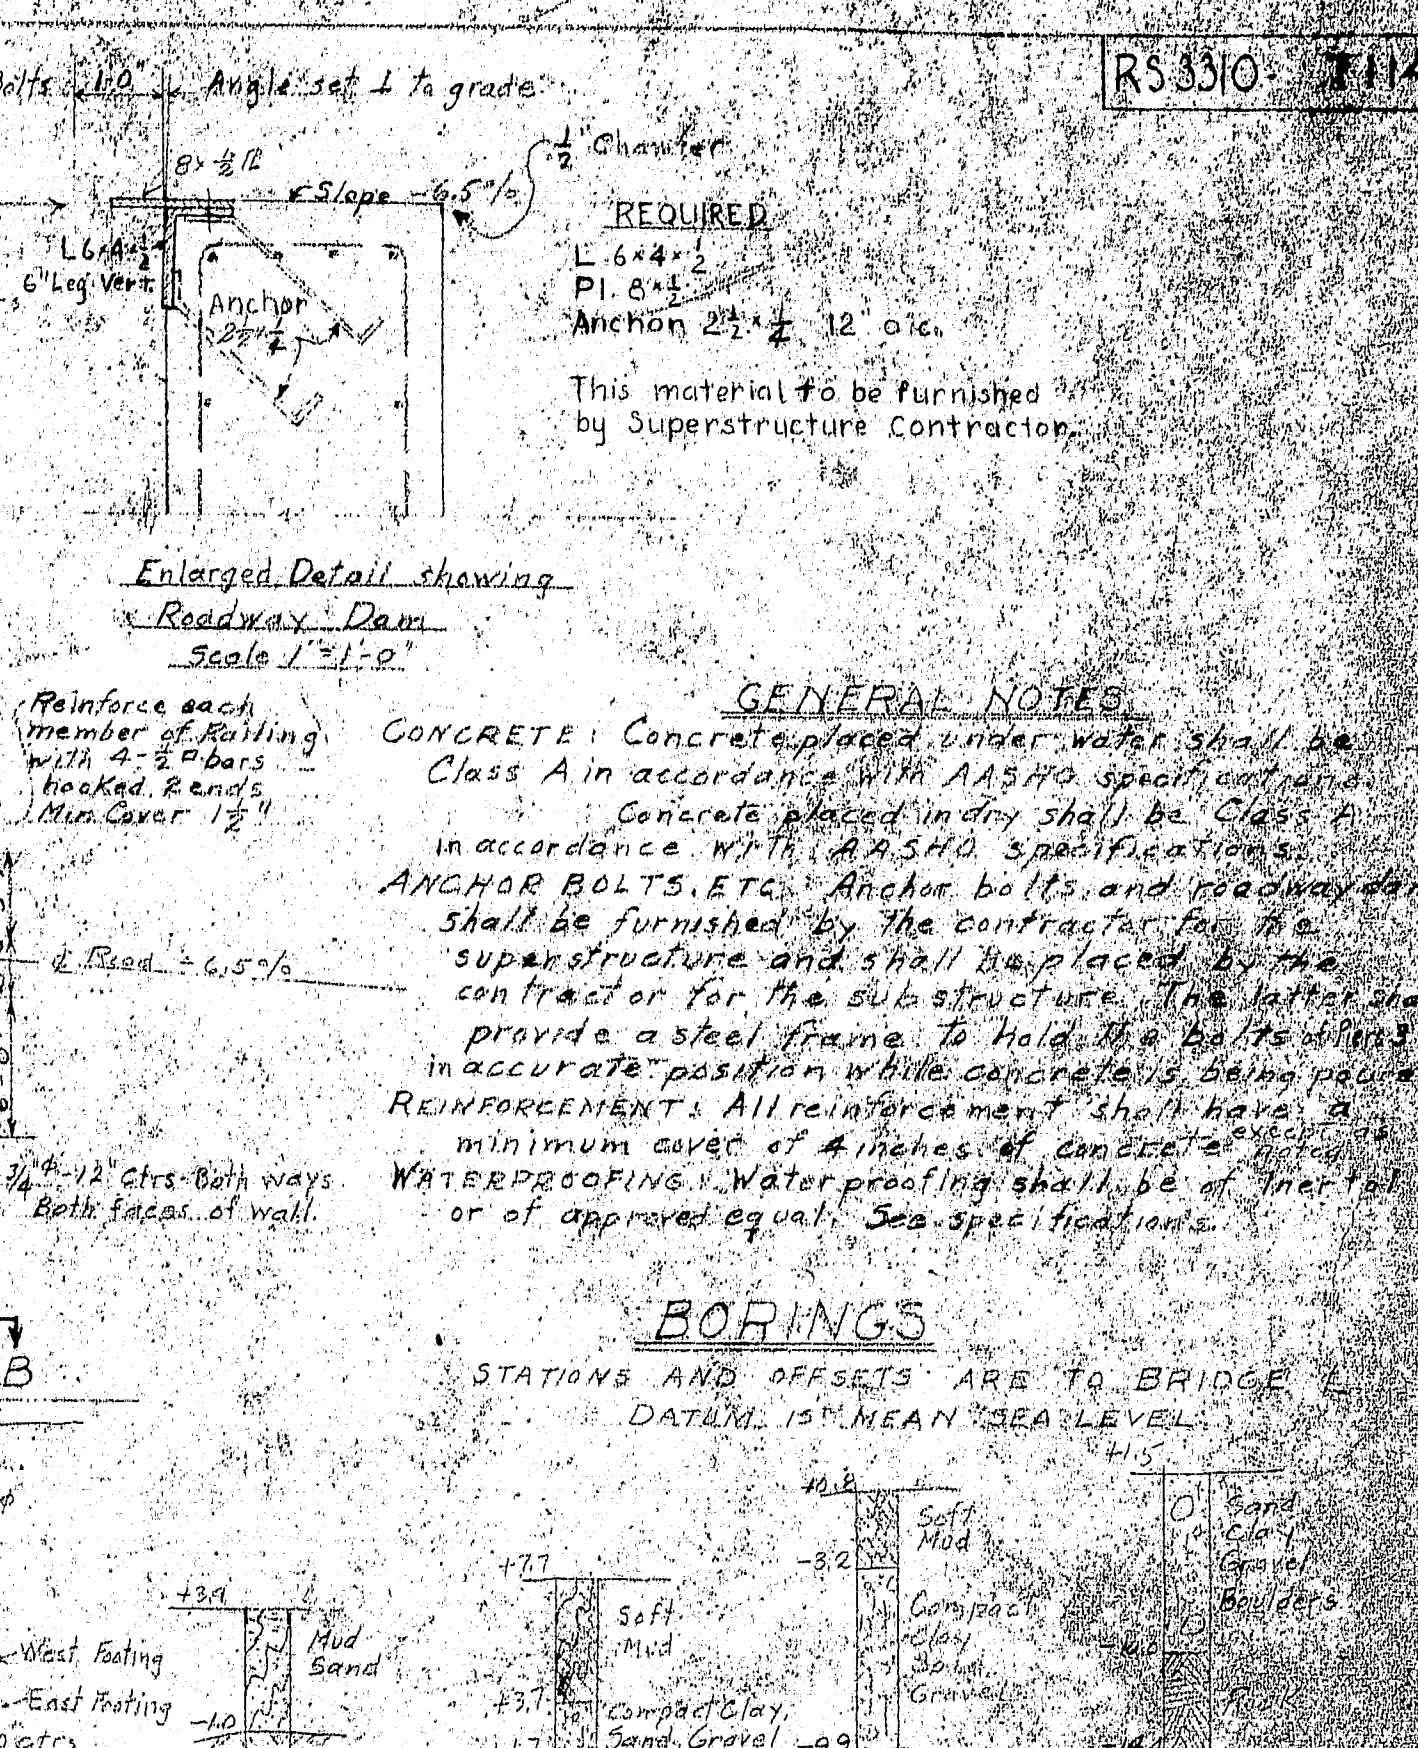


DEER ISLE ABUTMENT

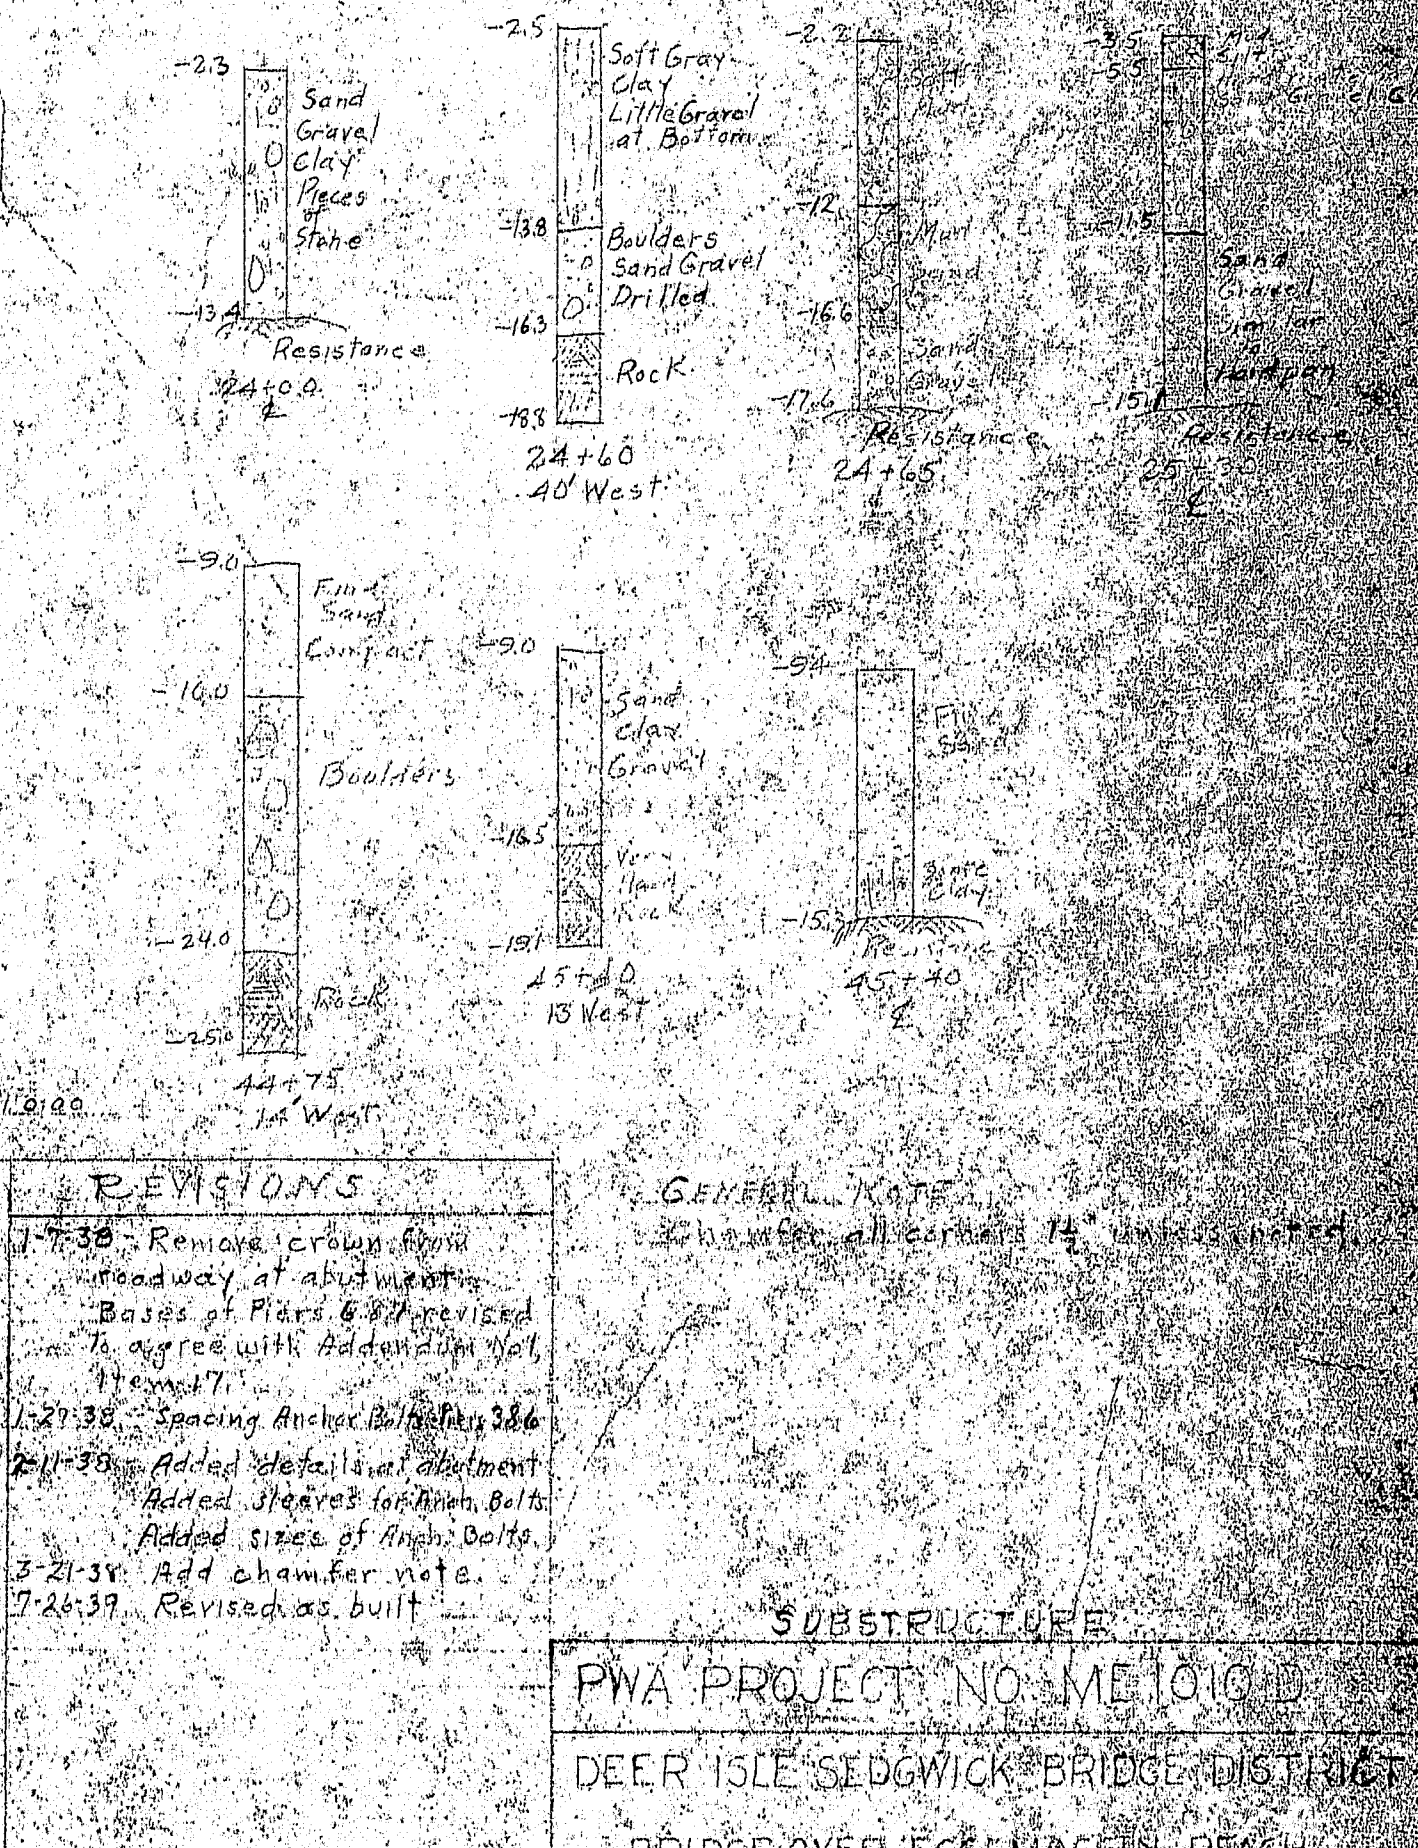


PIER NO. 1 Looking North

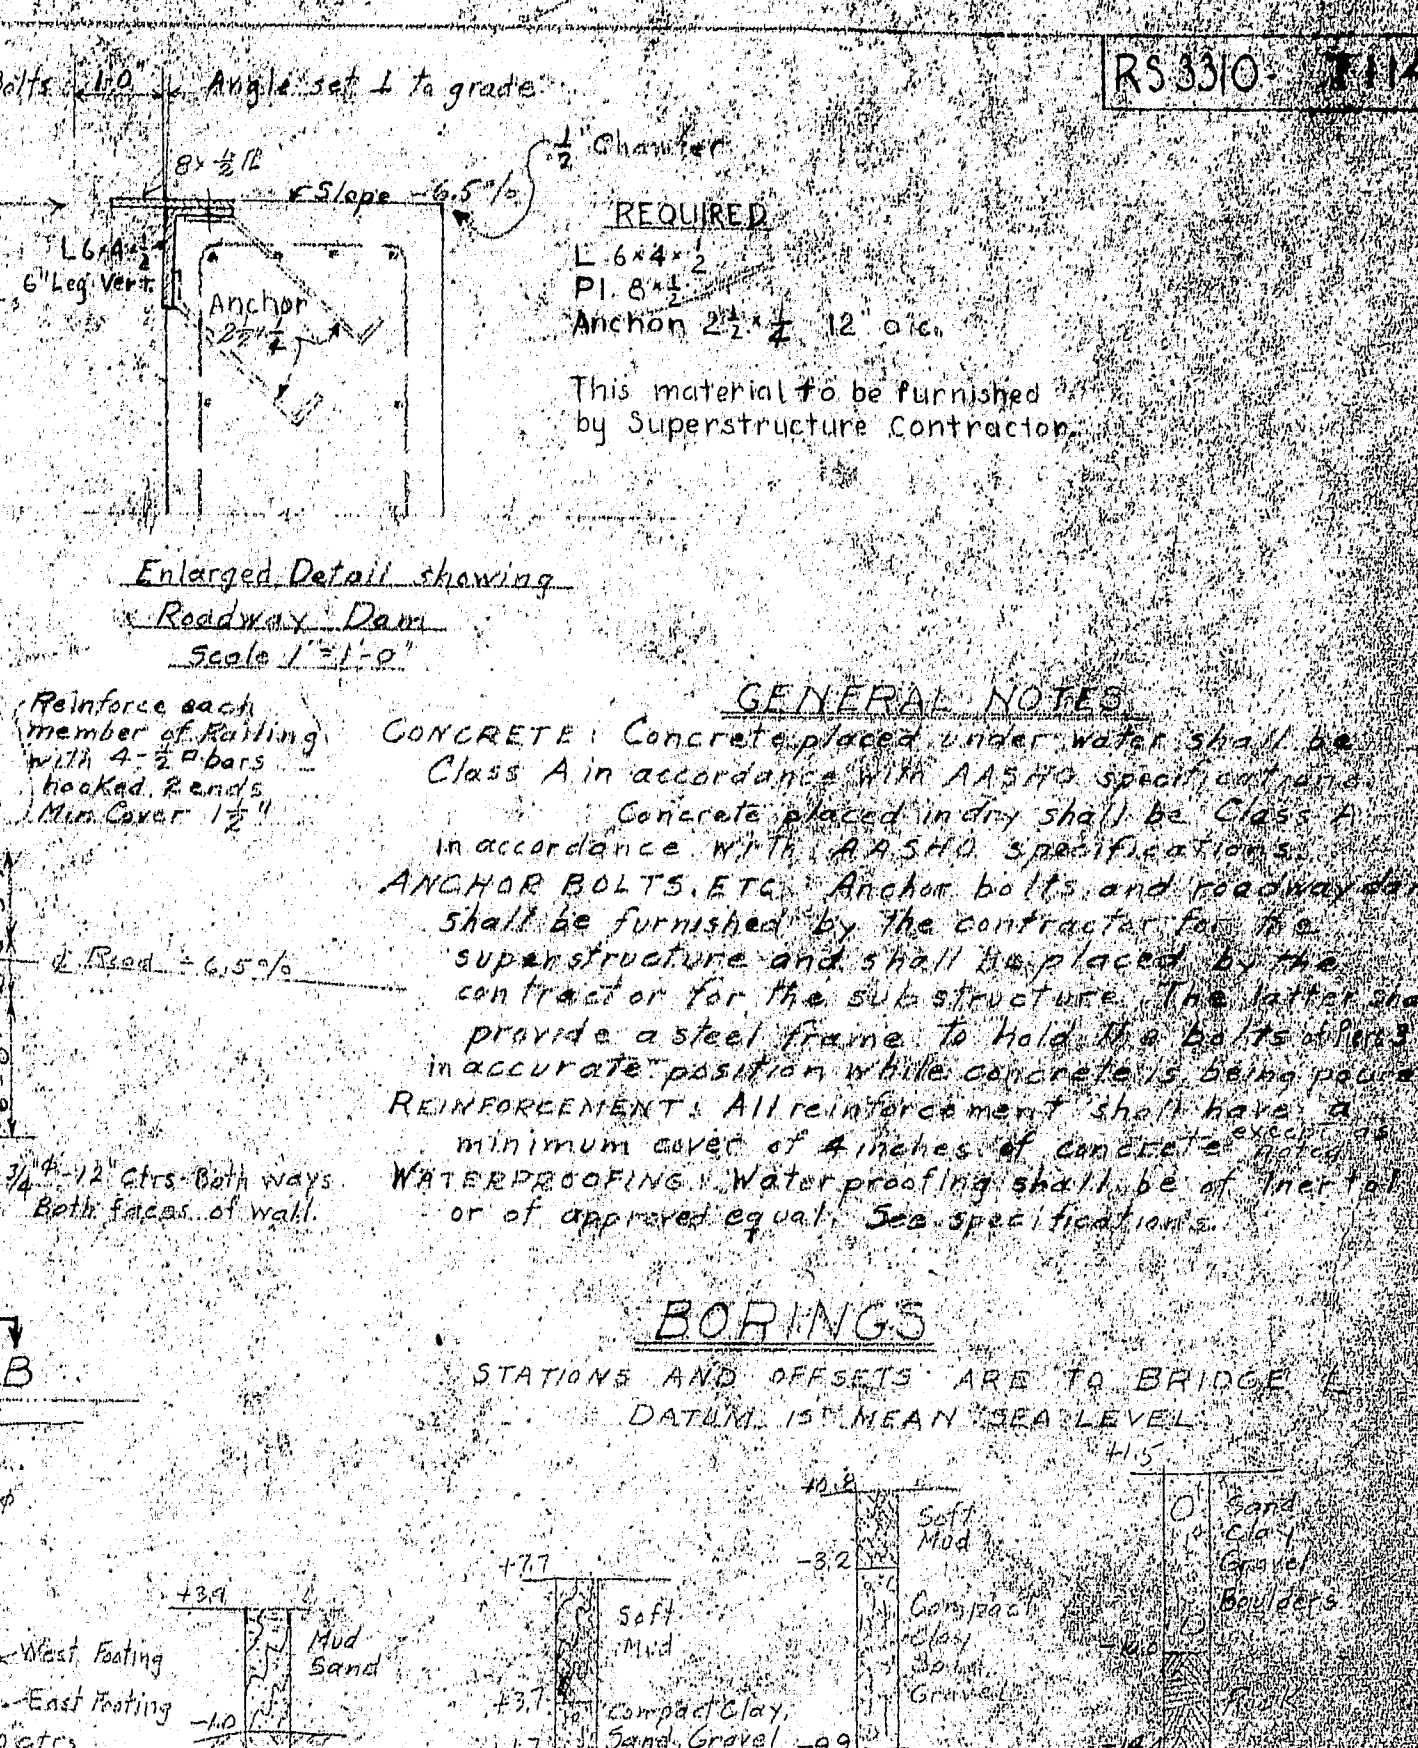


DEER ISLE ABUTMENT

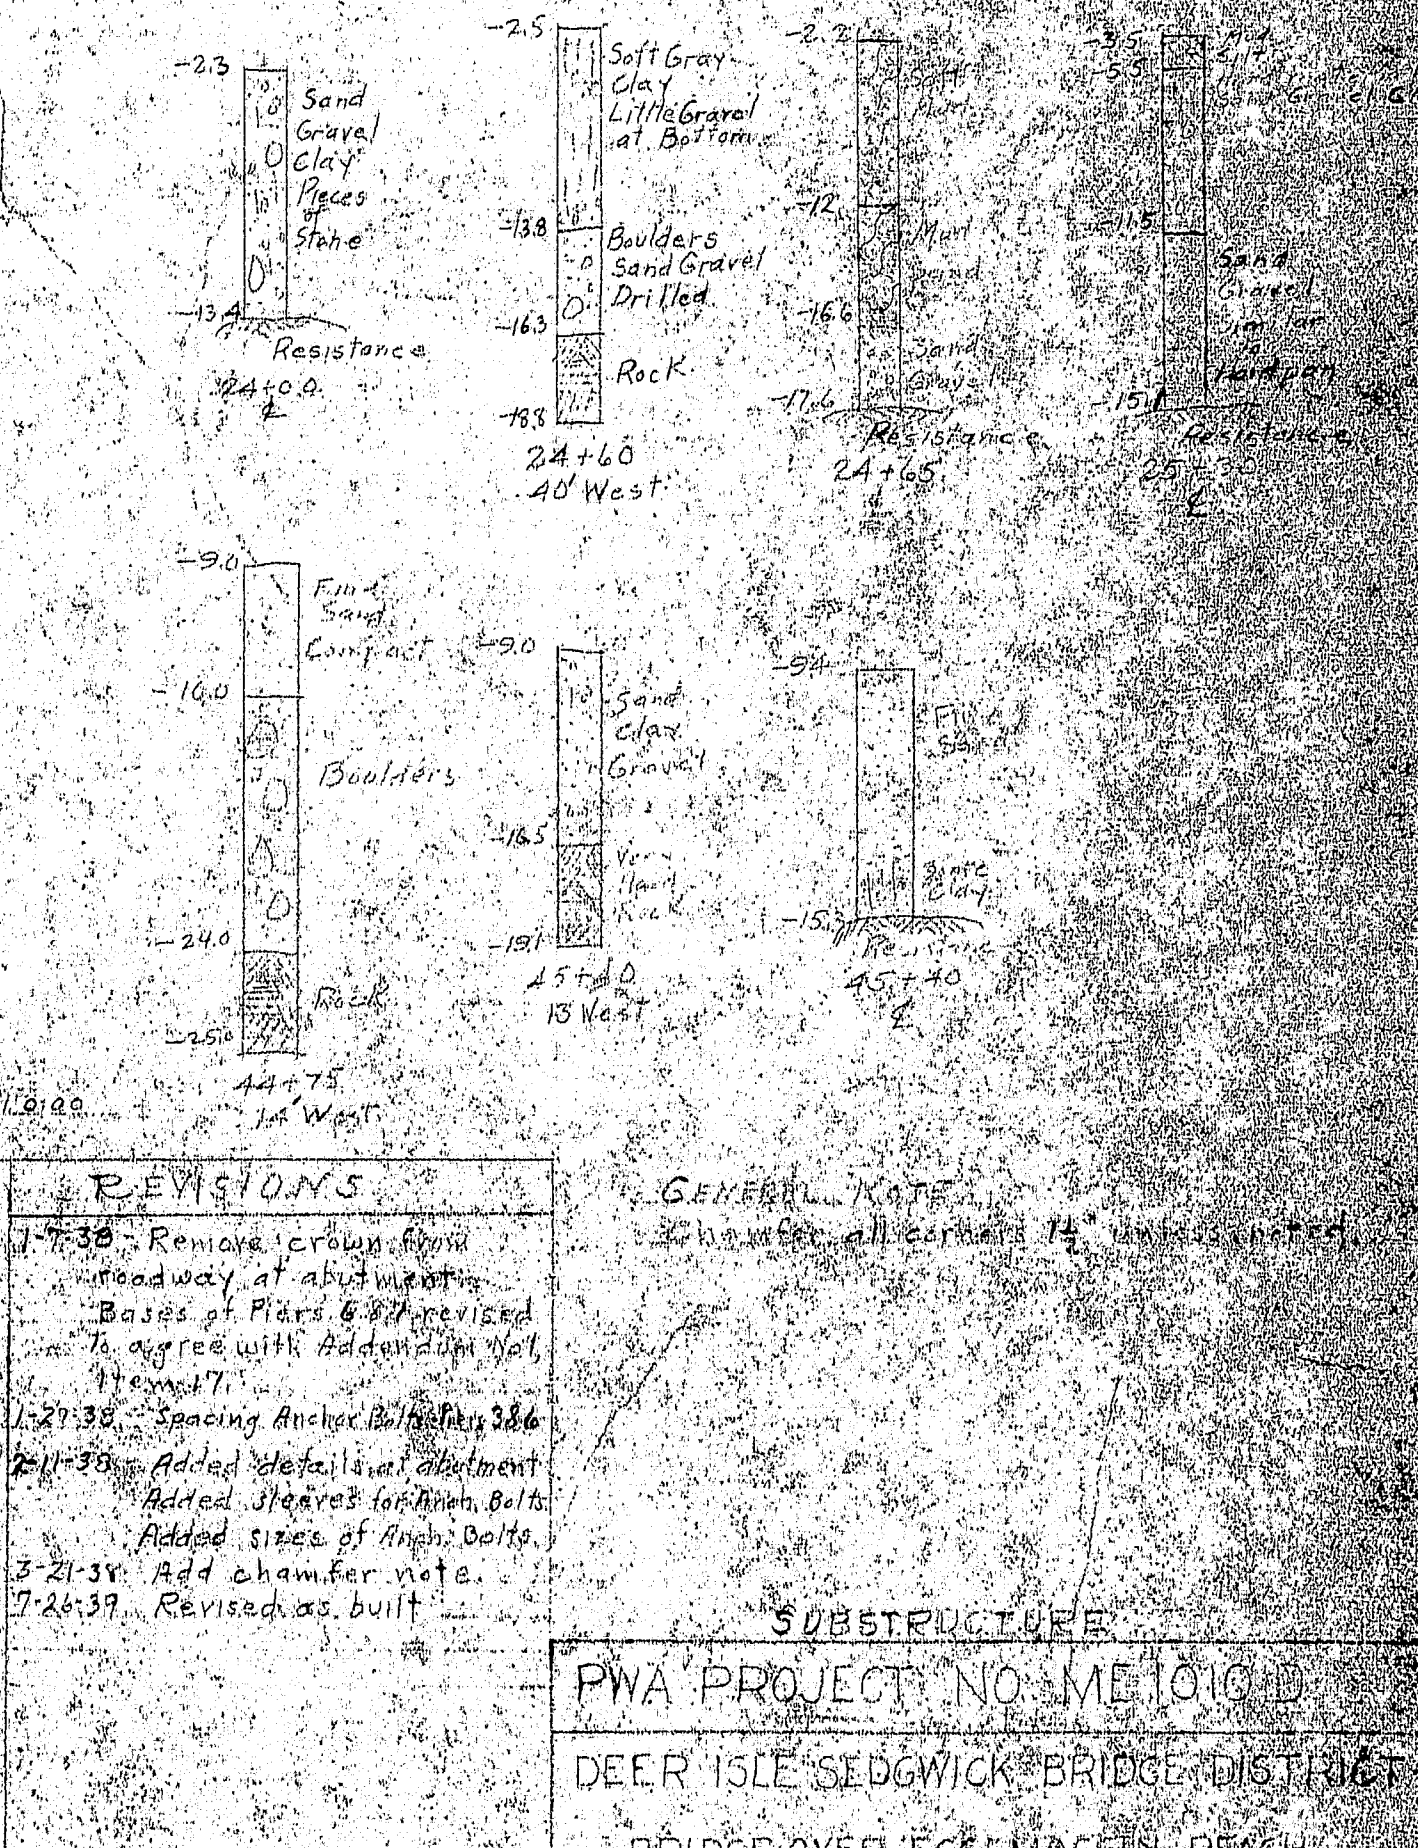


PIER NO. 1 Looking North

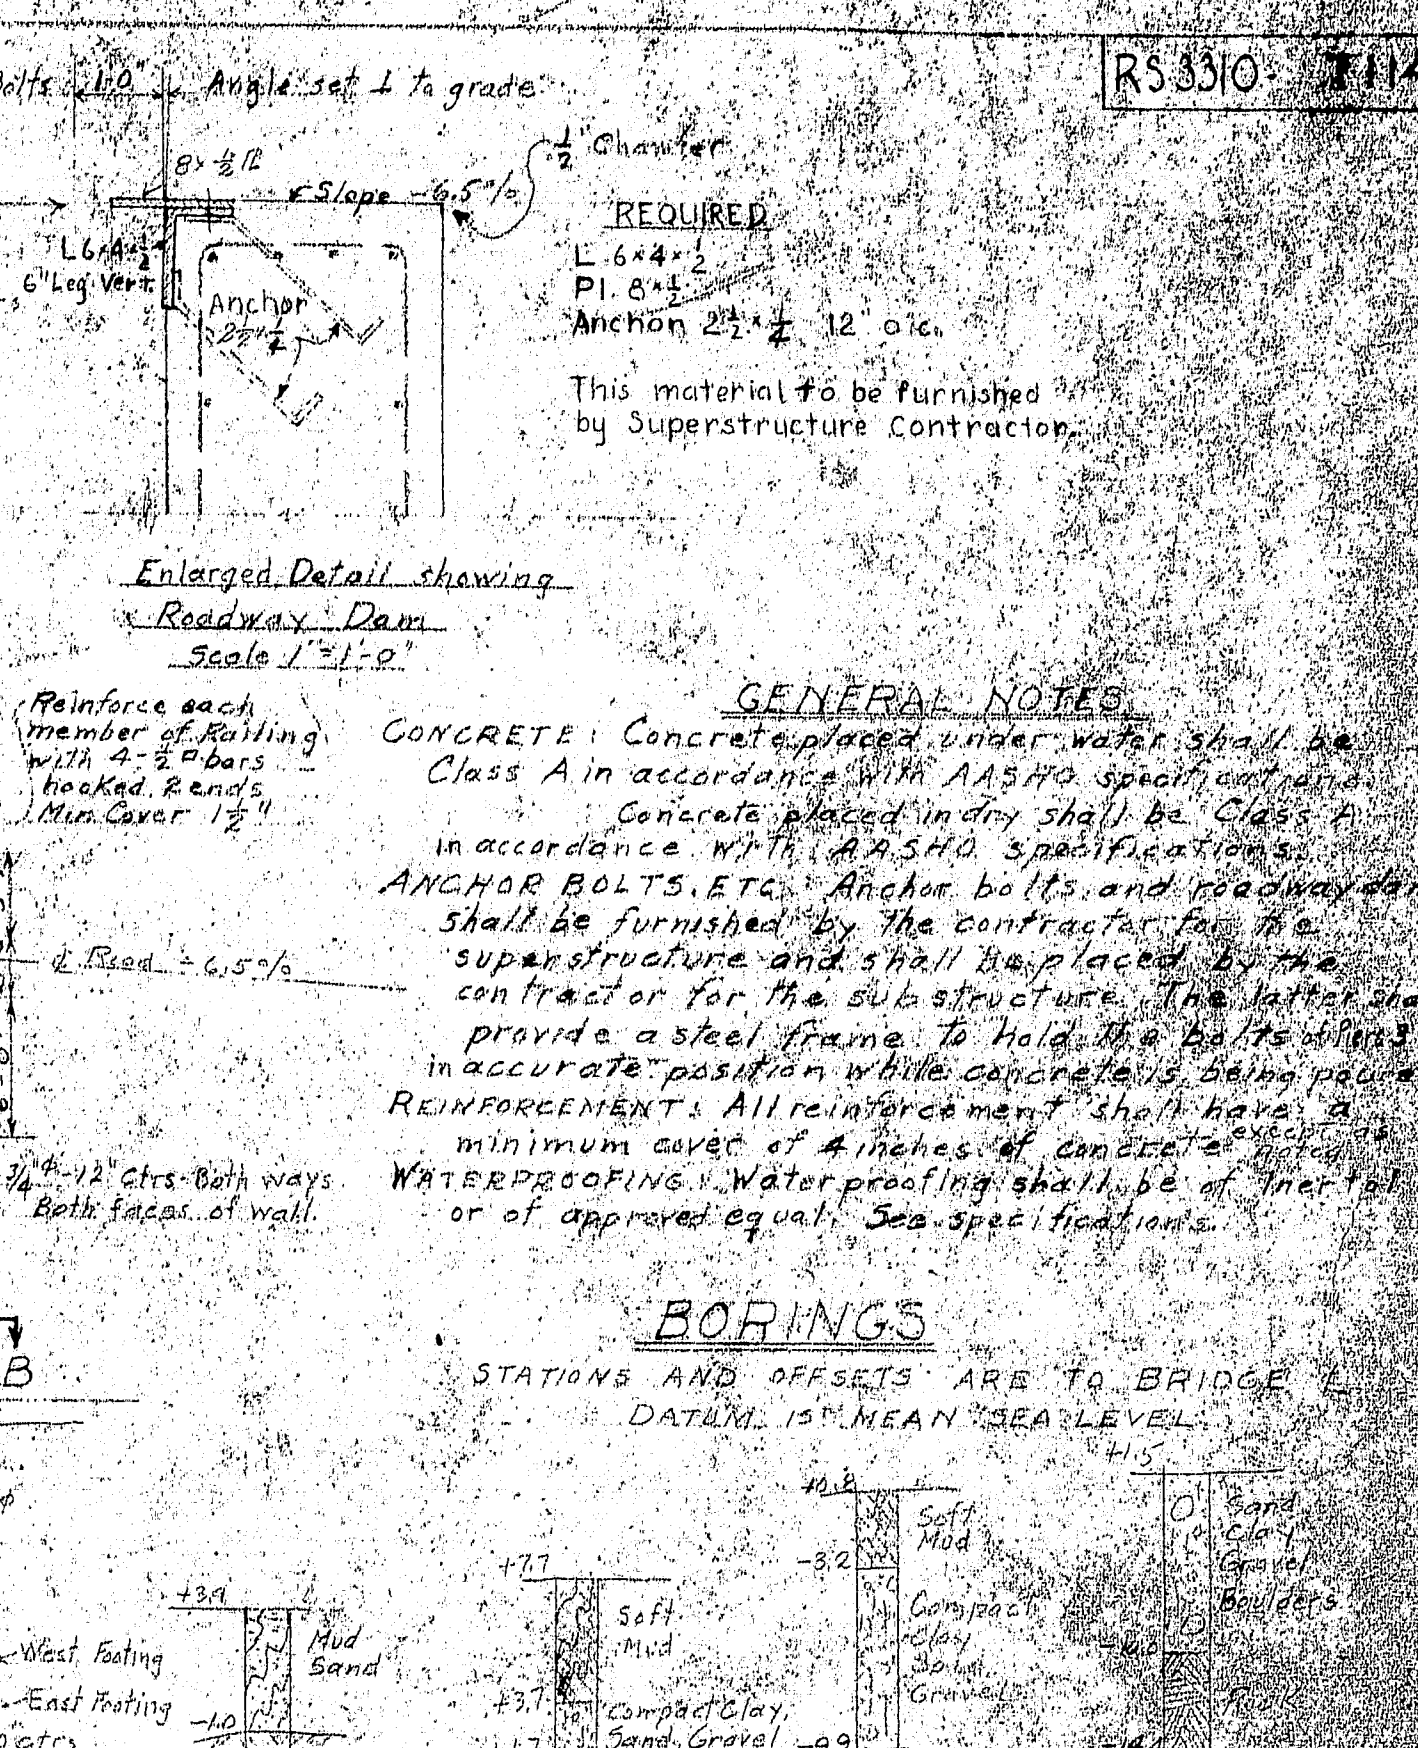


DEER ISLE ABUTMENT

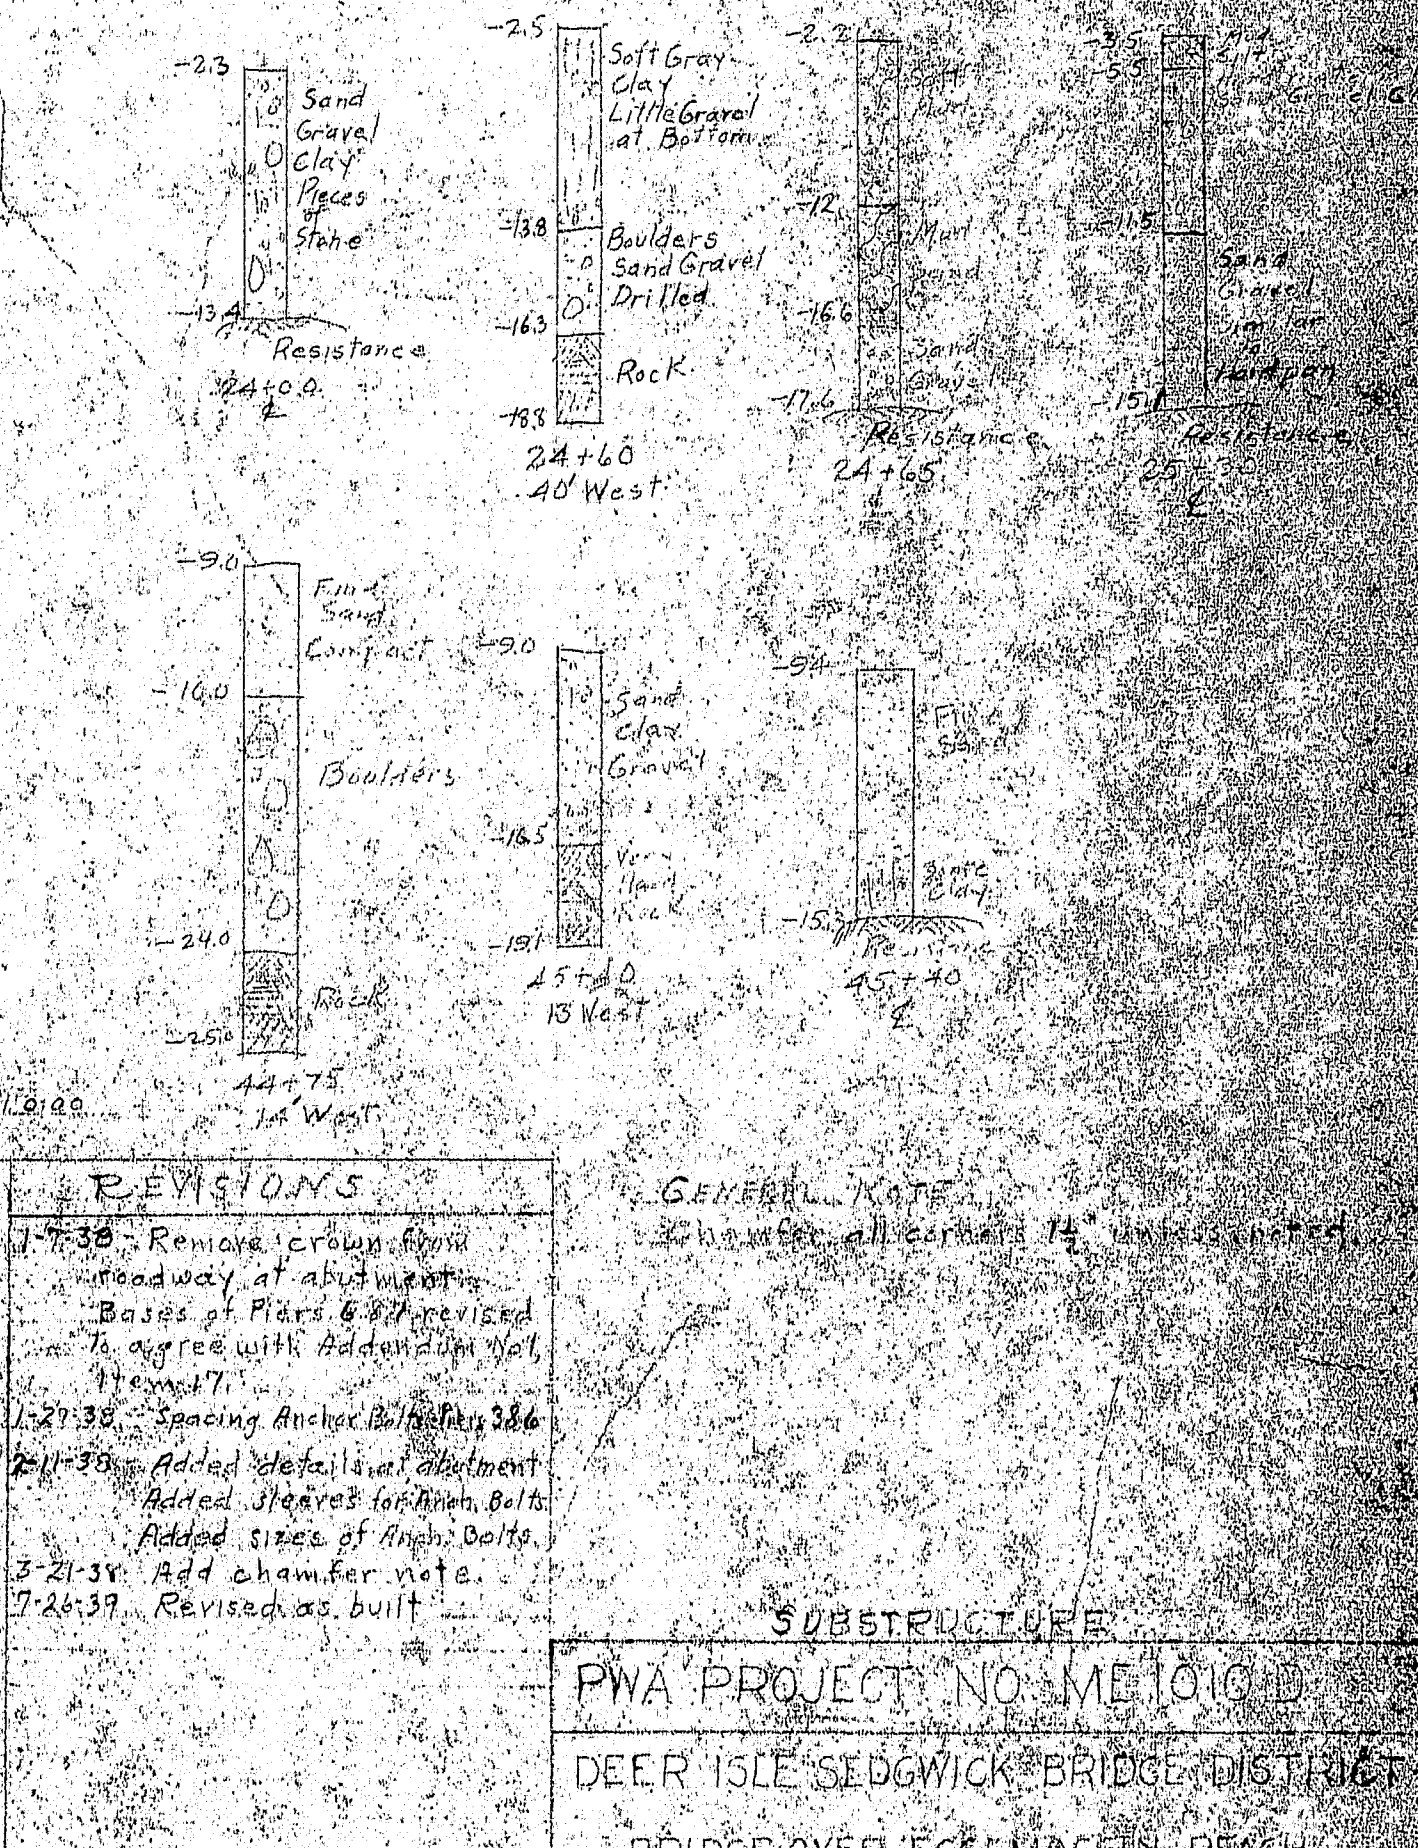


PIER NO. 1 Looking North

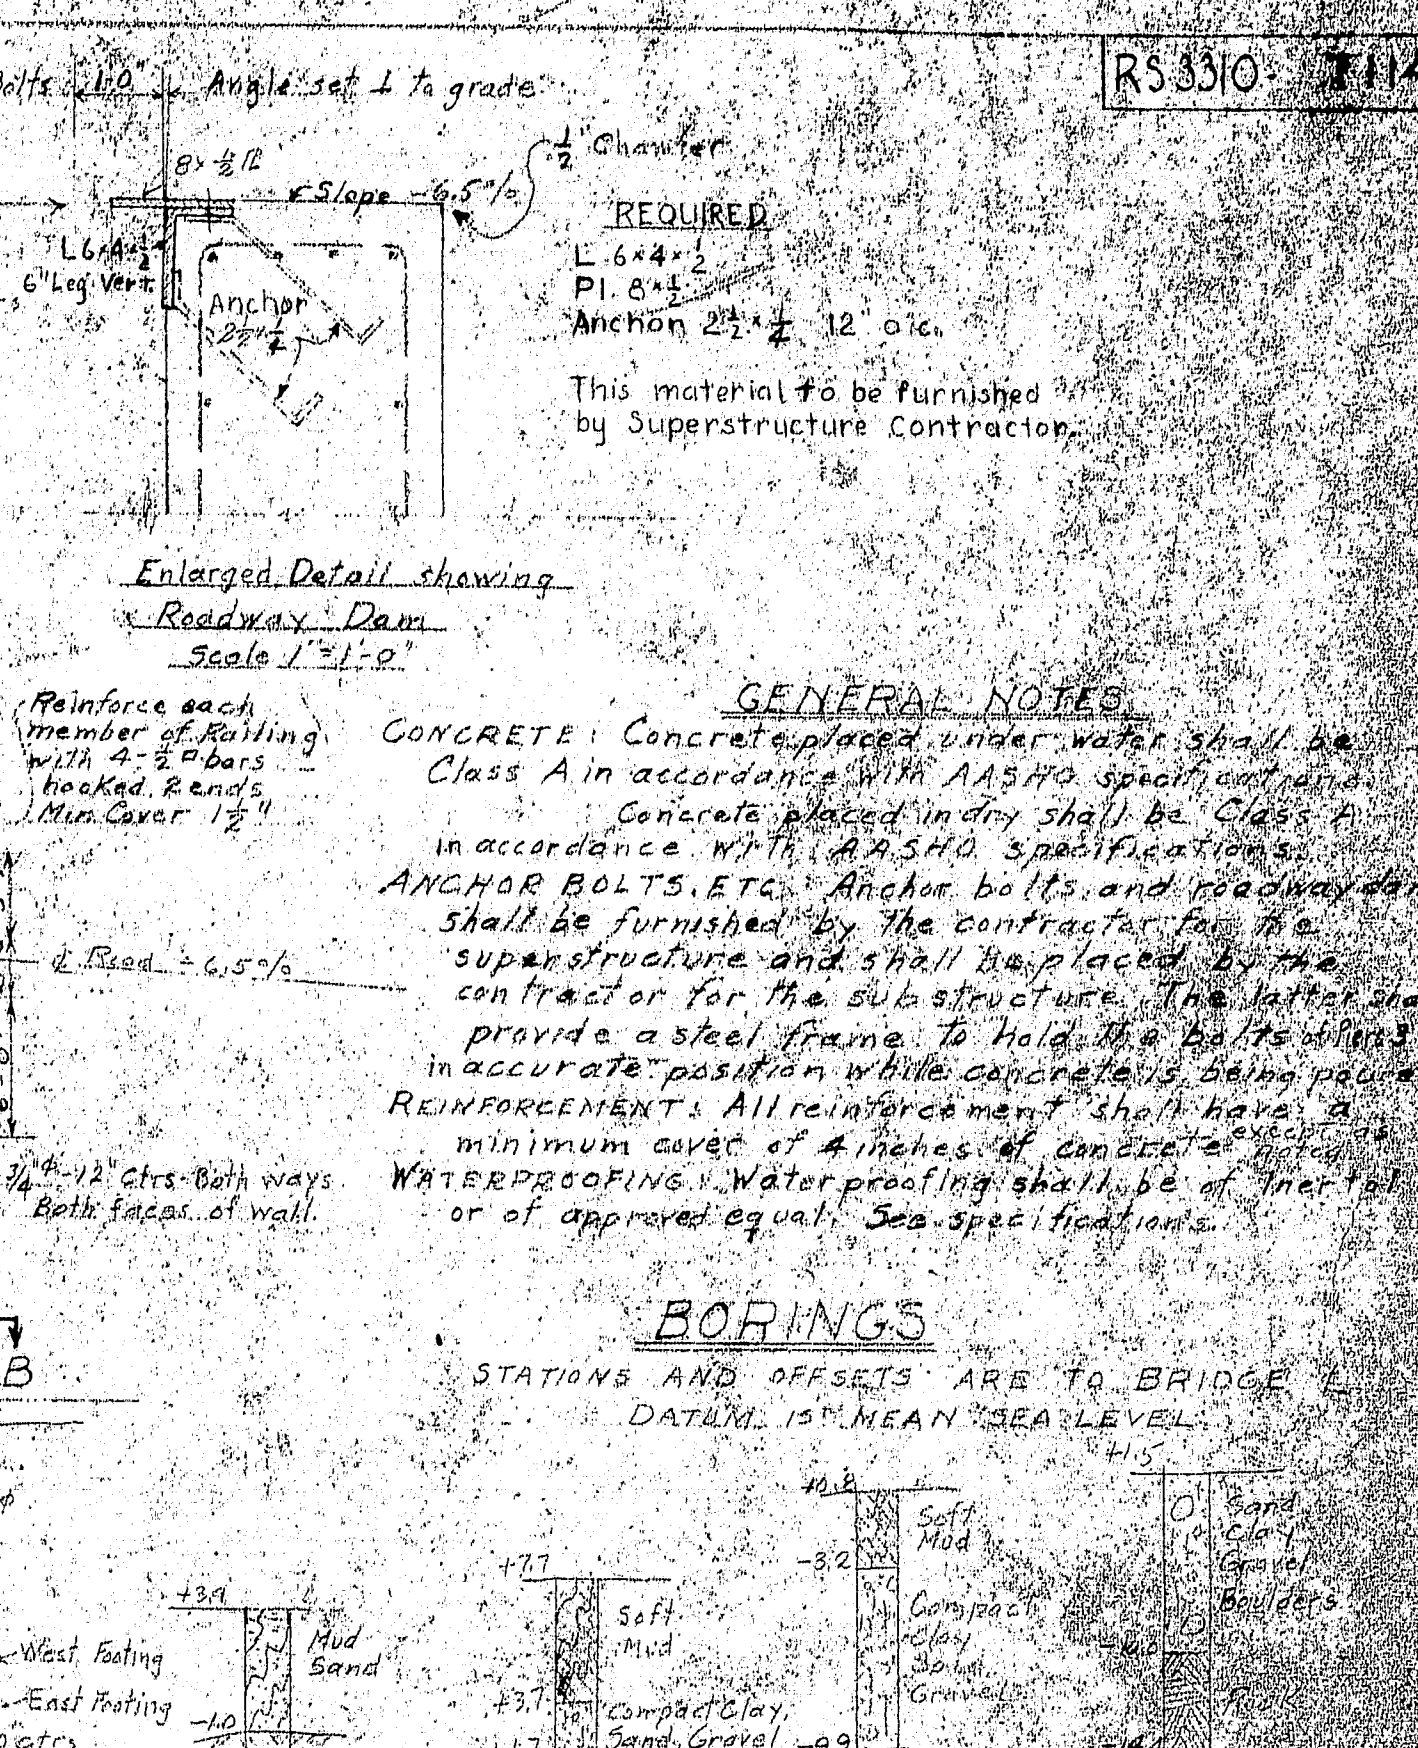


DEER ISLE ABUTMENT

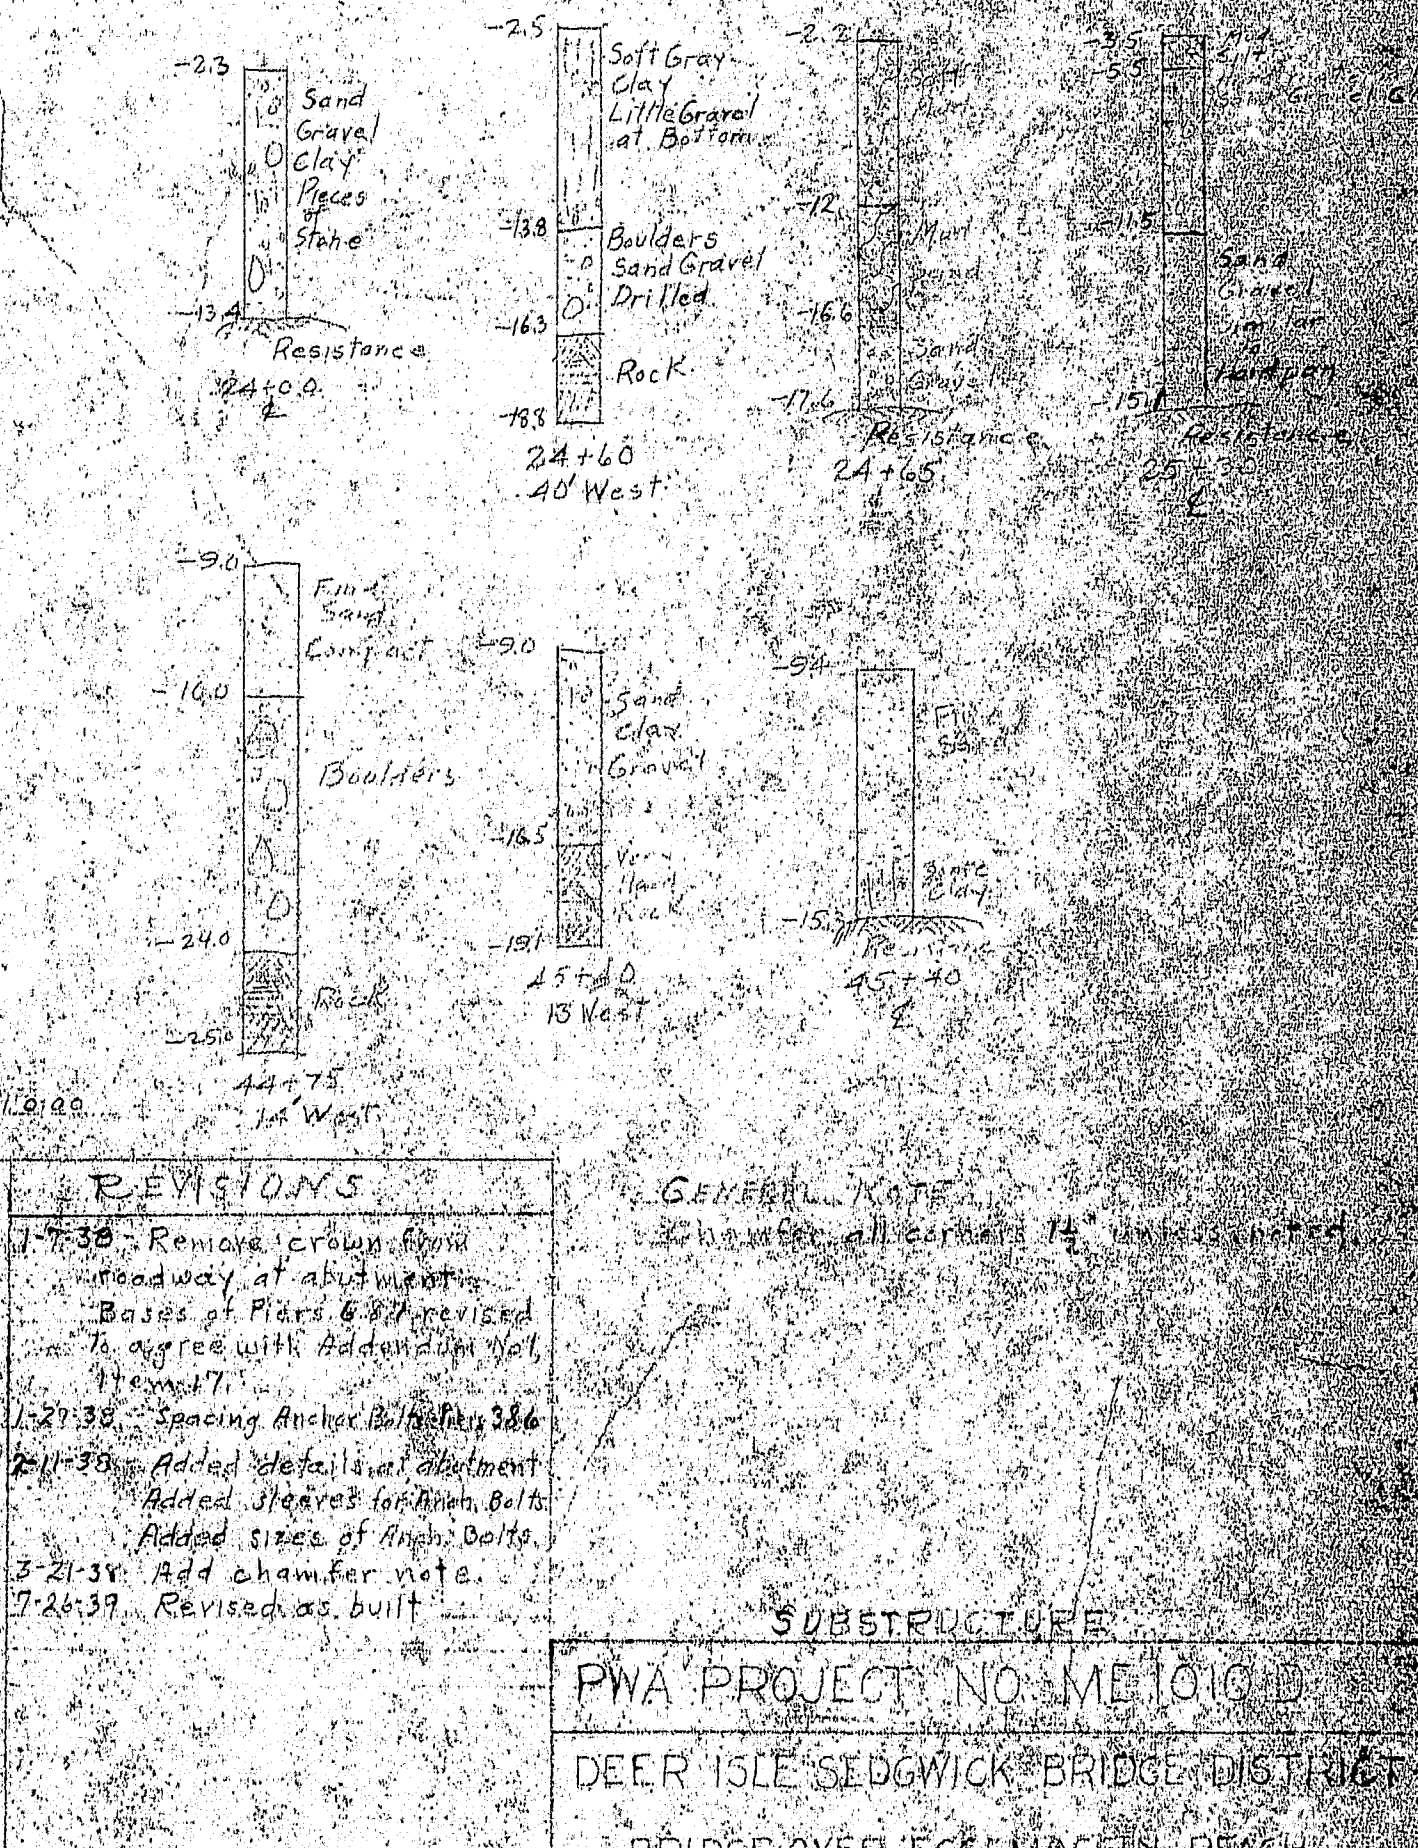

PIER NO. 1 Looking North

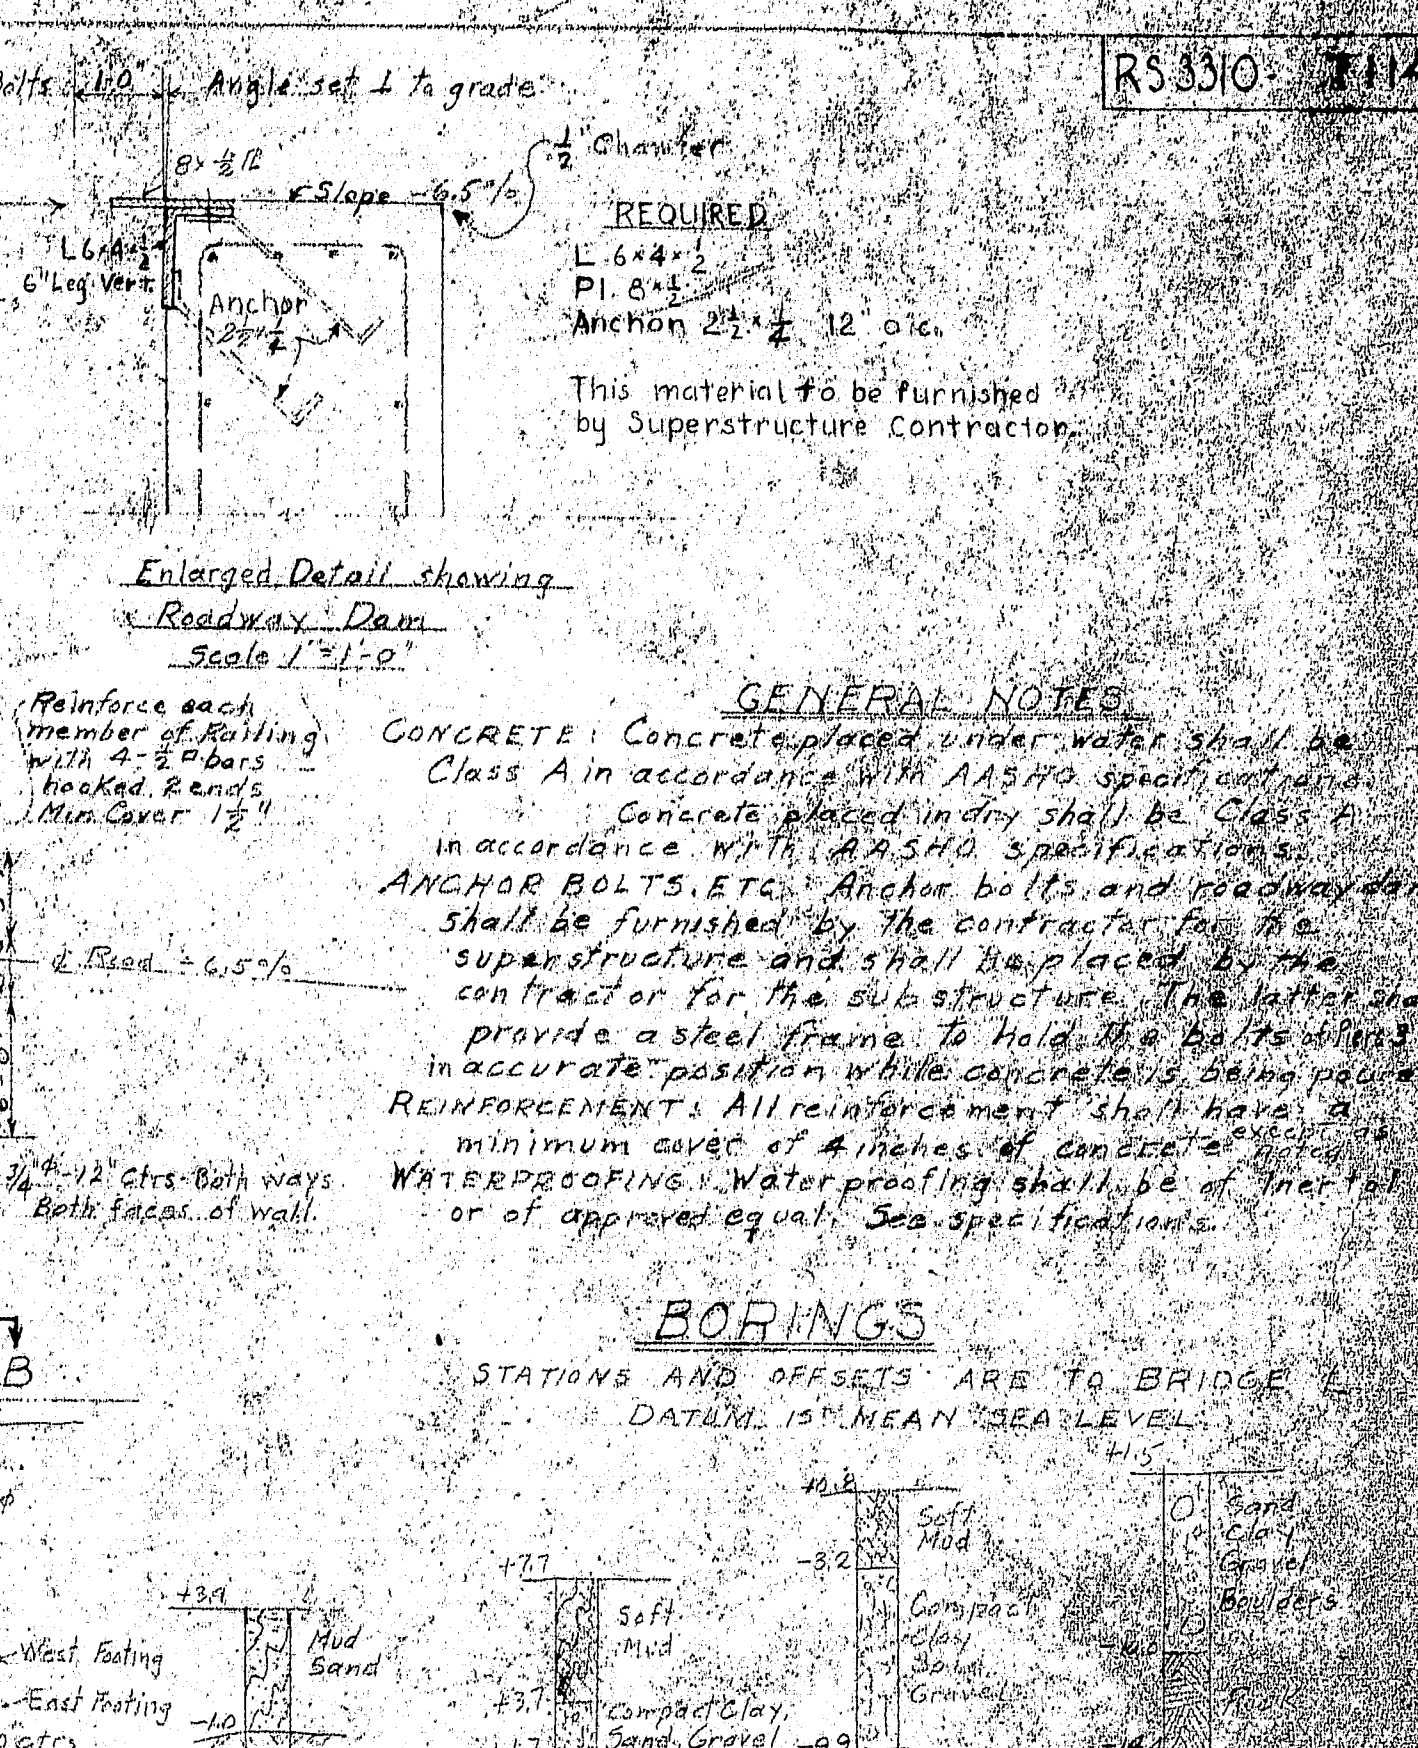

DEER ISLE ABUTMENT

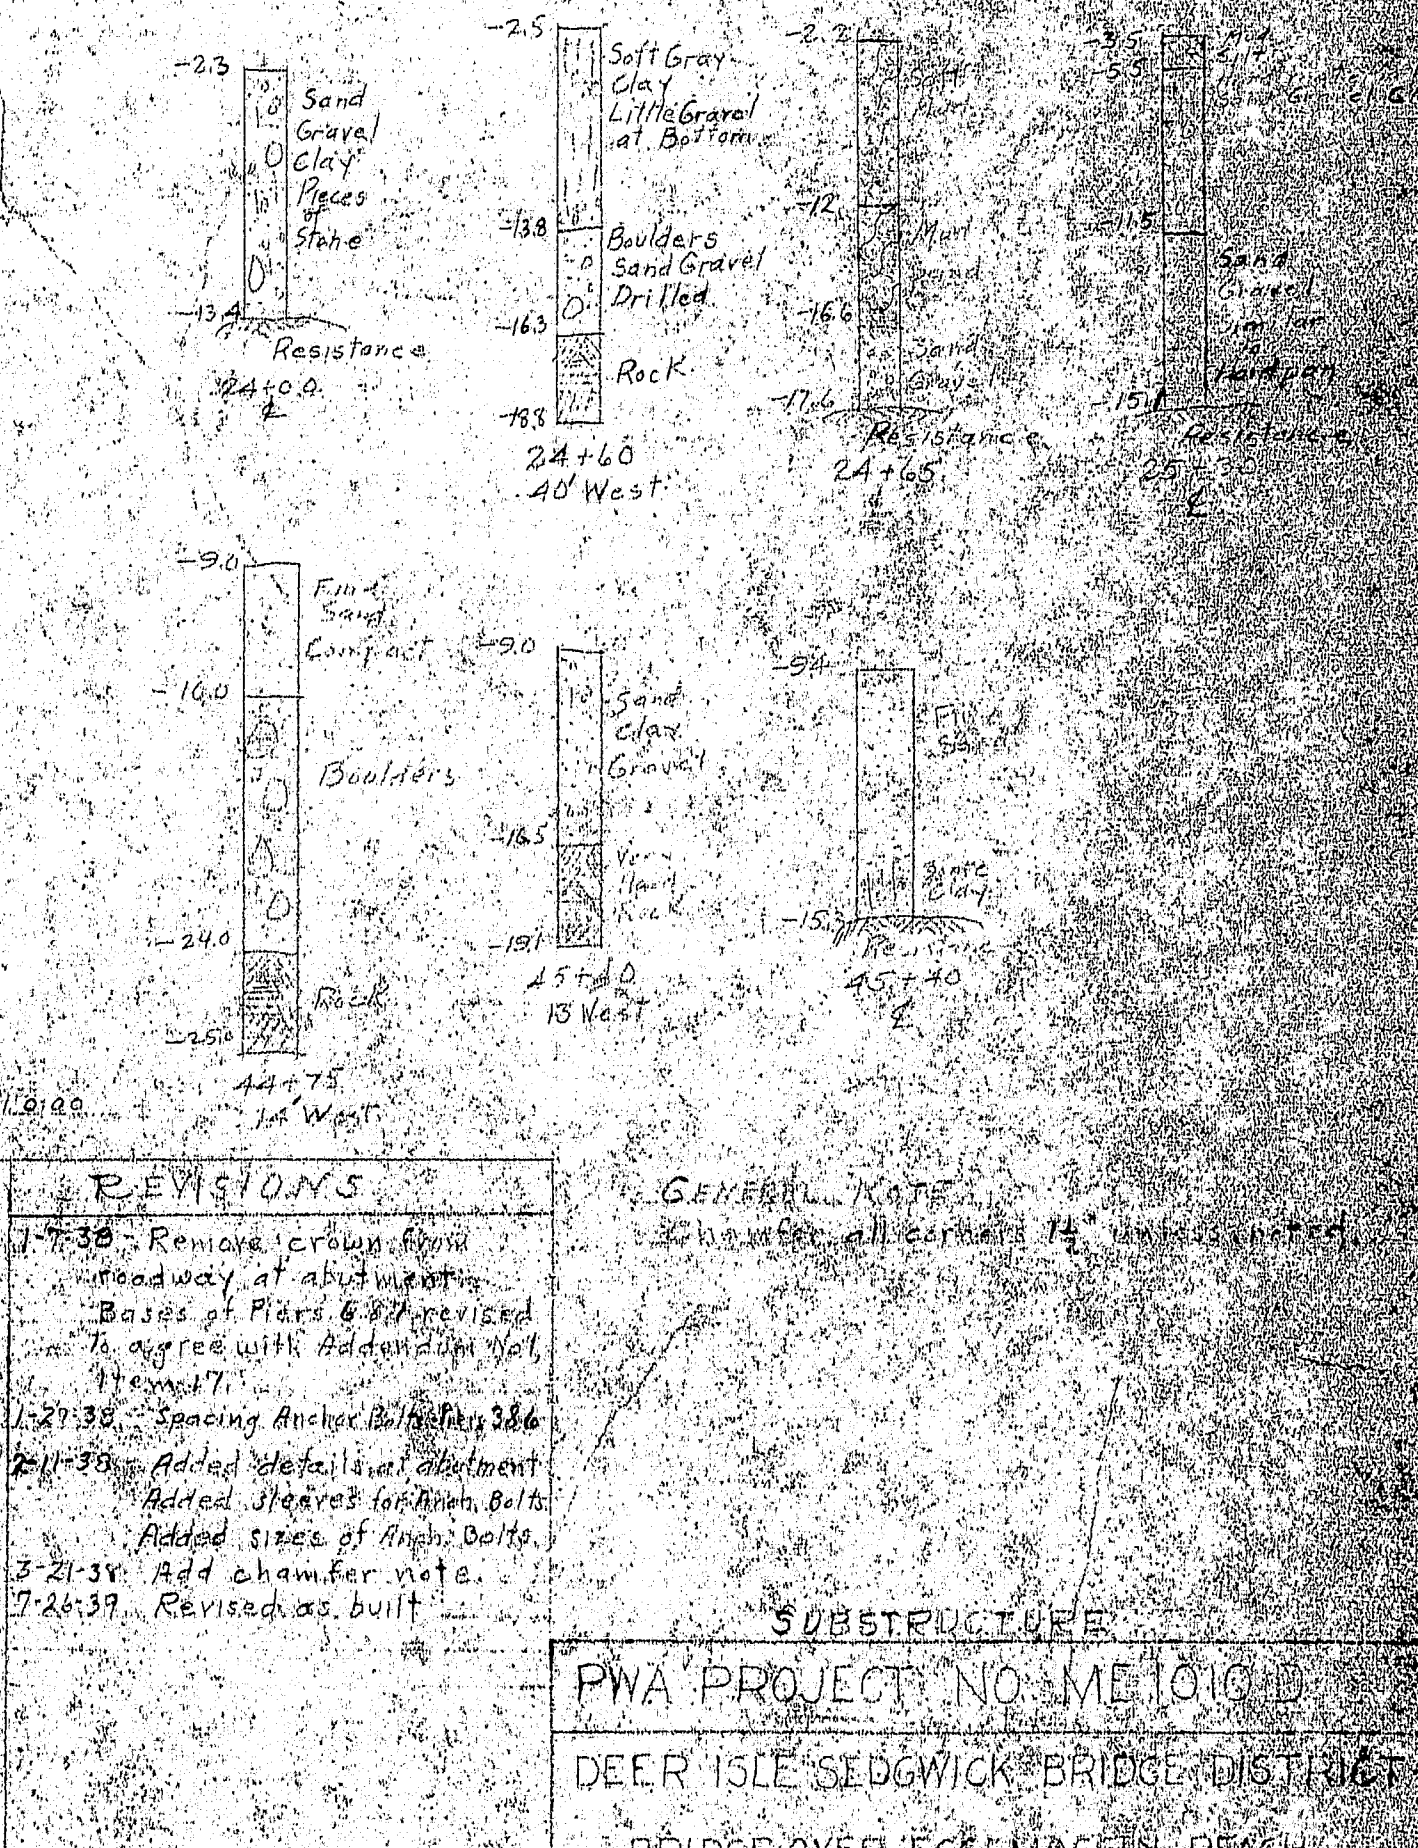

PIER NO. 1 Looking North

