


DEER ISLE - SEDGWICK BRIDGE

REVISION OF REINFORCEMENT -

3310  
SK 1  
3-31-37

✓

 

18'-0" 1/2

NOTE - Red X X X L is same length as original 27' 11 1/2'.  
111-111

RETURN TO  
ROBINSON AND STEINMAN  
CONSULTING ENGINEERS  
47 LIBERTY ST.  
NEW YORK CITY

