



- one  
ite trusses

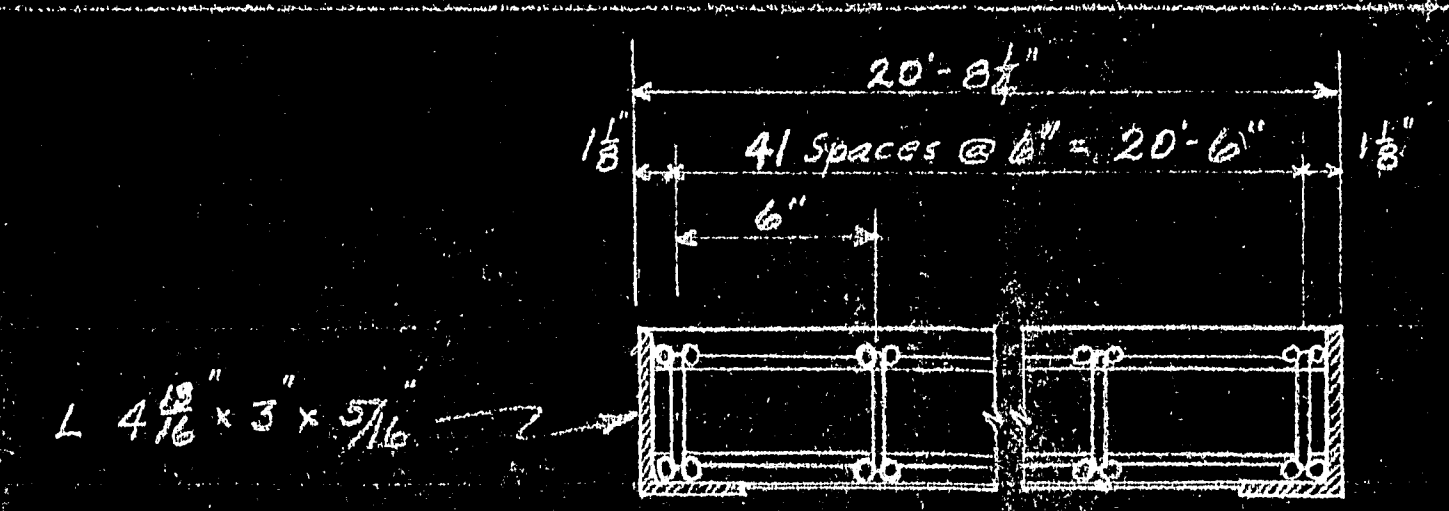


PART CROSS-SECTION - ORIGINAL

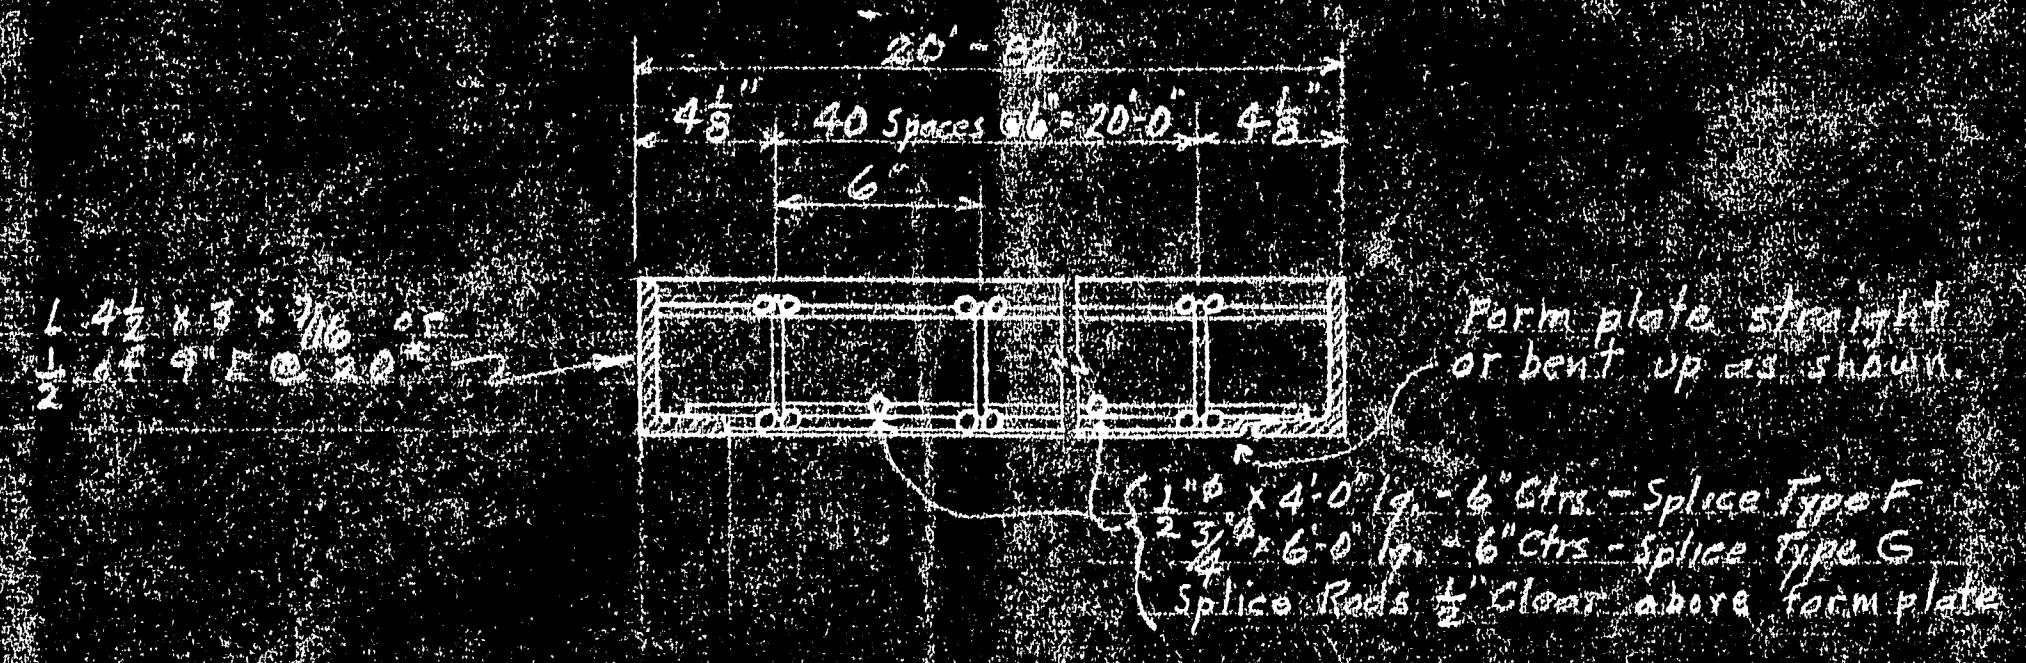


PART CROSS-SECTION - REVISED


2m 1/4" Fillet Welds	Splice Rods
Alternate Trusses	
Each Truss	
"	"
"	"
"	"
"	"
"	1/4" x 4'-0" - 6" Ctrs.
"	3/4" x 6'-0" - 6" Ctrs.

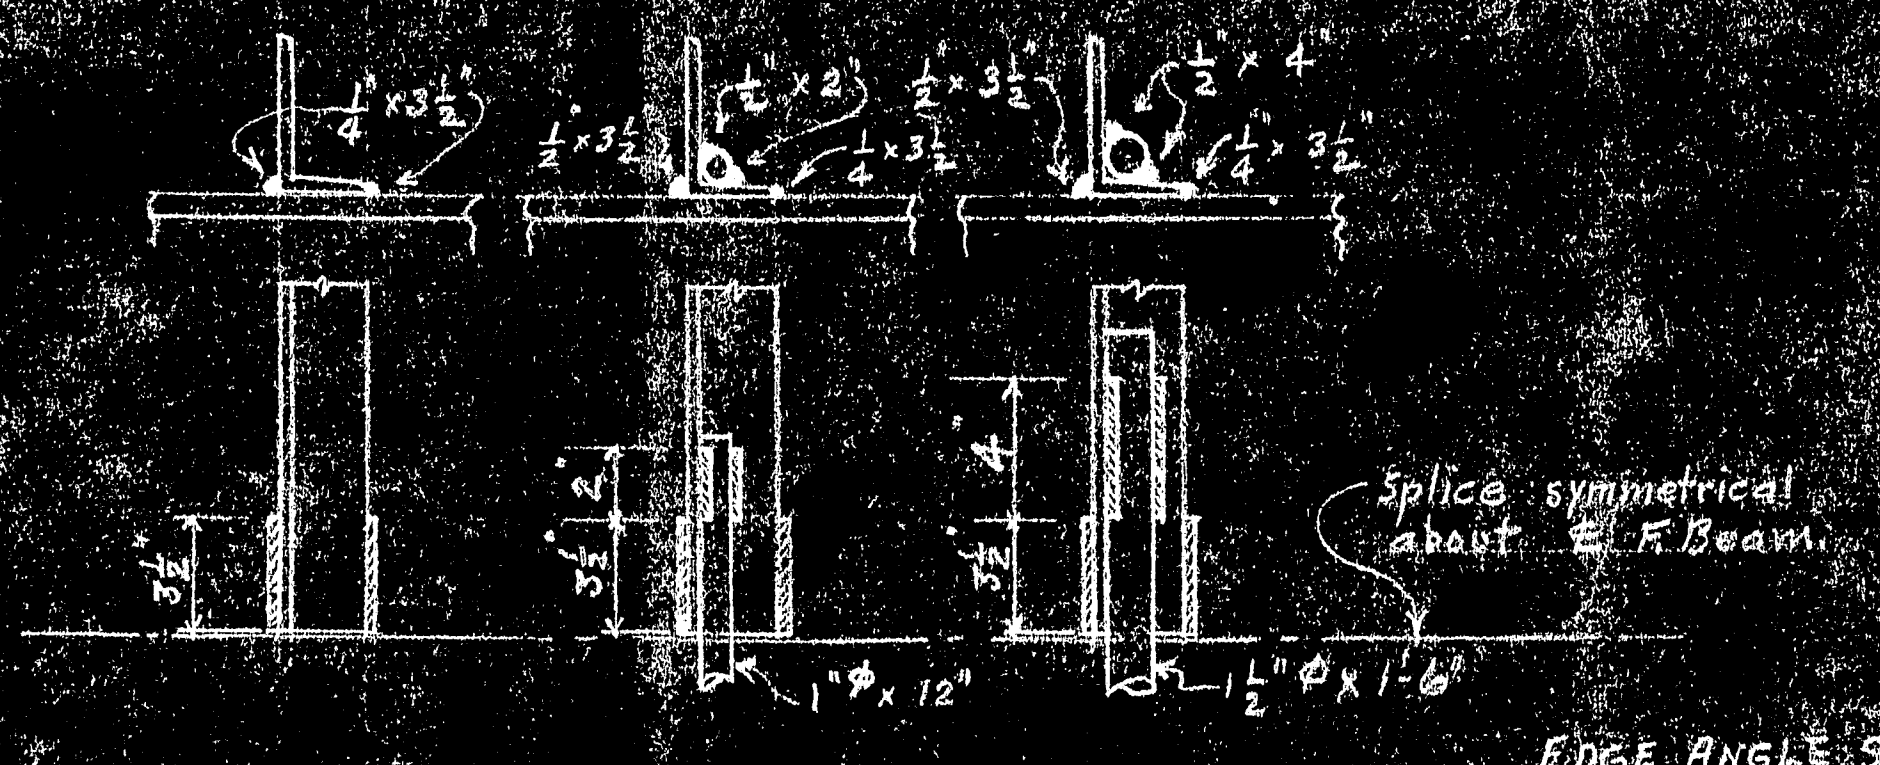

SPLICE FOR EDGE ANGLE - TYPE H — TYPE J — TYPE K

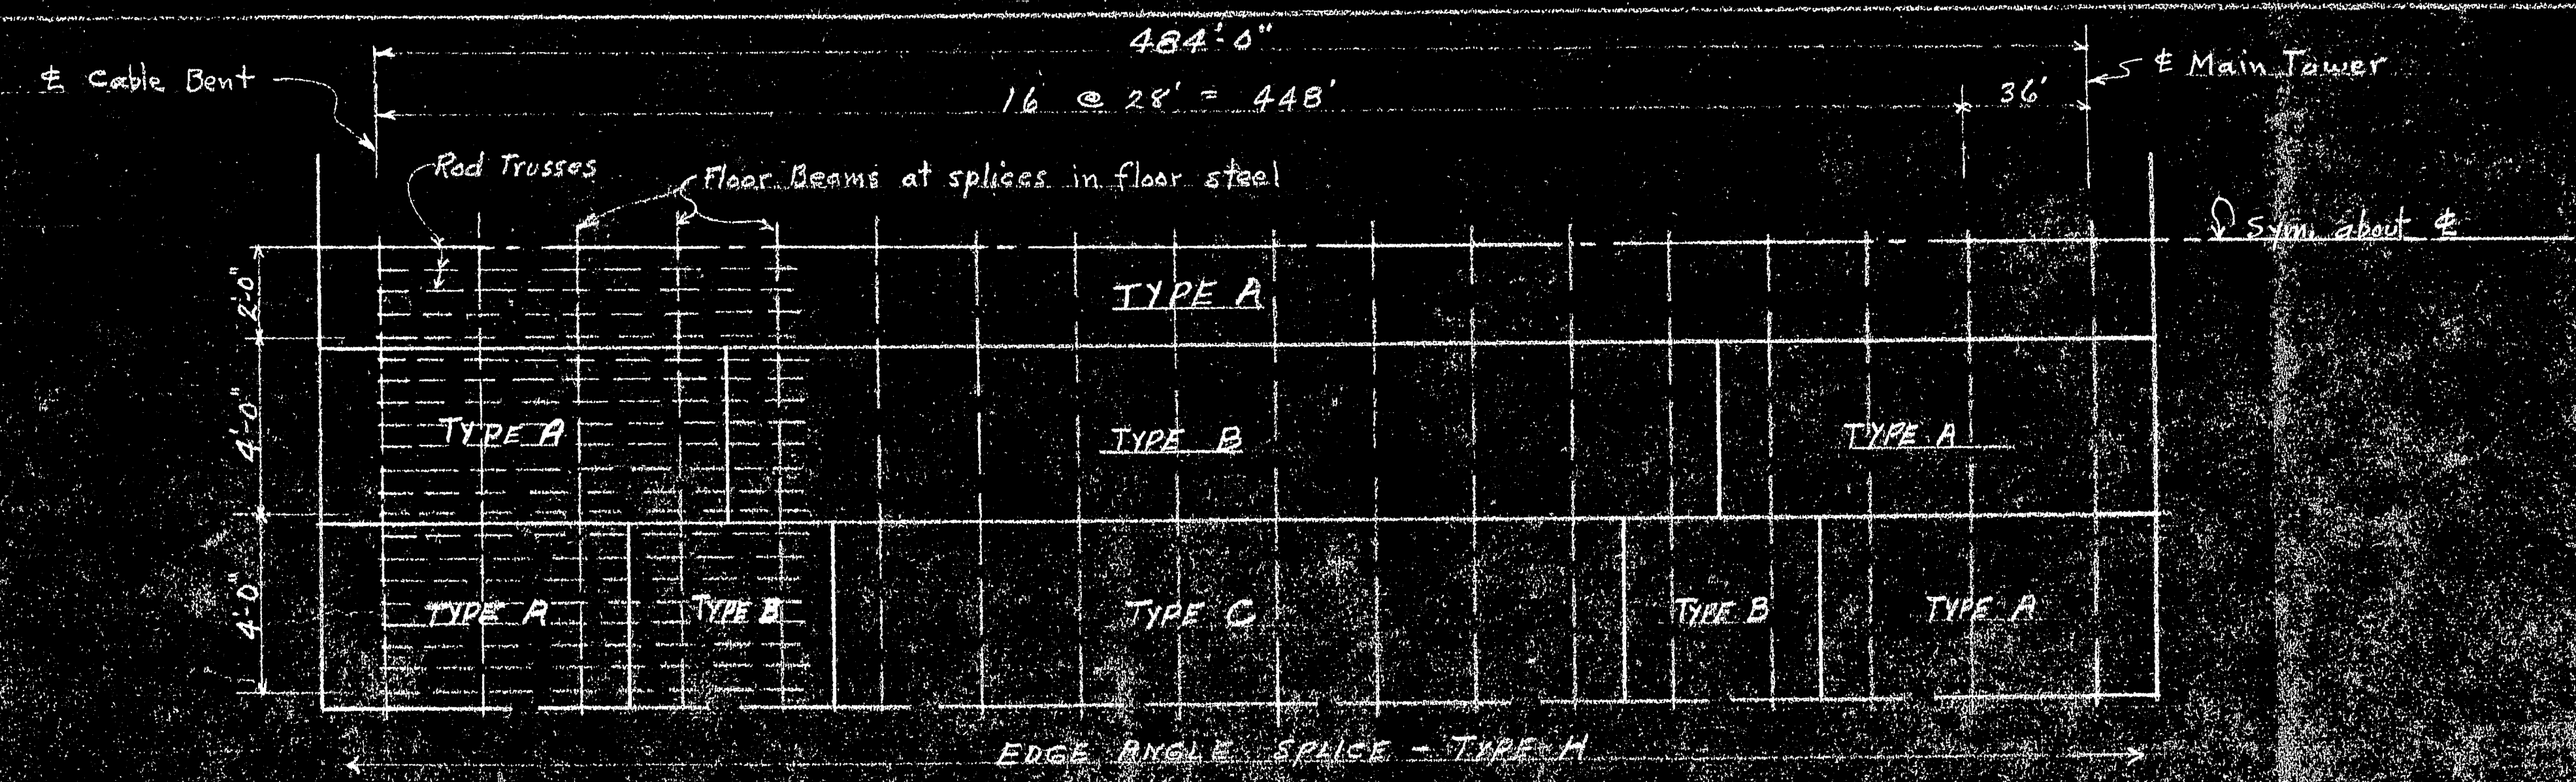

LOCATION & TYPES OF SPLICES - SIDE SPAN

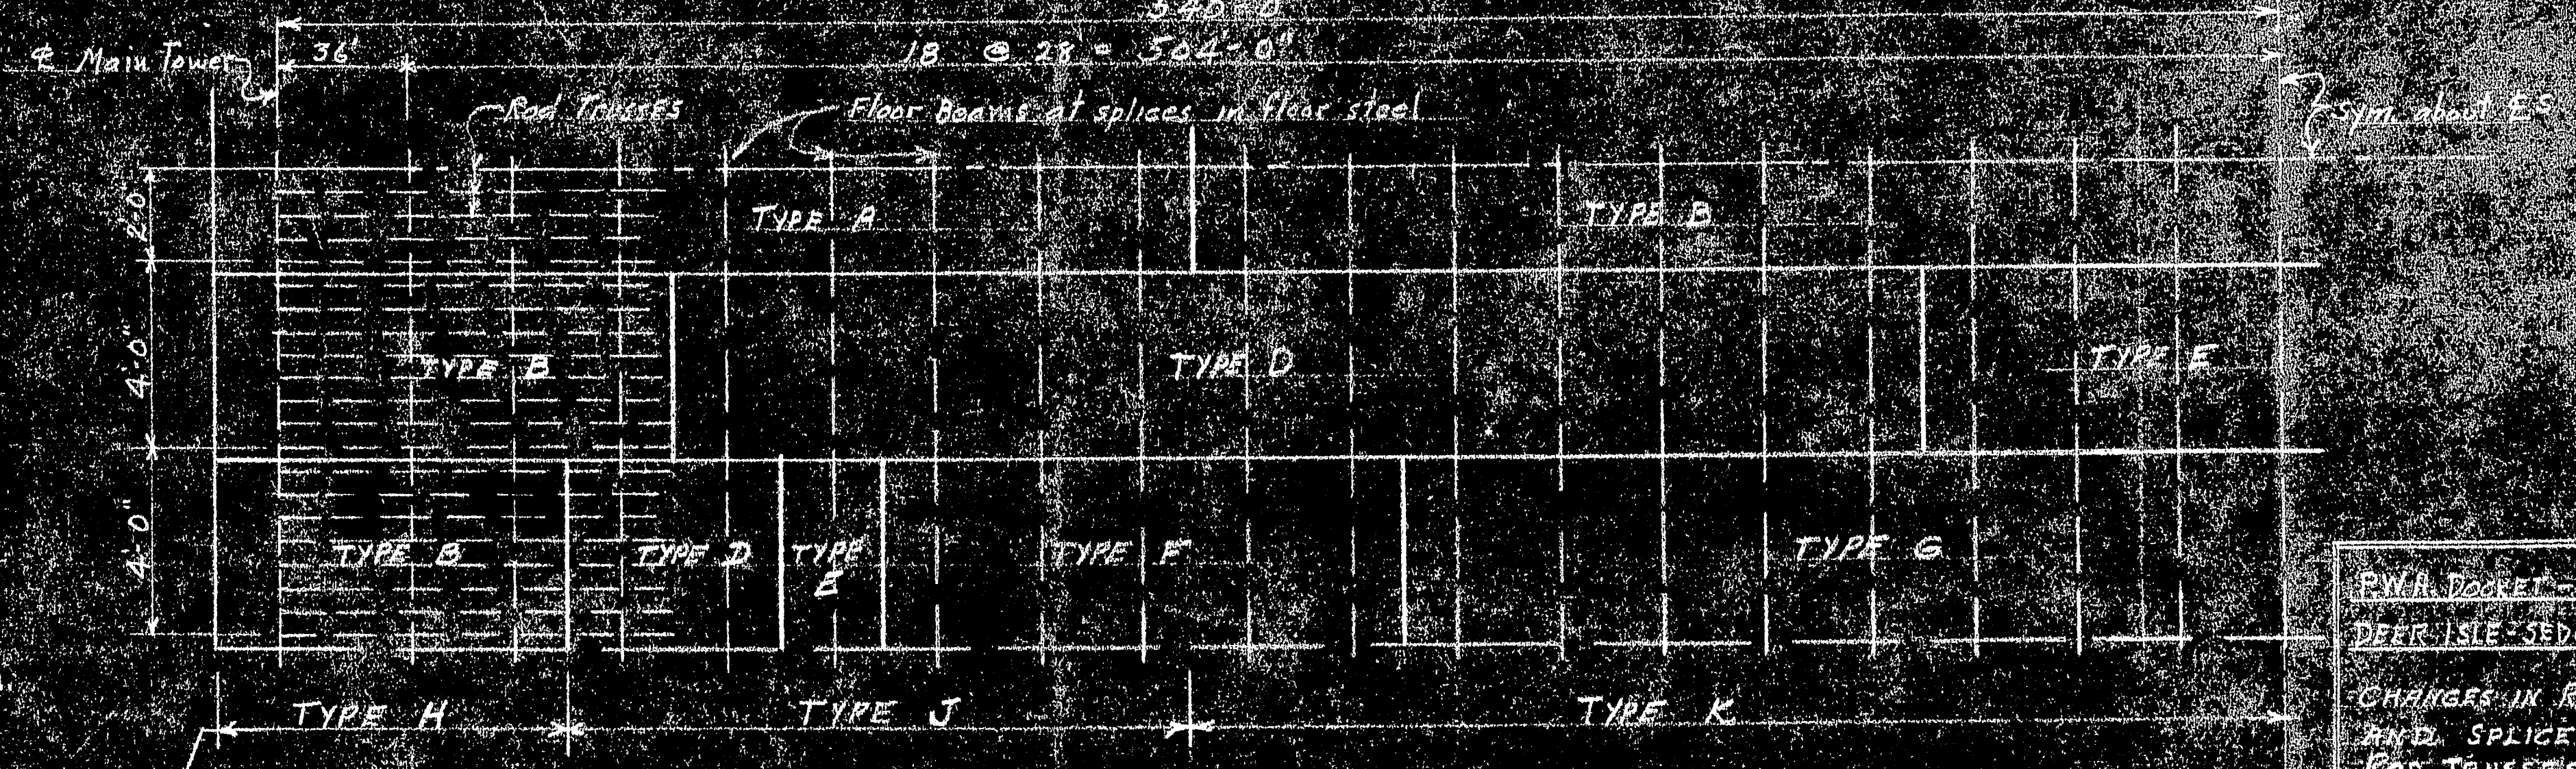

LOCATION & TYPES OF SPLICES - MAIN SPAN

PWA Docket - ME-1910-D  
DEER ISLE SEDGWICK BRIDGE  
CHANGES IN ROADWAY BEING  
AND SPLICES FOR REINF.  
ROD TRUSSES TO ACCOMPANY  
LETTER REQUESTING P.W.A.  
APPROVAL DATED 6-20-38

APRIL 12, 1938 ROBINSON & STEINMAN-ENGINEERS

