




PART CROSS-SECTION - ORIGINAL

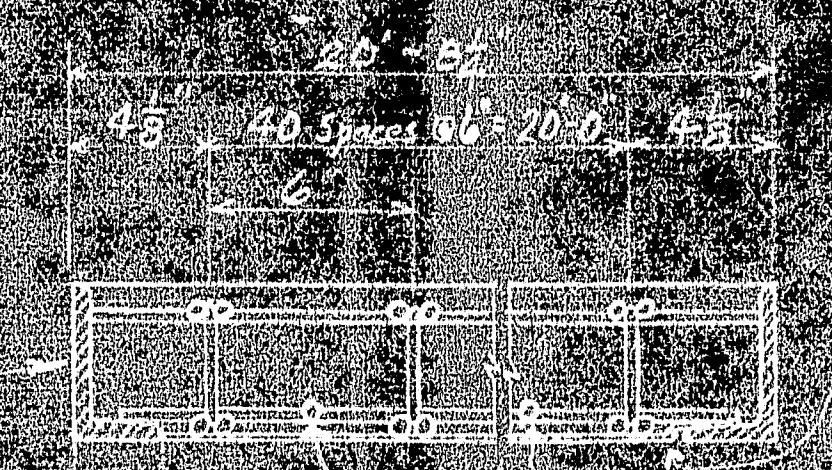


PART CROSS-SECTION - REVISED

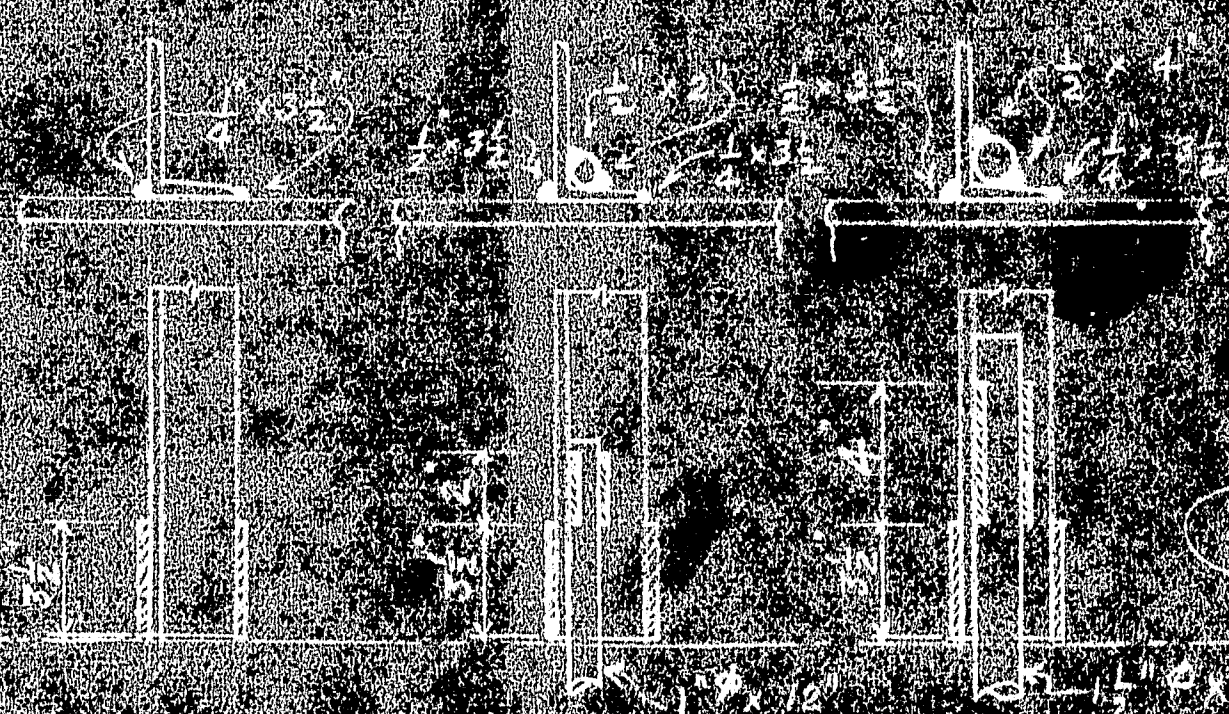

SPlice FOR EDGE ANGLE - TYPE H - TYPE J - TYPE K

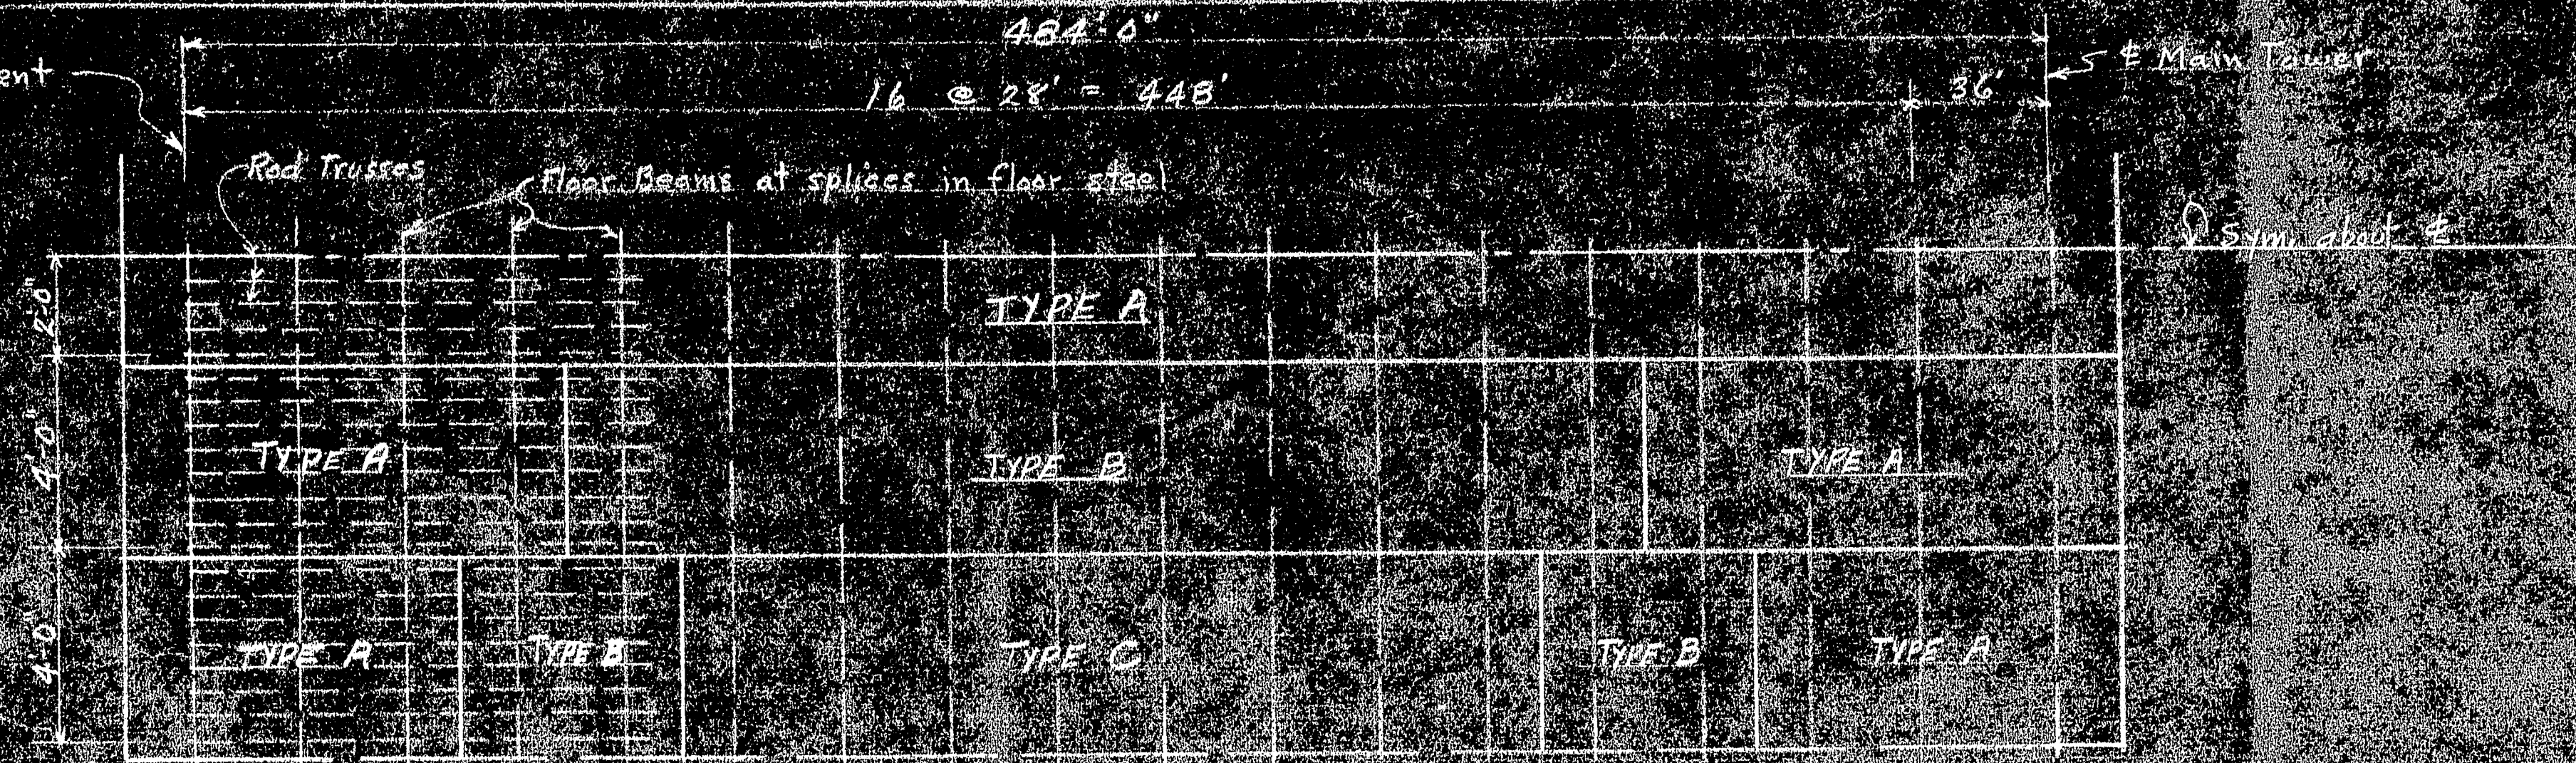

LOCATION & TYPES OF SPLICES - SIDE SPAN

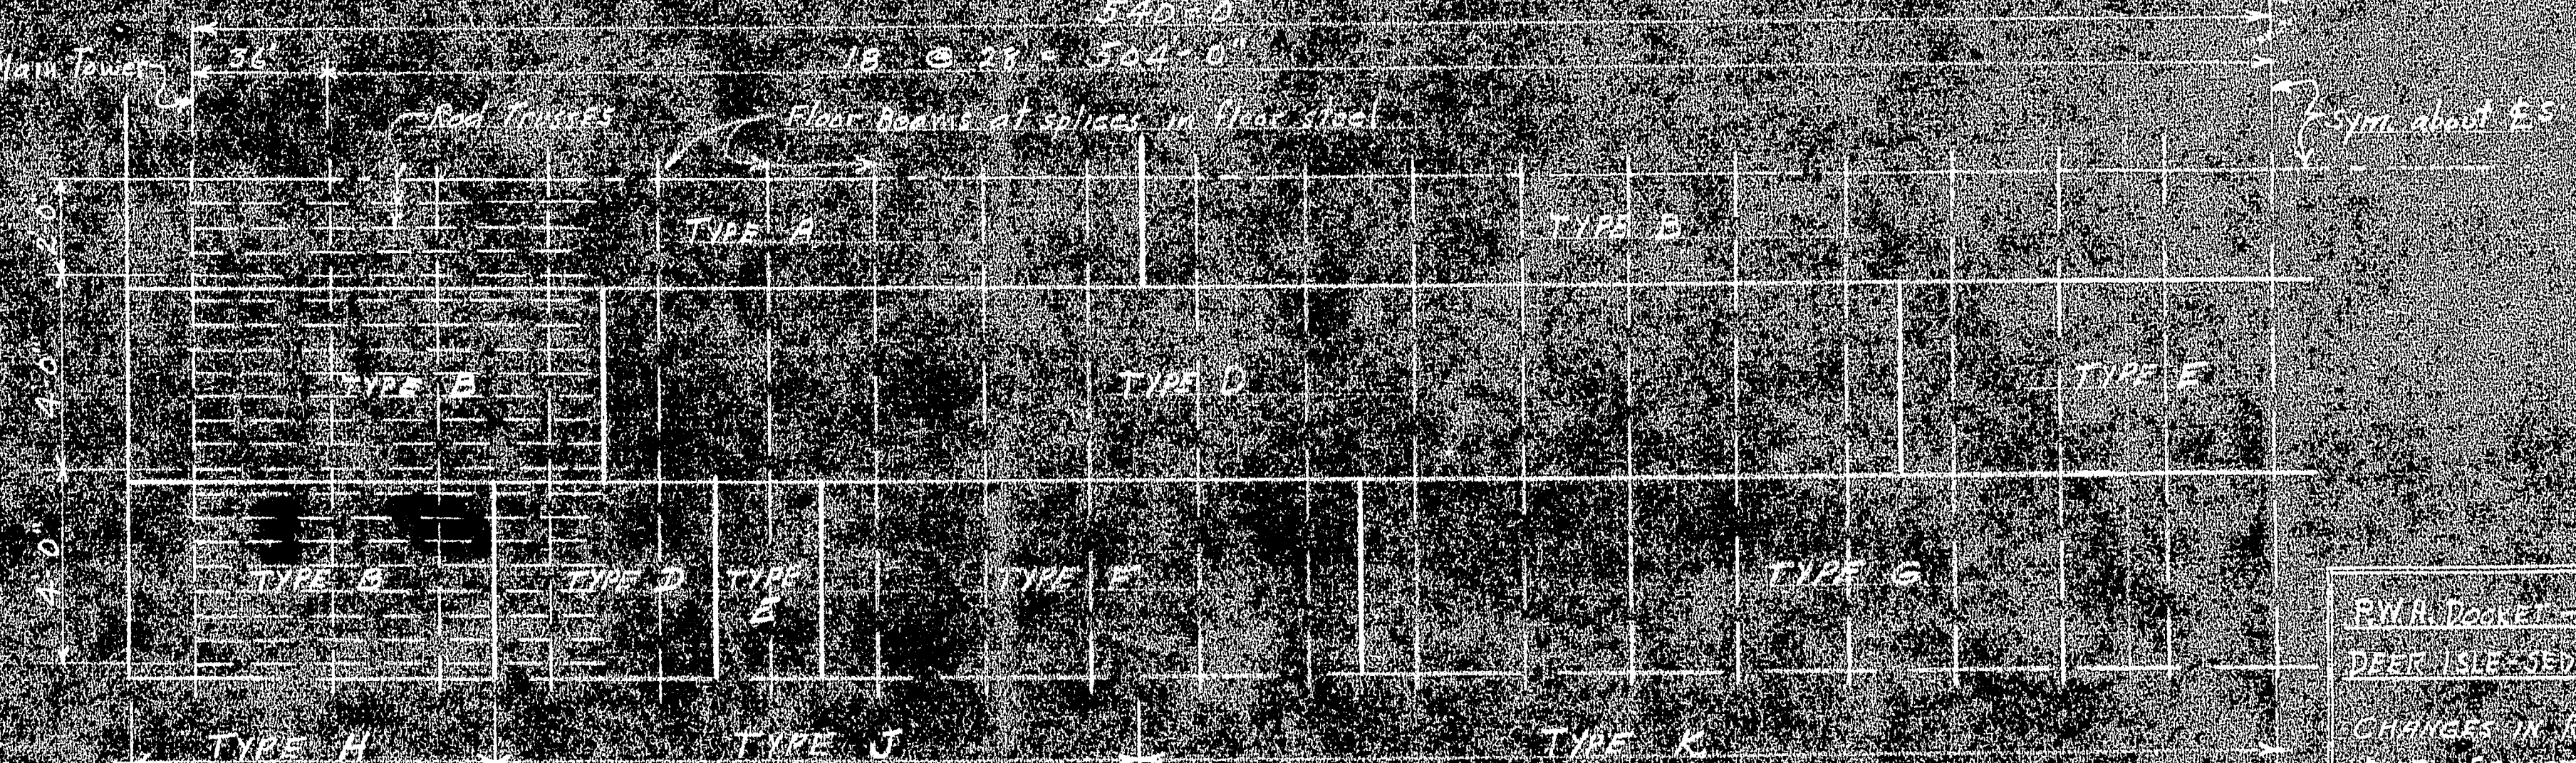

LOCATION & TYPES OF SPLICES - MAIN SPAN

FRANK DOUGLAS - ME. INC. D.  
DEPT. OF HIGHWAY BRIDGE  
CHANGES IN ROADWAY SLAB  
AND SPLICES FOR REINFORCING  
ROD TRUSSES TO ACCOMPANY  
LETTER REQUESTING R.C.A.  
APPROVAL DATED 6-20-38  
APRIL 10, 1939  
DOUGLAS & STEINMAN - ENGINEERS

