



LONGITUDINAL SECTION - ORIGINAL

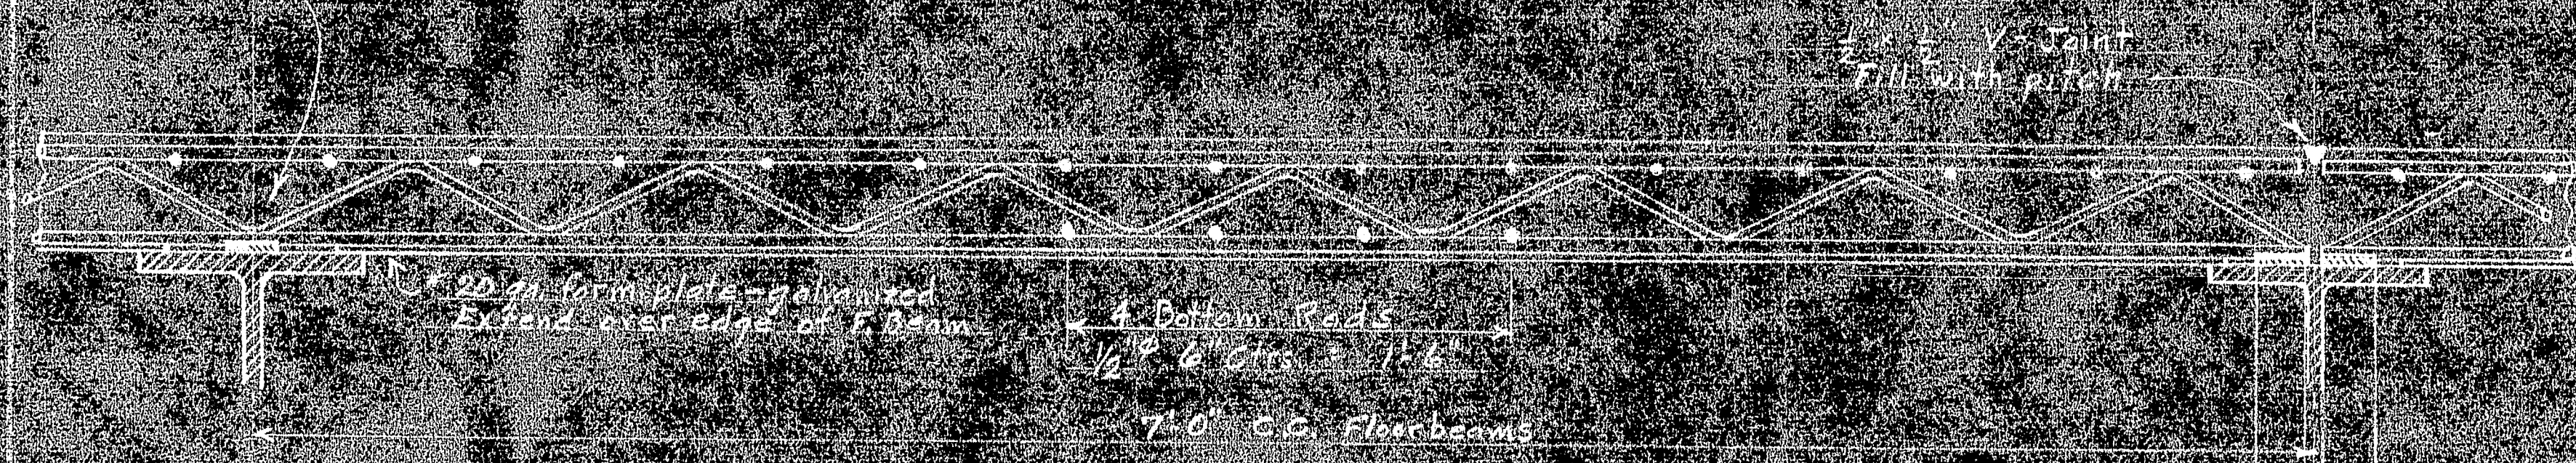


LONGITUDINAL SECTION - REVISED


TYPE	LOCATION - BOTTOM & FILLER WELDS	SPLICE RODS
A	One Side - Alternate Trusses	
B	" " " " " " " "	
C	Both Sides - " " " "	
D	" " " " " " " "	
E	" " " " " " " "	
F	" " " " " " " "	1/2\"
G	" " " " " " " "	3/4\"

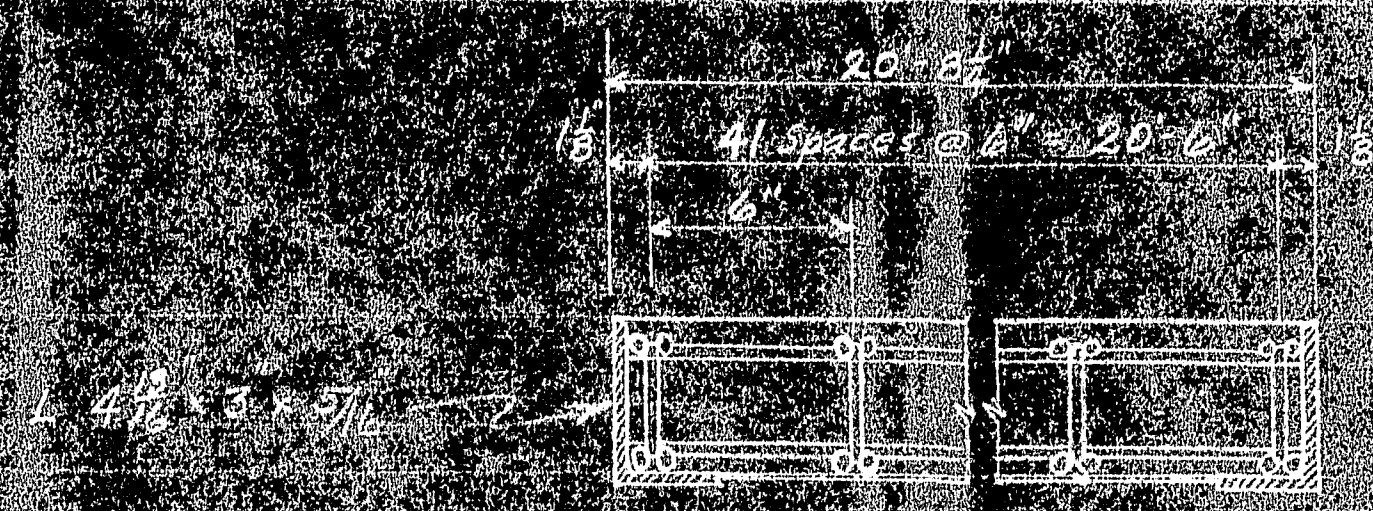

PART CROSS SECTION - ORIGINAL

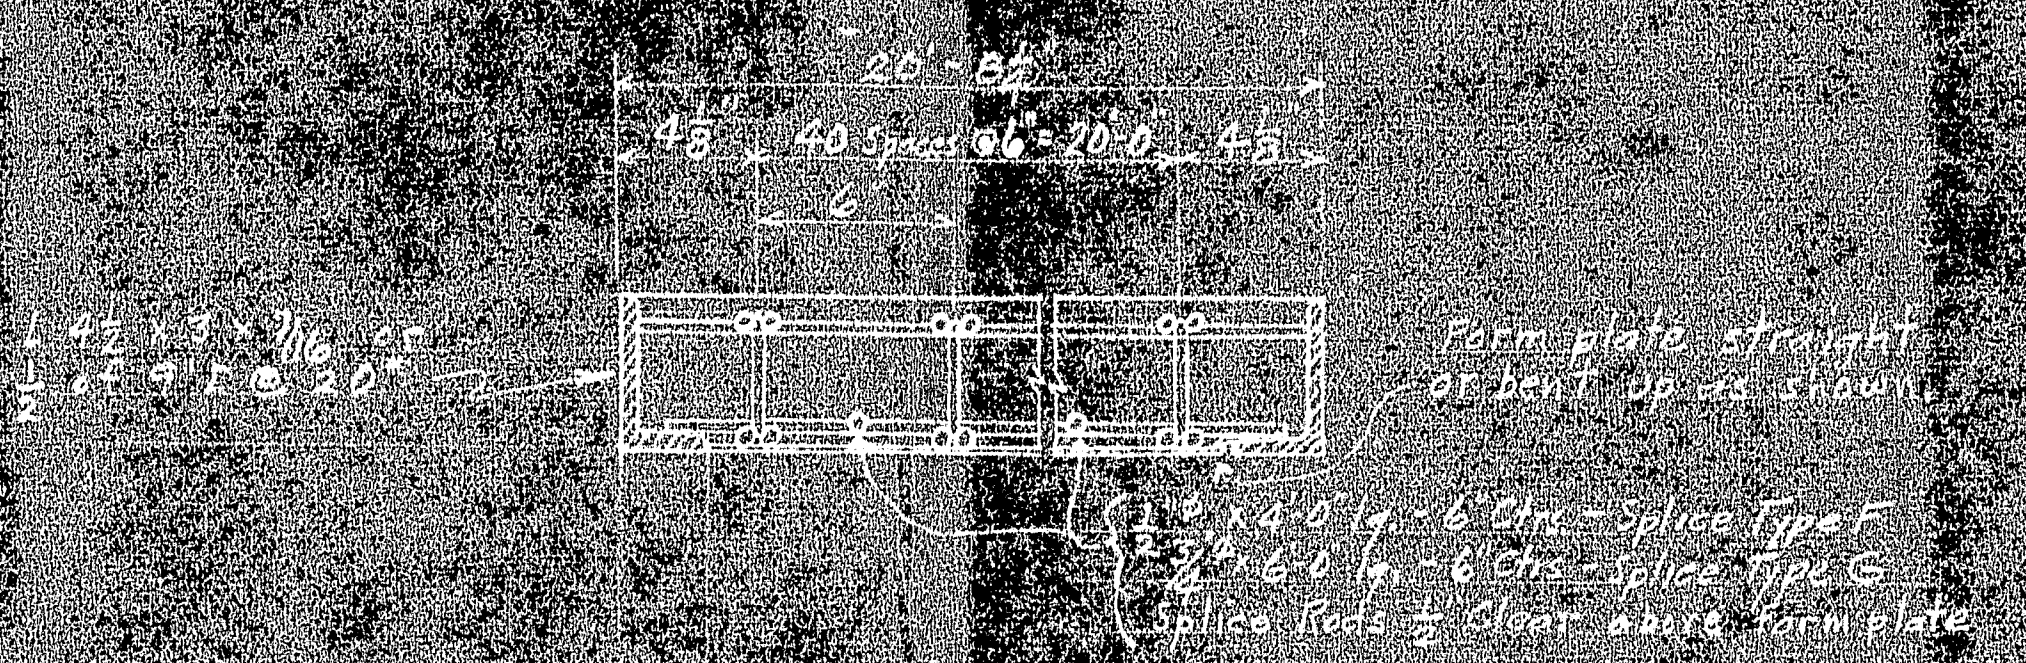

PART CROSS SECTION - REVISED

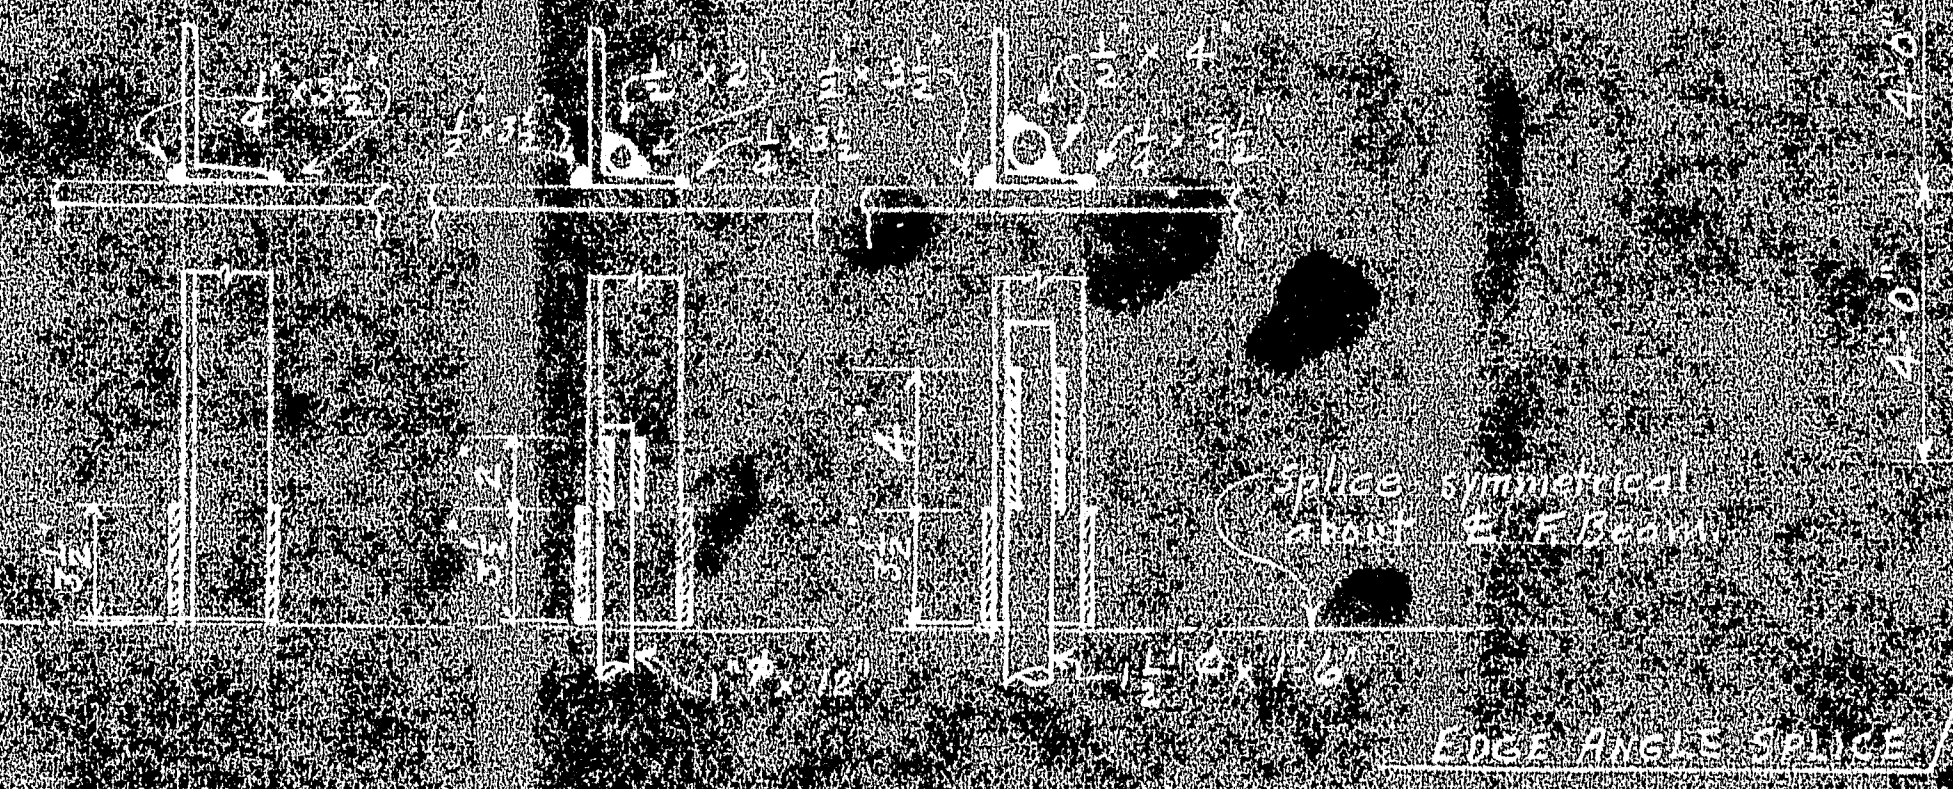

SPLICE FOR EDGE ANGLE - TYPE H - TYPE ST - TYPE K

